

DRAWING INDEX

DWG. N °	REV. N °	DATE	TITLE
CIVIL / STRUCTURAL			
CI-02	1	08/29/12	INJECTION WELL SITE PLAN
CI-03	1	08/29/12	INJECTION WELLS IW - 16, 17, 18, 19
CI-04	1	08/29/12	MISC. SECTIONS AND DETAILS SECTIONS AND DETAILS
CI-05	1	08/29/12	INJECTION WELLS IW - 1 THROUGH IW-7, AND CH - 8
CI-06	1	08/29/12	INJECTION WELLS IW - 15, 20, 21, 22
ST-01	1	08/29/12	CONTROL BUILDING - GENERAL NOTES
ST-02	1	08/29/12	CONTROL BUILDING - FLOOR PLAN
ST-03	1	08/29/12	CONTROL BUILDING - ELEVATIONS
ST-04	1	08/29/12	CONTROL BUILDING - SECTION AND DETAILS
ST-05	1	08/29/12	CONTROL BUILDING - SCHEDULE & DETAILS
ST-06	1	08/29/12	CONTROL BUILDING - FOUNDATION PLAN
ST-07	1	08/29/12	CONTROL BUILDING - MISCELLANEOUS DETAILS
ENGINEERING FLOW SHEETS			
EF-00	1	08/29/12	ENGINEERING FLOW SHEET - LEGEND
EF-01 S1	1	08/29/12	ENGINEERING FLOW SHEET - PROCESS EQUIPMENT
EF-01 S2	1	08/29/12	ENGINEERING FLOW SHEET - PROCESS EQUIPMENT
EF-02	1	08/29/12	ENGINEERING FLOW SHEET - MIDDLE FENCE INJECTION WELLS
EF-03	1	08/29/12	ENGINEERING FLOW SHEET - MIDDLE FENCE INJECTION WELLS
EF-04	1	08/29/12	ENGINEERING FLOW SHEET - MIDDLE FENCE INJECTION WELLS
EF-05	1	08/29/12	ENGINEERING FLOW SHEET - MIDDLE FENCE INJECTION WELLS
EF-06	1	08/29/12	ENGINEERING FLOW SHEET - NORTH FENCE INJECTION WELLS
EF-07	1	08/29/12	ENGINEERING FLOW SHEET - NORTH FENCE INJECTION WELLS
EF-08	1	08/29/12	ENGINEERING FLOW SHEET - NORTH FENCE INJECTION WELLS
MECHANICAL / PIPING			
MP-01	1	08/29/12	CONTROL BUILDING AND WELL - FIELD PIPING PLAN
MP-02	1	08/29/12	CONTROL BUILDING - EQUIPMENT LAYOUT AT GRADE
MP-03	1	08/29/12	CONTROL BUILDING - EQUIPMENT LAYOUT (UPPER)
MP-04	1	08/29/12	CONTROL BUILDING - EQUIPMENT SECTIONS
MP-05	1	08/29/12	WELL DETAILS
MP-06	1	08/29/12	INJECTION WELLS IW-16, 17 ,18 & 19 - PLAN AND SECTIONS
MP-07	1	08/29/12	INJECTION WELLS IW-15, 20 AND 22 - PLAN AND SECTIONS
MP-08	1	08/29/12	LAVATORY PLUMBING
MP-09	1	08/29/12	INJECTION WELL IW-08 - PLAN AND SECTIONS
MP-10	1	08/29/12	INJECTION WELLS IW-01 THRU IW-07 - PLAN AND SECTIONS
MP-11			REMOVED
MP-12	1	08/29/12	LINE LIST
MP-13	1	08/29/12	INJECTION WELLS IW-21A - PLAN AND SECTIONS
MP-14	1	08/29/12	INJECTION WELLS IW-21 - PLAN AND SECTIONS
ELECTRICAL / INSTRUMENTATION (NOT INCLUDED - TO BE PROVIDED AT LATER DATE)			
E-01	1	08/29/12	ELECTRICAL/INSTRUMENTATION SITE PLAN
E-02	1	08/29/12	CONTROL BUILDING SINGLE LINE DIAGRAM
E-03	1	08/29/12	CONTROL BUILDING - GROUNDING PLAN AND DETAILS
E-04	1	08/29/12	CONTROL BUILDING - LIGHTING PLAN AND DETAILS
E-05	1	08/29/12	CONTROL BUILDING - PANELBOARD SCHEDULES
E-06	1	08/29/12	CONTROL BUILDING POWER PLAN
E-07 SHT. 1	1	08/29/12	CONTROL BUILDING MOTOR SCHEMATIC DIAGRAMS
E-07 SHT. 2	1	08/29/12	CONTROL BUILDING MOTOR SCHEMATIC DIAGRAMS
E-08	1	08/29/12	CONTROL SYSTEM NETWORK ARCHITECTURE
E-09	1	08/29/12	CONTROL BUILDING INSTRUMENTATION PLAN AND DETAILS
E-10	1	08/29/12	MAIN PLC CONTROL PANEL ARRANGEMENT
E-11 SHT. 1	1	08/29/12	MAIN PLC CONTROL PANEL WIRING DIAGRAM
E-11 SHT. 2	1	08/29/12	MAIN PLC CONTROL PANEL ANALOG INPUT WIRING DIAGRAM
E-11 SHT. 3	1	08/29/12	MAIN PLC CONTROL PANEL ANALOG OUTPUT WIRING DIAGRAM
E-11 SHT. 4	1	08/29/12	MAIN PLC CONTROL PANEL DIGITAL INPUT WIRING DIAGRAM (1 OF 2)
E-11 SHT. 5	1	08/29/12	MAIN PLC CONTROL PANEL DIGITAL INPUT WIRING DIAGRAM (2 OF 2)
E-11 SHT. 6	1	08/29/12	MAIN PLC CONTROL PANEL DIGITAL OUTPUT WIRING DIAGRAM
E-12	1	08/29/12	INJECTION WELLS PLAN, SECTION & DETAILS
E-13	1	08/29/12	INJECTION WELLS HEAT TRACING PLAN, SECTION & DETAILS
E-14	1	08/29/12	INJECTION WELLS TYPICAL ELECTRICAL WIRING DIAGRAM
E-15	1	08/29/12	TYPICAL INJECTION WELL REMOTE I/O PANEL ARRANGEMENT
E-16 SHT. 1	1	08/29/12	INJECTION WELL IW-1 REMOTE I/O PANEL WIRING DIAGRAM
E-16 SHT. 2	1	08/29/12	INJECTION WELL IW-2 REMOTE I/O PANEL WIRING DIAGRAM
E-16 SHT. 3	1	08/29/12	INJECTION WELL IW-3 REMOTE I/O PANEL WIRING DIAGRAM
E-16 SHT. 4	1	08/29/12	INJECTION WELL IW-4 REMOTE I/O PANEL WIRING DIAGRAM
E-16 SHT. 5	1	08/29/12	INJECTION WELL IW-5 REMOTE I/O PANEL WIRING DIAGRAM
E-16 SHT. 6	1	08/29/12	INJECTION WELL IW-6 REMOTE I/O PANEL WIRING DIAGRAM
E-16 SHT. 7	1	08/29/12	INJECTION WELL IW-7 REMOTE I/O PANEL WIRING DIAGRAM
E-16 SHT. 15	1	08/29/12	INJECTION WELL IW-15 REMOTE I/O PANEL WIRING DIAGRAM
E-16 SHT. 16	1	08/29/12	INJECTION WELL IW-16 REMOTE I/O PANEL WIRING DIAGRAM
E-16 SHT. 17	1	08/29/12	INJECTION WELL IW-17 REMOTE I/O PANEL WIRING DIAGRAM
E-16 SHT. 18	1	08/29/12	INJECTION WELL IW-18 REMOTE I/O PANEL WIRING DIAGRAM
E-16 SHT. 19	1	08/29/12	INJECTION WELL IW-19 REMOTE I/O PANEL WIRING DIAGRAM
E-16 SHT. 20	1	08/29/12	INJECTION WELL IW-20 REMOTE I/O PANEL WIRING DIAGRAM
E-16 SHT. 22	1	08/29/12	INJECTION WELL IW-22 REMOTE I/O PANEL WIRING DIAGRAM

HOOKER/RUCO SITE  
HICKSVILLE, NEW YORK

BIOSPARGE  
TREATMENT SYSTEM  
MIDDLE AND NORTH INJECTION FENCE  
UNDERGROUND VAULTS


AS BUILT

06883-00(056)



CRA Infrastructure  
& Engineering, Inc.



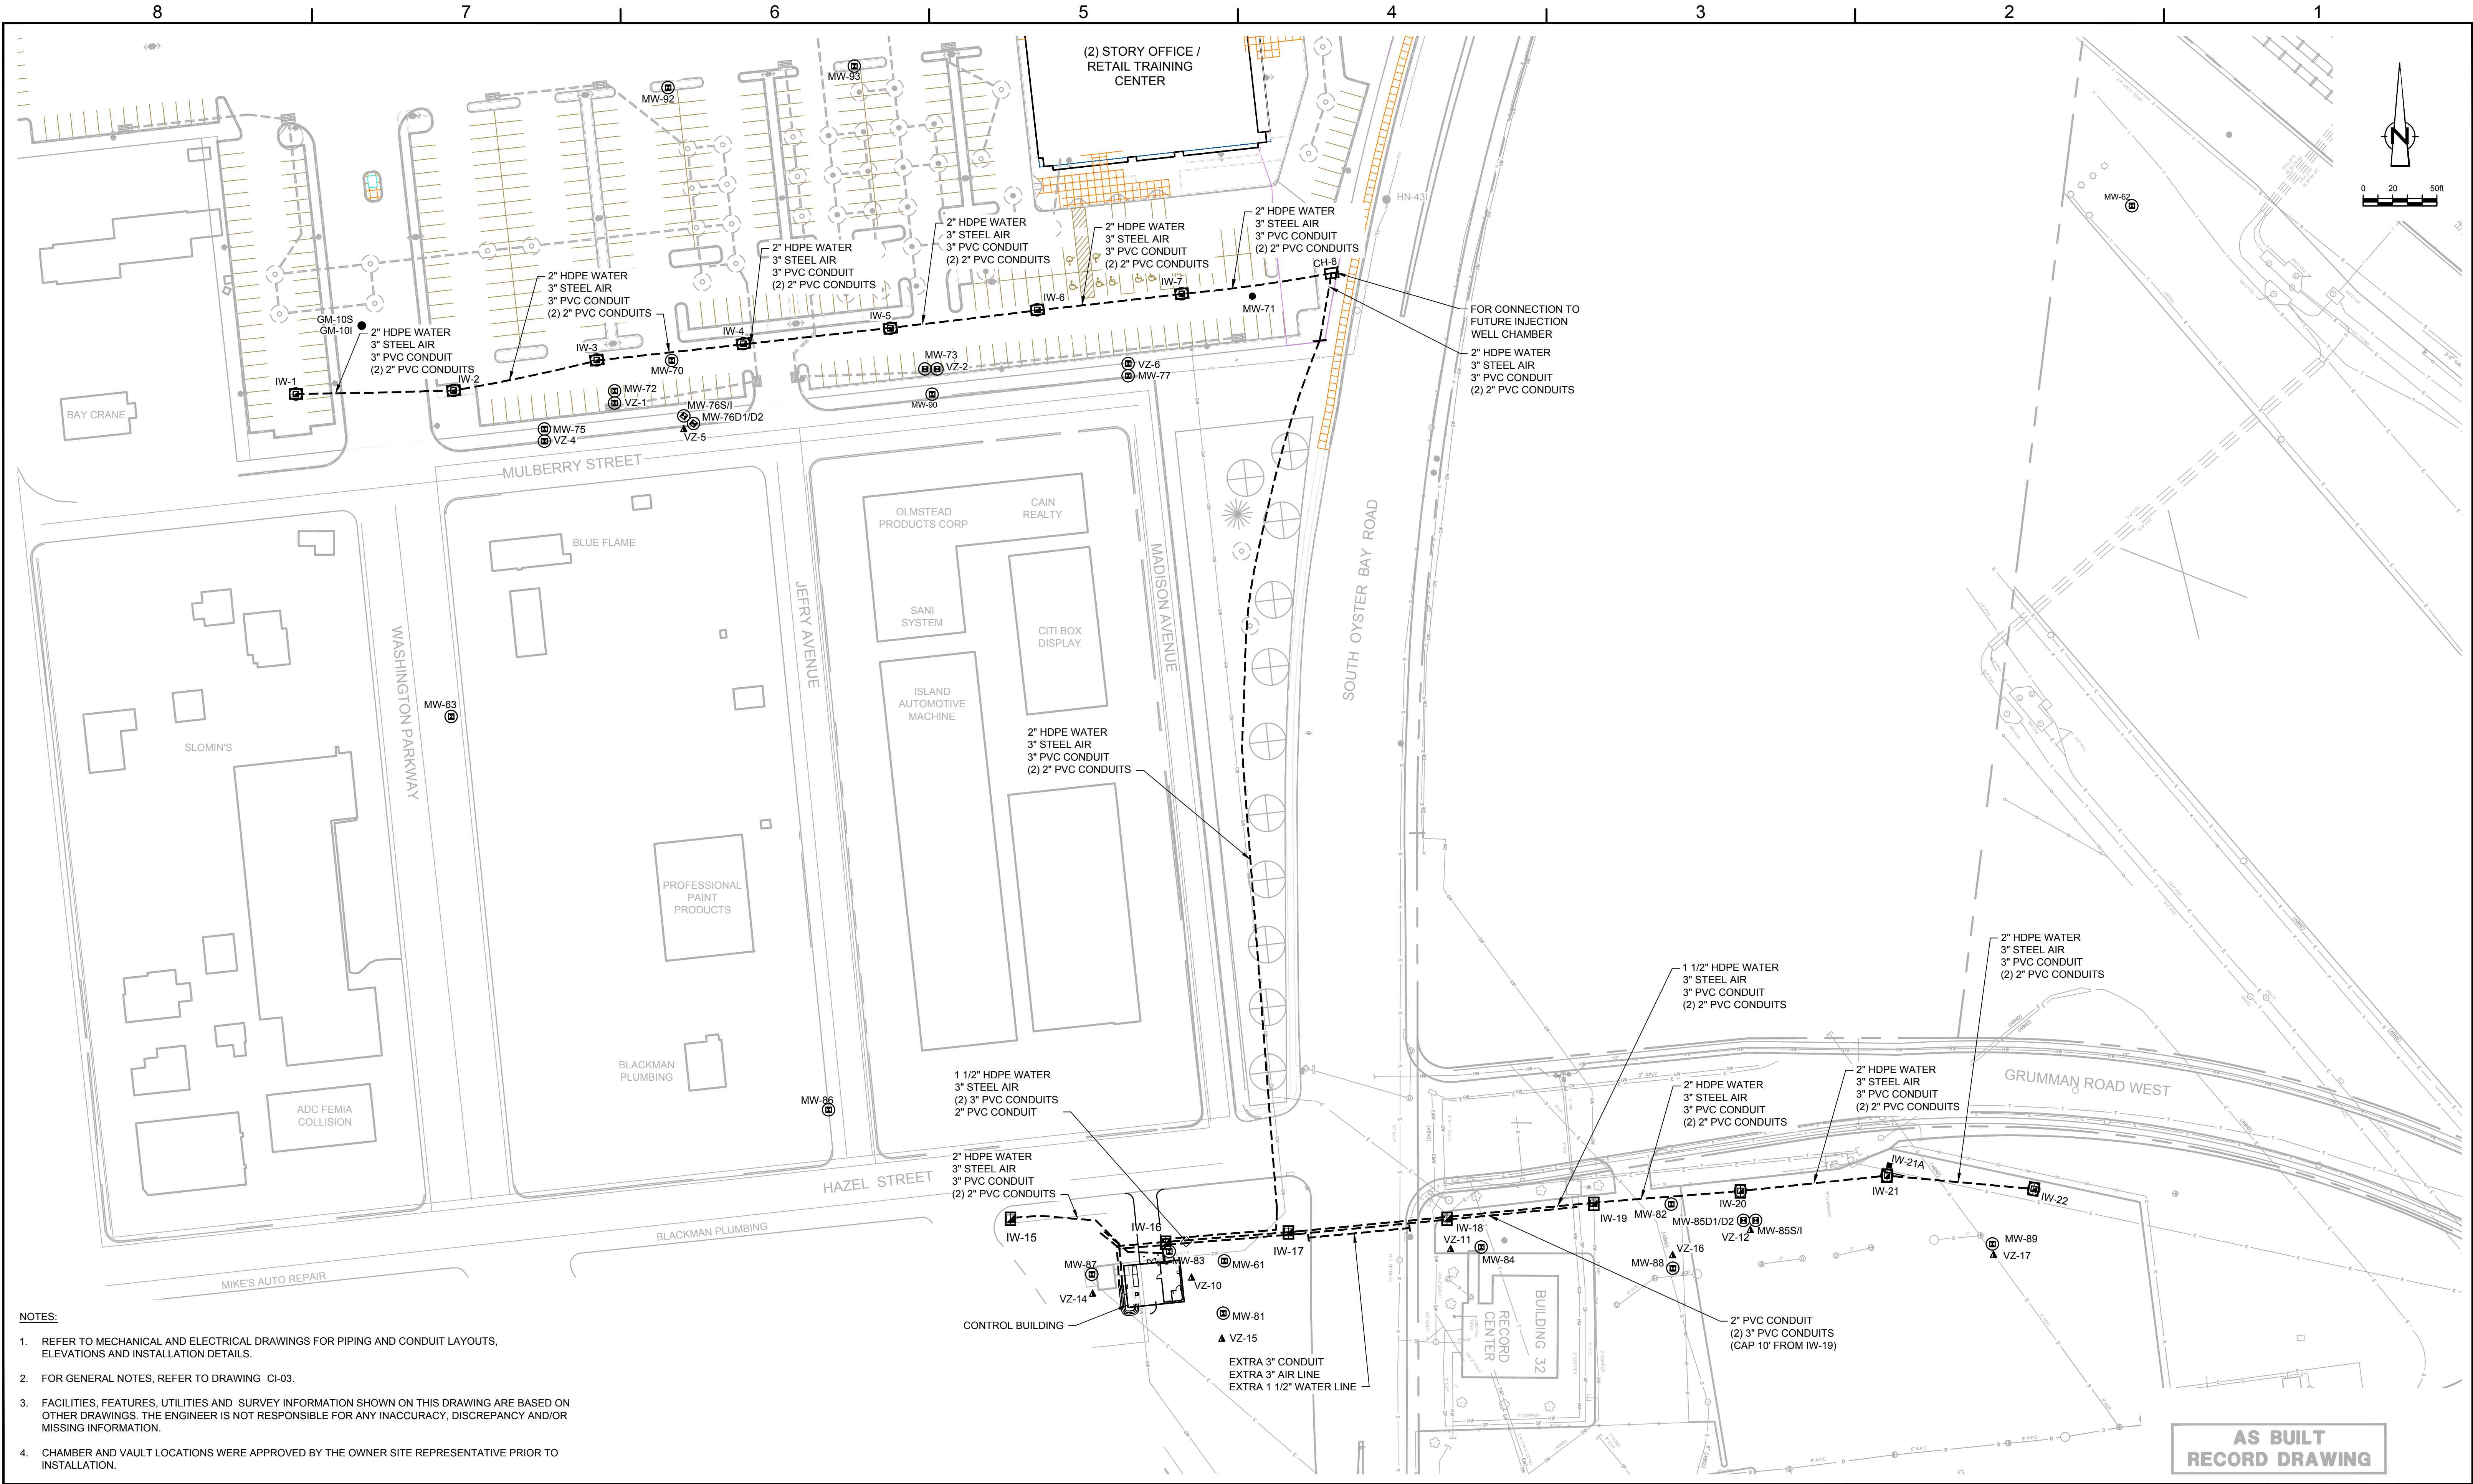

- NOTES:**
- REFER TO MECHANICAL AND ELECTRICAL DRAWINGS FOR PIPING AND CONDUIT LAYOUTS, ELEVATIONS AND INSTALLATION DETAILS.
  - FOR GENERAL NOTES, REFER TO DRAWING CI-03.
  - FACILITIES, FEATURES, UTILITIES AND SURVEY INFORMATION SHOWN ON THIS DRAWING ARE BASED ON OTHER DRAWINGS. THE ENGINEER IS NOT RESPONSIBLE FOR ANY INACCURACY, DISCREPANCY AND/OR MISSING INFORMATION.
  - CHAMBER AND VAULT LOCATIONS WERE APPROVED BY THE OWNER SITE REPRESENTATIVE PRIOR TO INSTALLATION.

LEGEND			
---	FORCEMAIN AND CONDUIT ALIGNMENT		
⊙ IW-6	INJECTION WELL LOCATION		
● MW-90	MONITORING WELL LOCATION		
⊕ MW-78	MONITORING WELL NEST AND VADOSE ZONE		
⊕ VZ-7	MONITORING WELL NEST LOCATION		
□	CHAMBER		


SCALE VERIFICATION: THIS BAR MEASURES 1" ON ORIGINAL. ADJUST SCALE ACCORDINGLY.			
1	AS BUILT	08/29/12	JA
No	Revision	Date	Initial

WARNING: ALTERING THIS DOCUMENT IS IN VIOLATION OF THE NEW YORK STATE EDUCATION LAW EXCEPTING AS PROVIDED IN SECTION 7209, PART 2 OF THE LAW.

HOOKER/ RUCO SITE HICKSVILLE, NEW YORK	
BIOSPARGE TREATMENT SYSTEM	
INJECTION WELL SITE PLAN	

		<b>CRA Infrastructure &amp; Engineering, Inc.</b>	
Source Reference:		Date: SEPTEMBER 2003	
Project Manager: J. KAY	Reviewed By: J. WORRALL	Designed By: J. THORNTON	Drawn By: C. ROHRICH
Scale: AS NOTED	Project No: 06883-00	Report No: 056	Drawing No: CI-02



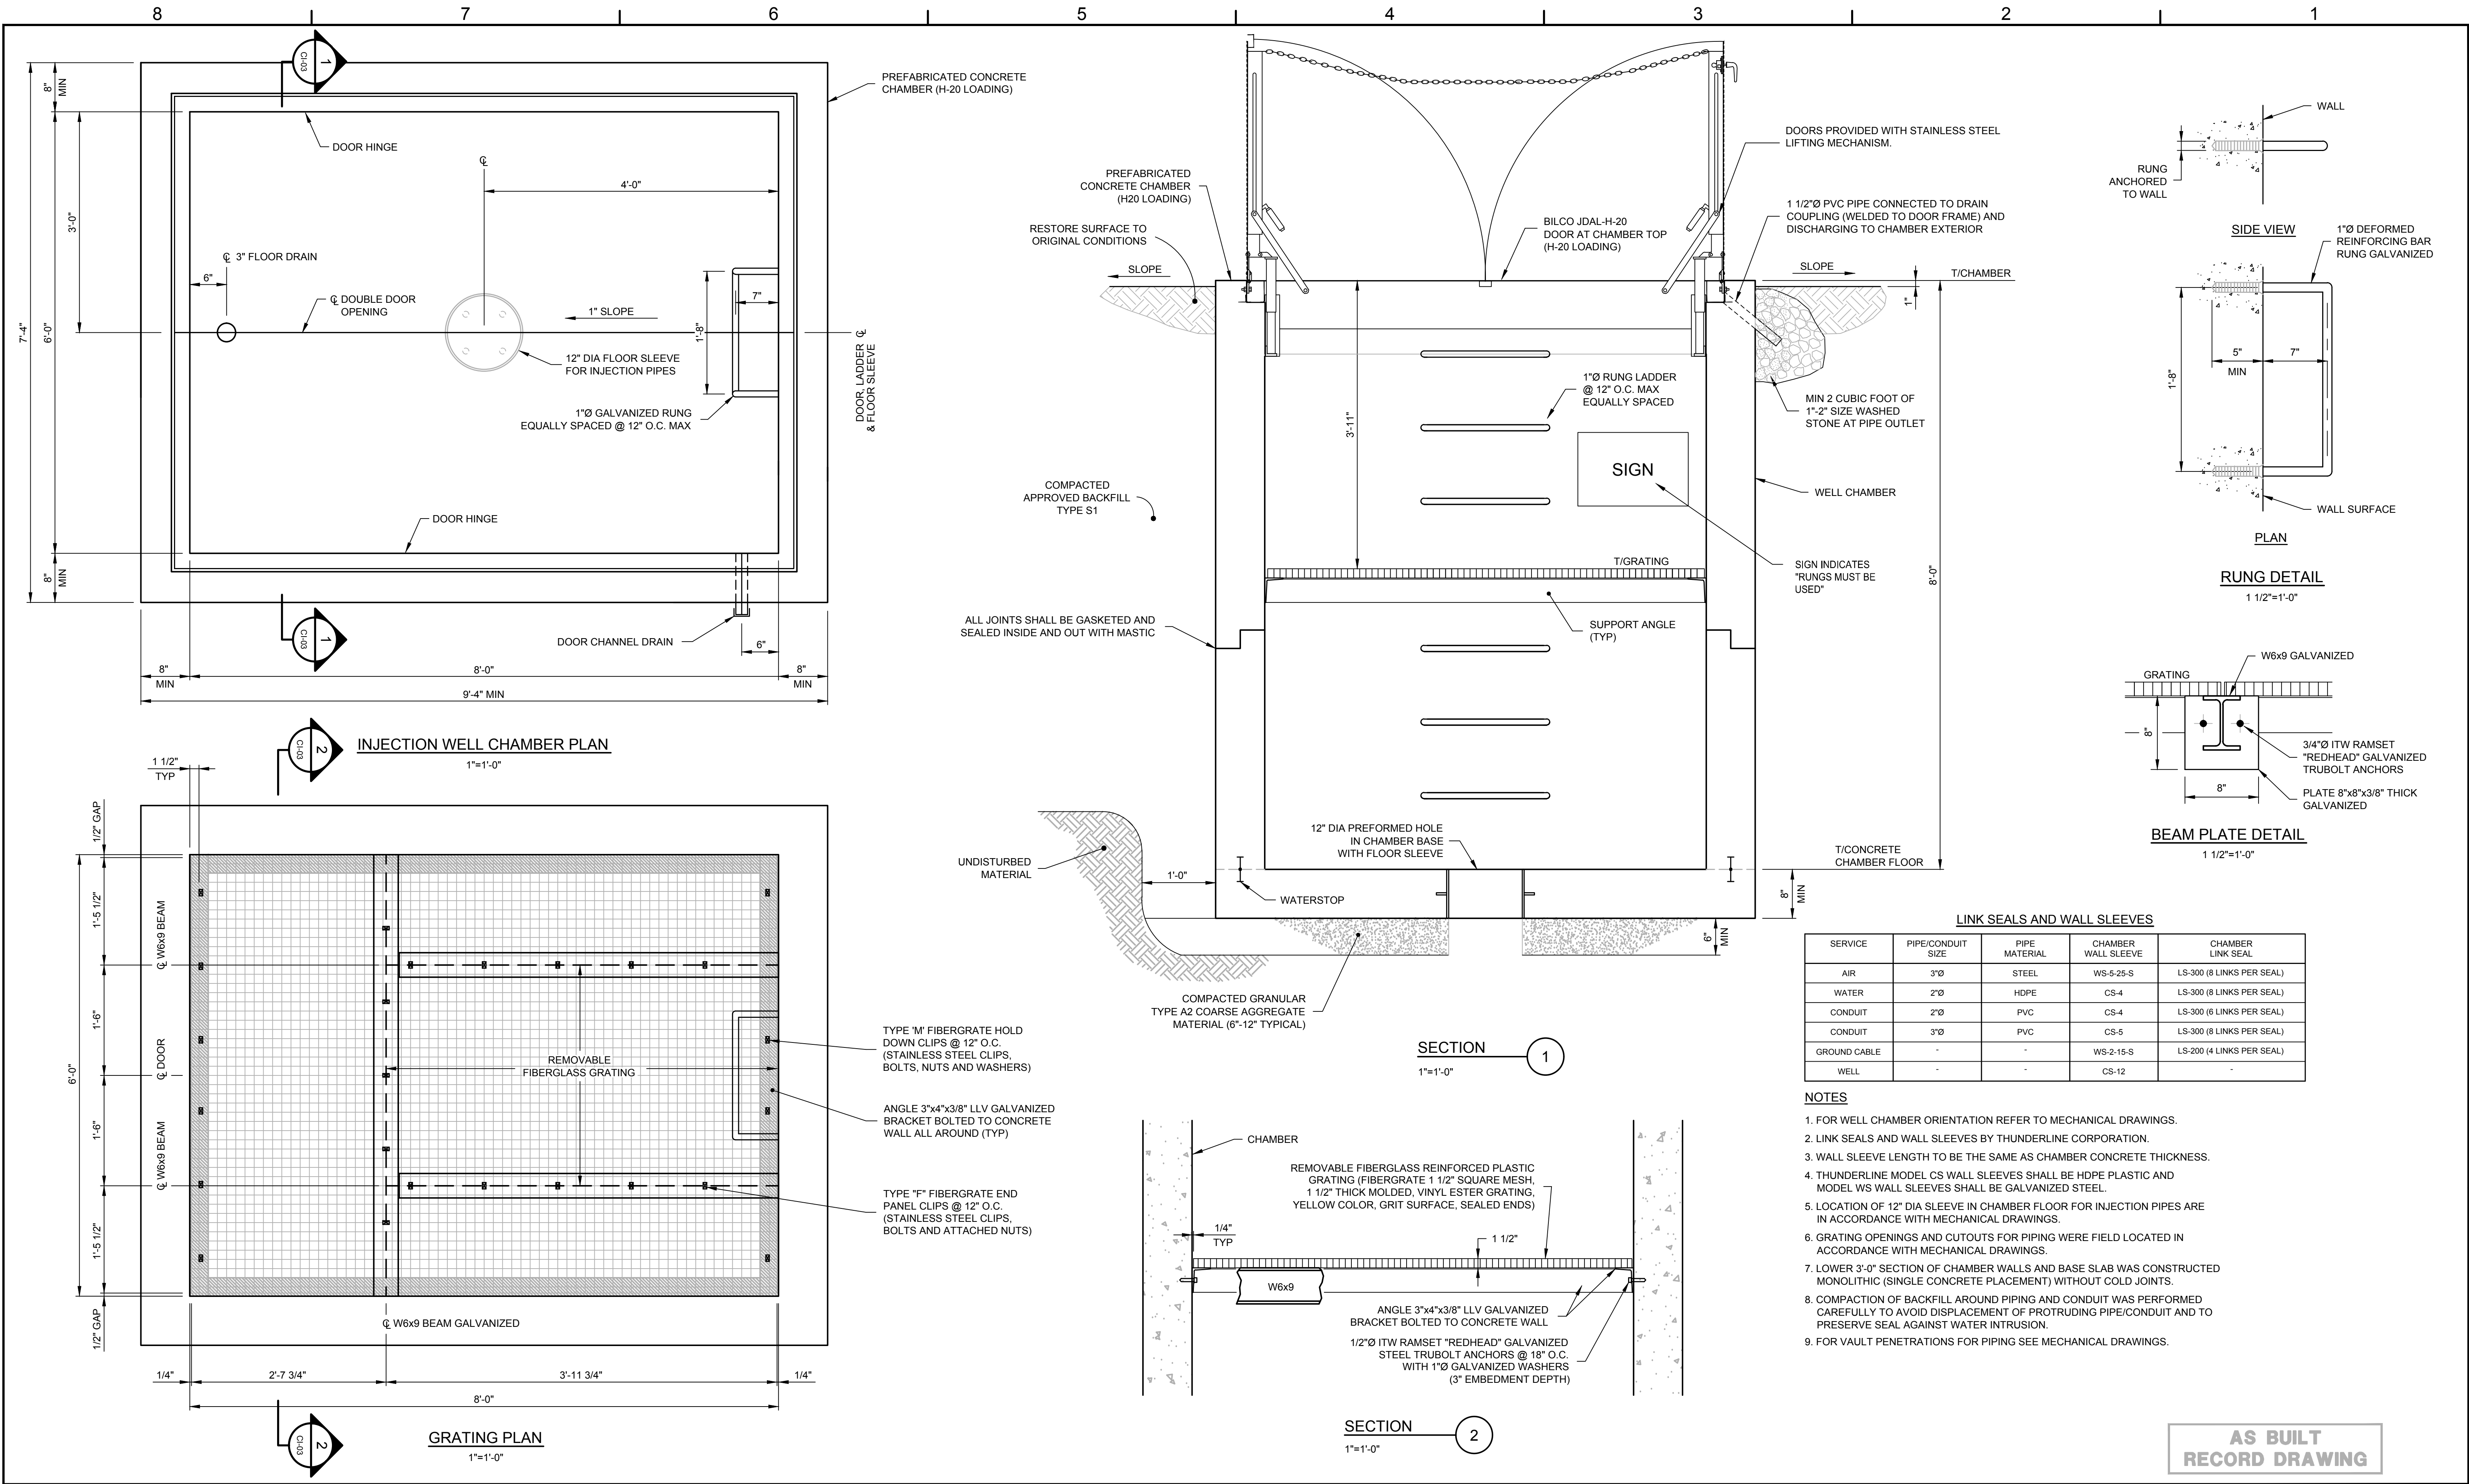

SCALE VERIFICATION: THIS BAR MEASURES 1" ON ORIGINAL. ADJUST SCALE ACCORDINGLY.

No	Revision	Date	Initial
1	AS BUILT	08/29/12	JA

WARNING: ALTERING THIS DOCUMENT IS IN VIOLATION OF THE NEW YORK STATE EDUCATION LAW EXCEPTING AS PROVIDED IN SECTION 7209, PART 2 OF THE LAW.

HOOVER/ RUCO SITE  
HICKSVILLE, NEW YORK


BIOSPARGE TREATMENT SYSTEM


INJECTION WELLS  
IW - 16, 17, 18, 19

**CRA Infrastructure & Engineering, Inc.**


Source Reference:			Date:
Project Manager:	Reviewed By:	Designed By:	Drawn By:
J. KAY	J. WERRALL	J. THORNTON	C. ROHRICH
Scale:	Project No:	Report No:	Drawing No:
AS NOTED	06883-00	056	CI-03

06883-00(056)CI-BU003 AUG 22/2012

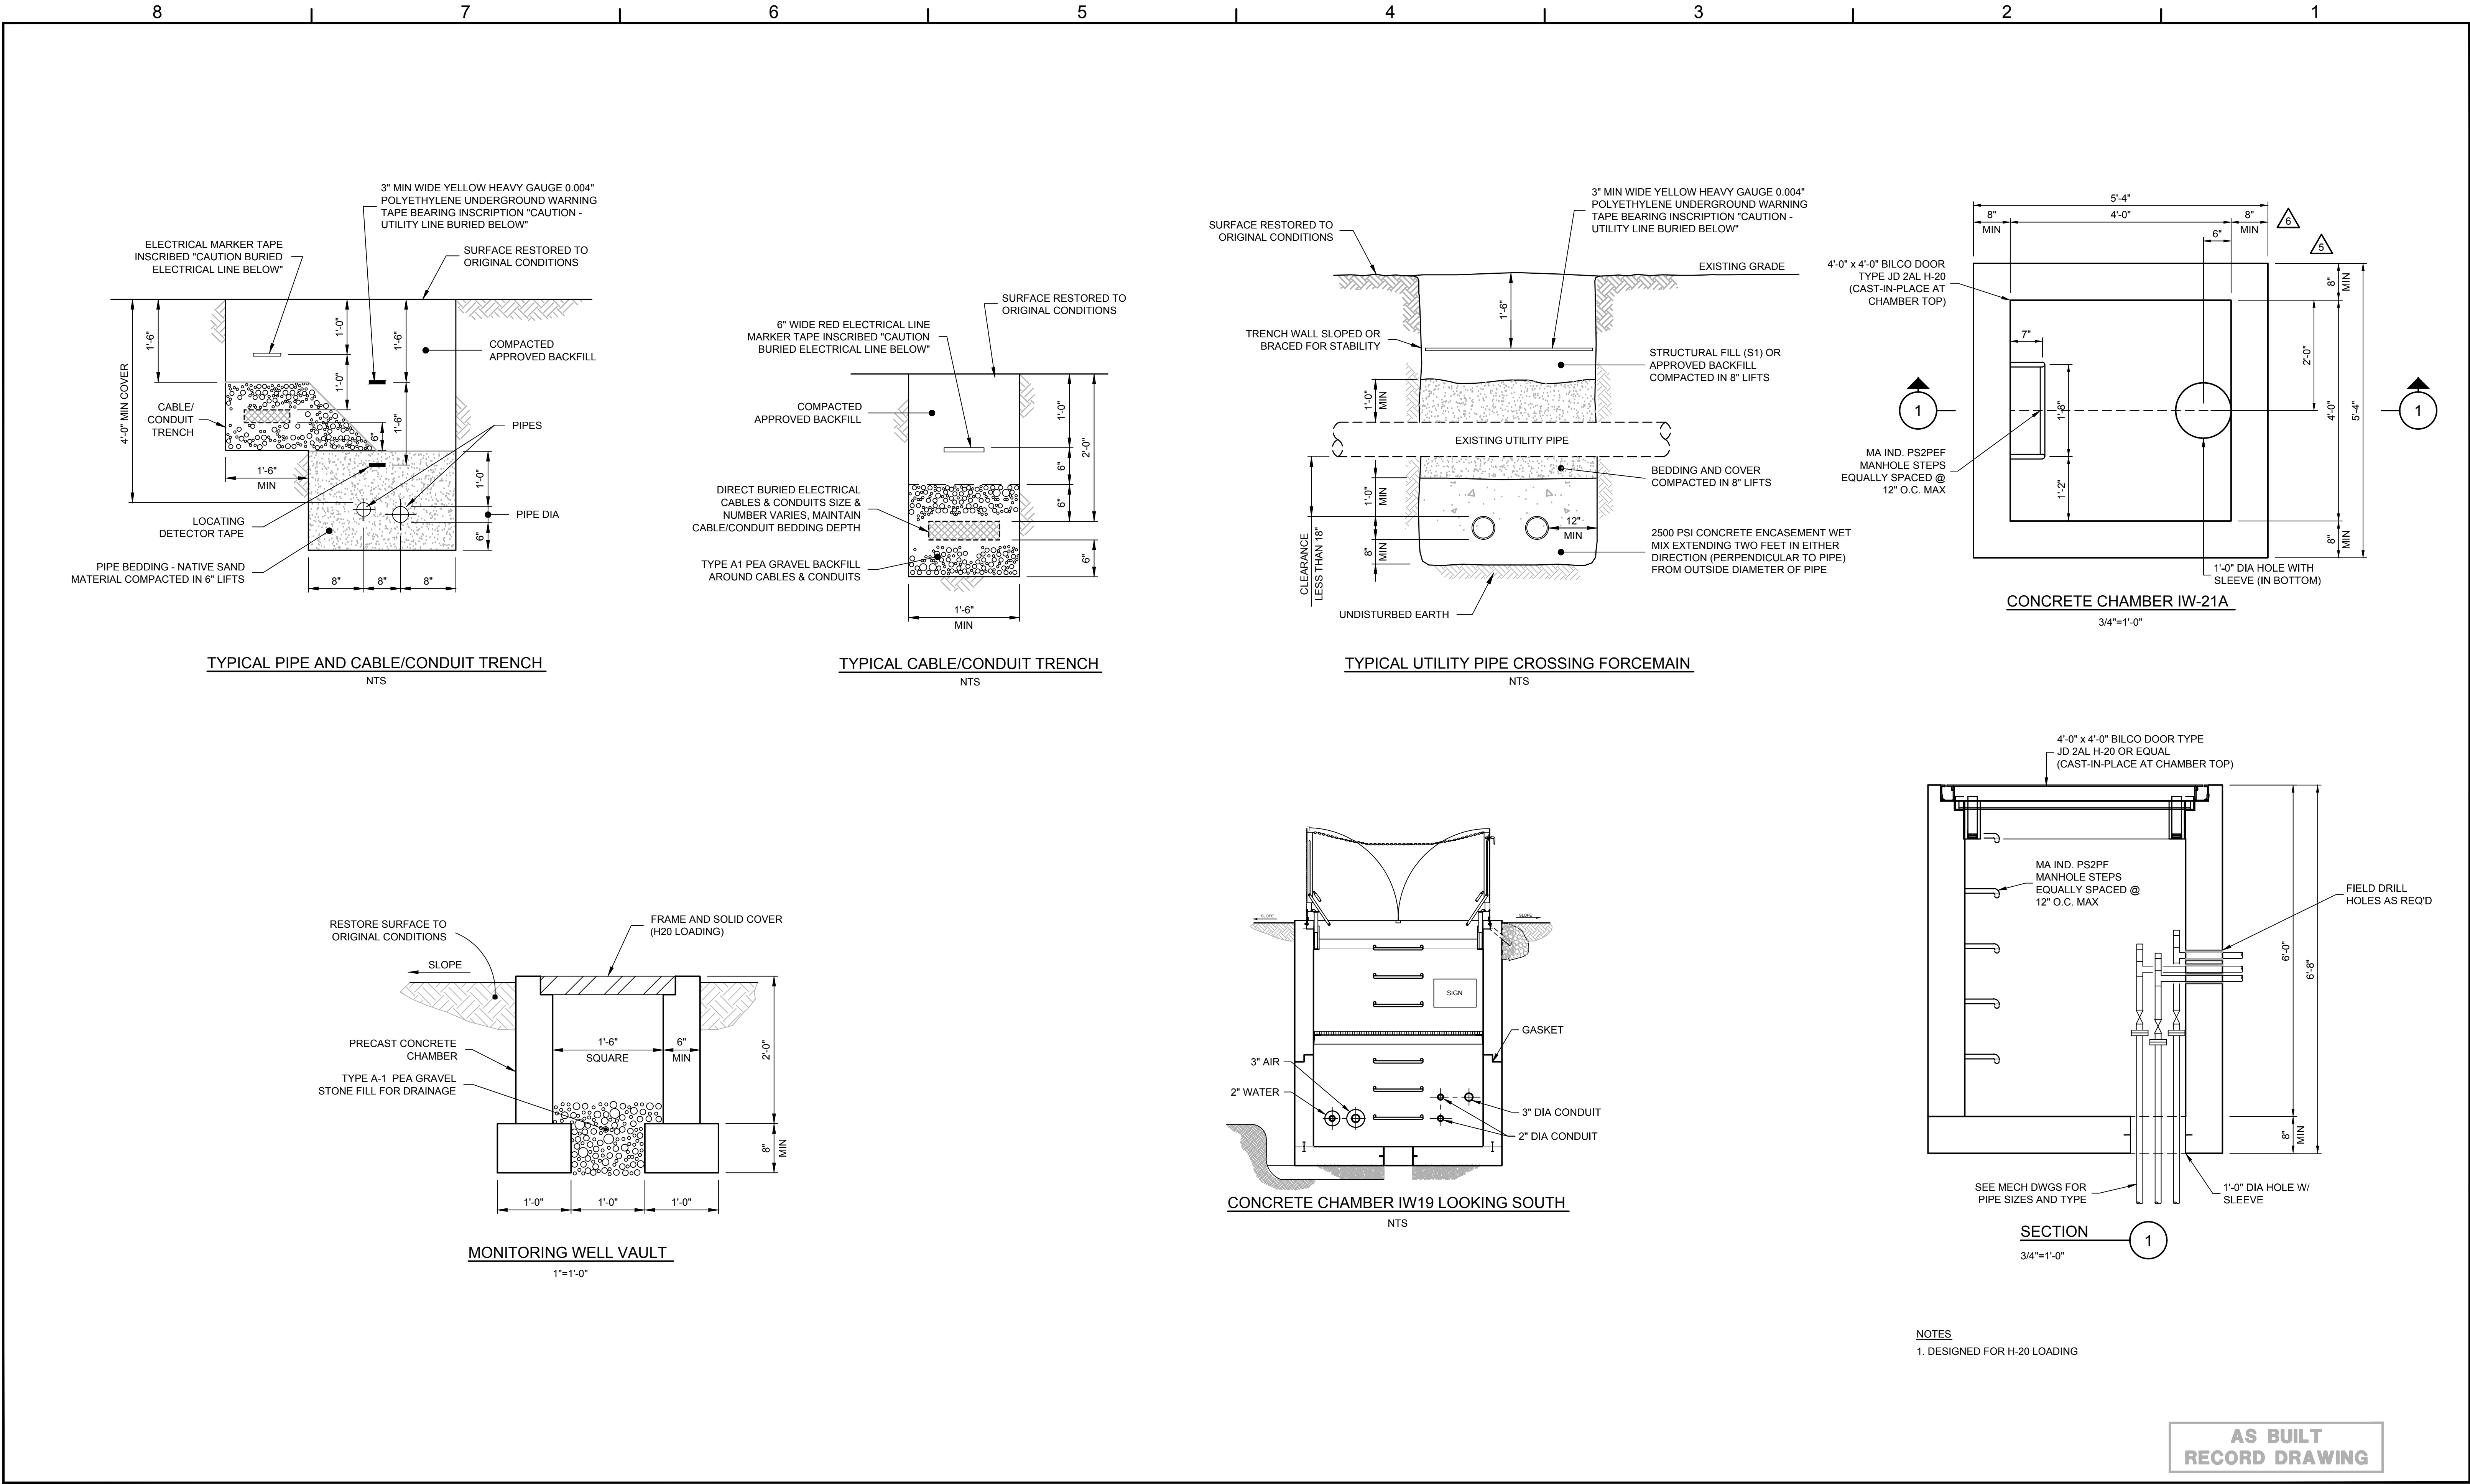


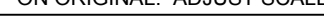	SCALE VERIFICATION: THIS BAR MEASURES 1" ON ORIGINAL. ADJUST SCALE ACCORDINGLY.			
				
	1	AS BUILT	08/29/12	JA
	No	Revision	Date	Initial
WARNING: ALTERING THIS DOCUMENT IS IN VIOLATION OF THE NEW YORK STATE EDUCATION LAW EXCEPTING AS PROVIDED IN SECTION 7209, PART 2 OF THE LAW.				

HOOKER/ RUCO SITE HICKSVILLE, NEW YORK	
BIOSPARGE TREATMENT SYSTEM	
MISC. SECTIONS AND DETAILS	

		<b>CRA Infrastructure &amp; Engineering, Inc.</b>	
Source Reference:			Date: SEPTEMBER 2003
Project Manager: J. KAY	Reviewed By: J. WORRALL	Designed By: J. THORNTON	Drawn By: C. ROHRICH
Scale: AS NOTED	Project No: 06883-00	Report No: 056	Drawing No: CI-04



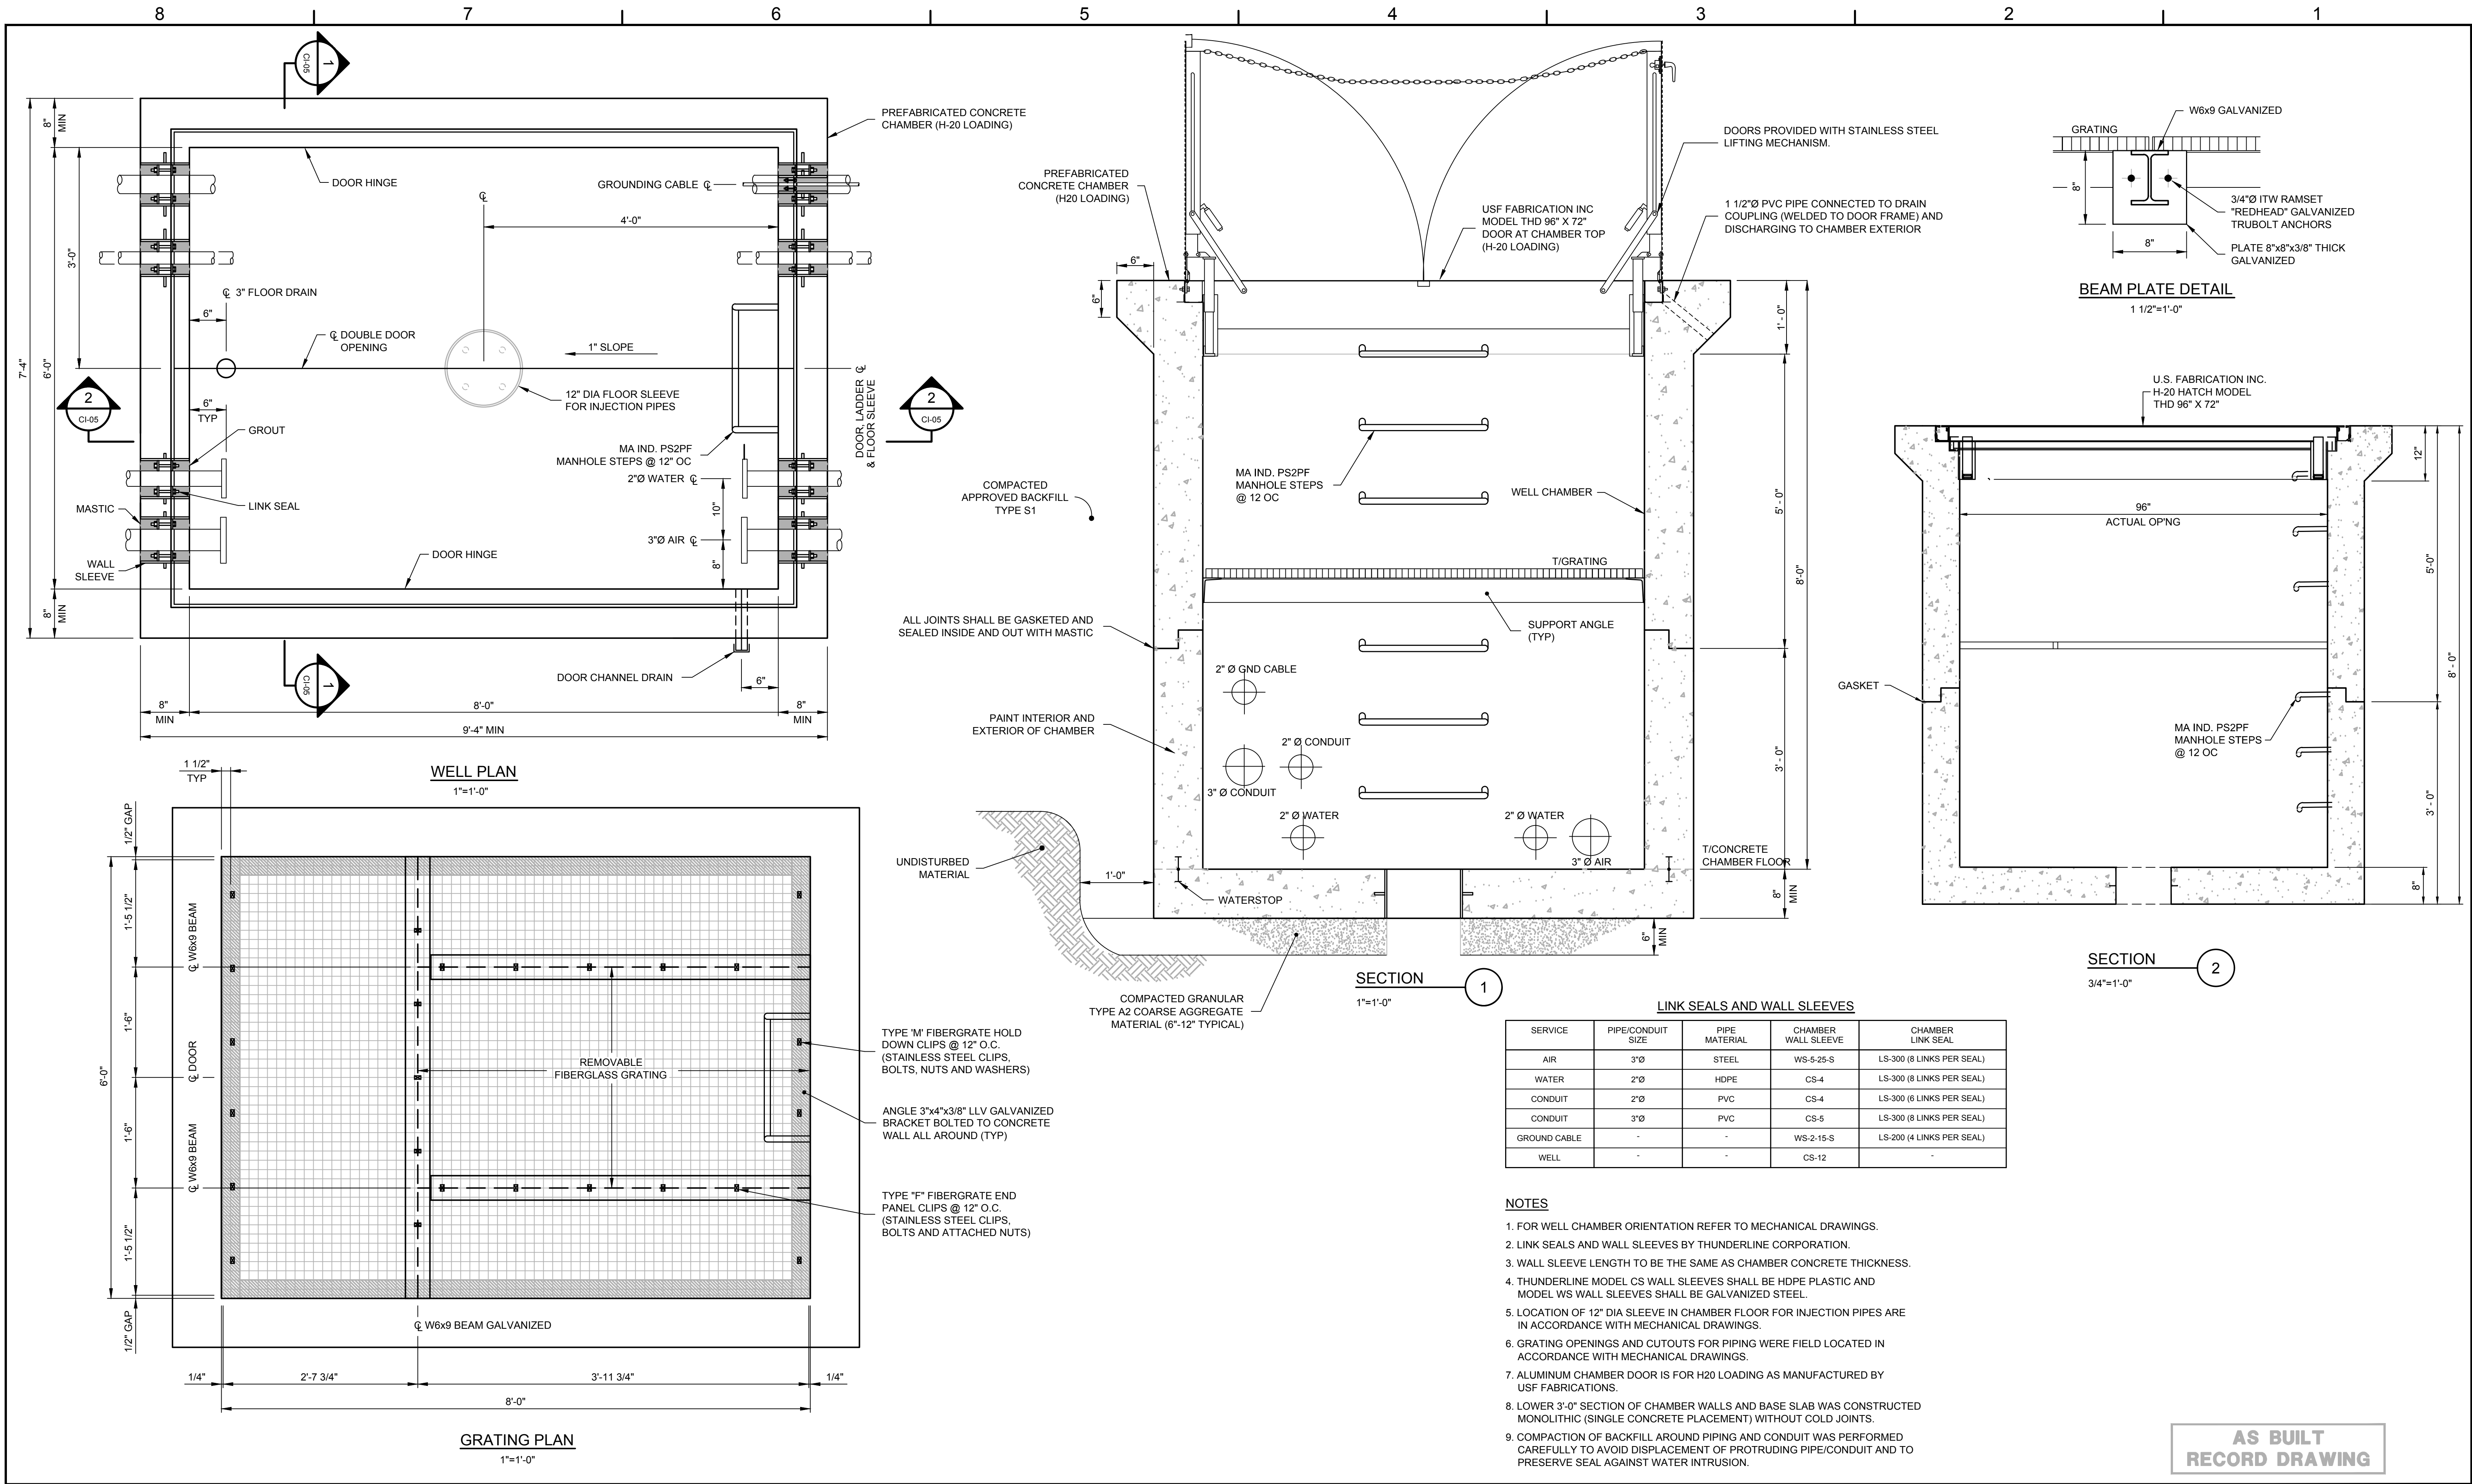

LINK SEALS AND WALL SLEEVES				
SERVICE	PIPE/CONDUIT SIZE	PIPE MATERIAL	CHAMBER WALL SLEEVE	CHAMBER LINK SEAL
AIR	3"Ø	STEEL	WS-5-25-S	LS-300 (8 LINKS PER SEAL)
WATER	2"Ø	HDPE	CS-4	LS-300 (8 LINKS PER SEAL)
CONDUIT	2"Ø	PVC	CS-4	LS-300 (6 LINKS PER SEAL)
CONDUIT	3"Ø	PVC	CS-5	LS-300 (8 LINKS PER SEAL)
GROUND CABLE	-	-	WS-2-15-S	LS-200 (4 LINKS PER SEAL)
WELL	-	-	CS-12	-

- NOTES**
- FOR WELL CHAMBER ORIENTATION REFER TO MECHANICAL DRAWINGS.
  - LINK SEALS AND WALL SLEEVES BY THUNDERLINE CORPORATION.
  - WALL SLEEVE LENGTH TO BE THE SAME AS CHAMBER CONCRETE THICKNESS.
  - THUNDERLINE MODEL CS WALL SLEEVES SHALL BE HDPE PLASTIC AND MODEL WS WALL SLEEVES SHALL BE GALVANIZED STEEL.
  - LOCATION OF 12" DIA SLEEVE IN CHAMBER FLOOR FOR INJECTION PIPES ARE IN ACCORDANCE WITH MECHANICAL DRAWINGS.
  - GRATING OPENINGS AND CUTOUTS FOR PIPING WERE FIELD LOCATED IN ACCORDANCE WITH MECHANICAL DRAWINGS.
  - ALUMINUM CHAMBER DOOR IS FOR H20 LOADING AS MANUFACTURED BY USF FABRICATIONS.
  - LOWER 3'-0" SECTION OF CHAMBER WALLS AND BASE SLAB WAS CONSTRUCTED MONOLITHIC (SINGLE CONCRETE PLACEMENT) WITHOUT COLD JOINTS.
  - COMPACTION OF BACKFILL AROUND PIPING AND CONDUIT WAS PERFORMED CAREFULLY TO AVOID DISPLACEMENT OF PROTRUDING PIPE/CONDUIT AND TO PRESERVE SEAL AGAINST WATER INTRUSION.

**AS BUILT  
RECORD DRAWING**

SCALE VERIFICATION: THIS BAR MEASURES 1" ON ORIGINAL. ADJUST SCALE ACCORDINGLY.			
1	AS BUILT	08/29/12	JA
No	Revision	Date	Initial

WARNING: ALTERING THIS DOCUMENT IS IN VIOLATION OF THE NEW YORK STATE EDUCATION LAW EXCEPTING AS PROVIDED IN SECTION 7209, PART 2 OF THE LAW.

HOOVER/ RUCO SITE  
HICKSVILLE, NEW YORK


BIOSPARGE TREATMENT SYSTEM

INJECTION WELLS  
IW - 1 THROUGH IW-7, AND CH - 8






**CRA Infrastructure  
& Engineering, Inc.**

Source Reference:			Date: SEPTEMBER 2003
Project Manager: J. KAY	Reviewed By: J. WORRALL	Designed By: J. THORNTON	Drawn By: C. ROHRICH
Scale: AS NOTED	Project No: 06883-00	Report No: 056	Drawing No: CI-05

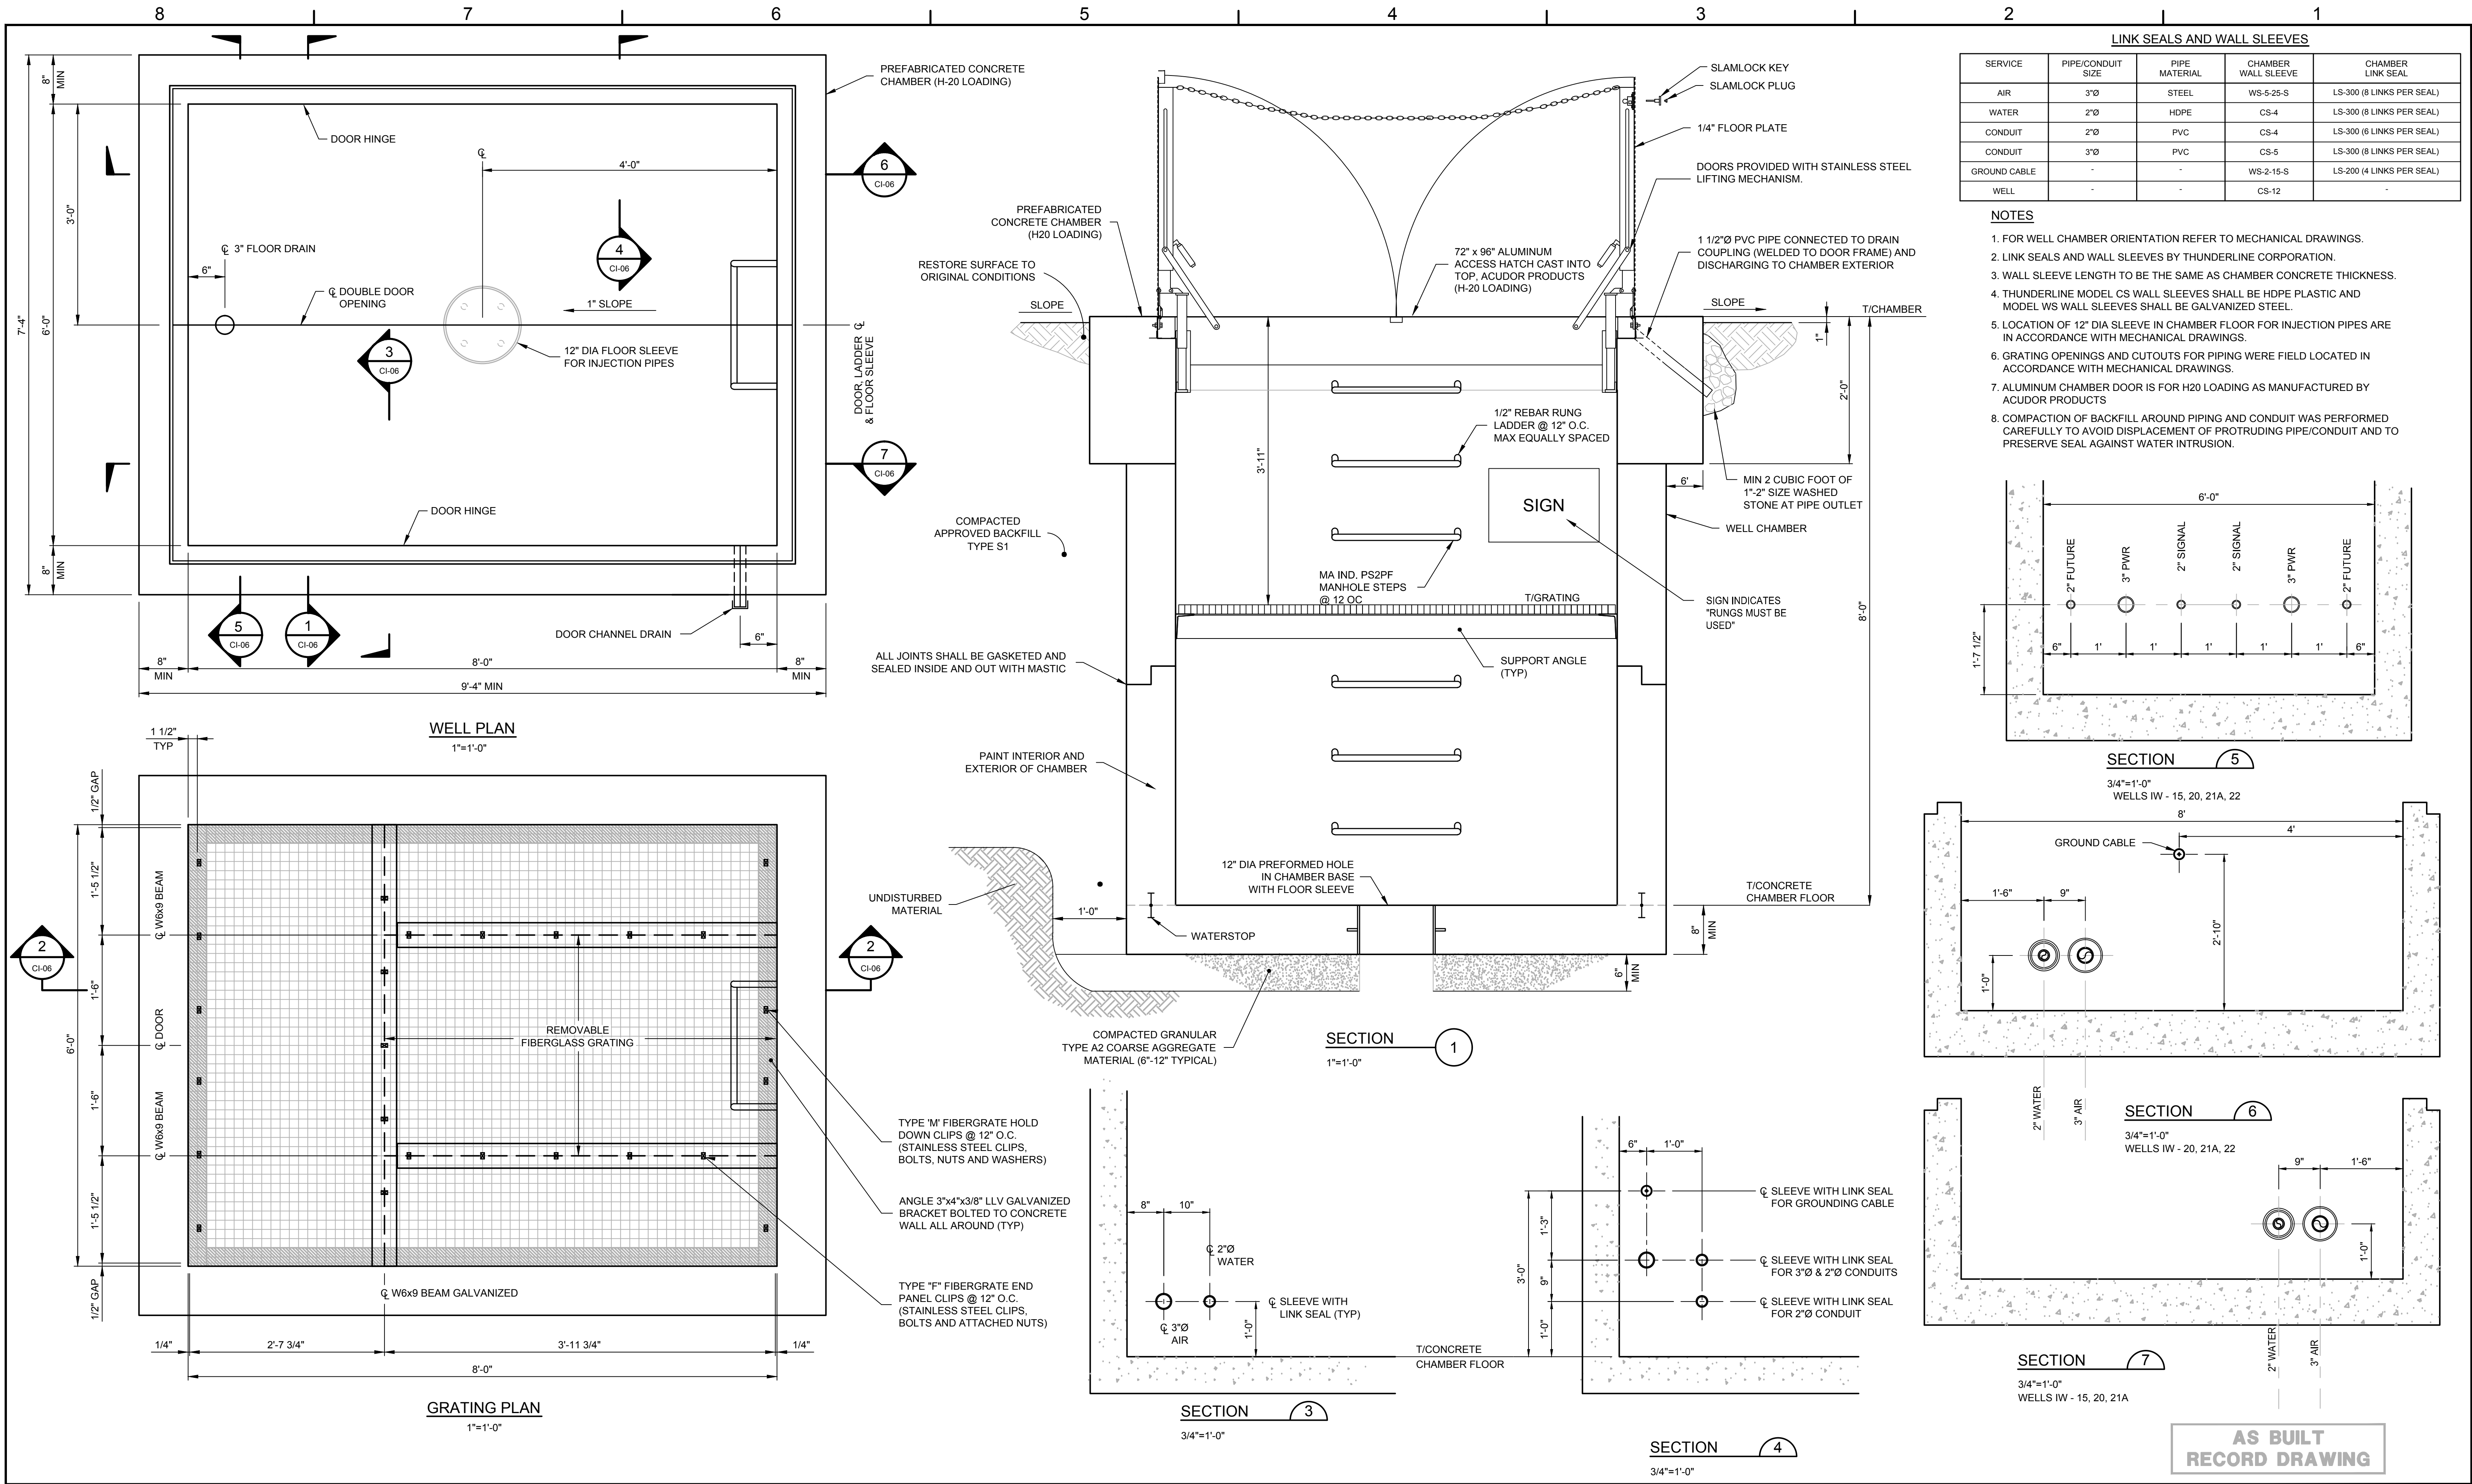

LINK SEALS AND WALL SLEEVES				
SERVICE	PIPE/CONDUIT SIZE	PIPE MATERIAL	CHAMBER WALL SLEEVE	CHAMBER LINK SEAL
AIR	3"Ø	STEEL	WS-5-25-S	LS-300 (8 LINKS PER SEAL)
WATER	2"Ø	HDPE	CS-4	LS-300 (8 LINKS PER SEAL)
CONDUIT	2"Ø	PVC	CS-4	LS-300 (6 LINKS PER SEAL)
CONDUIT	3"Ø	PVC	CS-5	LS-300 (8 LINKS PER SEAL)
GROUND CABLE	-	-	WS-2-15-S	LS-200 (4 LINKS PER SEAL)
WELL	-	-	CS-12	-

- NOTES
1. FOR WELL CHAMBER ORIENTATION REFER TO MECHANICAL DRAWINGS.
  2. LINK SEALS AND WALL SLEEVES BY THUNDERLINE CORPORATION.
  3. WALL SLEEVE LENGTH TO BE THE SAME AS CHAMBER CONCRETE THICKNESS.
  4. THUNDERLINE MODEL CS WALL SLEEVES SHALL BE HDPE PLASTIC AND MODEL WS WALL SLEEVES SHALL BE GALVANIZED STEEL.
  5. LOCATION OF 12" DIA SLEEVE IN CHAMBER FLOOR FOR INJECTION PIPES ARE IN ACCORDANCE WITH MECHANICAL DRAWINGS.
  6. GRATING OPENINGS AND CUTOUTS FOR PIPING WERE FIELD LOCATED IN ACCORDANCE WITH MECHANICAL DRAWINGS.
  7. ALUMINUM CHAMBER DOOR IS FOR H2O LOADING AS MANUFACTURED BY ACUDOR PRODUCTS
  8. COMPACTION OF BACKFILL AROUND PIPING AND CONDUIT WAS PERFORMED CAREFULLY TO AVOID DISPLACEMENT OF PROTRUDING PIPE/CONDUIT AND TO PRESERVE SEAL AGAINST WATER INTRUSION.

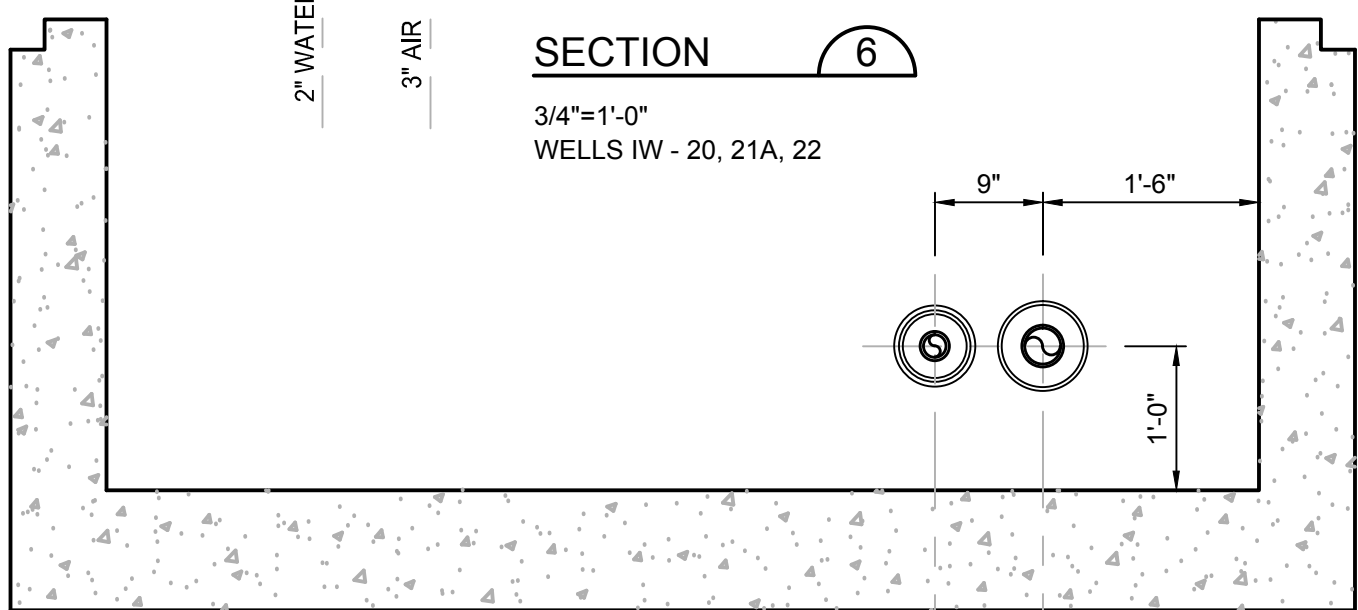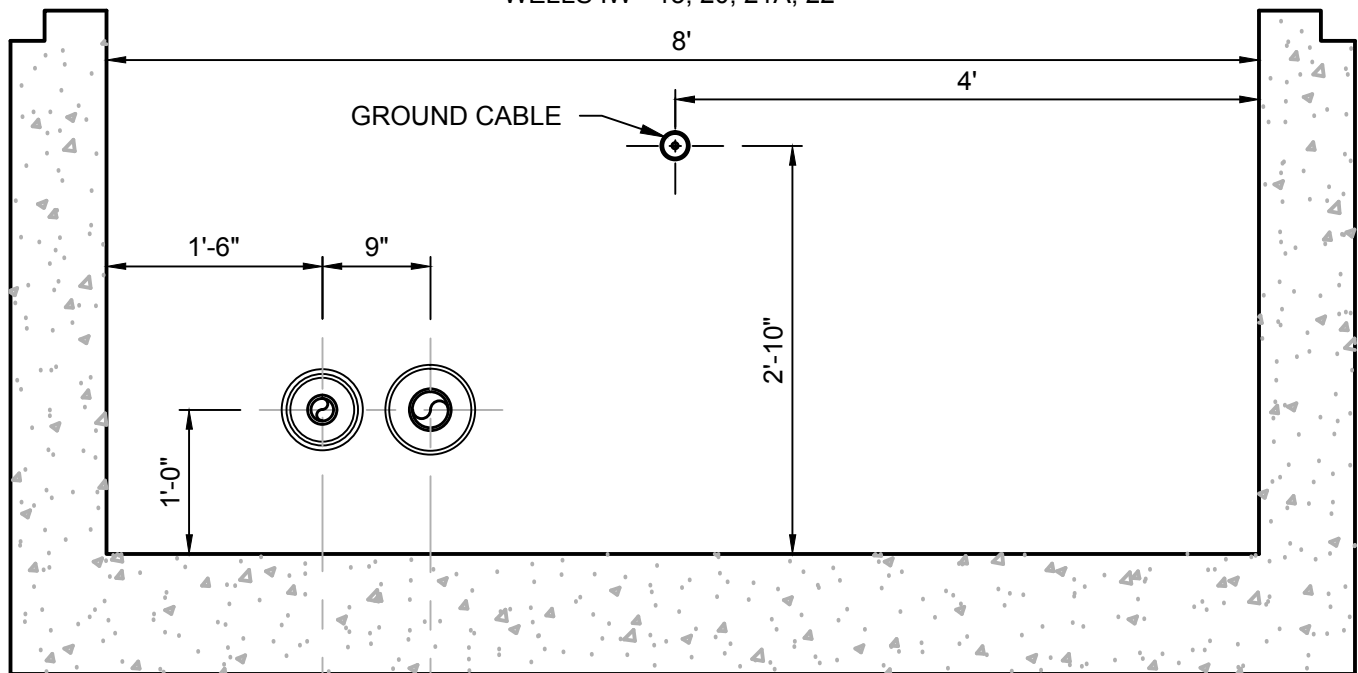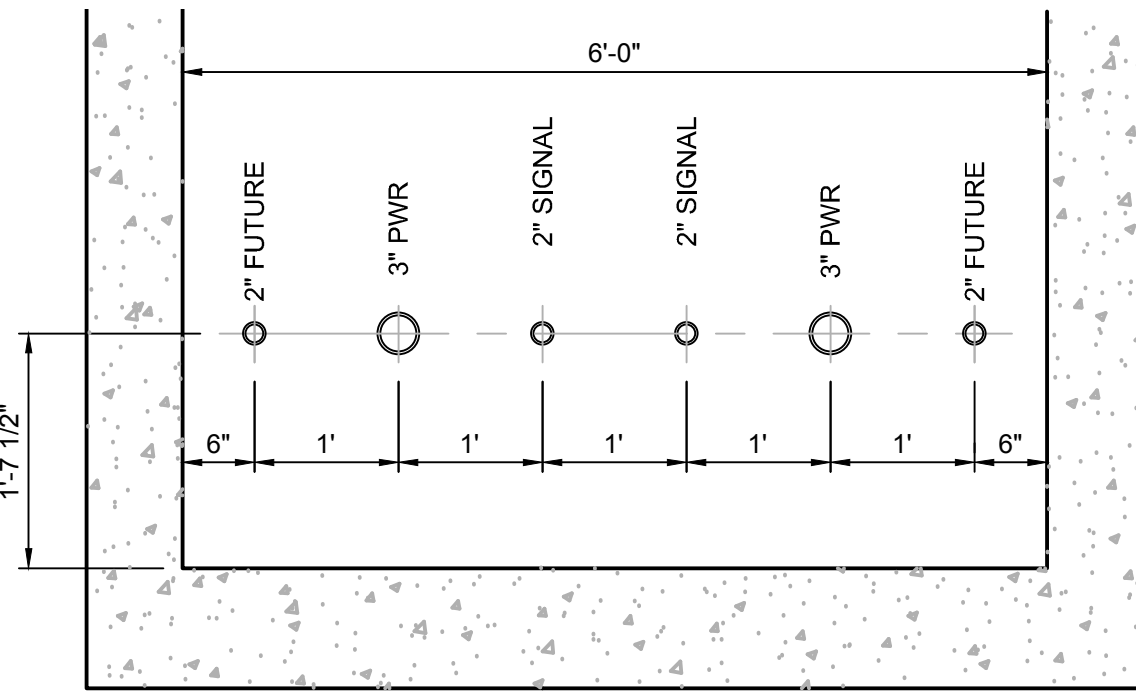

AS BUILT  
RECORD DRAWING

SCALE VERIFICATION: THIS BAR MEASURES 1" ON ORIGINAL. ADJUST SCALE ACCORDINGLY.

No	Revision	Date	Initial
1	AS BUILT	08/29/12	JA

WARNING: ALTERING THIS DOCUMENT IS IN VIOLATION OF THE NEW YORK STATE EDUCATION LAW EXCEPTING AS PROVIDED IN SECTION 7209, PART 2 OF THE LAW.

HOOVER/ RUCO SITE  
HICKSVILLE, NEW YORK

BIOSPARGE TREATMENT SYSTEM

INJECTION WELLS  
IW - 15, 20, 21, 22

**CRA Infrastructure & Engineering, Inc.**

Source Reference:			Date:
Project Manager:			SEPTEMBER 2003
J. KAY	Reviewed By:	J. THORNTON	Drawn By:
	J. WORRALL		C. ROHRICH
Scale:	Project No:	Report No:	Drawing No:
AS NOTED	06883-00	056	CI-06



GENERAL NOTES

1. THE CONTRACTOR SHALL NOT SCALE THE DRAWINGS TO ESTABLISH DIMENSIONS. ALL DIMENSIONS SHALL BE CHECKED ON-SITE PRIOR TO ASSEMBLY OR CONSTRUCTION OF ANY WORK.
2. THE STRUCTURE HAS BEEN DESIGNED FOR THE IN-SERVICE LOADS. THE METHODS, PROCEDURES AND SEQUENCES OF CONSTRUCTION TO BE USED ARE THE SOLE RESPONSIBILITY OF THE CONTRACTOR. SUPPORTING FORMWORK FOR CONCRETE CONSTRUCTION SHALL NOT BE REMOVED BEFORE THE CONCRETE HAS GAINED SUFFICIENT STRENGTH TO SAFELY SUPPORT THE DEAD AND SUPERIMPOSED LOADS. THE CONTRACTOR SHALL TAKE ALL NECESSARY PRECAUTIONS TO AVOID OVERLOADS, AND MAINTAIN AND INSURE THE INTEGRITY OF THE STRUCTURE AT ALL STAGES OF CONSTRUCTION.
3. THE CONTRACTOR SHALL REFER TO MECHANICAL & ELECTRICAL DRAWINGS AND SPECIFICATIONS FOR SIZE AND LOCATION OF SLEEVES, ANCHORS, INSERTS AND OPENINGS REQUIRED.
4. PRINCIPAL OPENINGS IN THE STRUCTURE ARE SHOWN ON THE DRAWINGS. SLEEVES AND OPENINGS NOT SHOWN ON STRUCTURAL DRAWINGS SHALL BE SUBJECT TO APPROVAL OF THE ENGINEER.
5. MATERIALS SPECIFIED ON THE DRAWINGS AND/OR IN THE SPECIFICATIONS SHALL BE USED UNLESS THE CONTRACTOR OBTAINS WRITTEN APPROVAL OF THE ENGINEER TO USE ALTERNATIVE MATERIALS. WHEN REQUESTING SUCH APPROVAL, THE CONTRACTOR SHALL PROVIDE ADEQUATE AND DETAILED MANUFACTURER'S LITERATURE AND TECHNICAL DATA FOR EACH MATERIAL PRIOR TO ITS POTENTIAL USE.

CONCRETE NOTES

1. CONCRETE CONSTRUCTION SHALL CONFORM TO ACI 301, 305, 306, 308, 315, 318 AND 350R SPECIFICATIONS.
2. LATEST REVISION AND/OR VERSION OF ALL CODES AND REFERENCE STANDARDS SHALL BE FOLLOWED.
3. CONCRETE SHALL DEVELOP A MINIMUM COMPRESSIVE STRENGTH OF 4,000 PSI AT 28 DAYS. SLUMP SHALL BE 3 1/2 INCHES ± 1 INCH.
4. CONCRETE SHALL BE AIR ENTRAINED. CEMENT SHALL BE PORTLAND CEMENT CONFORMING TO ASTM C150, TYPE II WITH AIR-ENTRAINING ADMIXTURE CONFORMING TO ASTM C260. AIR CONTENT (% BY VOLUME) SHALL NOT BE LESS THAN 4% NOR GREATER THAN 6.5% AND SHALL DEPEND ON MAXIMUM SIZE AGGREGATE USED.
5. NO ADMIXTURE SHALL CONTAIN CALCIUM CHLORIDE BASED COMPOUNDS. FLYASH AND POZZOLAN CONTENT SHALL NOT EXCEED 20% BY WEIGHT OF CEMENT.
6. REINFORCING BARS SHALL CONFORM TO ASTM A615 GRADE 60 SPECIFICATIONS.
7. LAP SPLICES IN REINFORCING BARS SHALL BE A MINIMUM 38 TIMES BAR DIAMETERS. THE SPLICES SHALL NOT BE LESS THAN 18 INCHES.
8. CONCRETE PROTECTION FOR REINFORCING BARS (UNLESS OTHERWISE NOTED):  
A. FOOTINGS - 3 INCH BOTTOM AND SIDES, 2 INCH TOP  
B. GRADE BEAMS - 2 INCH BOTTOM AND SIDES, 1 1/2 INCH TOP (TO STIRRUPS)  
C. PIERS - 1 1/2 INCH (TO TIES)  
D. FORMED SLABS - 1 1/2 INCH TOP AND BOTTOM  
E. WALLS AND PADS - 2 INCH  
F. EXTERIOR SLABS ON FILL - 2 1/2 INCH BOTTOM, 2 INCH TOP  
G. INTERIOR SLABS ON FILL - 2 1/2 INCH BOTTOM, 1 1/2 INCH TOP
9. ANCHOR BOLTS SHALL BE CARBON STEEL CONFORMING TO ASTM A307 SPECIFICATIONS, WITH HEAVY HEX NUTS AND WASHERS. BOLTS, NUTS AND WASHERS SHALL BE GALVANIZED CONFORMING TO ASTM A123 AND A153 SPECIFICATIONS, AND SHALL BE ACCURATELY PLACED USING TEMPLATES.
10. NO CONSTRUCTION JOINT SHALL BE MADE UNLESS SHOWN ON DRAWINGS OR APPROVED IN WRITING BY THE ENGINEER.
11. GROUT IN DRILLED HOLES FOR ANCHOR BOLTS AND REINFORCING STEEL DOWELS, AND UNDER BASE PLATES SHALL BE NON-SHRINK NON-METALLIC "MASTERFLOW 713" OR "MASTERFLOW 928" BY DEGUSSA BUILDING SYSTEMS. MANUFACTURER'S INSTRUCTIONS CONCERNING HOLE SIZE, SURFACE PREPARATION AND INSTALLATION SHALL BE FOLLOWED.
12. EDGE TOOL TOP HORIZONTAL EDGES OF PIERS, EQUIPMENT (PUMP) PADS. OTHER EXPOSED EDGES SHALL HAVE 3/4 INCH CHAMFER.
13. RAMPS, PADS AND SLABS SHALL BE TROWEL FINISHED TO WITHIN 1/8 INCH OF ELEVATIONS SHOWN ON DRAWINGS. FOLLOWING TROWELLING, PROVIDE NON-SLIP MEDIUM BROOM FINISH.
14. PROVIDE CORNER BARS TO MATCH HORIZONTAL BARS AT ALL EXTERIOR CORNERS.
15. WELDED WIRE FABRIC SHALL CONFORM TO ASTM A82 AND A185 SPECIFICATIONS.
16. PROVIDE MINIMUM OF 6 INCH MECHANICALLY COMPACTED CRUSHED STONE UNDER SLABS AND WHERE OTHERWISE NOTED ON DRAWINGS.
17. JOINT SEALANT SHALL BE ONE-COMPONENT POLYURETHANE "SIKAFLEX-1A" BY SIKA CHEMICAL CORPORATION.
18. WATERSTOPS SHALL BE 6 INCH FLAT RIBBED PVC WATERSTOPS R6-316 OR 4 INCH RIBBED CENTER BULB PVC WATERSTOPS RB4-316 BY VINYLEX CORPORATION. WATERSTOPS SHALL BE HEAT FUSED AT ALL JOINTS.
19. PERIMETER FOUNDATION WALL RIGID INSULATION SHALL BE STYROFOAM SQUARE EDGE BY DOW CHEMICAL COMPANY; AND LATEX MODIFIED CONCRETE FACING, TONGUE AND GROOVE FORMAT, WITH GALVANIZED CLIPS AND FASTENERS.
20. PRIOR TO CASTING CONCRETE PADS AND PIERS, BASE SLAB AND WALL SHALL BE ROUGHENED, CLEANED AND COATED WITH A CONCRETE BONDING AGENT. BONDING AGENT SHALL BE "CONCRESEVIE LIQUID (LPL)" OR "CONCRESEVIE PASTE (LPL)" BY DEGUSSA BUILDING SYSTEMS. MANUFACTURER'S INSTRUCTIONS CONCERNING SURFACE PREPARATION AND APPLICATION SHALL BE FOLLOWED.

STRUCTURAL STEEL NOTES

1. FABRICATION, ERECTION AND WORKMANSHIP SHALL CONFORM TO THE DESIGN DRAWINGS, SCOPE OF WORK AND SPECIFICATIONS, AND SHALL BE IN ACCORDANCE WITH THE AISC SPECIFICATIONS.
2. LATEST REVISION AND/OR VERSION OF ALL CODES AND REFERENCE STANDARDS SHALL BE FOLLOWED.
3. STRUCTURAL STEEL SHALL CONFORM TO ASTM A36 SPECIFICATIONS. STRUCTURAL TUBING SHALL CONFORM TO ASTM A500 GRADE B WITH YIELD STRESS OF 46 KSI.
4. ALL DIMENSIONS SHALL BE FIELD CHECKED BEFORE FABRICATION MAY BEGIN.
5. WELDING SHALL BE IN ACCORDANCE WITH THE AWS STRUCTURAL WELDING CODE. WELDED CONNECTIONS SHALL BE MADE WITH E70XX ELECTRODES. ROOT PASS AND TACK WELDS SHALL BE MADE WITH E6010 ELECTRODES. FILLET WELDS ON STANDARD FRAMED BEAM CONNECTIONS MAY BE 3/16 INCH MINIMUM. ALL OTHER FILLET WELDS SHALL BE 1/4 INCH MINIMUM.
6. GUSSET PLATES AND CLIP ANGLES SHALL BE 5/16 INCH THICK MINIMUM (UNLESS OTHERWISE NOTED). GENERALLY, ONE-SIDED CONNECTIONS FOR BEAMS SHALL NOT BE USED.
7. SHOP CONNECTIONS MAY BE EITHER WELDED OR BOLTED. FIELD CONNECTIONS SHALL BE BOLTED (UNLESS OTHERWISE NOTED). CONNECTIONS FOR NEW STEEL FRAMING TO EXISTING STEEL SHALL HAVE ONE END OF MEMBER BOLTED TO ALLOW FOR ADJUSTMENTS. WELDED CONNECTIONS, FIELD AND SHOP, SHALL BE CONTINUOUS FULL PENETRATION SEAL WELDS.
8. FASTENERS SHALL BE HIGH STRENGTH ASTM A325-N, 3/4 INCH DIAMETER GALVANIZED BOLTS WITH ASTM A194 GRADE 2H OR A563 GRADE DH NUTS TAPPED OVERSIZE AFTER GALVANIZING AND THREADS LUBRICATED. HARDENED WASHERS SHALL BE PROVIDED UNDER ROTATING PART OF NUT AND BOLT ASSEMBLY. CONNECTIONS NOTED WITH A325-SC BOLTS SHALL BE SLIP CRITICAL PER AISC SPECIFICATIONS.
9. BOLT HOLES SHALL NOT BE LARGER THAN 1/16 INCH PLUS DIAMETER OF THE BOLT. A MINIMUM OF TWO BOLTS PER CONNECTION SHALL BE REQUIRED.
10. WHERE BRACING FORCES ARE NOT GIVEN, DESIGN CONNECTIONS AT EACH END FOR 50% OF MEMBER CAPACITY IN TENSION.
11. ALL STRUCTURAL STEEL FRAMES INCLUDING GIRTS, PURLINS, MISCELLANEOUS STEEL; DOOR/ WINDOW/OPENING FRAMES, DOORS, COMBINATION LOUVER/DAMPER AND SHUTTERS SHALL BE PAINTED.
12. PAINT SHALL CONSIST OF ONE COAT PRIMER (6 MILS DFT) EPOXY BAR-RUST 235 AND ONE COAT FINISH (2 MILS DFT) ALIPHATIC URETHANE DEVTHANE 379 BY ICI DULUX-DEVOE COATINGS.

FOUNDATION NOTES

1. FOUNDATION DESIGN IS BASED UPON A NET ALLOWABLE SOIL BEARING CAPACITY OF 3,000 POUNDS PER SQUARE FOOT FOR FOOTINGS BEARING ON APPROVED NATIVE SUBGRADE SOILS OR COMPACT STRUCTURAL GRANULAR FILL.
2. CONTRACTOR SHALL FIELD VERIFY THE FOUNDATION BEARING GRADE MATERIAL AND BEARING CAPACITY DURING CONSTRUCTION. FOUNDATIONS SHALL BE PLACED ON APPROVED BEARING GRADE.
3. NO FOOTING SHALL BEAR ON EXISTING FILL, SOFT/LOOSE, ORGANIC OR OTHER UNSUITABLE SOILS. IF ENCOUNTERED, THE EXISTING FILL AND UNSUITABLE SOILS AT THE FOOTING BEARING GRADE LEVEL SHALL BE REMOVED DOWN TO COMPETENT NATIVE SUBGRADE AND EXCAVATION BACKFILLED WITH COMPACTED STRUCTURAL GRANULAR FILL IN ACCORDANCE WITH THE SPECIFICATION.
4. EXISTING UNDERGROUND PIPING, REINFORCED CONCRETE STRUCTURES, UTILITIES, ELECTRICAL CABLES AND GROUNDING SYSTEMS NOT IDENTIFIED ON THE DRAWINGS MAY EXIST. WHEN UNCOVERED, THE CONTRACTOR MUST REPORT FINDINGS TO THE ENGINEER FOR IDENTIFICATION AND RECOMMENDED ACTION.
5. BACKFILL AROUND PIPES AND CABLES AS PER SPECIFICATIONS. NO PIPES OR CONDUITS SHALL BE PLACED IN FOOTINGS.
6. WHERE PIPES OR CONDUITS RUN PERPENDICULAR TO A FOOTING, STEP THE TOP OF THE FOOTING DOWN TO ALLOW PIPES OR CONDUITS TO RUN OVER TOP OF THE FOOTING. WHERE PIPES OR CONDUITS RUN PARALLEL TO A FOOTING, STEP BOTTOM OF FOOTING DOWN SO THAT A LINE DRAWN BETWEEN THE INVERT OF PIPE OR CONDUIT AND BOTTOM OF FOOTING SHALL NOT EXCEED 30 DEGREES ABOVE THE HORIZONTAL. NO PIPING OR CONDUIT SHALL BE ALLOWED TO PASS WITHIN A 30-DEGREE PLANE OF INFLUENCE BELOW AND AWAY FROM FOOTINGS.
7. MAXIMUM WALL FOOTING STEP SHALL BE 1'-0" VERTICAL SPACED NOT LESS THAN 2'-0" ON CENTER.
8. BUILDING FOUNDATIONS OVER EXISTING UTILITY LINES SHALL BEAR ONLY ON COMPACTED STRUCTURAL FILL PLACED AFTER REMOVAL OF ALL UNCONTROLLED FILL AND UNSUITABLE SOILS.

ARCHITECTURAL NOTES

1. BUILDING SHALL CONSIST OF PRE-ENGINEERED METAL, CLEAR SINGLE SPAN RIGID FRAME WITH STRAIGHT COLUMNS (NON-TAPERED) AND GABLED ROOF BEAMS.
2. ROOF SHALL HAVE A 2:12 PITCH.
3. ROOF PANELS SHALL BE 24 GAUGE STANDING SEAM STEEL.
4. EXTERIOR WALL PANELS SHALL BE 26 GAUGE.
5. INTERIOR WALL LINER PANELS SHALL BE 28 GAUGE (STANDARD HEIGHT 8'-3").
6. BOTTOM OF STEEL BASE PLATE TO BE AT EL. 100'-7".
7. BUILDING SHALL HAVE A 6" HIGH CURB AND 1" GROUT UNDER STEEL BASE PLATES.
8. CUTOUTS AND HOLES IN WALL AND ROOF PANELS SHALL BE COMPLETELY SEALED BY MECHANICAL/ELECTRICAL CONTRACTORS WITH FIRE STOP AND WEATHER PROOF MATERIALS AFTER PIPE/DUCT/CABLE INSTALLATIONS.
9. PAINT FOR CONTROL ROOM GYPSUM BOARD WALL SHALL CONSIST OF ONE COAT PRIMER (1 MIL DFT) ULTRA-HIDE PVA (1030) AND ONE COAT FINISH (2 MILS DFT) ULTRA-HIDE LATEX ENAMEL (1416) BY ICI PAINT STORES.
10. FIRE EXTINGUISHERS:  
CONTROL ROOM - (2 NOS) CLASS C TYPE,  
OTHER AREAS - (1 NO) CLASS ABC TYPE.
11. BASED ON USE, BUILDING IS NOT INTENDED TO BE "ACCESSIBLE" PER CODE.

PRECAST CONCRETE NOTES

1. CONCRETE SHALL DEVELOP A MINIMUM COMPRESSIVE STRENGHT OF 5,000 PSI AT 28 DAYS.
2. AIR ENTRAINED CONCRETE:  
A. CONCRETE SHALL BE AIR ENTRAINED  
B. CEMENT SHALL BE PORTLAND CEMENT CONFORMING TO ASTM C150, TYPE II WITH AIR ENTRAINING ADMIXTURE CONFORMING TO ASTM C260. AIR CONTENT (% BY VOLUME) SHALL NOT BE LESS THAN 5% NOR GREATER THAN 7%.
3. REINFORCING BARS SHALL CONFORM TO ASTM A615 GRADE 60 SPECIFICATIONS.
4. LAP SPLICES IN REINFORCING SHALL BE IN ACCORDANCE WITH ACI 318 SPECIFICATIONS. LAP SPLICES SHALL NOT BE LESS THAN 18 INCHES.
5. CONCRETE PROTECTION FOR REINFORCING BARS SHALL BE INDUSTRY OR DOT STANDARDS, UNLESS NOTED OTHERWISE.
6. DESIGN LOADING TO MEET AASHTO HS-20-44 WITH 30% IMPACT. FOR HYDROSTATIC PRESSURE AND UPLIFT FORCES, WATER TABLE SHALL BE CONSIDERED AT THE GROUND SURFACE.
7. LIFTING HOLES IN PRECAST UNITS TO BE FILLED WITH CONCRETE REPAIR MATERIAL IN ACCORDANCE WITH NYSDOT 701-04 SPECIFICATION.

PERMIT NOTE

CONTRACTOR SHALL OBTAIN ALL NECESSARY PERMITS FROM CITY AND STATE AGENCIES FOR UTILITIES AND ROAD PAVEMENT INCLUDING RIGH-OF-WAY WORK.

AS BUILT  
RECORD DRAWING

SCALE VERIFICATION: THIS BAR MEASURES 1" ON ORIGINAL. ADJUST SCALE ACCORDINGLY.



1	AS BUILT	08/29/12	ZM
No	Revision	Date	Initial

Approved

WARNING: ALTERING THIS DOCUMENT IS IN VIOLATION OF THE NEW YORK STATE EDUCATION LAW EXCEPTING AS PROVIDED IN SECTION 7209, PART 2 OF THE LAW.

HOOKER/RUCO SITE  
HICKSVILLE, NEW YORK



BIOSPARGE TREATMENT SYSTEM

CONTROL BUILDING  
GENERAL NOTES



CRA Infrastructure  
& Engineering, Inc.

Source Reference:			Date: AUGUST 2012
Project Manager: JK	Reviewed By: JGRW	Designed By: SKM	Drawn By: ZM
Scale: NONE	Project No: 06883-00	Report No: 056	Drawing No: ST-01

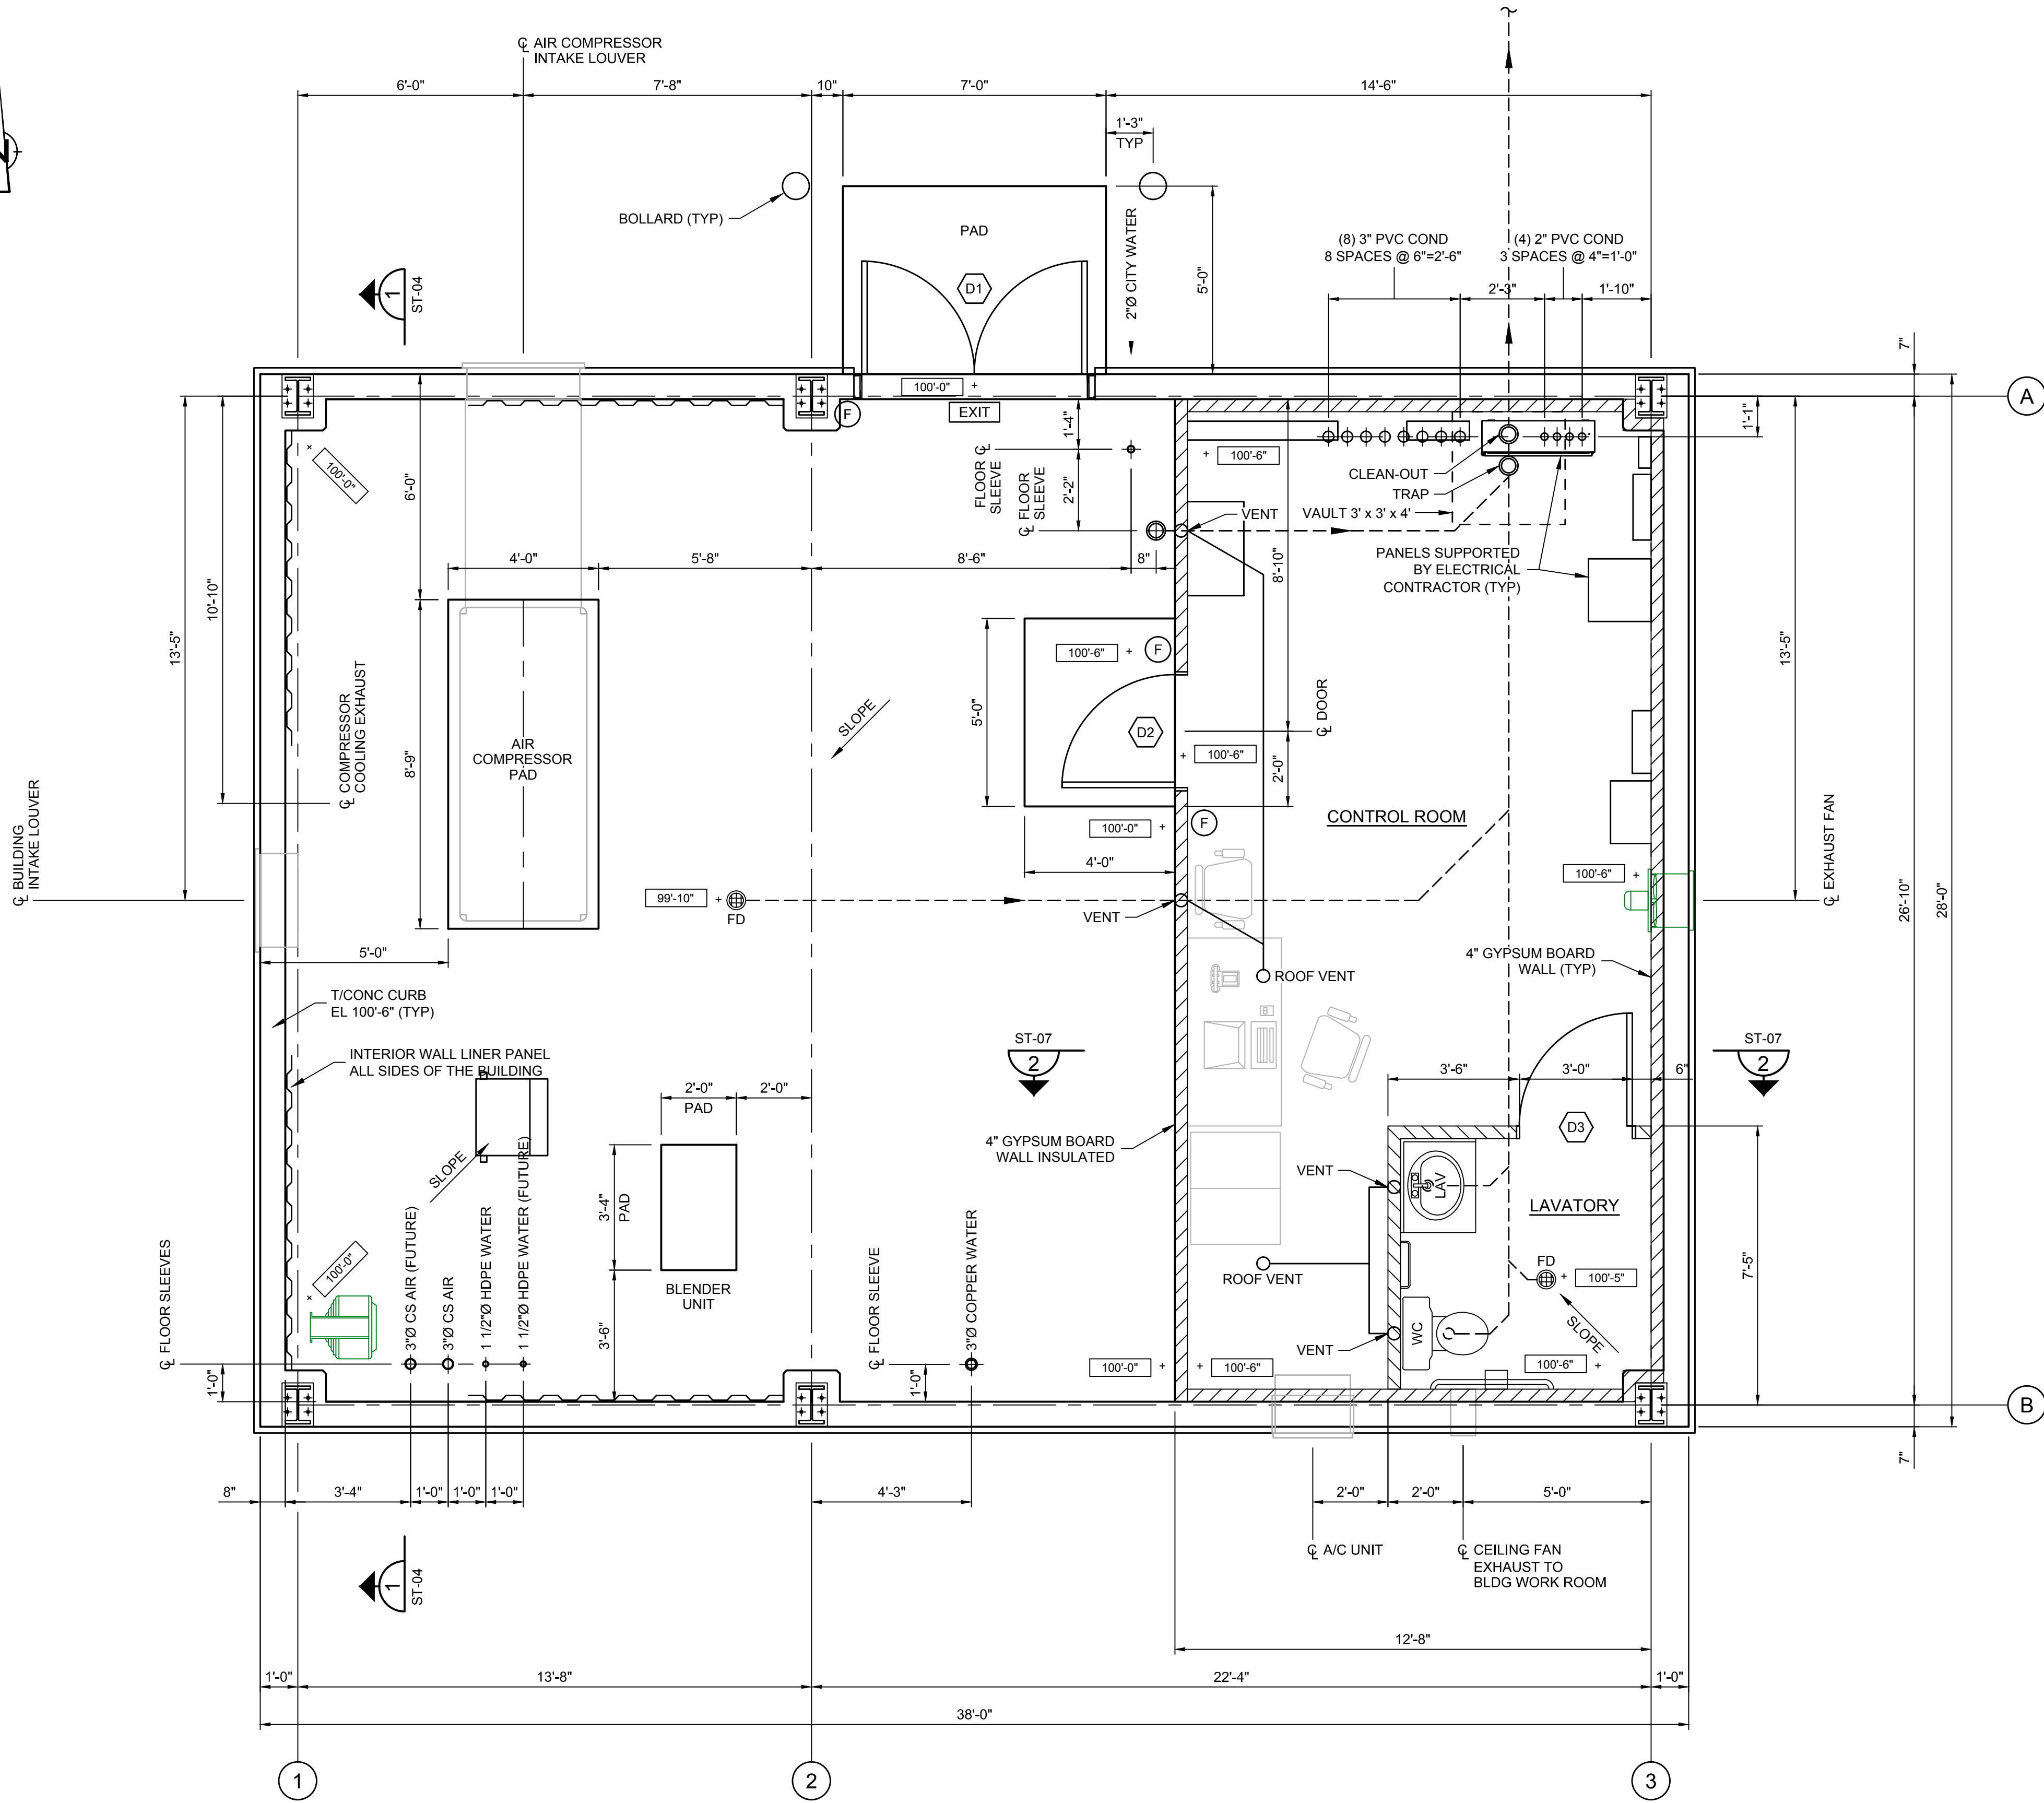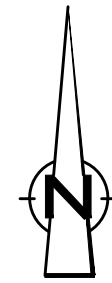

FLOOR PLAN  
3/8" = 1'-0"

BUILDING CODE DATA

CODE:	BUILDING CODE OF NEW YORK STATE
LOCATION:	TOWN OF OYSTER BAY, NASSAU COUNTY, NEW YORK
BUILDING DIMENSIONS:	28'-0" x 38'-0" ONE STORY
BUILDING HEIGHT:	14'-6" NOMINAL EAVE - ABOVE FLOOR
BUILDING AREA:	1,064 SQUARE FEET (TABLE 503)
OCCUPANCY CLASS:	USE GROUP F-2 FACTORY INDUSTRIAL (SECTION 306.3)
CONSTRUCTION:	NON-COMBUSTIBLE TYPE 2B (SECTION 602.2, TABLE 601)
OCCUPANT LOAD:	ACTUAL - NONE; TABLE - 10 PERSONS (SECTION 1003.2.2.2)
BUILDING TYPE:	PRE-ENGINEERED METAL, STRUCTURAL STEEL RIGID FRAMED
BUILDING INSULATION:	WALLS - R19, ROOF - R30
FIRE SEPARATION DISTANCE:	GREATER THAN 30 FEET
FIRE RESISTANCE RATING:	EXTERIOR WALL - 0 HR (TABLES 601 & 602)
FIRE SEPARATION ASSEMBLIES:	NOT REQUIRED (TABLE 302.3.3)

STRUCTURAL LOADS (NON-FACTORED)

1. DEAD LOAD	STRUCTURAL, NONSTRUCTURAL, EQUIPMENT, PIPE, CABLE
2. FLOOR LIVE LOAD	125 POUNDS PER SQUARE FOOT 2,000 POUNDS (ON 2 1/2 FT x 2 1/2 FT SQUARE AREA)
3. ROOF LIVE LOAD	0 - 200 SQUARE FEET TRIBUTARY AREA 201 - 600 SQUARE FEET TRIBUTARY AREA OVER 600 SQUARE FEET TRIBUTARY AREA CONCENTRATED LOAD
4. ROOF SNOW LOAD	20 POUNDS PER SQUARE FOOT 16 POUNDS PER SQUARE FOOT 12 POUNDS PER SQUARE FOOT 200 POUNDS (ON AREA OF ONE SQUARE INCH)
5. WIND LOAD	45 POUNDS PER SQUARE FOOT (FIGURE 1608.2) 0.9 (TABLE 1608.3.1) 1.0 (SECTION 1604.5)
6. EARTHQUAKE LOAD	120 MILES PER HOUR (FIGURE 1609) C (SECTION 1609.4) 1.0 (SECTION 1604.5)
7. SPECIAL LOADS	GROUP I (SECTION 1616.2) 1.0 (SECTION 1604.5) D (SECTION 1615.1.1)
8. DEFLECTION LIMITATION	10 POUNDS PER SQUARE FOOT REFER DRAWINGS NONE 250 POUNDS EACH 500 POUNDS
9. FOUNDATION	NOT TO EXCEED 1/240 OF SPAN OF STRUCTURAL MEMBER
	3,000 POUNDS PER SQUARE FOOT 200 KIPS PER CUBIC FOOT

LEGEND

+ 100'-0"	ELEVATION FEET AMSL
EXIT	EXIT SIGN INSTALLED ABOVE DOOR
F	FIRE EXTINGUISHER
D1	DOOR
→	DIRECTION OF FLOOR SLOPE
UNIT HEATER	UNIT HEATER
WALL INTERIOR PANEL	WALL INTERIOR PANEL
GYPSUM BOARD WALL (FIRE-RATED)	GYPSUM BOARD WALL (FIRE-RATED)
FD	FLOOR DRAIN

AS BUILT  
RECORD DRAWING

NOTES

- ELECTRICAL CONTRACTOR SHALL INSTALL CONDUITS IN CONTROL ROOM FLOOR SLAB AREA PRIOR TO SLAB CONSTRUCTION.
- CONTRACTOR SHALL INSTALL FLOOR SLEEVES FOR PIPING PRIOR TO SLAB CONSTRUCTION.
- REFER MECHANICAL DRAWINGS FOR PLUMBING.
- FLOOR DRAIN SHALL BE FD-2330-PV3 HEAVY DUTY WITH SEDIMENT BASKET BY ZURN (TEL. (716) 665-1131, WWW.ZURN.COM).

SCALE VERIFICATION: THIS BAR MEASURES 1" ON ORIGINAL. ADJUST SCALE ACCORDINGLY.

1	AS BUILT	08/29/12	ZM
No	Revision	Date	Initial

Approved

WARNING: ALTERING THIS DOCUMENT IS IN VIOLATION OF THE NEW YORK STATE EDUCATION LAW EXCEPTING AS PROVIDED IN SECTION 7209, PART 2 OF THE LAW.

HOOKE/RUCO SITE  
HICKSVILLE, NEW YORK

BIOSPARGE TREATMENT SYSTEM





CONTROL BUILDING  
FLOOR PLAN



CRA Infrastructure  
& Engineering, Inc.

Source Reference:	Date:
Project Manager: JK	Reviewed By: JGRW
Designed By: SKM	Drawn By: ZM
Scale: 3/8"=1'-0"	Project No: 06883-00
Report No: 056	Drawing No: ST-02



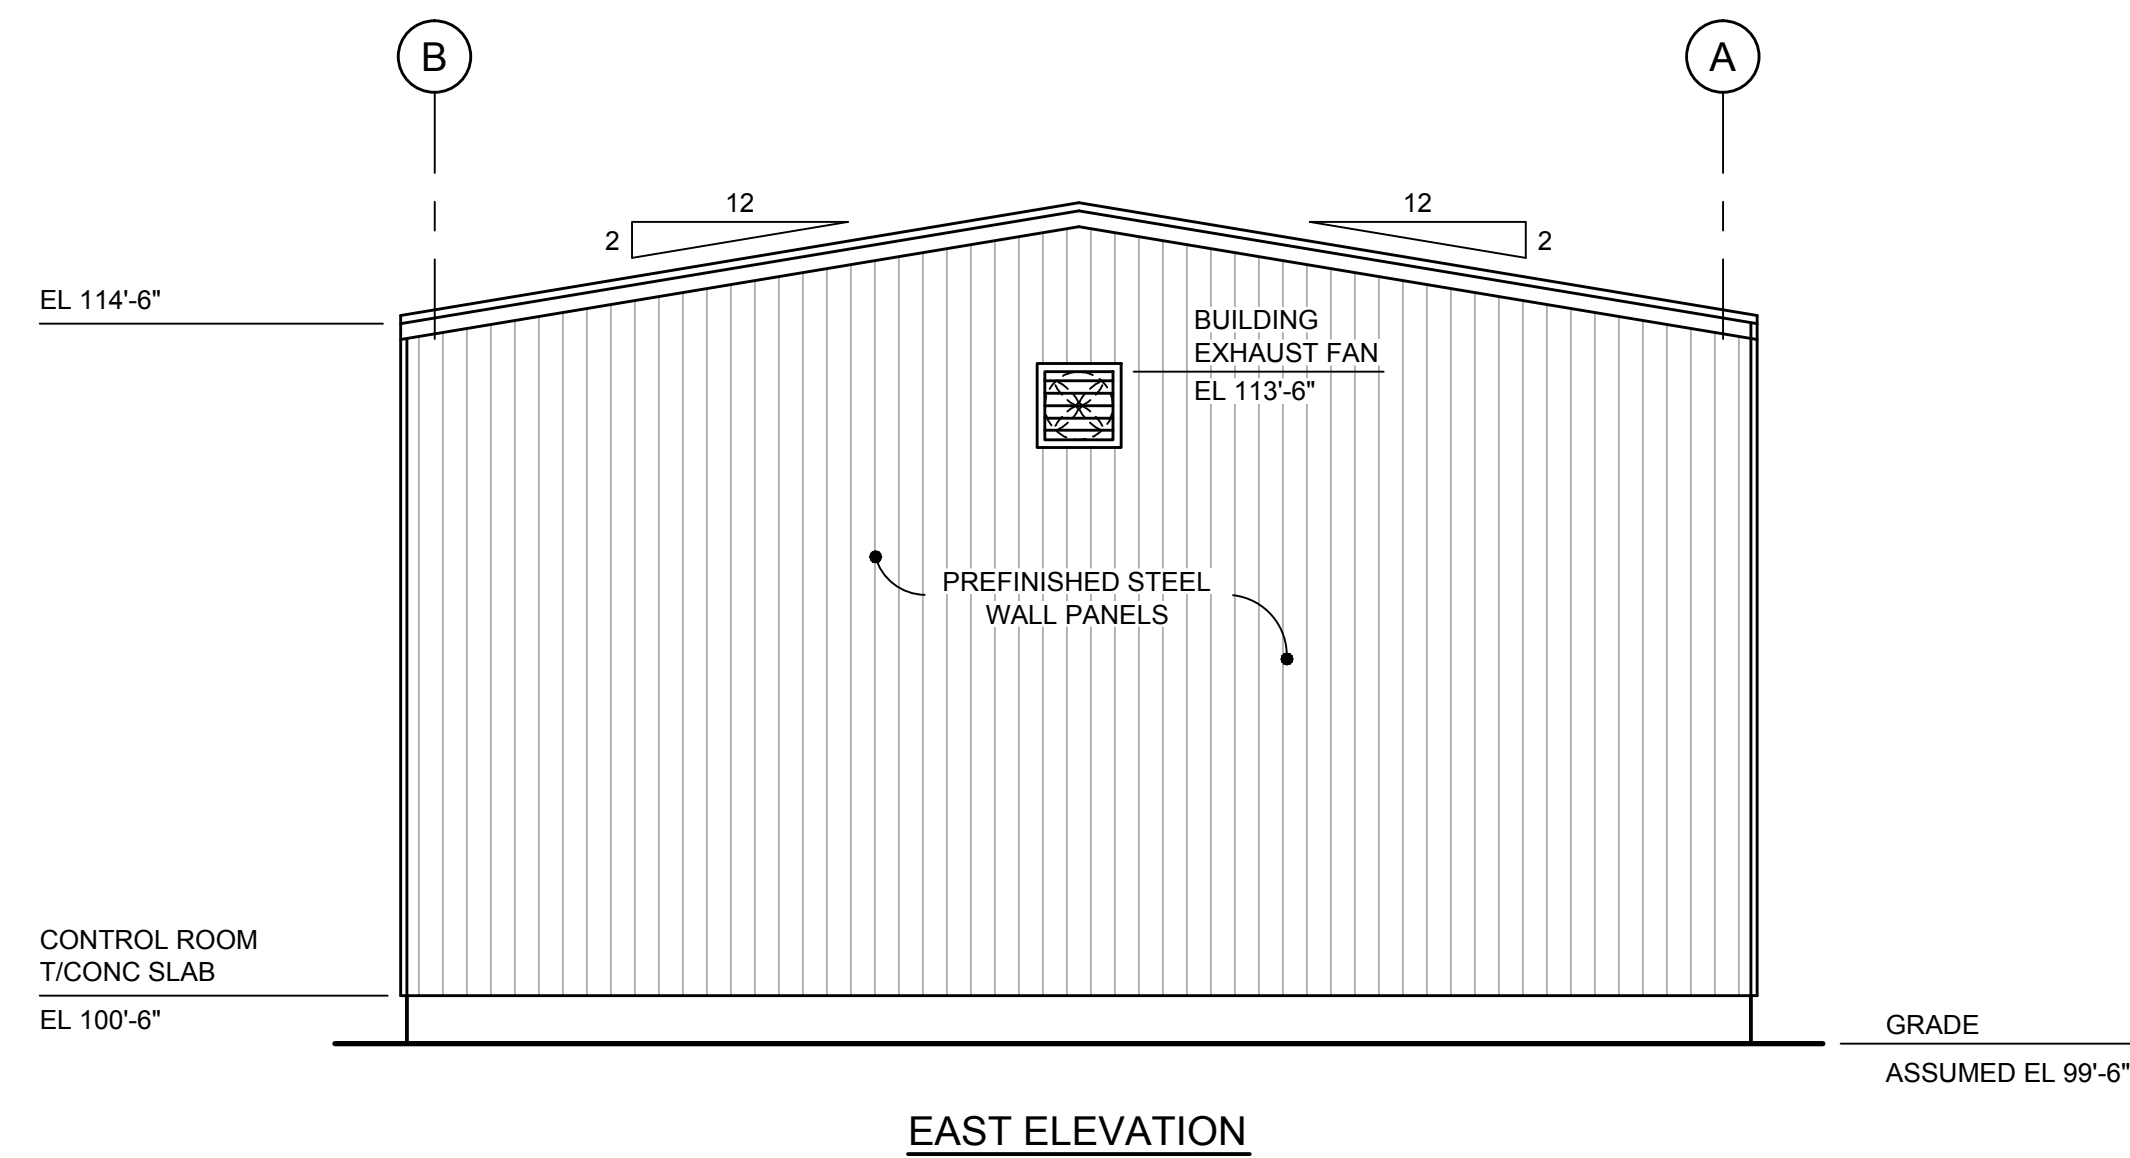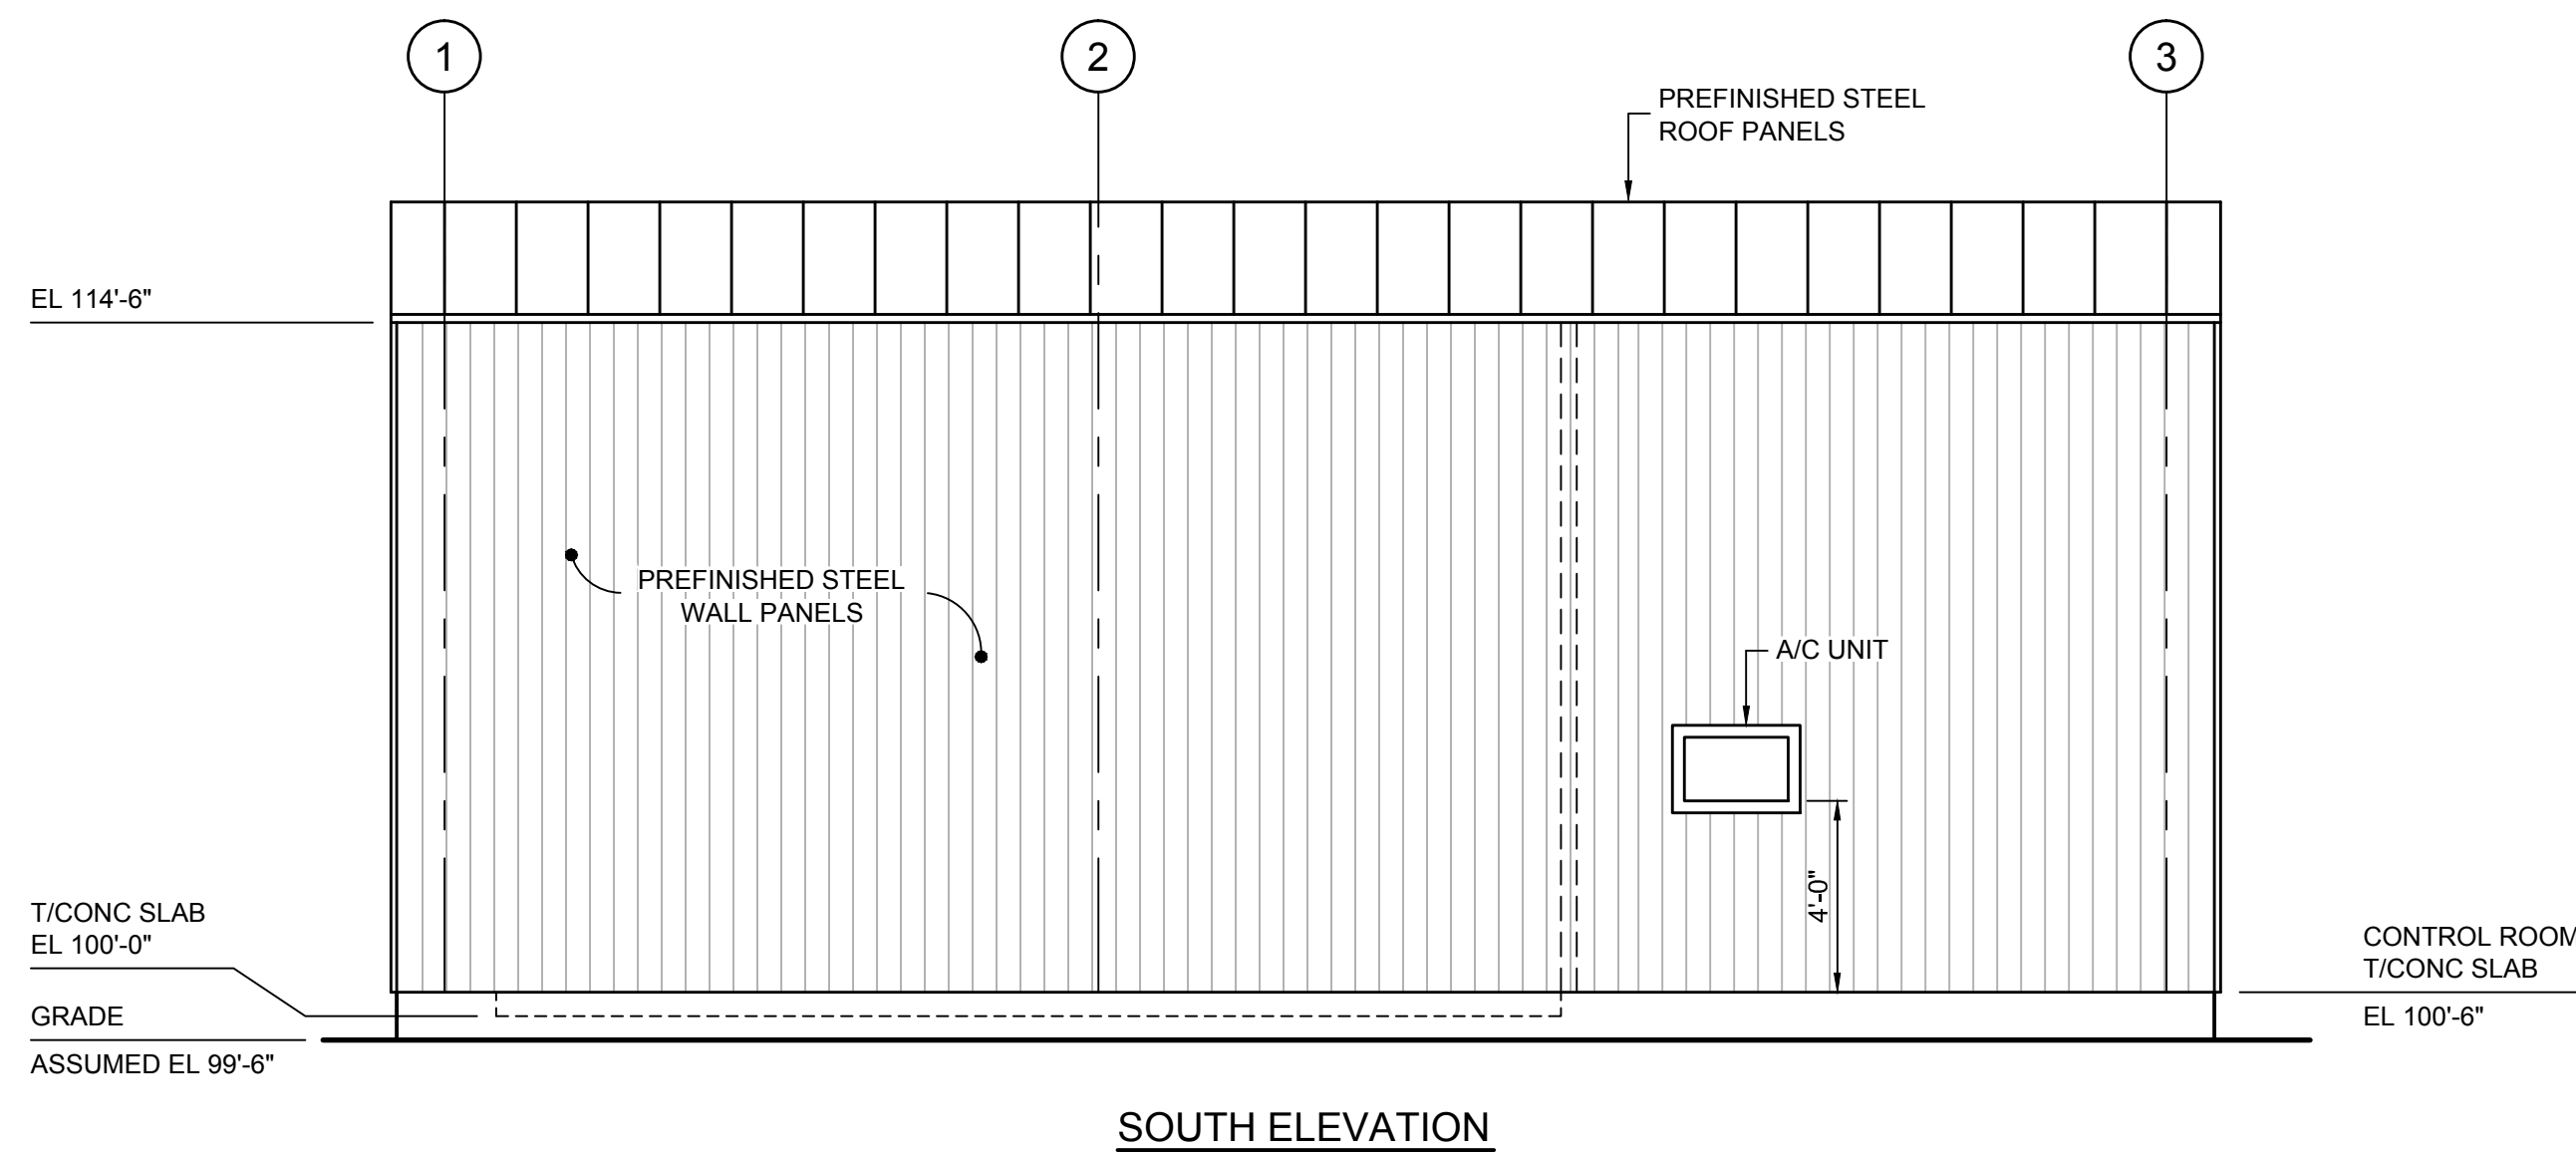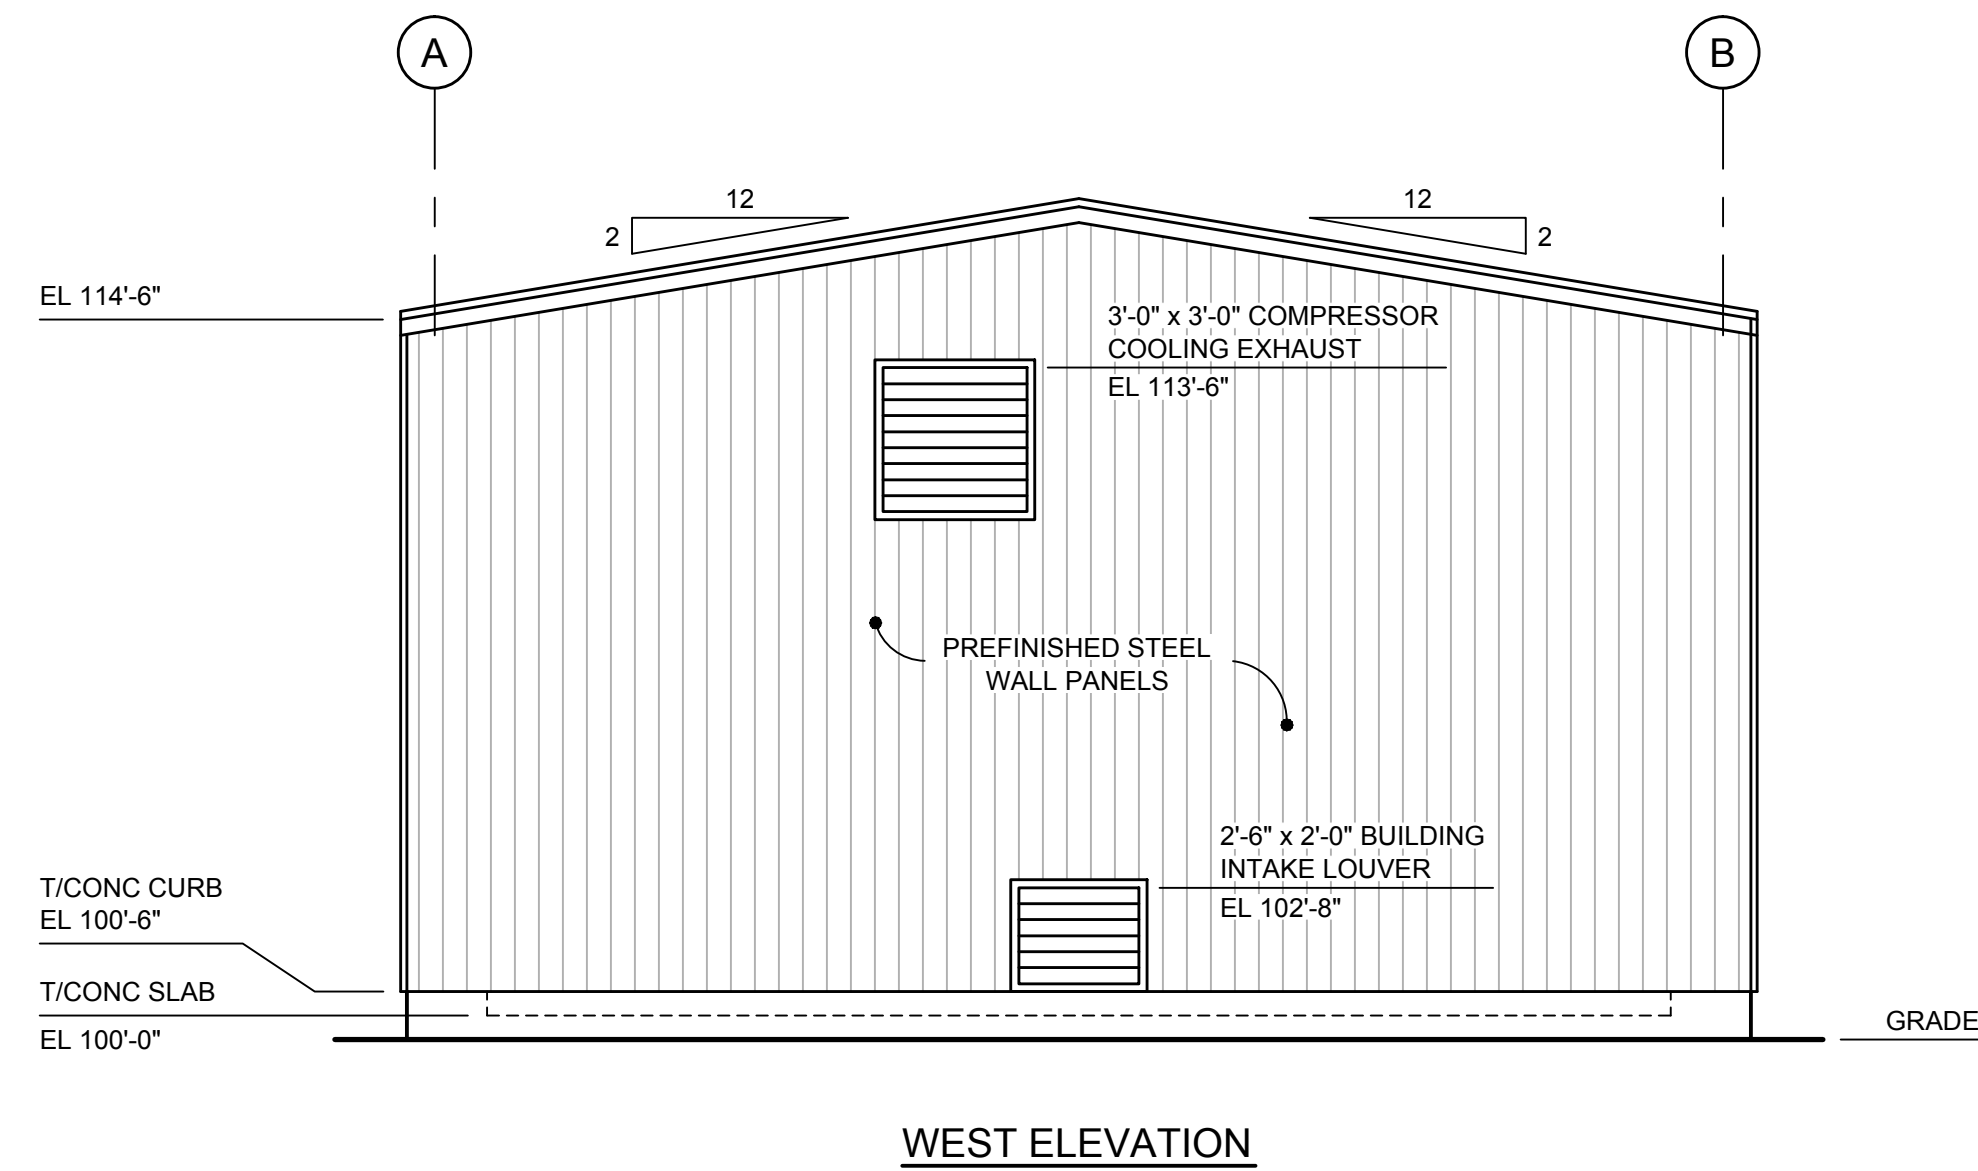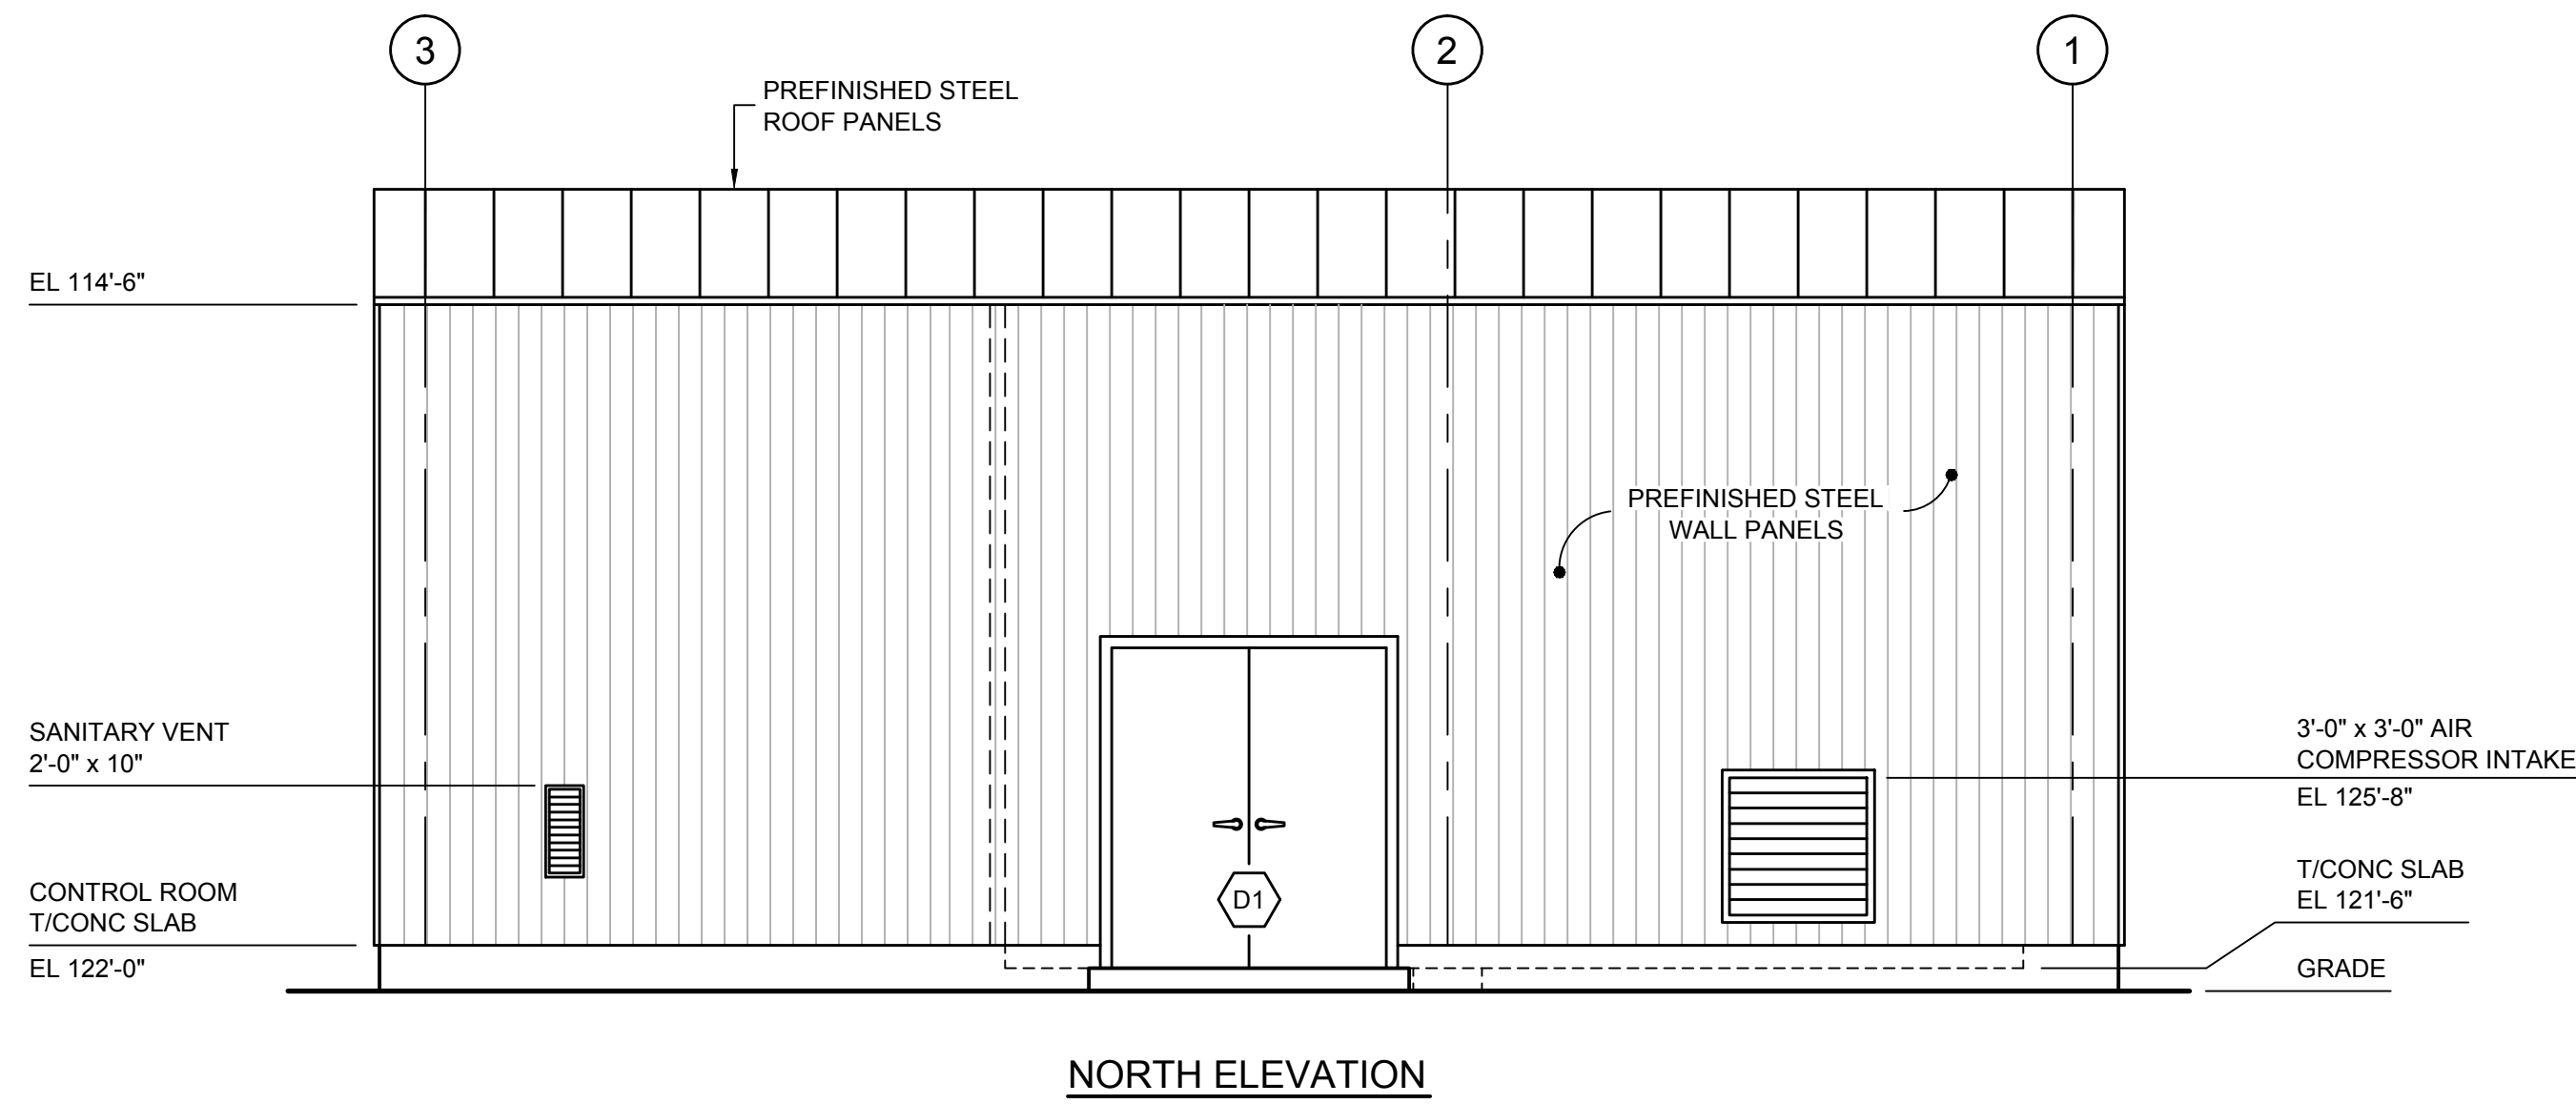

CONTRACTOR SHALL PROVIDE BUILDING EXTERIOR ELEVATION OF 114'-6" AND INTERIOR CLEARANCE AT PRIMARY RIGID FRAME OF MINIMUM 12'-8" ABOVE FLOOR SLAB EL 100'-0", WHICHEVER RESULTS IN GREATER BUILDING HEIGHT

AS BUILT  
RECORD DRAWING

SCALE VERIFICATION: THIS BAR MEASURES 1" ON ORIGINAL. ADJUST SCALE ACCORDINGLY.			
1	AS BUILT	08/29/12	ZM
No	Revision	Date	Initial

Approved

WARNING: ALTERING THIS DOCUMENT IS IN VIOLATION OF THE NEW YORK STATE EDUCATION LAW EXCEPTING AS PROVIDED IN SECTION 7209, PART 2 OF THE LAW.

HOOKER/RUCO SITE  
HICKSVILLE, NEW YORK


BIOSPARGE TREATMENT SYSTEM

CONTROL BUILDING  
ELEVATIONS








**CRA Infrastructure  
& Engineering, Inc.**

Source Reference:		Date:	
Project Manager:		Reviewed By:	
JK		JGRW	
Designed By:		Drawn By:	
SKM		ZM	
Scale:		Project No:	
1/4"=1'-0"		06883-00	
Report No:		Drawing No:	
056		ST-03	

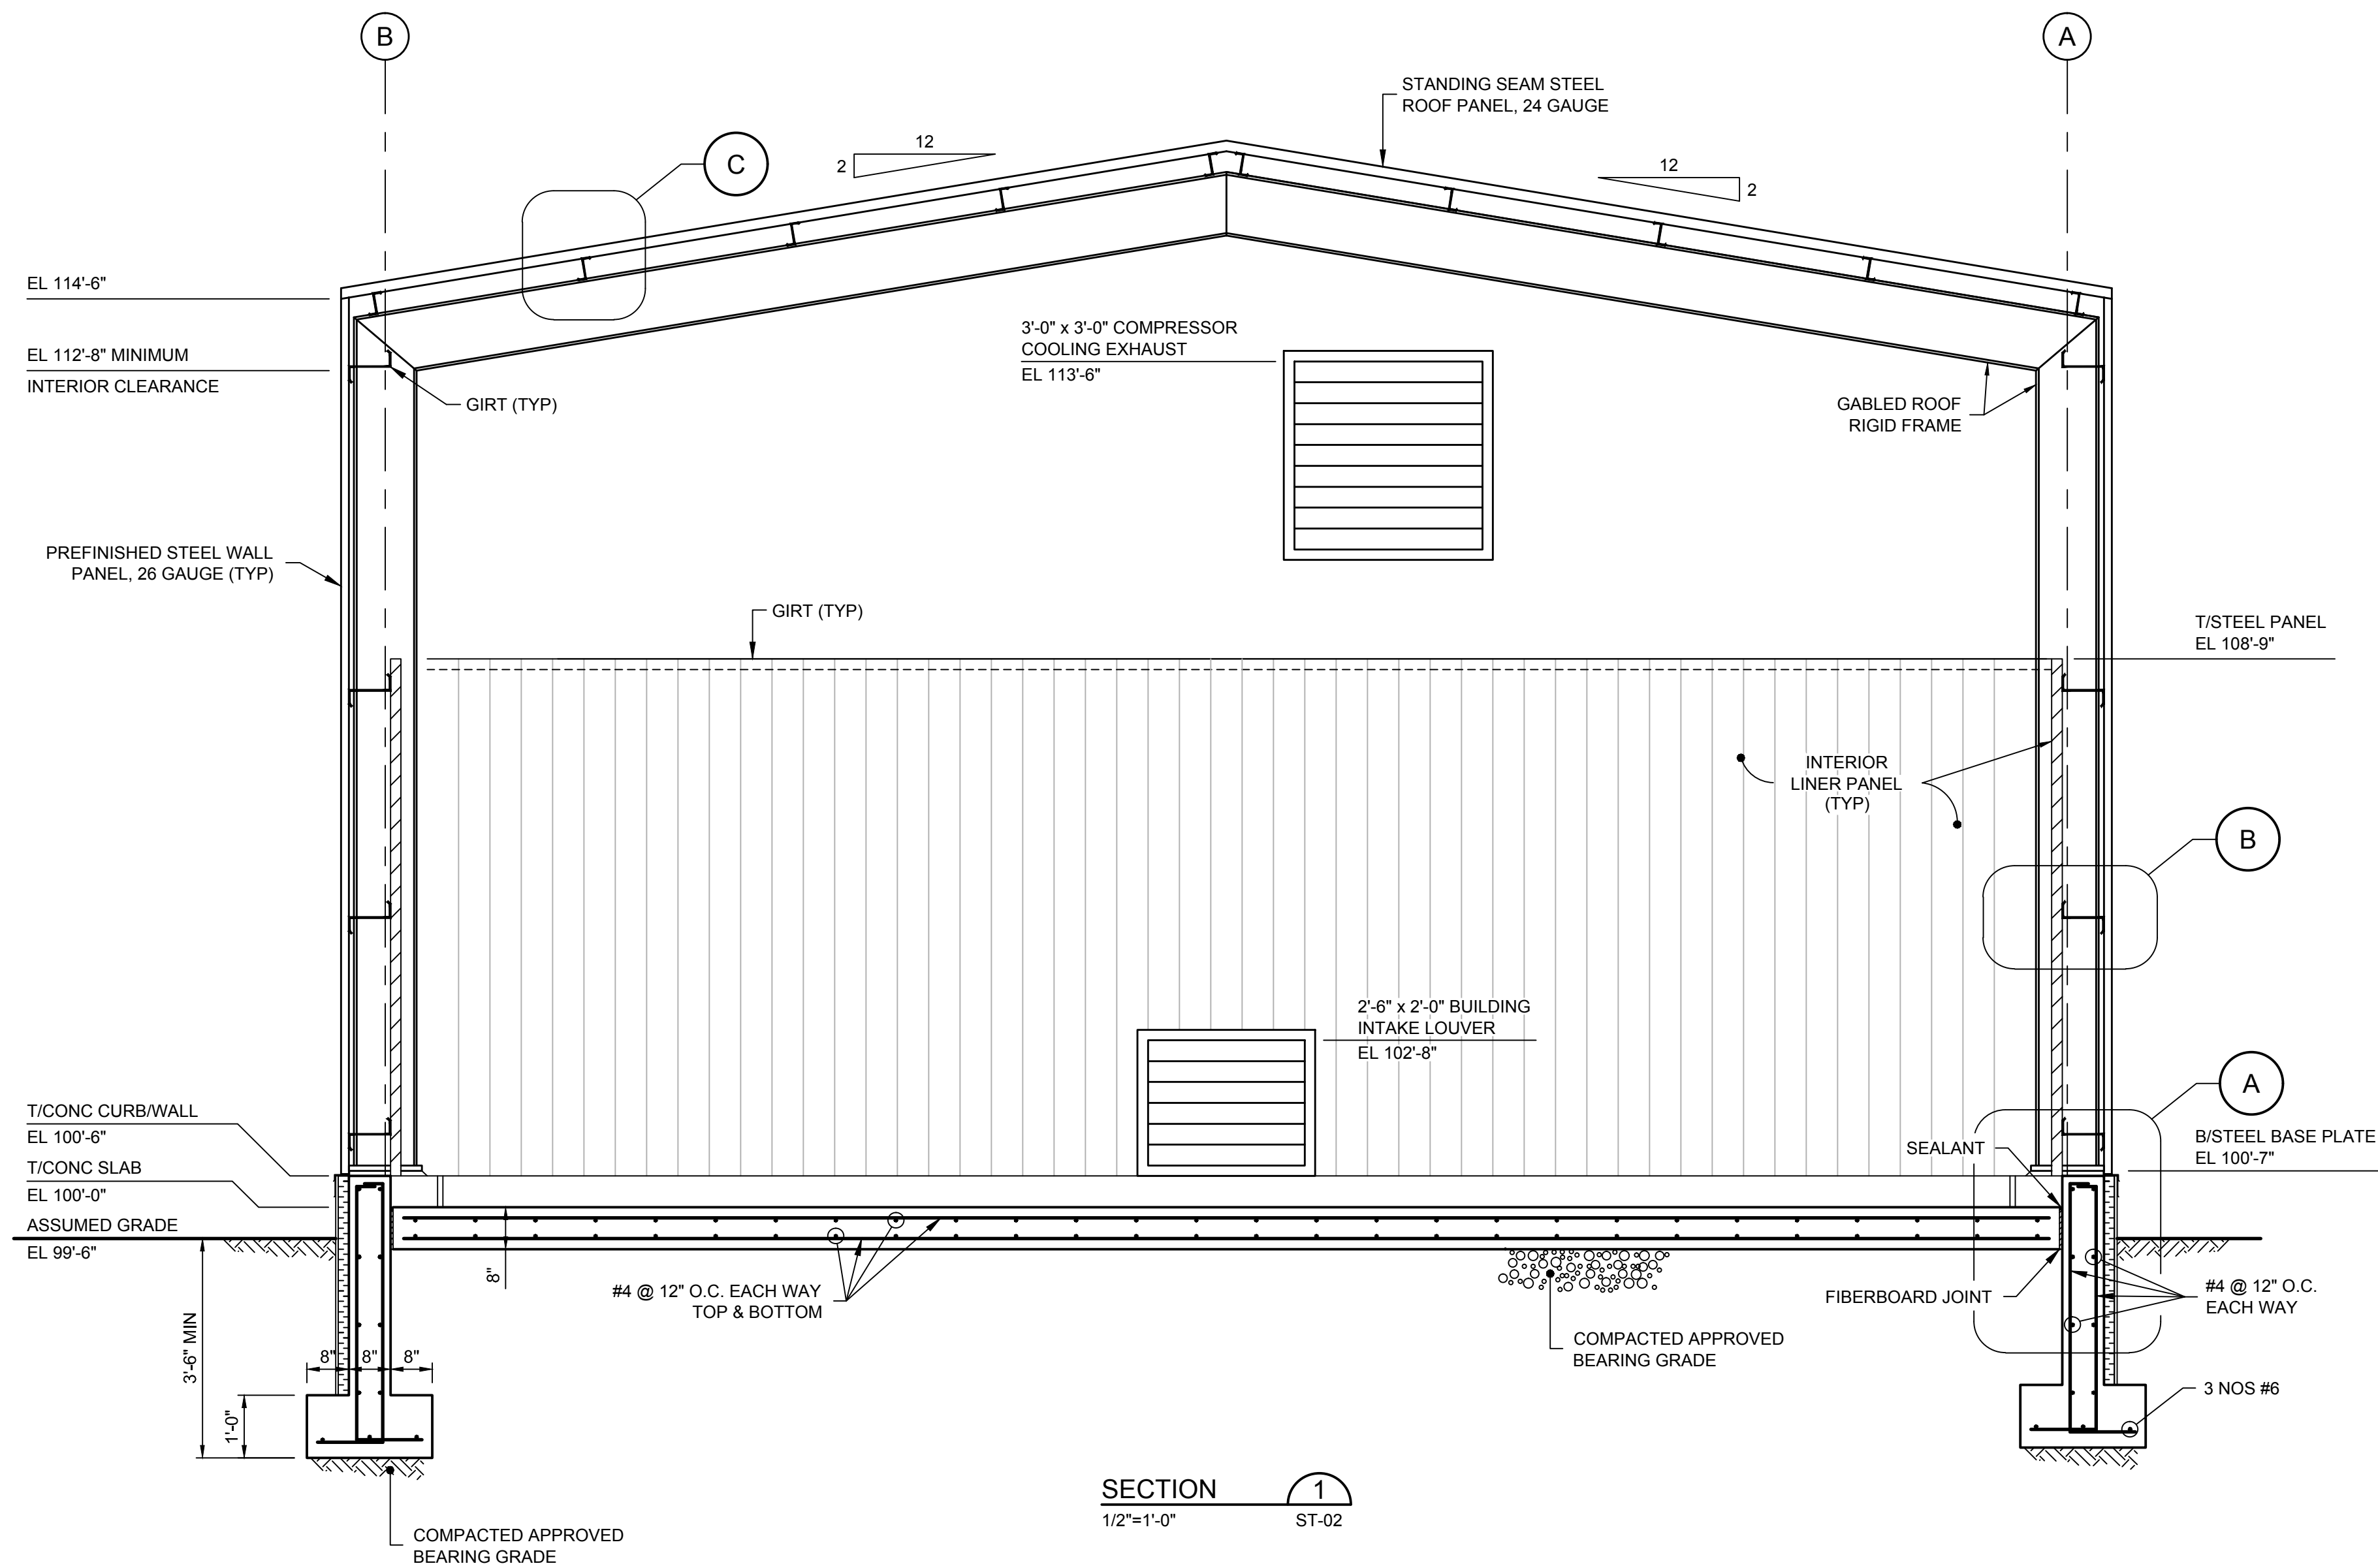

CONTRACTOR SHALL PROVIDE BUILDING EXTERIOR ELEVATION OF 114'-6" AND INTERIOR CLEARANCE AT PRIMARY RIGID FRAME OF MINIMUM 12'-8" ABOVE FLOOR SLAB EL 100'-0", WHICHEVER RESULTS IN GREATER BUILDING HEIGHT

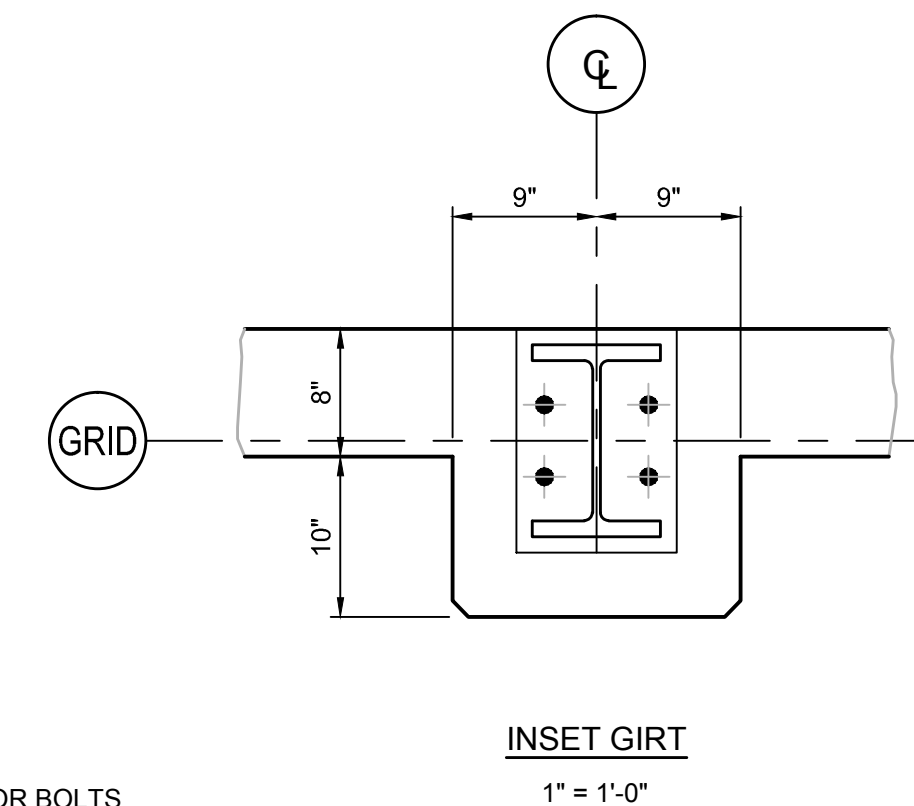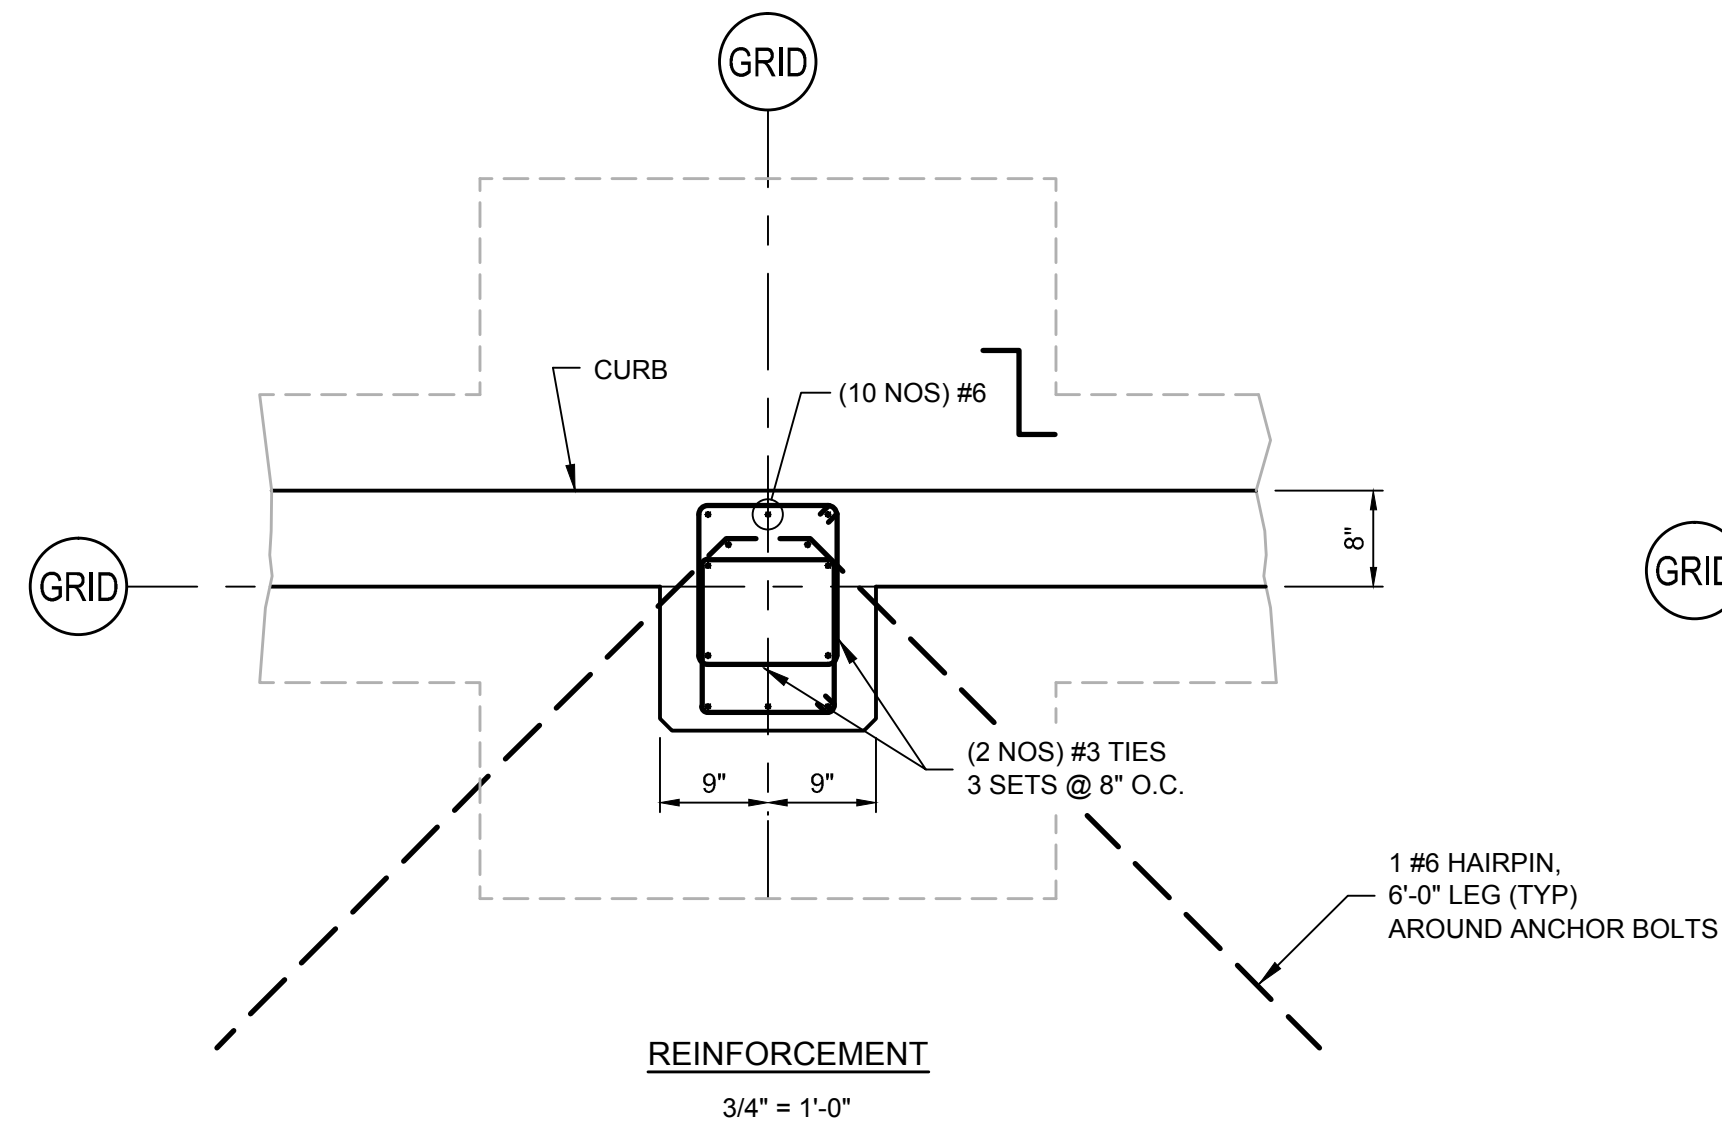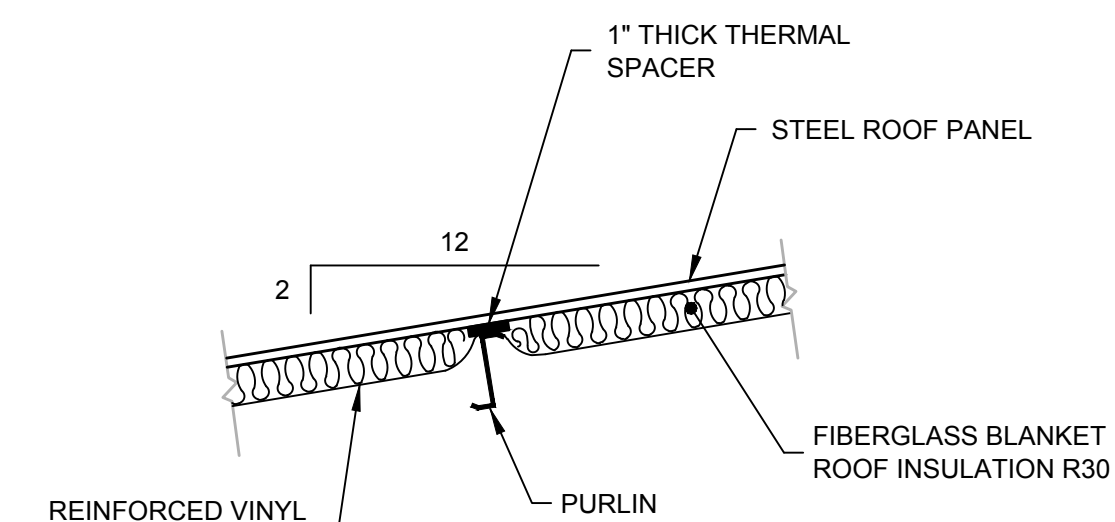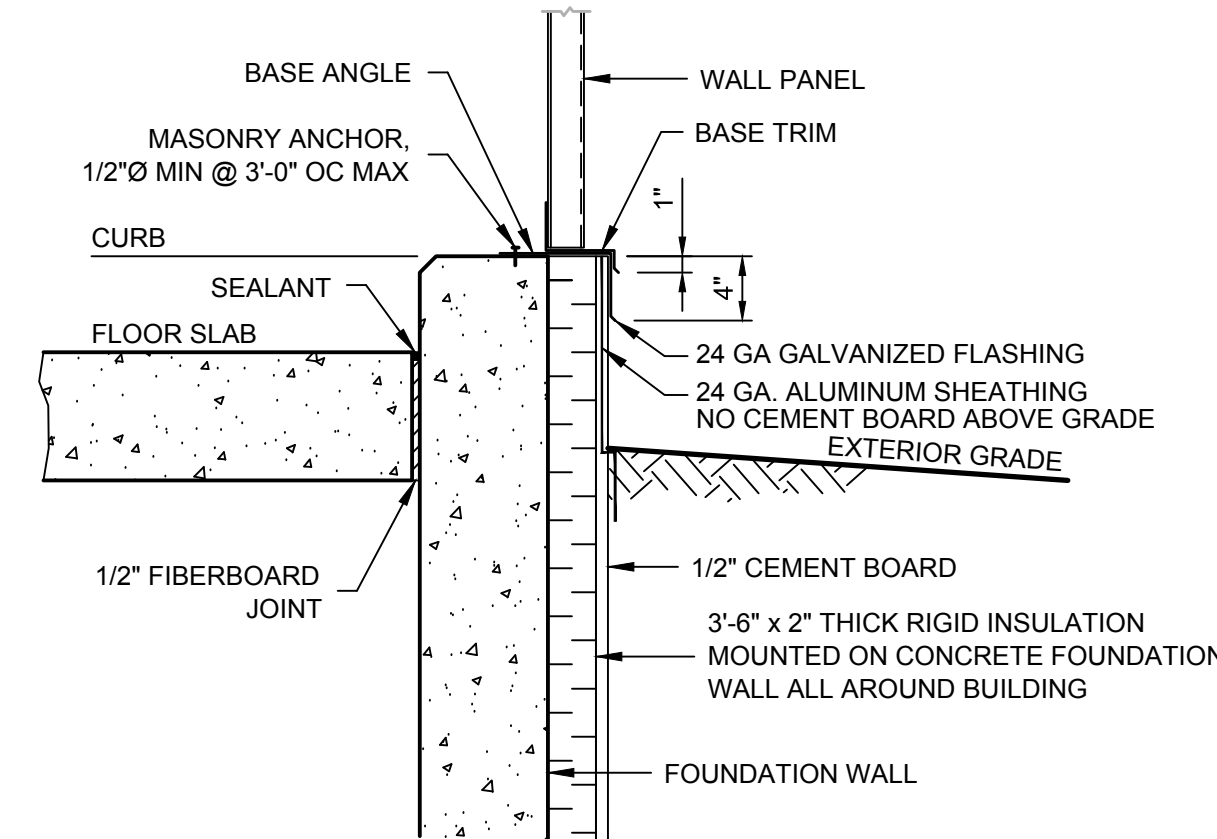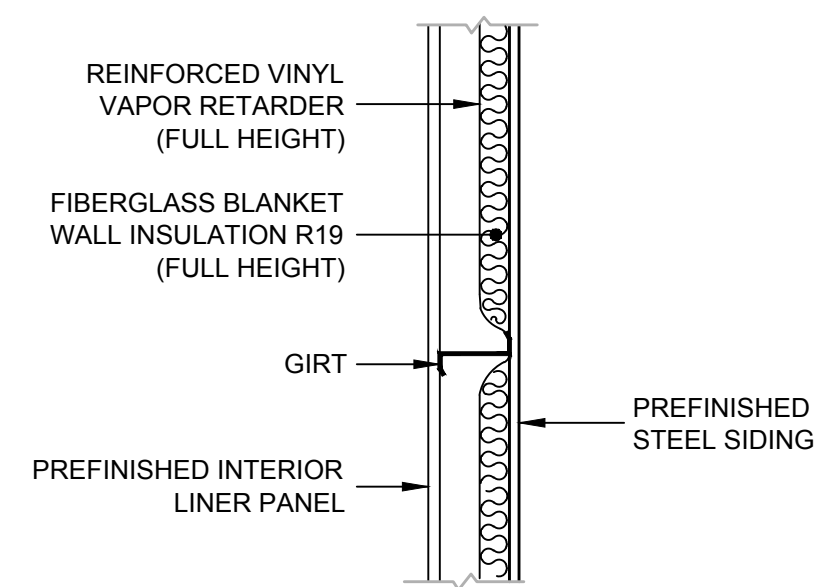

BUILDING COLUMN PIERS - TYPICAL

AS BUILT  
RECORD DRAWING

SCALE VERIFICATION: THIS BAR MEASURES 1" ON ORIGINAL. ADJUST SCALE ACCORDINGLY.

No	Revision	Date	Initial
1	AS BUILT	08/29/12	ZM

Approved

WARNING: ALTERING THIS DOCUMENT IS IN VIOLATION OF THE NEW YORK STATE EDUCATION LAW EXCEPTING AS PROVIDED IN SECTION 7209, PART 2 OF THE LAW.

HOOKER/RUCO SITE  
HICKSVILLE, NEW YORK

BIOSPARGE TREATMENT SYSTEM


CONTROL BUILDING  
SECTION AND DETAILS




**CRA Infrastructure & Engineering, Inc.**

Source Reference:			Date:
			AUGUST 2012
Project Manager:	Reviewed By:	Designed By:	Drawn By:
JK	JGRW	SKM	ZM
Scale:	Project No:	Report No:	Drawing No:
AS NOTED	06883-00	056	ST-04




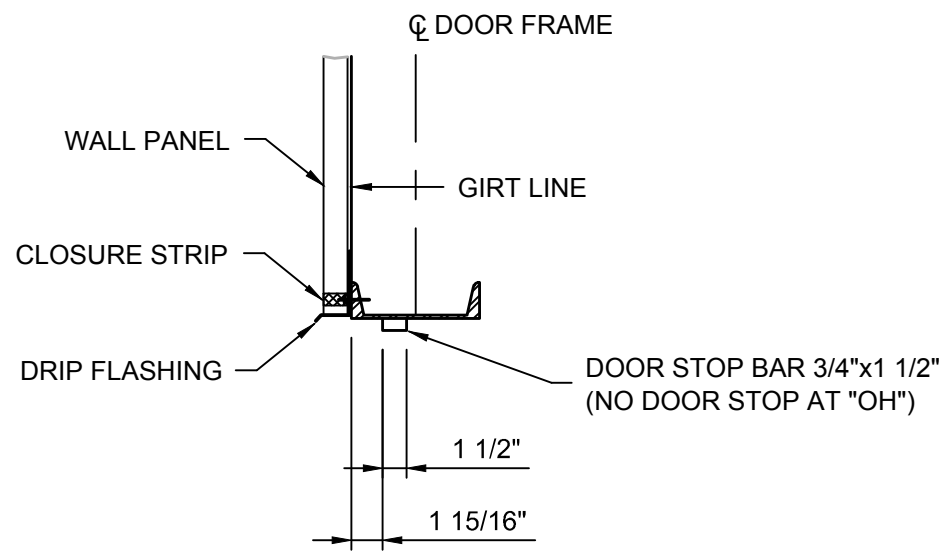

HEAD H-1  
1"=1'-0"

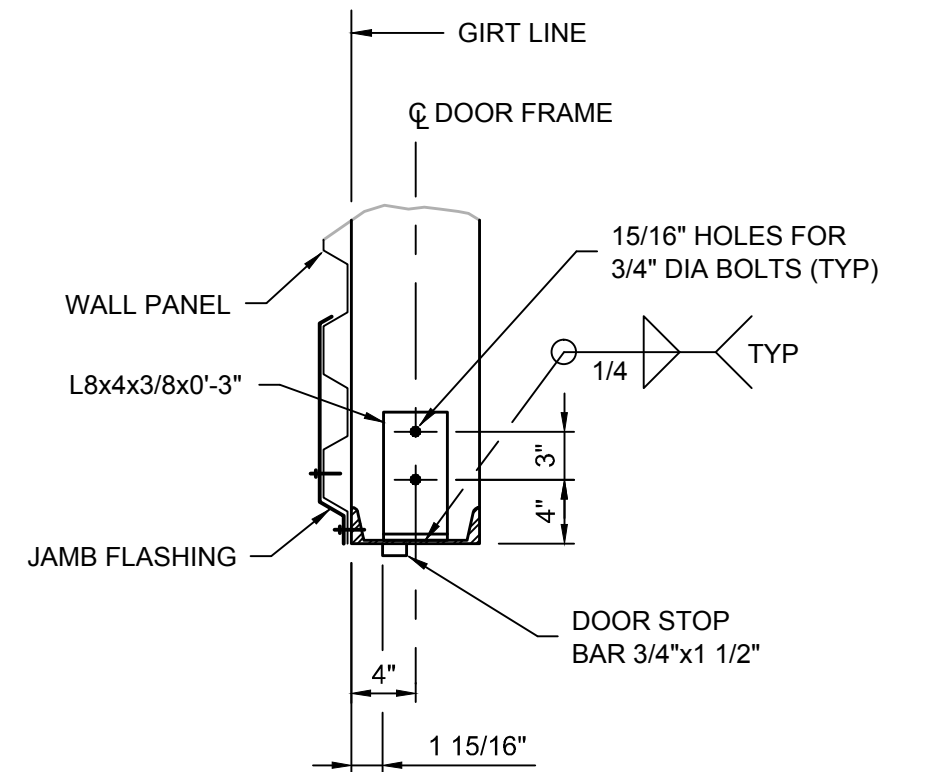


JAMB J-1  
1"=1'-0"

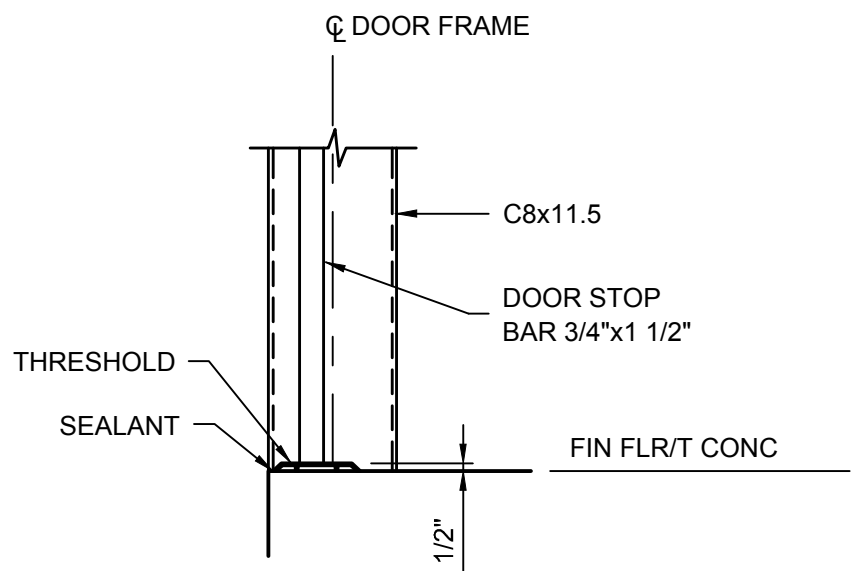

SILL S-1  
1"=1'-0"

DOOR & HARDWARE SCHEDULE																							
<div>ABBREVIATIONS:</div> <div><div>ENALUMINUM ENAMEL</div><div>FRPFIBERGLASS REINFORCED PLASTIC</div><div>GHMGALVANIZED HOLLOW METAL</div><div>RBRUBBER</div></div> <div><div>SFT1/4" SAFETY GLASS - STEEL WIRED</div><div>SSSTAINLESS STEEL</div><div>STLSTRUCTURAL STEEL</div></div>												<div><div><div>INTERIOR</div><div>LEFT HAND</div><div>RIGHT HAND</div><div>EXTERIOR</div></div><div><div>INTERIOR</div><div>LEFT HAND REVERSE BEVEL</div><div>RIGHT HAND REVERSE BEVEL</div><div>EXTERIOR</div></div></div>											
DOOR												FRAME				HARDWARE							
DOOR MARK	TYPE	DOOR HAND	FIRE RATING LABELED	EXTERIOR	INTERIOR	THERMAL INSUL.	DOOR OPENING		THICKNESS	MATERIAL	GLAZING	MATERIAL	HEAD DETAIL	JAMB DETAIL	SILL DETAIL	CLOSER	DOOR STOP	HINGES	KICK PLATE	PANIC SET	THRESHOLD	WEATHERSTRIP	REMARKS
							WIDTH "W"	HEIGHT "H"															
D1	"C"	RHRB LHRB	-	X		R14.97	6'-0"	7'-0"	1 3/4"	GHM	-	STL	H-1	J-1	S-1	X	X	6	X	X	A	X	LHRB DOOR - DEAD BOLT T & B, RHRB DOOR - LATCHES & EXIT DEVICE
D2	"B"	RHRB	3/4 HR		X	R2.44	3'-0"	7'-0"	1 3/4"	GHM	SFT	STL	-	-	-	X	X	3	X	X	B	X	
D3	"A"	RHRB	-		X	-	3'-0"	7'-0"	1 3/4"	GHM	-	STL	-	-	-	X	-	3	X	-	-	-	INTERIOR LATCH

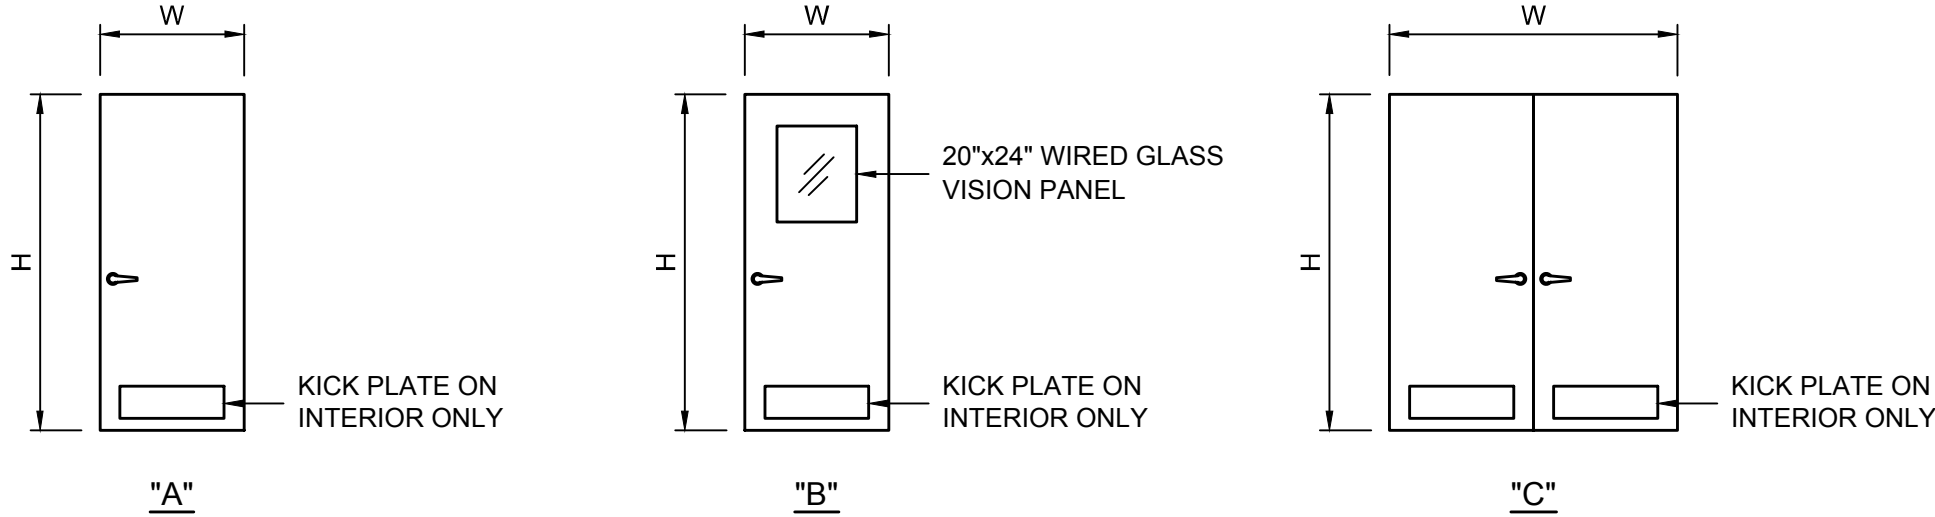

DOOR TYPES  
1/4" = 1'-0"

#### DOOR AND HARDWARE NOTE

ALL DOORS AND HARDWARE SHALL BE AS SPECIFIED OR APPROVED EQUAL, AND SHALL CONFORM TO CODE REQUIREMENTS FOR ACCESSIBILITY.

#### DOORS

- EXTERIOR DOORS SHALL BE "IMPERIAL" BY CECO DOOR PRODUCTS, 16 GAUGE, POLYURETHANE CORE, GALVANIZED AND PAINTED.
- INTERIOR DOORS SHALL BE "REGENT" BY CECO DOOR PRODUCTS, 18 GAUGE, HONEYCOMB CORE, GALVANIZED AND PAINTED.

#### HARDWARE (MANUFACTURER'S STANDARD)

- CLOSER: 1250 SERIES ALUMINUM ENAMEL (EN) - "SARGENT".
- DOOR STOP: TRI BASE FLOOR STOP #259F-US26D - "HAGER".
- HINGES: FULL MORTISE STAINLESS STEEL 32D, 4 1/2"x4 1/2"x0.134 GAUGE, #BB1191 - "HAGER".
- KICK PLATE: STAINLESS STEEL 32D, 16 GAUGE, 8"x26", #220S - "HAGER".
- PANIC SET:
  - EXIT DEVICE: #12-9913-ETF, US 32D FIRE RATED - "SARGENT"; EXTERIOR DOOR BY BUTLER.
  - PUSH PLATE: STAINLESS STEEL 32D, 3"x12", #30S - "HAGER".
  - PULL PLATE: STAINLESS STEEL 32D, 3"x12", #32G - "HAGER".
  - LOCKS: MORTISE - "SARGENT".
- THRESHOLD:
  - SKID RESISTANT ABRASIVE CAST ALUMINUM HEAVY DUTY, 4" WIDE, #624S - "HAGER".
  - NON-SLIP ABRASIVE ALUMINUM SADDLE, 4" WIDE, #410S - "HAGER".
- WEATHERSTRIP AND DOOR BOTTOM:
  - WEATHERSTRIP JAMB & HEAD #870S-N - "HAGER".
  - DOOR BOTTOM #774S-V - "HAGER".

AS BUILT  
RECORD DRAWING

SCALE VERIFICATION: THIS BAR MEASURES 1" ON ORIGINAL. ADJUST SCALE ACCORDINGLY.

1	AS BUILT	08/29/12	ZM
No	Revision	Date	Initial

Approved

WARNING: ALTERING THIS DOCUMENT IS IN VIOLATION OF THE NEW YORK STATE EDUCATION LAW EXCEPTING AS PROVIDED IN SECTION 7209, PART 2 OF THE LAW.

HOOKER/RUCO SITE  
HICKSVILLE, NEW YORK


BIOSPARGE TREATMENT SYSTEM

CONTROL BUILDING  
SCHEDULE & DETAILS



**CRA Infrastructure  
& Engineering, Inc.**

Source Reference:			Date: AUGUST 2012
Project Manager: JK	Reviewed By: JGRW	Designed By: SKM	Drawn By: ZM
Scale: AS NOTED	Project No: 06883-00	Report No: 056	Drawing No: ST-05

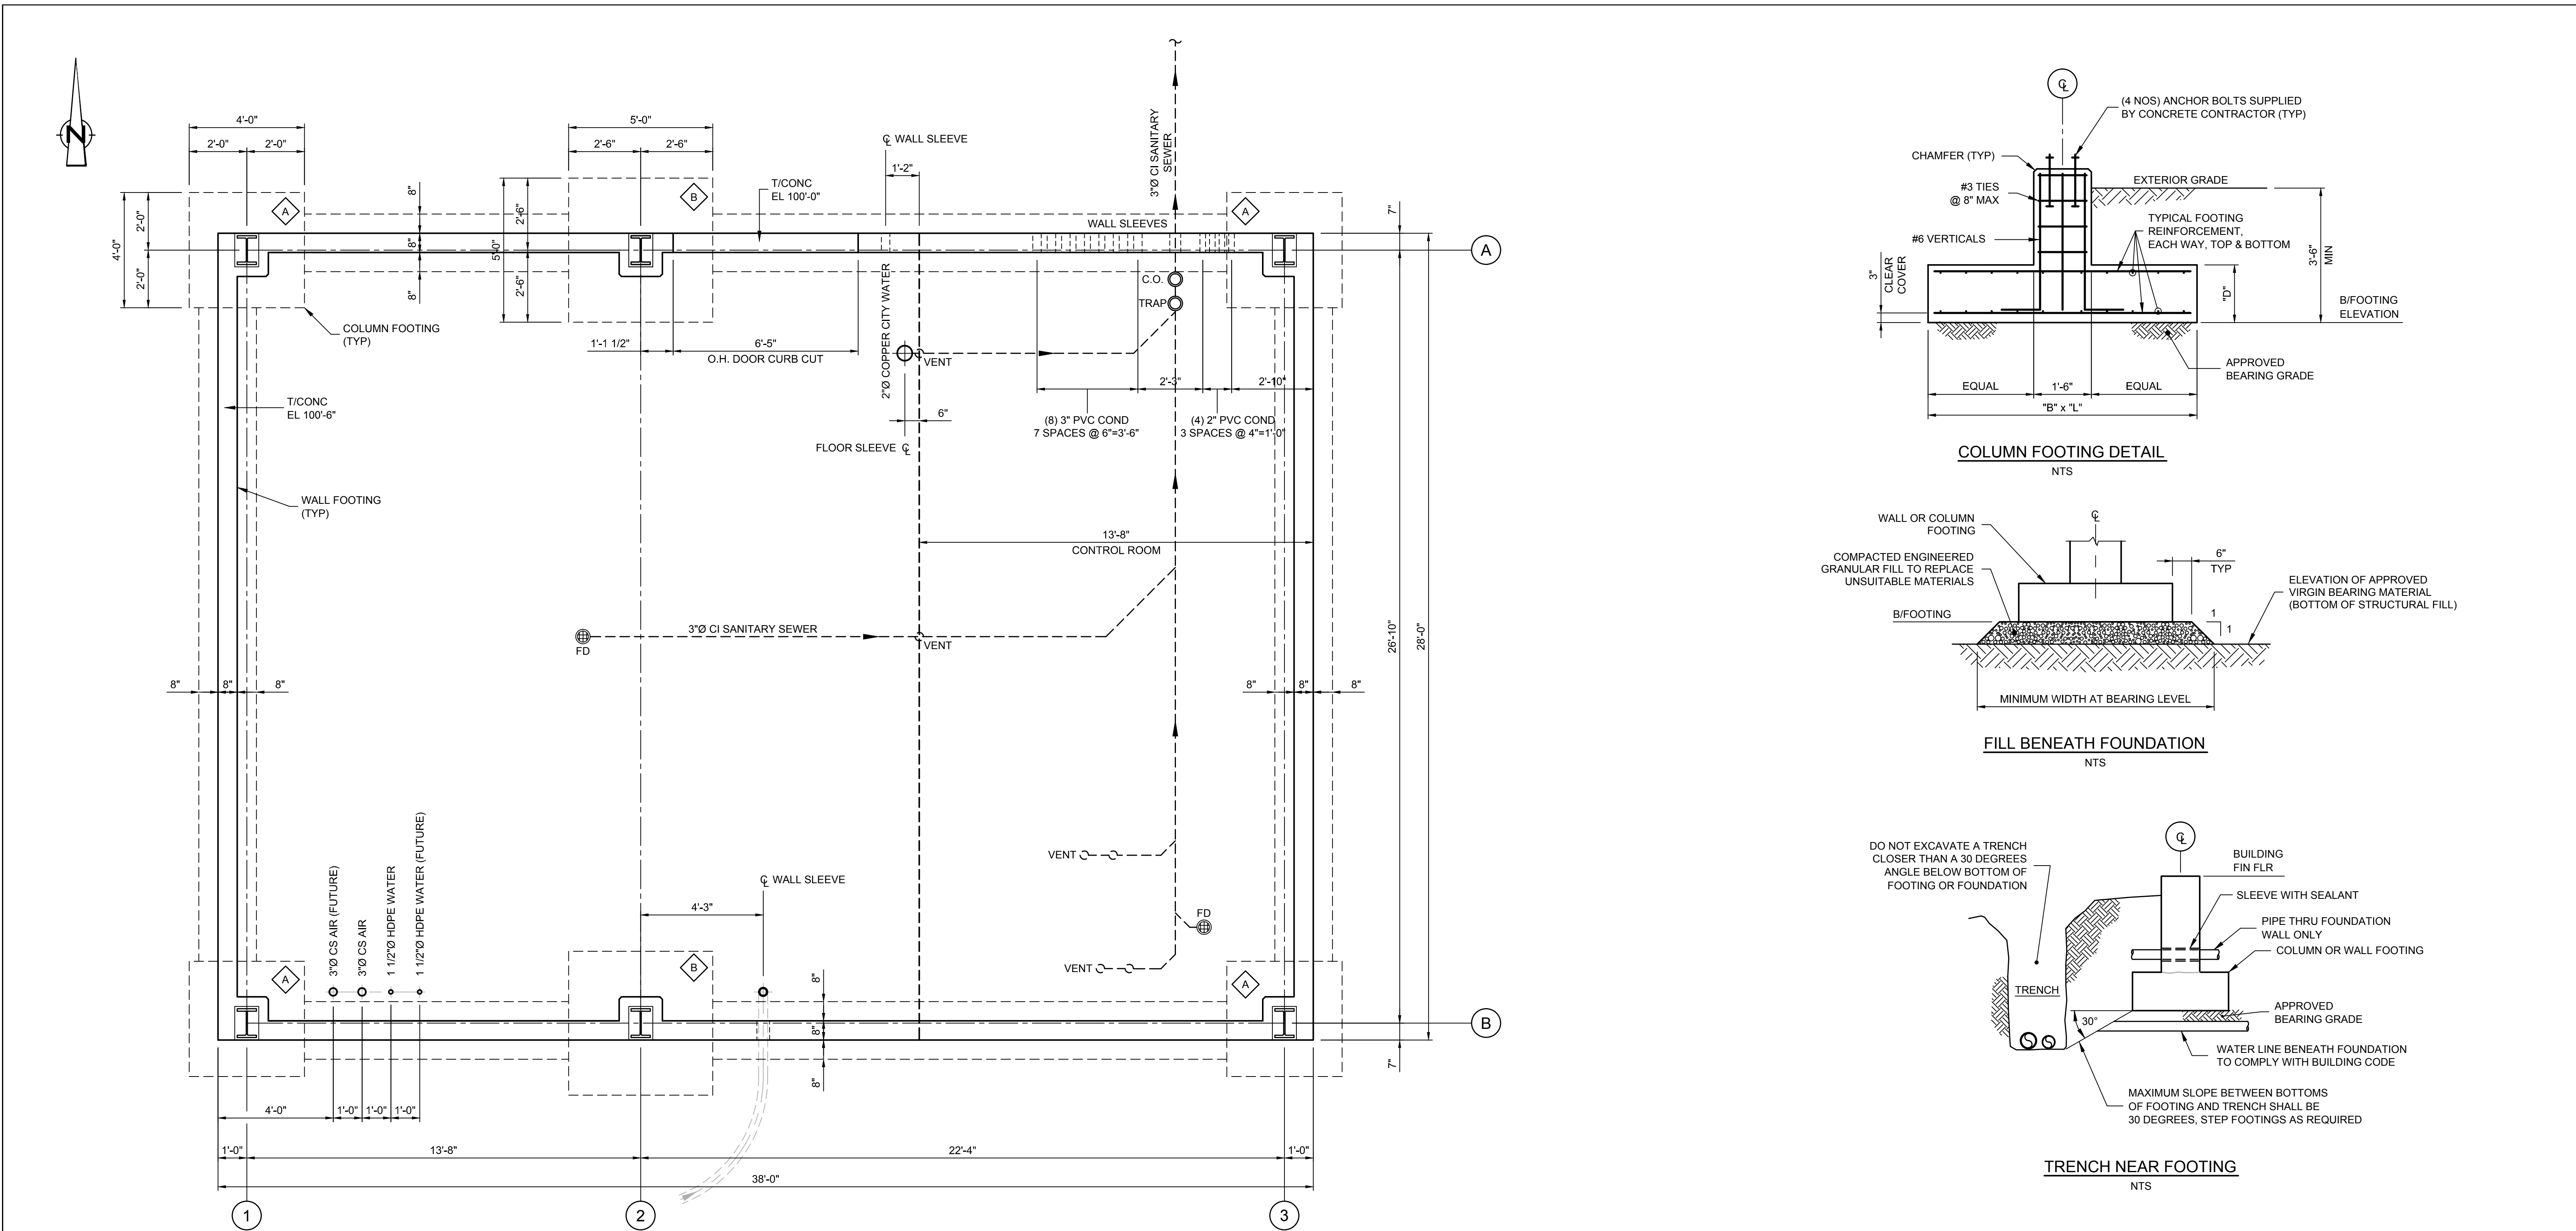

FOUNDATION PLAN  
3/8" = 1'-0"

NOTES

- FOOTING SIZES AND DETAILS SHOWN ON VARIOUS DRAWINGS ARE BASED ON BUTLER MANUFACTURING COMPANY INFORMATION PROVIDED TO CRAIE.
- FOOTING SIZES, DETAILS AND DESIGN SHALL BE VERIFIED/MODIFIED BASED ON ACTUAL PRE-ENGINEERED BUILDING LOADS PROVIDED BY MANUFACTURER PRIOR TO ORDERING MATERIALS FOR CONSTRUCTION.
- FOR ANCHOR BOLT AND BUILDING COLUMN LAYOUT DETAILS REFER TO DRAWINGS BY PRE-ENGINEERED BUILDING MANUFACTURER.
- BUILDING COLUMN FOUNDATION ANCHORS LAYOUT, NUMBER, TYPE, DIAMETER, LENGTH, EMBEDMENT DEPTH, AND OTHER DETAILS SHALL BE BASED ON BUILDING MANUFACTURER'S REQUIREMENTS AND LOADINGS. THE ANCHORS SHALL BE INSTALLED PER ITS MANUFACTURER'S RECOMMENDATIONS.
- CONTINUE WALL HORIZONTAL AND VERTICAL REINFORCEMENTS INTO COLUMN PIERS AND FOUNDATIONS, RESPECTIVELY.
- PROVIDE TYPICAL PIER REINFORCEMENTS FOR ALL BUILDING COLUMNS.

COLUMN FOOTING SCHEDULE								
FOOTING MARK	DIMENSIONS			REINFORCEMENT				NOTES
	"B" (EAST-WEST)	"L" (NORTH-SOUTH)	"D"	BOTTOM (EAST-WEST)	BOTTOM (NORTH-SOUTH)	TOP (EAST-WEST)	TOP (NORTH-SOUTH)	
A	4'-0"	4'-0"	1'-6"	7 #7	7 #7	5 #3	5 #3	-
B	5'-0"	5'-0"	1'-6"	7 #7	7 #7	5 #3	5 #3	-

AS BUILT  
RECORD DRAWING


SCALE VERIFICATION: THIS BAR MEASURES 1" ON ORIGINAL. ADJUST SCALE ACCORDINGLY.			
1	AS BUILT	08/29/12	ZM
No	Revision	Date	Initial

Approved	
WARNING: ALTERING THIS DOCUMENT IS IN VIOLATION OF THE NEW YORK STATE EDUCATION LAW EXCEPTING AS PROVIDED IN SECTION 7209, PART 2 OF THE LAW.	

HOOKER/RUCO SITE HICKSVILLE, NEW YORK	
BIOSPARGE TREATMENT SYSTEM	
CONTROL BUILDING FOUNDATION PLAN	

		<b>CRA Infrastructure &amp; Engineering, Inc.</b>	
Source Reference:			Date: AUGUST 2012
Project Manager: JK	Reviewed By: JGRW	Designed By: SKM	Drawn By: ZM
Scale: 3/8" = 1'-0"	Project No: 06883-00	Report No: 056	Drawing No: ST-06



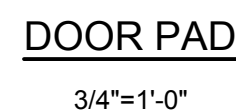

CLEAN SURFACE AND APPLY BONDING AGENT

CHAMFER

ANCHOR BOLTS

1'-6"

#4 @ 12" O.C. (TYP) AROUND PERIMETER

T/CONCRETE EL VARIES

SLAB REINF EACH WAY, TOP & BOTTOM

(1) #4 CONTINUOUS AROUND PERIMETER



T/EQUIPMENT PAD

REFER SCHEDULE

#4 @ 12" EW

SECTION 1

1. HILTI ANCHOR BOLTS SHALL CONSIST OF HVA ANCHORING SYSTEM (HVA ADHESIVE AND HAS STAINLESS STEEL ROD) WITH SPECIFIED BOLT DIAMETER AND MINIMUM CONCRETE EMBEDMENT.
2. HILTI ANCHORS SHALL BE SUPPLIED AND INSTALLED BY MECHANICAL CONTRACTOR.
3. LAYOUT, SIZE AND NUMBER OF ANCHORS SHALL BE AS PER MECHANICAL REQUIREMENTS.

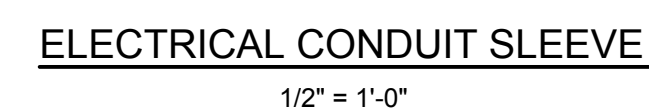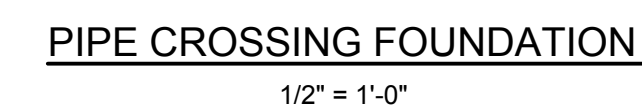


**AS BUILT  
RECORD DRAWING**

1	AS BUILT	08/29/12	ZM
No	Revision	Date	Initials

WARNING: ALTERING THIS DOCUMENT IS  
IN VIOLATION OF THE NEW YORK STATE  
EDUCATION LAW EXCEPTING AS PROVIDED  
IN SECTION 7209, PART 2 OF THE LAW.

## CONTROL BUILDING MISCELLANEOUS DETAILS

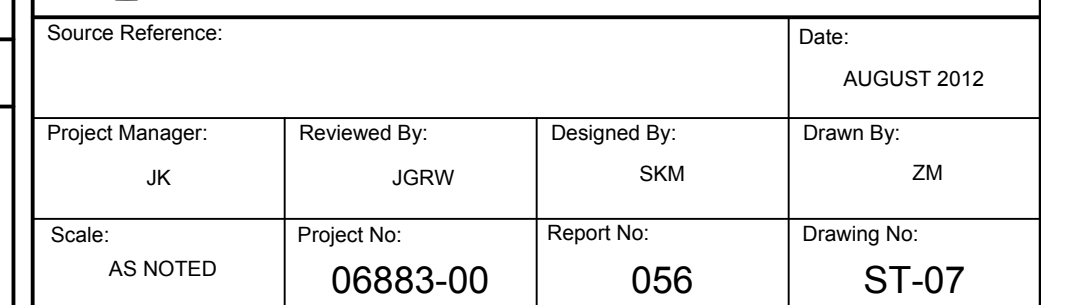

PROCESS / INSTRUMENT LINES

MAIN PROCESS LINE

SECONDARY PROCESS LINE

UNDEFINED SIGNAL

PNEUMATIC SIGNAL

ELECTRICAL SIGNAL

CAPILLARY TUBE, FILLED SYSTEM

ELECTROMAGNETIC OR SONIC SIGNAL (GUIDED)

ELECTROMAGNETIC OR SONIC SIGNAL (NOT GUIDED)

INTERNAL SYSTEM LINK

HYDRAULIC SIGNAL

MECHANICAL LINK

ELECTRICAL BINARY SIGNAL

TO / FROM  
SHEET No.

OFF PAGE CONNECTOR

1<sup>2</sup>

HARDWIRED INTERLOCK LOGIC  
(-1,2,3...IS OPTIONAL REFERENCE TO INTERLOCK  
DETAIL DESCRIPTION)

MISCELLANEOUS SYMBOLS

REDUCER

FLEXIBLE PIPE

EXPANSION JOINT

BLIND FLANGE

HOSE CONNECTION

SCREWED CAP, CLEANOUT

Y-LINE STRAINER

SPECIFICATION CHANGE

FUNNEL DRAIN

STATIC MIXER

FILTER/REGULATOR/LUBRICATOR

ANNUNCIATOR HORN

FILTER/REGULATOR

EQUIPMENT INSULATED WITH "X"  
OF INSULATION

RESET FOR LATCH-TYPE ACTUATOR

OPEN VENT TO ATMOSPHERE

INLINE BLANK

RESTRICTION ORIFICE

AIR EJECTOR

TRAP

PULSATION DAMPER

BLOCK & BLEED ASSEMBLY

TIE POINT TO EXISTING SYSTEM

DRAIN (FLOOR, SEWER, ETC.)

FLOW STRAIGHTENING VANE

SPECIALITY PART

AIR VENT, AUTOMATIC

INTERLOCK LOGIC IN CONTROLLER OR PLC WHERE:  
- 1,2,3,...IS OPTIONAL REFERENCE TO INTERLOCK  
DETAIL DESCRIPTION  
- x = PLC No. WHEN MORE THAN ONE PLC IS  
PRESENT IN THE SYSTEM

PLCx

VALVE SYMBOLS

BA - "  
BU - "  
CH - "  
GA - "  
GL - "  
GLOBE VALVE  
THREE WAY VALVE  
(FAIL OPEN TO PATH A-C)  
FOUR WAY VALVE  
(FAIL OPEN TO PATH A-C AND B-D)  
DAMPER OR LOUVER

BALL VALVE

BUTTERFLY VALVE

CHECK VALVE

GATE VALVE

GLOBE VALVE

THREE WAY VALVE  
(FAIL OPEN TO PATH A-C)

FOUR WAY VALVE  
(FAIL OPEN TO PATH A-C AND B-D)

DAMPER OR LOUVER

GENERAL INSTRUMENT SYMBOLS

LOCALLY MOUNTED INSTRUMENTS

PRIMARY PANEL MOUNTED INSTRUMENTS

AUXILIARY PANEL MOUNTED INSTRUMENTS  
WHERE x = PANEL No. WHEN MORE THAN  
ONE PANEL IS PRESENT

BEHIND BOARD MOUNTED INSTRUMENTS

INSTRUMENTS SHARING COMMON HOUSING

IN LINE INSTRUMENTS AS IDENTIFIED

SIGNAL CONVERTER (INPUT/OUTPUT)  
\* E - VOLTAGE      P - PNEUMATIC  
I - CURRENT      B - BINARY (MODBUS,  
RS232,...)

PILOT LIGHT  
A = AMBER      G = GREEN      W = WHITE  
B = BLUE      R = RED      Y = YELLOW  
C = CLEAR

DISTRIBUTED CONTROL / SHARED DISPLAY INSTRUMENTS

INDICATOR/CONTROLLER/RECORDER OR ALARM  
POINTS - USUALLY USED TO INDICATE VIDEO  
DISPLAY (DCS OR HMI CONFIGURATIONS)  
\* NORMALLY ACCESSIBLE TO OPERATOR

NORMALLY BLIND OPERATION  
\* NOT NORMALLY ACCESSIBLE TO OPERATOR

DISTRIBUTED CONTROL INTERCONNECTING LOGIC  
CONTROLLER OR PLC WITH BINARY OR SEQUENTIAL  
LOGIC FUNCTIONS.  
\* NORMALLY ACCESSIBLE TO OPERATOR

NORMALLY BLIND OPERATION  
\* NOT NORMALLY ACCESSIBLE TO OPERATOR

1

PLCx

INTERLOCK LOGIC IN CONTROLLER OR PLC WHERE:  
- 1,2,3,...IS OPTIONAL REFERENCE TO INTERLOCK  
DETAIL DESCRIPTION  
- x = PLC No. WHEN MORE THAN ONE PLC IS  
PRESENT IN THE SYSTEM

CONSERVATION VENT

FLAME ARRESTOR

PRIMARY ELEMENT SYMBOLS

VARIABLE AREA FLOWMETER

DIAPHRAM SEAL WITH PRESSURE  
LEAD LINE

DIAPHRAM SEAL (LINE-MOUNTED)

TEMPERATURE ELEMENT WITH THERMOWELL  
(OPTIONAL ELEMENT DESCRIPTION RTD, TYPE K...)

FLOW SIGHT GLASS  
(LG - LEVEL SIGHT GLASS, SG - GENERAL SIGHT GLASS)

LEVEL DEVICE, FLOAT TYPE

ACTUATOR SYMBOLS

DIAPHRAM ACTUATOR

CYLINDER ACTUATOR

ROTARY MOTOR ACTUATOR

SOLENOID ACTUATOR

HAND ACTUATOR OR HANDWHEEL

AIR ACTUATED VALVE W/POSITIONER  
OPTIONAL:  
D - DIRECT ACTING POSITIONER  
R - REVERSE ACTING POSITIONER

VALVE FAIL SYMBOLS  
FO - FAIL OPEN  
FC - FAIL CLOSED  
FL - FAIL LOCKED (LAST POSITION)  
FI - FAIL INDETERMINATE

LIMIT SWITCH ACTIVATED WHEN VALVE CLOSED  
(ZSH ACTIVATED WHEN VALVE OPEN)

SELF-ACTUATED REGULATORS, VALVES,  
AND OTHER DEVICES

RUPTURE DISC FOR PRESSURE RELIEF

RUPTURE DISC FOR VACUUM RELIEF

PRESSURE RELIEF VALVE

VACUUM RELIEF VALVE

PRESSURE REDUCING REGULATOR  
(SELF CONTAINED)

BACKPRESSURE REGULATOR  
(SELF CONTAINED)

LEVEL REGULATOR WITH MECHANICAL  
LINKAGE

TYPICAL ISA LETTER COMBINATIONS

First Letters

Initiating or Measured Variable

Controllers

Self-Actuated Control Valves

Readout Devices

Switches and Alarm Devices \*

Transmitters

Solenoids, Relays, Computing Devices

Primary Element

Test Point

Well or Probe

Viewing Device, Glass

Safety Device

Final Element

ARC AIC AC

BR BIC BC

ERC EIC EC

FRC FIC FC

FFRC FFIC FFC

HIC HC

IRC IIC

JRC JIC

KRC KIC KC

LRC LIC LC

PRC PIC PC

PDRC PDIC PDC

QRC QIC

RRC RIC RC

SRC SIC SC

TRC TIC TC

TDRC TDIC TDC

WRC WIC WC

ZRC ZIC ZC

YIC YC

ZC ZC

FCV, FICV

KCV LCV

PCV PDCV

SCV WDCV

ZCV ZDCV

RTD

TE

FG

TD

UR

VR

WR

ZR

YR

ZI

ZD

PI

PI

TE

FG

TD

UR

VR

WR

ZR

YR

ZI

ZD

PI

PI

TE

FG

TD

UR

VR

WR

ZR

YR

ZI

ZD

PI

PI

TE

FG

TD

UR

VR

WR

ZR

YR

ZI

ZD

PI

PI

TE

FG

TD

UR

VR

WR

ZR

YR

ZI

ZD

PI

PI

TE

FG

TD

UR

VR

WR

ZR

YR

ZI

ZD

PI

PI

TE

FG

TD

UR

VR

WR

ZR

YR

ZI

ZD

PI

PI

TE

FG

TD

UR

VR

WR

ZR

YR

ZI

ZD

PI

PI

TE

FG

TD

UR

VR

WR

ZR

YR

ZI

ZD

PI

PI

TE

FG

TD

UR

VR

WR

ZR

YR

ZI

ZD

PI

PI

TE

FG

TD

UR

VR

WR

ZR

YR

ZI

ZD

PI

PI

TE

FG

TD

UR

VR

WR

ZR

YR

ZI

ZD

PI

PI

TE

FG

TD

UR

VR

WR

ZR

YR

ZI

ZD

PI

PI

TE

FG

TD

UR

VR

WR

ZR

YR

ZI

ZD

PI

PI

TE

FG

TD

UR

VR

WR

ZR

YR

ZI

ZD

PI

PI

TE

FG

TD

UR

VR

WR

ZR

YR

ZI

ZD

PI

PI

TE

FG

TD

UR

VR

WR

ZR

YR

ZI

ZD

PI

PI

TE

FG

TD

UR

VR

WR

ZR

YR

ZI

ZD

PI

PI

TE

FG

TD

UR

VR

WR

ZR

YR

ZI

ZD

PI

PI

TE

FG

TD

UR

VR

WR

ZR

YR

ZI

ZD

PI

PI

TE

FG

TD

UR

VR

WR

ZR

YR

ZI

ZD

PI

PI

TE

FG

TD

UR

VR

WR

ZR

YR

ZI

ZD

PI

PI

TE

FG

TD

UR

VR

WR

ZR

YR

ZI

ZD

PI

PI

TE

FG

TD

UR

VR

WR

ZR

YR

ZI

ZD

PI

PI

TE

FG

TD

UR

VR

WR

ZR

YR

ZI

ZD

PI

PI

TE

FG

TD

UR


ZD


PI

PI





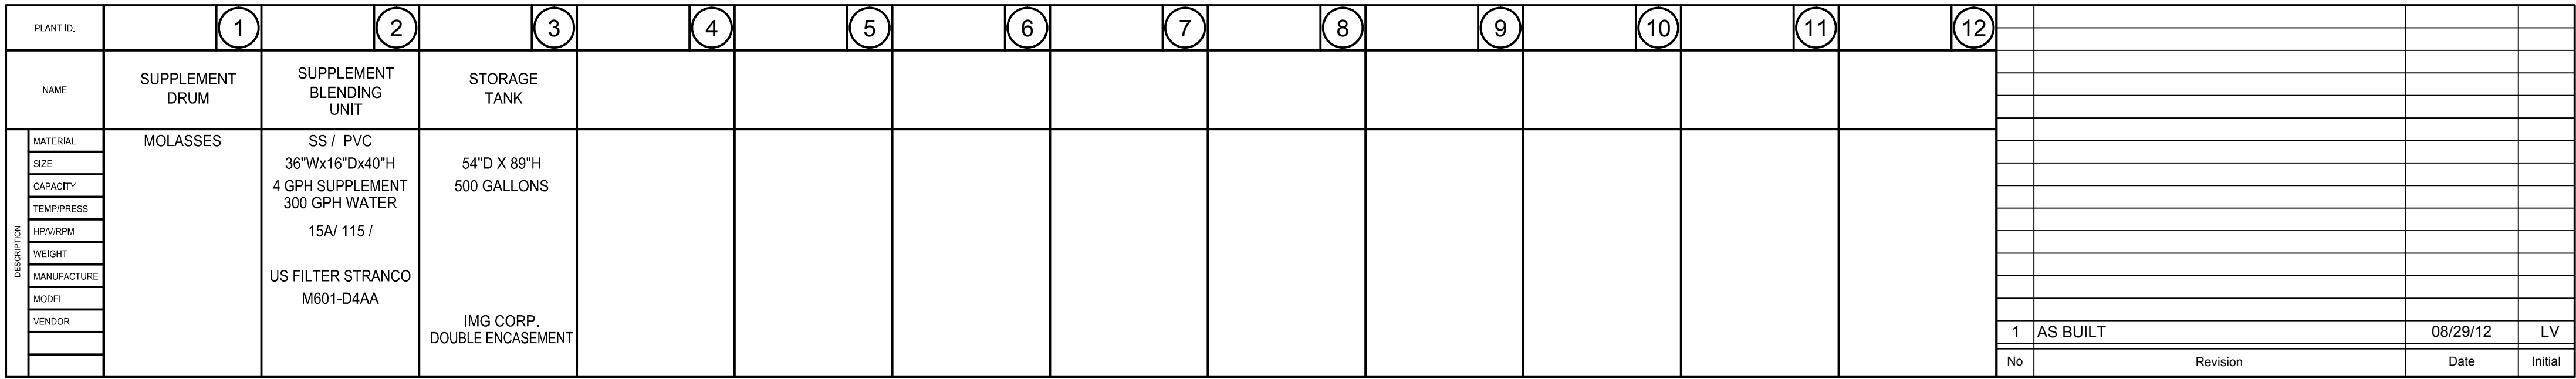


<p>HOOKER/RUCO SITE HICKSVILLE, NEW YORK</p> <p>BIOSPARGE TREATMENT SYSTEM</p> <p>ENGINEERING FLOW SHEET PROCESS EQUIPMENT</p>		<p><b>AS BUILT</b></p> <p><b>RECORD DRAWING</b></p>	
		<p> <b>CRA Infrastructure &amp; Engineering, Inc.</b></p>	
Source Reference:		Date: SEPTEMBER 2003	
Project Manager: J. KAY	Reviewed By:	Designed By: B.A. BEEBE	Drawn By: B.A. BEEBE
Scale:	Project No: 06883-00	Report No: 056	Drawing No: EF-01 S2







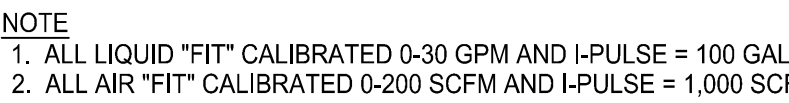


HOOKER/RUCO SITE HICKSVILLE, NEW YORK
BIOSPARGES TREATMENT SYSTEM
ENGINEERING FLOW SHEET MIDDLE FENCE INJECTION WELLS

## ENGINEERING FLOW SHEET

### MIDDLE FENCE INJECTION WELLS



Scale:	Project No: 06883-00	Report No: 056	Drawing No: EF-04
--------	-------------------------	-------------------	----------------------

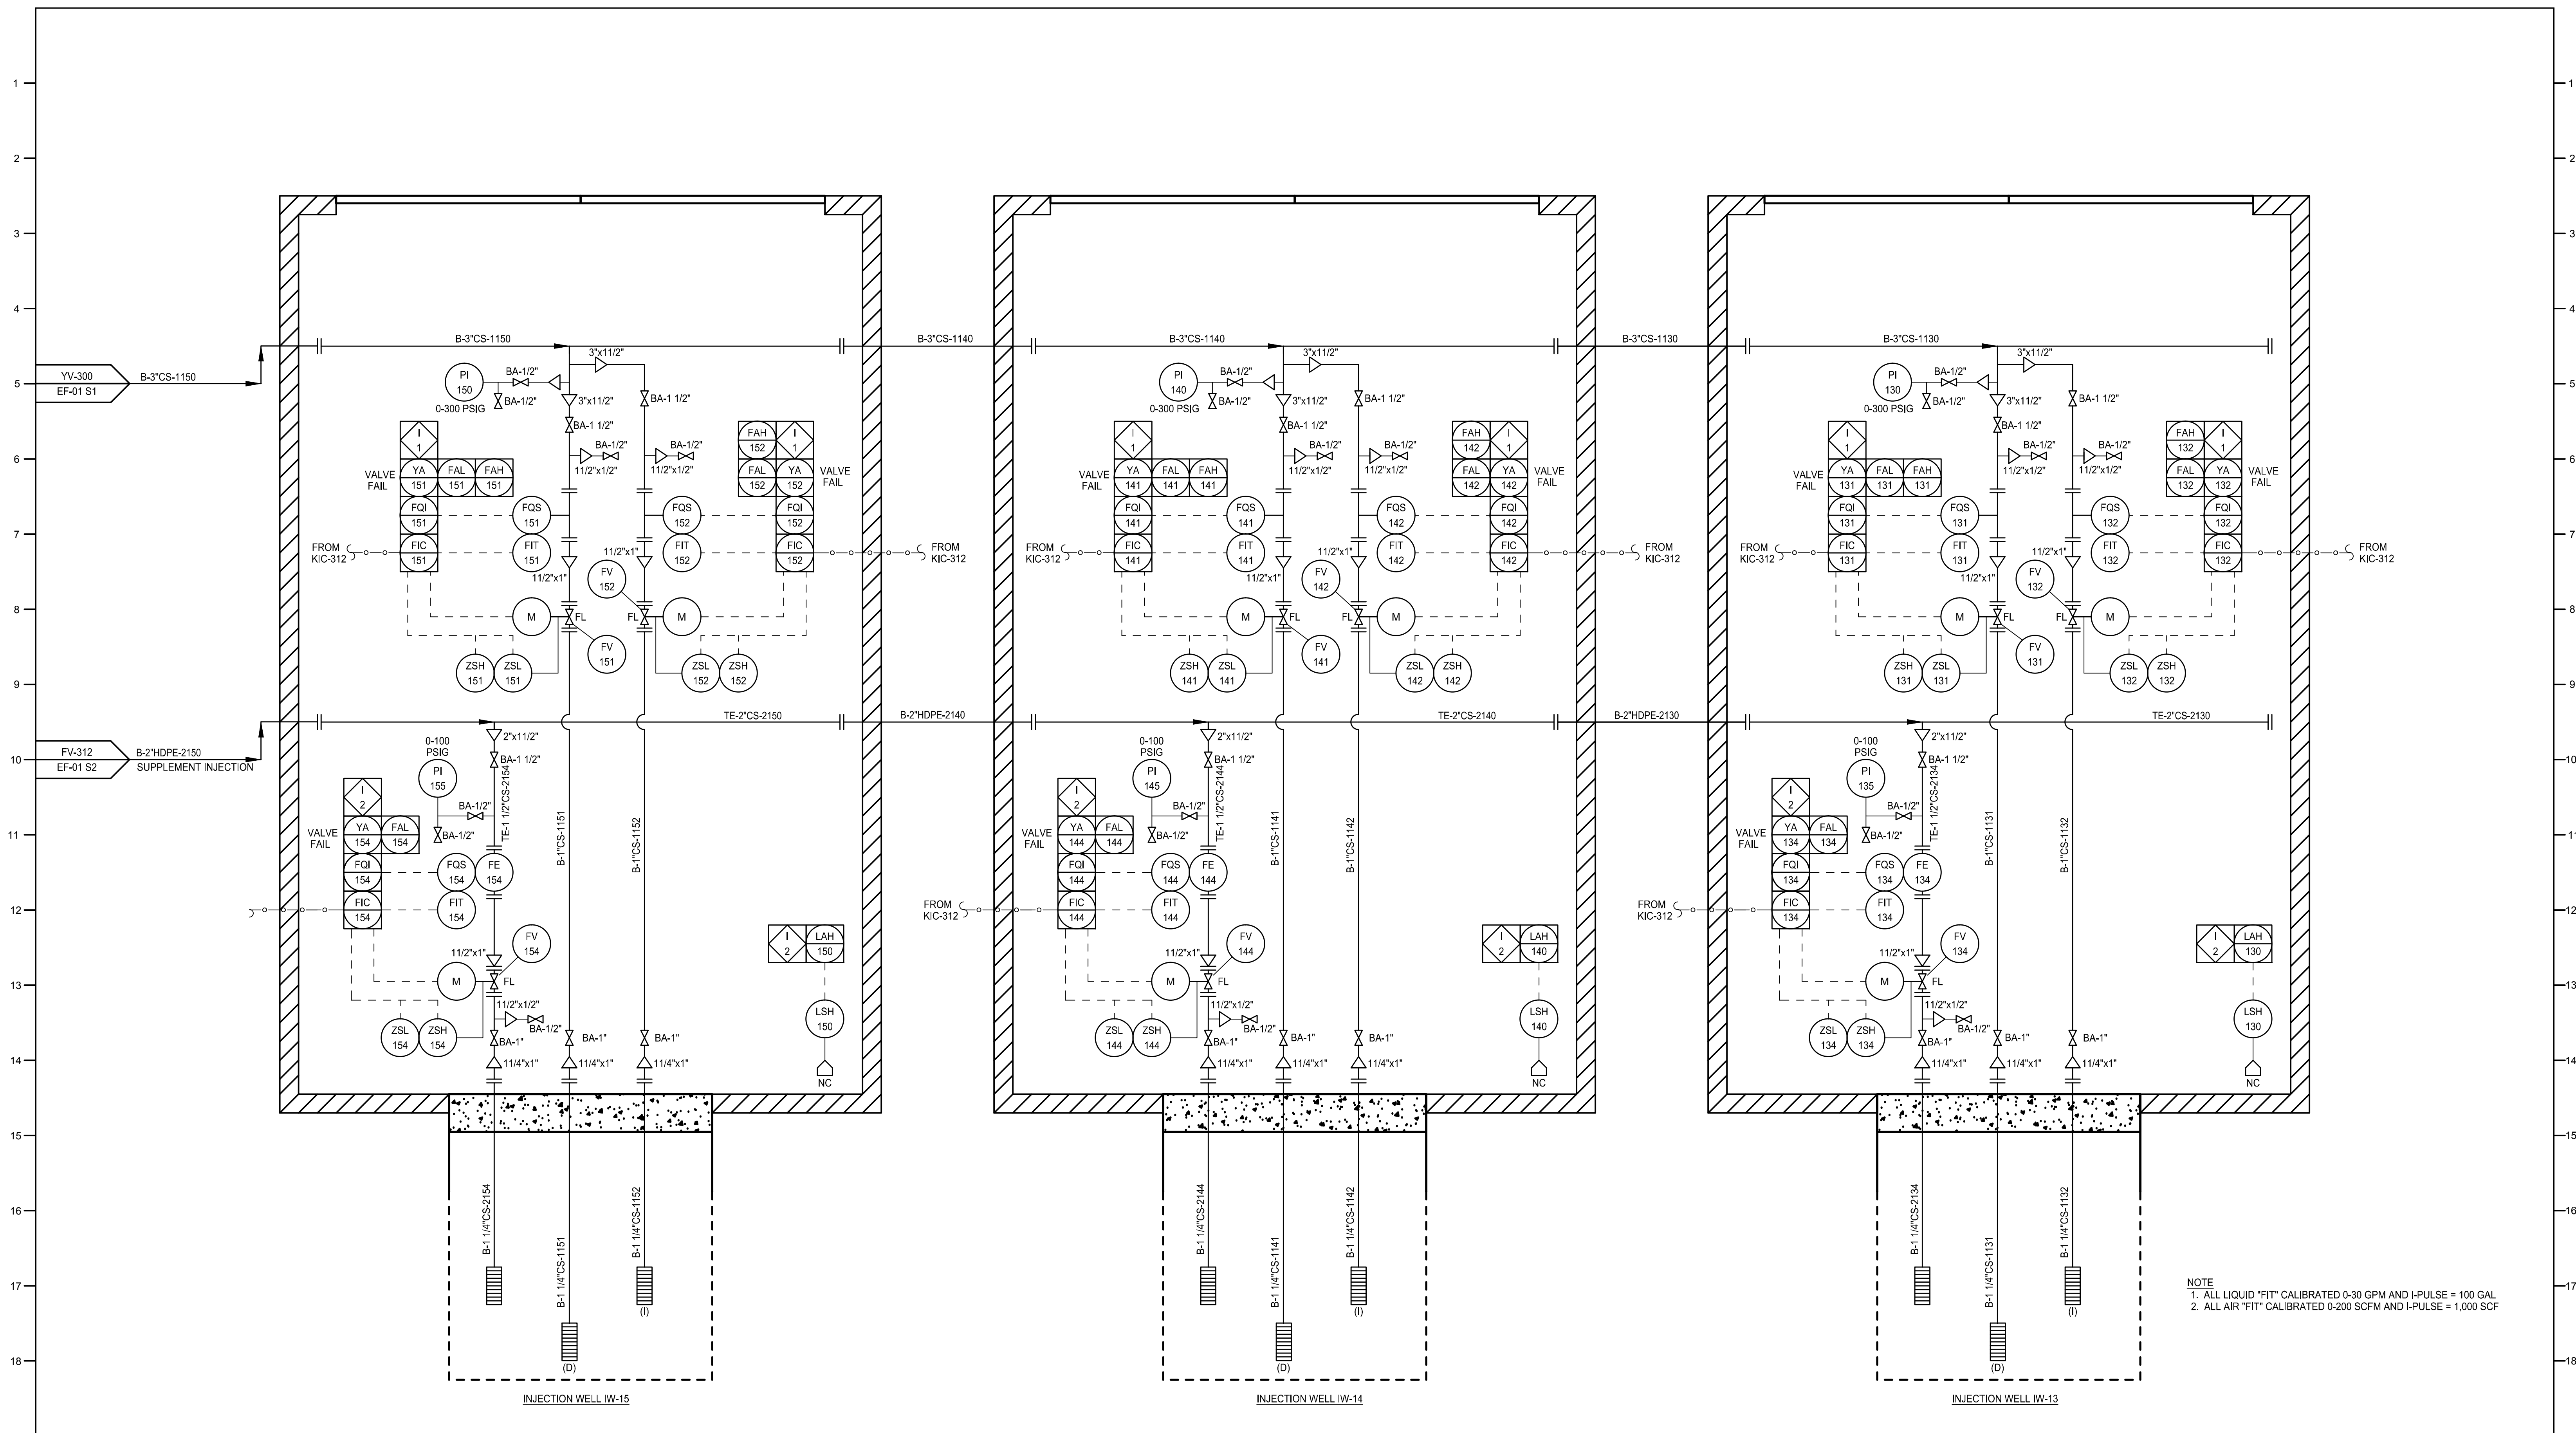

PLANT ID:		1	2	3	4	5	6	7	8	9	10	11	12							
NAME:																				
DESCRIPTION	MATERIAL:																			
	SIZE:																			
	CAPACITY:																			
	TEMP/PRESS:																			
	CRV/VS/PM:																			
	WEIGHT:																			
	MANUFACTURE:																			
	MODEL:																			
	VENDOR:																			
														1	AS BUILT		08/29/12	LV		
No	Revision												Date	Initial						

**AS BUILT  
RECORD DRAWING**



**CRA Infrastructure  
& Engineering, Inc.**

Source Reference:

SEPTEMBER 2003

Project Manager:  
J. KAY

Reviewed By:

Designed By:

own By:

Scale:

Project No:

Report No:

Drawing No:

HOOKER/RUCO SITE  
HICKSVILLE, NEW YORK


BIOSPARGE TREATMENT SYSTEM

## ENGINEERING FLOW SHEET

### MIDDLE FENCE INJECTION WELLS



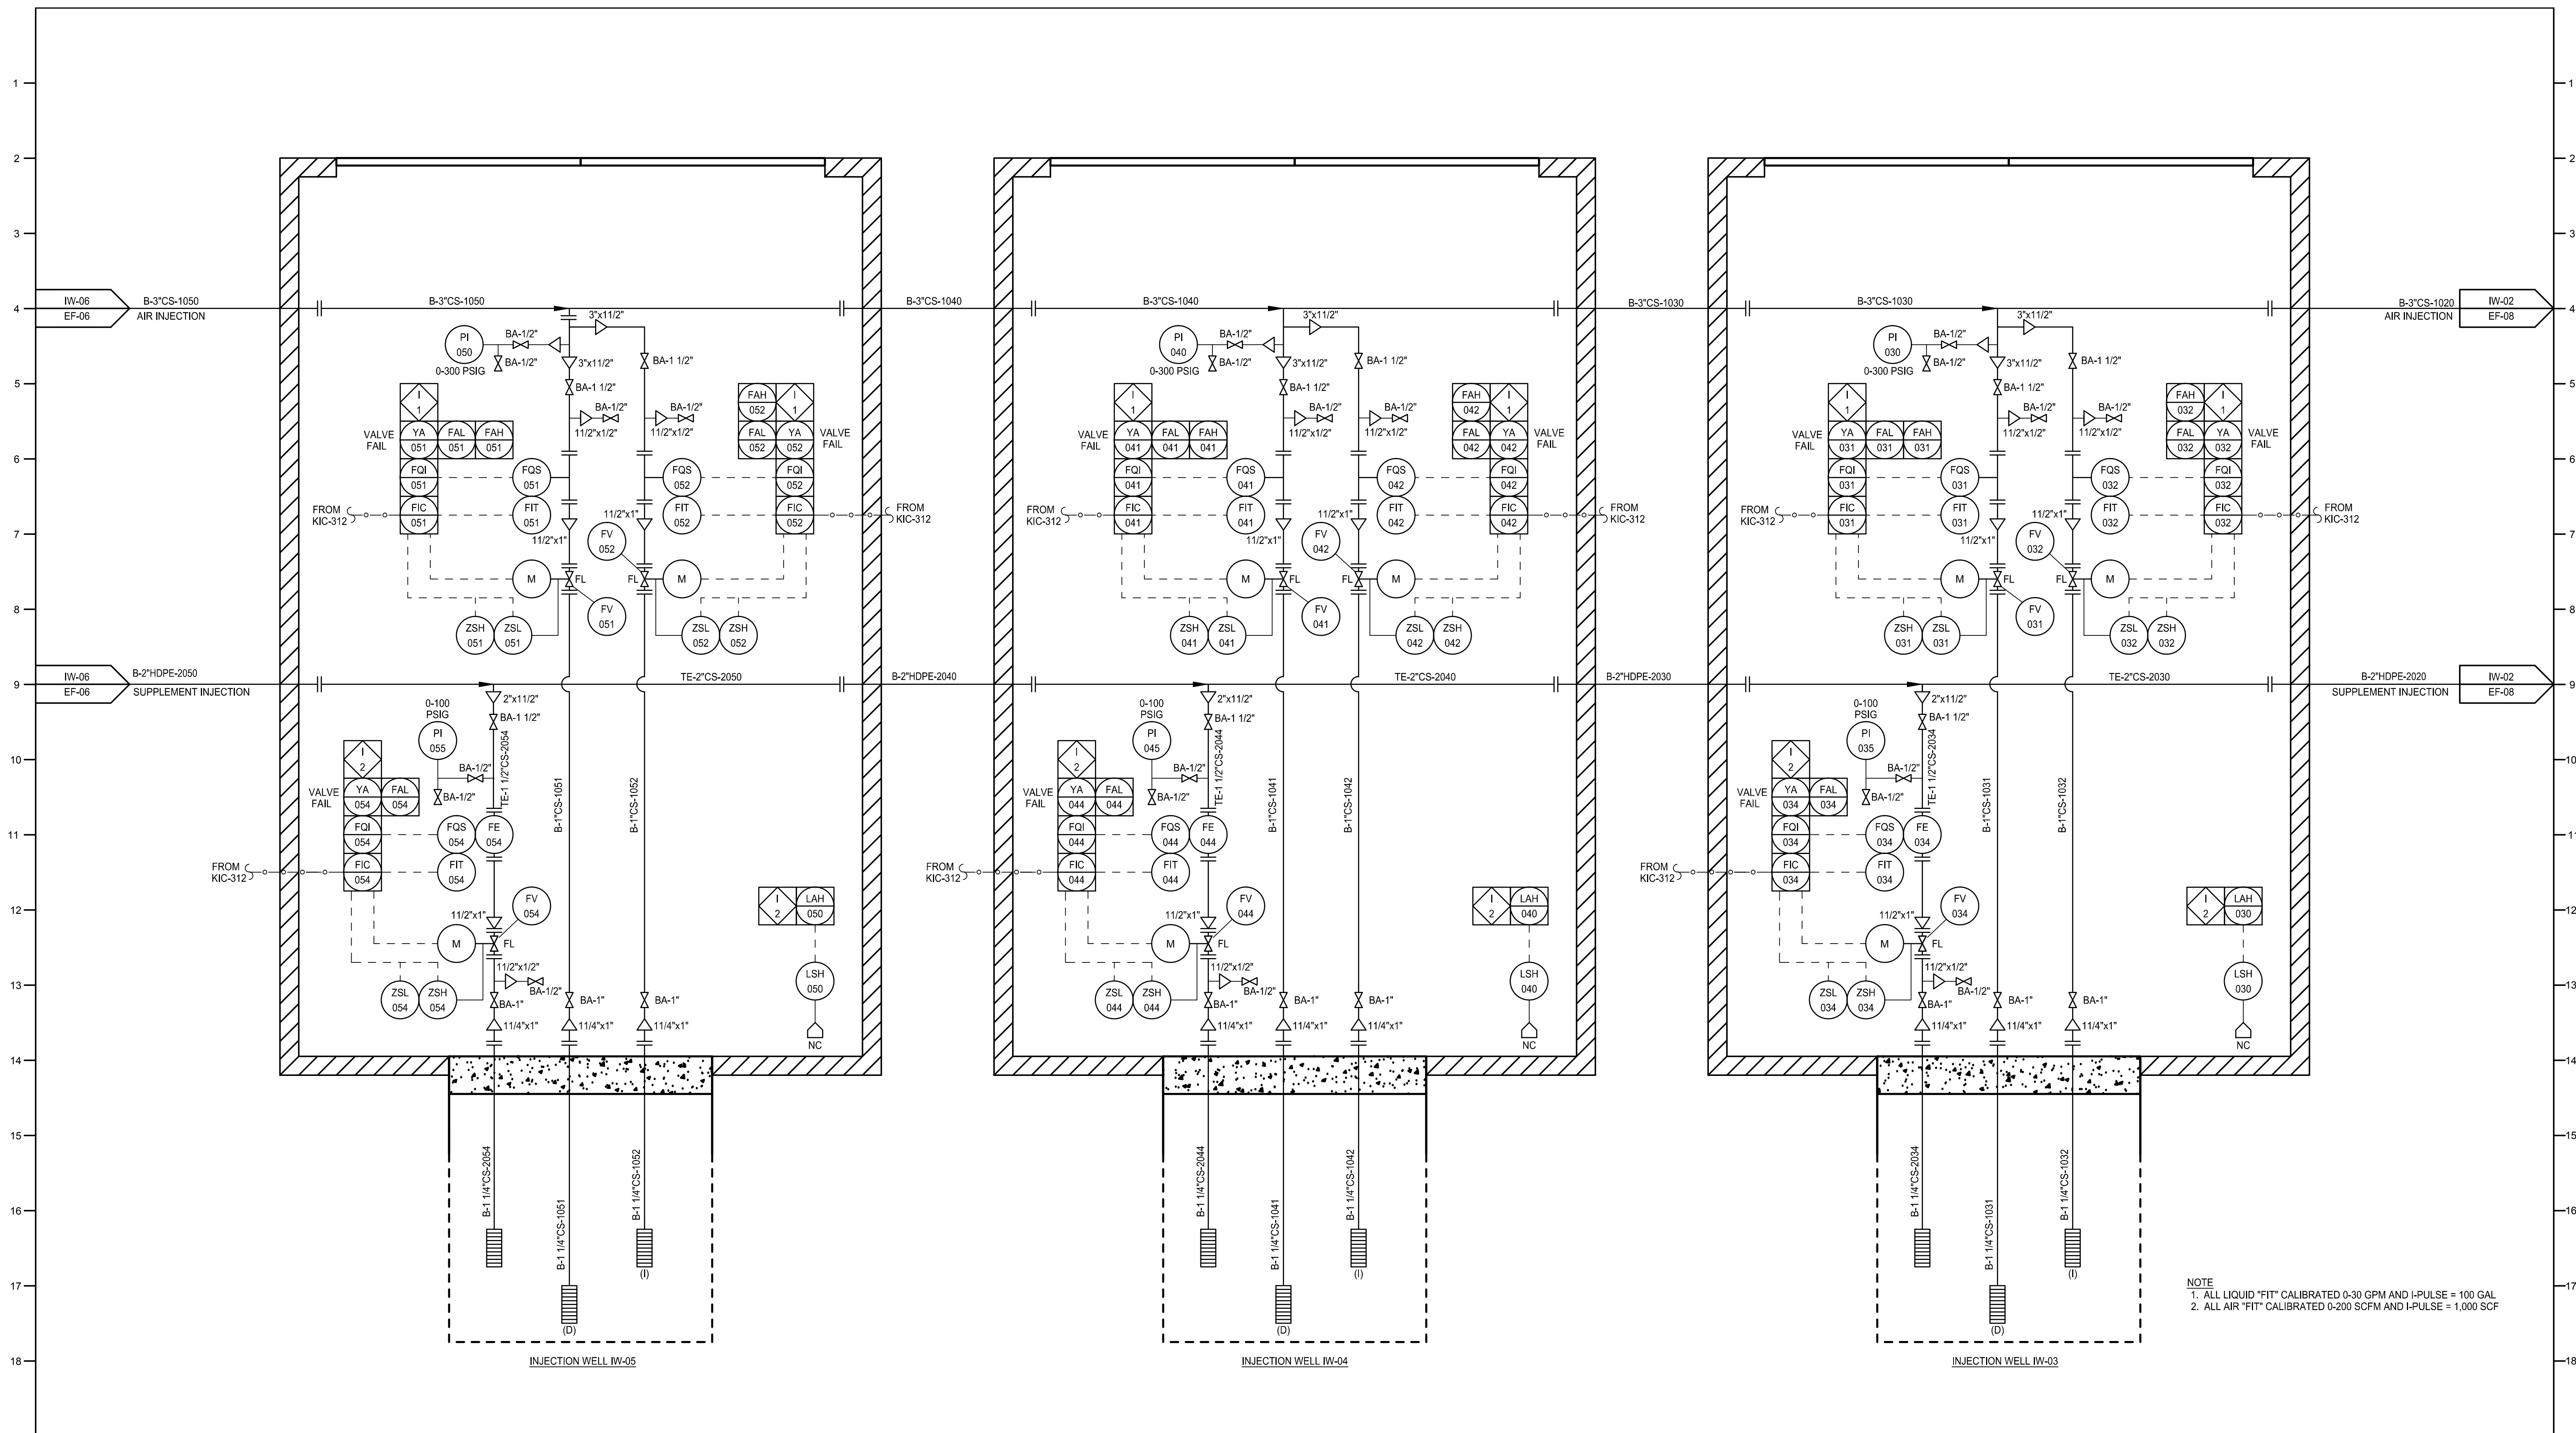

[illegible]

**AS BUILT  
RECORD DRAWING**

**CRA Infrastructure  
& Engineering, Inc.**

Source Reference:

SEPTEMBER 2003

Project Manager:  
J. KAY

Reviewed By:

Designed By:  
B.A. BEEBE

own By:  
B.A. BEEBE

Scale:

Project No:  
06883-0

Report No: 056


Wing No:	EF-07
----------	-------

HOOKE/RUCO SITE  
HICKSVILLE, NEW YORK

BIOSPARGE TREATMENT SYSTEM


## ENGINEERING FLOW SHEET

### NORTH FENCE INJECTION WELLS

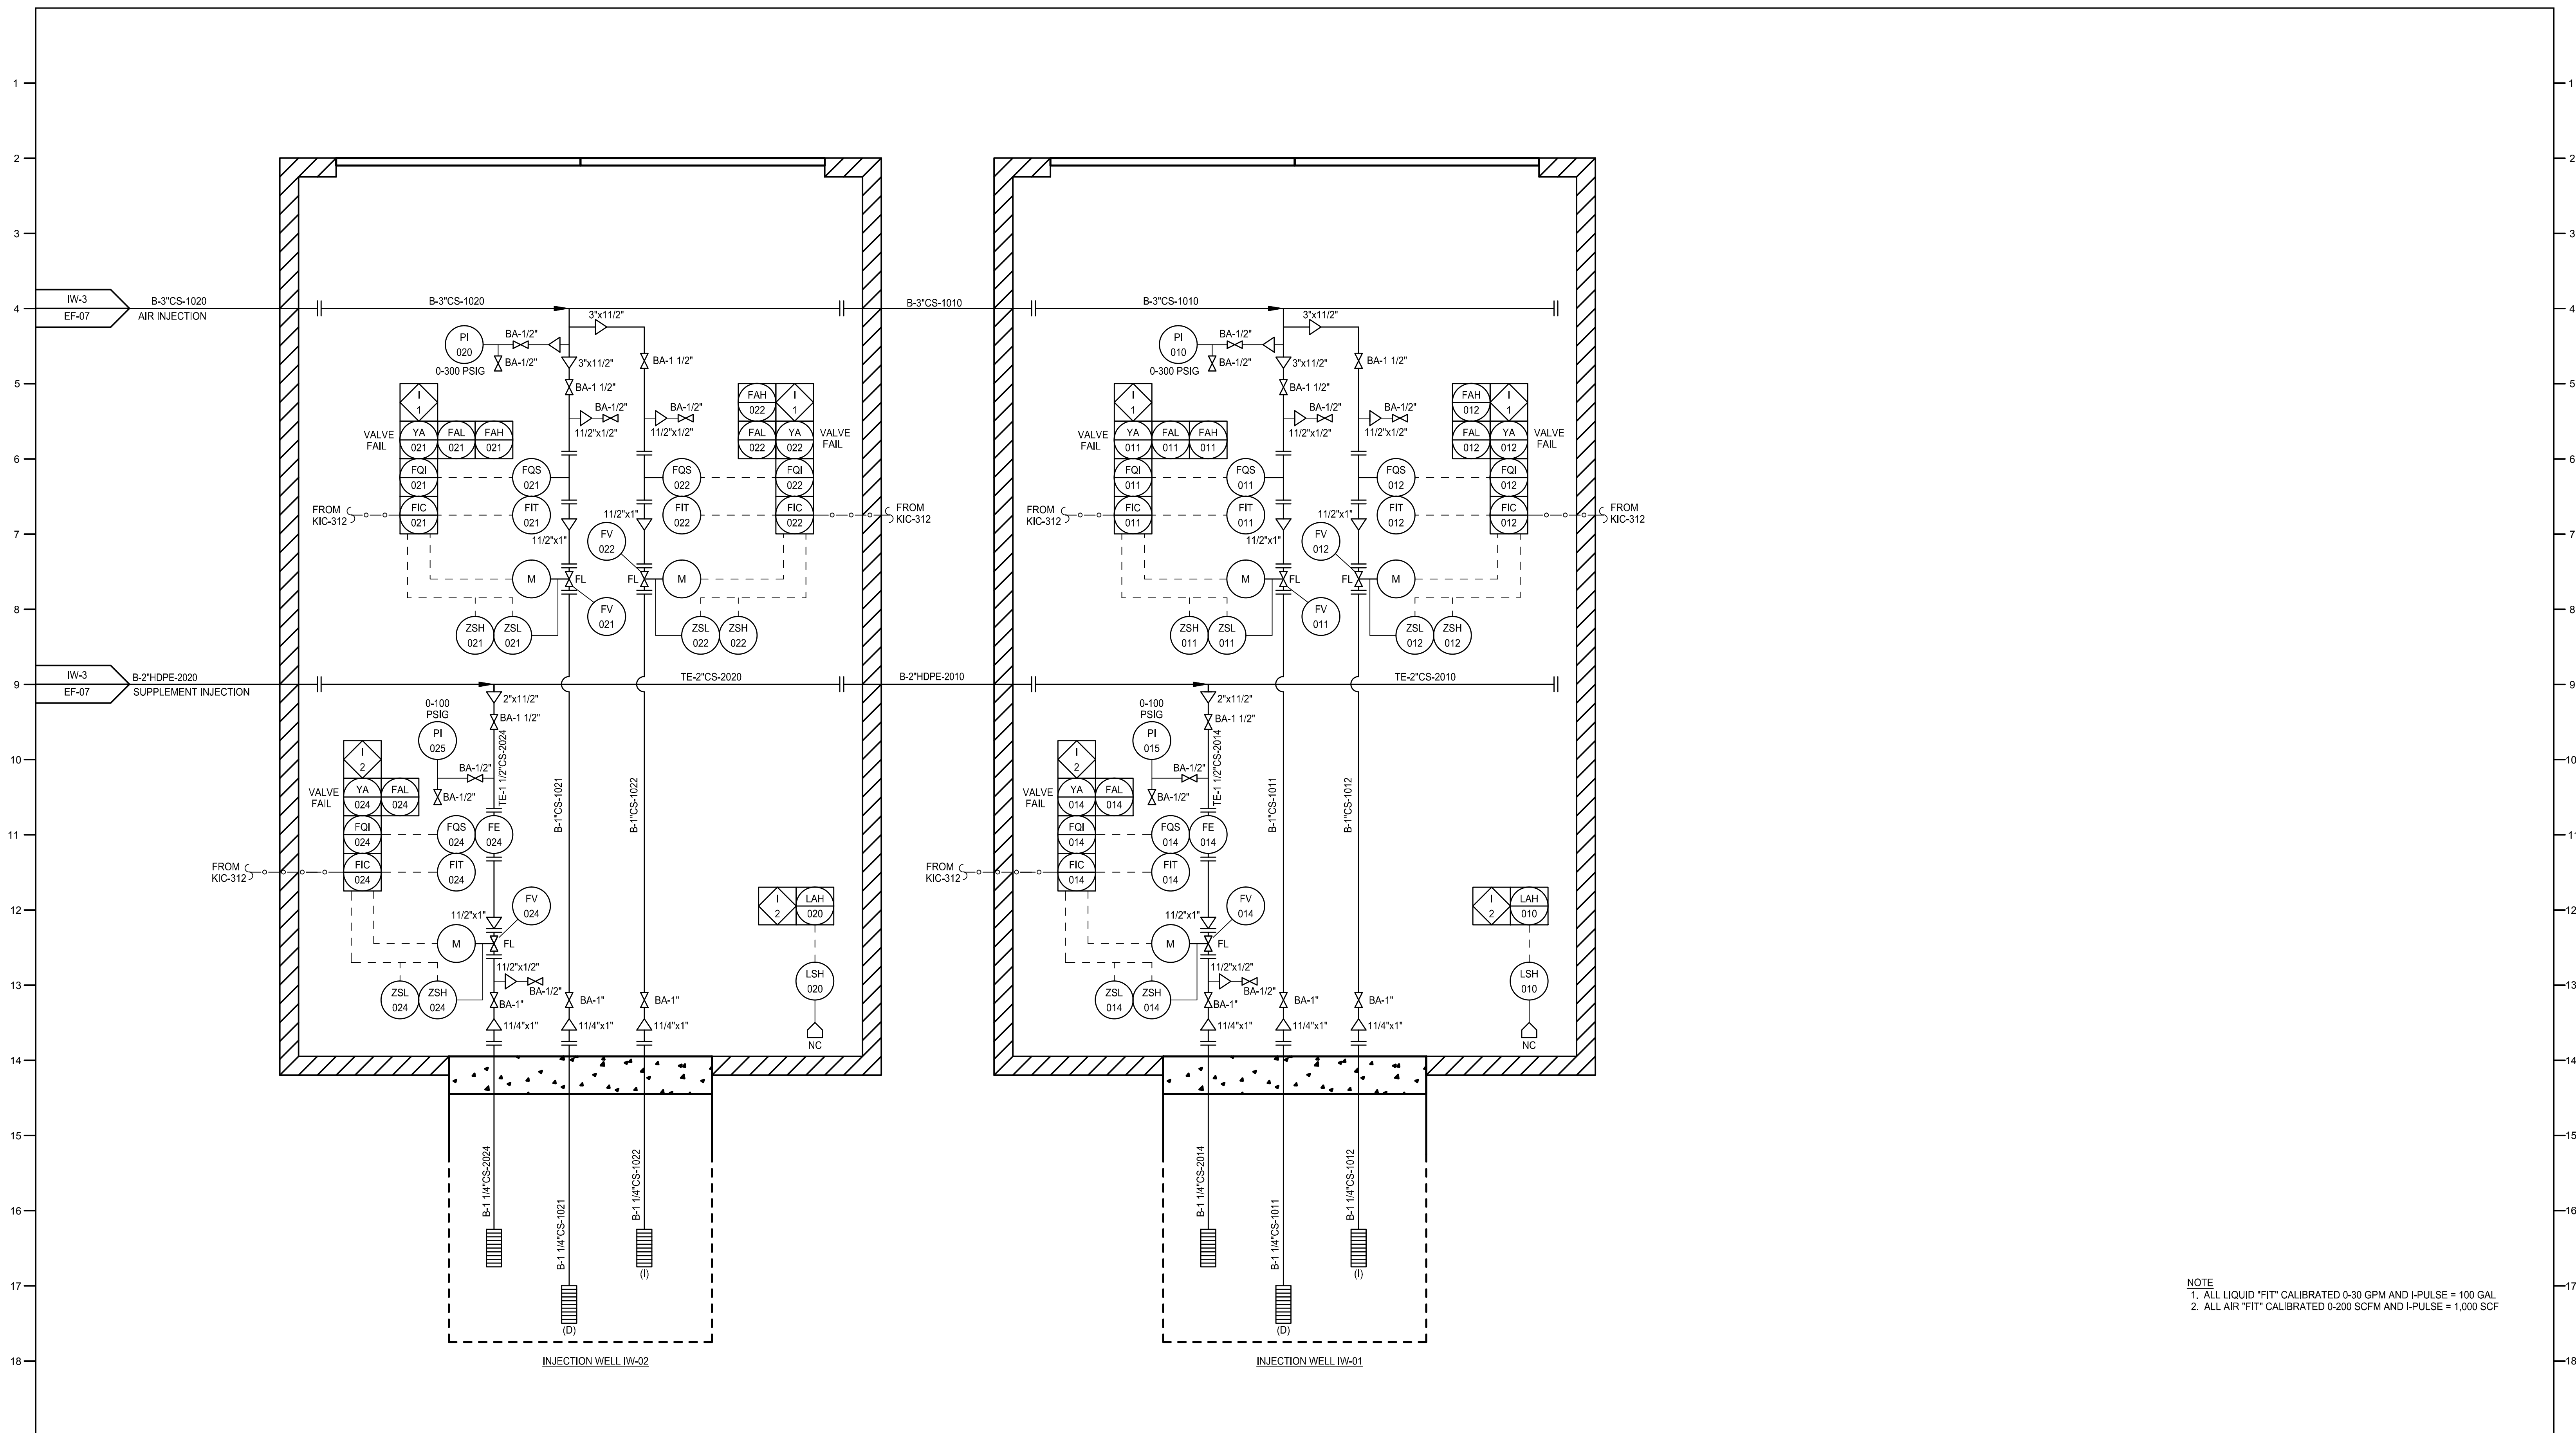

PLANT ID:		1	2	3	4	5	6	7	8	9	10	11	12				
NAME																	
DESCRIPTION	MATERIAL																
	SIZE																
	CAPACITY																
	TEMP/PRESS																
	CRV/VS/PM																
	WEIGHT																
	MANUFACTURE																
	MODEL																
	VENDOR																
														1	AS BUILT	08/29/12	LV
														No	Revision	Date	Initial

**AS BUILT  
RECORD DRAWING**

<p style="text-align: center;">HOOKER/RUCO SITE HICKSVILLE, NEW YORK</p>	<div style="display: flex; align-items: center;">  <div> <p><b>CRA Infrastructure &amp; Engineering, Inc.</b></p> </div> </div>								
<p style="text-align: center;">BIOSPARGE TREATMENT SYSTEM</p>	<div style="display: flex; justify-content: space-between;"> <span>Source Reference:</span> <span>Date: SEPTEMBER 2003</span> </div>								
<p style="text-align: center;">ENGINEERING FLOW SHEET NORTH FENCE INJECTION WELLS</p>	<table border="1" style="width: 100%; border-collapse: collapse;"> <tr> <td style="width: 25%;">Project Manager: J. KAY</td> <td style="width: 25%;">Reviewed By: B. A. BEEBE</td> <td style="width: 25%;">Designed By: B. A. BEEBE</td> <td style="width: 25%;">Drawn By: B. A. BEEBE</td> </tr> <tr> <td>Scale:</td> <td>Project No: 06883-00</td> <td>Report No: 056</td> <td>Drawing No: EF-08</td> </tr> </table>	Project Manager: J. KAY	Reviewed By: B. A. BEEBE	Designed By: B. A. BEEBE	Drawn By: B. A. BEEBE	Scale:	Project No: 06883-00	Report No: 056	Drawing No: EF-08
Project Manager: J. KAY	Reviewed By: B. A. BEEBE	Designed By: B. A. BEEBE	Drawn By: B. A. BEEBE						
Scale:	Project No: 06883-00	Report No: 056	Drawing No: EF-08						




WARNING: ALTERING THIS DOCUMENT IS  
IN VIOLATION OF THE NEW YORK STATE  
EDUCATION LAW EXCEPTING AS PROVIDED  
IN SECTION 7209, PART 2 OF THE LAW.



Source Reference:			Date: OCTOBER 2010
Project Manager: J. KAY	Reviewed By:	Designed By:	Drawn By: L. VAN NOTE
Scale: 1" = 40'	Project No: 06883-00	Report No: 056	Drawing No: MP-01





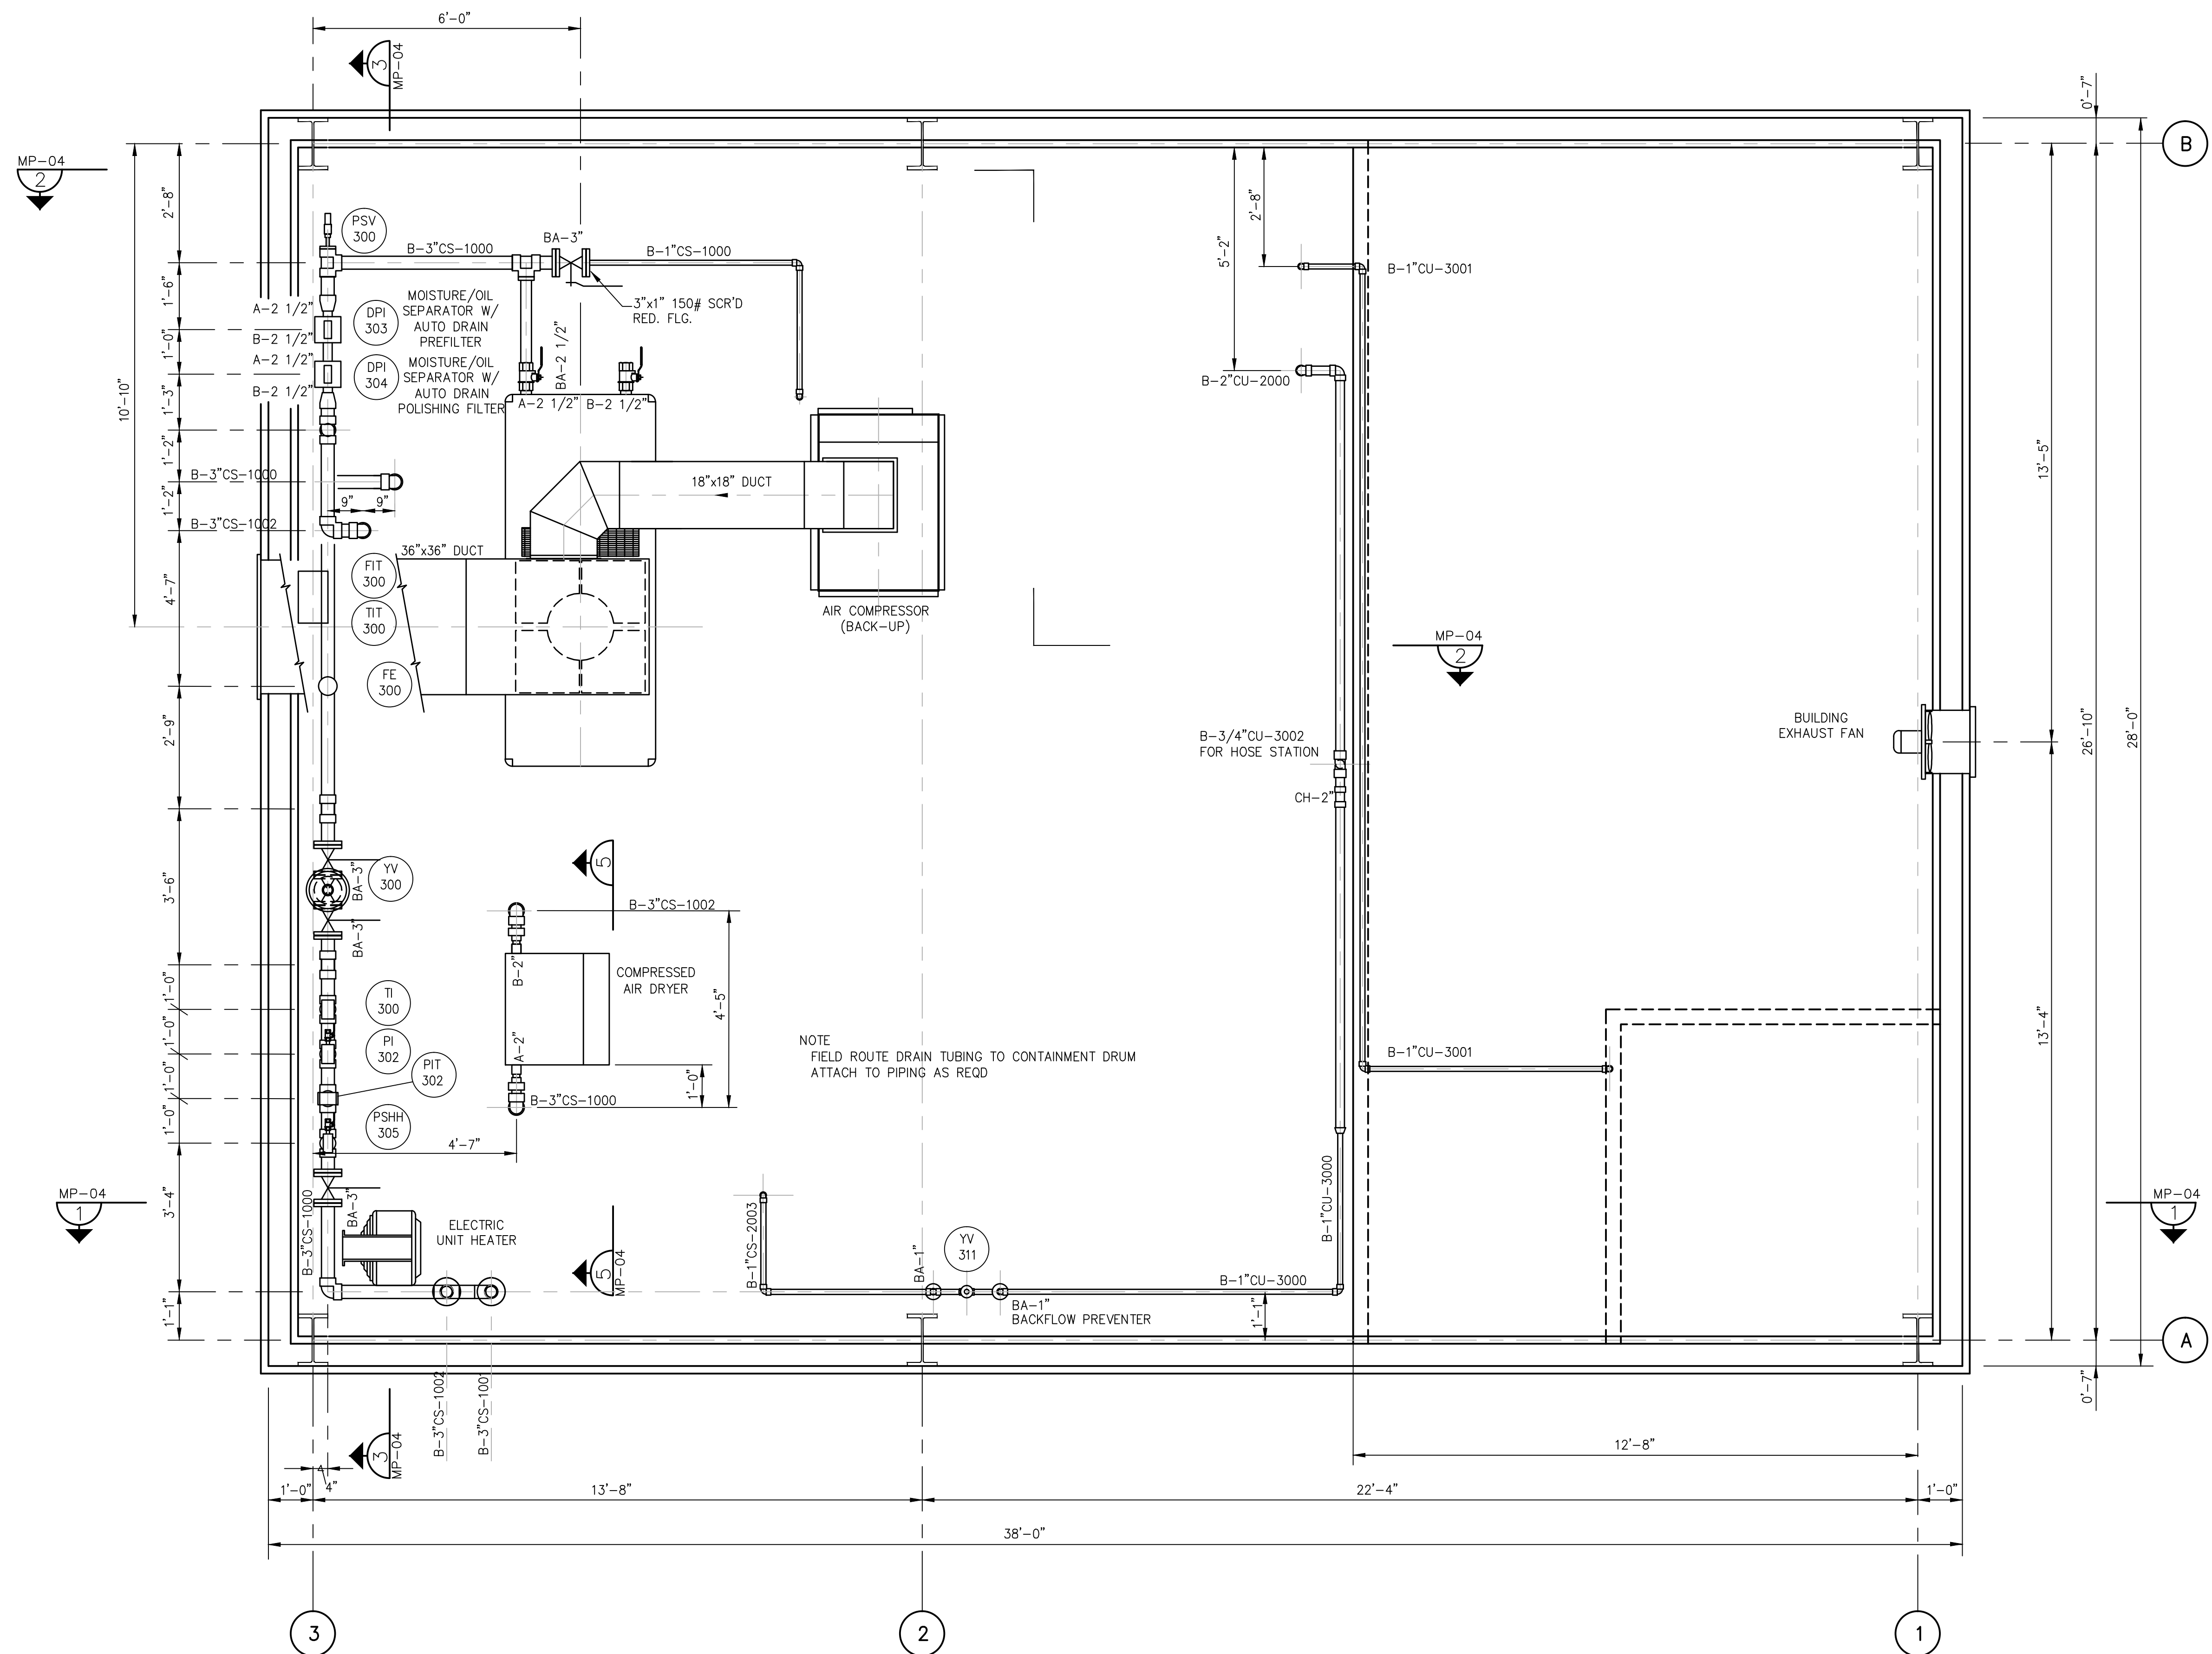


06883-00(056)MP-BU003 AUG 08/201

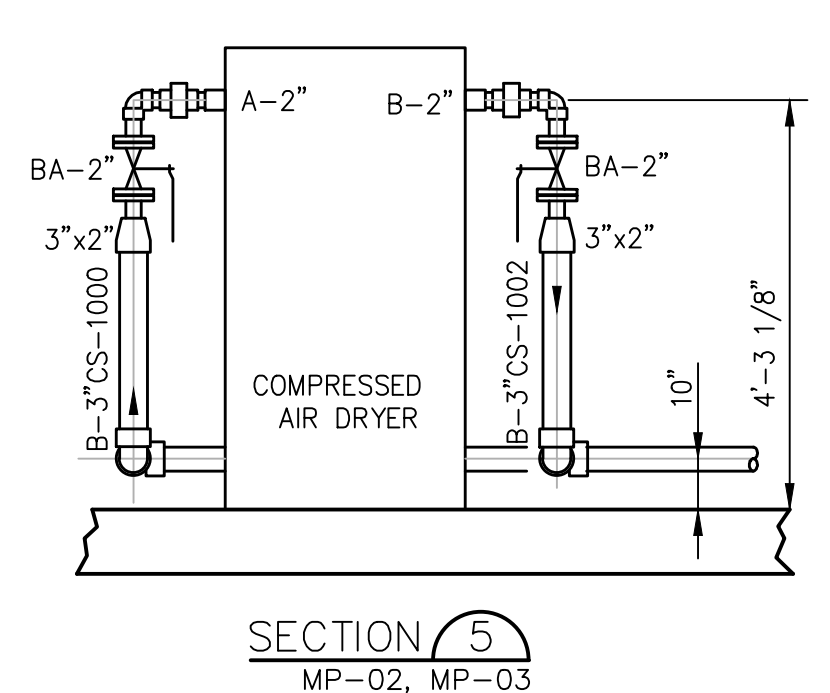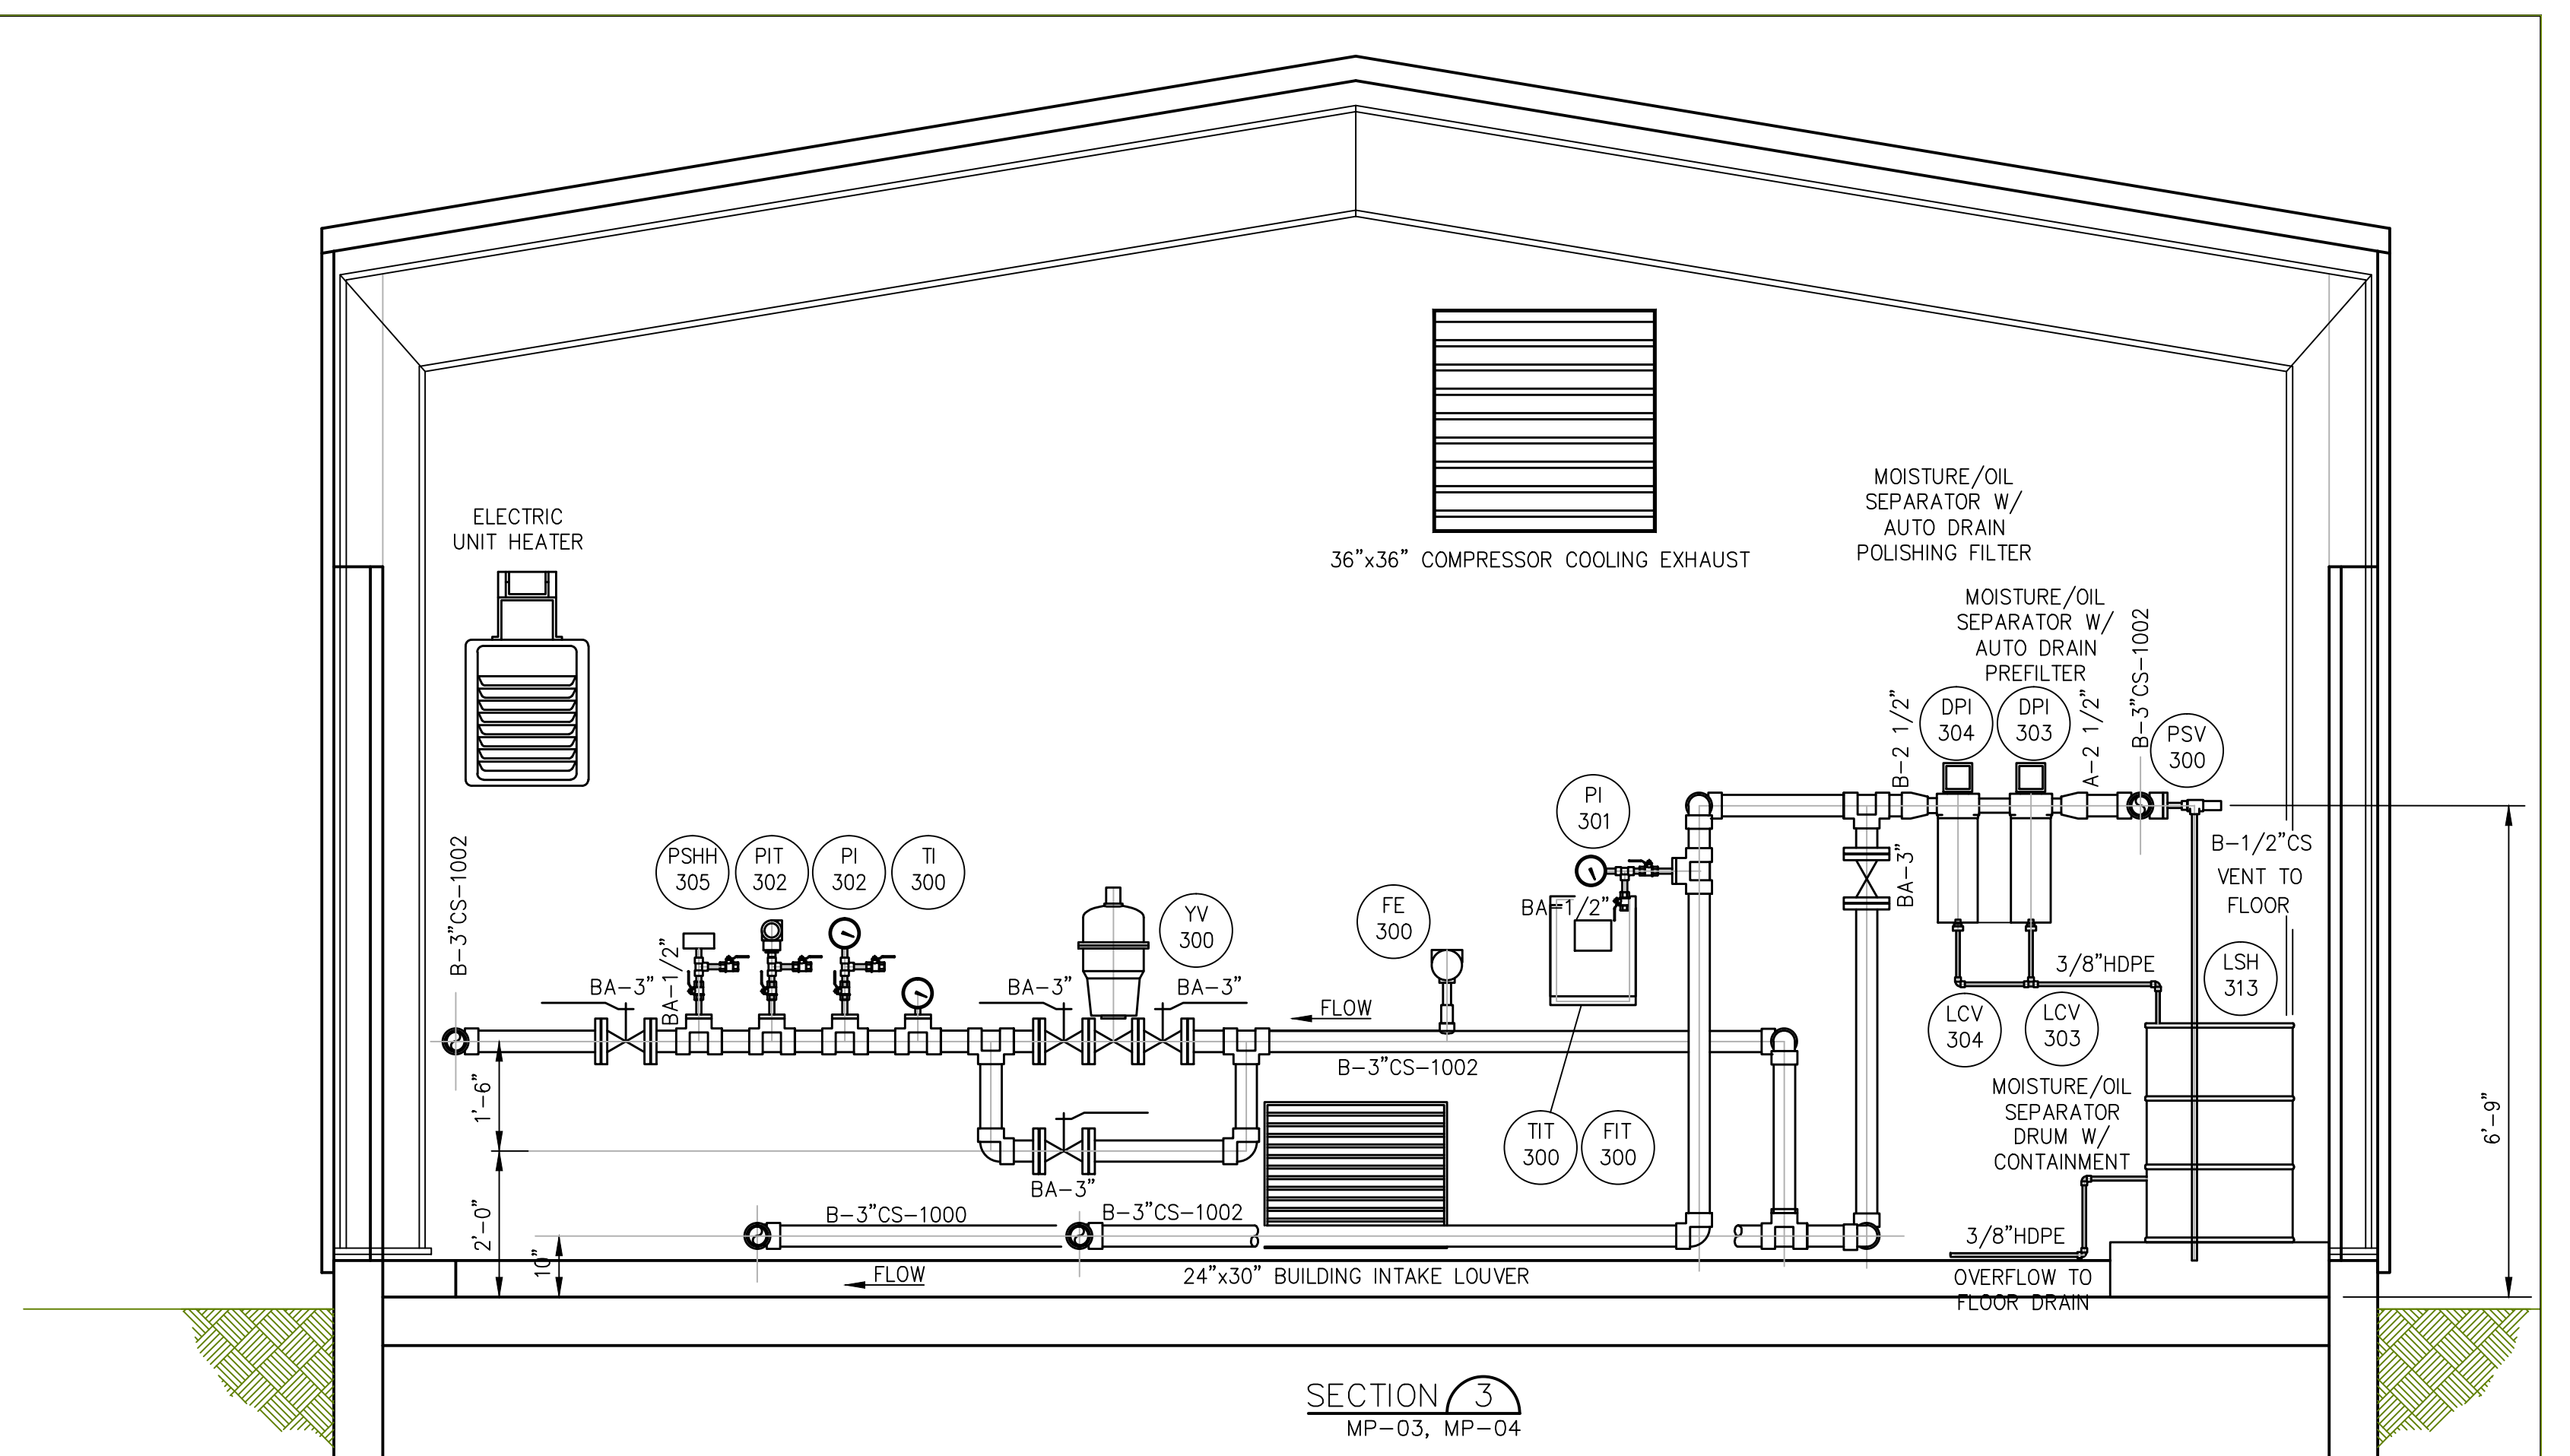


WARNING: ALTERING THIS DOCUMENT IS  
IN VIOLATION OF THE NEW YORK STATE  
EDUCATION LAW EXCEPTING AS PROVIDED  
IN SECTION 7209, PART 2 OF THE LAW.

06883-00(056)MP-BU004 AUG 08/2012




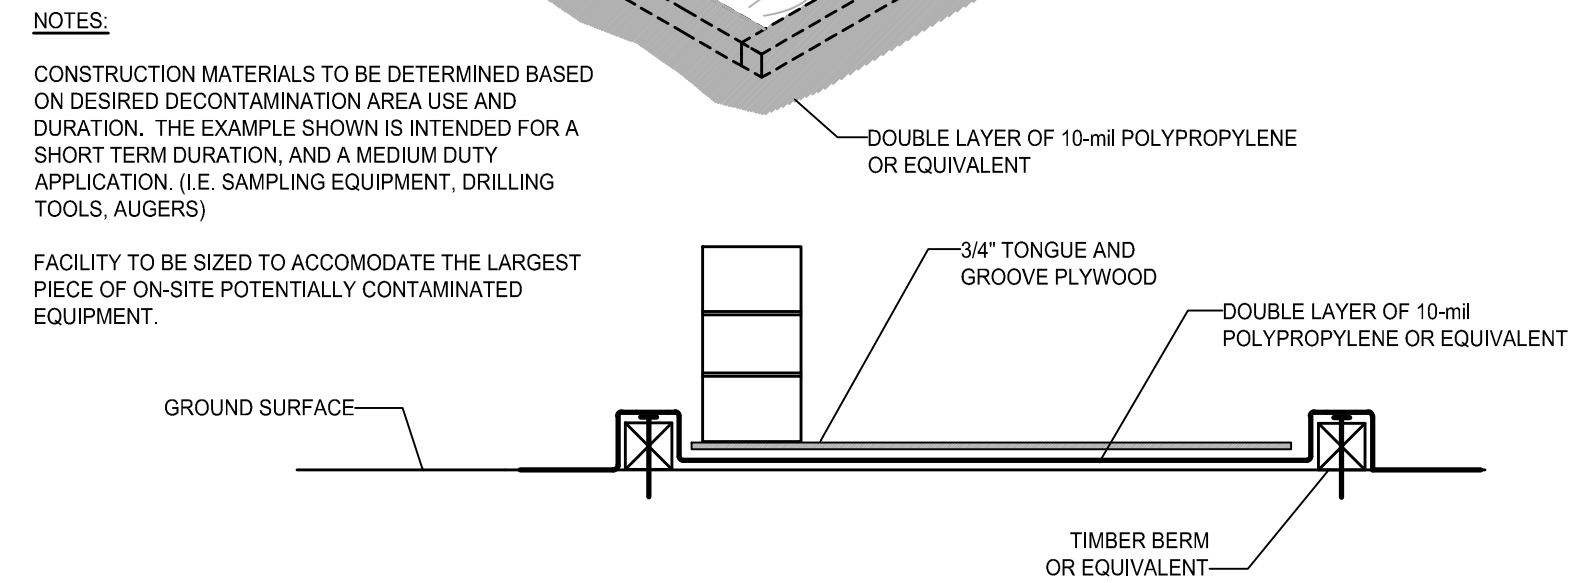

### TYPICAL DECONTAMINATION AREA (MEDIUM DUTY)

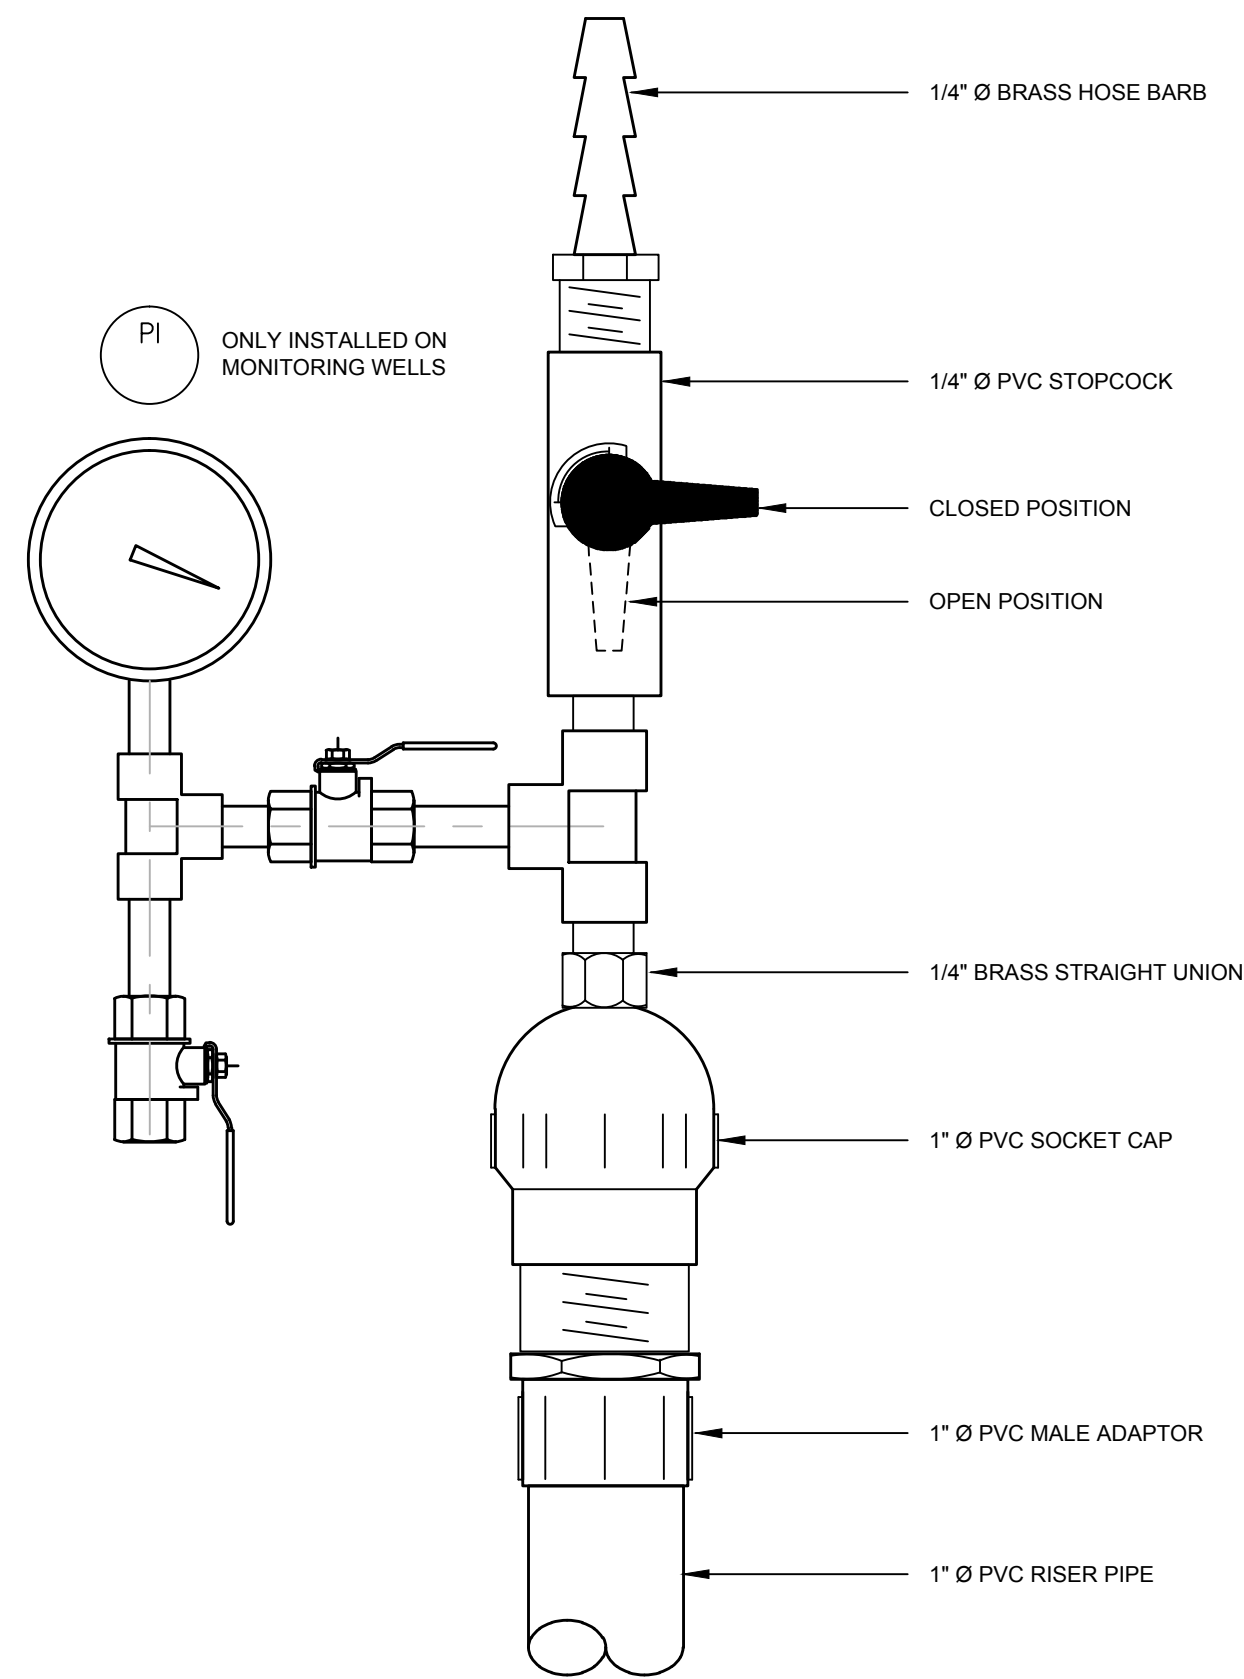


### VADOSE ZONE WELL HEAD DETAIL

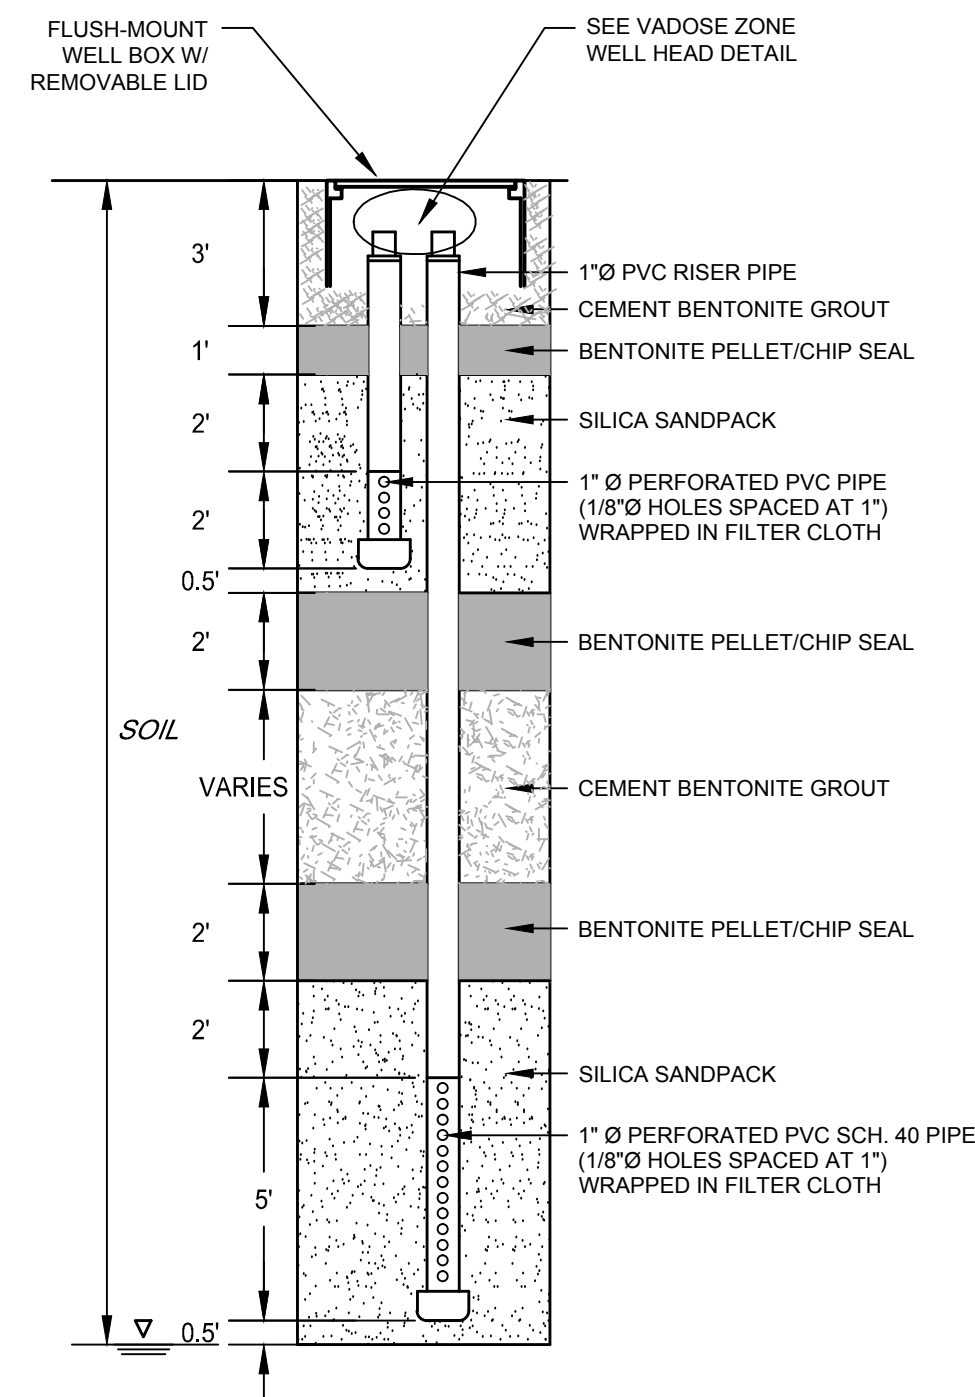


### TYPICAL VADOSE ZONE MONITORING WELL DETAIL

NOT TO SCALE


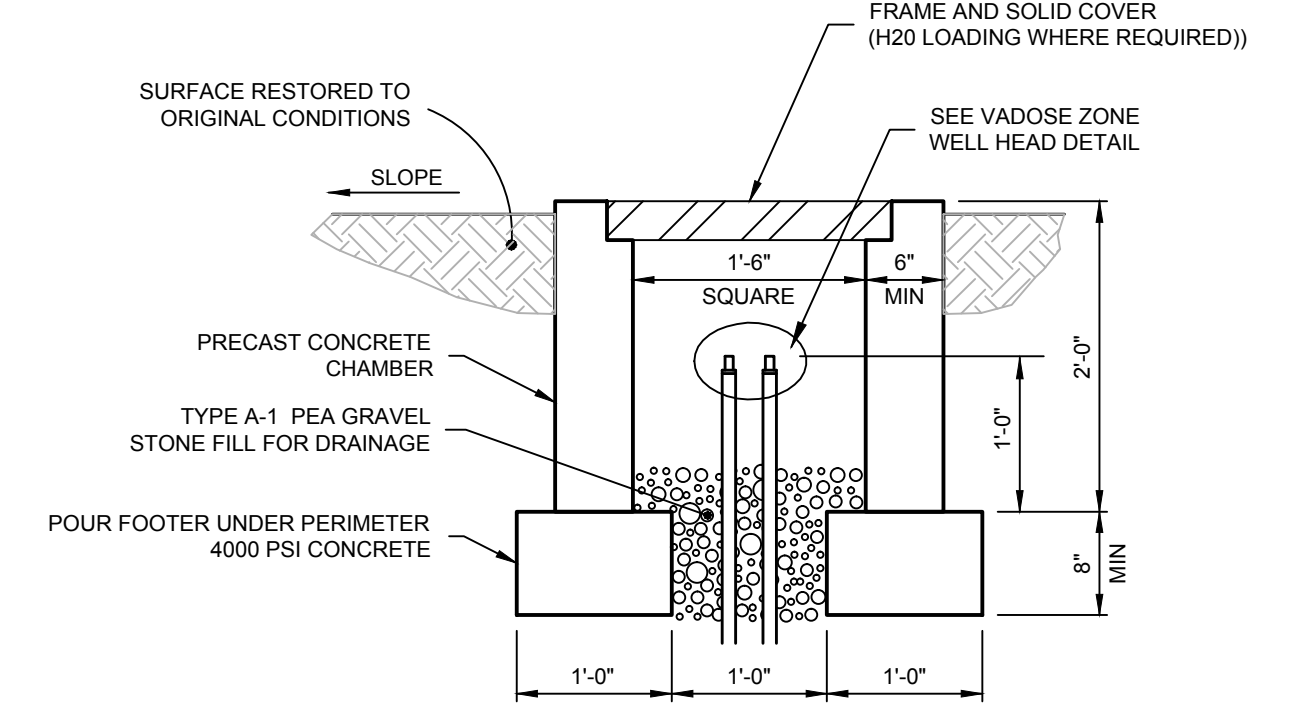


VADOSE ZONE  
MONITORING WELL VAULT

### GROUNDWATER MONITORING WELL HEAD DETAIL

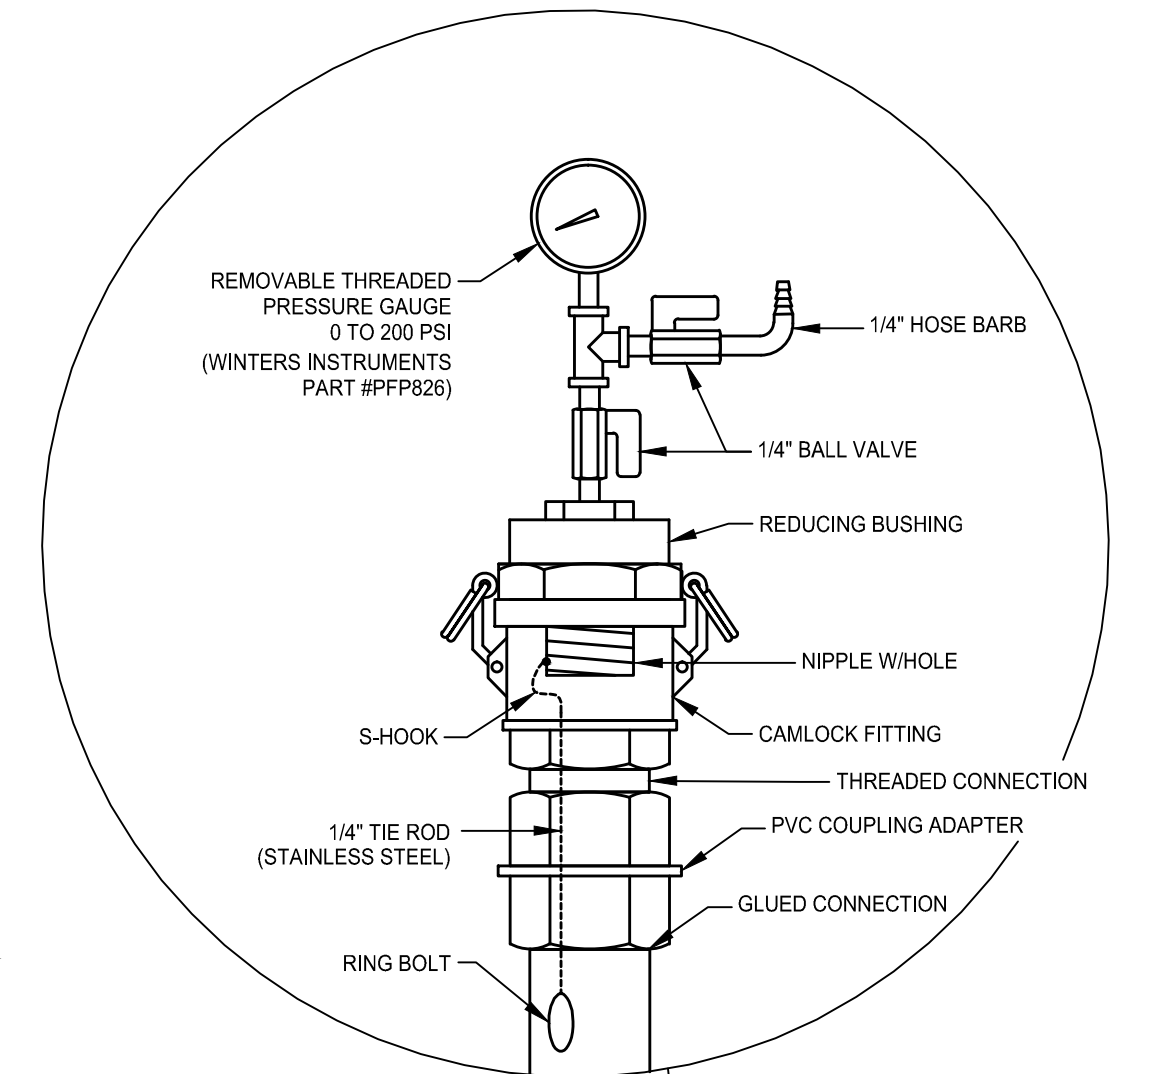


### SPACER DETAIL

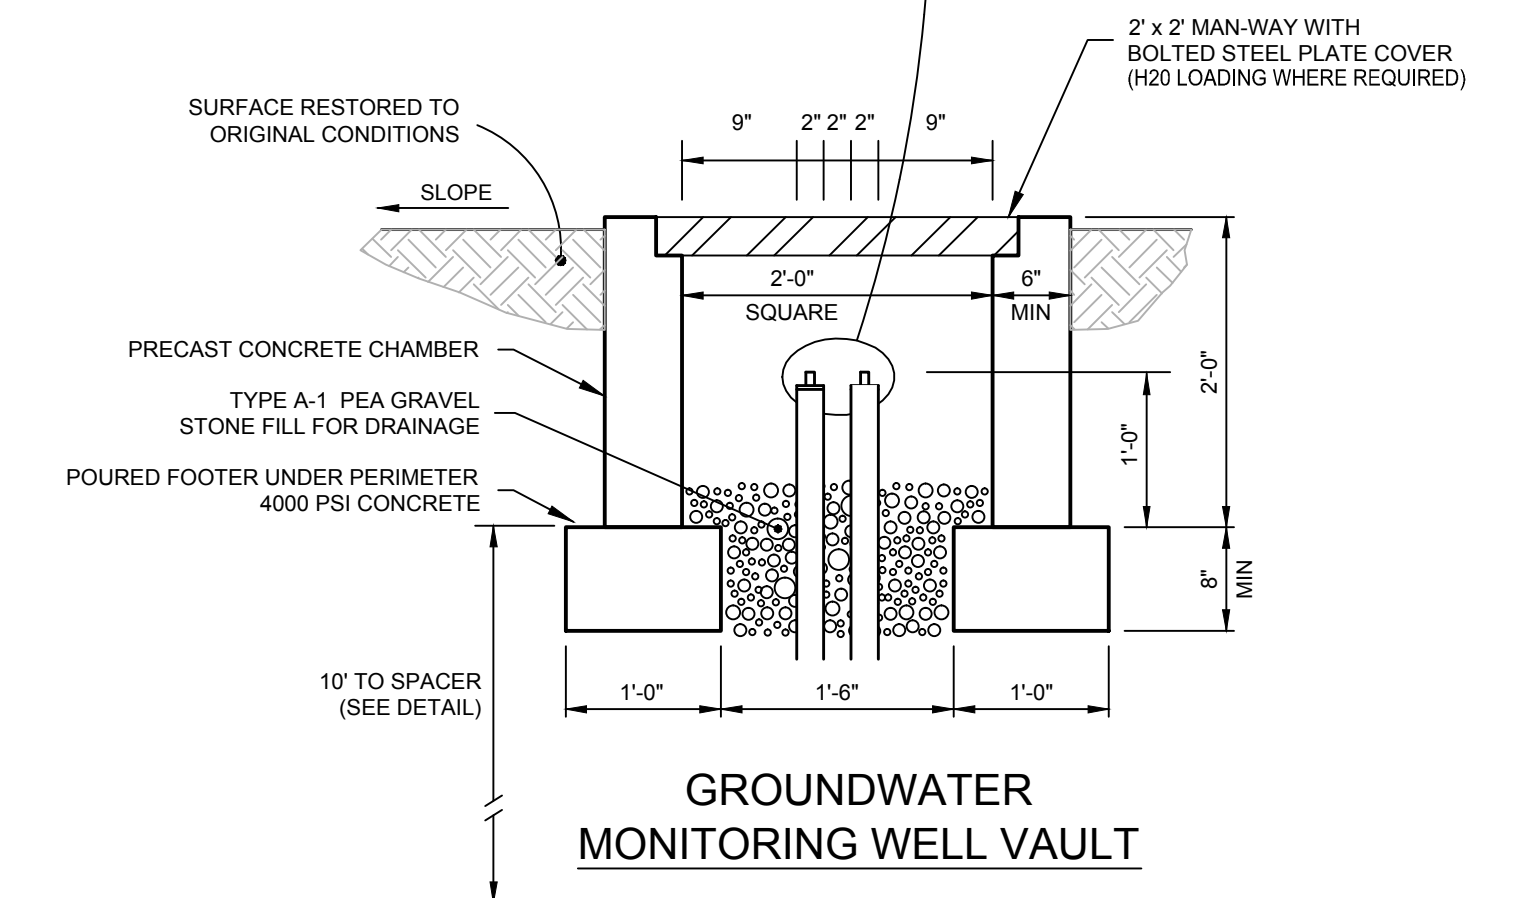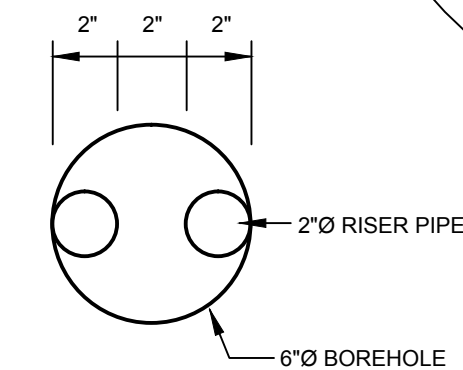


GROUNDWATER  
MONITORING WELL VAULT

**AS BUILT  
RECORD DRAWING**

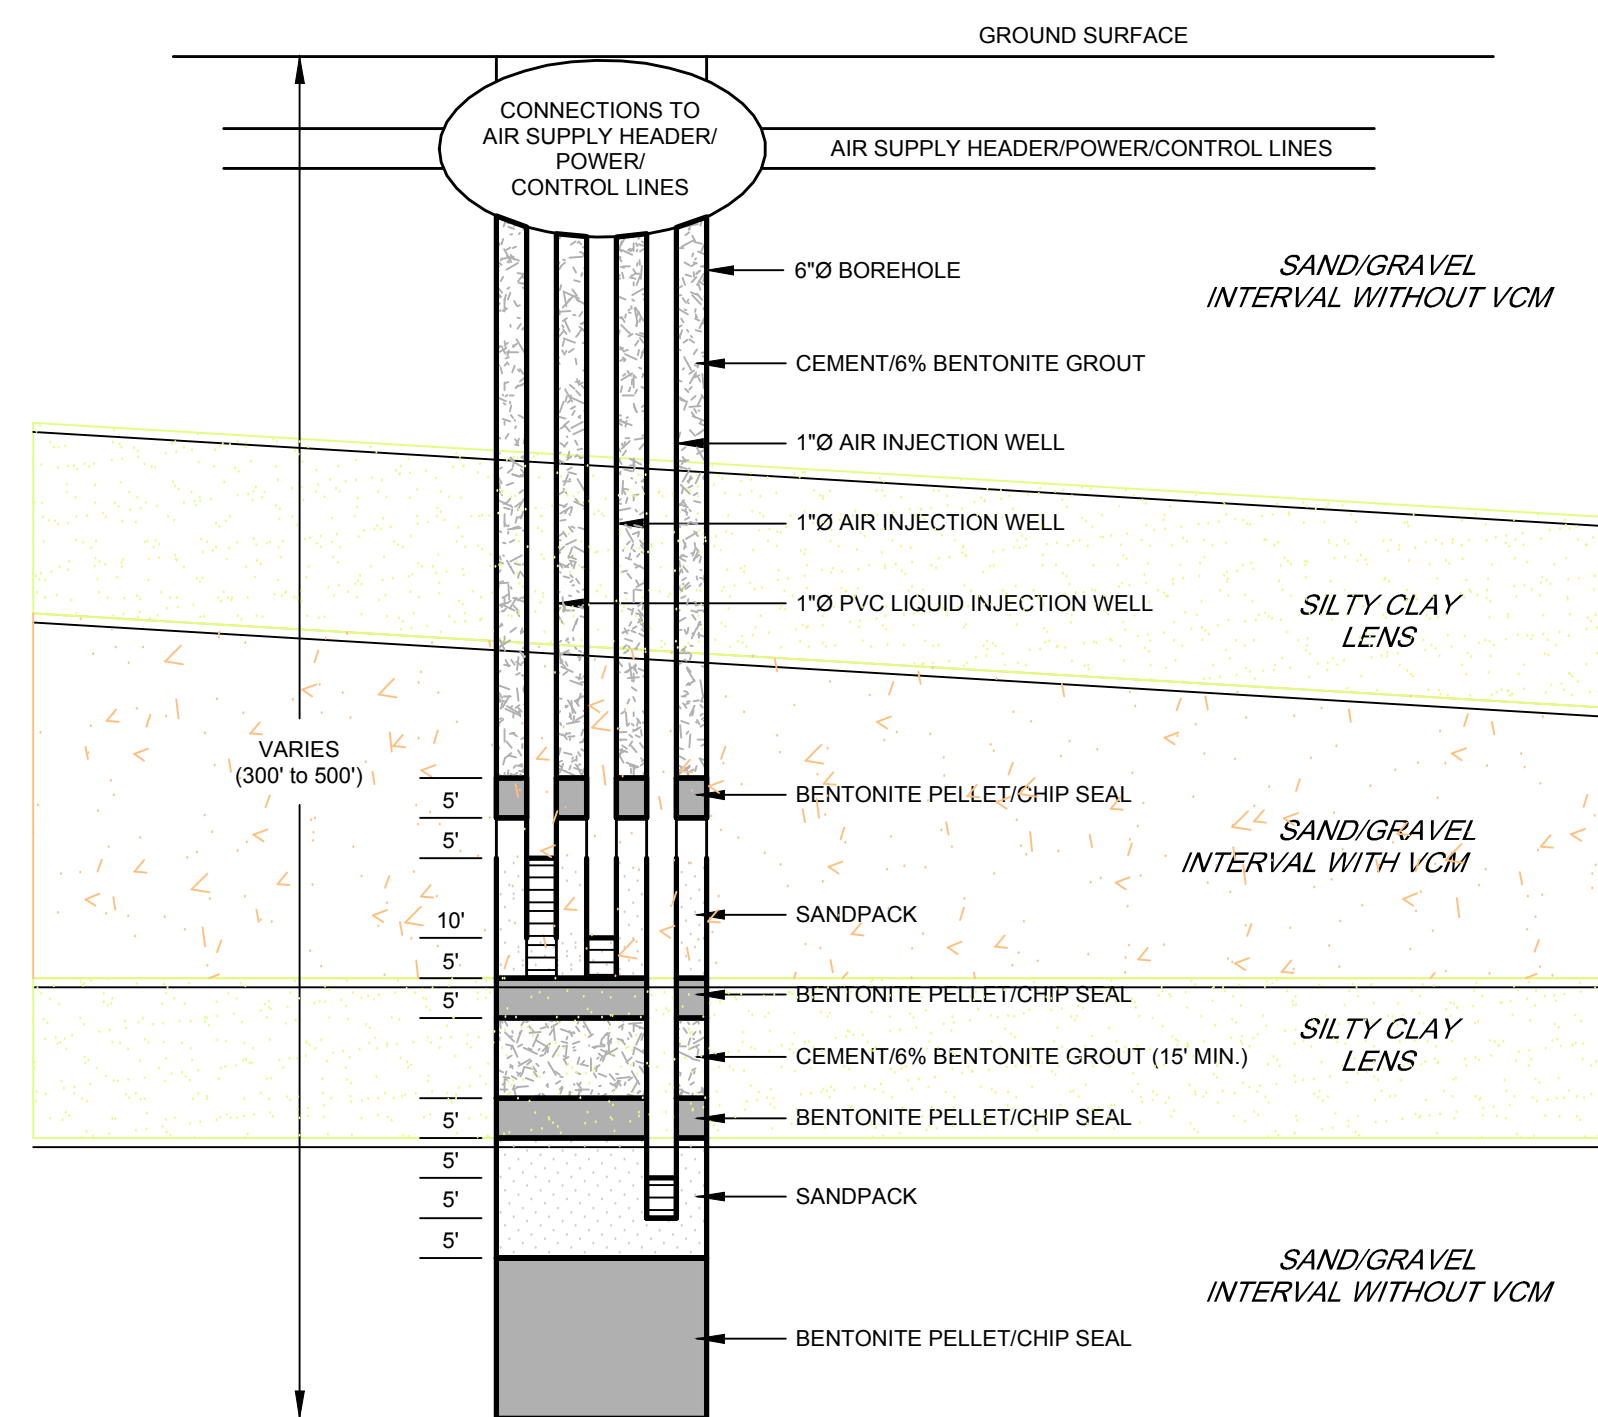


TYPICAL INJECTION WELL DETAIL  
(IW-16, 17, 18 AND 19)

NOT TO SCALE

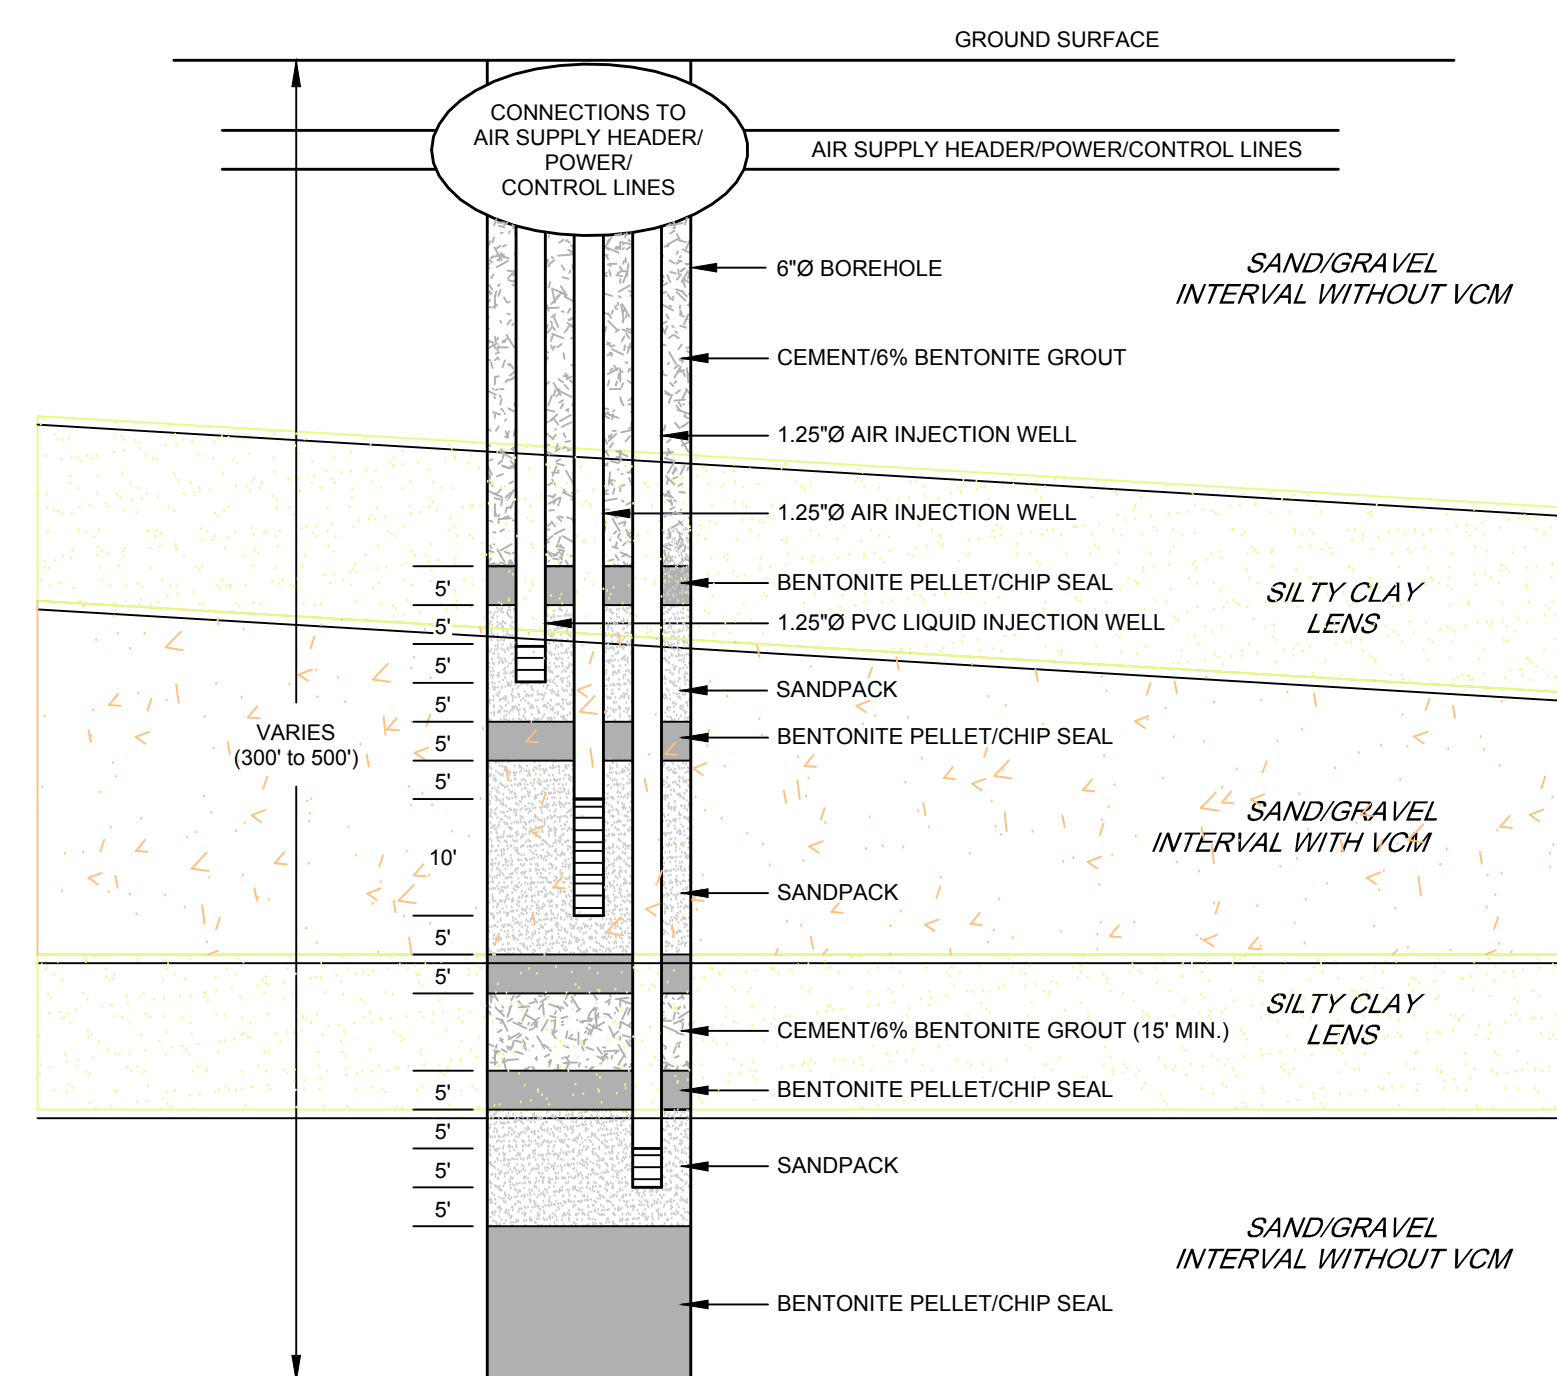

TYPICAL INJECTION WELL DETAIL  
(IW-1 THRU 7, 15, 20 THRU 22)

NOT TO SCALE

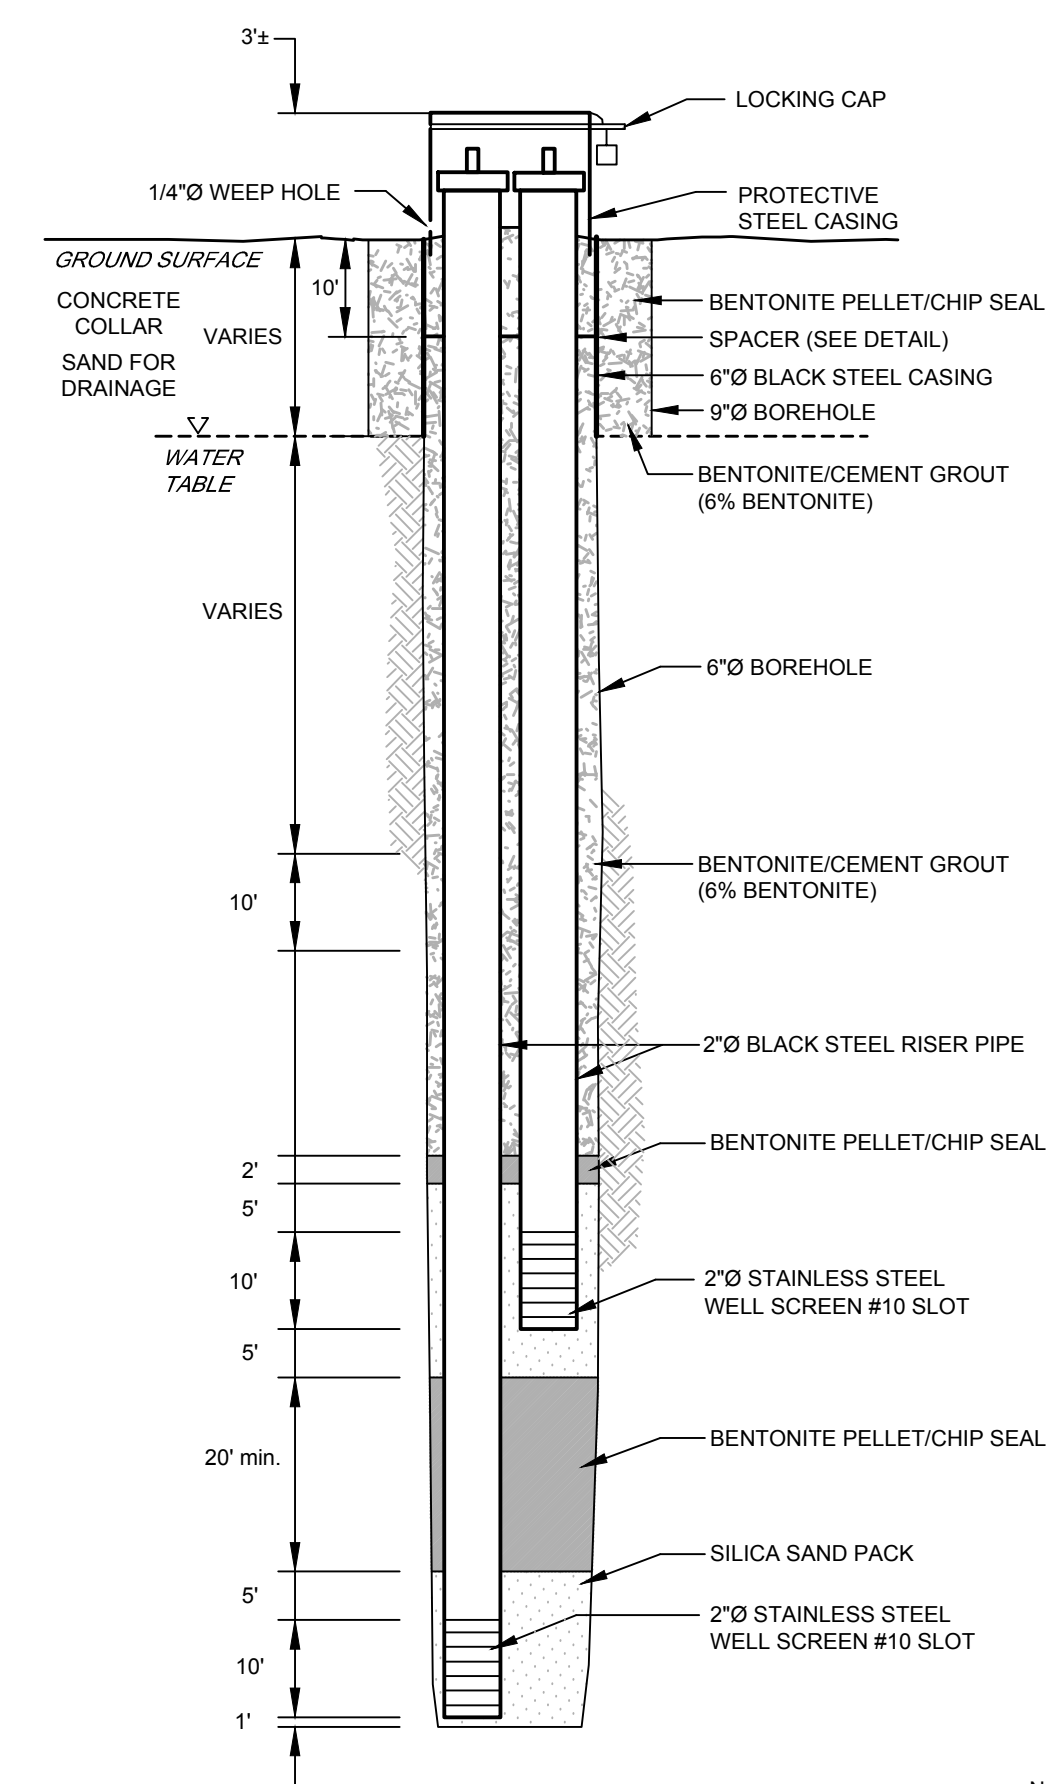


### TYPICAL GROUNDWATER MONITORING WELL DETAIL

NOT TO SCALE

NOTES:

1. WELLS EXTEND TO DEPTH RANGING FROM 250' TO 450'
2. NUMBER OF MONITORED INTERVALS DETERMINED IN THE FIELD

SCALE VERIFICATION: THIS BAR MEASURES 1" ON ORIGINAL. ADJUST SCALE ACCORDINGLY.			
			
1	AS BUILT	08/29/12	LV
No	Revision	Date	Initial

WARNING: ALTERING THIS DOCUMENT IS  
IN VIOLATION OF THE NEW YORK STATE  
EDUCATION LAW EXCEPTING AS PROVIDED  
IN SECTION 7209, PART 2 OF THE LAW.

HOOKER/RUCO SITE  
HICKSVILLE, NEW YORK

BIOSPARGE TREATMENT SYSTEM


WELL DETAILS




**CRA Infrastructure  
& Engineering, Inc.**

Source Reference:			Date: AUGUST 2012
Project Manager: J. KAY	Reviewed By:	Designed By:	Drawn By:
Scale: NONE	Project No: 06883-00	Report No: 056	Drawing No: MP-05




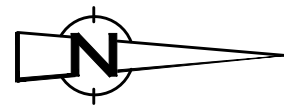


WELL NUMBER	LINE NUMBER	INSTRUMENT NUMBER				"TIE POINT" NUMBER
		PI	FE	FV	FSQ	
IW-16	TE-1 1/2"CS-2160					TP-4, TP-56
	B-3"CS-1160	160				TP-6, TP-8
	TE-1 1/2"CS-2164	165	164	164		TP-5
	B-1 1/2"CS-1161			161	161	TP-7
IW-17	B-1 1/2"CS-1162			162	162	TP-9
	TE-1 1/2"CS-2170					TP-10, TP-57
	B-3"CS-1170	170				TP-12, TP-14
	TE-1 1/2"CS-2174	175	174	174		TP-11
IW-18	B-1 1/2"CS-1171			171	171	TP-13
	B-1 1/2"CS-1172			172	172	TP-15
	TE-1 1/2"CS-2180					TP-16, TP-58
	B-3"CS-1180	180				TP-18, TP-20
IW-19	TE-1 1/2"CS-2184	185	184	184		TP-17
	B-1 1/2"CS-1181			181	181	TP-19
	B-1 1/2"CS-1182			182	182	TP-21
	TE-1 1/2"CS-2190					TP-22
	B-3"CS-1190	190				TP-24
	TE-1 1/2"CS-2194	195	194	194		TP-23
	B-1 1/2"CS-1191			191	191	TP-25
	B-1 1/2"CS-1192			192	192	TP-27

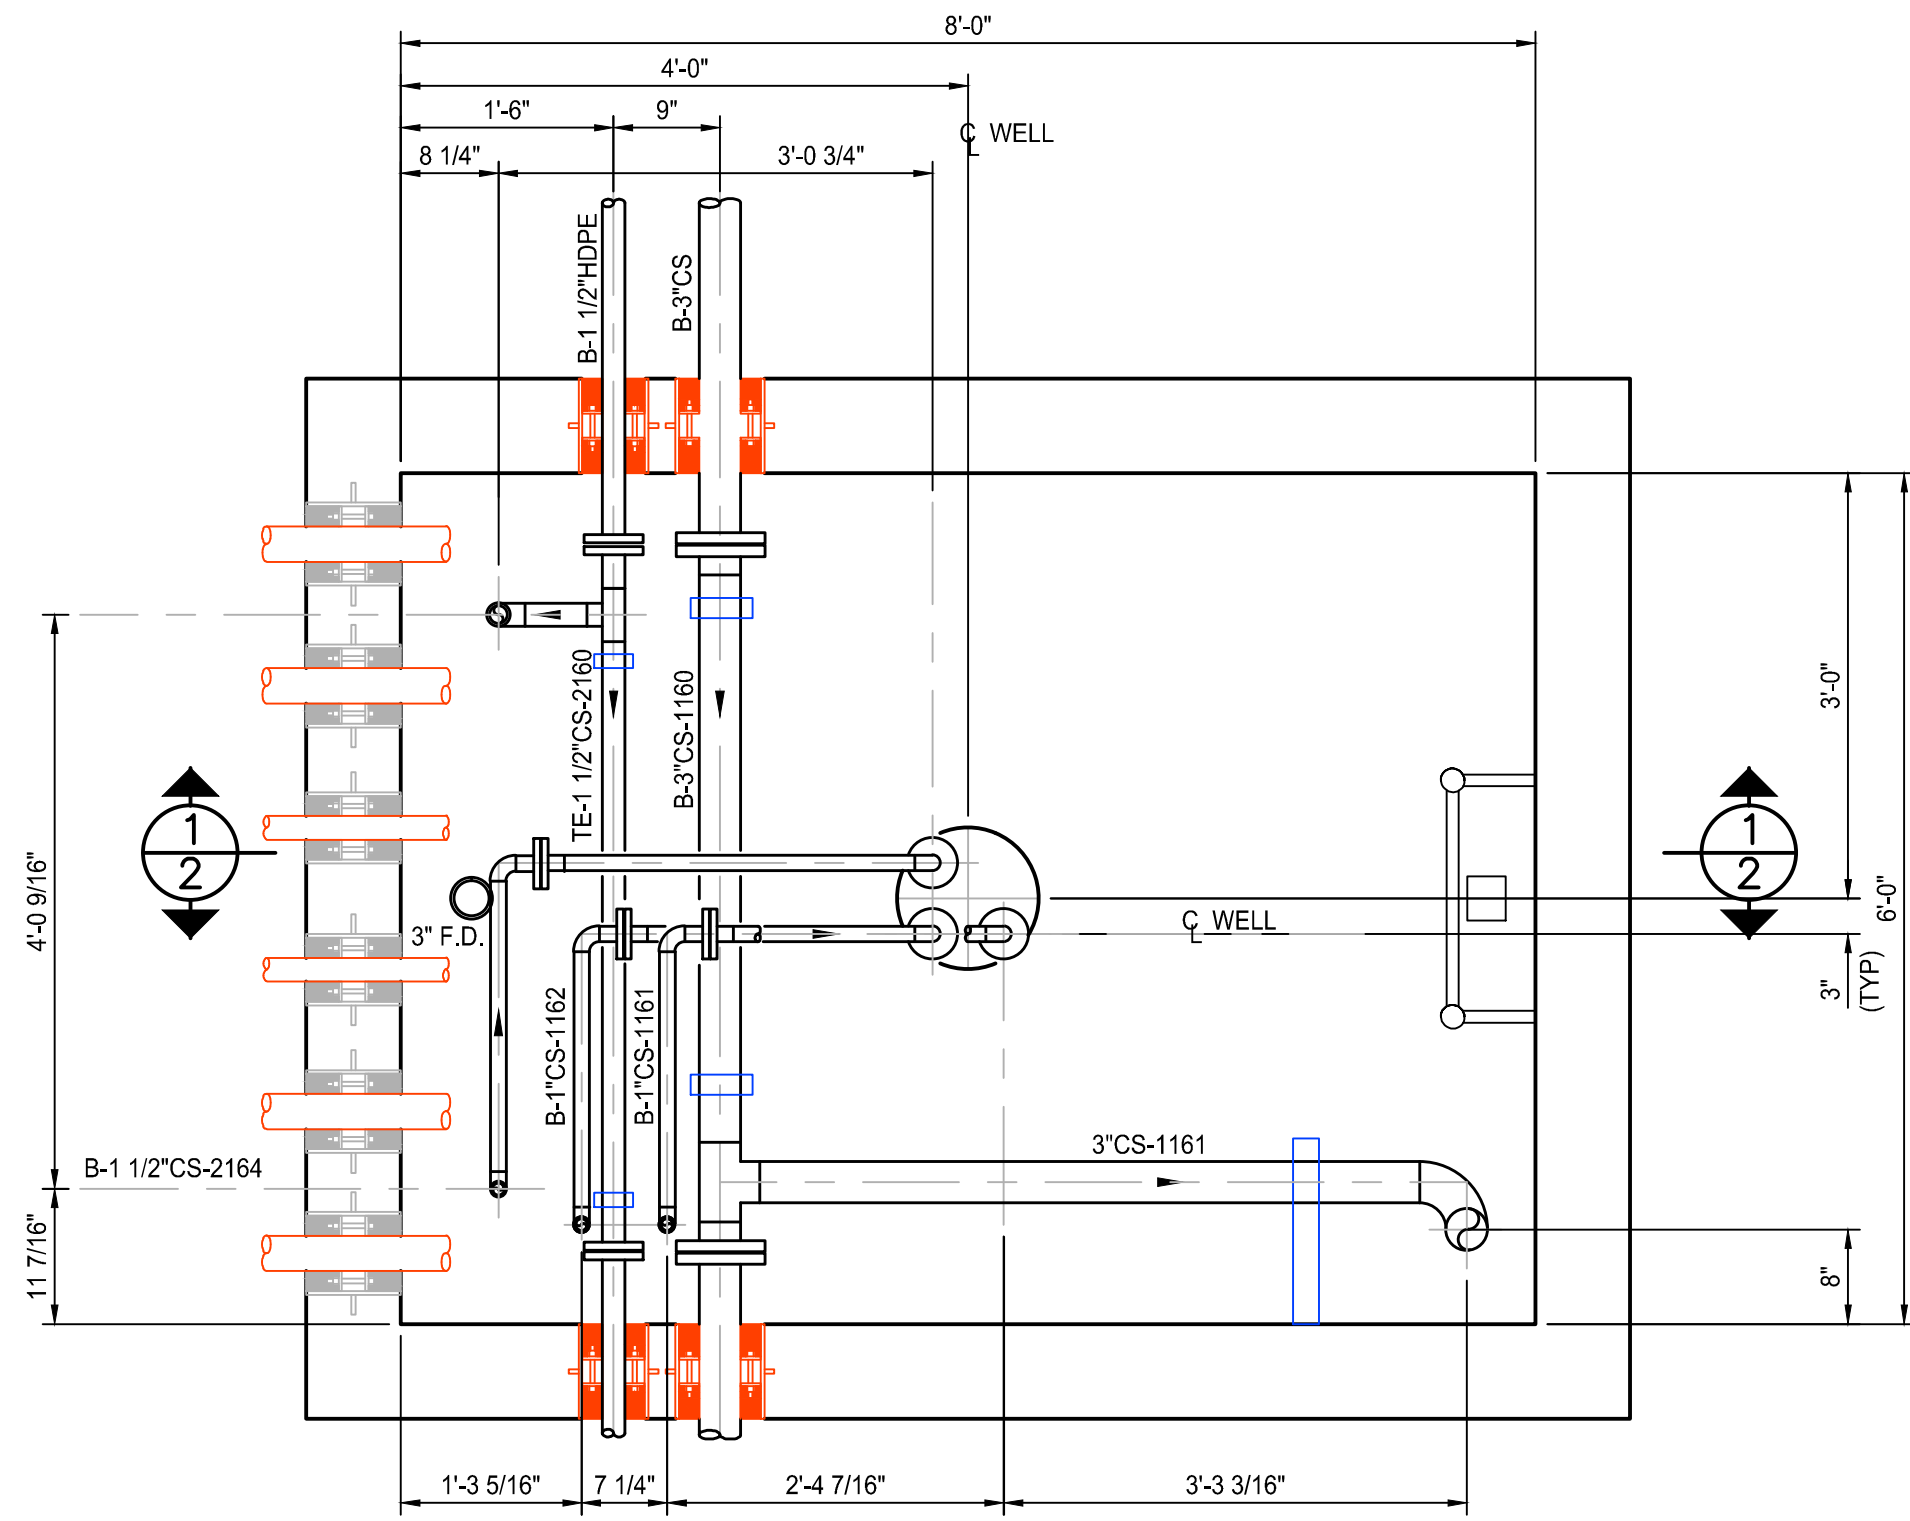


PLAN BELOW THE GRATING

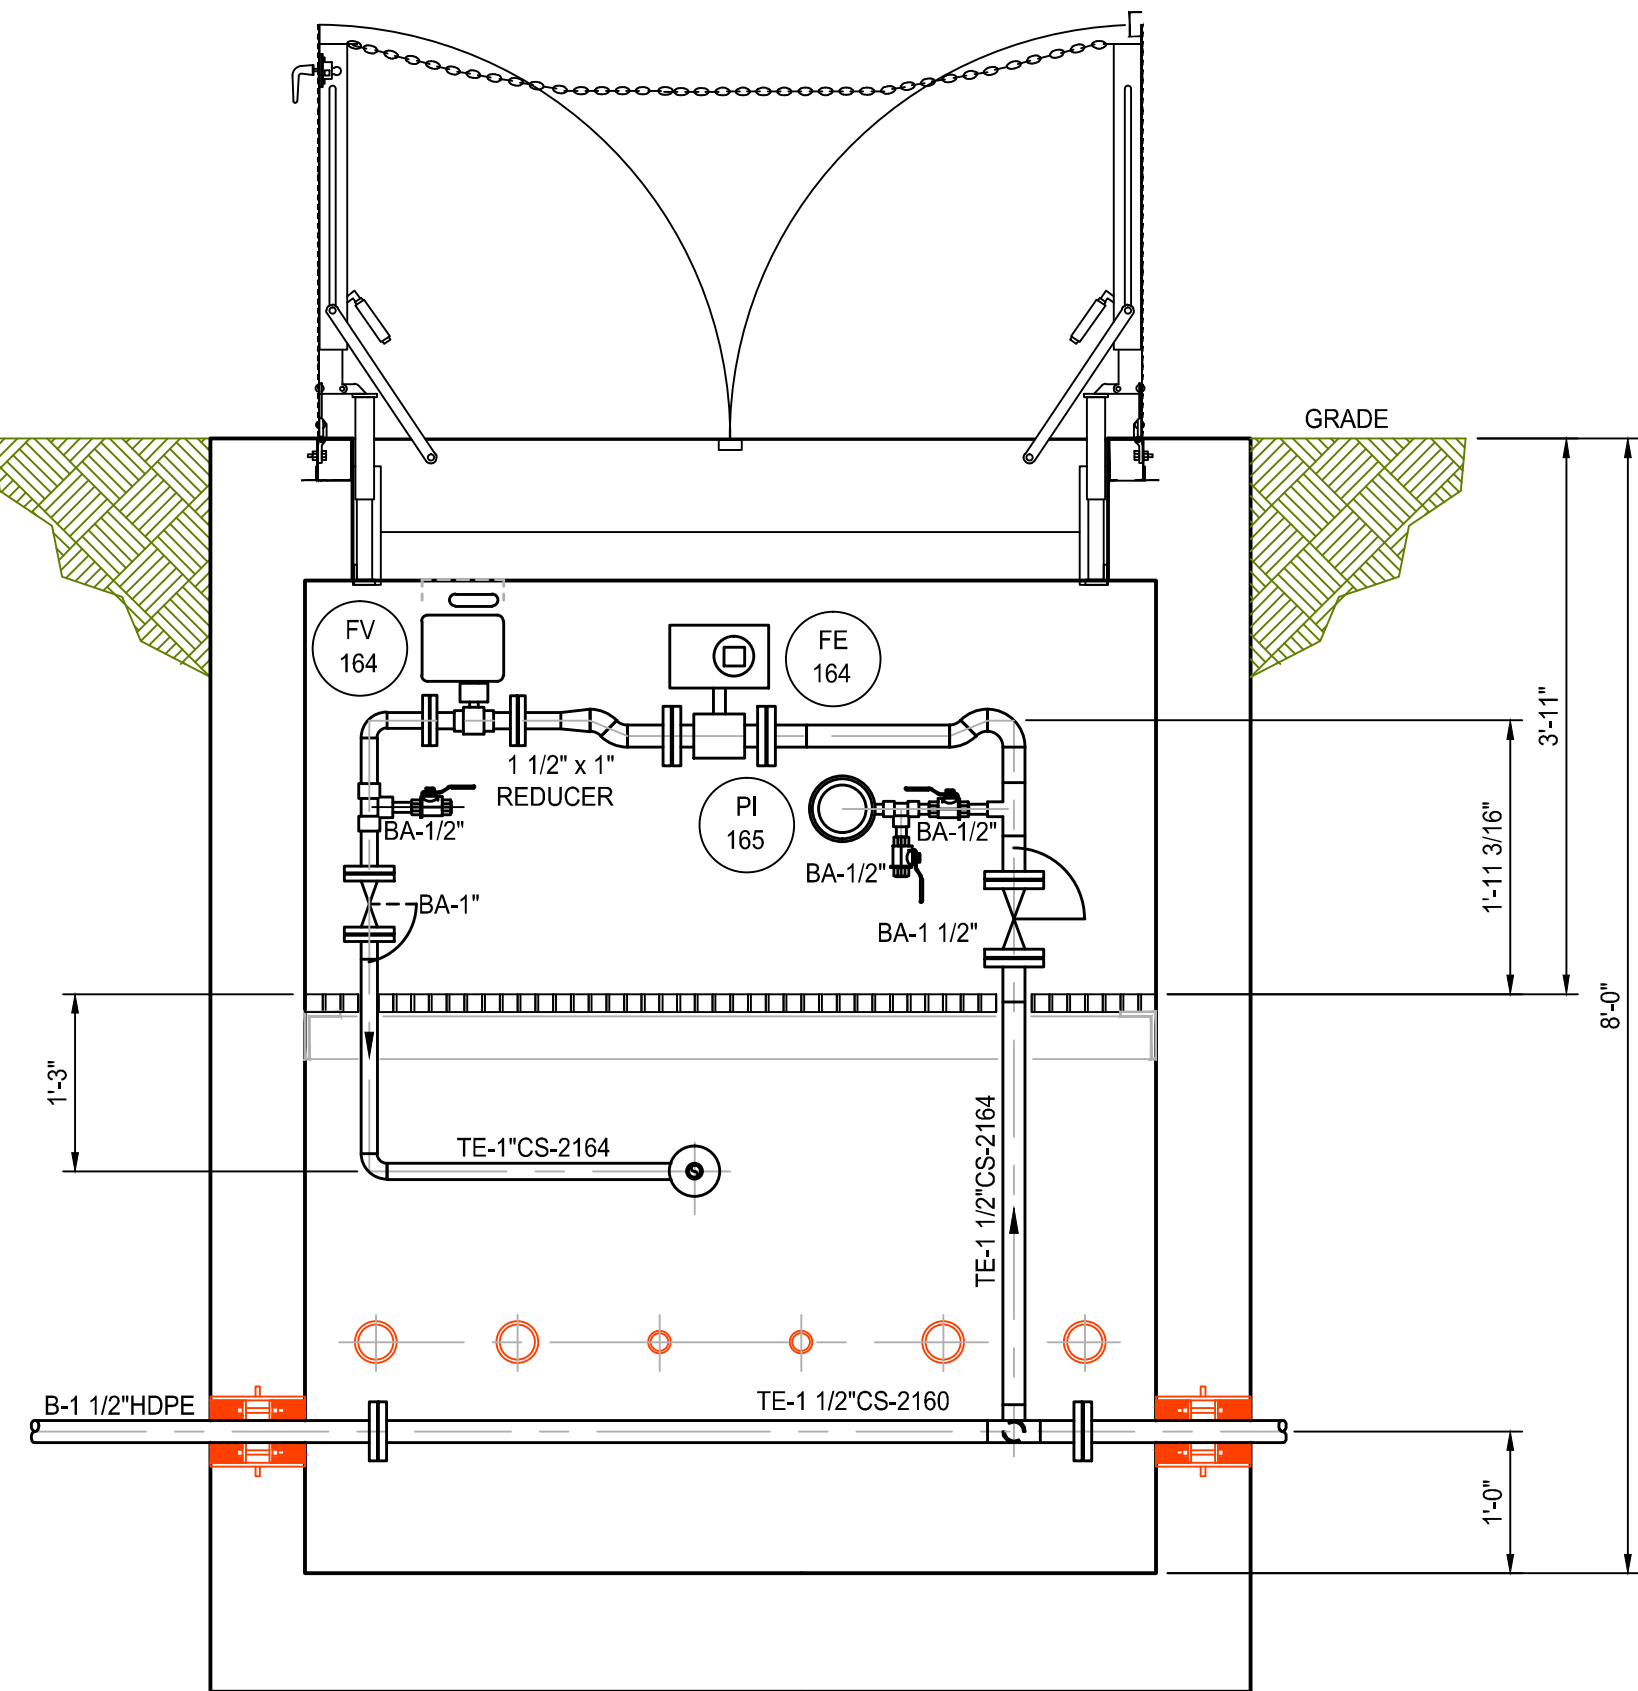


SECTION 3

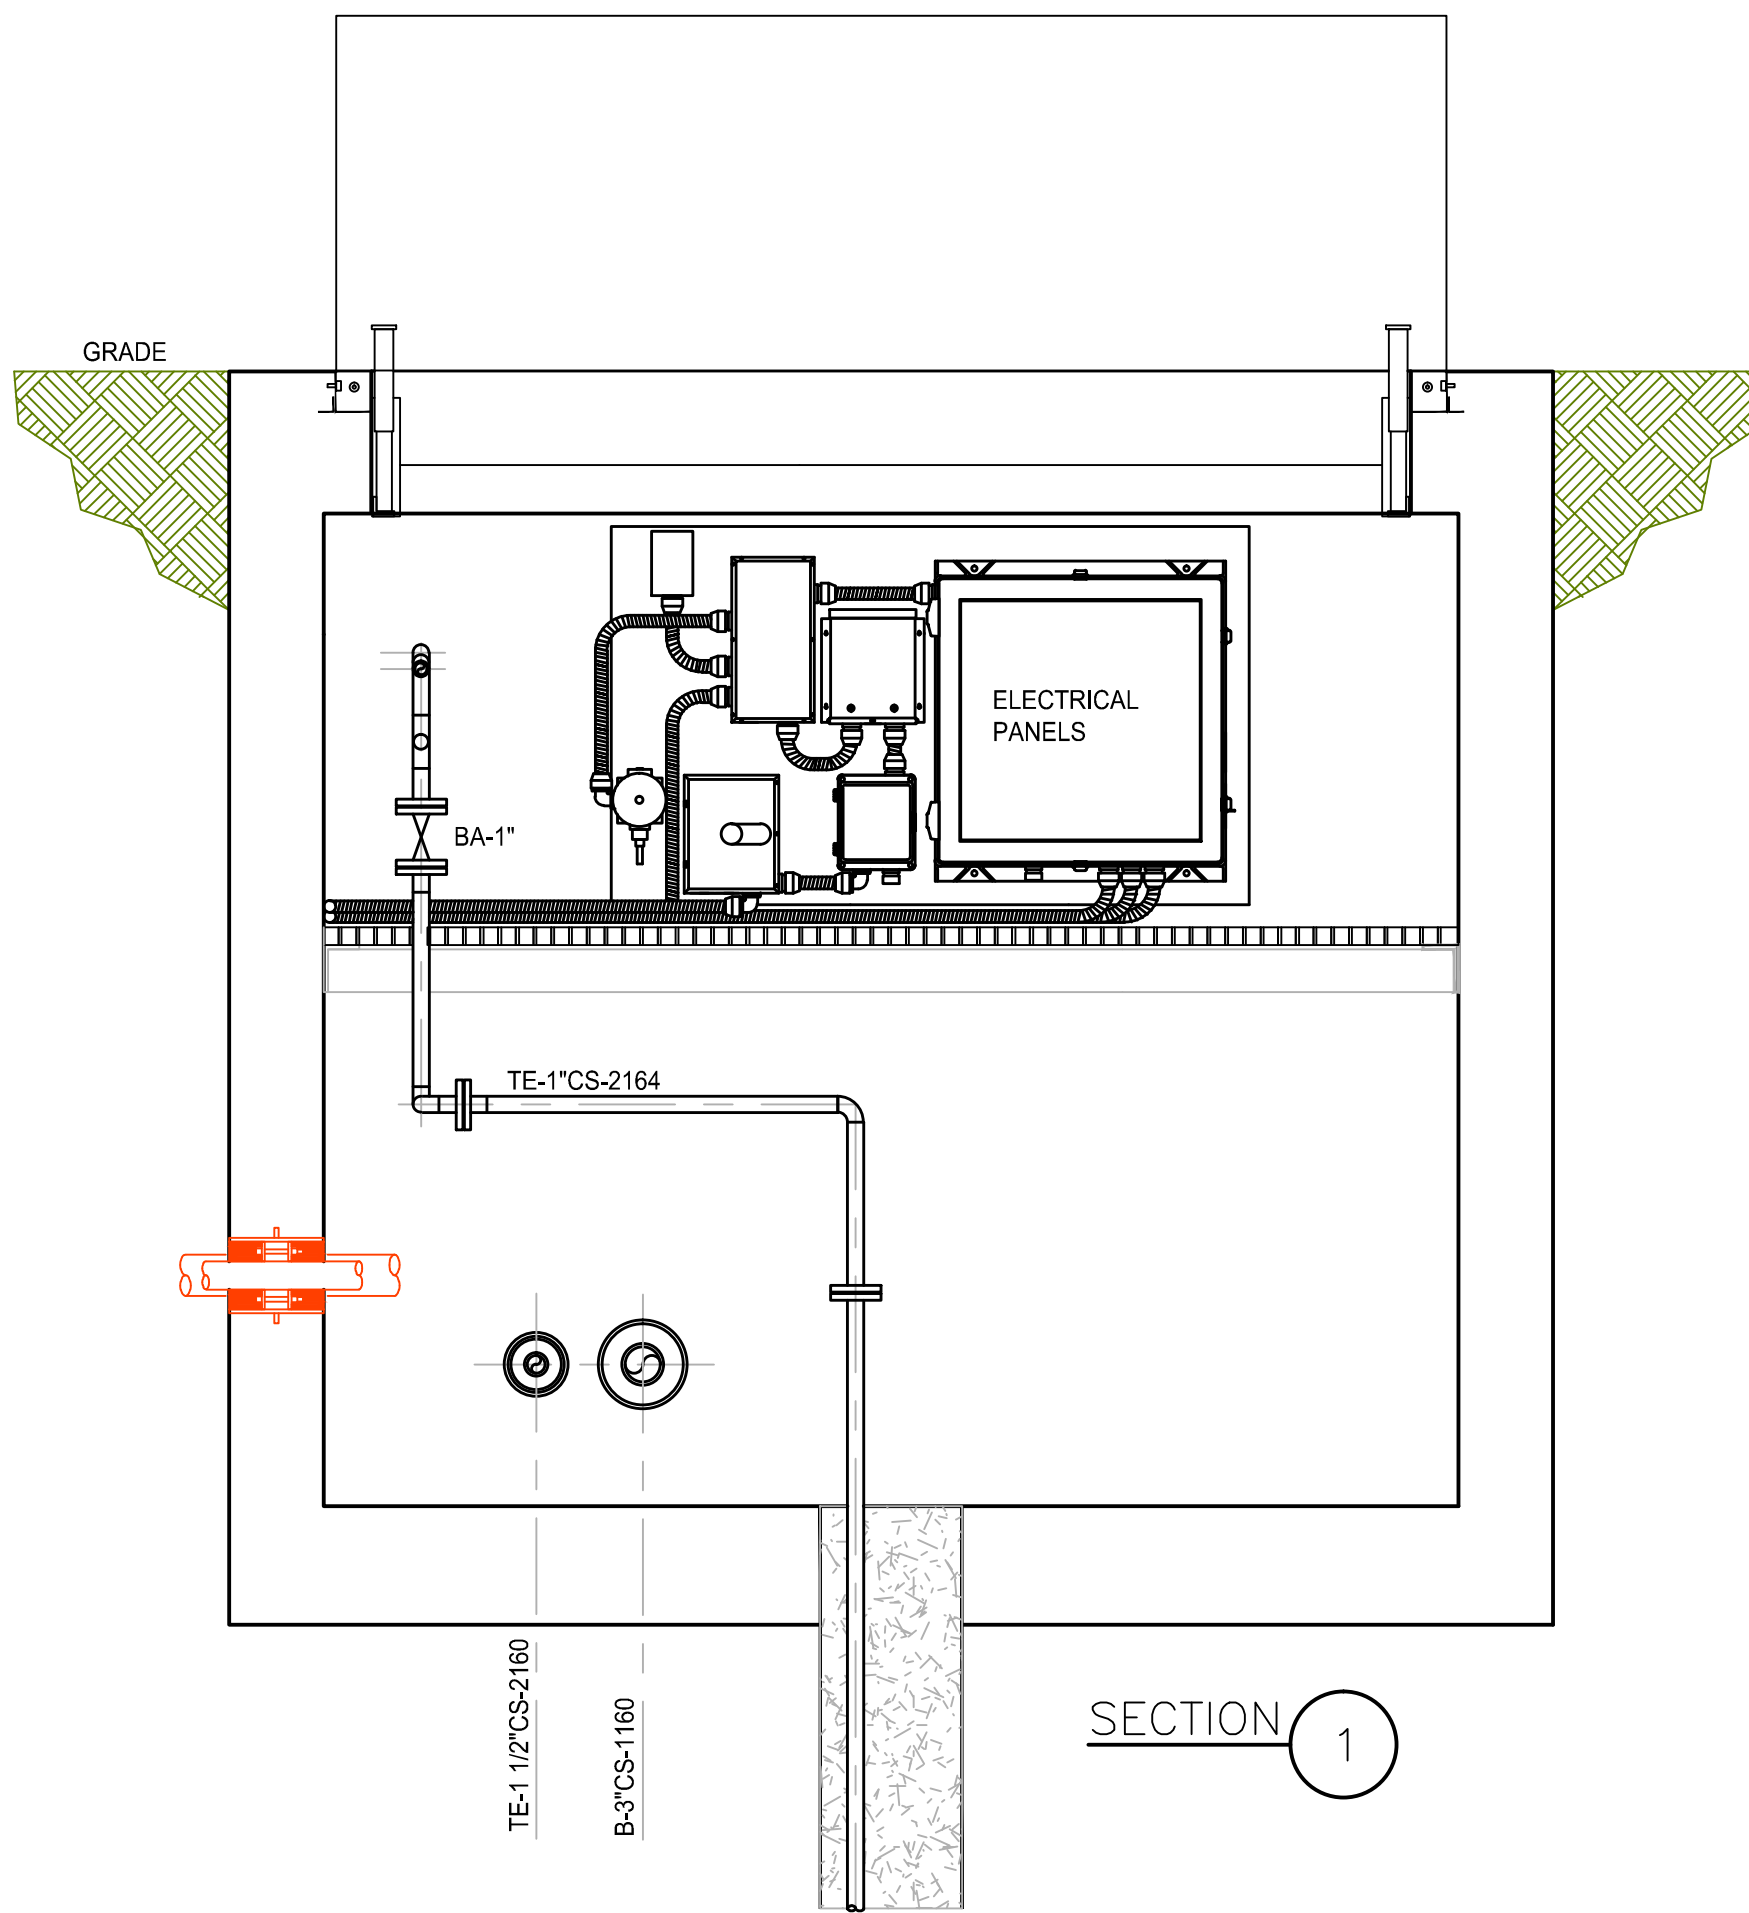

SECTION 1

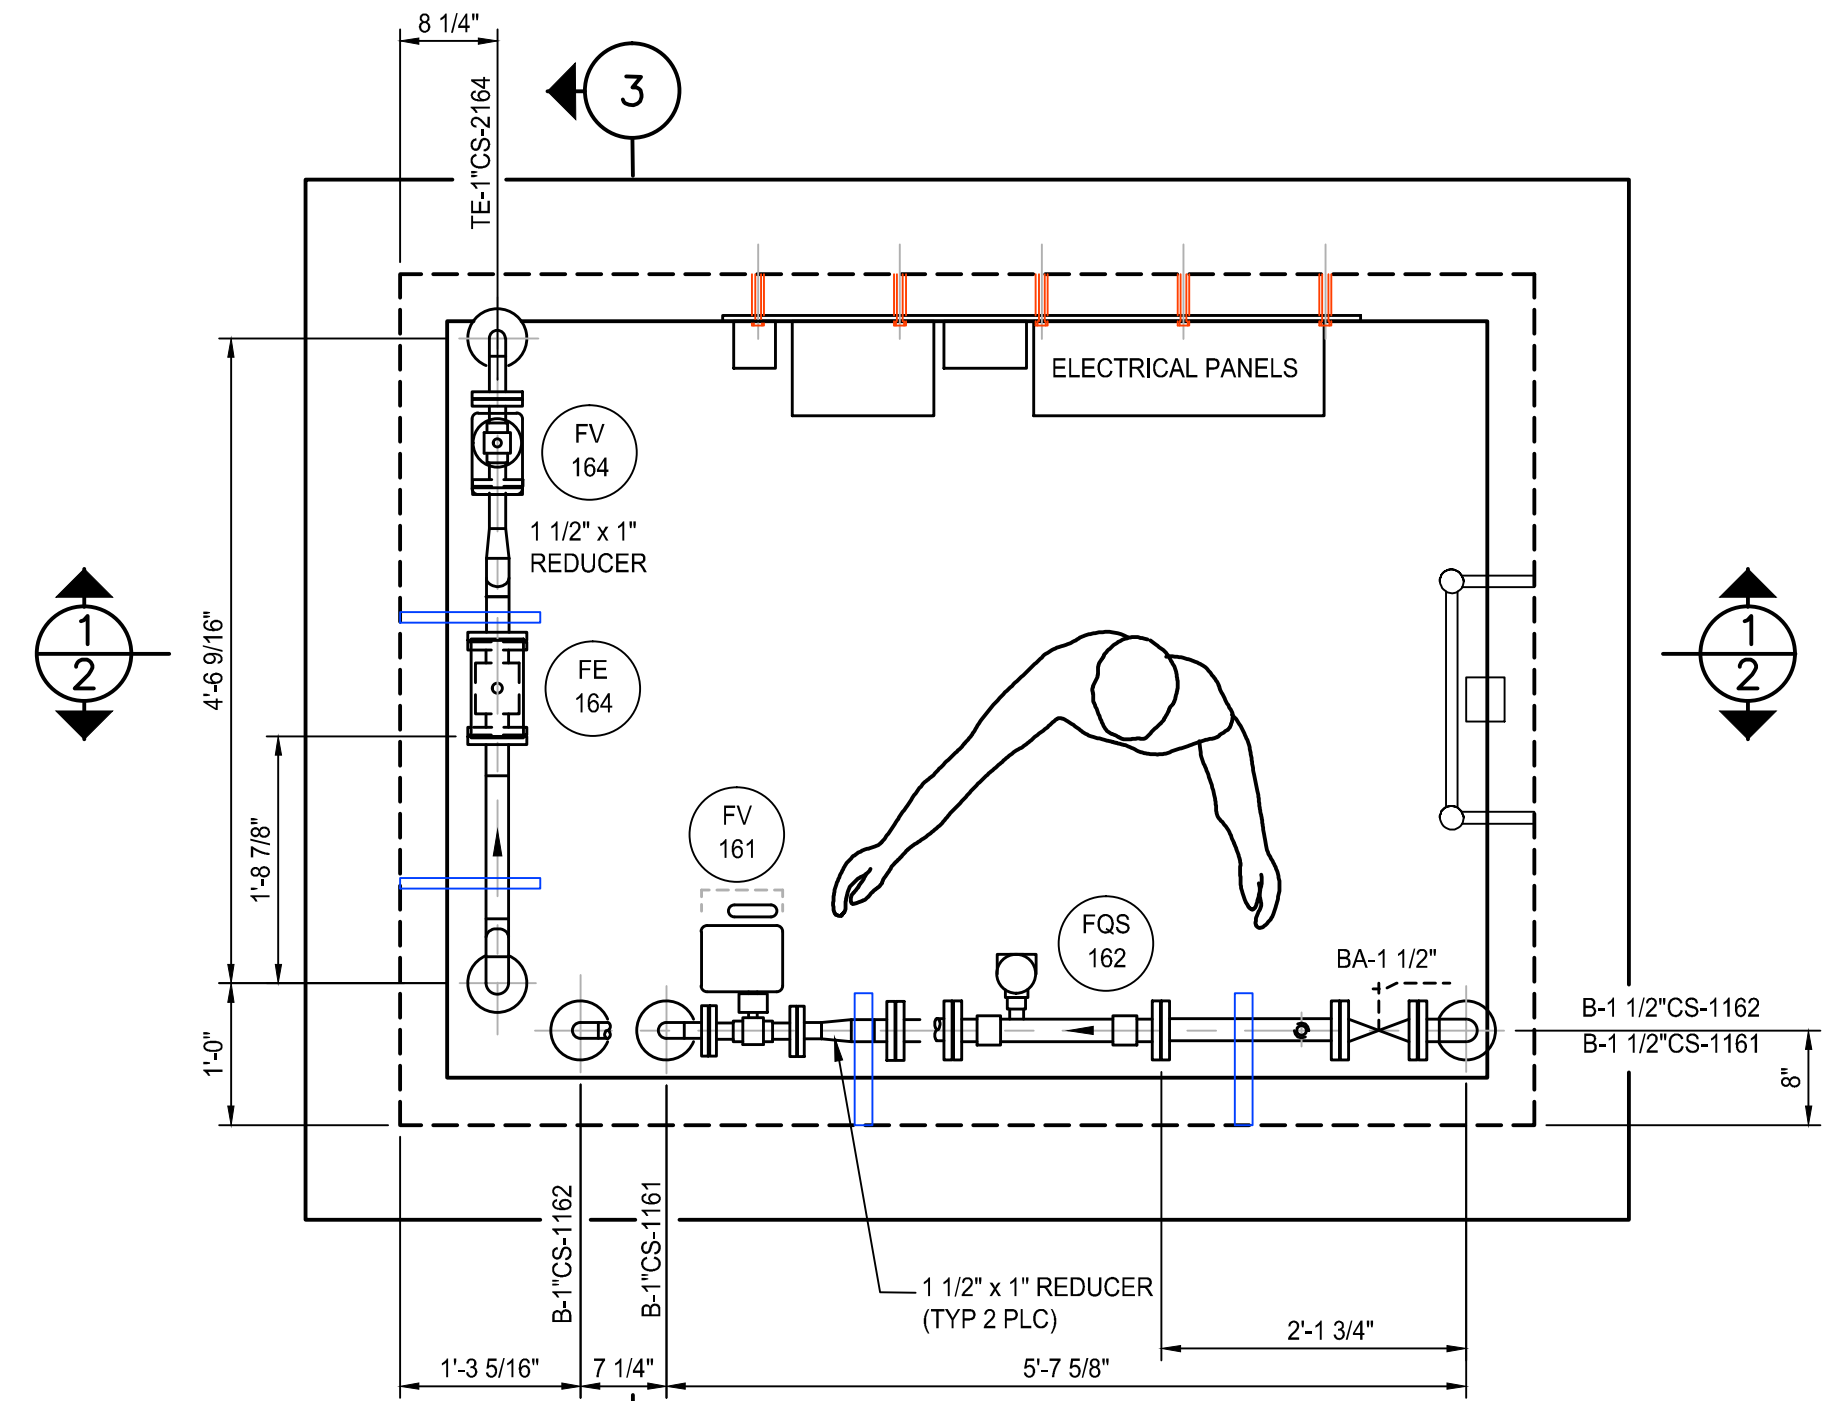

PLAN ABOVE THE GRATING

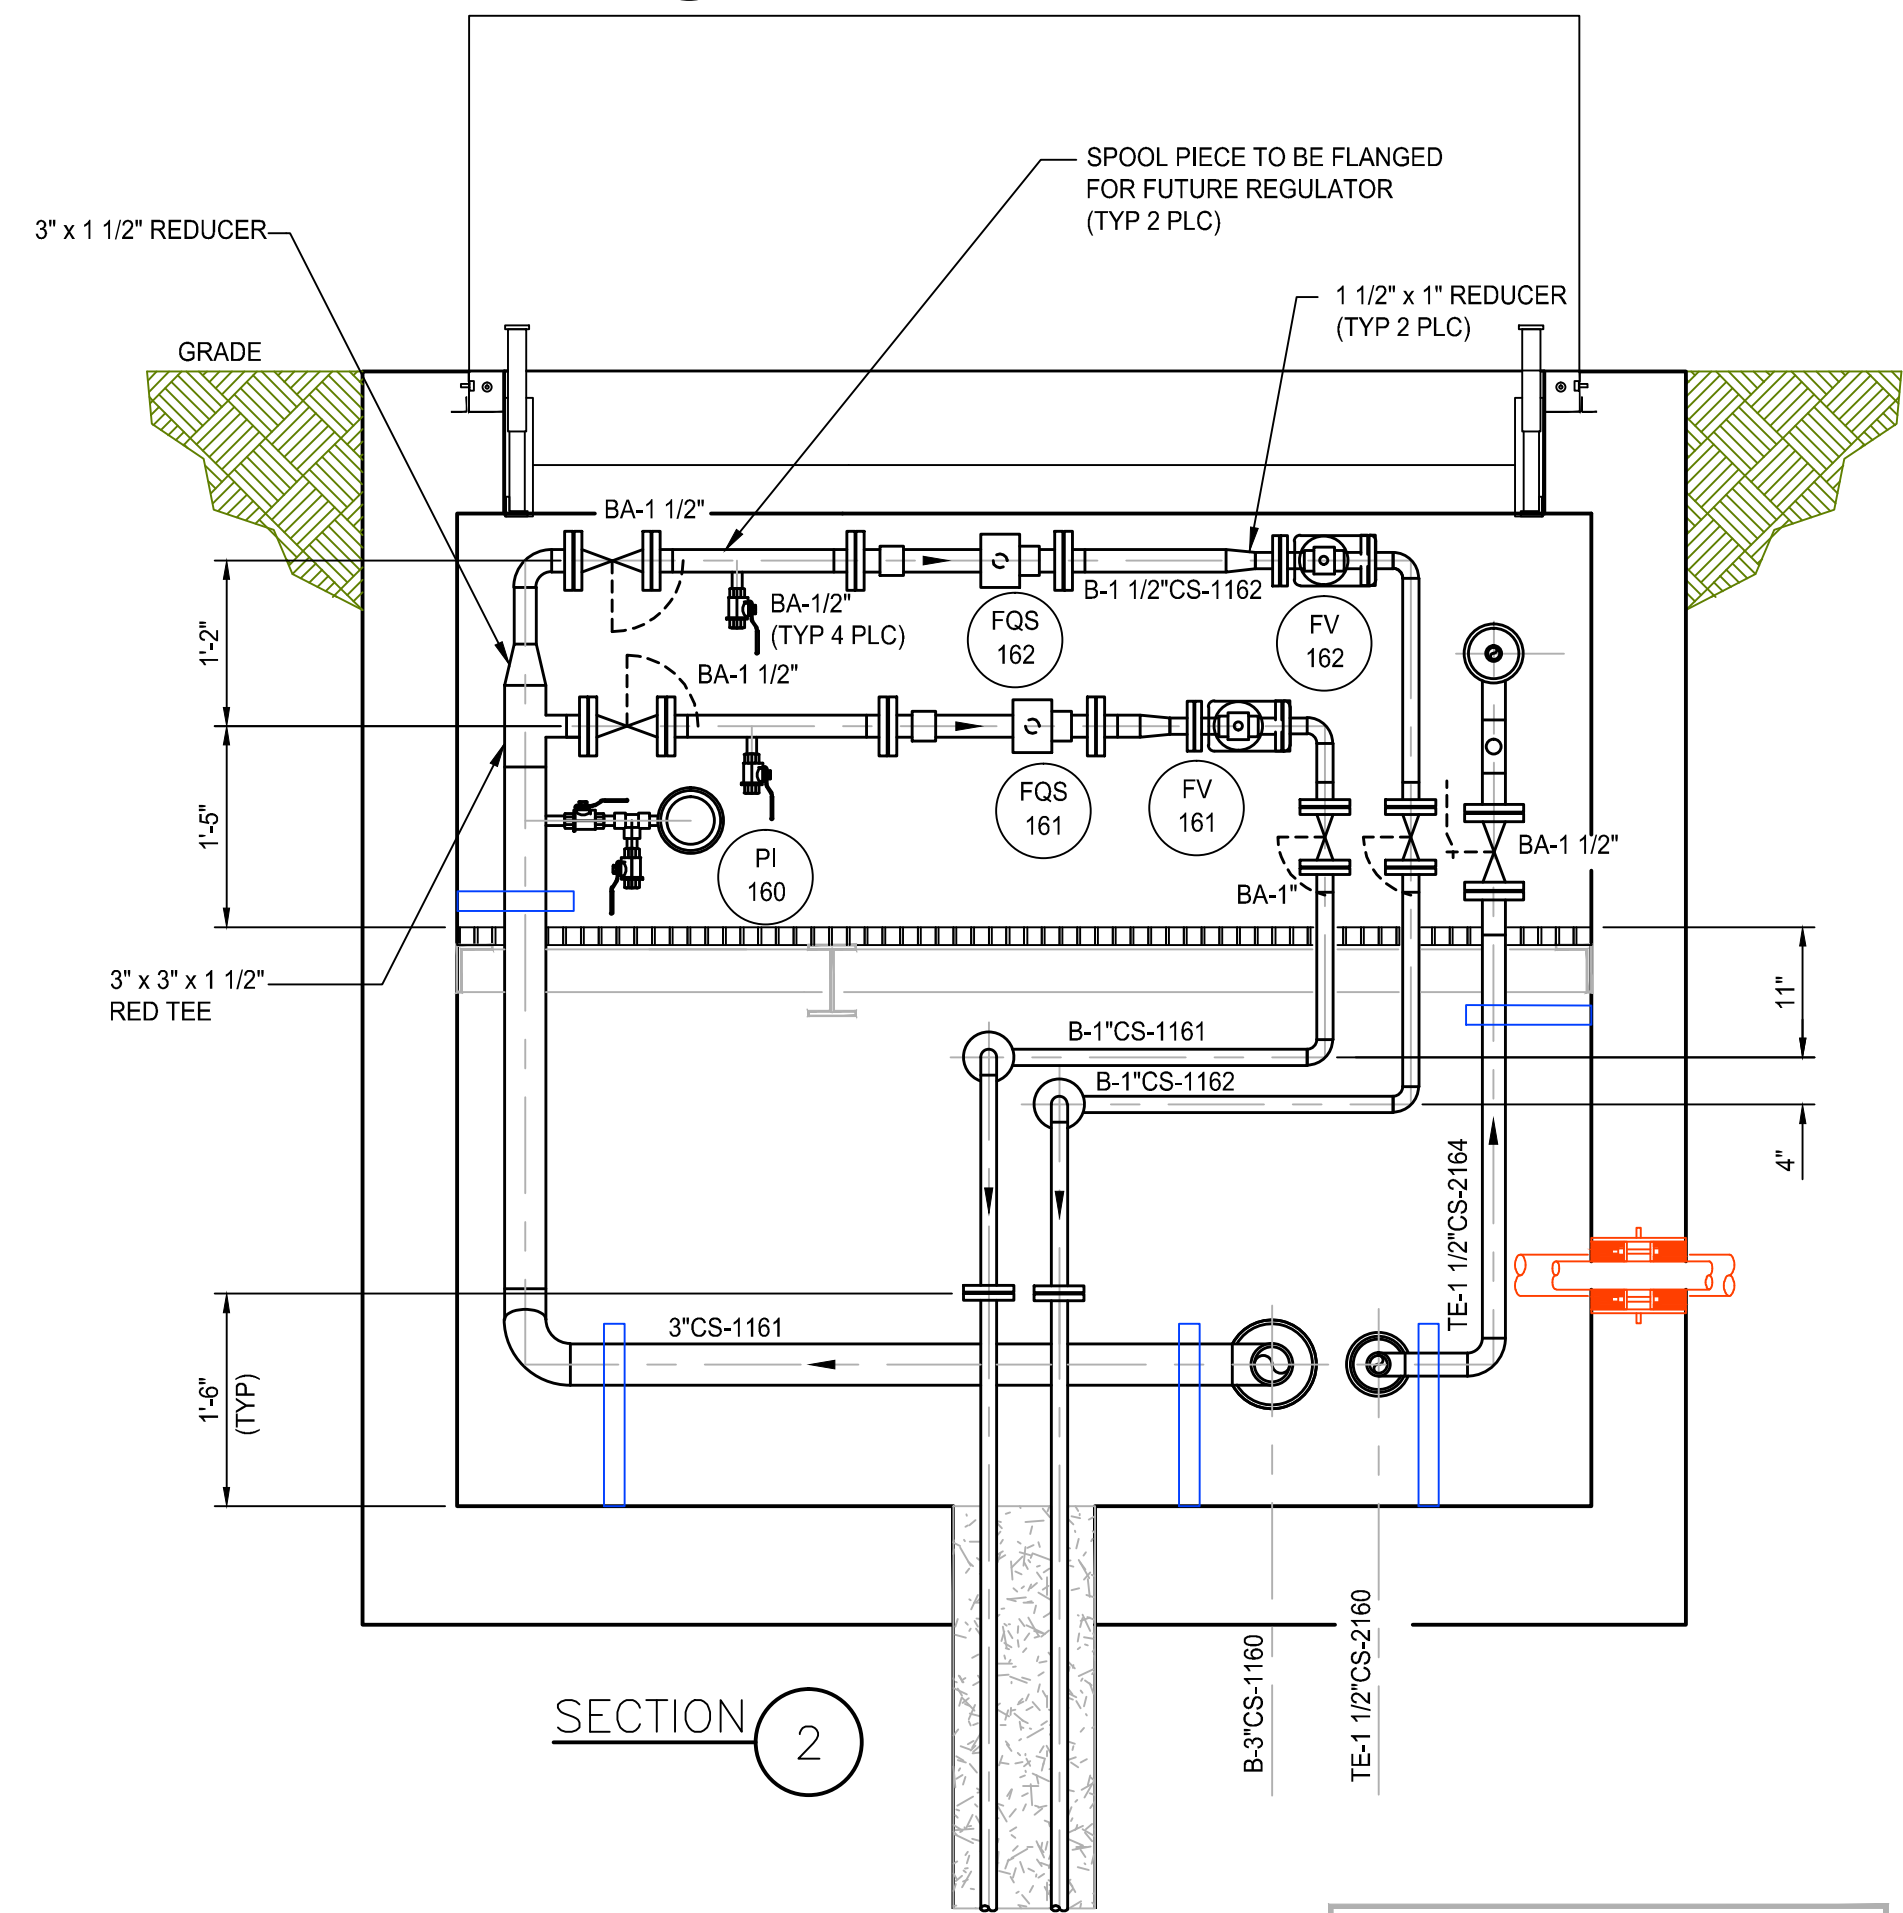

SECTION 2

AS BUILT  
RECORD DRAWING

NOTES:

1. THE VAULT SHOWN ABOVE IS FOR WELL IW-16. ALL VAULTS WERE PIPED AS PER THIS TYPICAL DRAWING. INSTRUMENT AND LINE NUMBERS FOR THE OTHER VAULTS MAY BE FOUND ON TABLE.
2. WELLS IW-01 THRU IW-07 ARE LOCATED NORTH OF THE CONTROL BUILDING. THESE VAULTS ARE POSITIONED WITH THE WELL LOCATED ON THE NORTH SIDE OF THE VAULT.
3. WELLS IW-15 THRU IW-22 ARE LOCATED JUST NORTH OF THE CONTROL BUILDING. THESE VAULTS ARE POSITIONED WITH THE WELL LOCATED ON THE SOUTH SIDE OF THE VAULT.
4. ALL AIR, LIQUID, CONTROL, AND ELECTRICAL LINES PASS THRU THE VAULTS, EXCEPT IW-1, IW-8, IW-15, AND IW-22. CONTRACTOR PLUGGED ANY ADDITIONAL HOLES IN THESE VAULTS.

SCALE VERIFICATION: THIS BAR MEASURES 1" ON ORIGINAL. ADJUST SCALE ACCORDINGLY.

No	Revision	Date	Initial
1	AS BUILT	08/29/12	LV

WARNING: ALTERING THIS DOCUMENT IS IN VIOLATION OF THE NEW YORK STATE EDUCATION LAW EXCEPTING AS PROVIDED IN SECTION 7209, PART 2 OF THE LAW.

HOOKE/RUCO SITE  
HICKSVILLE, NEW YORK





BIOSPARGE TREATMENT SYSTEM


INJECTION WELLS IW-16, 17, 18 & 19  
PLAN AND SECTIONS



**CRA Infrastructure  
& Engineering, Inc.**

Source Reference:			Date:
			7-23-03
Project Manager:	Reviewed By:	Designed By:	Drawn By:
J. KAY		B. A. BEEBE	B. A. BEEBE
Scale:	Project No:	Report No:	Drawing No:
NONE	06883-00	056	MP-06

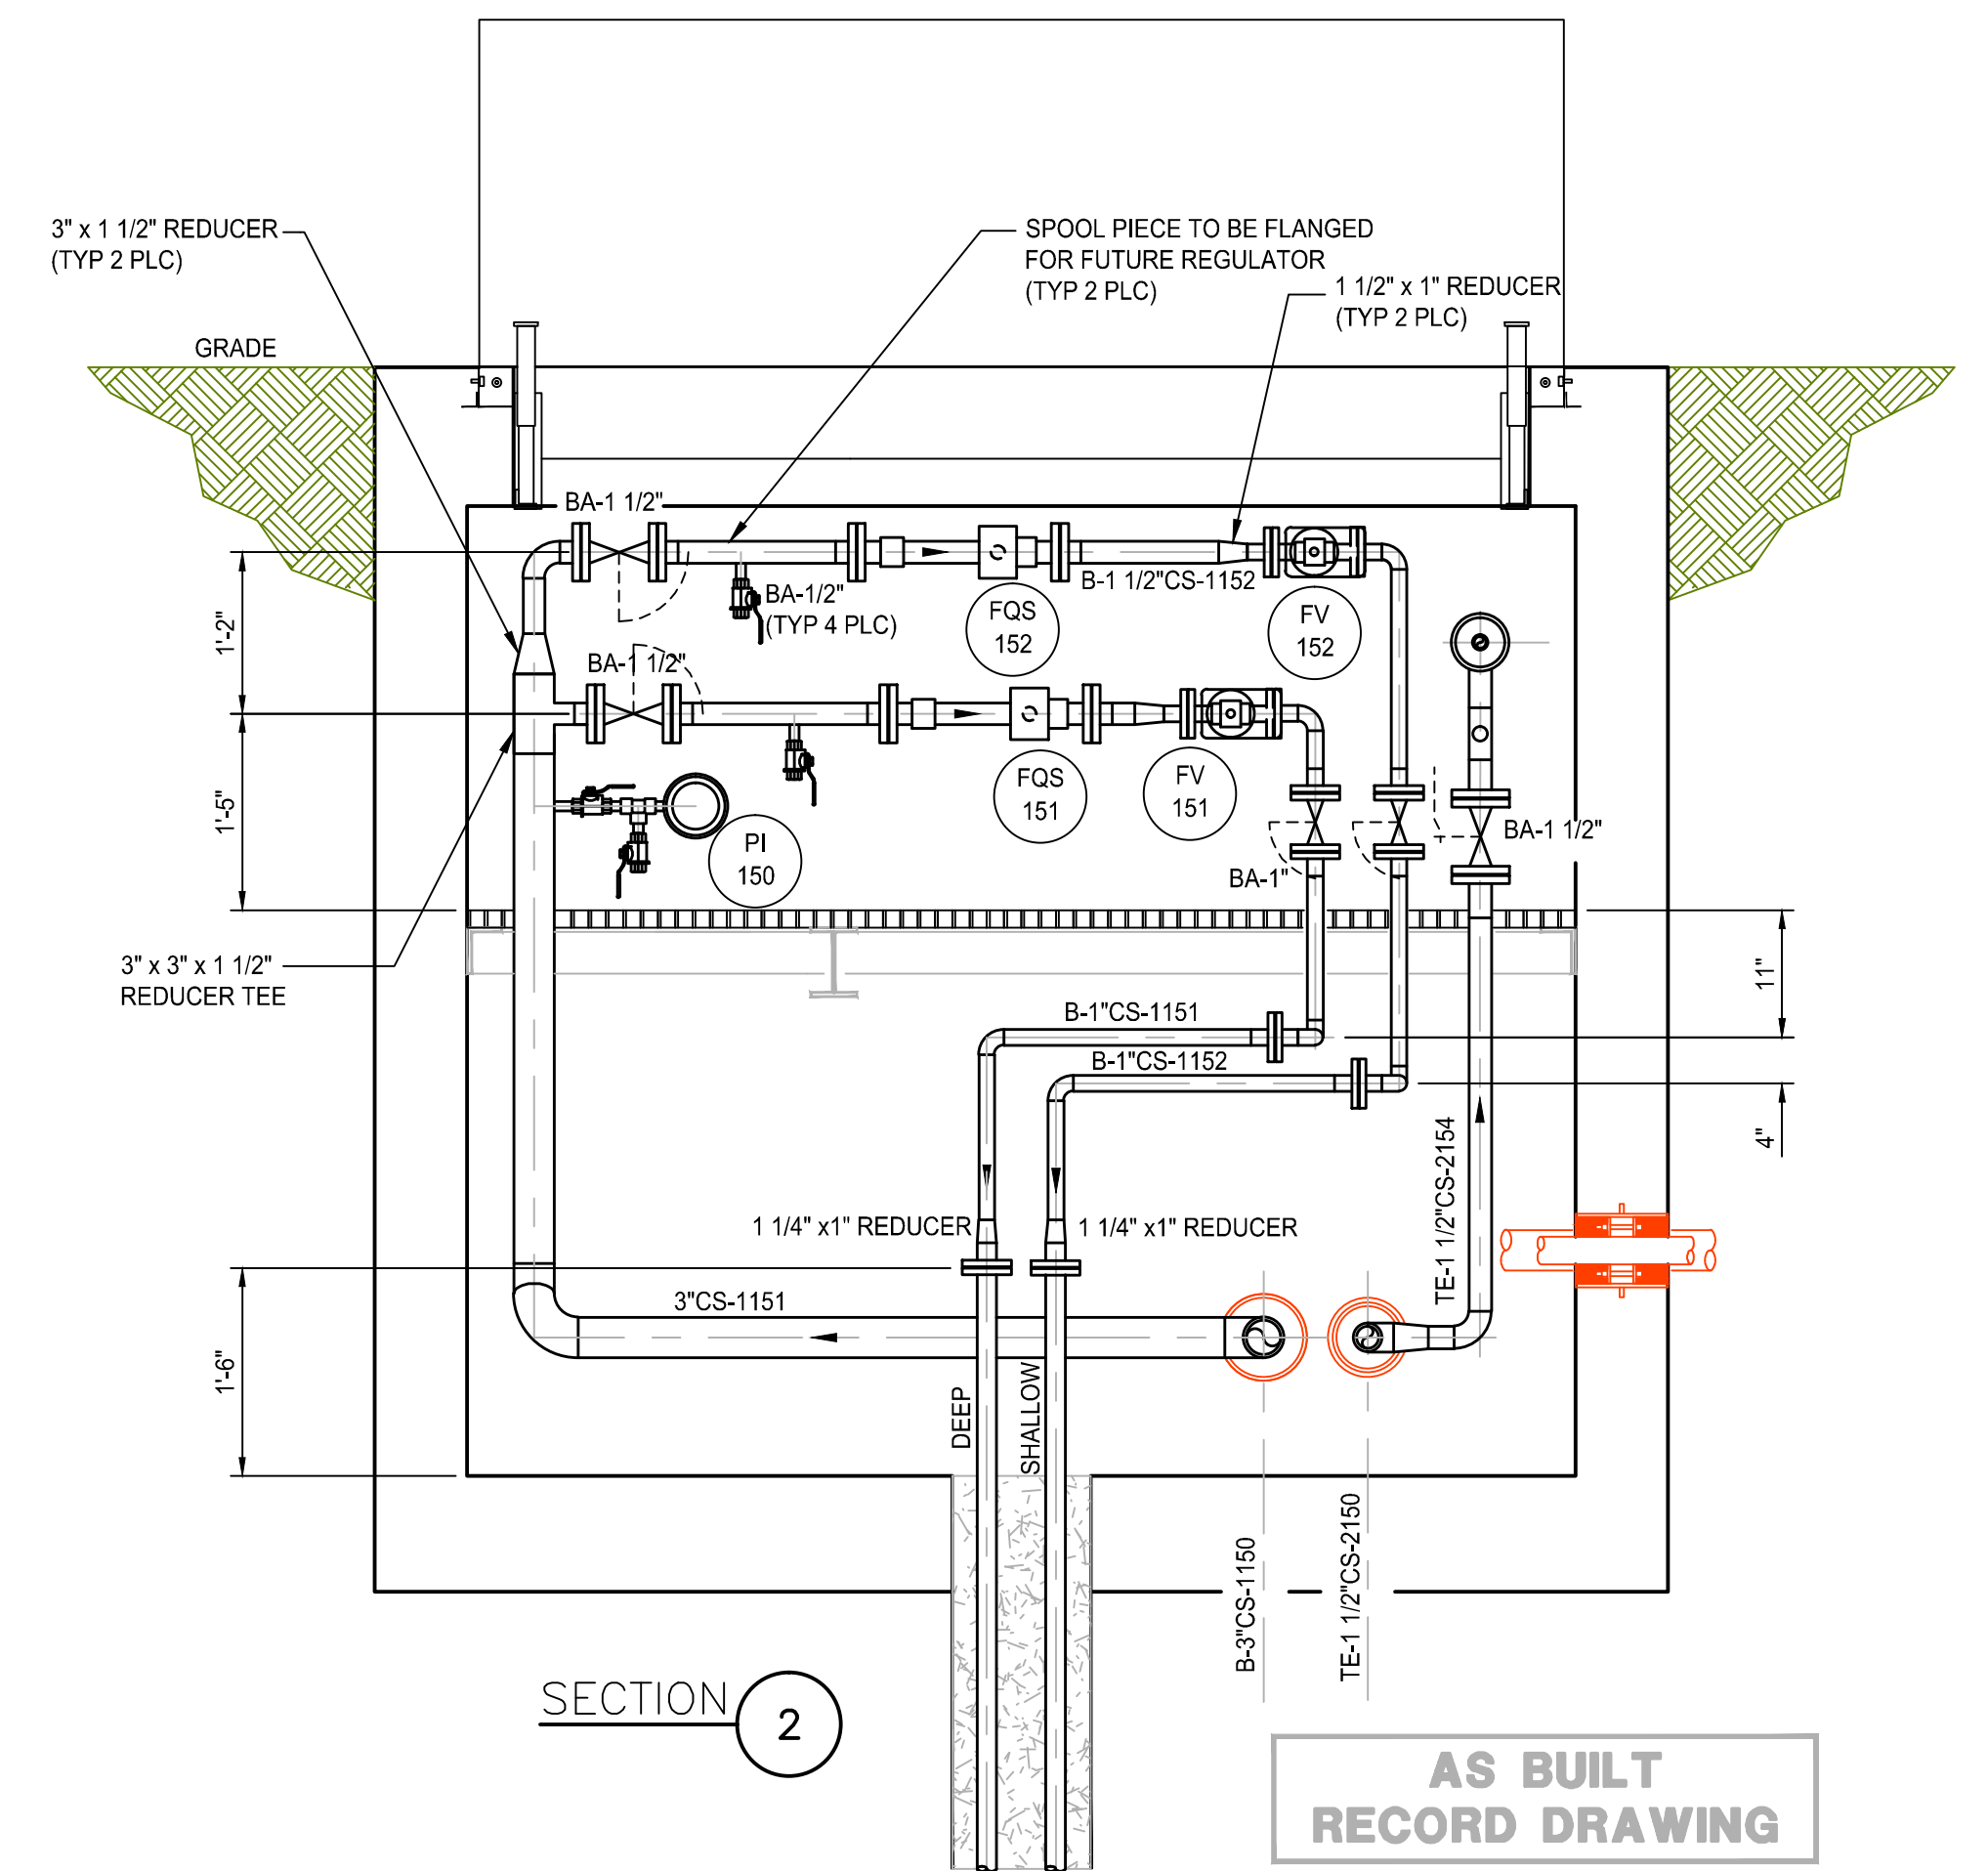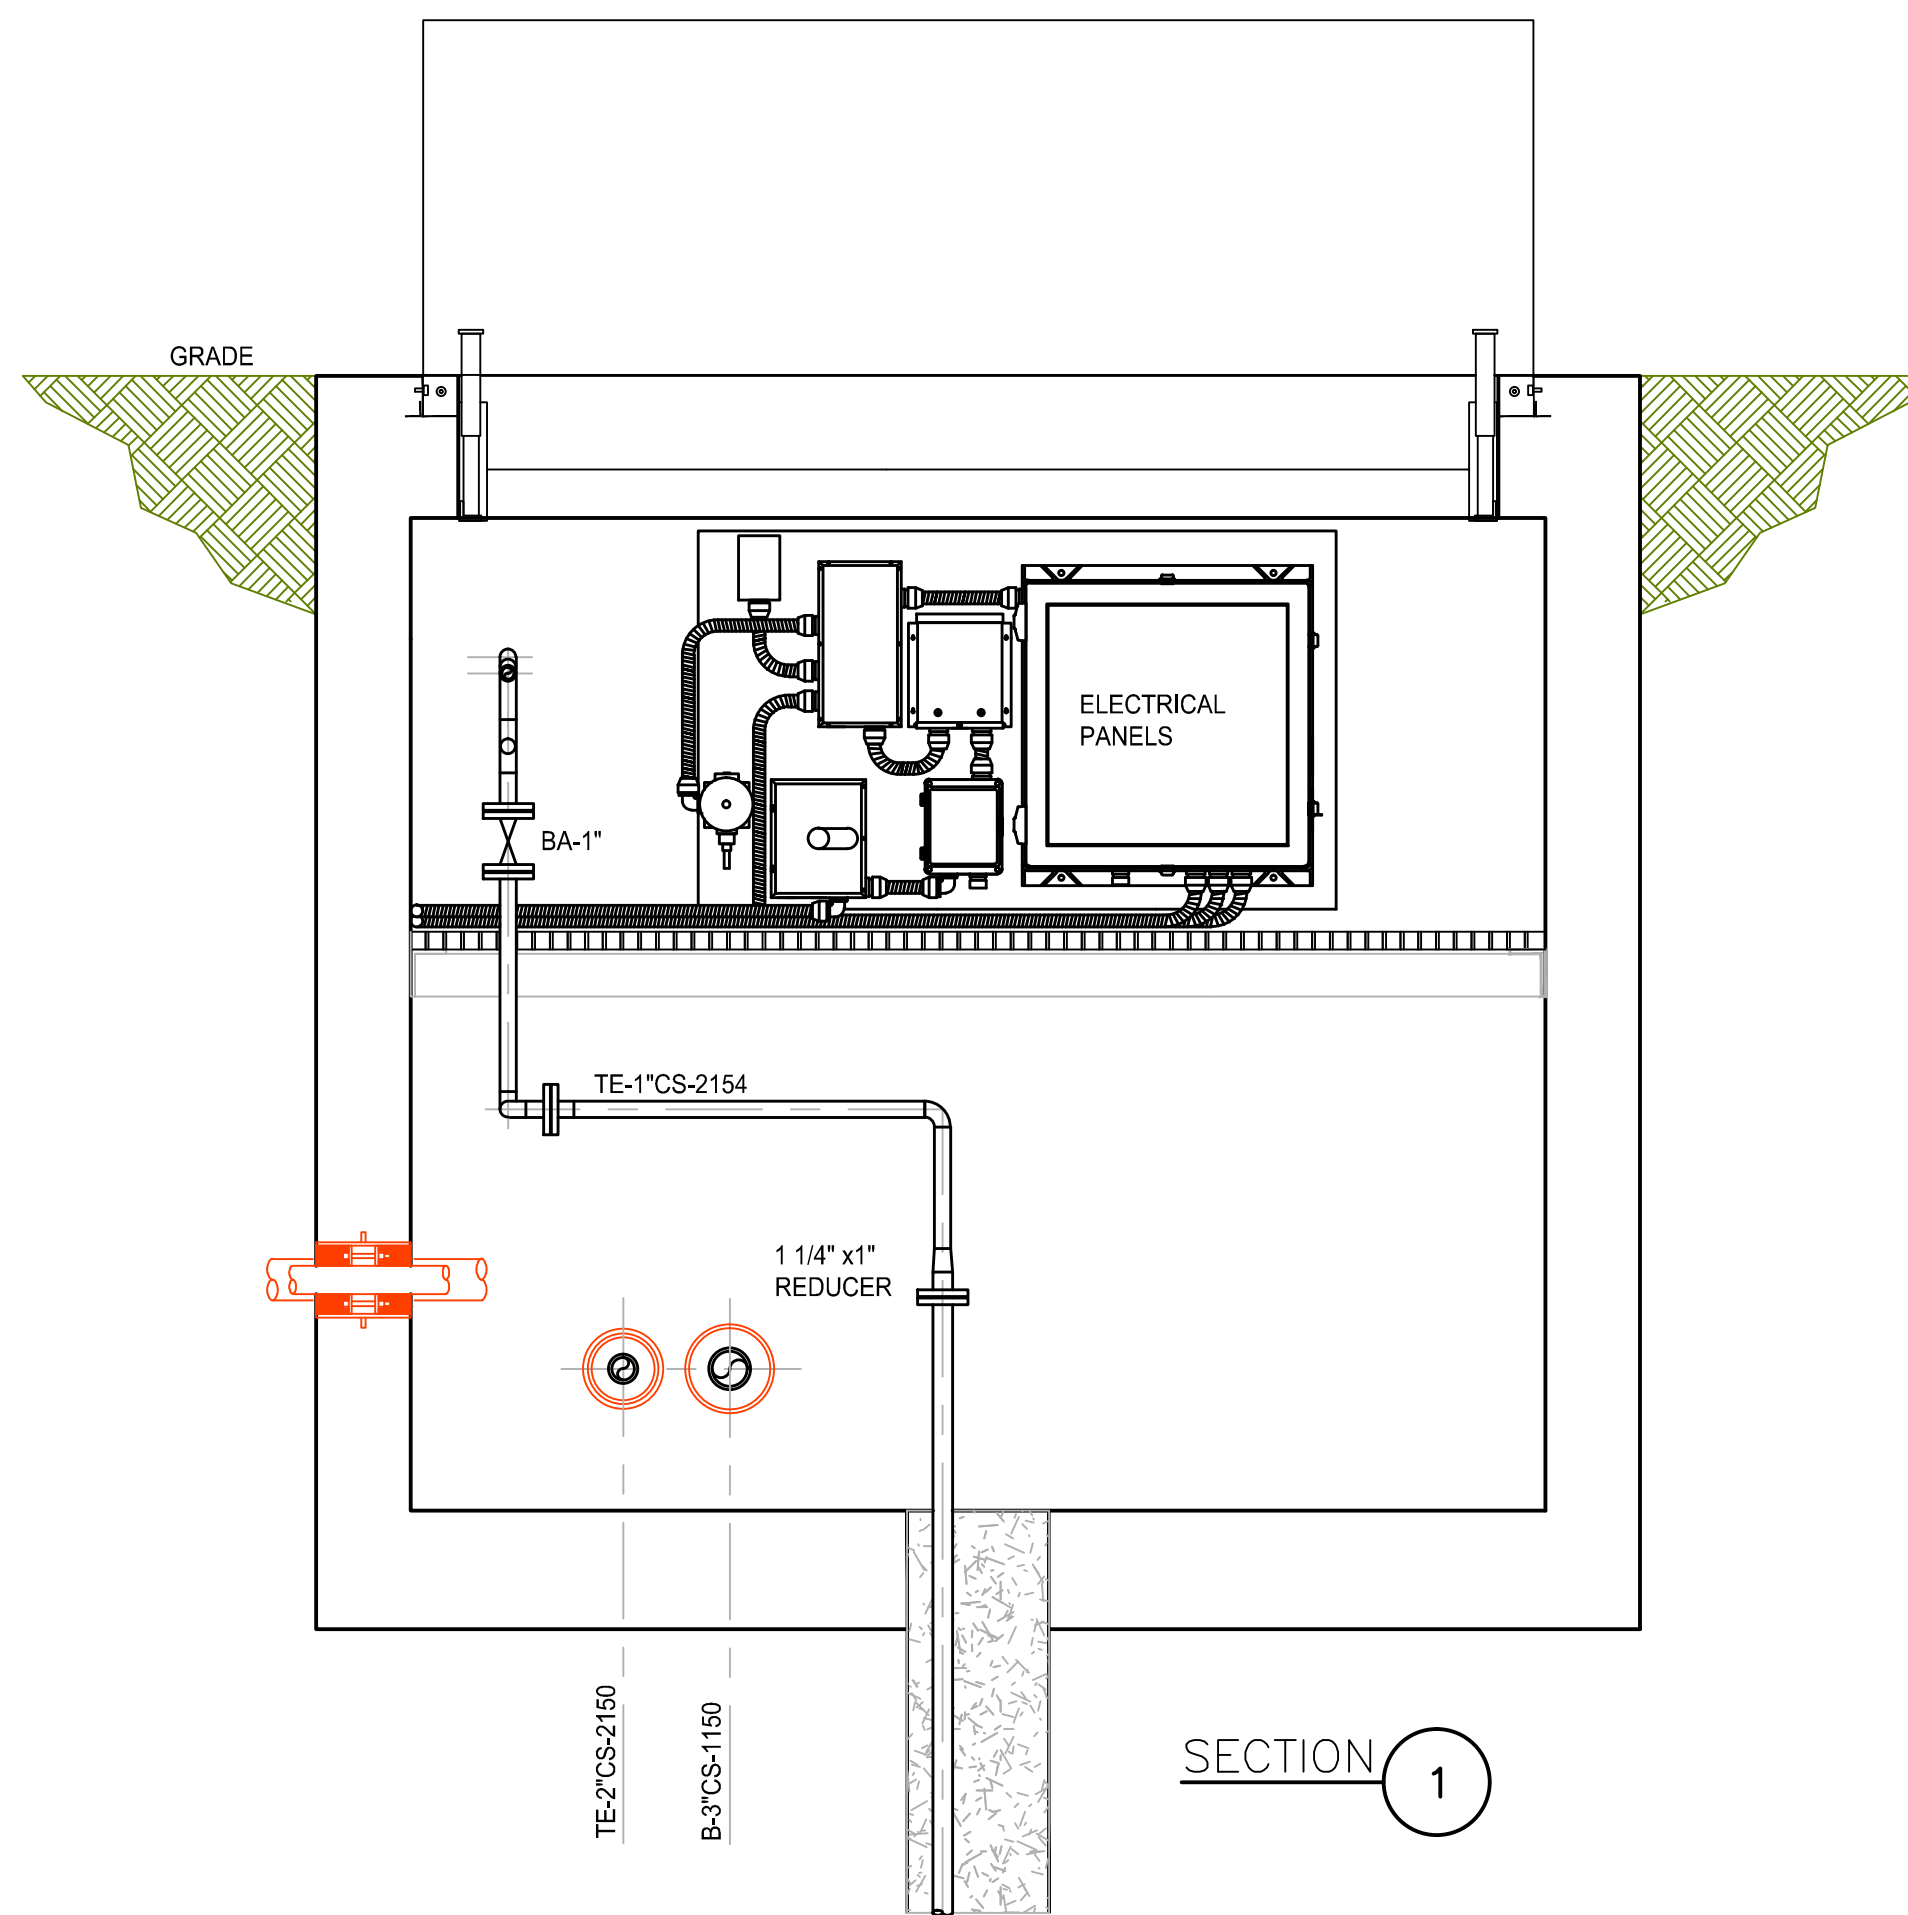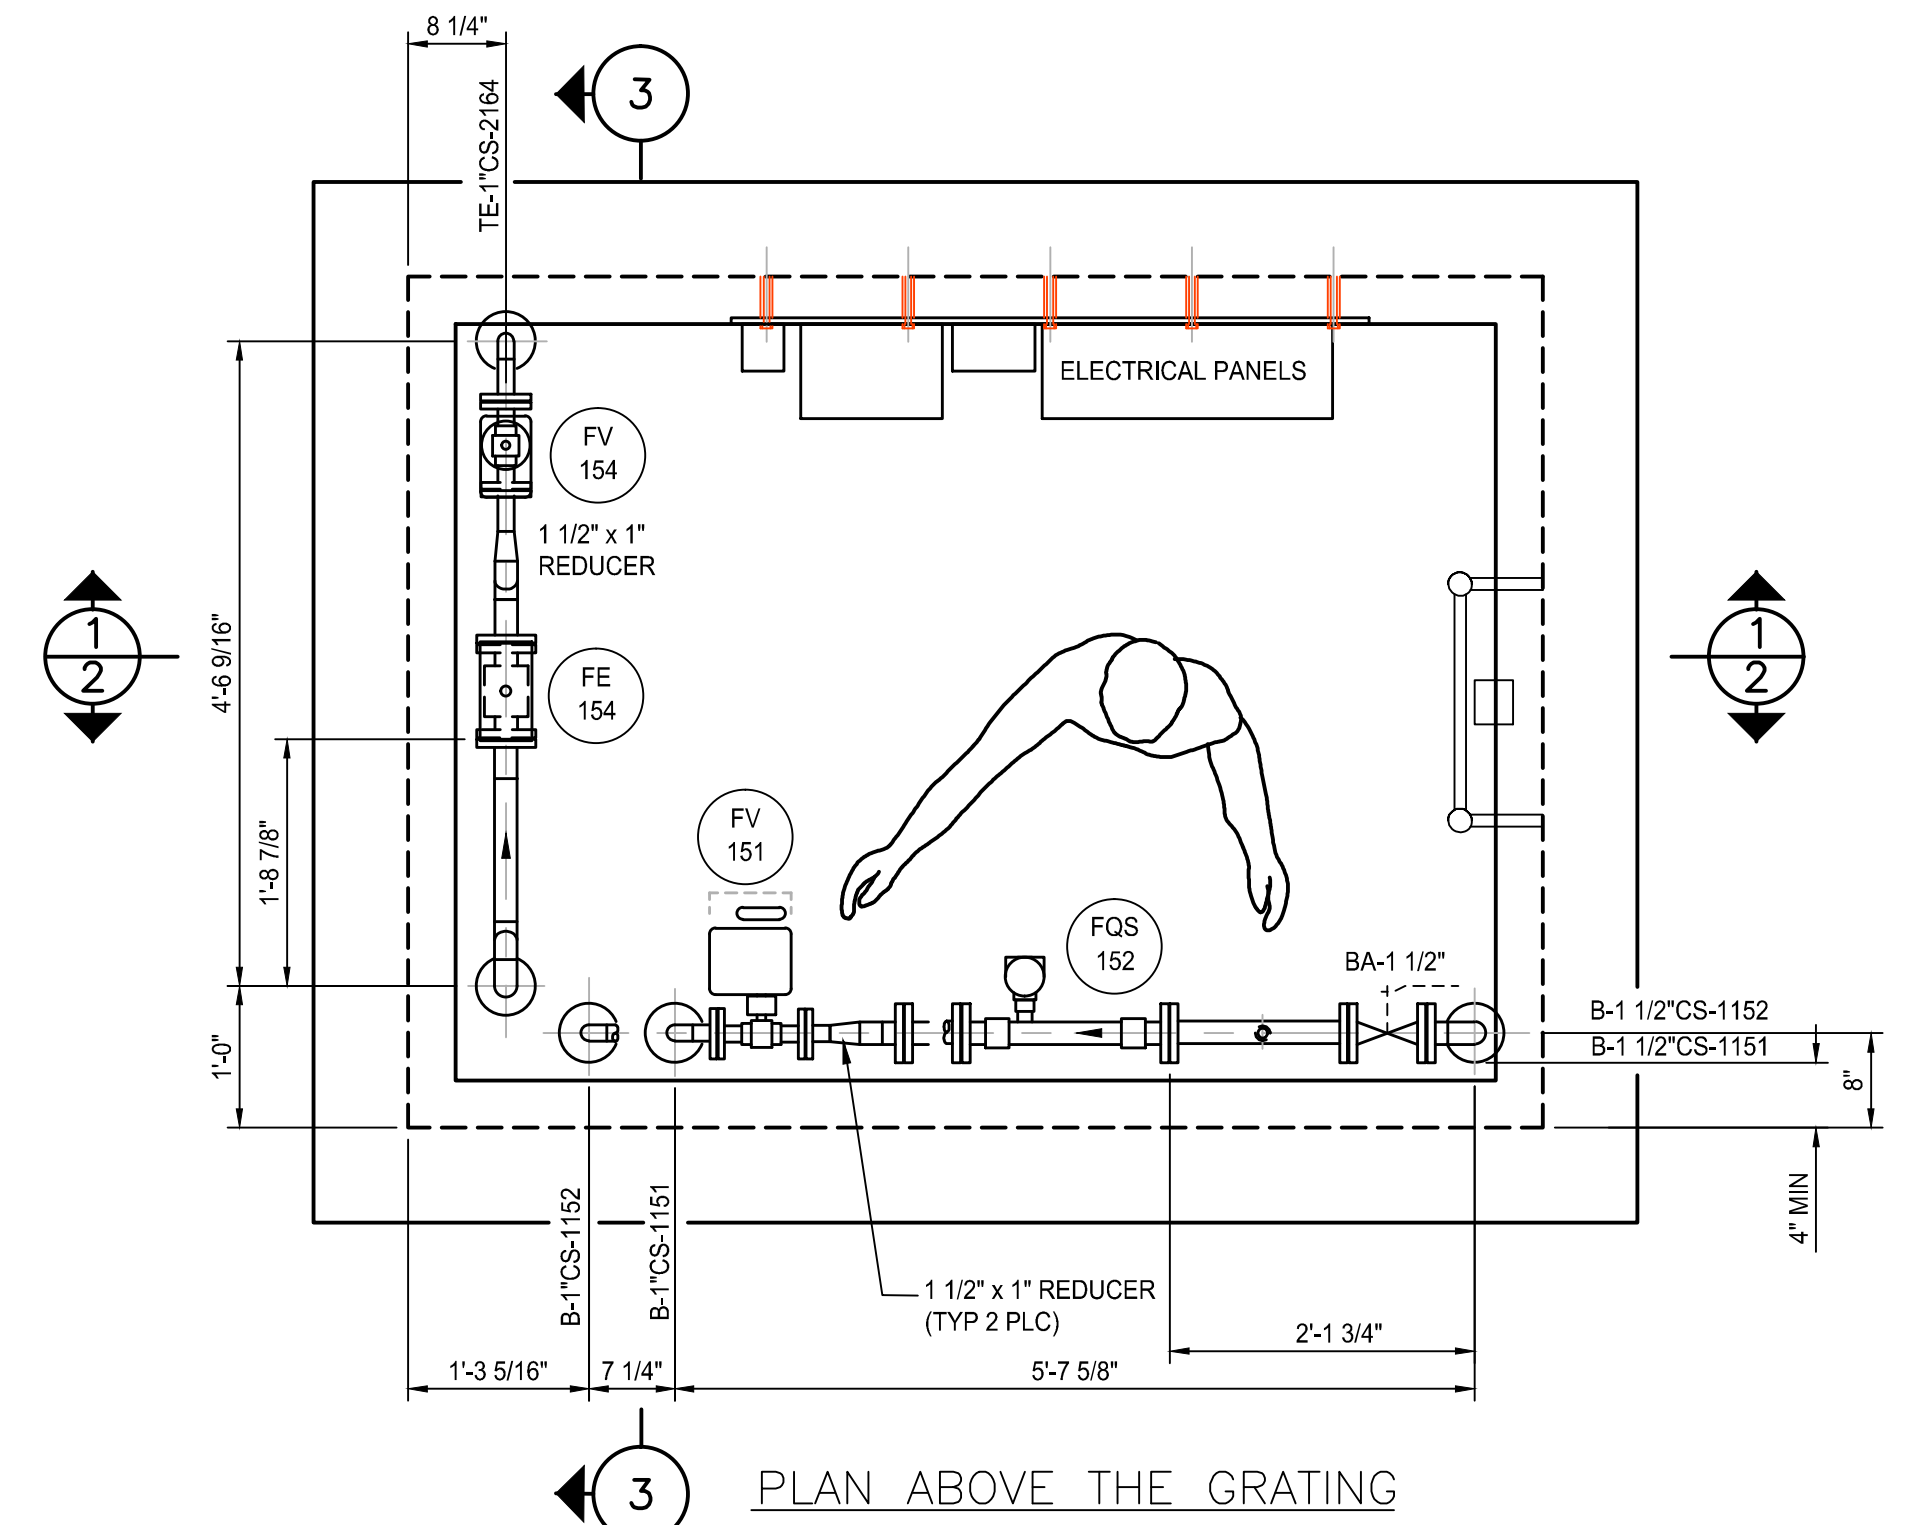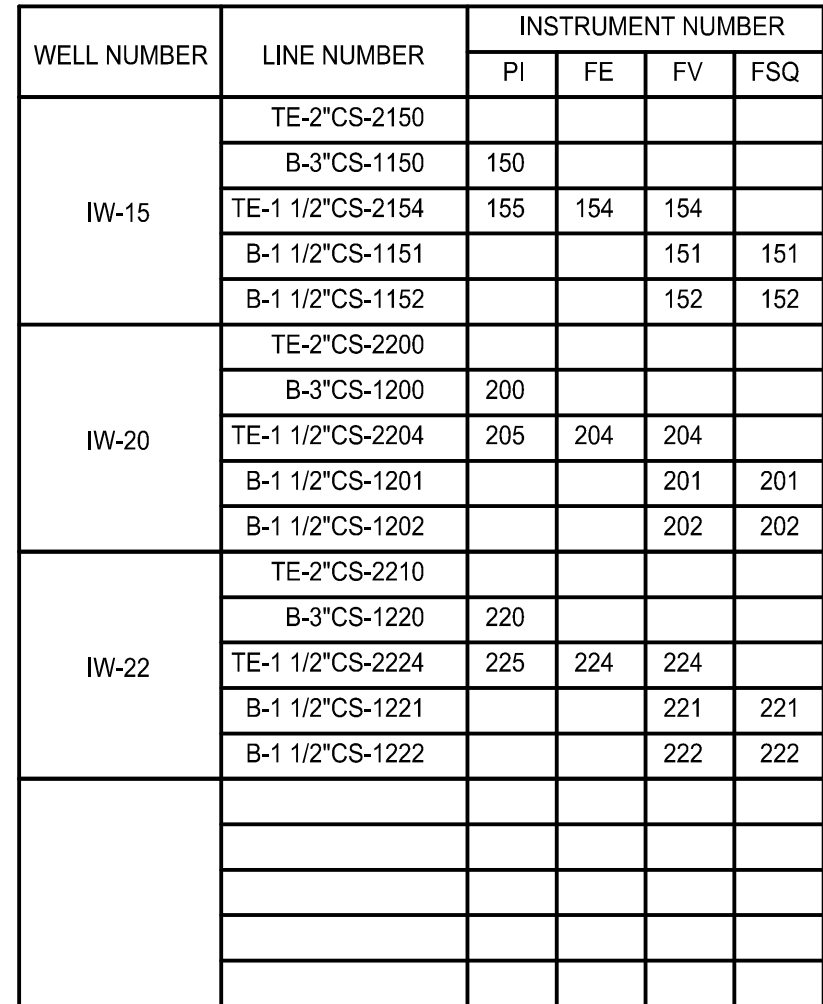

SCALE VERIFICATION: THIS BAR MEASURES 1" ON ORIGINAL. ADJUST SCALE ACCORDINGLY.			
			
1	AS BUILT	08/29/12	LV
No	Revision	Date	Initial

HOOKER/RUCO SITE  
HICKSVILLE, NEW YORK

---

BIOSPARGE TREATMENT SYSTEM


---

INJECTION WELLS IW-15, 20 AND 22  
PLAN AND SECTIONS

06883-00(056)MP-BU007 AUG 08/2012





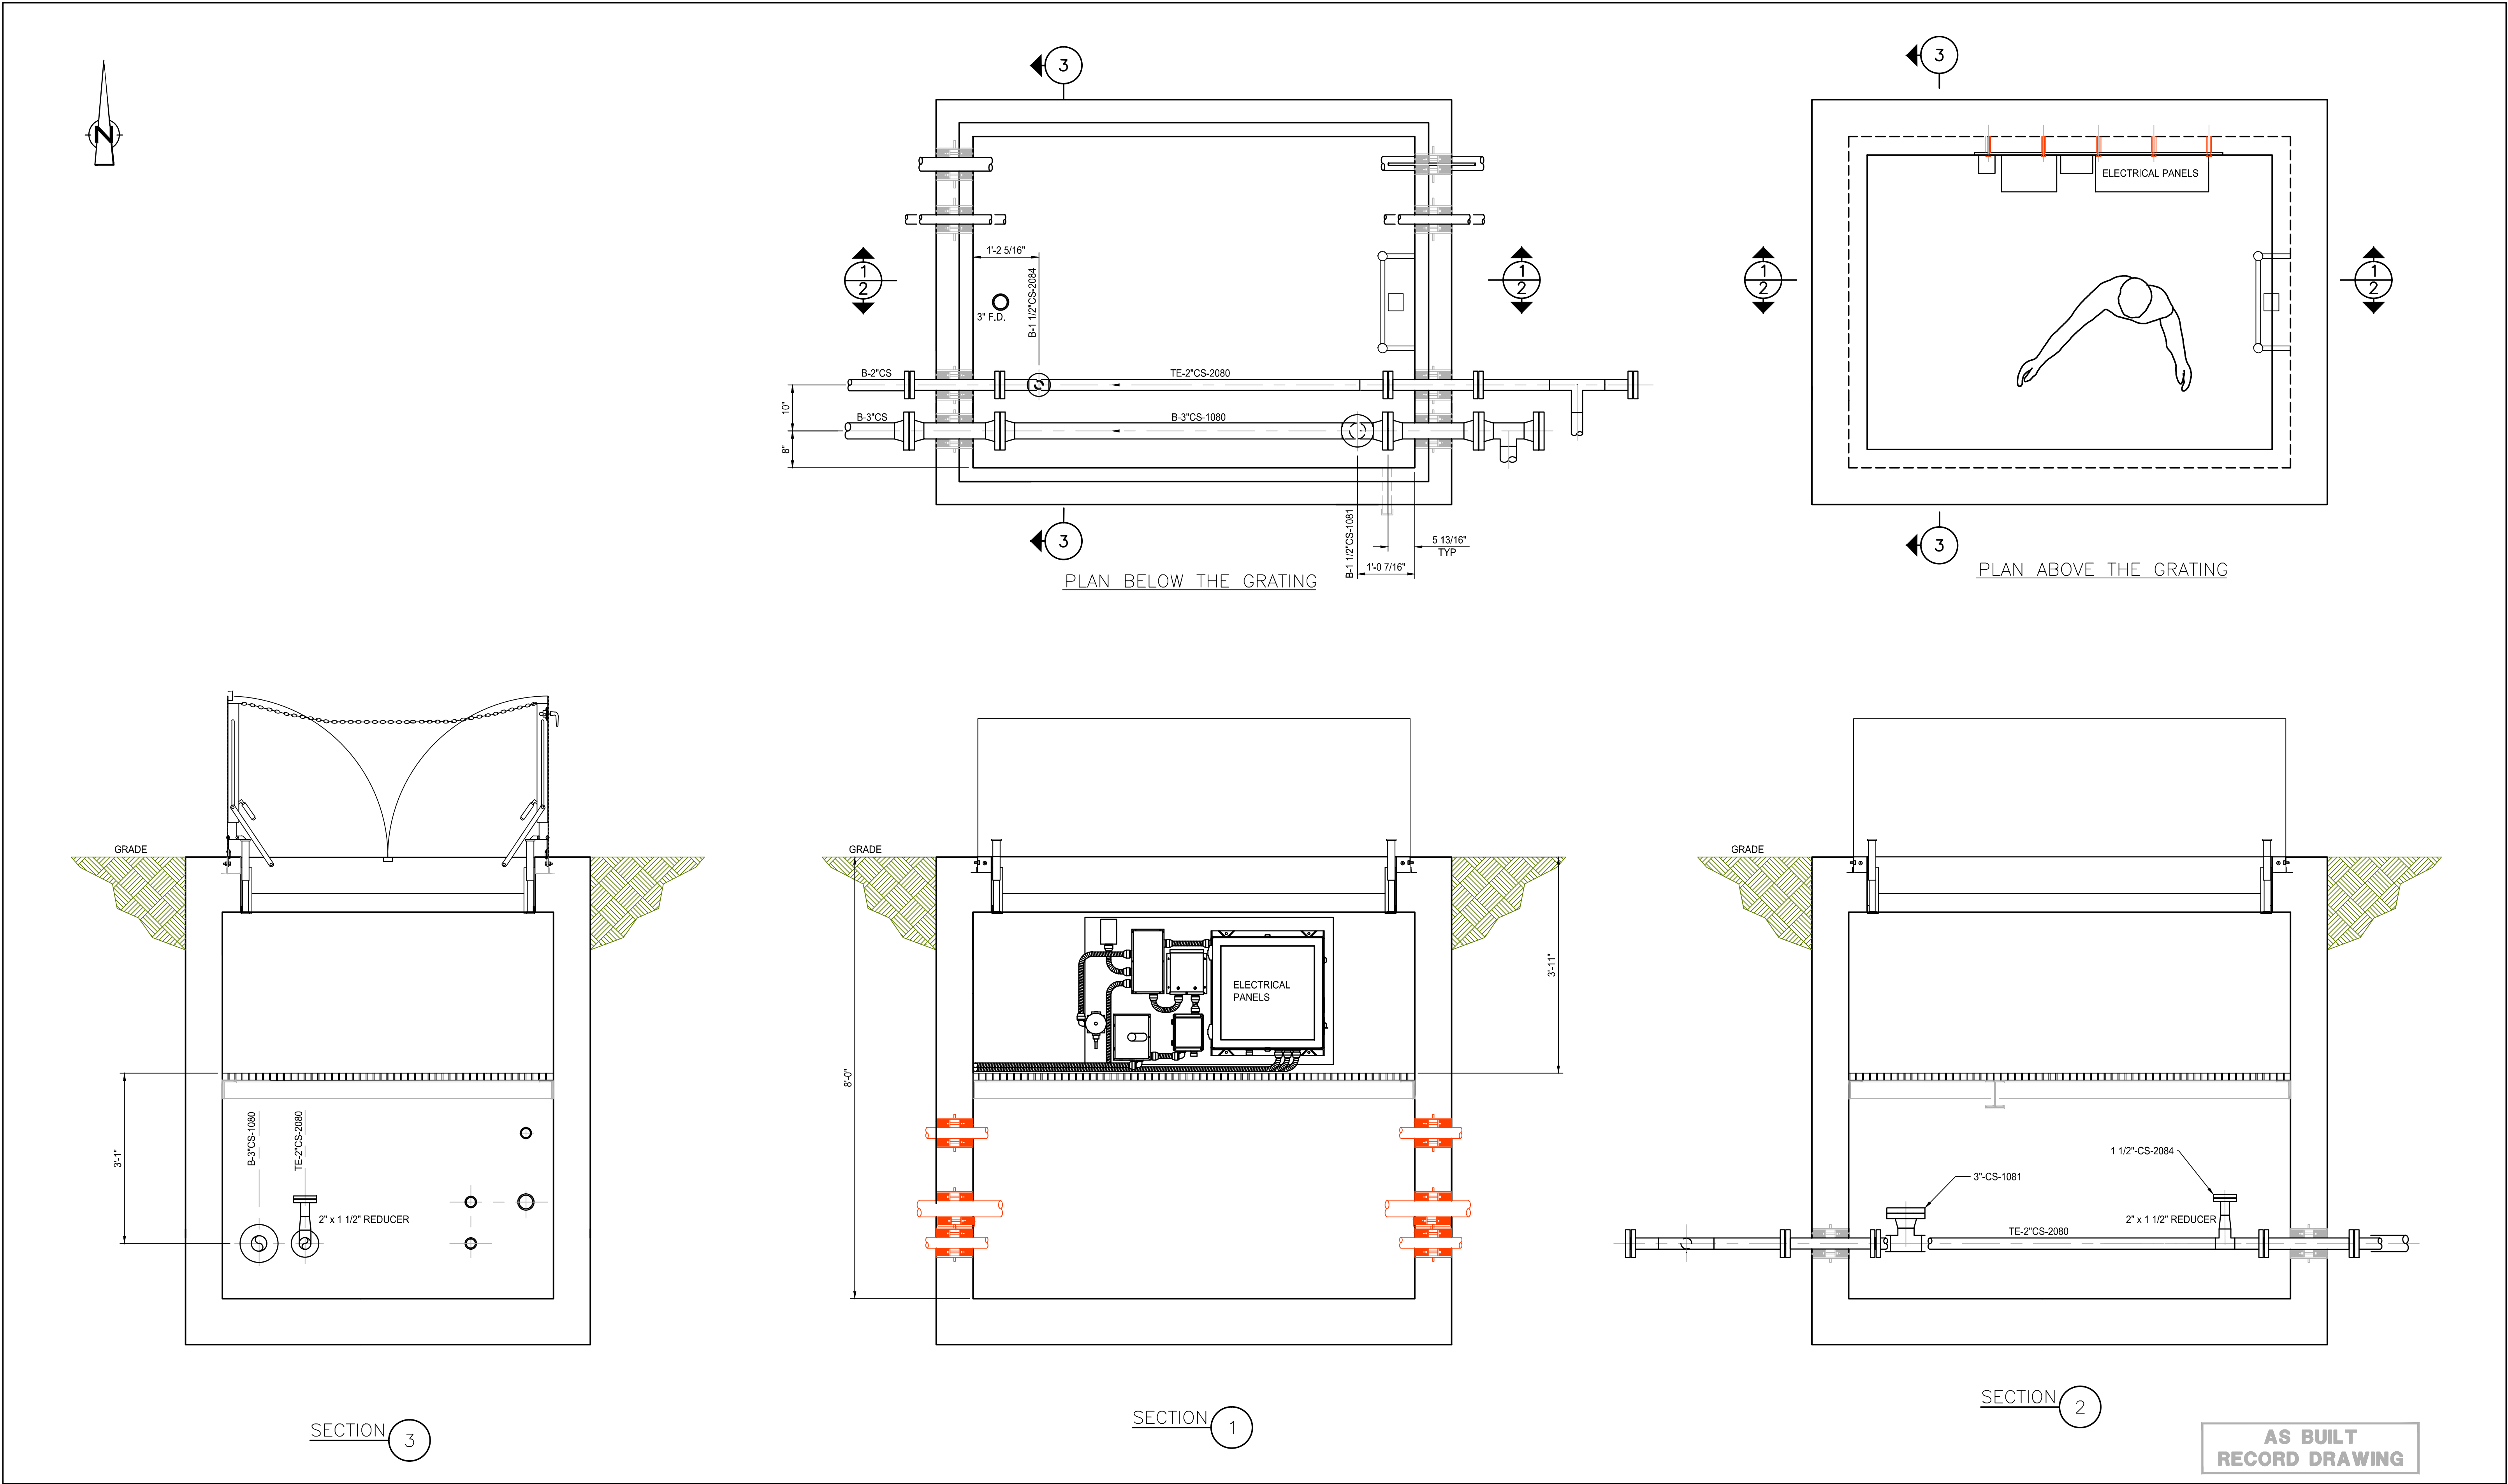

NOTES:

1. WELLS IW-01 THRU IW-07 ARE LOCATED NORTH OF THE CONTROL BUILDING. THESE VAULTS ARE POSITIONED WITH THE WELL LOCATED ON THE NORTH SIDE OF THE VAULT.
2. WELLS IW-15 THRU IW-22 ARE LOCATED JUST NORTH OF THE CONTROL BUILDING. THESE VAULTS ARE POSITIONED WITH THE WELL LOCATED ON THE SOUTH SIDE OF THE VAULT.
3. ALL AIR, LIQUID, CONTROL, AND ELECTRICAL LINES PASS THRU THE VAULTS, EXCEPT IW-1, IW-8, IW-15, AND IW-22. CONTRACTOR PLUGGED ANY ADDITIONAL HOLES IN THESE VAULTS.

SCALE VERIFICATION: THIS BAR MEASURES 1" ON ORIGINAL. ADJUST SCALE ACCORDINGLY.			
1	AS BUILT	08/29/12	LV
No	Revision	Date	Initial

WARNING: ALTERING THIS DOCUMENT IS IN VIOLATION OF THE NEW YORK STATE EDUCATION LAW EXCEPTING AS PROVIDED IN SECTION 7209, PART 2 OF THE LAW.


HOOVER/RUCO SITE  
HICKSVILLE, NEW YORK

BIOSPARGE TREATMENT SYSTEM


INJECTION WELL IW-08  
PLAN AND SECTIONS

		<b>CRA Infrastructure &amp; Engineering, Inc.</b>	
Source Reference:		Date:	
Project Manager:		Reviewed By:	
J. KAY		B. A. BEEBE	
Designed By:		Drawn By:	
B. A. BEEBE		B. A. BEEBE	
Scale:		Project No:	
NONE		06883-00	
Report No:		Drawing No:	
056		MP-09	




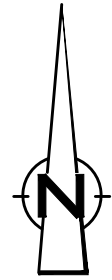


WELL NUMBER	LINE NUMBER	INSTRUMENT NUMBER				TIE POINT NUMBER
		PI	FE	FV	FSQ	
IW-01	TE-2"CS-2010					TP-72
	B-3"CS-1010	010				TP-71
	TE-1 1/2"CS-2014	015	014	014		
	B-1 1/2"CS-1011			011		
IW-02	B-1 1/2"CS-1012			012	012	TP-67,TP-69
	TE-2"CS-2020					TP-69,TP-70
	B-3"CS-1020	020				
	TE-1 1/2"CS-2024	025	024	024		
IW-03	B-1 1/2"CS-1021			021		
	B-1 1/2"CS-1022			022	022	
	TE-2"CS-2030					TP-64,TP-66
	B-3"CS-1030	030				TP-63,TP-65
IW-04	TE-1 1/2"CS-2034	035	034	034		
	B-1 1/2"CS-1031			031	031	
	B-1 1/2"CS-1032			032	032	
	TE-2"CS-2040					TP-45,TP-47
IW-05	B-3"CS-1040	040				TP-44,TP-46
	TE-1 1/2"CS-2044	045	044	044		
	B-1 1/2"CS-1041			041	041	
	B-1 1/2"CS-1042			042	042	
IW-06	TE-2"CS-2050					TP-41,TP-43
	B-3"CS-1050	050				TP-40,TP-42
	TE-1 1/2"CS-2054	055	054	054		
	B-1 1/2"CS-1051			051	051	
IW-07	B-1 1/2"CS-1052			052	052	
	TE-2"CS-2060					TP-37,TP-39
	B-3"CS-1060	060				TP-36,TP-38
	TE-1 1/2"CS-2064	065	064	064		
IW-08	B-1 1/2"CS-1061			061	061	
	B-1 1/2"CS-1062			062	062	
	TE-2"CS-2070					TP-33,TP-35
	B-3"CS-1070	070				TP-32,TP-34
IW-09	TE-1 1/2"CS-2074	075	074	074		
	B-1 1/2"CS-1071			071	071	
	B-1 1/2"CS-1072			072	072	

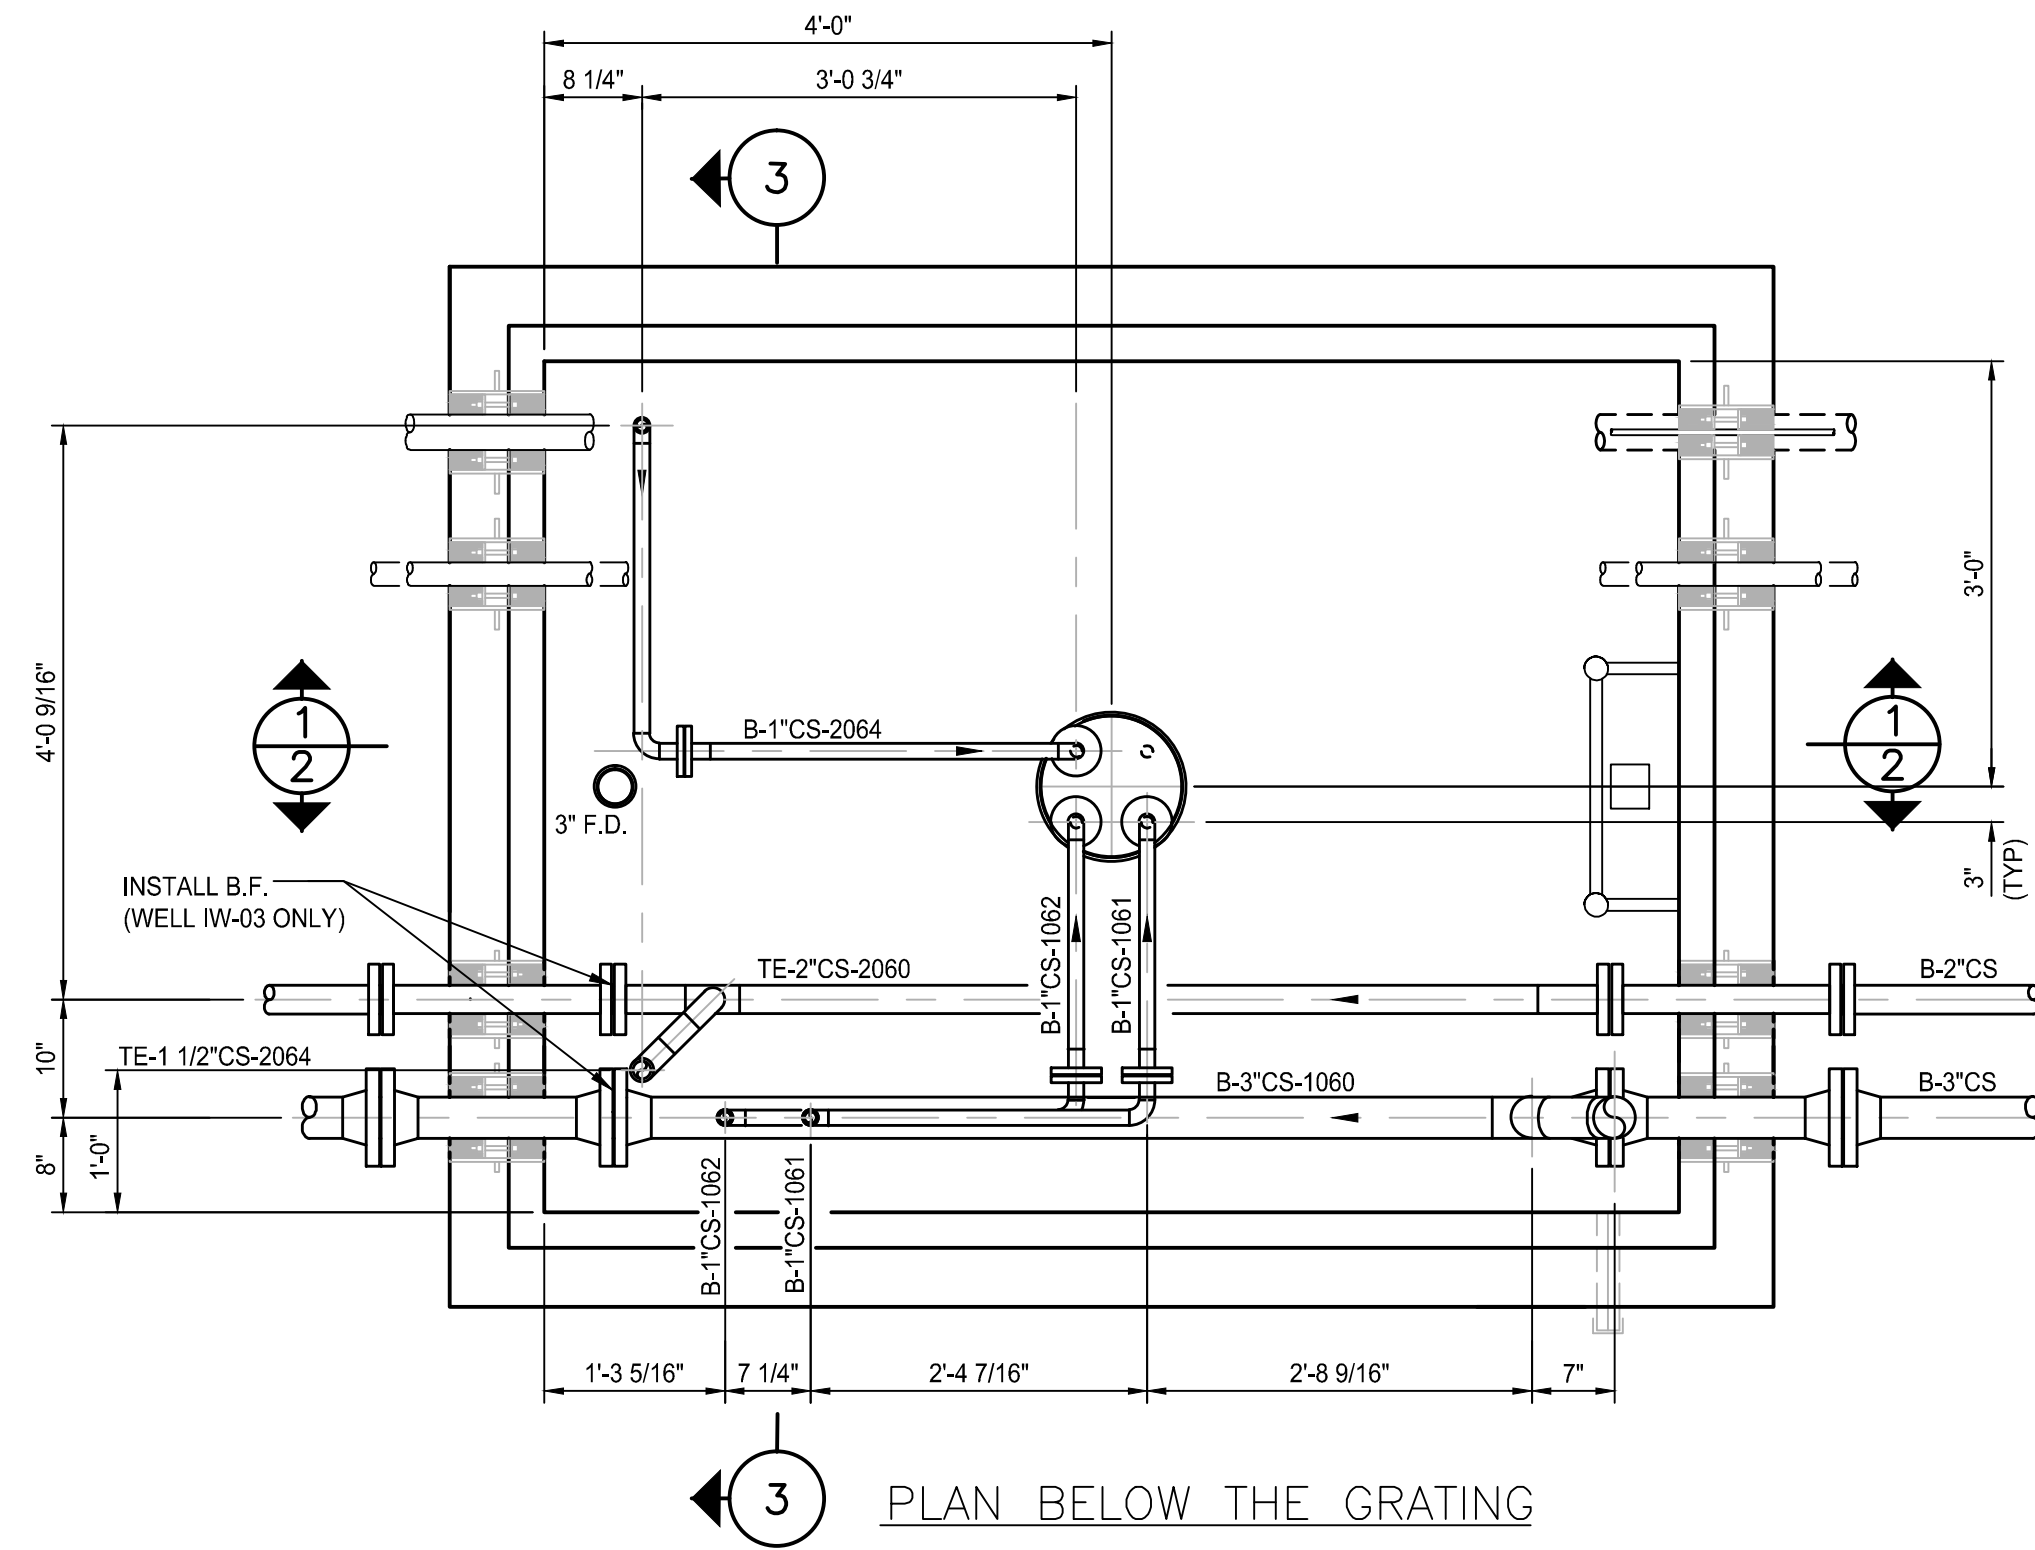


PLAN BELOW THE GRATING

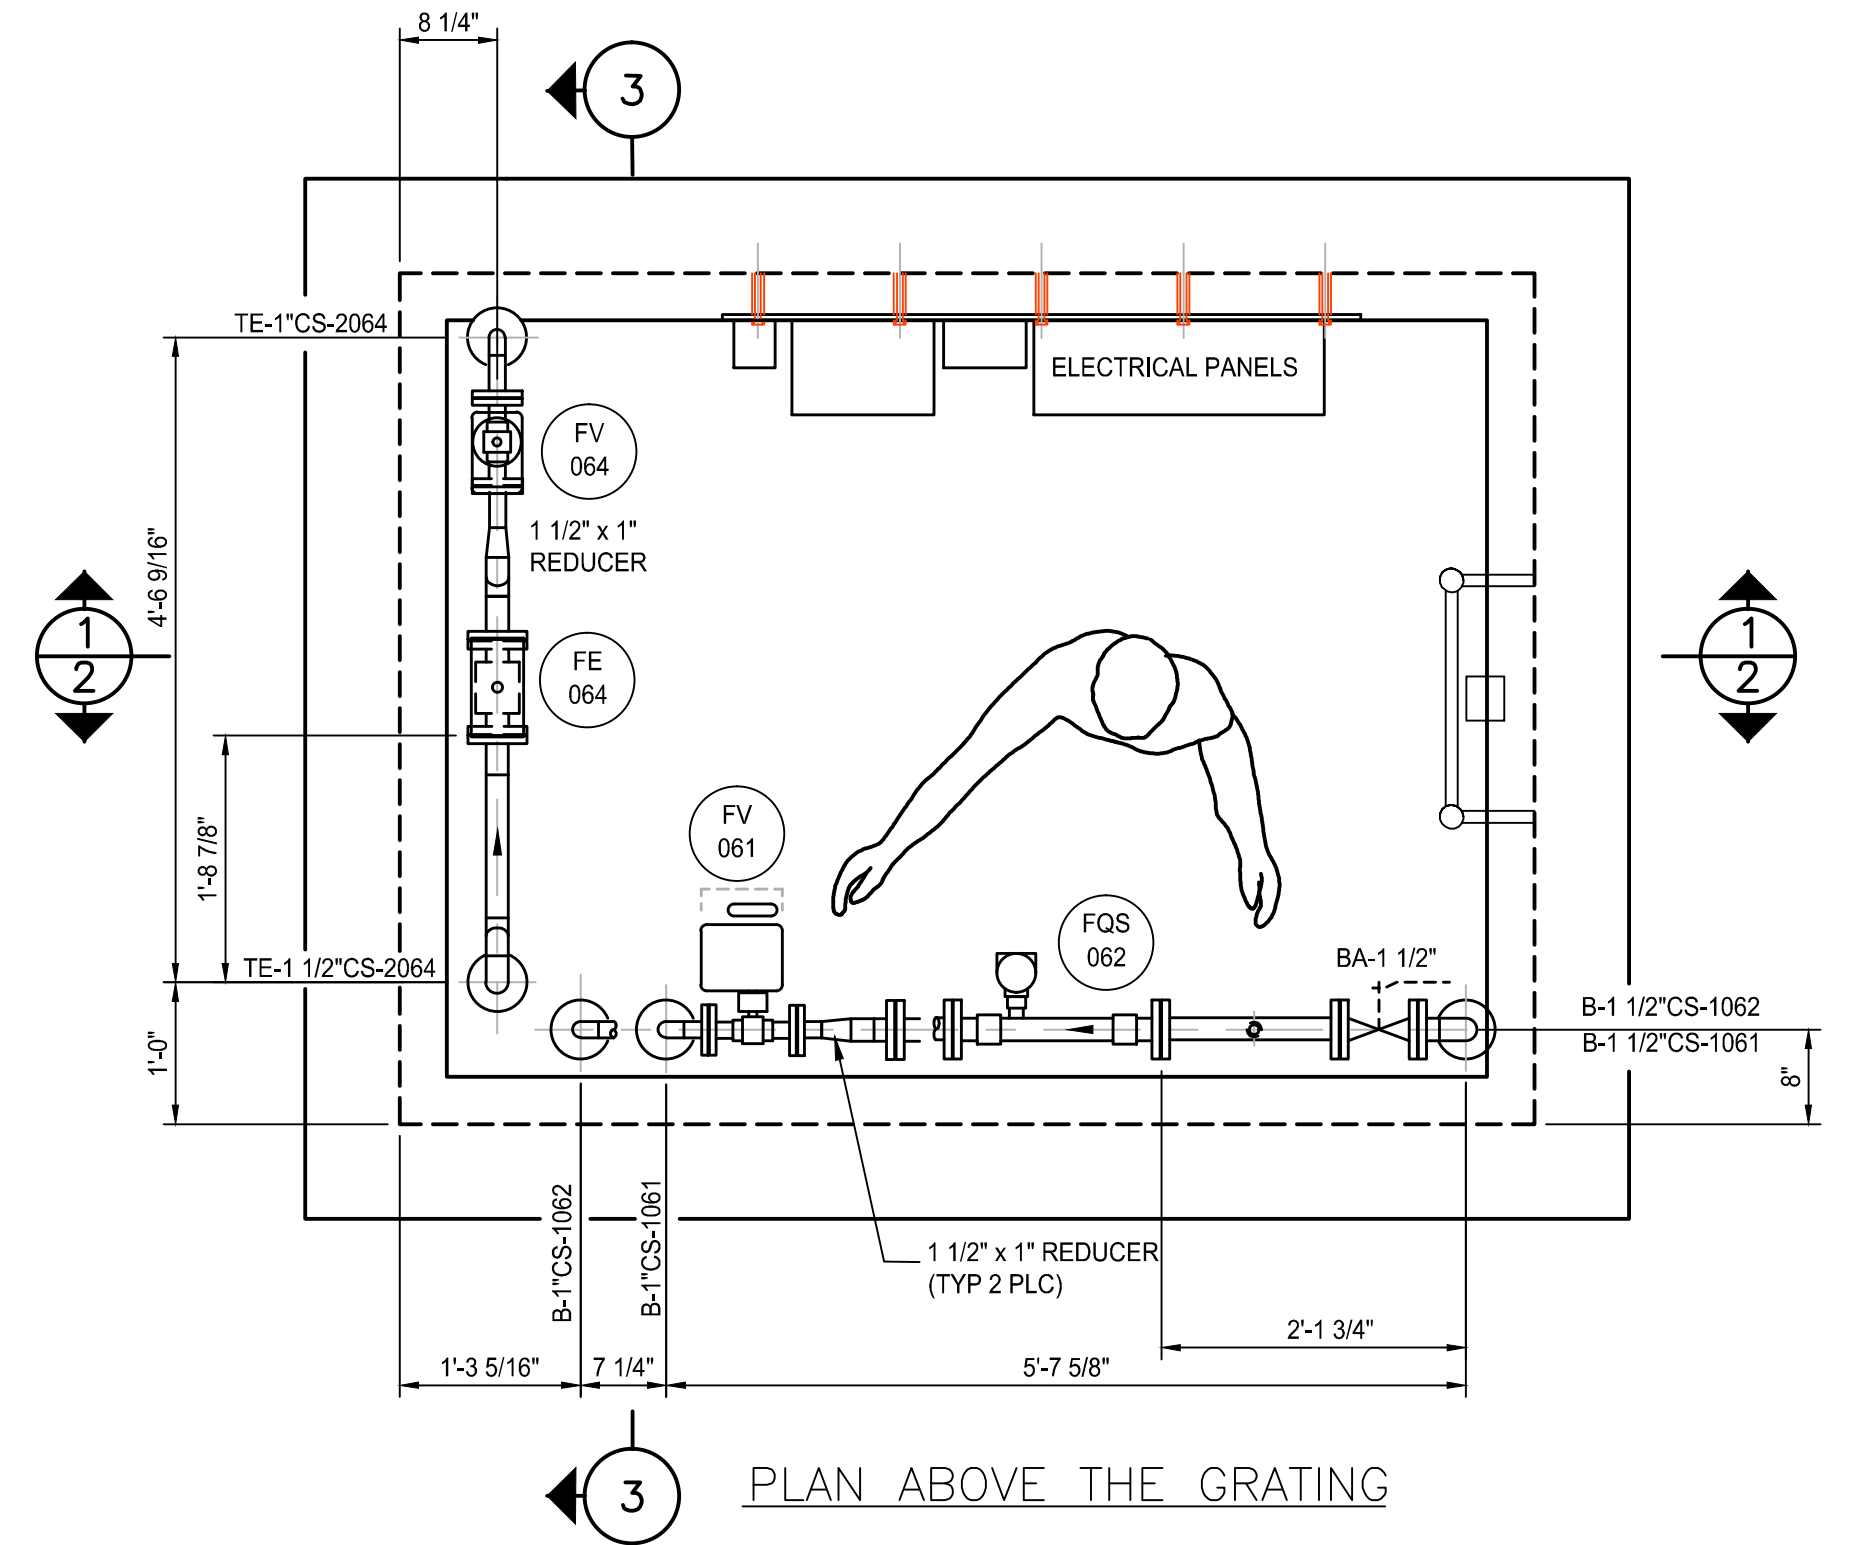


PLAN ABOVE THE GRATING

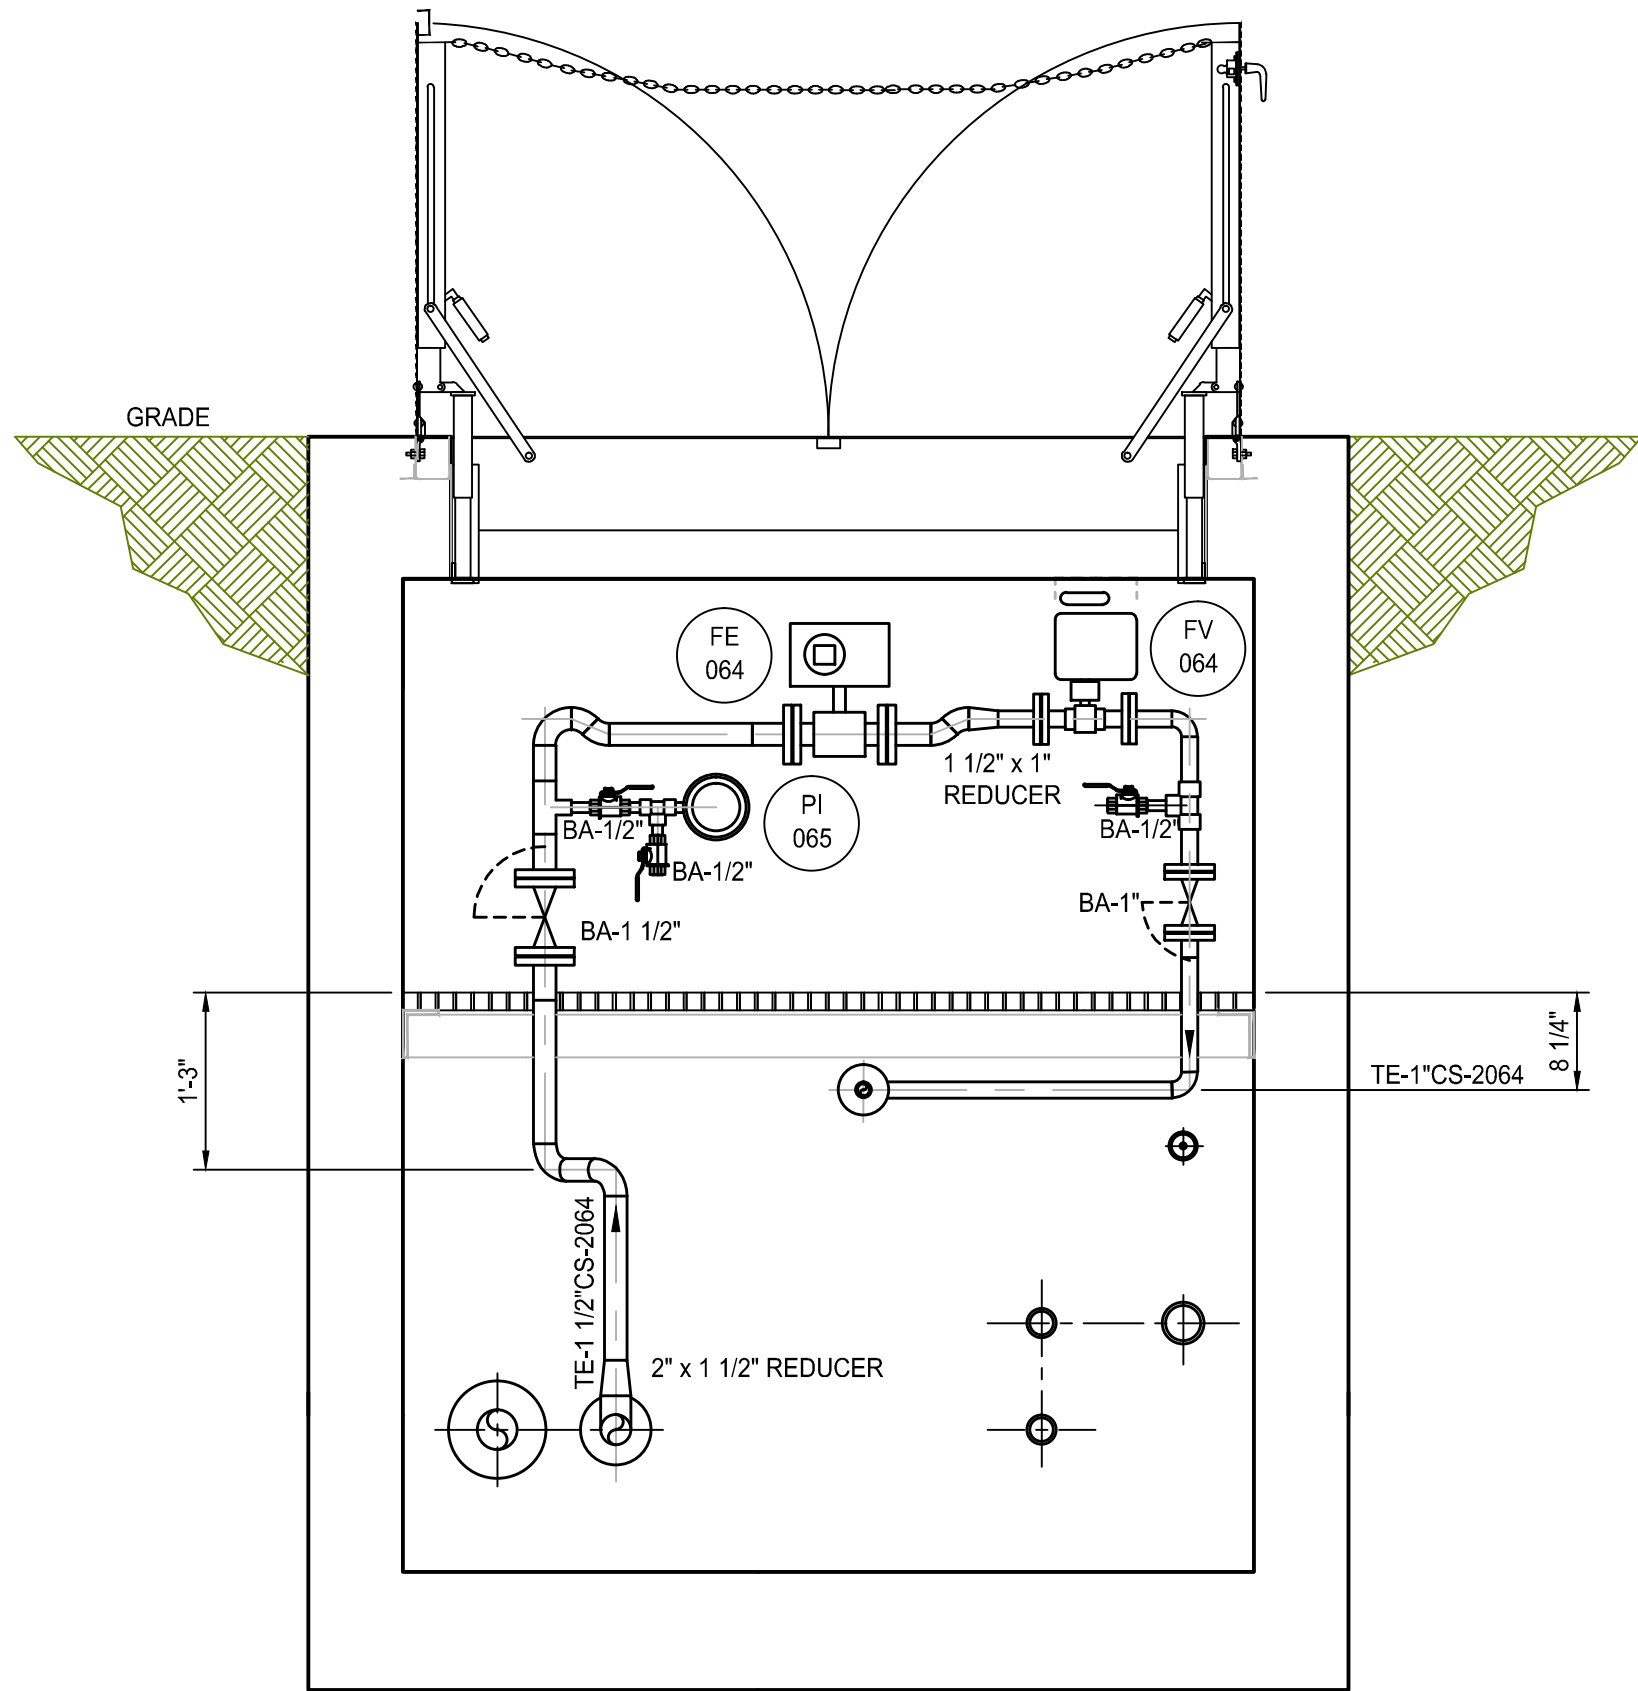

SECTION 3

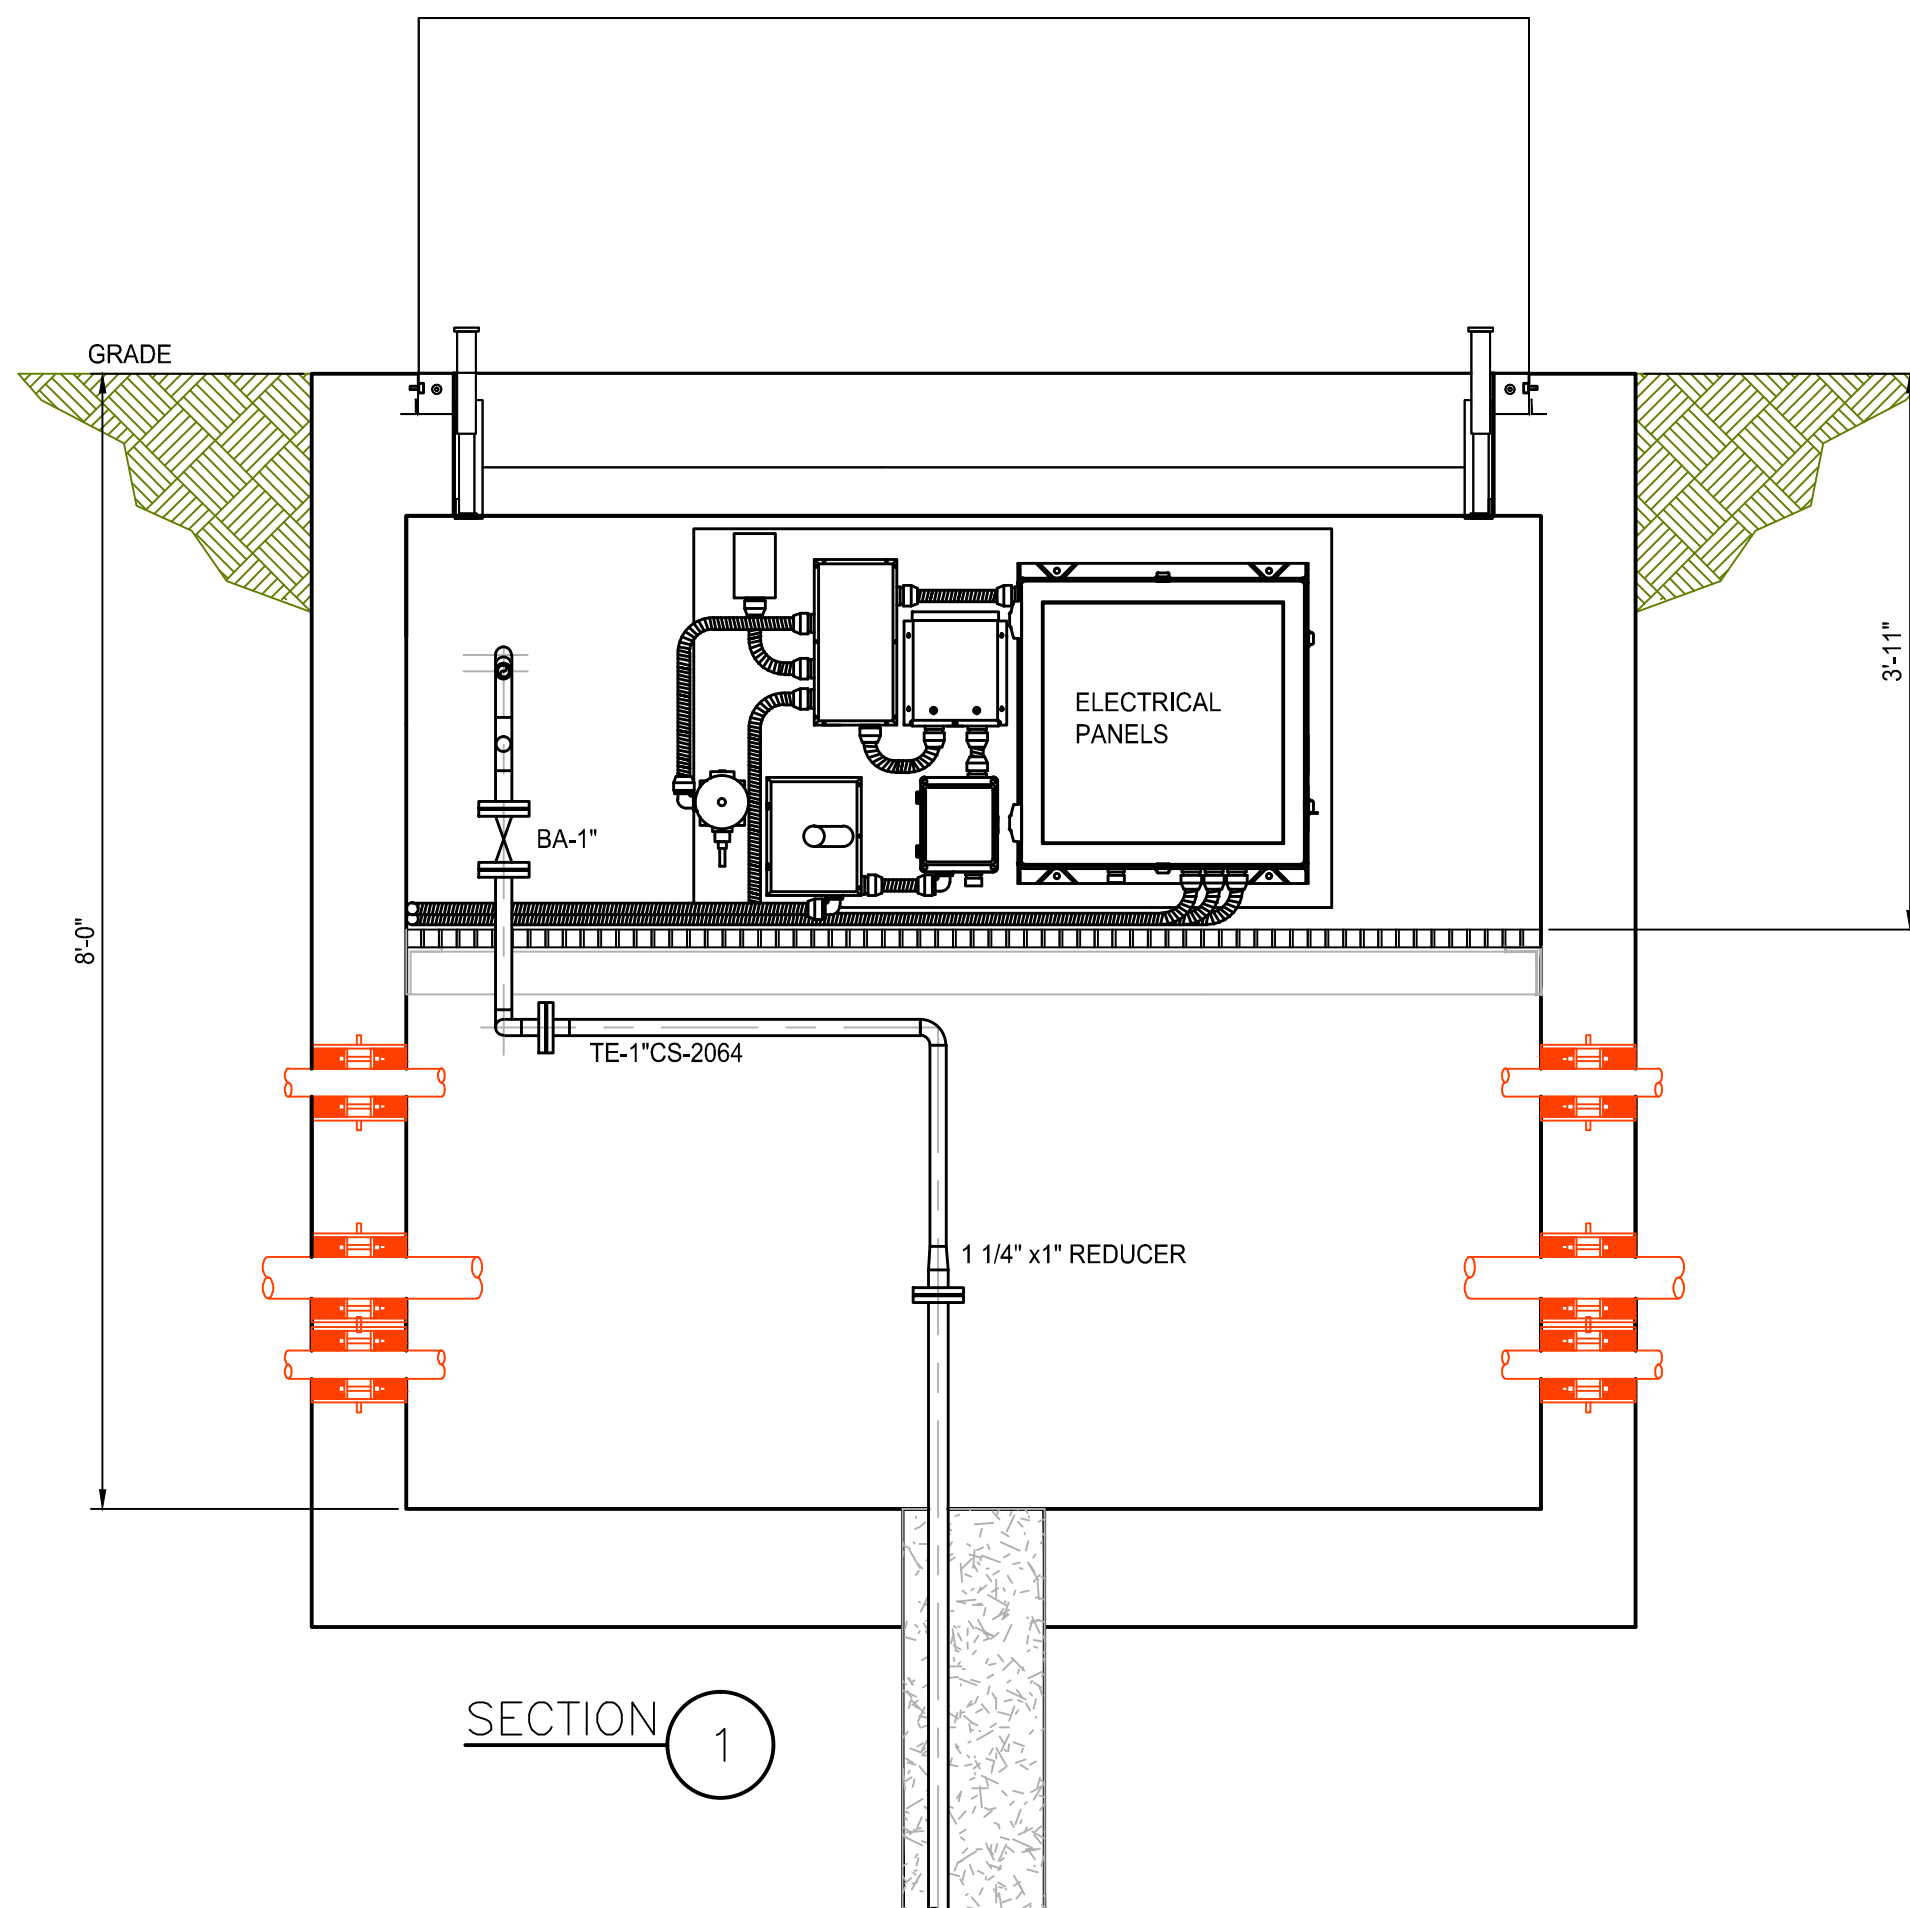

SECTION 1

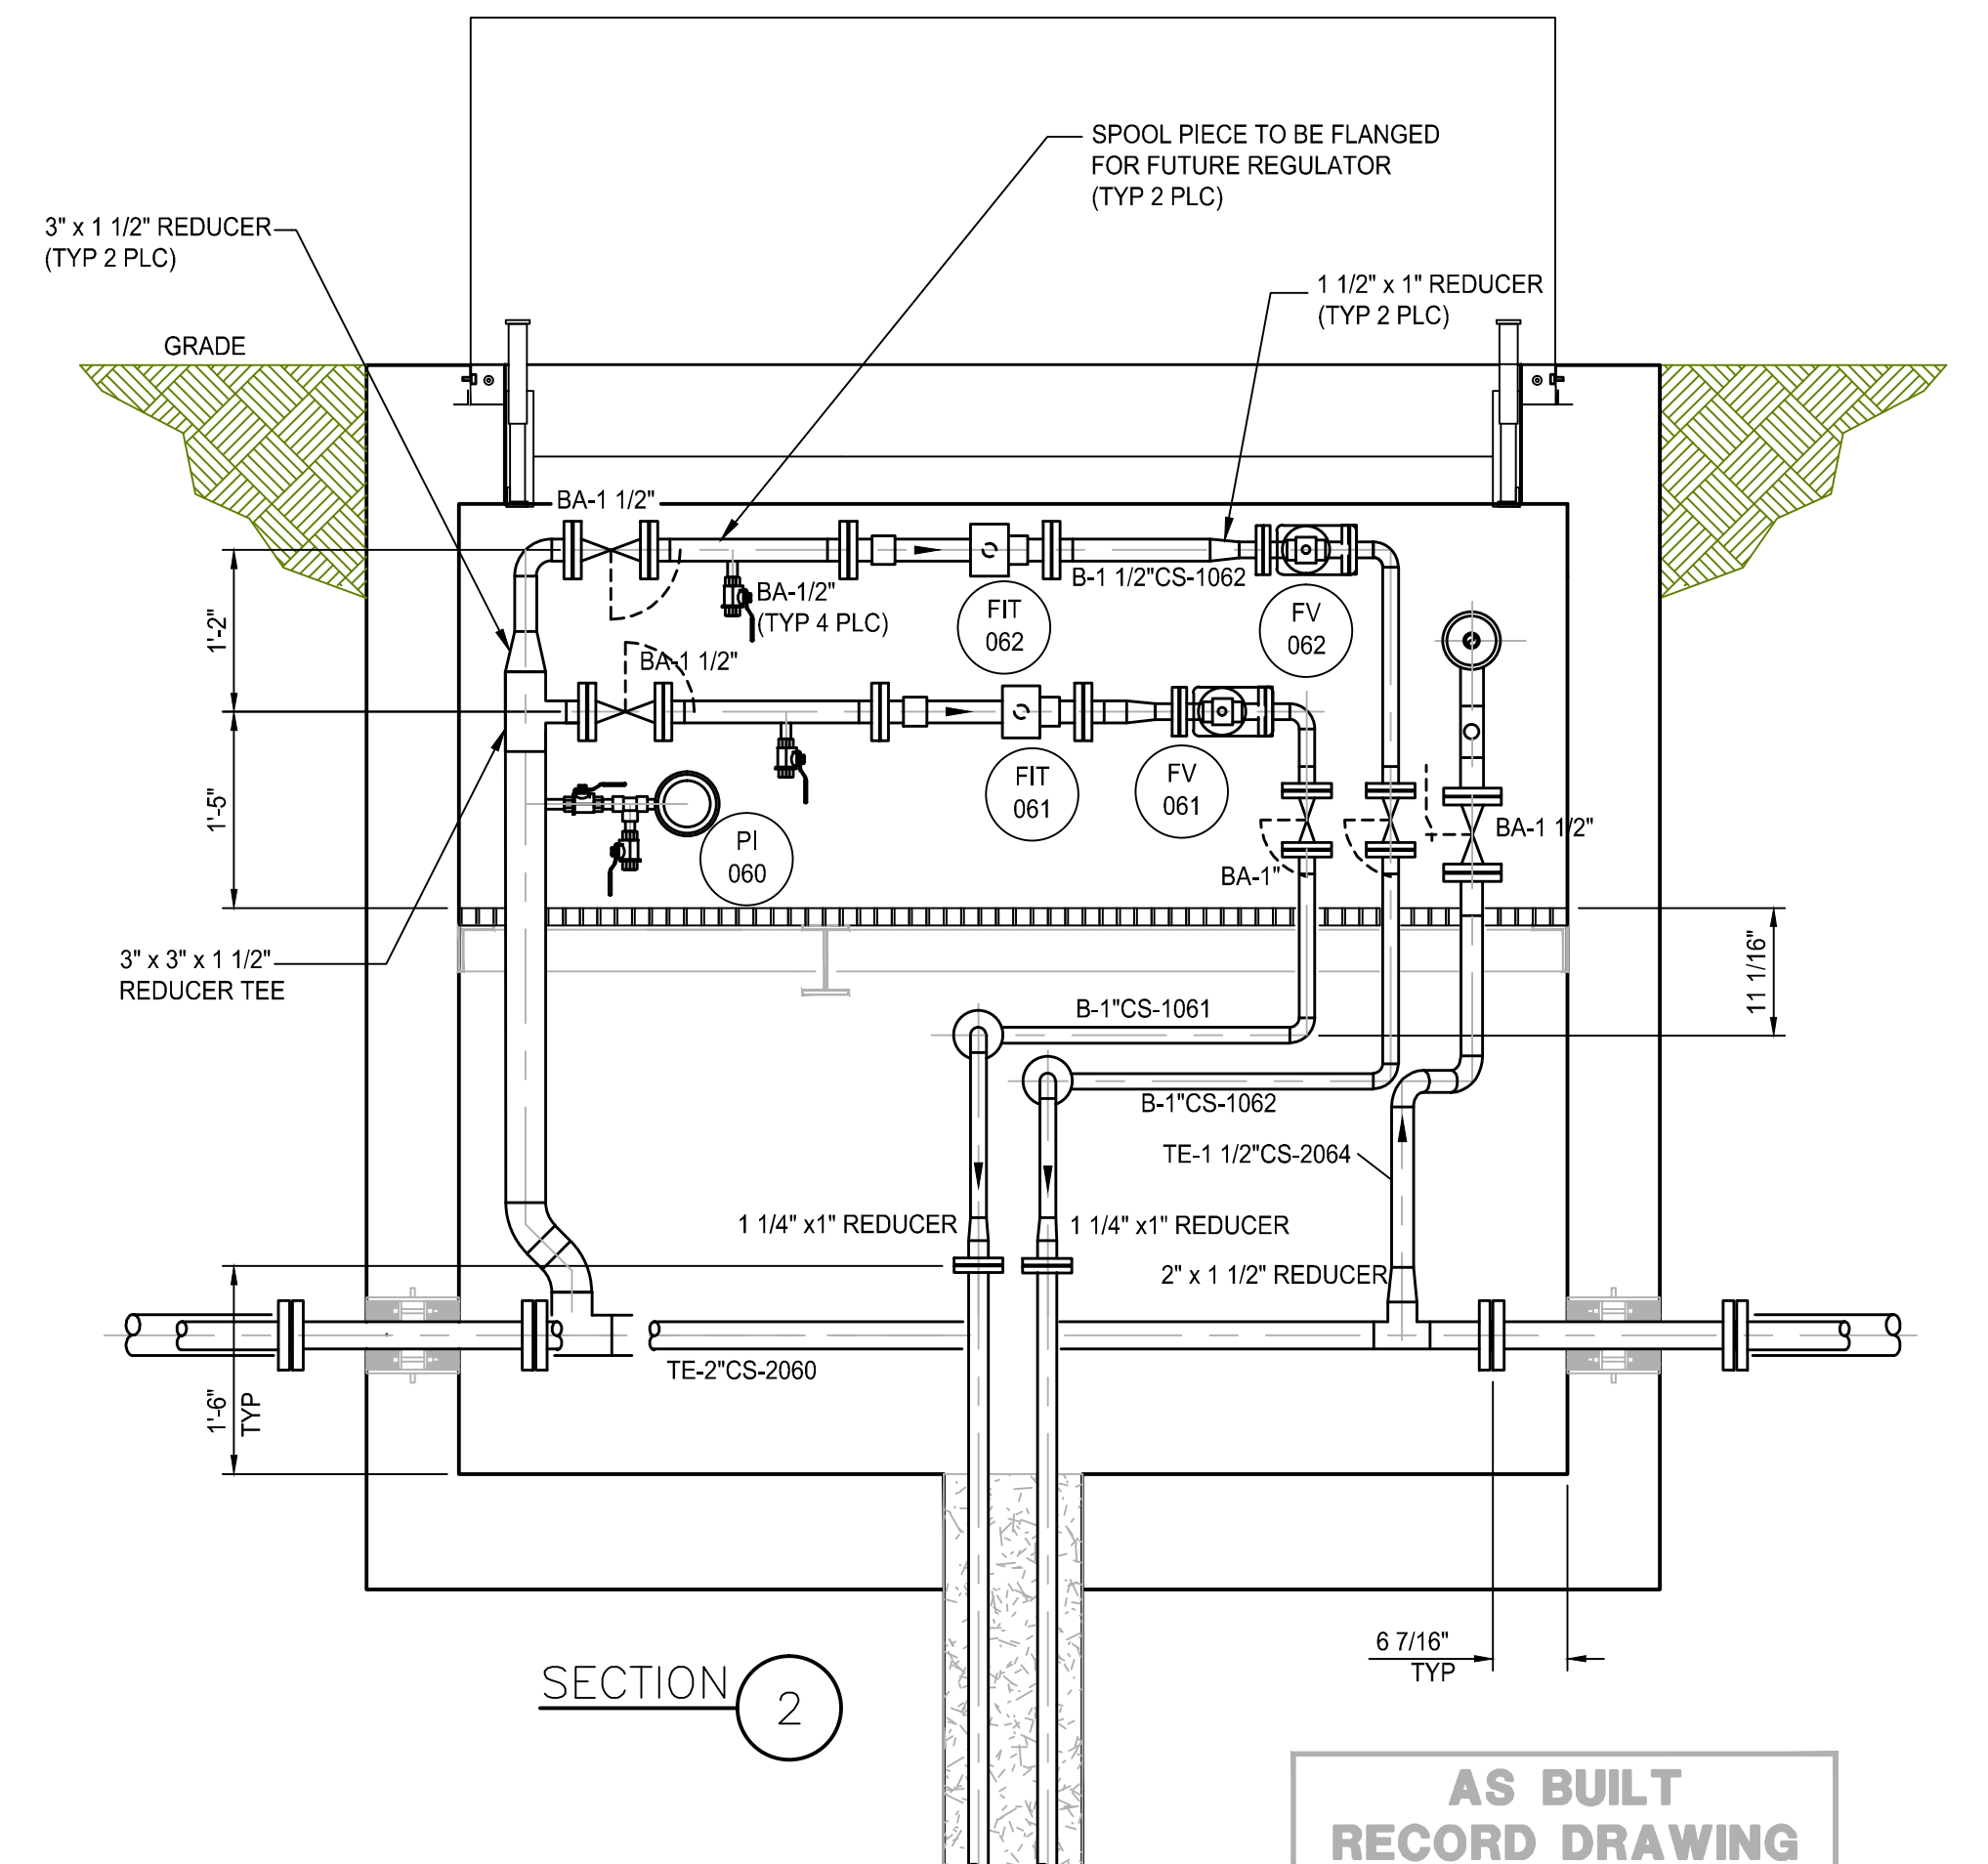

SECTION 2

AS BUILT  
RECORD DRAWING

NOTES:

1. THE VAULT SHOWN ABOVE IS FOR WELL IW-06. ALL VAULTS WERE PIPED AS PER THIS TYPICAL DRAWING. INSTRUMENT AND LINE NUMBERS FOR THE OTHER VAULTS MAY BE FOUND ON TABLE.
2. WELLS IW-01 THRU IW-07 ARE LOCATED NORTH OF THE CONTROL BUILDING. THESE VAULTS ARE POSITIONED WITH THE WELL LOCATED ON THE NORTH SIDE OF THE VAULT.
3. WELLS IW-15 THRU IW-22 ARE LOCATED JUST NORTH OF THE CONTROL BUILDING. THESE VAULTS ARE POSITIONED WITH THE WELL LOCATED ON THE SOUTH SIDE OF THE VAULT.
4. ALL AIR, LIQUID, CONTROL, AND ELECTRICAL LINES PASS THRU THE VAULTS, EXCEPT IW-1, IW-8, IW-15, AND IW-22. CONTRACTOR PLUGGED ANY ADDITIONAL HOLES IN THESE VAULTS.

SCALE VERIFICATION: THIS BAR MEASURES 1" ON ORIGINAL. ADJUST SCALE ACCORDINGLY.

No	Revision	Date	Initial
1	AS BUILT	08/29/12	LV

WARNING: ALTERING THIS DOCUMENT IS IN VIOLATION OF THE NEW YORK STATE EDUCATION LAW EXCEPTING AS PROVIDED IN SECTION 7209, PART 2 OF THE LAW.

HOOKE/RUCO SITE  
HICKSVILLE, NEW YORK

BIOSPARGE TREATMENT SYSTEM



INJECTION WELLS IW-01 THRU IW-07  
PLANS AND SECTIONS




Source Reference:			Date:
Project Manager: J. KAY			7-23-03
Reviewed By:	Designed By:	Drawn By:	
	B. A. BEEBE	B. A. BEEBE	
Scale:	Project No:	Report No:	Drawing No:
NONE	06883-00	056	MP-10





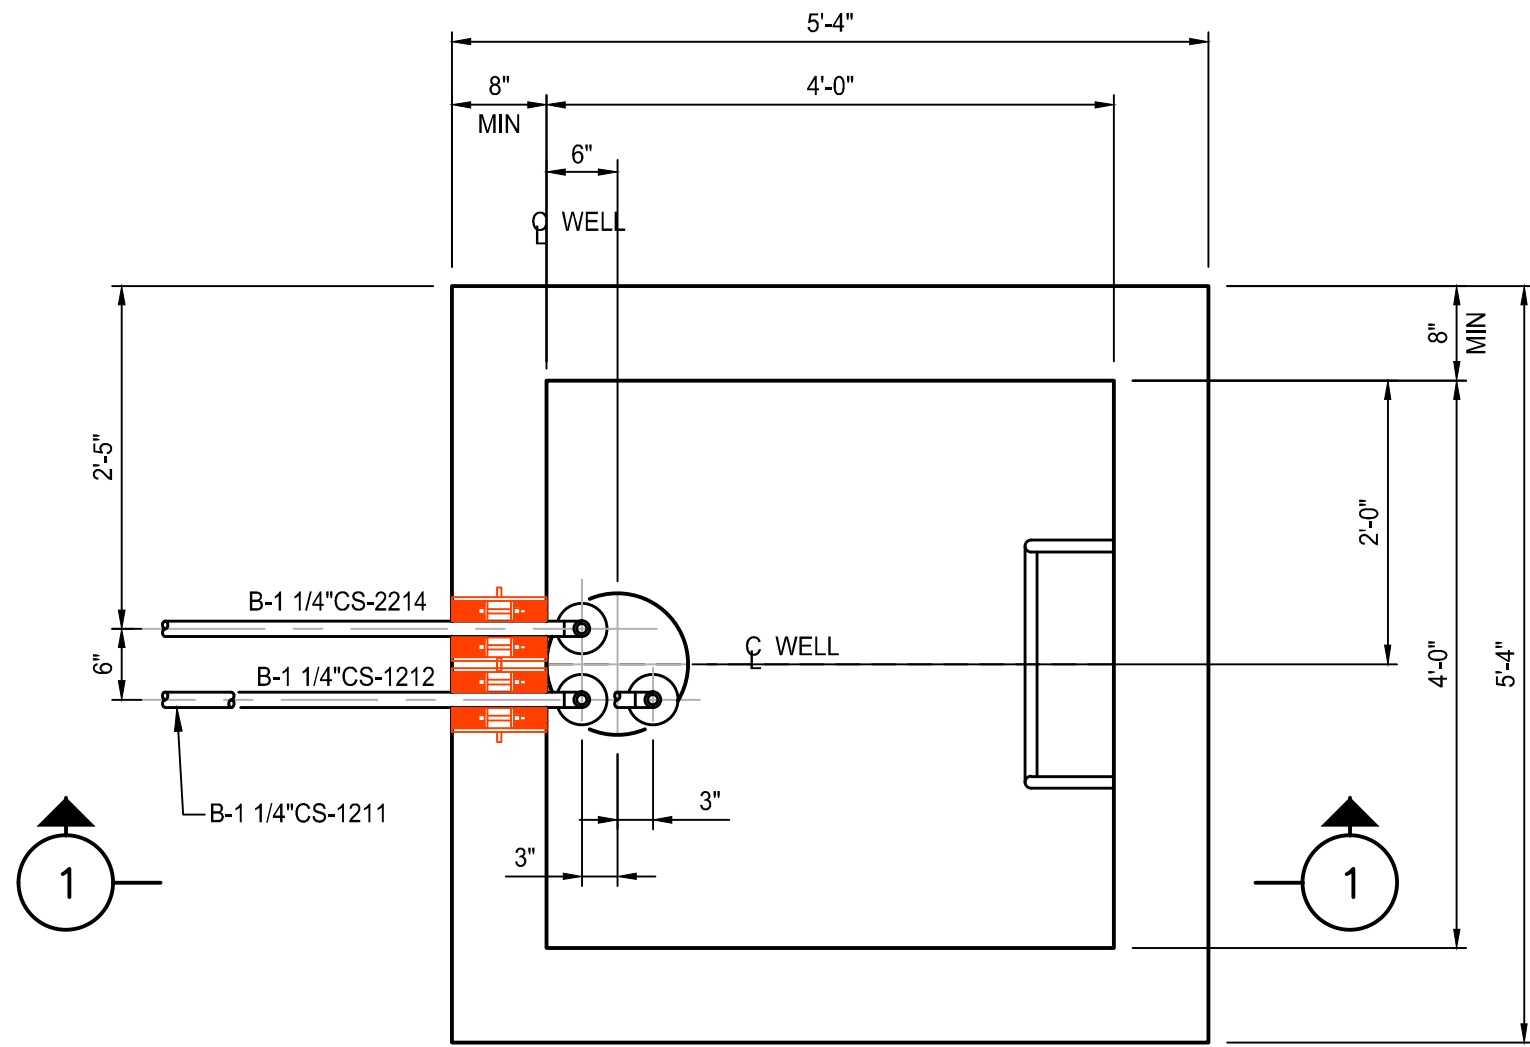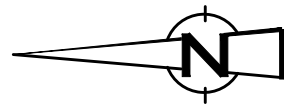

PLAN VIEW

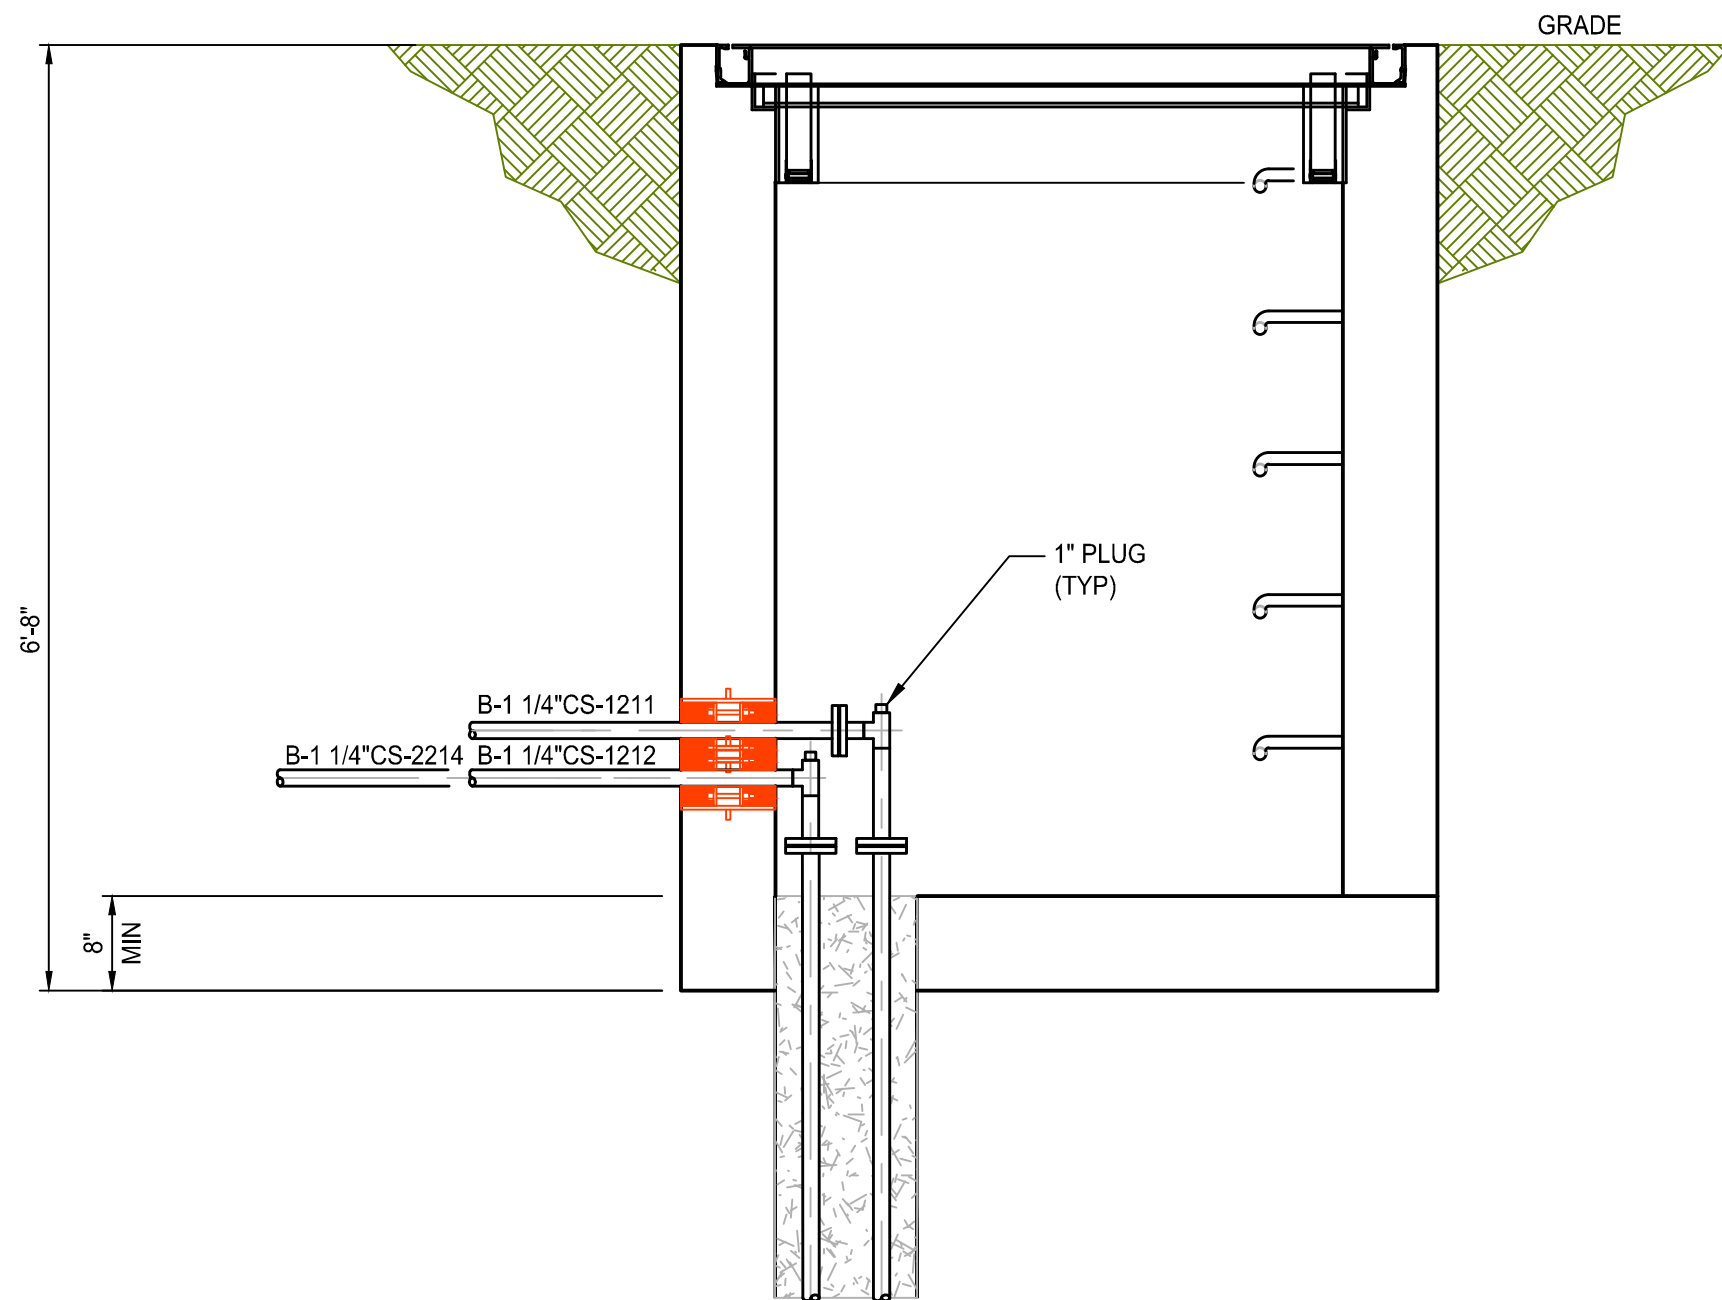

SECTION 1

AS BUILT  
RECORD DRAWING

NOTES:

1. WELLS IW-01 THRU IW-07 ARE LOCATED NORTH OF THE CONTROL BUILDING. THESE VAULTS ARE POSITIONED WITH THE WELL LOCATED ON THE NORTH SIDE OF THE VAULT.
2. WELLS IW-15 THRU IW-22 ARE LOCATED JUST NORTH OF THE CONTROL BUILDING. THESE VAULTS ARE POSITIONED WITH THE WELL LOCATED ON THE SOUTH SIDE OF THE VAULT.
3. ALL AIR, LIQUID, CONTROL, AND ELECTRICAL LINES PASS THRU THE VAULTS, EXCEPT IW-1, IW-8, IW-15, AND IW-22. CONTRACTOR PLUGGED ANY ADDITIONAL HOLES IN THESE VAULTS.

SCALE VERIFICATION: THIS BAR MEASURES 1" ON ORIGINAL. ADJUST SCALE ACCORDINGLY.



1	AS BUILT	08/29/12	LV
No	Revision	Date	Initial

WARNING: ALTERING THIS DOCUMENT IS  
IN VIOLATION OF THE NEW YORK STATE  
EDUCATION LAW EXCEPTING AS PROVIDED  
IN SECTION 7209, PART 2 OF THE LAW.

HOOKER/RUCO SITE  
HICKSVILLE, NEW YORK







BIOSPARGE TREATMENT SYSTEM

INJECTION WELLS IW-21A  
PLAN AND SECTIONS



**CRA Infrastructure  
& Engineering, Inc.**

Source Reference:			Date:
			7-23-03
Project Manager:	Reviewed By:	Designed By:	Drawn By:
J. KAY		B. A. BEEBE	B. A. BEEBE
Scale:	Project No:	Report No:	Drawing No:
NONE	06883-00	056	MP-13

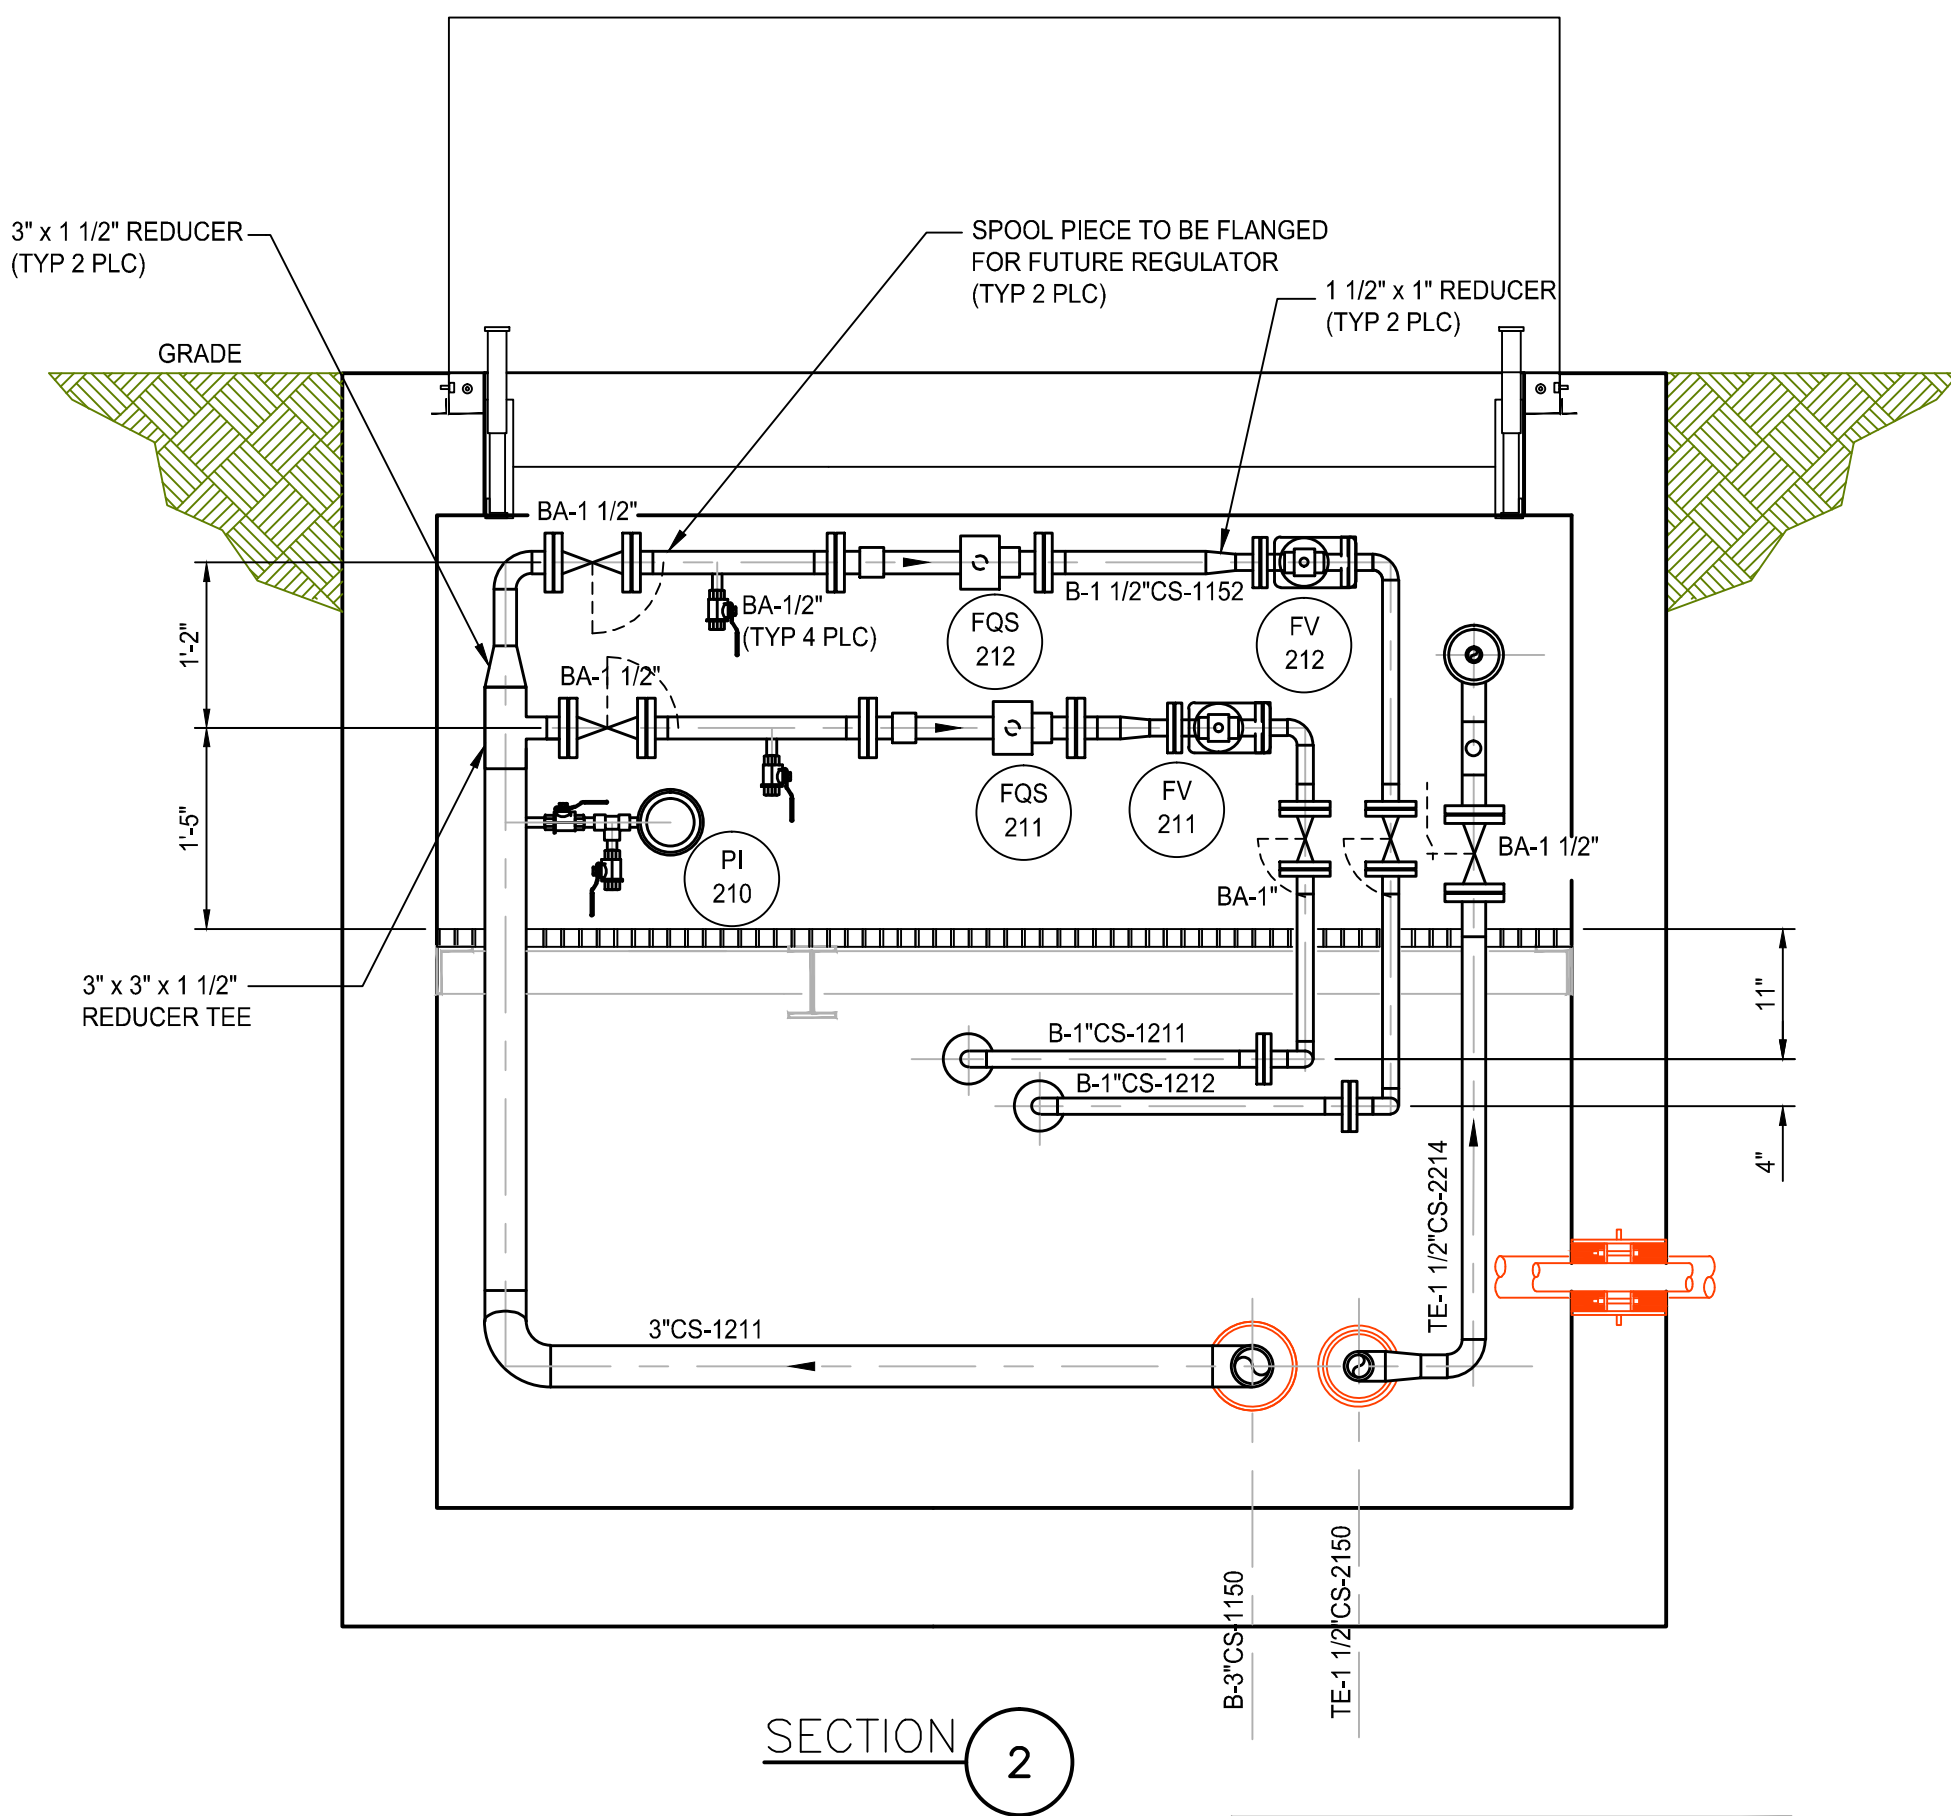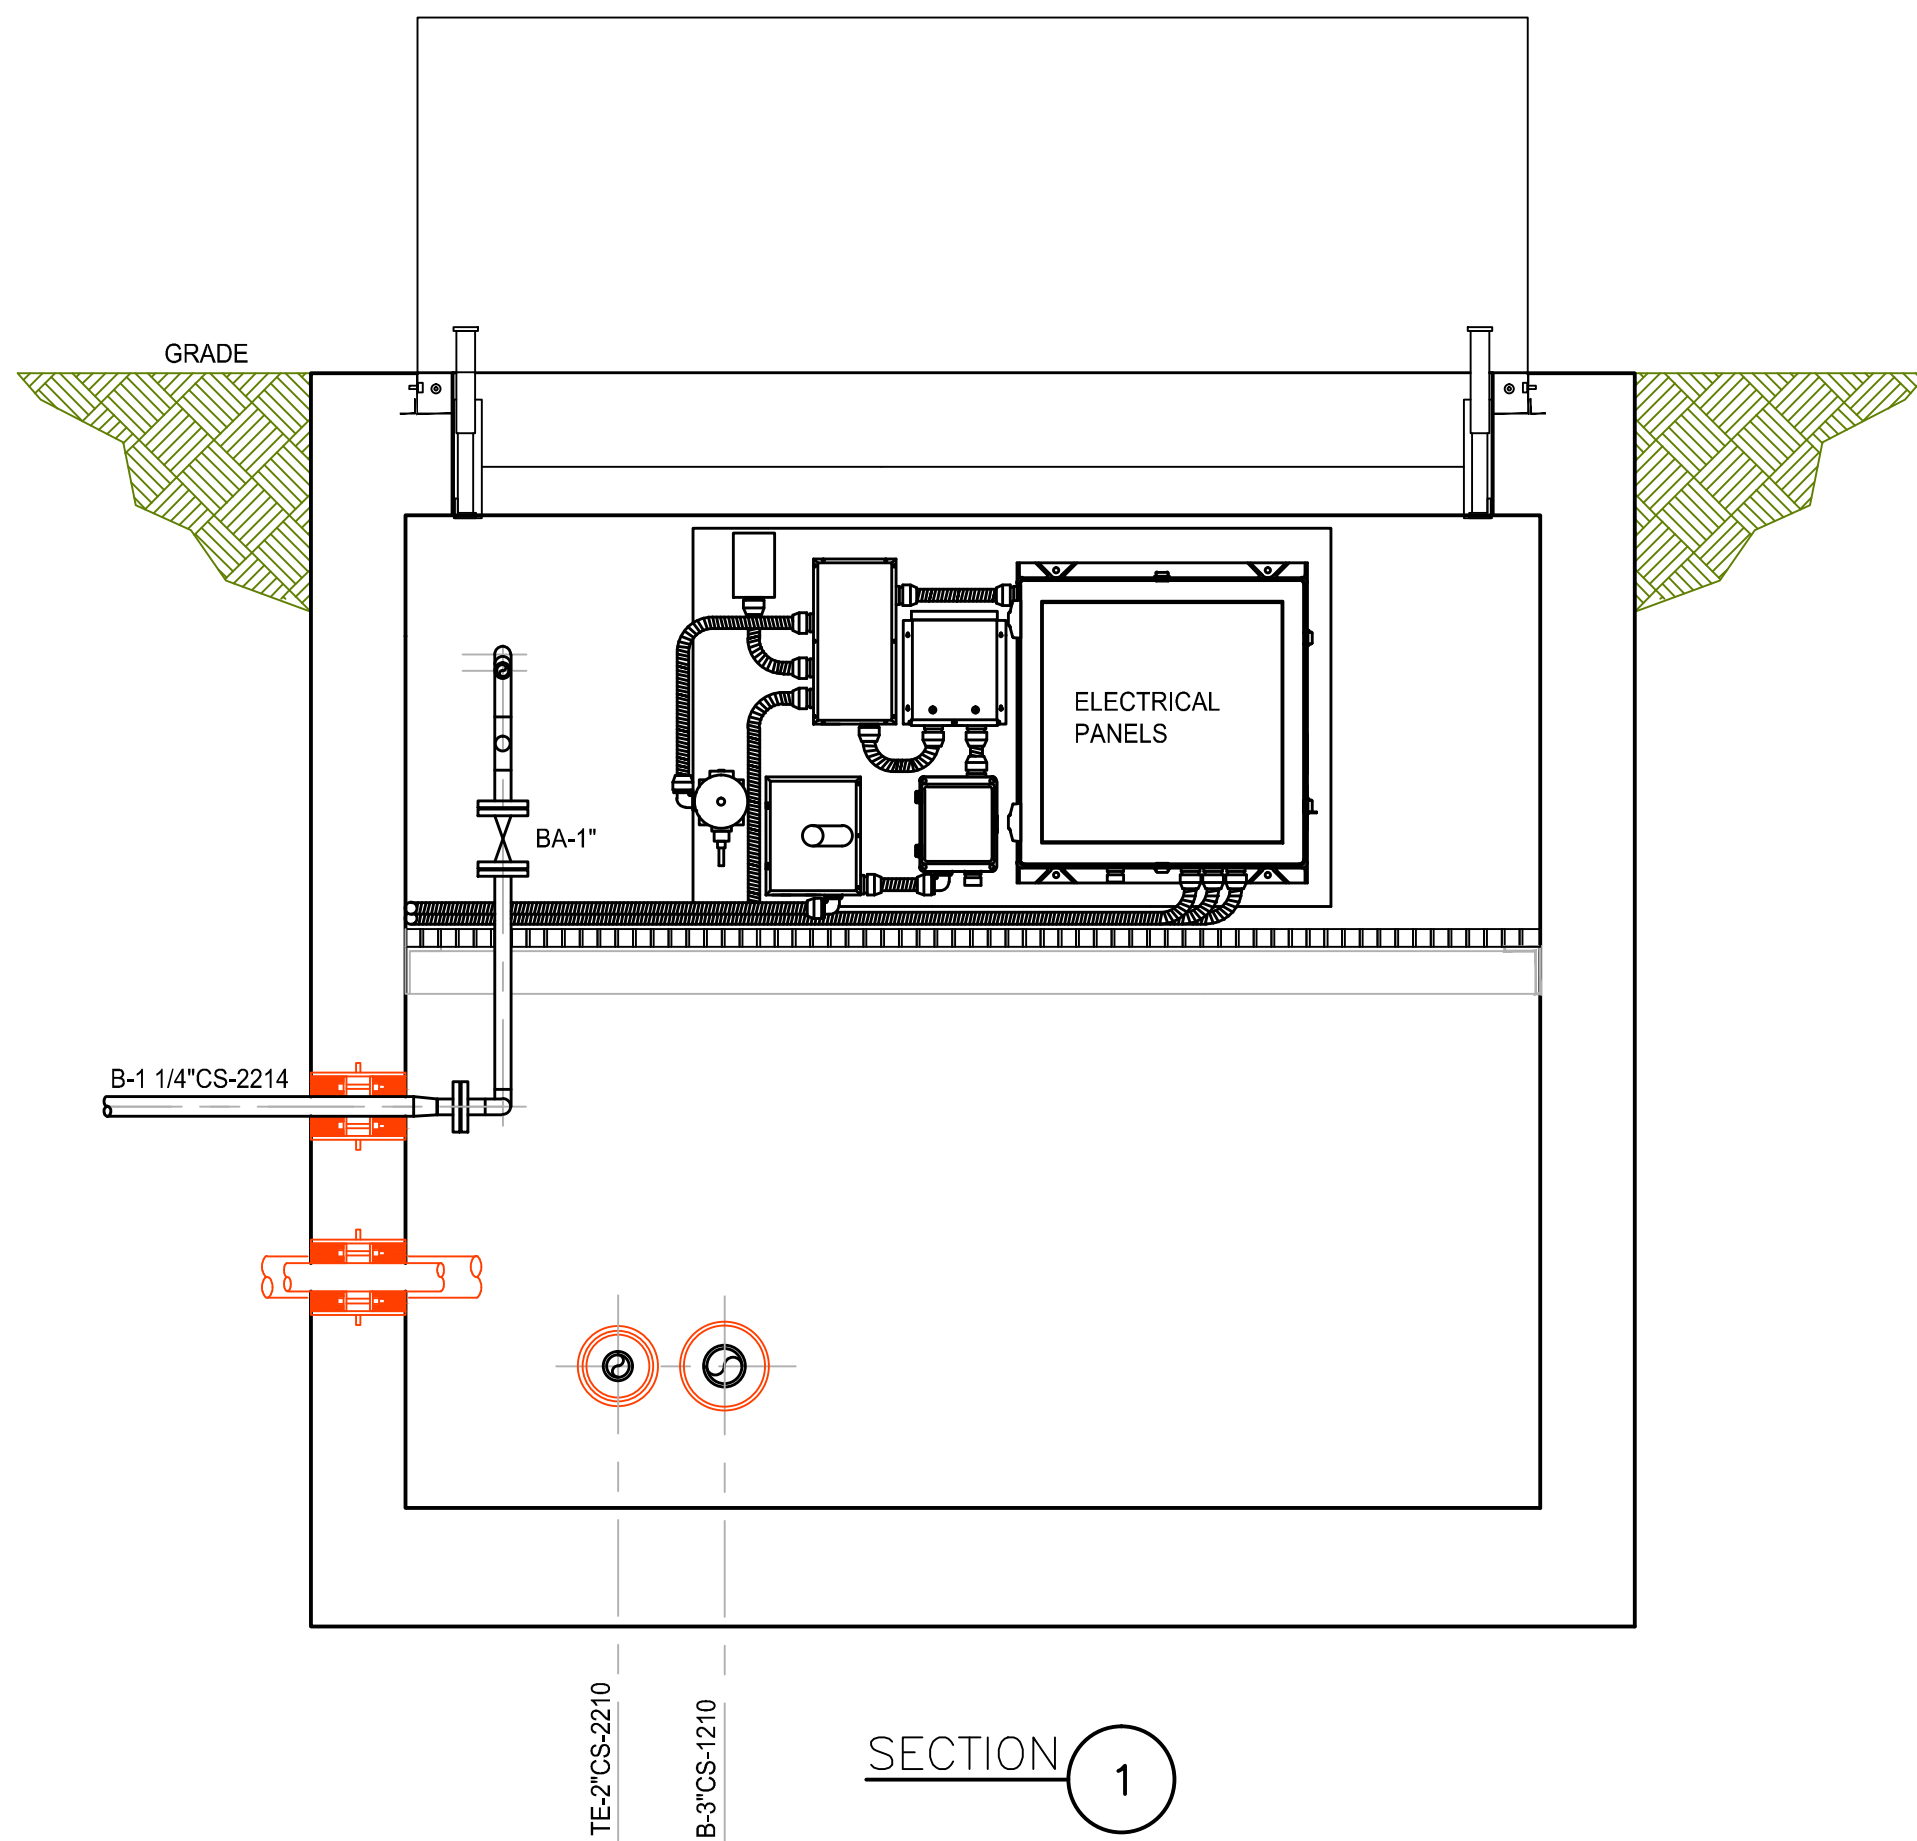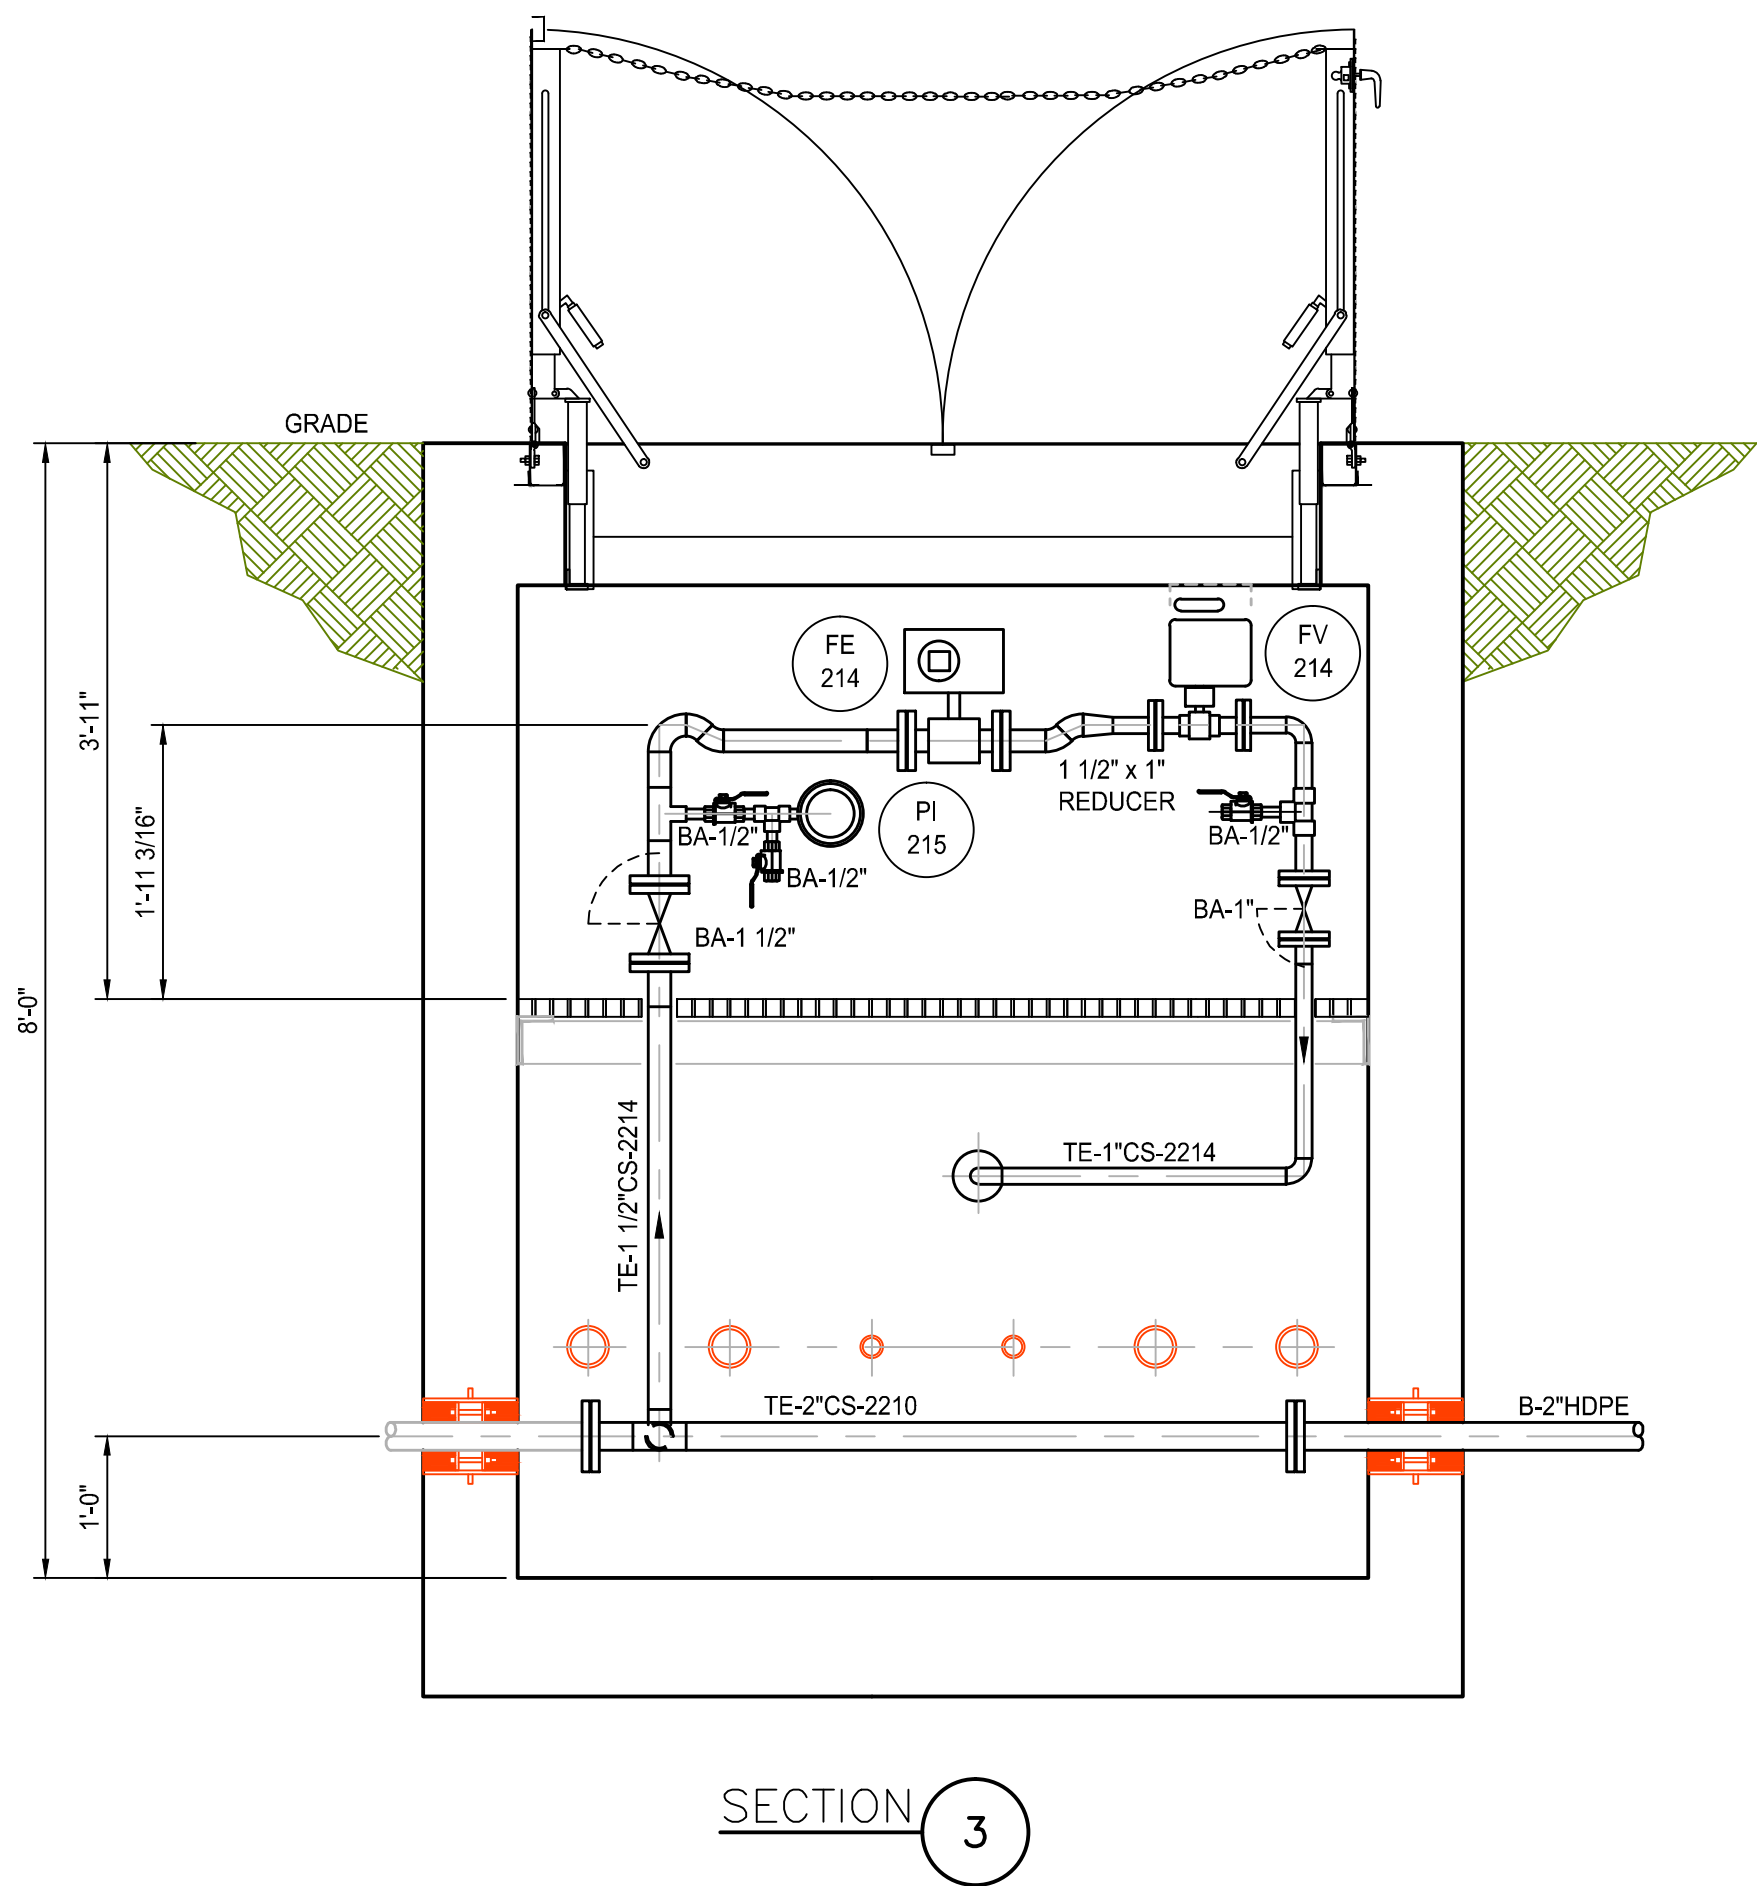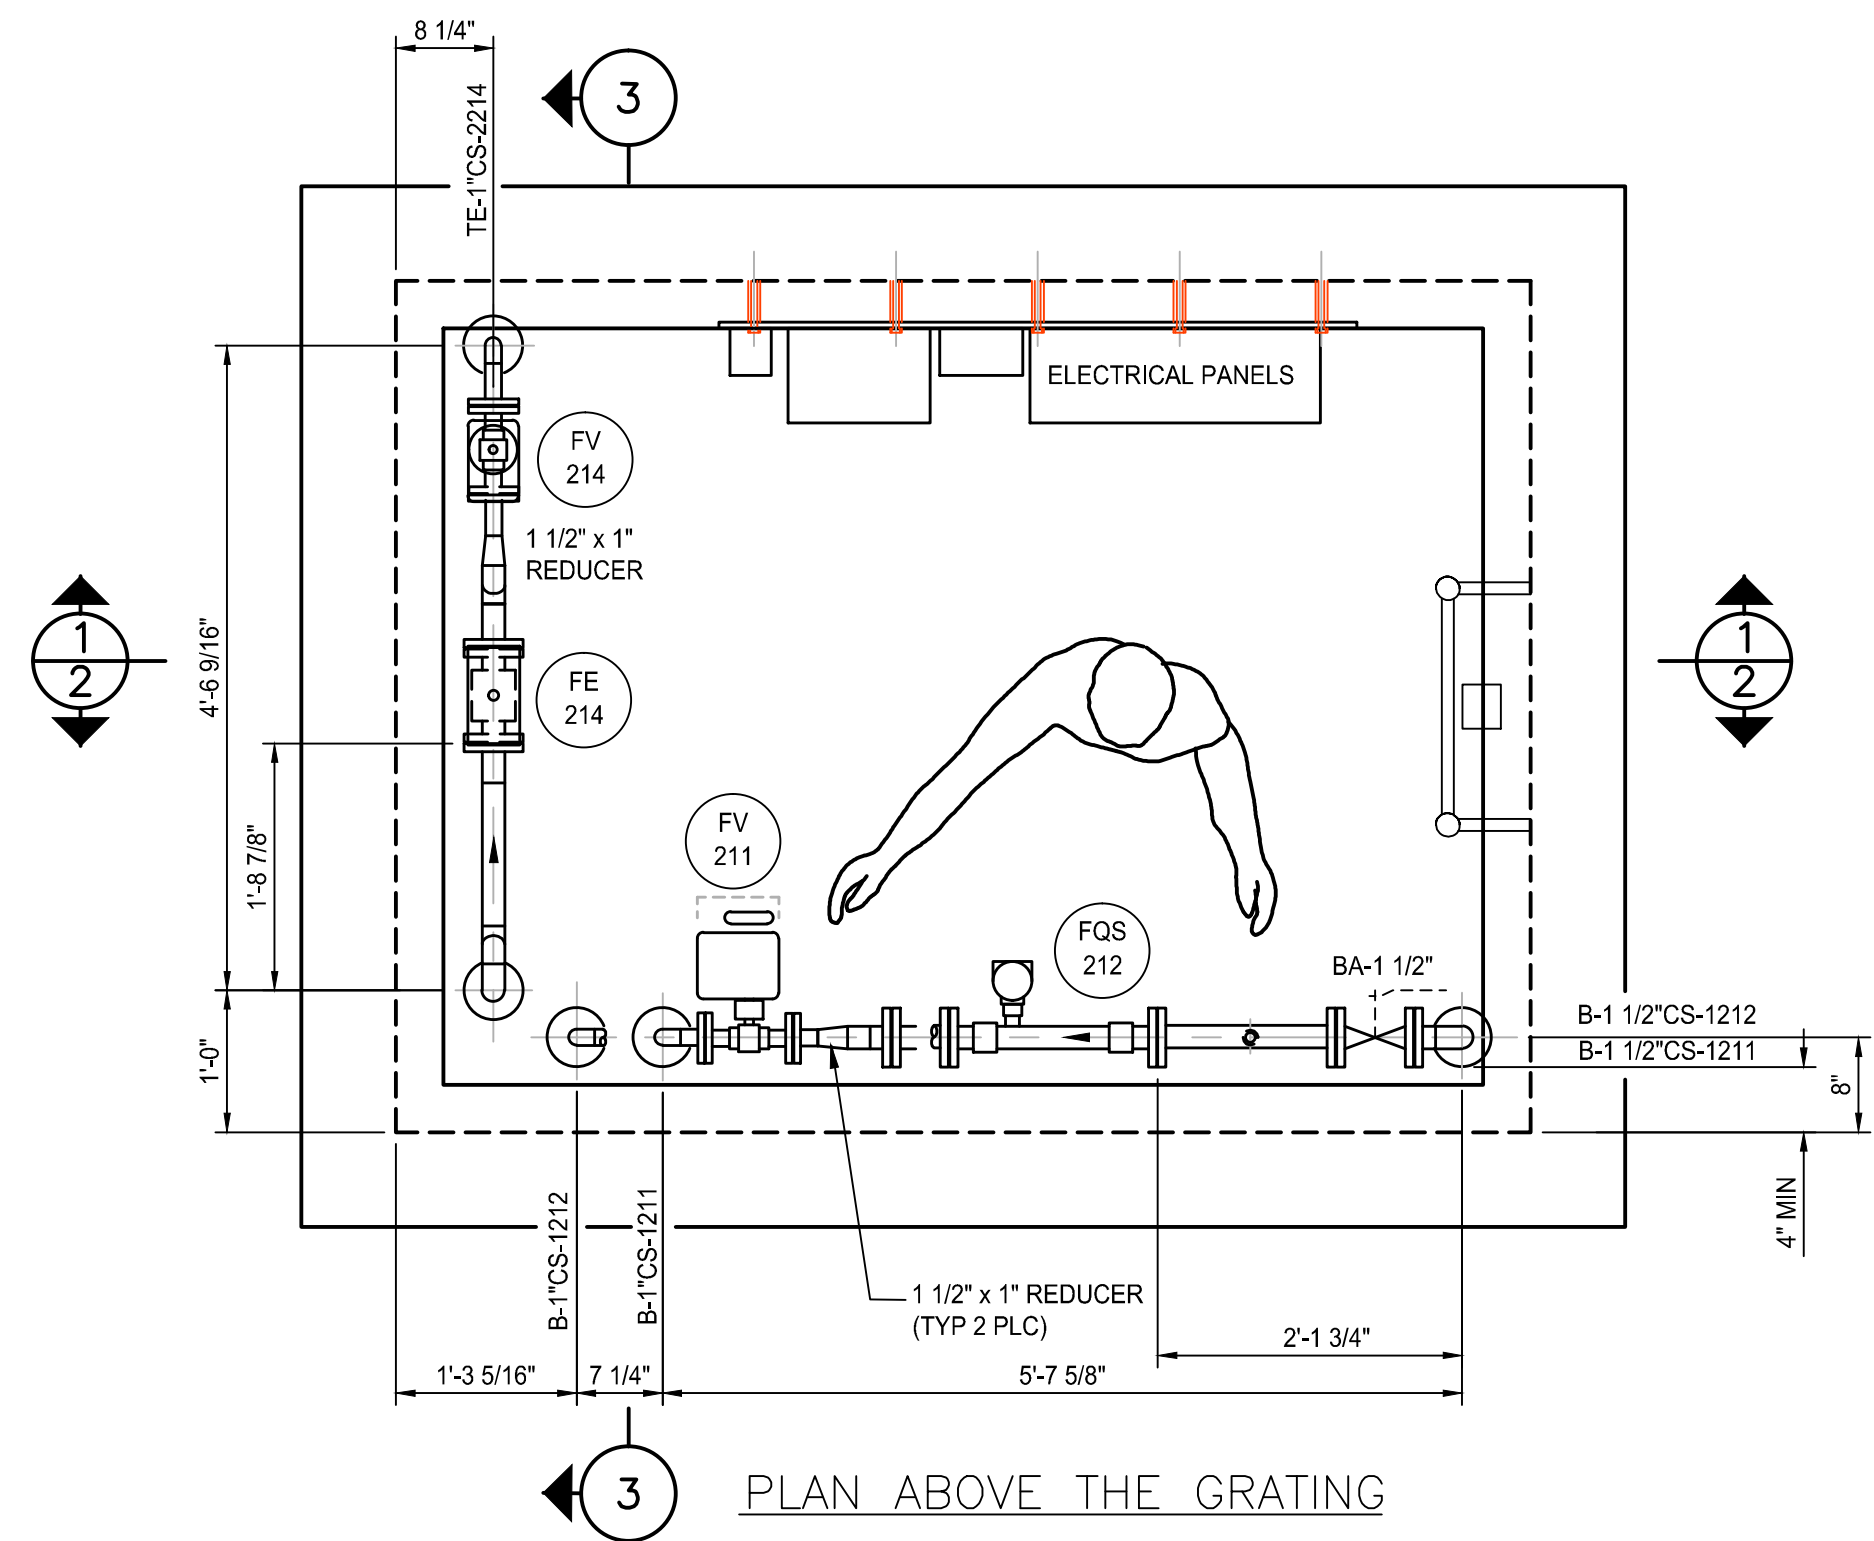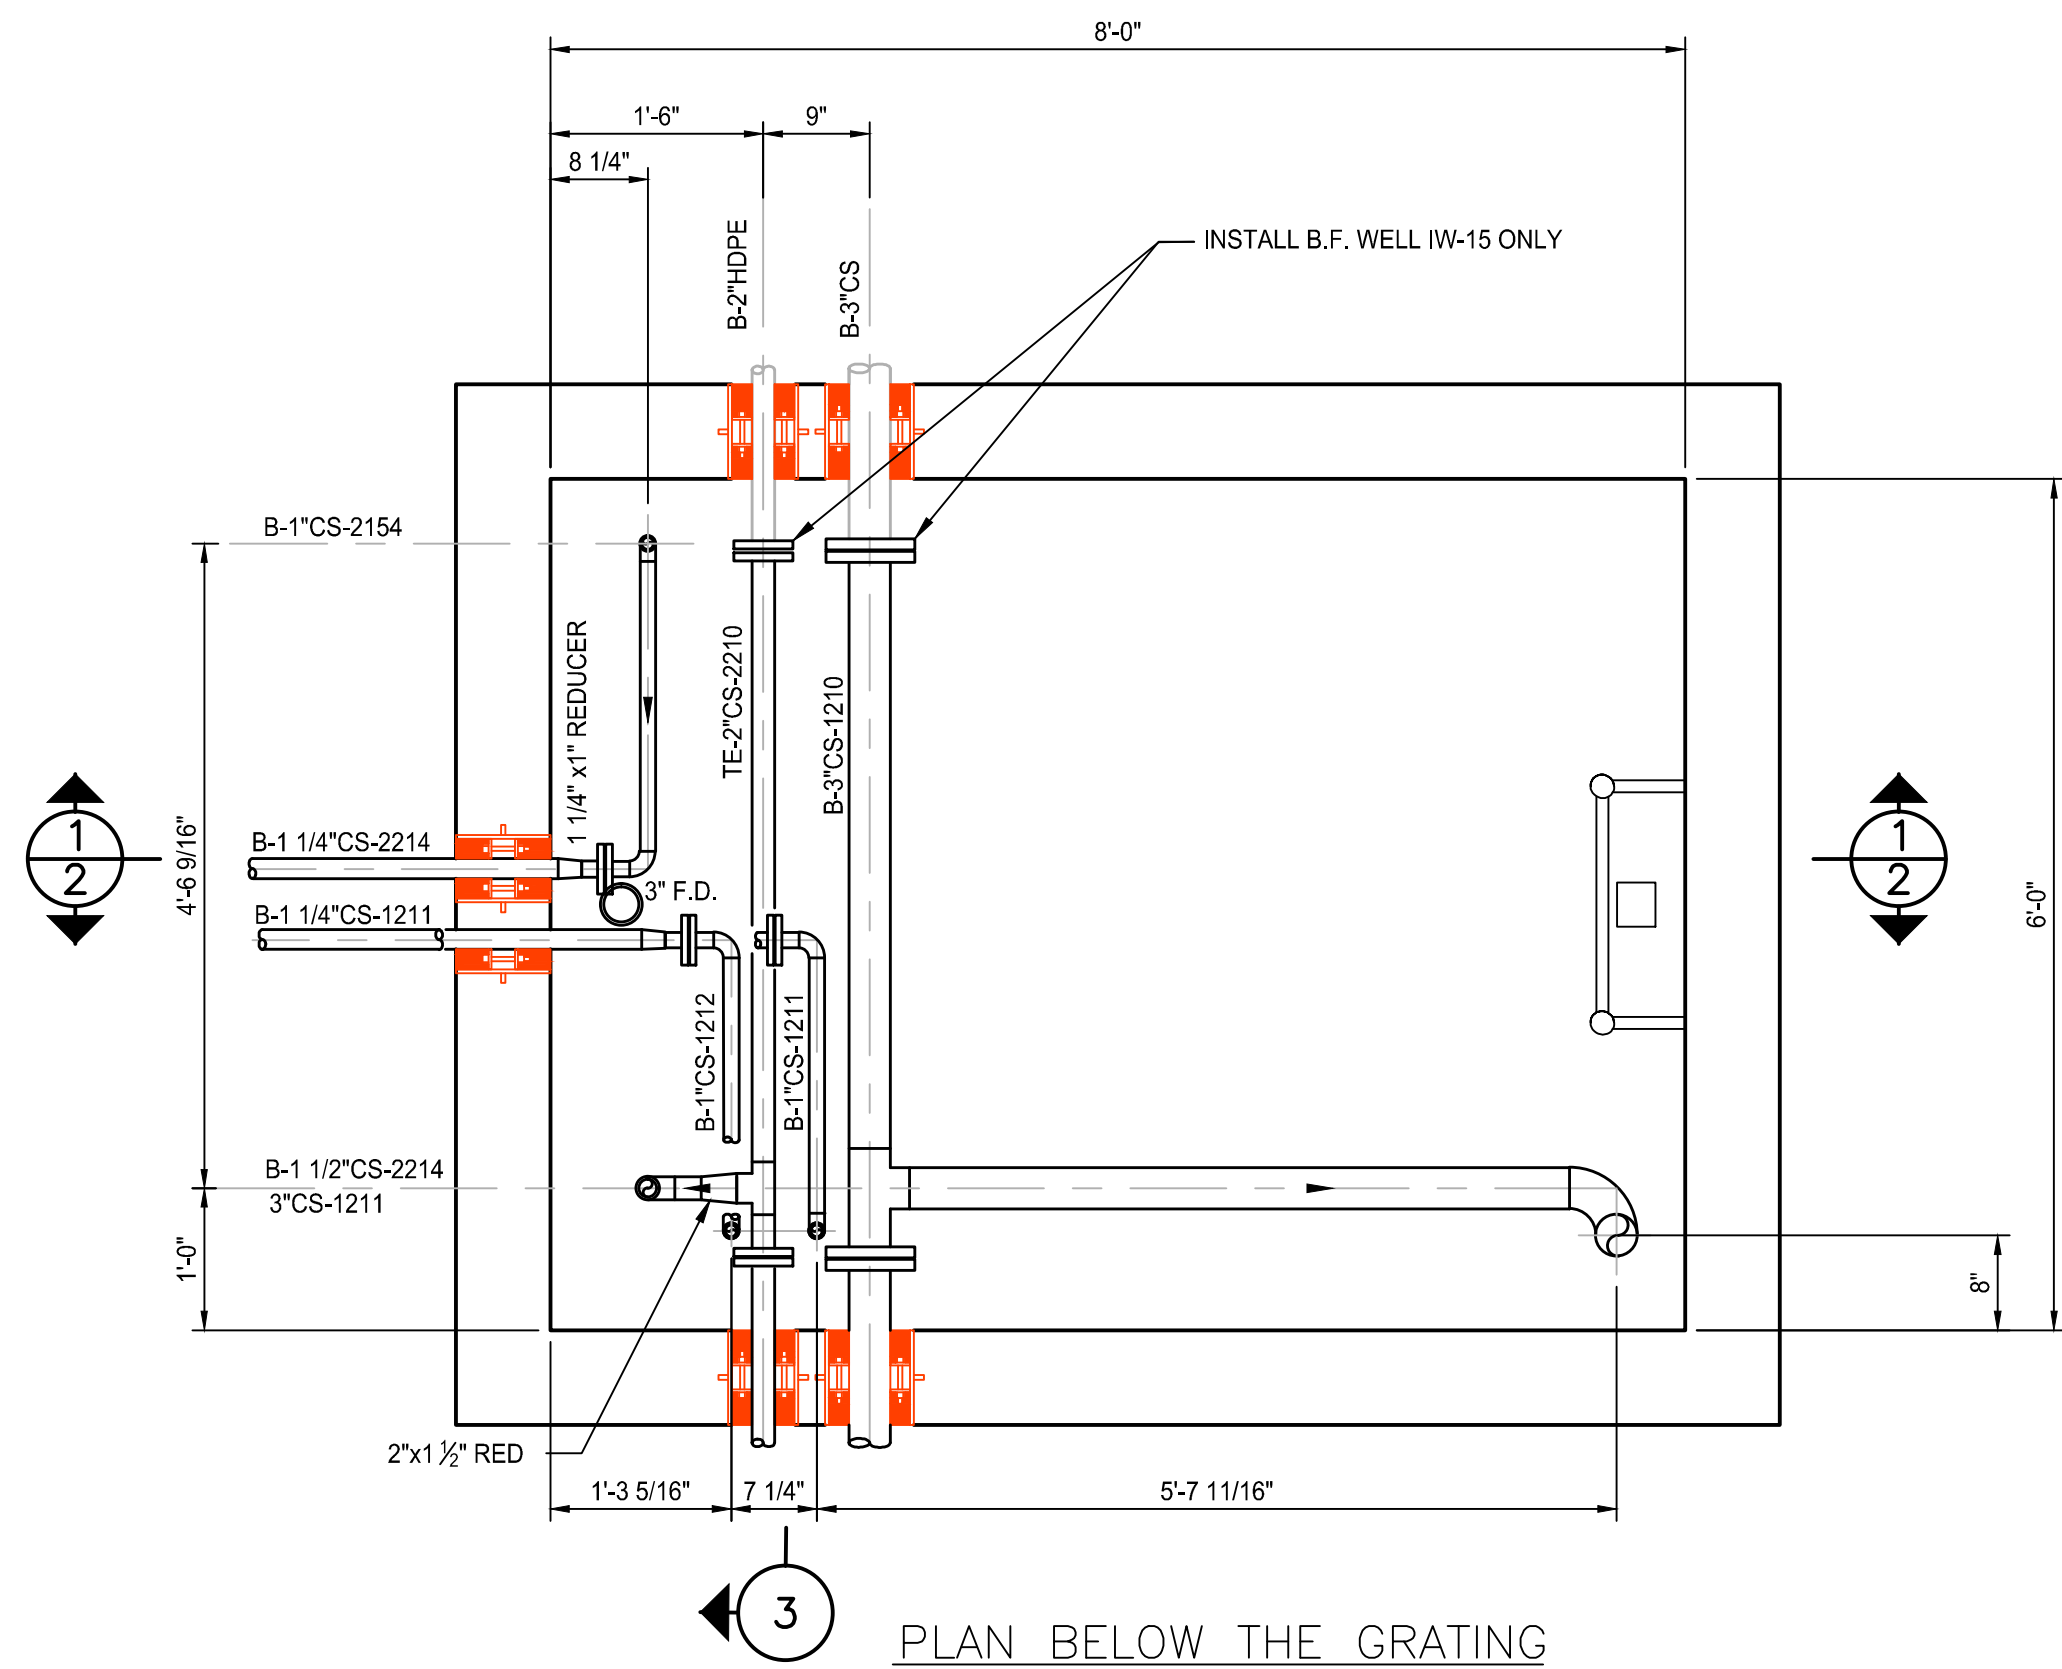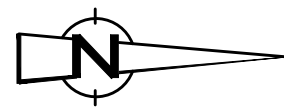

AS BUILT  
RECORD DRAWING

NOTES:

1. WELLS IW-01 THRU IW-07 ARE LOCATED NORTH OF THE CONTROL BUILDING. THESE VAULTS ARE POSITIONED WITH THE WELL LOCATED ON THE NORTH SIDE OF THE VAULT.
2. WELLS IW-15 THRU IW-22 ARE LOCATED JUST NORTH OF THE CONTROL BUILDING. THESE VAULTS ARE POSITIONED WITH THE WELL LOCATED ON THE SOUTH SIDE OF THE VAULT.
3. ALL AIR, LIQUID, CONTROL, AND ELECTRICAL LINES PASS THRU THE VAULTS, EXCEPT IW-1, IW-8, IW-15, AND IW-22. CONTRACTOR PLUGGED ANY ADDITIONAL HOLES IN THESE VAULTS.

SCALE VERIFICATION: THIS BAR MEASURES 1" ON ORIGINAL. ADJUST SCALE ACCORDINGLY.



No	Revision	Date	Initial
1	AS BUILT	08/29/12	LV

WARNING: ALTERING THIS DOCUMENT IS IN VIOLATION OF THE NEW YORK STATE EDUCATION LAW EXCEPTING AS PROVIDED IN SECTION 7209, PART 2 OF THE LAW.

HOOVER/RUCO SITE  
HICKSVILLE, NEW YORK

BIOSPARGE TREATMENT SYSTEM

INJECTION WELLS IW-21  
PLAN AND SECTIONS



Source Reference:			Date:
Project Manager: J. KAY			7-23-03
Reviewed By: B. A. BEEBE	Designed By: B. A. BEEBE	Drawn By: B. A. BEEBE	
Scale: NONE	Project No: 06883-00	Report No: 056	Drawing No: MP-14