


NOTES:  
1. PIPE INSTALLATION WITH LIMITS OF STATE RIGHT OF WAY TO BE BURIED MINIMUM 120" BELOW GRADE. REFER TO DETAIL 5, SHEET C-03.  
2. RESTORATION WITHIN NYDOT RIGHT OF WAY TO BE COMPLETED IN ACCORDANCE WITH NYDOT STANDARD SPECIFICATION SECTION 107-08.

GENERAL NOTES  
COORDINATES BASED ON HORIZONTAL SYSTEM  
NAD '83, SPC (3104 NY L).  
ELEVATIONS BASED ON VERTICAL DATUM NAVD '88.  
FOR WELLS EW1, EW2, IW-01, IW-02, IW-03, IW-04 AND IW-05  
THE ELEVATIONS ARE TAKEN ON THE EDGE OF HOLE ON THE  
INSIDE OF THE FLANGE.  
ALL OTHER ELEVATIONS TAKEN ON THE NOTCH ON THE  
NORTH SIDE OF THE CASING.

| WELL #     | NORTHING  | EASTING    | ELEVATION |
|------------|-----------|------------|-----------|
| EW1        | 278985.42 | 1241213.95 | 219.30    |
| EW2        | 279180.50 | 1241367.23 | 222.61    |
| IW01       | 278204.79 | 1241693.86 | 225.99    |
| IW02       | 278227.33 | 1241796.61 | 225.27    |
| IW03       | 278152.12 | 1241790.03 | 224.99    |
| IW04       | 278167.07 | 1241626.33 | 225.68    |
| IW05       | 278150.73 | 1241759.26 | 224.48    |
| IW-ISCO-1  | 278742.00 | 1241494.66 | N/A       |
| IW-ISCO-2  | 278783.55 | 1241521.54 | N/A       |
| IW-ISCO-3  | 278807.40 | 1241535.63 | N/A       |
| IW-ISCO-4  | 278768.69 | 1241453.64 | N/A       |
| IW-ISCO-5  | 278795.69 | 1241486.95 | N/A       |
| IW-ISCO-6  | 278810.50 | 1241462.48 | N/A       |
| IW-ISCO-7  | 278833.75 | 1241504.95 | N/A       |
| IW-ISCO-8  | 278870.09 | 1241500.51 | N/A       |
| IW-ISCO-9  | 278864.13 | 1241537.24 | N/A       |
| IW-ISCO-10 | 278897.45 | 1241521.28 | N/A       |
| IW-ISCO-11 | 278842.08 | 1241381.56 | N/A       |
| IW-ISCO-12 | 278884.16 | 1241408.31 | N/A       |
| IW-ISCO-13 | 278926.36 | 1241435.60 | N/A       |
| MW-ISCO-1  | 278873.76 | 1241383.84 | 228.11    |
| MW-ISCO-2  | 278907.54 | 1241408.33 | 227.24    |
| MW-ISCO-3  | 278849.85 | 1241526.94 | 228.50    |
| MW-ISCO-4  | 278807.98 | 1241504.14 | 228.58    |
| MW-ISCO-5  | 278760.26 | 1241498.63 | 228.43    |
| PZ-01      | 278959.38 | 1242210.32 | 224.04    |
| PZ-02      | 278477.20 | 1241653.38 | 226.99    |
| PZ-03      | 276320.85 | 1242062.76 | 227.90    |
| PZ-04      | 276697.26 | 1241742.80 | 224.63    |
| PZ-05      | 276575.94 | 1241082.17 | 226.81    |
| PZ-06      | 279037.60 | 1241413.68 | 230.20    |
| PZ-07      | 279409.87 | 1241606.24 | 217.88    |

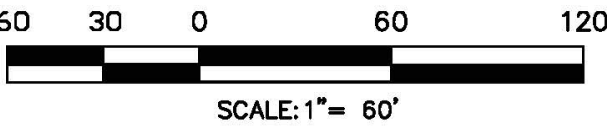

| REV #                                                                                      | Revisions               | Date                                                                 | Approved                              |
|--------------------------------------------------------------------------------------------|-------------------------|----------------------------------------------------------------------|---------------------------------------|
|                                                                                            |                         |                                                                      |                                       |
|                                                                                            | AS-BUILT                | 12/10                                                                |                                       |
|                                                                                            | ISSUED FOR CONSTRUCTION | 5/19/10                                                              |                                       |
| 1                                                                                          | 100 PERCENT DESIGN      | 3/19/10                                                              |                                       |
| ARROWHEAD CONTRACTING INC.<br>10881 Eicher Drive<br>Lenexa, Kansas 66219<br>(913) 814-9994 |                         | CDM FEDERAL PROGRAMS<br>NEW YORK, NEW YORK                           |                                       |
| Designed by:<br>DLR                                                                        |                         | LAWRENCE AVIATION SUPERFUND SITE<br>PORT JEFFERSON STATION, NEW YORK |                                       |
| Drawn by:<br>DLR                                                                           |                         | GROUNDWATER TREATMENT PLANT<br>PROJECT SITE PLAN                     |                                       |
| Checked by:<br>GW                                                                          |                         | Reviewed by:<br>SFS                                                  |                                       |
| Submitted by:<br>GW                                                                        |                         | Scale:<br>AS SHOWN                                                   | Sheet<br>reference<br>number:<br>C-01 |
|                                                                                            |                         | Spec. No.:<br>-                                                      | Date:<br>JANUARY 27, 2010             |
|                                                                                            |                         | Contract No.:<br>-                                                   | Drawing Code:<br>-                    |

VERIFY SCALE  
BAR IS ONE INCH  
ON ORIGINAL  
DRAWING  
IF NOT ONE INCH  
ON THIS SHEET,  
ADJUST SCALES  
ACCORDINGLY.

