

NYSDEC Division of Environmental Remediation		 NEW YORK STATE Department of Environmental Conservation		Contract No. DEC Insp. DEC PM – Payson Long, P.E. GES PM. – Scott McDonald HRP Engineer PM – Tom Battles HRP PM – Derek Roy	
Site Location: NYSDEC Lawrence Aviation, Port Jefferson Station, NY					
Weather Conditions					
General Description	Sunny	AM	Sunny	PM	
Temperature	30F	AM	32F	PM	
Wind	0-5 mph	AM	0-5 mph	PM	
Health & Safety If any box below is checked “Yes”, provide explanation under “Health & Safety Comments”.					
Were there any changes to the Health & Safety Plan?				*Yes	No NA
Were there any exceedances of the perimeter air monitoring reported on this date?				*Yes	No NA
Were there any nuisance issues reported/observed on this date?				*Yes	No NA
Health & Safety Comments					
Conducted daily tailgate meeting, conduct drive around to check for trespassers, check for access issues/ icy areas.					
Summary of Work Performed		Arrived at site:	0630	Departed Site:	1615
<p>0630 – Pawel Mecinski, Greg Ernst (GES) onsite. Unlocked Park Ave Gate. Highground Industrial (HGI) personnel onsite. 0720 – Joel Hara, Carly Saindon (HRP) onsite. 0745 – Zachary Zehr (HRP) onsite. 0850 – Ambriel Johnson (HRP) onsite with survey crew to survey 3 new onsite monitoring wells.</p> <p>GES set up and monitored ambient air with 4 CAMP stations located throughout the site. No abnormal or exceedances were observed at the Dust and PID monitors. CAMPs were operational from 7am to 3.45pm.</p> <p>-Excavated and removed concrete dome structures and applicable concrete collars from cesspools CESS-1, CESS-2, CESS-2 (abandoned), CESS-5, CESS-6 and CESS-7. -Concrete rings were left and structures were backfilled with sand fill. -Excavated remains of CESS-2 septic tank – removed concrete cover, crushed sidewalls, and backfilled with sand to grade. -Processed concrete with concrete crushing attachment. -Partially excavated CESS-4 and CESS-4A. The structure is a septic tank with an overflow wall inside.</p> <p>1615 – All personnel offsite. Locked gates and system shed.</p>					

[illegible]

Equipment/Material Tracking Comments:

Visitors to Site

Name	Representing	Entered Exclusion/CRZ Zone	
		Yes	No
		Yes	No
		Yes	No

Site Representatives

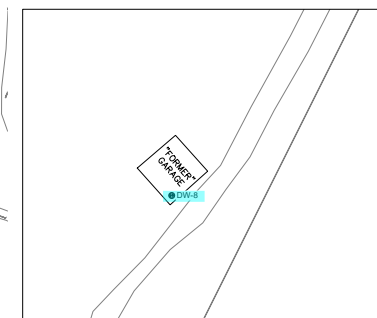
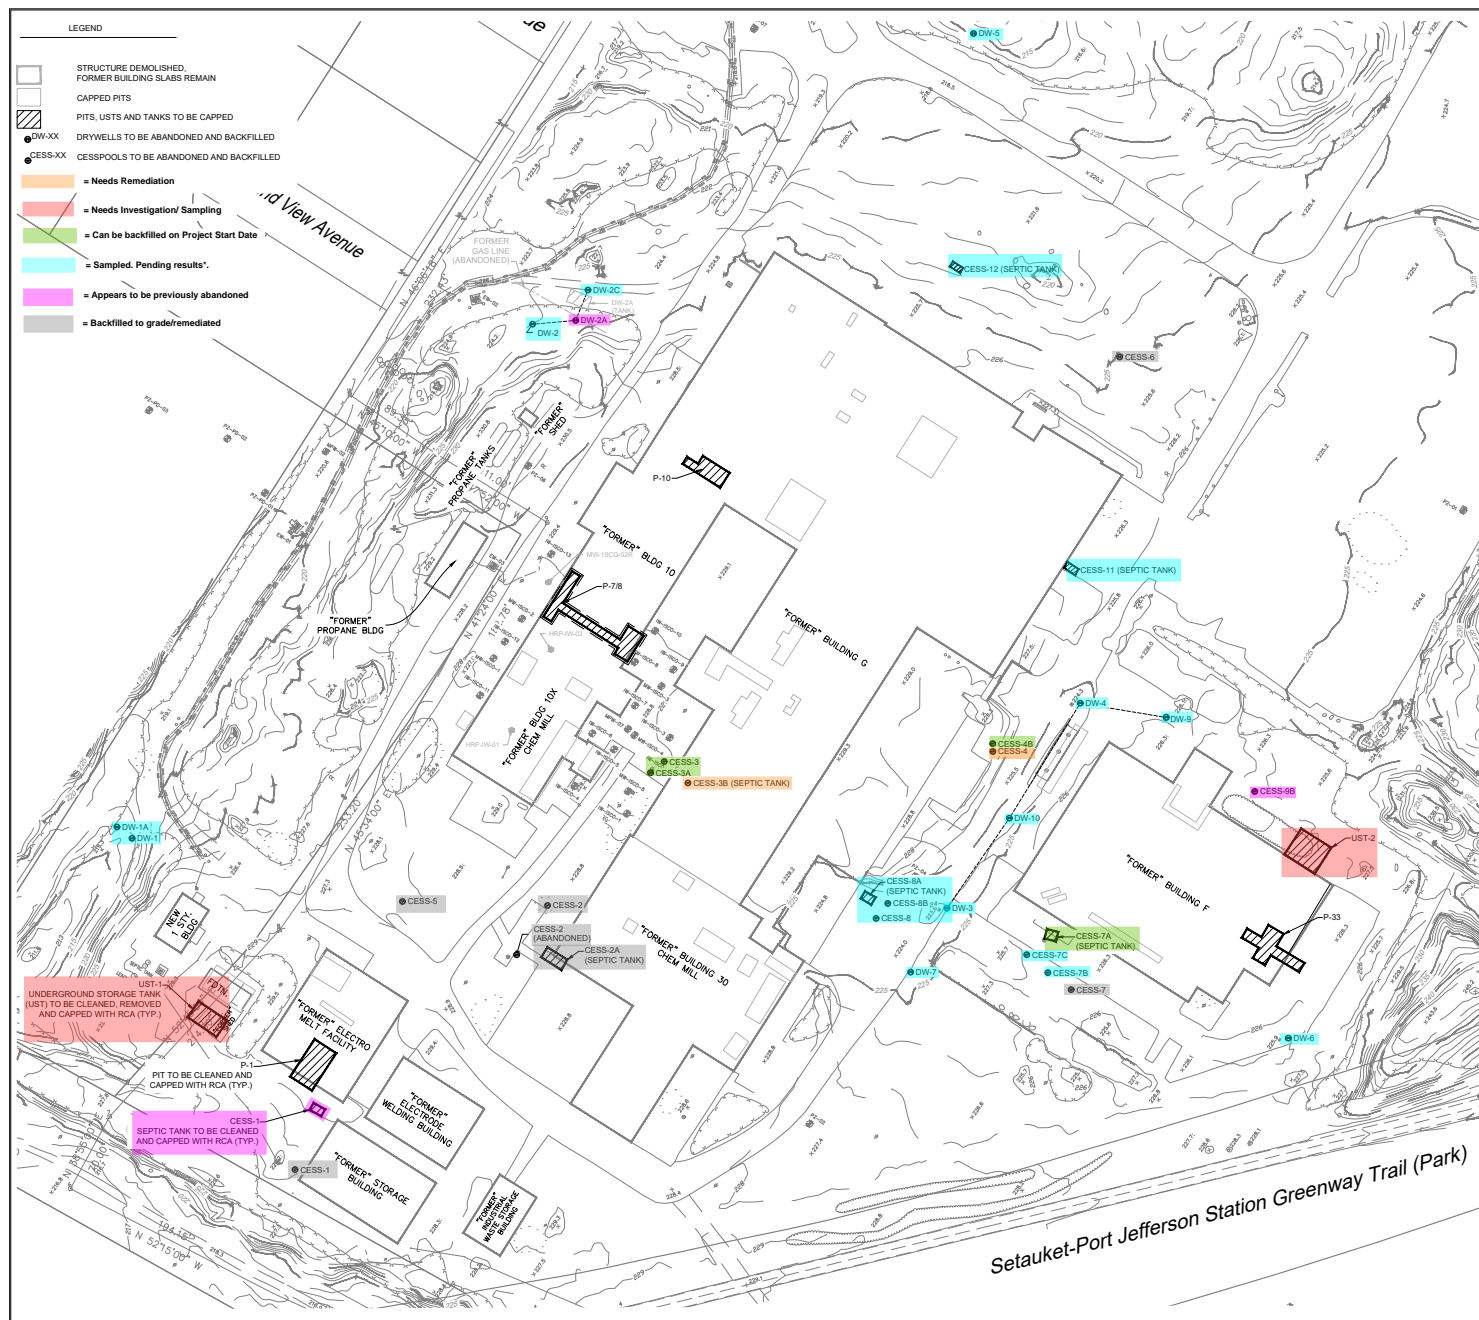
None	

Project Schedule Comments

Issues Pending




Interaction with Public, Property Owners, Media, etc.

Include (insert) figures with markups showing location of work and job progress



FORMER GARAGE LOCATED ON THE NORTHEAST CORNER OF THE
PROPERTY OFF OF SHEEP PASTURE ROAD

- GENERAL NOTES:

<div> <div>  <div> <div>HRP</div> <div> MOVE YOUR ENVIRONMENT FORWARD ONE FAIRCHILD SQUARE SUITE 110 CLIFTON PARK, NY 12065 (518) 877-7101 HRP@ASSOCIATES.COM </div> </div> <div>  <div>NORTH</div> </div> <div>  </div> </div> </div>	<div> <div> <div>DESIGNED</div> <div>SCALE</div> <div>1" = 50'</div> </div> <div> <div>CVP</div> <div>DATE</div> <div>06/26/2024</div> </div> <div> <div>REVISED</div> <div>PROJECT NUMBER</div> <div>DEC1027 OM</div> </div> <div> <div>APPROVED</div> <div>SHEET SIZE</div> <div></div> </div> </div>	<div> <div>NO.</div> <div>DATE</div> <div></div> <div></div> <div></div> <div></div> <div></div> <div></div> <div></div> <div></div> </div>	<div> <div>REVISIONS</div> <div>DESCRIPTION</div> <div></div> <div></div> <div></div> <div></div> <div></div> <div></div> <div></div> <div></div> </div>
	<div> <div> <div> <div> <div>LAWRENCE AVIATION INDUSTRIES</div> <div>NEW YORK STATE DEPARTMENT OF ENVIRONMENTAL CONSERVATION</div> <div>100 SHEEP PASTURE ROAD</div> <div>PO BOX 100</div> </div> </div> </div> </div>	<div> <div> <div>SITE DRAINAGE FEATURES</div> <div>2025</div> </div> </div>	<div> <div>SHEET NO.</div> <div>Fig. 2</div> </div>

[illegible]

DESIGNED:	CVP	SCALE:	1" = 50'
DRAWN:	CVP	ISSUE DATE:	06/26/2024
REVIEWED:	DR	PROJECT NUMBER:	DEC1027.0M
APPROVED:		SHEET SIZE:	

**LAWRENCE AVIATION
INDUSTRIES**
NEW YORK STATE DEPARTMENT OF
ENVIRONMENTAL CONSERVATION
100 SHEEP PASTURE ROAD
PORT JEFFERSON, NEW YORK

SITE DRAINAGE FEATURES

SHEET NO.

Fig. 2

Site Photographs (Descriptions Below)	
	
Photo 1 – Excavation of CESS-1, typical for all cesspool structures, dome removed and structure backfilled.	Photo 2- Excavation of CESS-5 structure.
	
Photo 3 – Excavation of CESS-2 structures (2 overfills and previously abandoned septic tank)	Photo 4- Backfilling of CESS-2 (abandoned) structure.
	
Photo 5 – Excavation of CESS-7 structure.	Photo 6 – Exposed CESS-6 structure prior to backfilling.

	
<p>Photo 7 – Backfilled CESS-5.</p>	<p>Photo 8 – Backfilled CESS-1.</p>
	
<p>Photo 9 – Backfilled CESS-7.</p>	<p>Photo 10 – Backfilled CESS-6.</p>
<p>Comments</p>	
Empty space for comments	
<p>Site Inspector(s): Carly Saindon and Pawel Mecinski</p>	<p>Date: 01/27/2024</p>

Videos of discreet operations have been provided to the DEC Project Manager to facilitate understanding of the ongoing work?
 Yes ☐ No ☐ N/A ☐

REMEDIAL ACTIVITIES AT OTHER PROPERTIES
[Residential, Adjacent, AWS, non-Site Properties]
(Section may be deleted for ongoing remedial sites)

1. Does the Department and its Contractor(s) have permission to enter the property or properties for the day's work?	Yes <input checked="" type="checkbox"/>	No <input type="checkbox"/>
2. Does anyone at this location have any symptoms of a respiratory infection (e.g., cough, sore throat, fever, or shortness of breath)?	Yes <input type="checkbox"/>	No <input checked="" type="checkbox"/>
3. Has anyone at this location been tested and confirmed to have COVID-19?	Yes <input type="checkbox"/>	No <input checked="" type="checkbox"/>
4. If Yes to 1, 2 or 3, follow the latest NYSDOH COVID-19 guidance: https://coronavirus.health.ny.gov/home	Yes <input type="checkbox"/>	No <input type="checkbox"/>
<u>Comments:</u>		

ON-SITE WASTE STORAGE

Drums, roll offs and piles are staged in secure areas?	Yes <input checked="" type="checkbox"/>	No <input type="checkbox"/>	N/A <input type="checkbox"/>
Liners and berms have been installed if necessary to prevent cross contamination of clean areas?	Yes <input type="checkbox"/>	No <input type="checkbox"/>	N/A <input checked="" type="checkbox"/>
Containers are in good condition or properly overpacked?	Yes <input type="checkbox"/>	No <input type="checkbox"/>	N/A <input checked="" type="checkbox"/>
Waste materials are scheduled to be properly characterized and disposed of prior to demobilization?	Yes <input checked="" type="checkbox"/>	No <input type="checkbox"/>	N/A <input type="checkbox"/>
Complying with RCRA 90 day storage limitation for hazardous waste?	Yes <input checked="" type="checkbox"/>	No <input type="checkbox"/>	N/A <input type="checkbox"/>
Piles are securely covered when not in use?	Yes <input type="checkbox"/>	No <input type="checkbox"/>	N/A <input checked="" type="checkbox"/>
Containers are closed when not in use?	Yes <input type="checkbox"/>	No <input type="checkbox"/>	N/A <input checked="" type="checkbox"/>
Staging areas should be inspected periodically and any issues addressed immediately?	Yes <input checked="" type="checkbox"/>	No <input type="checkbox"/>	N/A <input type="checkbox"/>
Signage and labeling comply with RCRA requirements for all staging areas and containers?	Yes <input type="checkbox"/>	No <input type="checkbox"/>	N/A <input checked="" type="checkbox"/>
If any issues noted, has Contractor been notified?	Yes <input type="checkbox"/>	No <input type="checkbox"/>	N/A <input checked="" type="checkbox"/>
<u>Comments:</u>			

NUISANCE CHECKLIST

Were there any community complaints related to work on this date?	Yes <input type="checkbox"/>	No <input checked="" type="checkbox"/>	N/A <input type="checkbox"/>
Were there any odors detected on this date?	Yes <input type="checkbox"/>	No <input checked="" type="checkbox"/>	N/A <input type="checkbox"/>
Was noise outside specification and/or above background on this date?	Yes <input type="checkbox"/>	No <input checked="" type="checkbox"/>	N/A <input type="checkbox"/>
Were vibration readings outside specification and/or above background on this date?	Yes <input type="checkbox"/>	No <input checked="" type="checkbox"/>	N/A <input type="checkbox"/>
Any visible dust observed beyond the work perimeter on this date?	Yes <input type="checkbox"/>	No <input checked="" type="checkbox"/>	N/A <input type="checkbox"/>
Any visible contrast (turbidity) beyond engineering controls observed on this date?	Yes <input type="checkbox"/>	No <input checked="" type="checkbox"/>	N/A <input type="checkbox"/>
Was turbidity checked at the outfall(s)?	AM <input type="checkbox"/>	PM <input type="checkbox"/>	N/A <input checked="" type="checkbox"/>
Were any property owners NOT provided advance notice for work performed on this property on this date?	Yes <input type="checkbox"/>	No <input checked="" type="checkbox"/>	N/A <input type="checkbox"/>

Was the temporary fabric structure closed at the end of the day?	Yes <input type="checkbox"/>	No <input type="checkbox"/>	N/A <input checked="" type="checkbox"/>
Has Contractor failed to protect all foundations and structures adjacent to and adjoining the site which are affected by the excavations or other operations connected with performance of the Work?	Yes <input type="checkbox"/>	No <input type="checkbox"/>	N/A <input checked="" type="checkbox"/>
If yes, has Contractor been notified?	Yes <input type="checkbox"/>	No <input type="checkbox"/>	N/A <input checked="" type="checkbox"/>
<u>Comments:</u>			

RESILIENCE/GREEN REMEDIATION CHECKLIST

Is site power procured from renewable energy sources (e.g., solar, wind, geothermal, biomass and biogas)?	Yes <input type="checkbox"/>	No <input type="checkbox"/>	N/A <input checked="" type="checkbox"/>
Is the Contractor employing 2007 or newer or retrofitted (BART*) diesel on-road trucks and non-road equipment?	Yes <input type="checkbox"/>	No <input type="checkbox"/>	N/A <input checked="" type="checkbox"/>
Is vehicle idling adequately reduced per 6NYCRR Part 217-3?	Yes <input type="checkbox"/>	No <input type="checkbox"/>	N/A <input checked="" type="checkbox"/>
Have equipment operators been trained in the idling requirements of 6NYCRR Part 217-3?	Yes <input type="checkbox"/>	No <input type="checkbox"/>	N/A <input checked="" type="checkbox"/>
Is BART-equipped equipment properly maintained and working?	Yes <input type="checkbox"/>	No <input type="checkbox"/>	N/A <input checked="" type="checkbox"/>
Is work being sequenced to avoid double handling?	Yes <input checked="" type="checkbox"/>	No <input type="checkbox"/>	N/A <input type="checkbox"/>
Is there an onsite recycling program for CONTRACTOR-generated wastes and is it complied with?	Yes <input type="checkbox"/>	No <input type="checkbox"/>	N/A <input checked="" type="checkbox"/>
Are office trailer heating and cooling systems maintained at efficient set points, have programmable thermostats been installed?	Yes <input type="checkbox"/>	No <input type="checkbox"/>	N/A <input checked="" type="checkbox"/>
Are products and materials used in performance of the work appropriately certified (e.g., LEED, Energy Star, Sustainable Forestry Initiative®, etc.)?	Yes <input type="checkbox"/>	No <input type="checkbox"/>	N/A <input checked="" type="checkbox"/>
Are resiliency features included in the design, or completed remedy properly installed and/or maintained (flood control, storm water controls, erosion measures, etc.)?	Yes <input type="checkbox"/>	No <input type="checkbox"/>	N/A <input checked="" type="checkbox"/>
Are green remediation elements included in the design, or completed remedy properly installed and/or maintained (e.g., porous pavement, geothermal, variable speed drives, native plantings, natural stream bank restoration, etc.)?	Yes <input type="checkbox"/>	No <input type="checkbox"/>	N/A <input checked="" type="checkbox"/>
Has Contractor been notified of any deficiencies?	Yes <input type="checkbox"/>	No <input type="checkbox"/>	N/A <input checked="" type="checkbox"/>
Are remote/call in job meetings being held in lieu of meeting in person where possible?	Yes <input type="checkbox"/>	No <input checked="" type="checkbox"/>	N/A <input type="checkbox"/>
<u>Comments:</u>			

* BART – Best Available Retrofit Technology