

Project: Spectrum Finishing - Remedial Action
 Contractor: EnviroTrac Environmental Services
 CDM Job No: D-006956 Site No. 1-52-029
 CDM Project Manager: John Blaum

CDM
 100 Crossways Park West
 Woodbury, NY 11797
 Telephone: 516.496.8400
 Fax: 516.496.8864

DAILY REPORT

Day:

S	M	T	W	TH	F	S
---	---	---	---	----	---	---

 Date: 18-May-09
 REPORT No. 145
 PAGE No. 1

WEATHER	Clear	Partly Cloudy	Overcast	Rain	Snow
TEMP L/H		56/60			
HUMIDITY	Dry	Moderate	High		
WIND	Calm	Light	Moderate	High	
WIND DIR	N	E	S	W	
	NE	SE	SW	NW	

PREPARED BY: F.Robinson TITLE: Inspector

AVERAGE FIELD FORCE

Name of Contractor	Title	Hours Worked	Remarks
EnviroTrac	Construction Manager	1x8 hrs	M.Rose
EnviroTrac	Operator	2x8 hrs	B.Gimbel, J.Byrnes
EnviroTrac	Technician	2x8 hrs	K.Davies, R.Maletta
AARCO	Technician	2x8 hrs	M. Bonislawski, A.Sanchez
Cork and Sons	Operator	2X8 hrs	G.Cork
Cork and Sons	Technician	2x8 hrs	T.Cork, G. Christie
United Cesspool	Technician	1x1 hrs	Shawn Gaul

EQUIPMENT AT THE SITE

I = Idle W = Working

20" Storage Container - W	AARCO Guzzler Vac Truck - W
Daewoo 450 skidder - W	Cork and Sons Case 580 Backhoe - W
CAT 430E Backhoe -W	Cork and Sons Case CX225SR Excavator - W
Sakai Paving Pro 270 roller - W	Cork and Sons: Mack Dump Truck - W
	United Cesspool Vac Truck - W

HEALTH AND SAFETY

Name	Time (From - To)	Task/Level of PPE
		All workers onsite were in level D-PPE

CONSTRUCTION ACTIVITIES

Site Representative: Frank Robinson - CDM
Health and Safety Site Officer: N/A
DESCRIPTION OF WORK PERFORMED AND OBSERVED
1-Tailgate H&S meeting performed before the start of the work day. 2 air monitoring stations, dust and PID, were set up.
2-AARCO cleaned out the following structures of sediment: 60 Dale St.:DS-9 and 12. 51 Cabot St.: CP-5. United Cesspool pumped liquids from the following structures: 60 Dale St.: DS-12. 50 Dale St.: DS-10. 51 Cabot St.: CP-5.
3-EnviroTrac conducted end point sampling on the following structures that were cleaned out: 51 Cabot St.:CP-6A. Sample were collected with the excavator's bucket and sampled for metals EPA 6010 and 7470 and volatiles EPA 8260.
4-Cork and Sons performed the following work: 51 Cabot St.: While excavating for PDS-6 (contaminated soil) an unknown structure was found 12' north and 2' west of CP-6, which will be designated CP-6A, an overflow structure for CP-6. CP-6A was dug out and PDS-6 was installed in its location. The contaminated soil was moved to a separate staging area at 50 Dale St. Visibly green contaminated soil was excavated around CP-6A, ~1-2' around the structure. CP-6A's dome will go out as C&D and the rings were broken up and will out with the contaminated soil. Only visible contaminated soil left was on the south wall, 6-12' BGS. PDS-6 was backfilled to grade.
5-EnviroTrac rolled the RCA in the south alleyway in preparation of paving the alleyway tomorrow.
6- Long Island Pre-Cast delivered 1 load of structures to the site. Delivery slip will be sent at a later date, the driver did not have it.
7-A Port-a-John was delivered for use by the people in 51 Cabot St. while septic system #4 is installed.

x - Designates report is continued on additional pages

CDM Site Representative: F. Robinson

Project Manager: John Blaum

PHOTOGRAPHIC LOG
18-May-09
CDM Job No. D-006956
Spectrum Finishing Remedial Action
SITE No. 1-52-029

PHOTO	DATE	TIME	DESCRIPTION
100_00616.jpg	5/18/2009	AM	EnviroTrac compacting RCA in south alleyway
100_00617.jpg	5/18/2009	AM	Location of CP-6A (51 Cabot St.) previously unknown, overflow to CP-6
100_00620.jpg	5/18/2009	AM	Visibly contaminated green soil next to CP-6A
100_00624.jpg	5/18/2009	PM	AARCO cleaning out CP-5, 51 Cabot St.
100_00626.jpg	5/18/2009	PM	PDS-6 installed in location of CP-6A by Cork and Sons
100_00628.jpg	5/18/2009	PM	PDS-6 backfilled to grade
100_00623.jpg	5/18/2009	PM	Visibly contaminated green soil left on south wall of CP-6A 6-12' BGS

PHOTOS 5/18/09



100_00616.jpg - EnviroTrac compacting RCA in south alleyway



100_00617.jpg - Location of CP-6A (51 Cabot St.) previously unknown overflow to CP-6



100_00620.jpg - Visibly contaminated green soil next to CP-6A



100_00624.jpg -AARCO cleaning out CP-5 (51 Cabot St.)




100_00626.jpg - PDS-6 installed in location of CP-6A by Cork and Sons



100_00628.jpg - PDS-6 backfilled to grade



100_00623.jpg - Visibly contaminated green soil left on south wall of CP-6A,6-12' BGS

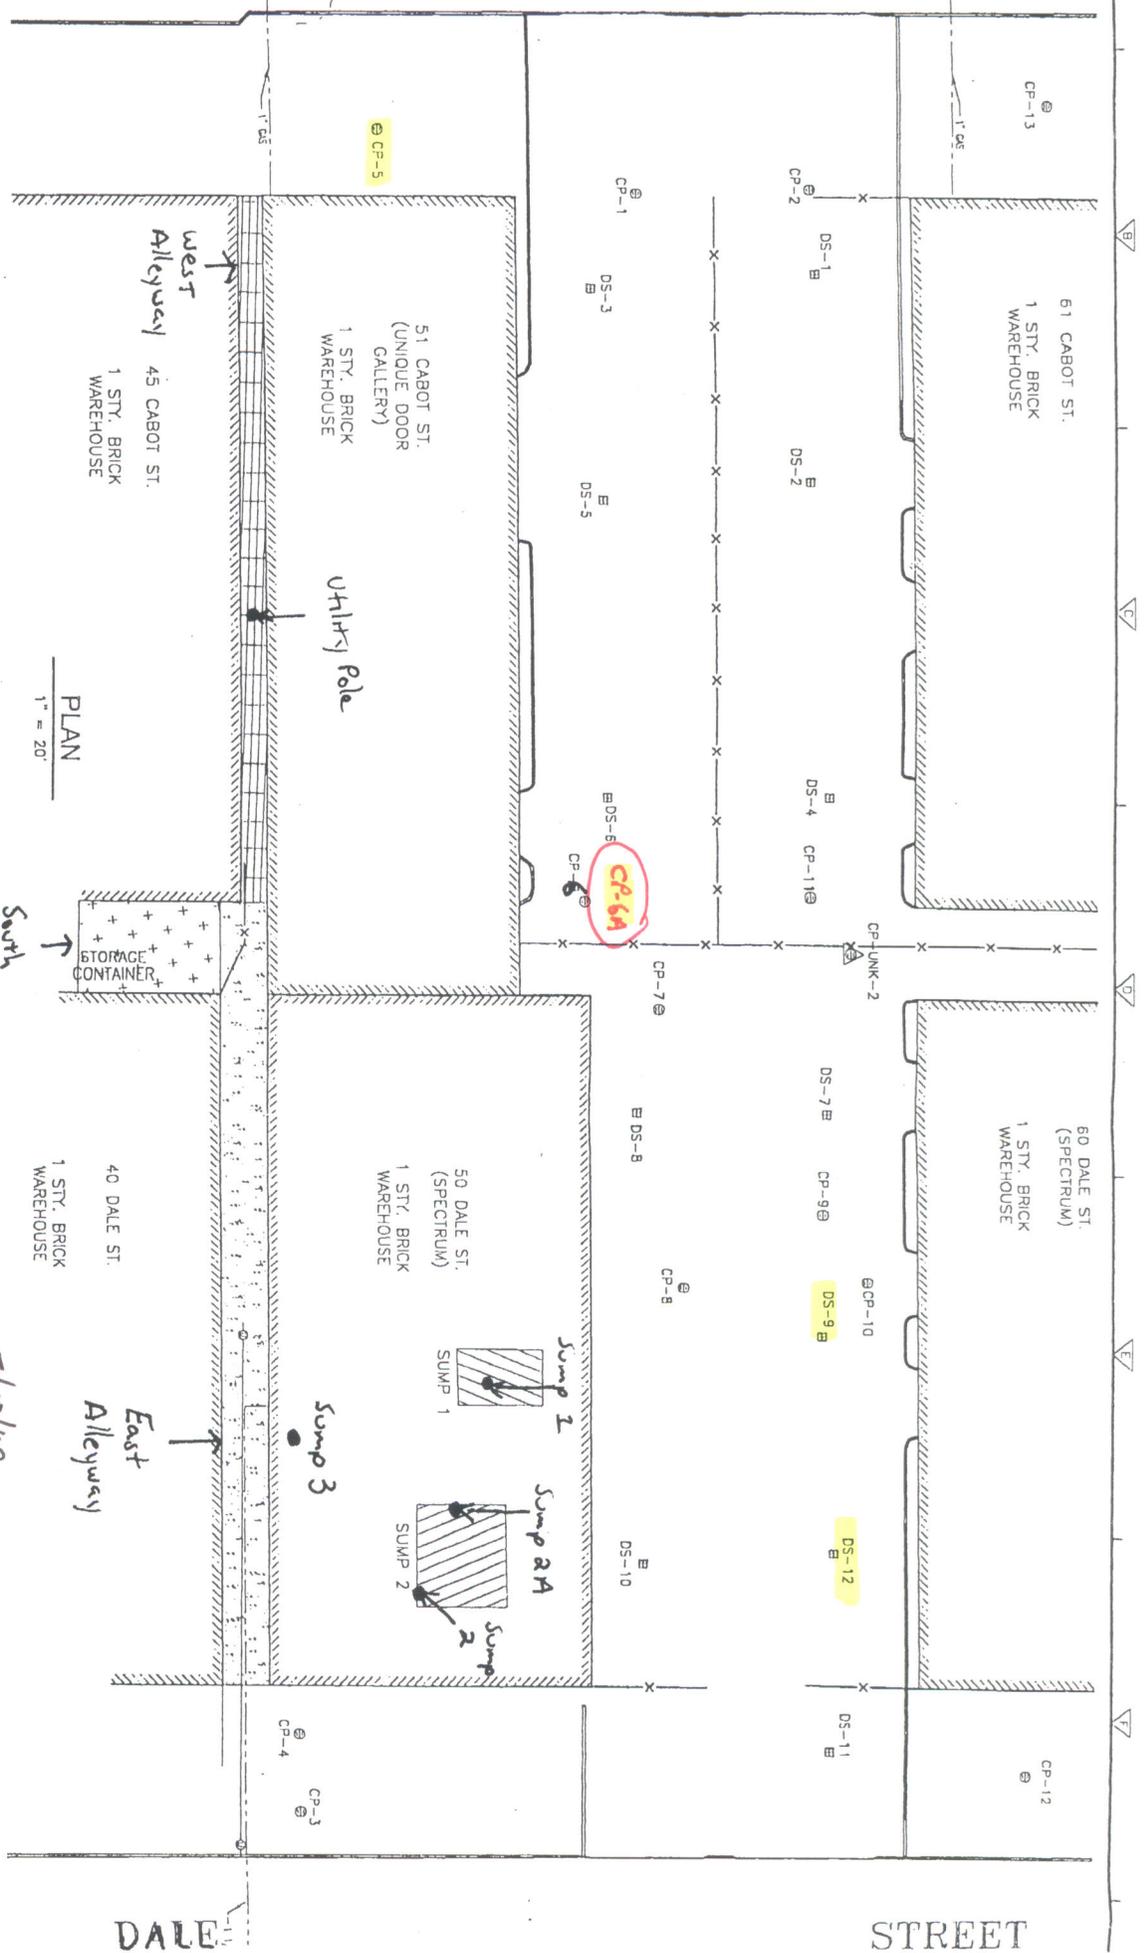

PLAN
1" = 20'

South Alleyway

East Alleyway

5/18/09


Work Areas

End Point Sample

DALE

STREET


CABOT STREET

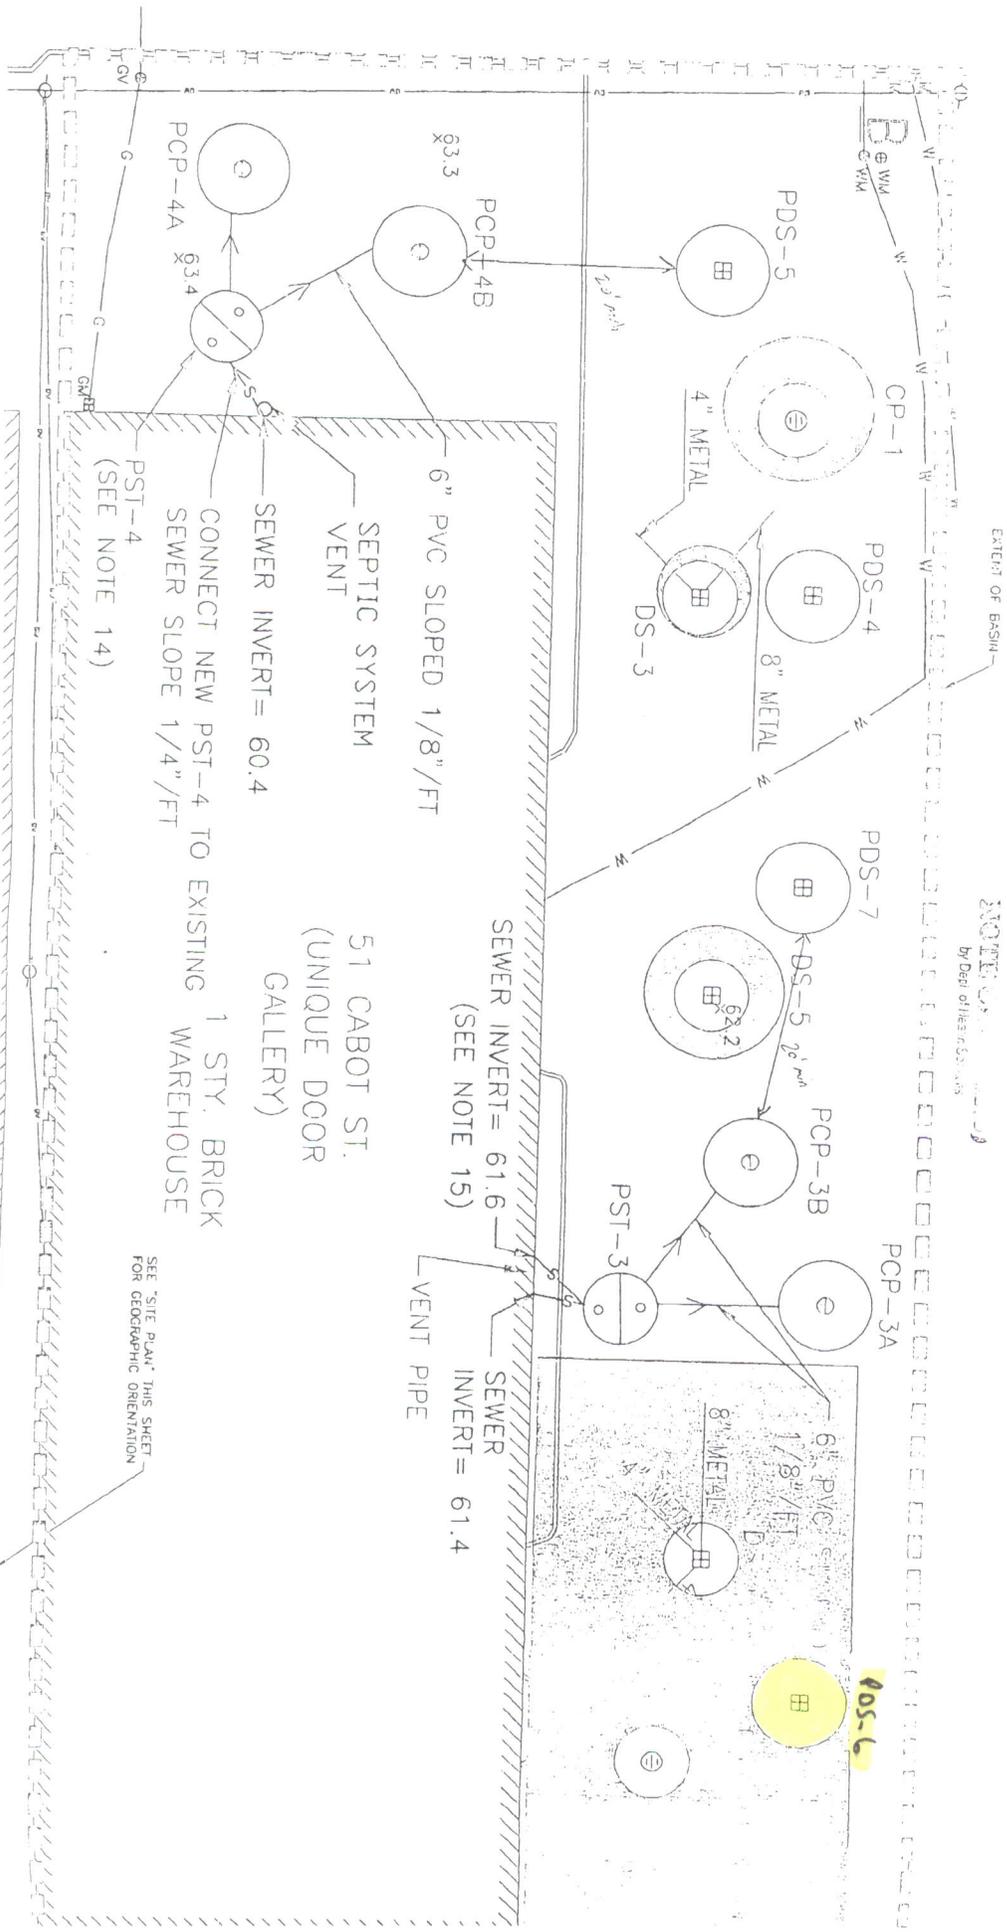

NOTE
By Dept of Health Services

5/18/09
Work Area

SEE "SITE PLAN" THIS SHEET FOR GEOGRAPHIC ORIENTATION

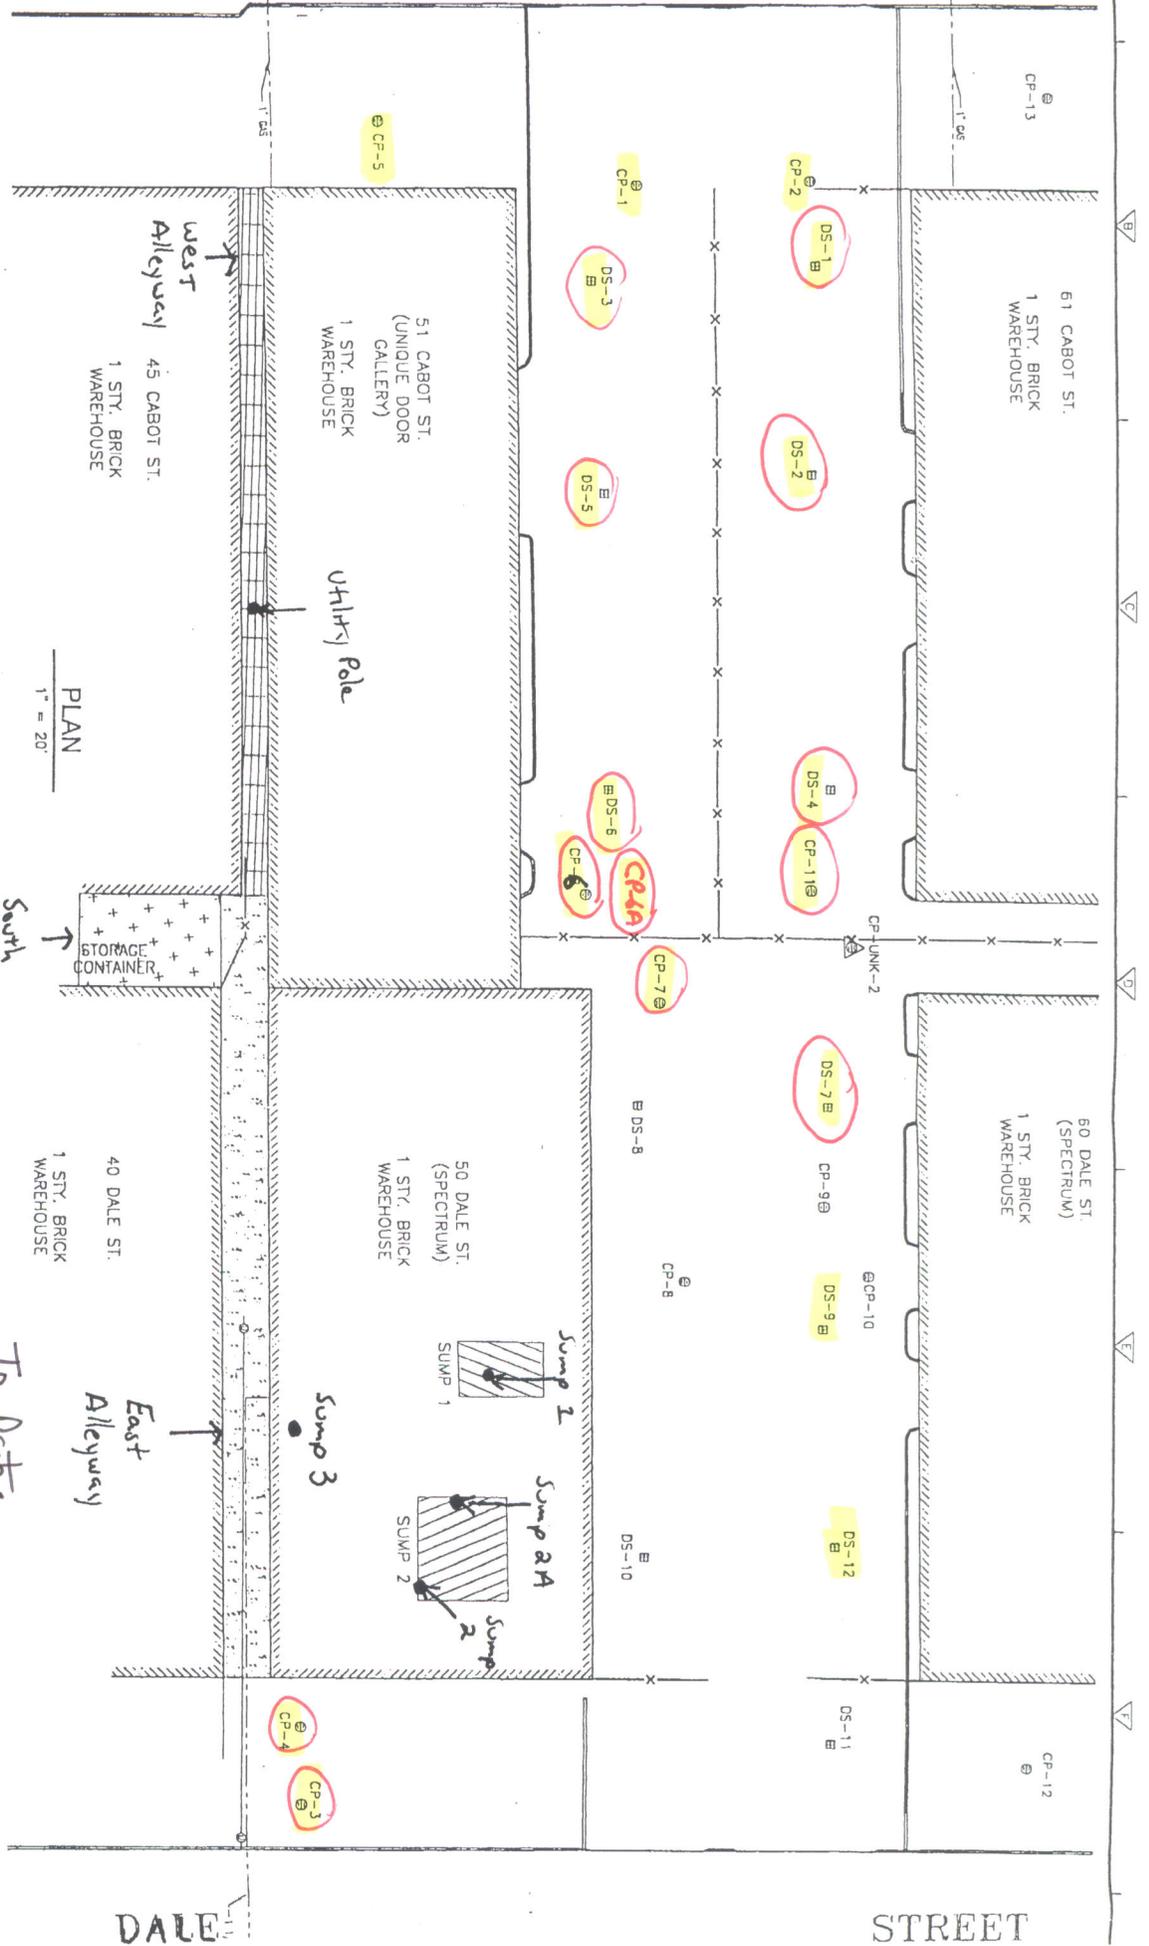

PLAN
1" = 20'

South Alleyway

To Date:

Structures cleaned out

end point sampled

DALE

STREET