

Project: Spectrum Finishing - Remedial Action
 Contractor: EnviroTrac Environmental Services
 CDM Job No: D-006956 Site No. 1-52-029
 CDM Project Manager: John Blaum

CDM
 100 Crossways Park West
 Woodbury, NY 11797
 Telephone: 516.496.8400
 Fax: 516.496.8864

DAILY REPORT

Day:

S	M	T	W	TH	F	S
---	---	---	---	----	---	---

 Date: 26-May-09
 REPORT No. 150
 PAGE No. 1

WEATHER	Clear	Partly Cloudy	Overcast	Rain	Snow
TEMP L/H		54/60			
HUMIDITY	Dry	Moderate	High		
WIND	Calm	Light	Moderate	High	
WIND DIR	N	E	S	W	
	NE	SE	SW	NW	

PREPARED BY: F.Robinson TITLE: Inspector

AVERAGE FIELD FORCE

Name of Contractor	Title	Hours Worked	Remarks
EnviroTrac	Construction Manager	1x8 hrs	M.Rose
EnviroTrac	Operator	2x8 hrs	B.Gimbel, J.Byrnes
EnviroTrac	Technician	2x8 hrs	K.Davies, R.Maletta
Cork and Sons	Operator	2x8 hrs	G.Cork, G.Cork
Cork and Sons	Technician	4x8 hrs	E.O'Connor, L.Moreno, T.Cork, G.Christie
AARCO	Technician	2x8 hrs	A.Sanchez, M.Pellegrino

EQUIPMENT AT THE SITE

I = Idle W = Working

20" Storage Container - W	Cork and Sons: Mack Dump Truck - W
Daewoo 450 skidder - W	Cork and Sons Case 580 Backhoe - W
CAT 430E Backhoe -W	Cork and Sons Case CX225SR Excavator - W
Case 621C Front End Loader - I	

HEALTH AND SAFETY

Name	Time (From - To)	Task/Level of PPE
		All workers onsite were in level D-PPE

CONSTRUCTION ACTIVITIES

Site Representative: Frank Robinson - CDM
Health and Safety Site Officer: N/A
DESCRIPTION OF WORK PERFORMED AND OBSERVED
1-Tailgate H&S meeting performed before the start of the work day. 2 air monitoring stations, dust and PID.
2-Cork and Sons performed the following work at 61 Cabot St.: Received structures for septic system #2. Removed CP-13 and installed PST-2 in its location and installed piping from the building to PST-2.. PST-2 was moved to the north and east to comply with the property line requirements. PCP-2A was installed and piping installed to PST-2. 51 Cabot St.: new roof drain piping was installed to PDS-7 that previously ran to an existing structure, DS-5.
3-EnviroTrac collected end point samples from CP-13 (61 Cabot St.) using the excavator bucket and 50 Dale St: CP-8, DS-8 and 10;60 Dale St.: DS-11 using a hand auger . The samples will be analyzed for metals EPA 6010 and 7470 and volatiles EPA 8260.
4-AARCO cleaned out the following structures: 61 Cabot St.: CP-13. 50 Dale St.: DS-8, CP-8 was cleaned out previously (like CP-3 and 4) to the bottom of the structure, no need to clean out now.
5-There was no report yesterday, 5/25/09 as it was Memorial Day.



x - Designates report is continued on additional pages

CDM Site Representative: F. Robinson

Project Manager: John Blaum

PHOTOGRAPHIC LOG
26-May-09
CDM Job No. D-006956
Spectrum Finishing Remedial Action
SITE No. 1-52-029

PHOTO	DATE	TIME	DESCRIPTION
100_00677.jpg	5/26/2009	AM	Completed PDS-5, 51 Cabot St.
100_00681.jpg	5/26/2009	AM	Removing existing CP-13, 61 Cabot St.
100_00684.jpg	5/26/2009	AM	Piping installed 61 Cabot St. to PST-2
100_00691.jpg	5/26/2009	PM	PCP-2 and piping installed to PST-2, 61 Cabot St.
100_00685.jpg	5/26/2009	PM	Installing new roof drain piping to PDS-7, 51 Cabot St.
100_00686.jpg	5/26/2009	PM	Installing new roof drain piping to PDS-7(in background), 51 Cabot St.
100_00690.jpg	5/26/2009	PM	51 and 61 Cabot St. at the end of the day

PHOTOS 5/26/09



100_00677.jpg - Completed PDS-5, 51 Cabot St.



100_00681.jpg - Removing existing CP-13, 61 Cabot St.



100_00684pg - Piping installed from 61 Cabot St. to PST-2



100_00691.jpg - PCP-2A and piping installed to PST-2, 61 Cabot St.




100_00685.jpg - Installing new roof drain piping to PDS-7, 51 Cabot St.



100_00686.jpg - Installing new roof drain piping to PDS-7, in background




100_00690.jpg - 51 and 61 Cabot St. at the end of the day

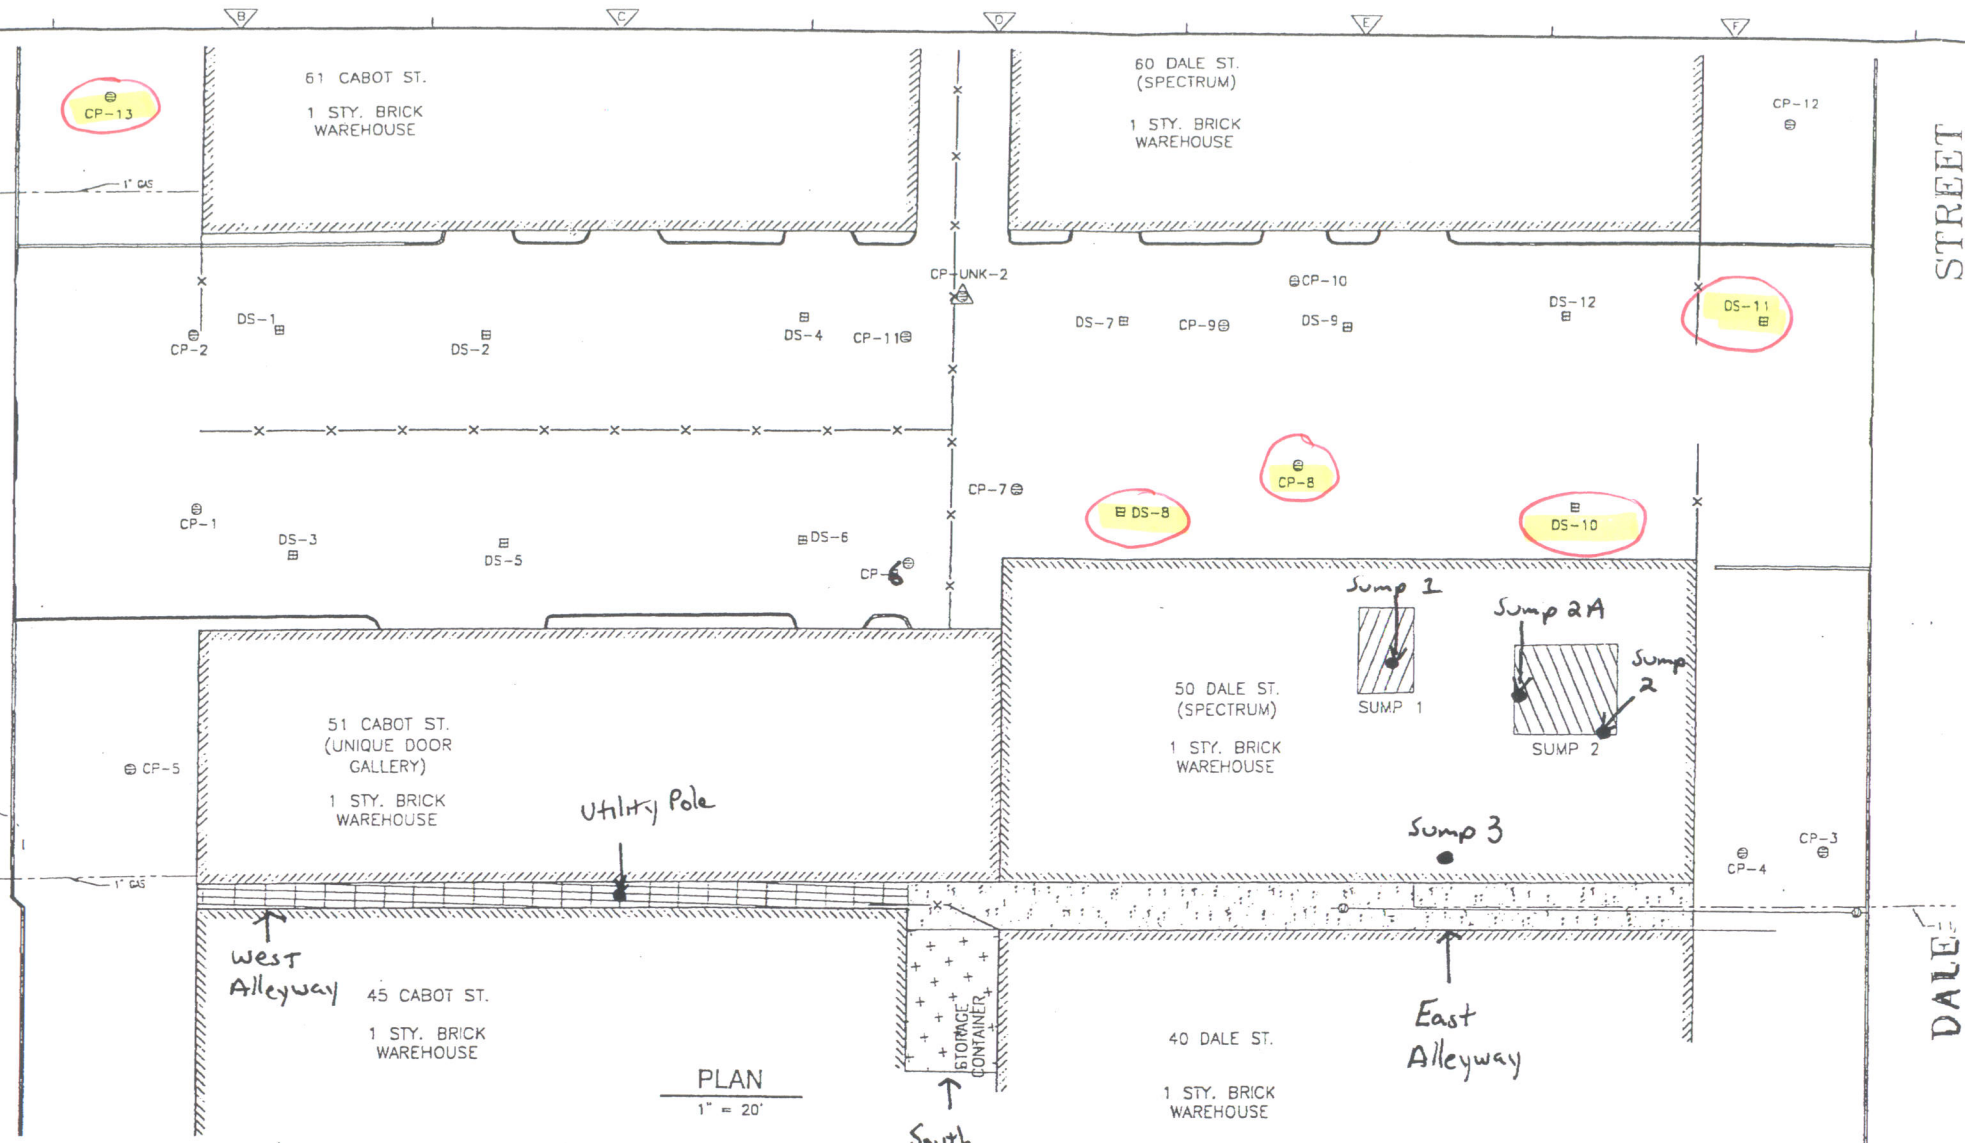

PLAN
1" = 20'

5/26/09

- Work Areas
- End Point Samples

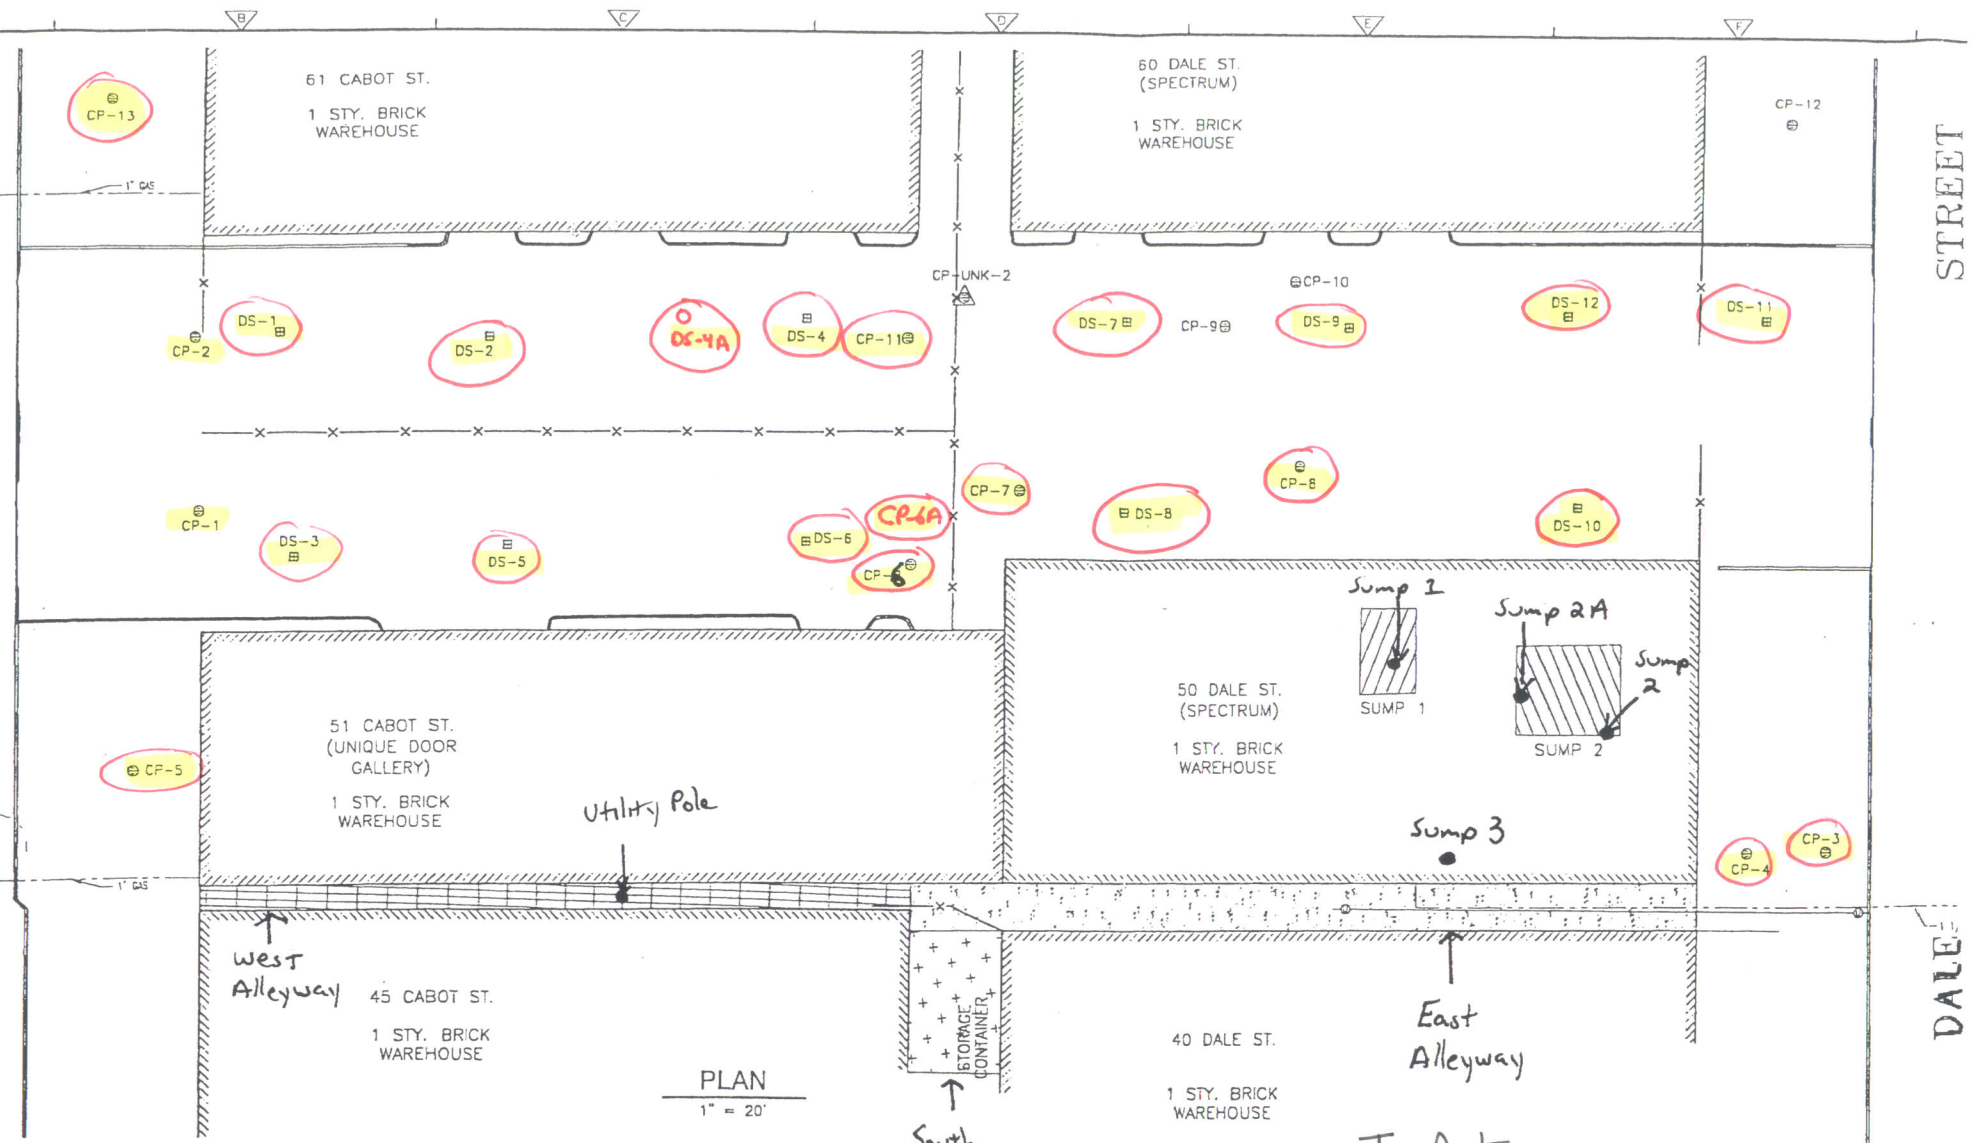


PLAN
1" = 20'


To Date:

- Structures cleaned out
- end point sampled


5/26/09

CABOT STREET

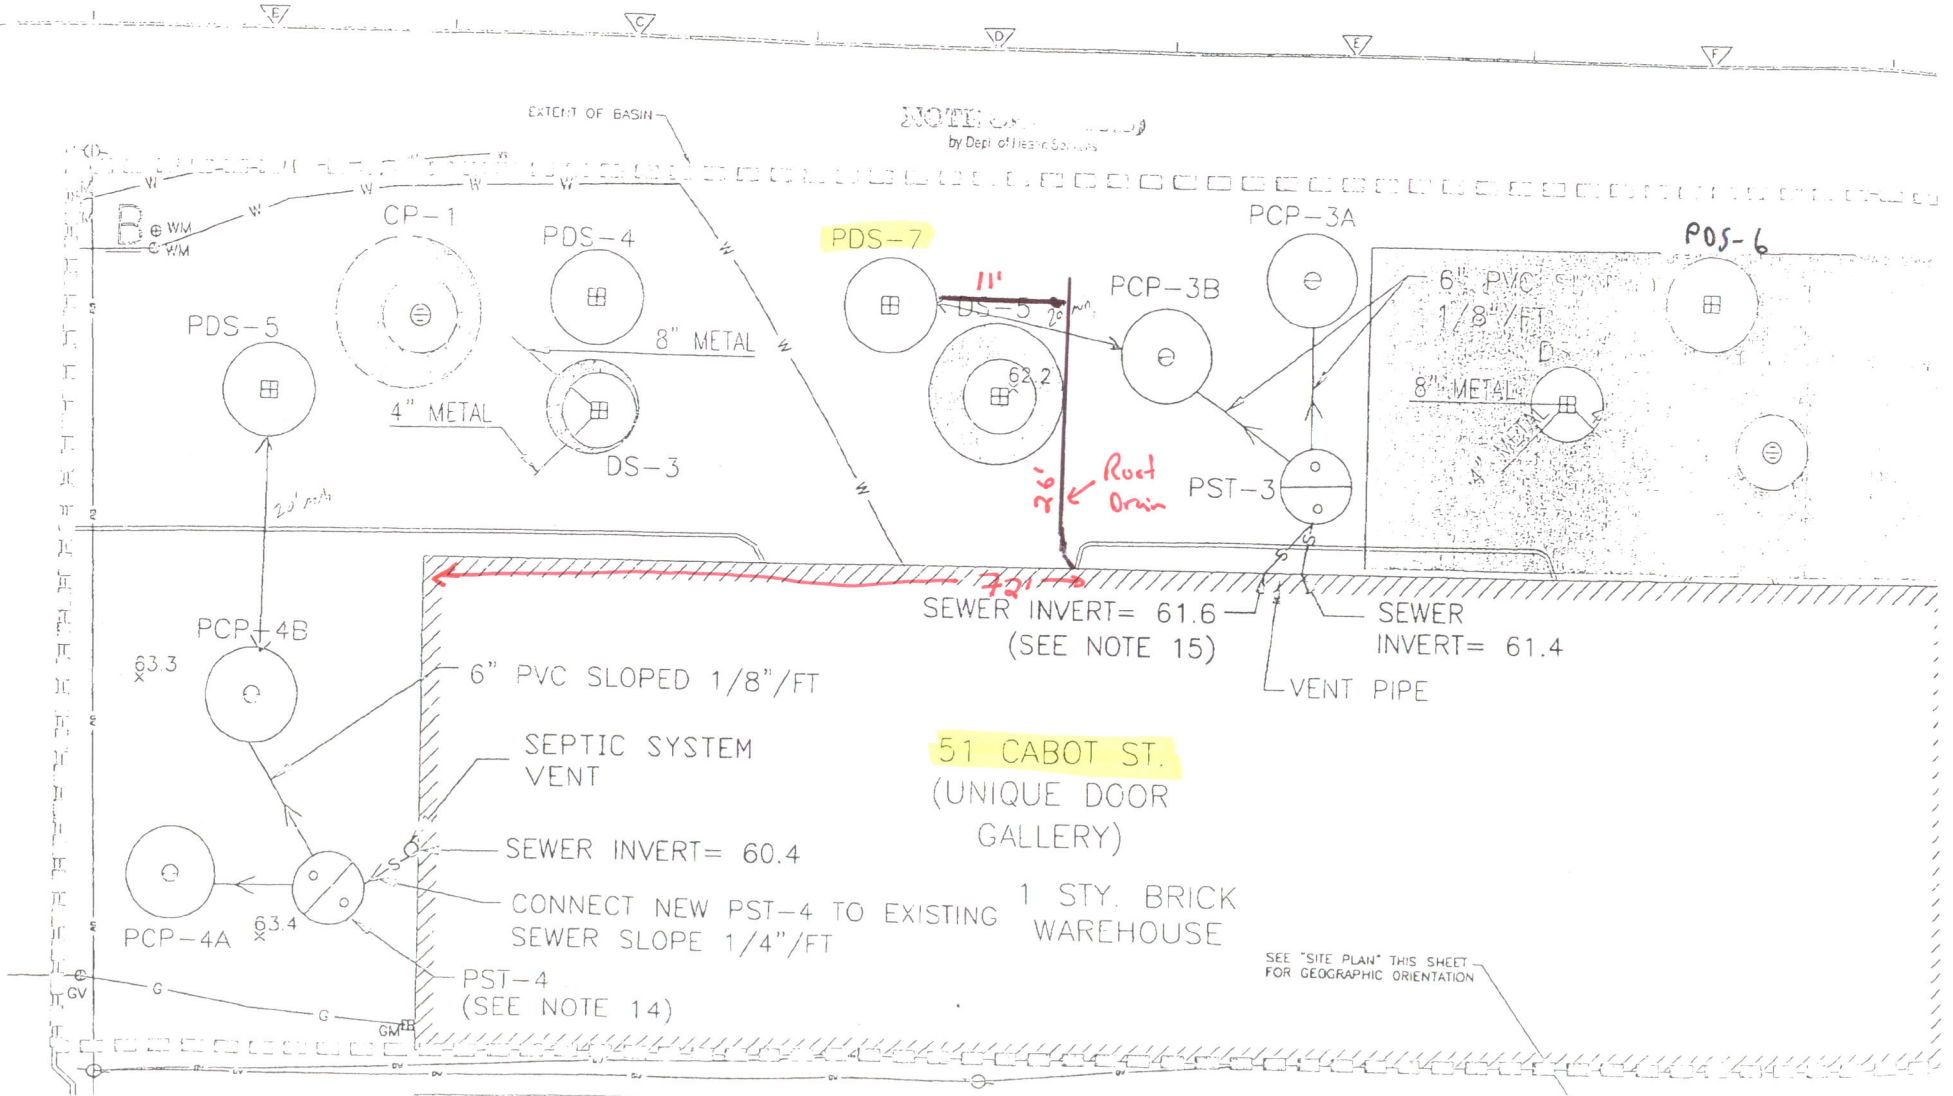

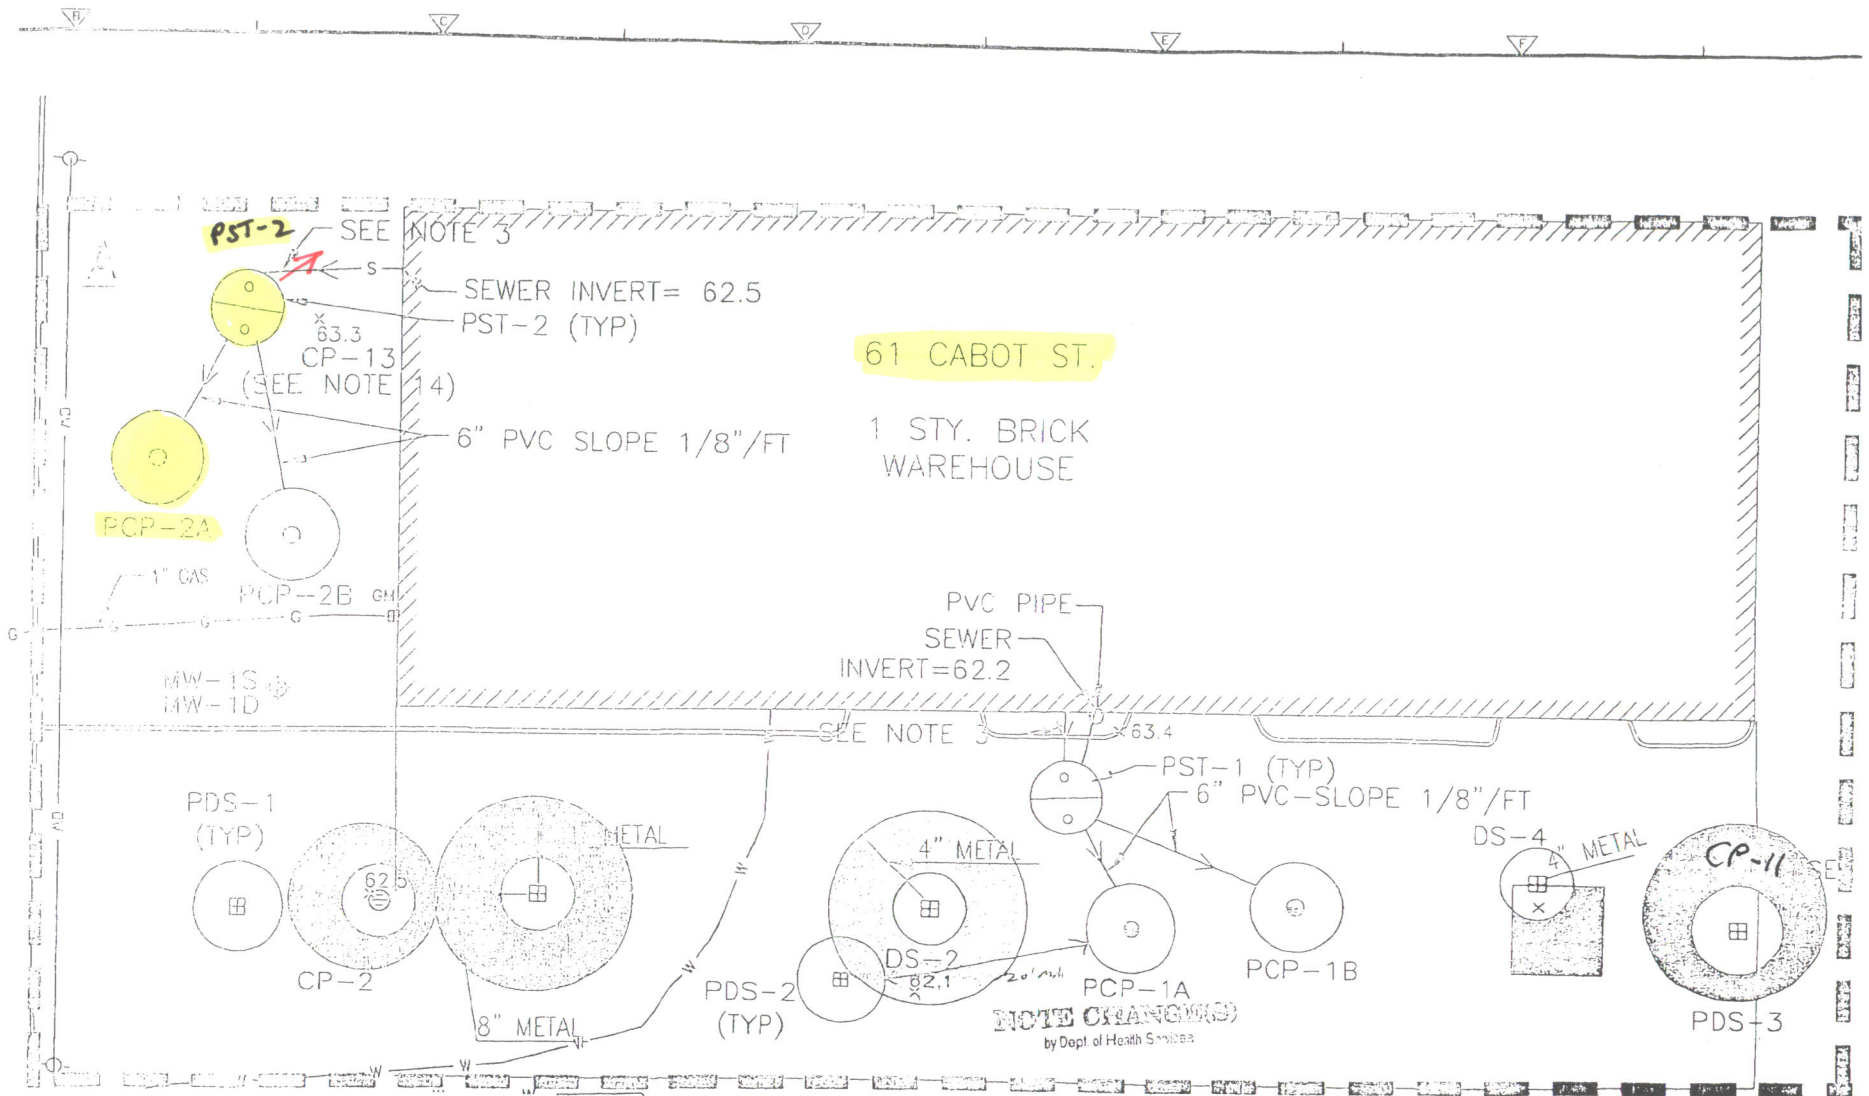

5/26/09

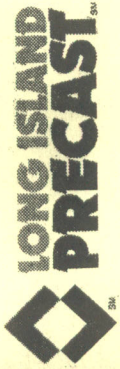

20 Stiriz Road • Brookhaven, NY 11719
 Tel: (631) 286-0240 • Fax: (631) 286-6313

Order No. _____ Date 5-26 2009

Sold To _____
 Ship To CORK

QUANTITY	DESCRIPTION	PRICE	AMOUNT
	Concrete Covers		
<u>1</u>	8' x 4'6" Drain Ring <u>Barrier Wall</u>		
	8' x 4'0" Drain Ring		
	8' x 3'6" Drain Ring		
<u>1</u>	8' x 3'0" Drain Ring <u>Solid Ring</u>		
<u>1</u>	8' x 2'0" Drain Ring <u>mono-burst</u>		
	8' x 2'9" Dome		
	8' x 6" Slab		
<u>1</u>	8' x 8" Slab <u>w/2p</u>		
	4' - 10" x Manhole w/ Steps		
	1000 gal. Septic Tank		
<u>2</u>	<u>10p LowDomes</u>		
	10' x 3' Drain Ring		
	10' x 4' Drain Ring		
<u>2</u>	10' x 5' Drain Ring <u>50w</u>		
	10' x 3'8" Dome		
	10' x 8" Slab		
<u>2</u>	<u>6" Ext</u>		
	1' Extension		
	2' Extension		
	Catch Basin		
<u>4</u>	<u>4" Solid Castings</u>		

A SERVICE CHARGE OF 1.5% PER MONTH WILL BE ADDED TO ALL INVOICES 30 DAYS PAST DUE (AN ANNUAL RATE OF 18%)

FREIGHT _____ TAX _____ TOTAL _____

All claims and returned goods MUST be accompanied by this bill

NO 57206 Rec'd By Gene Blomay