
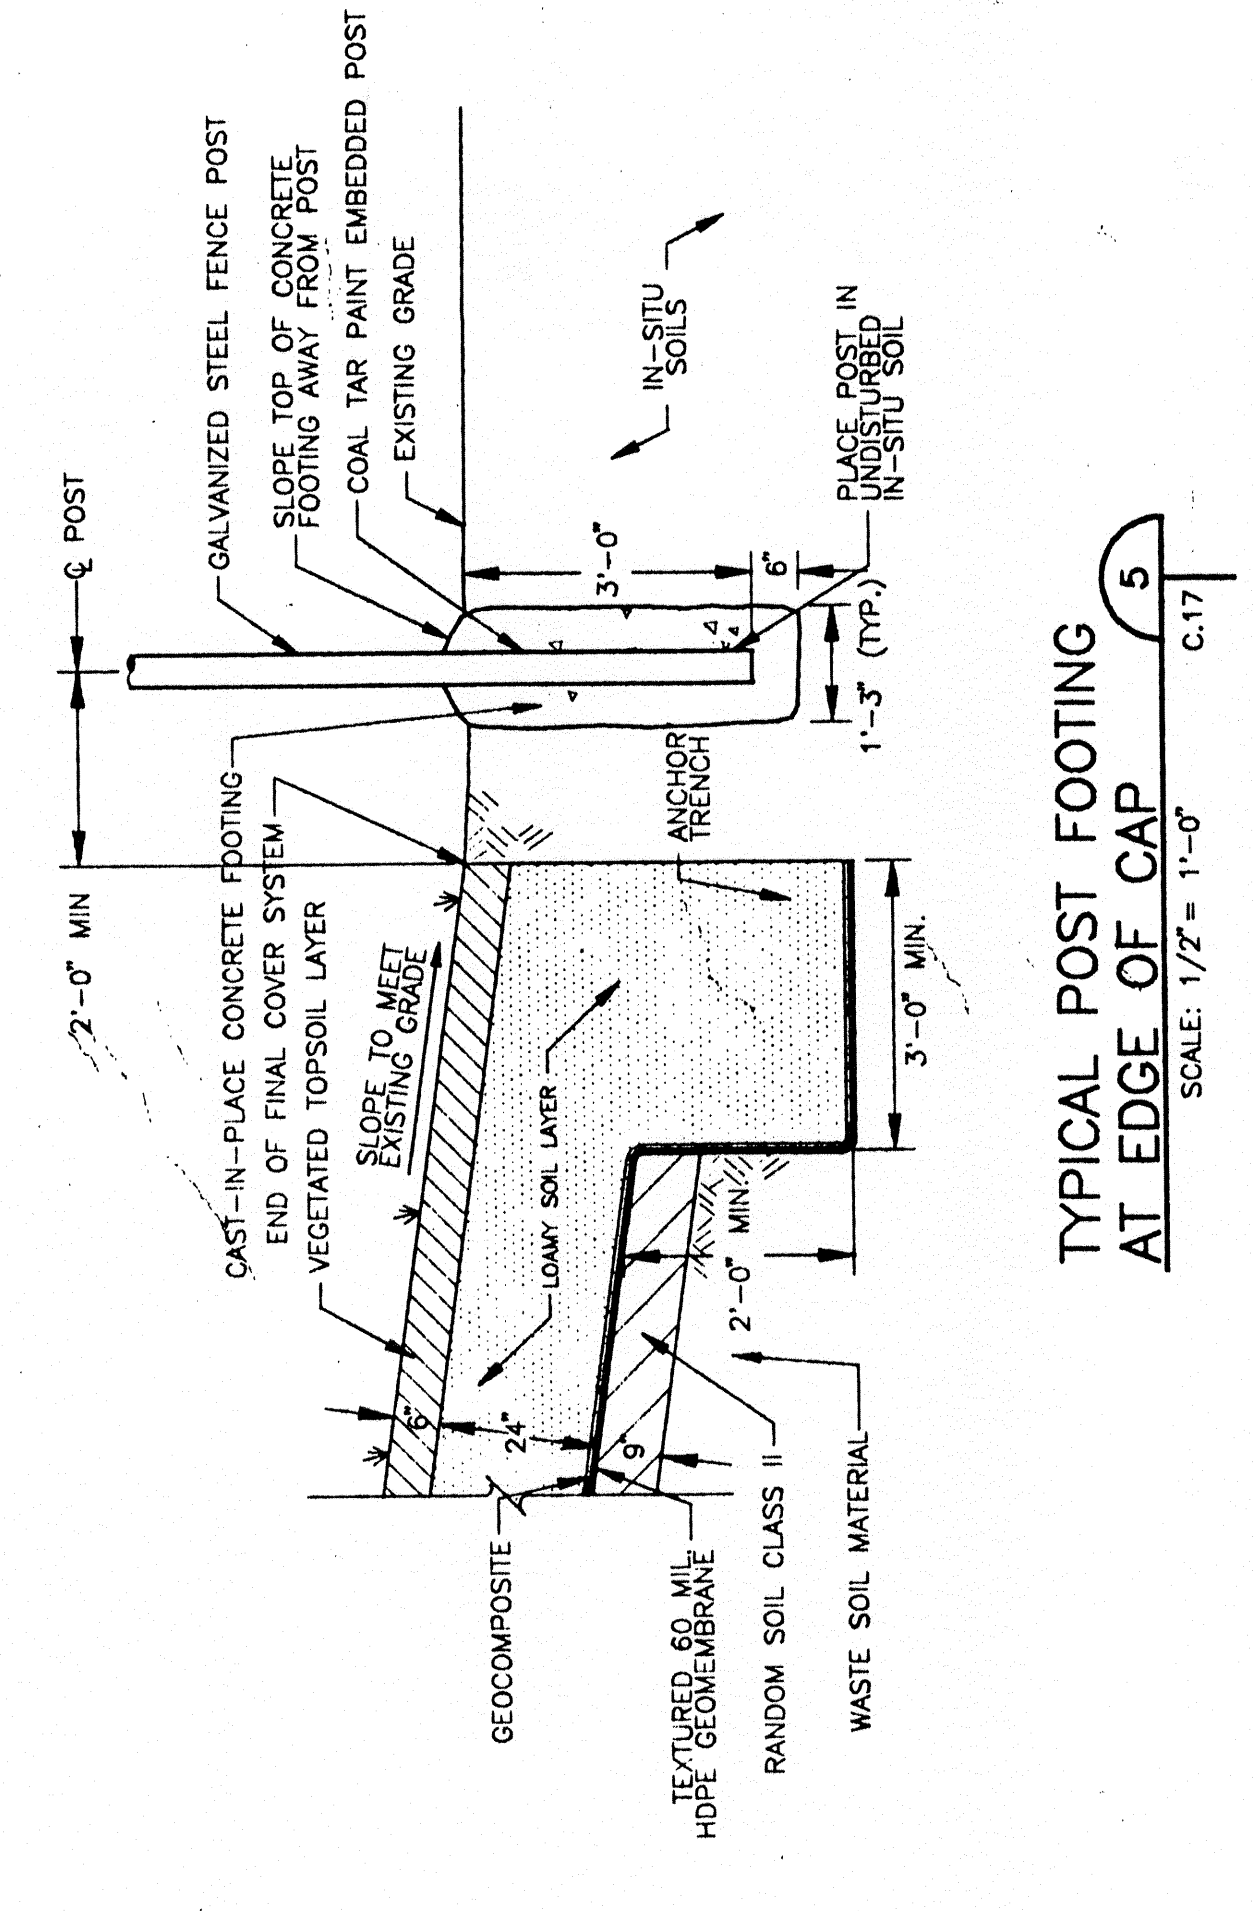
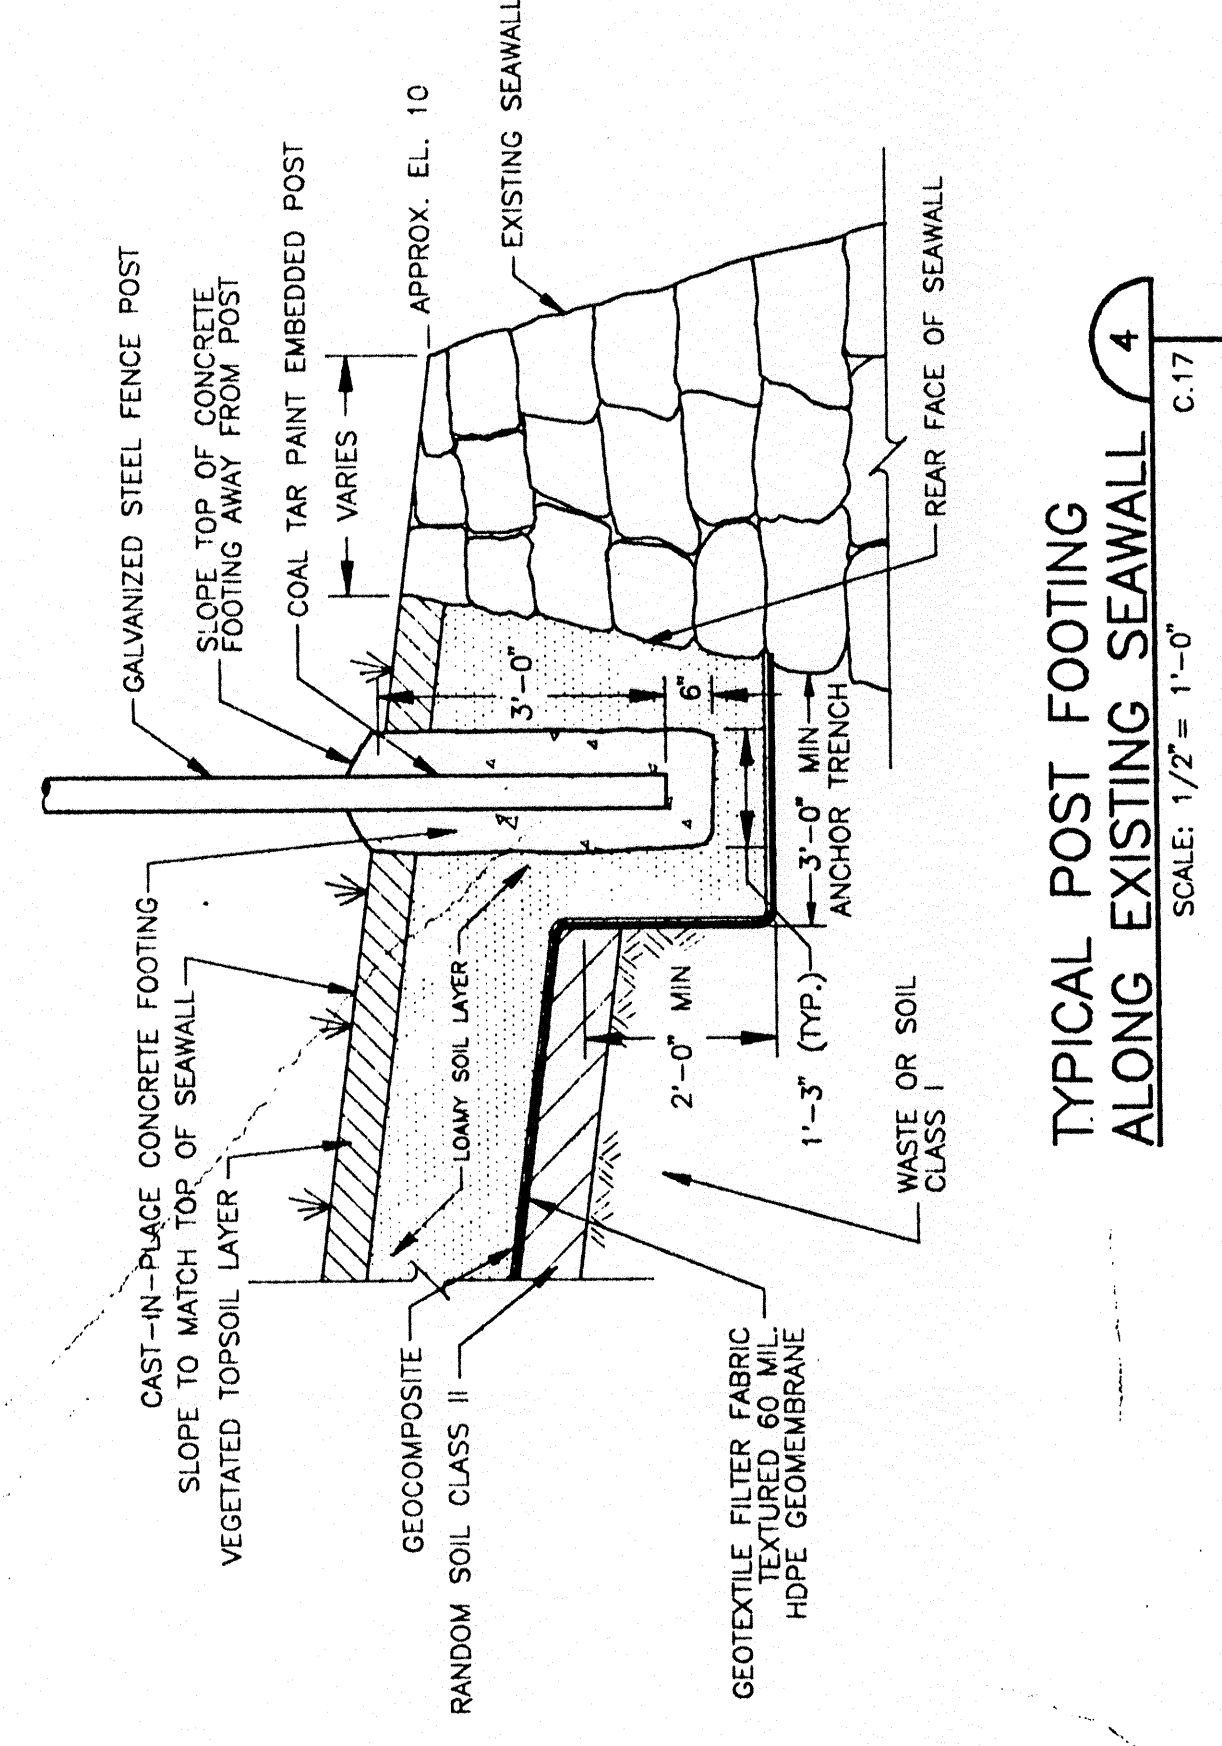
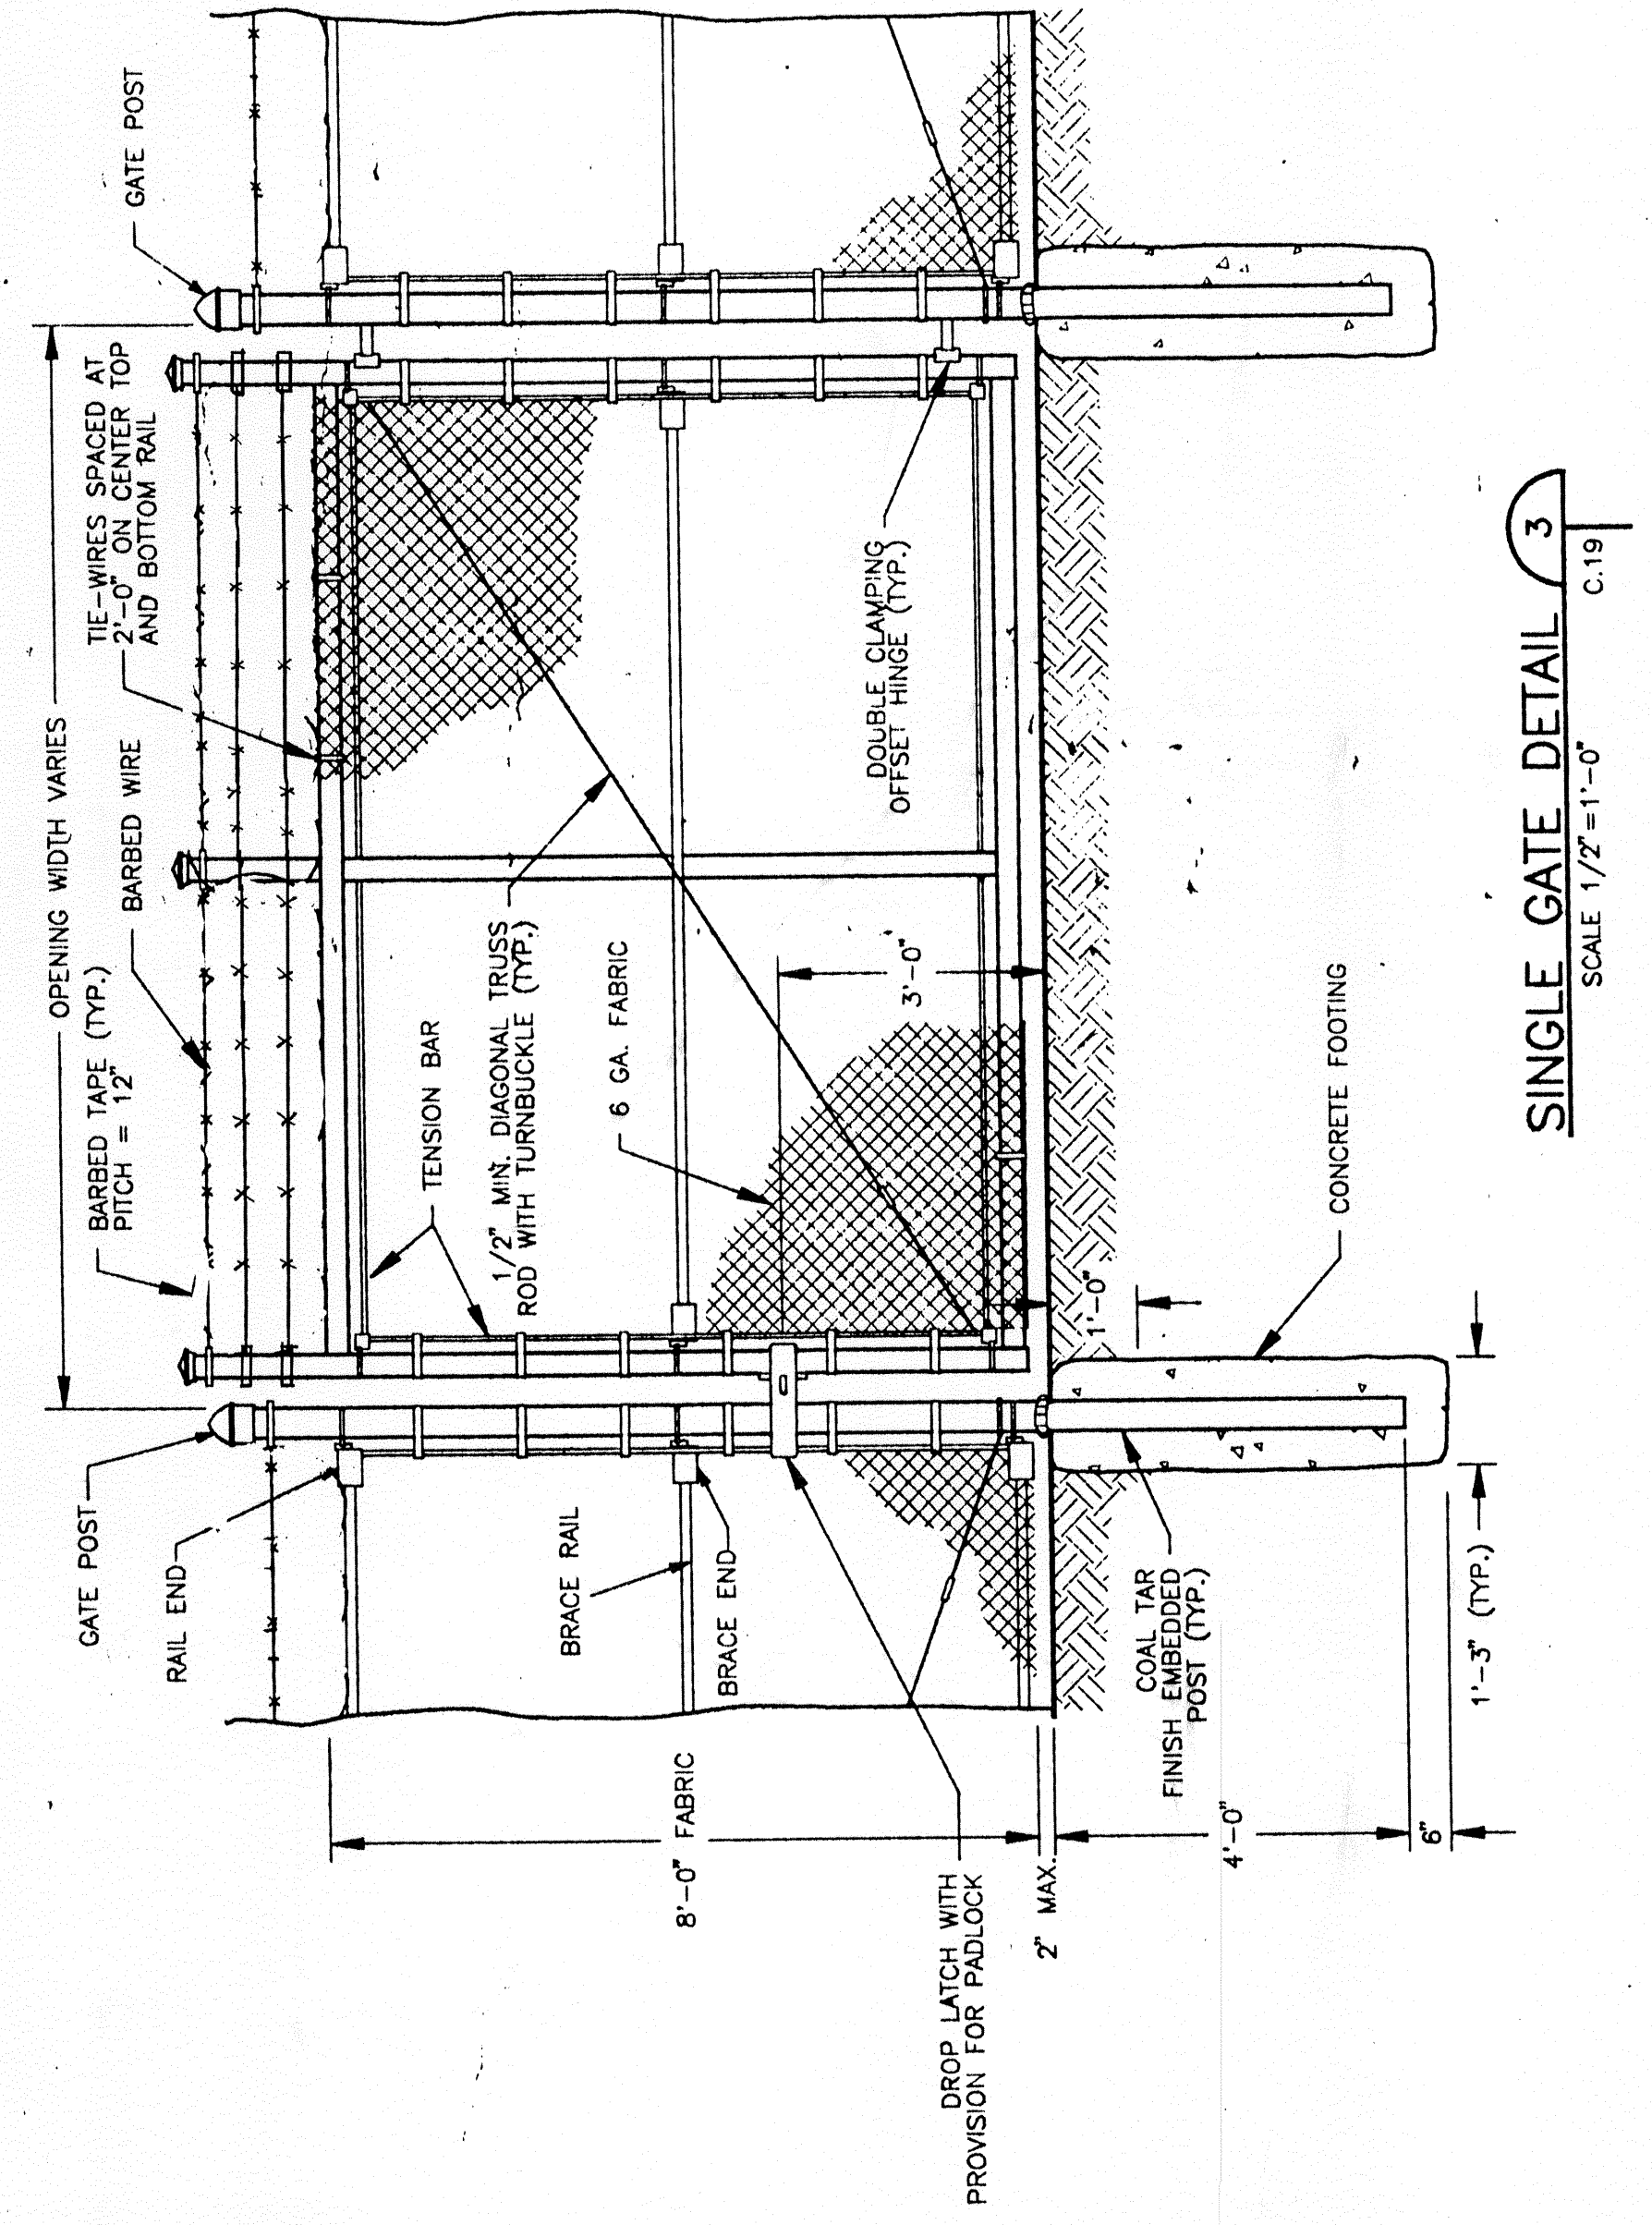
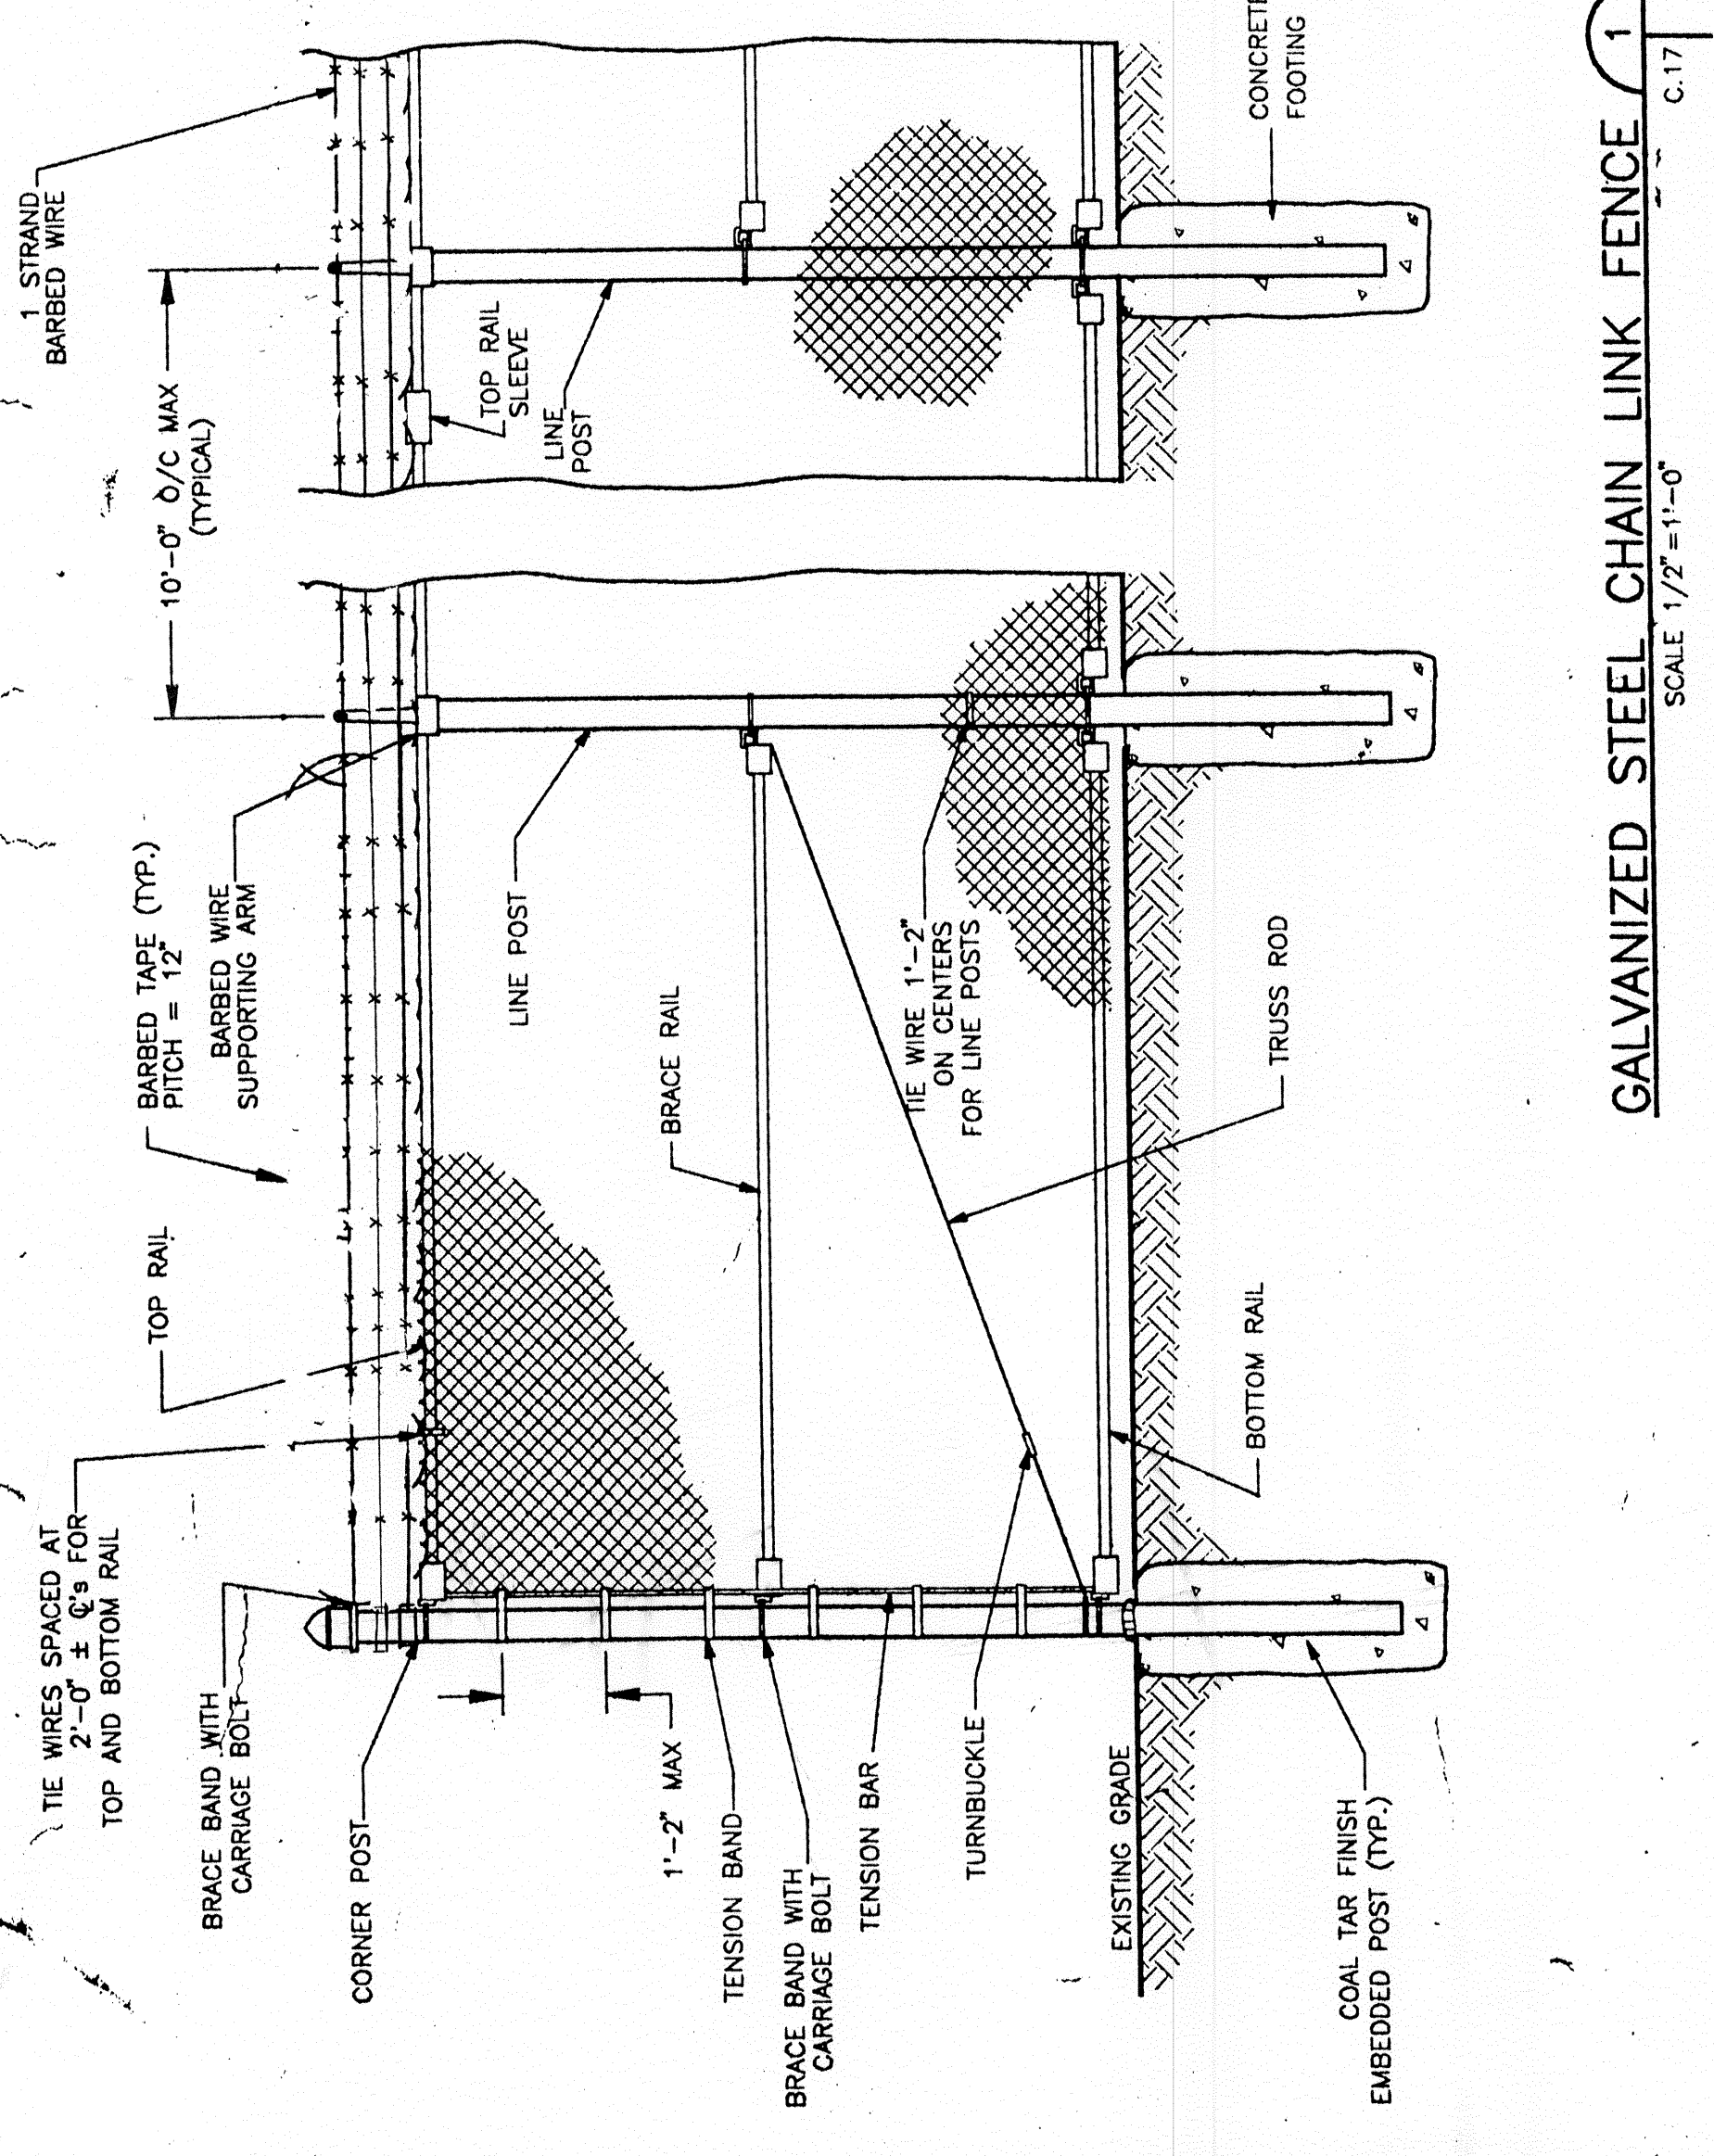
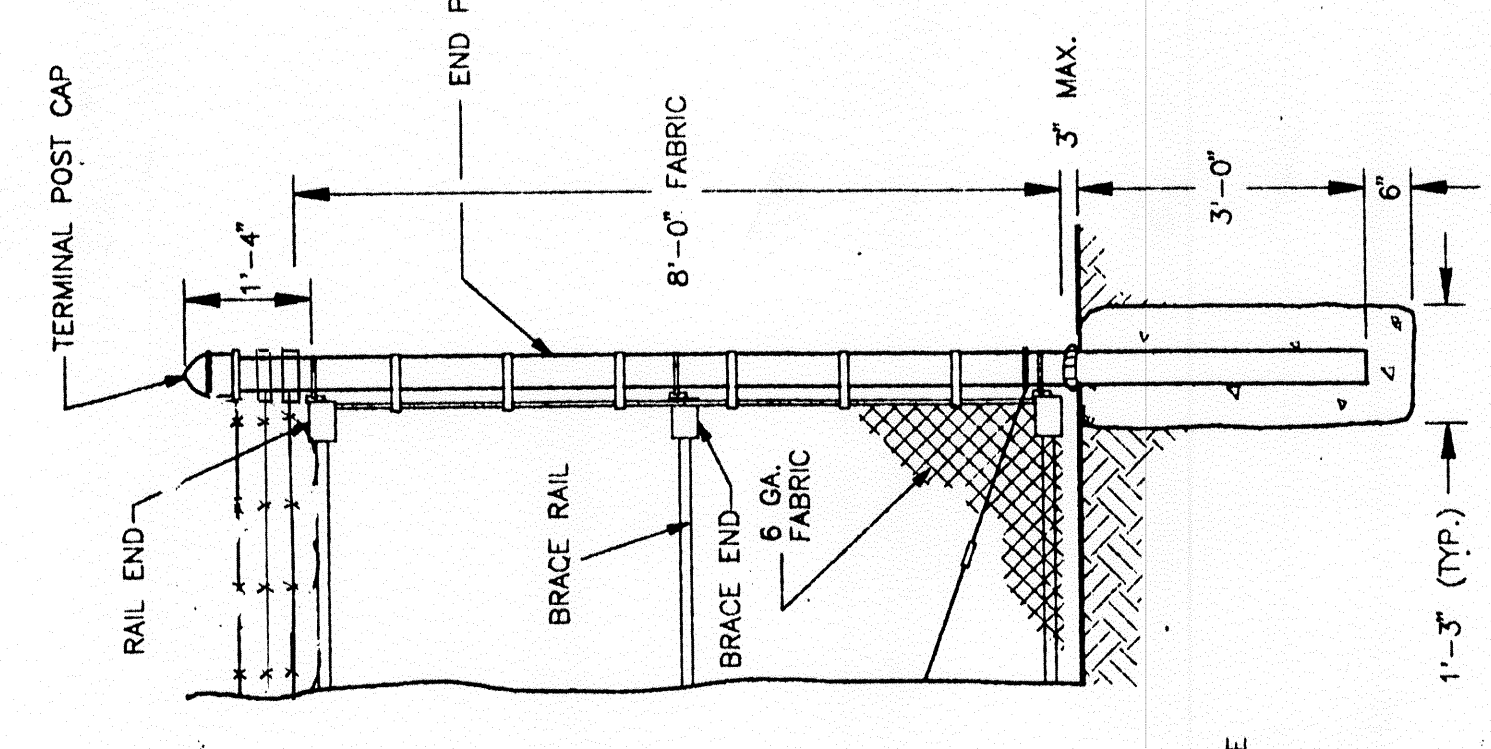
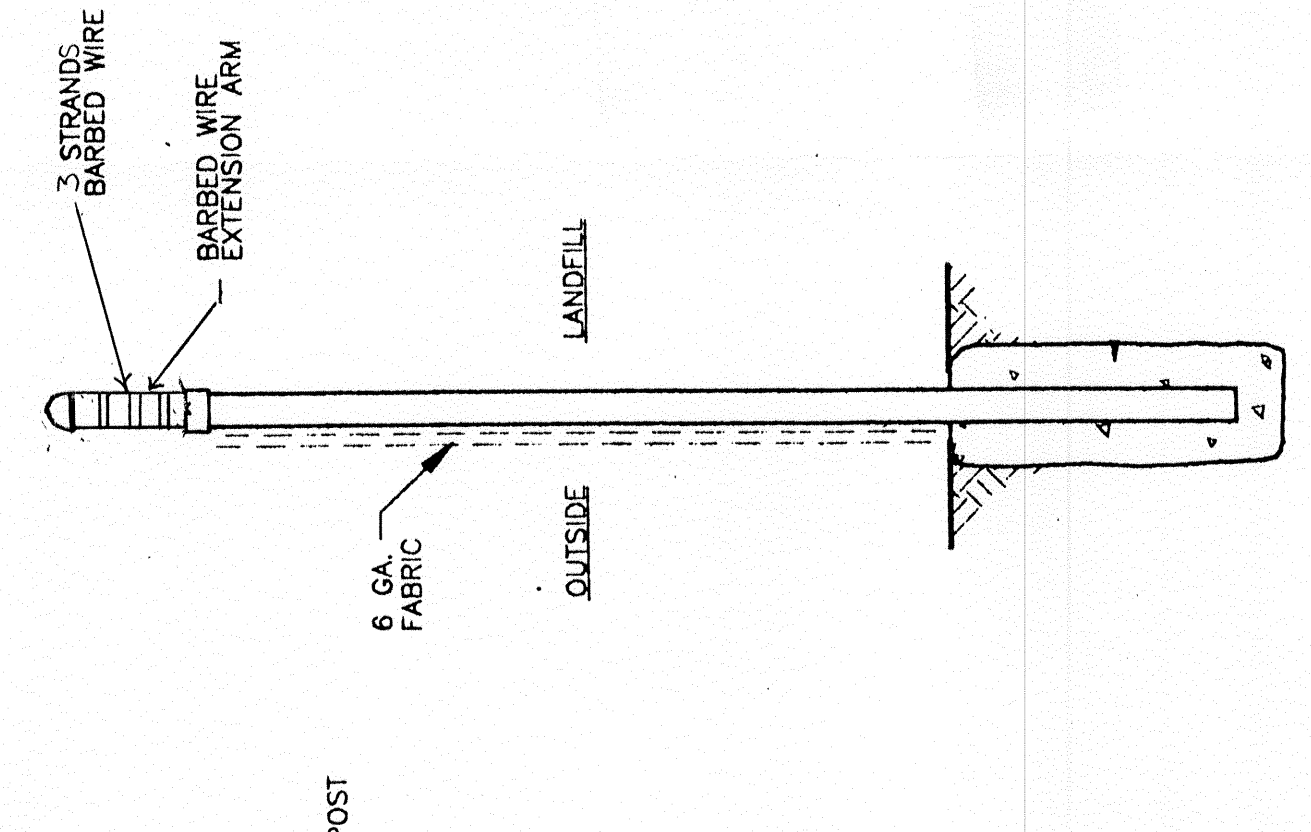


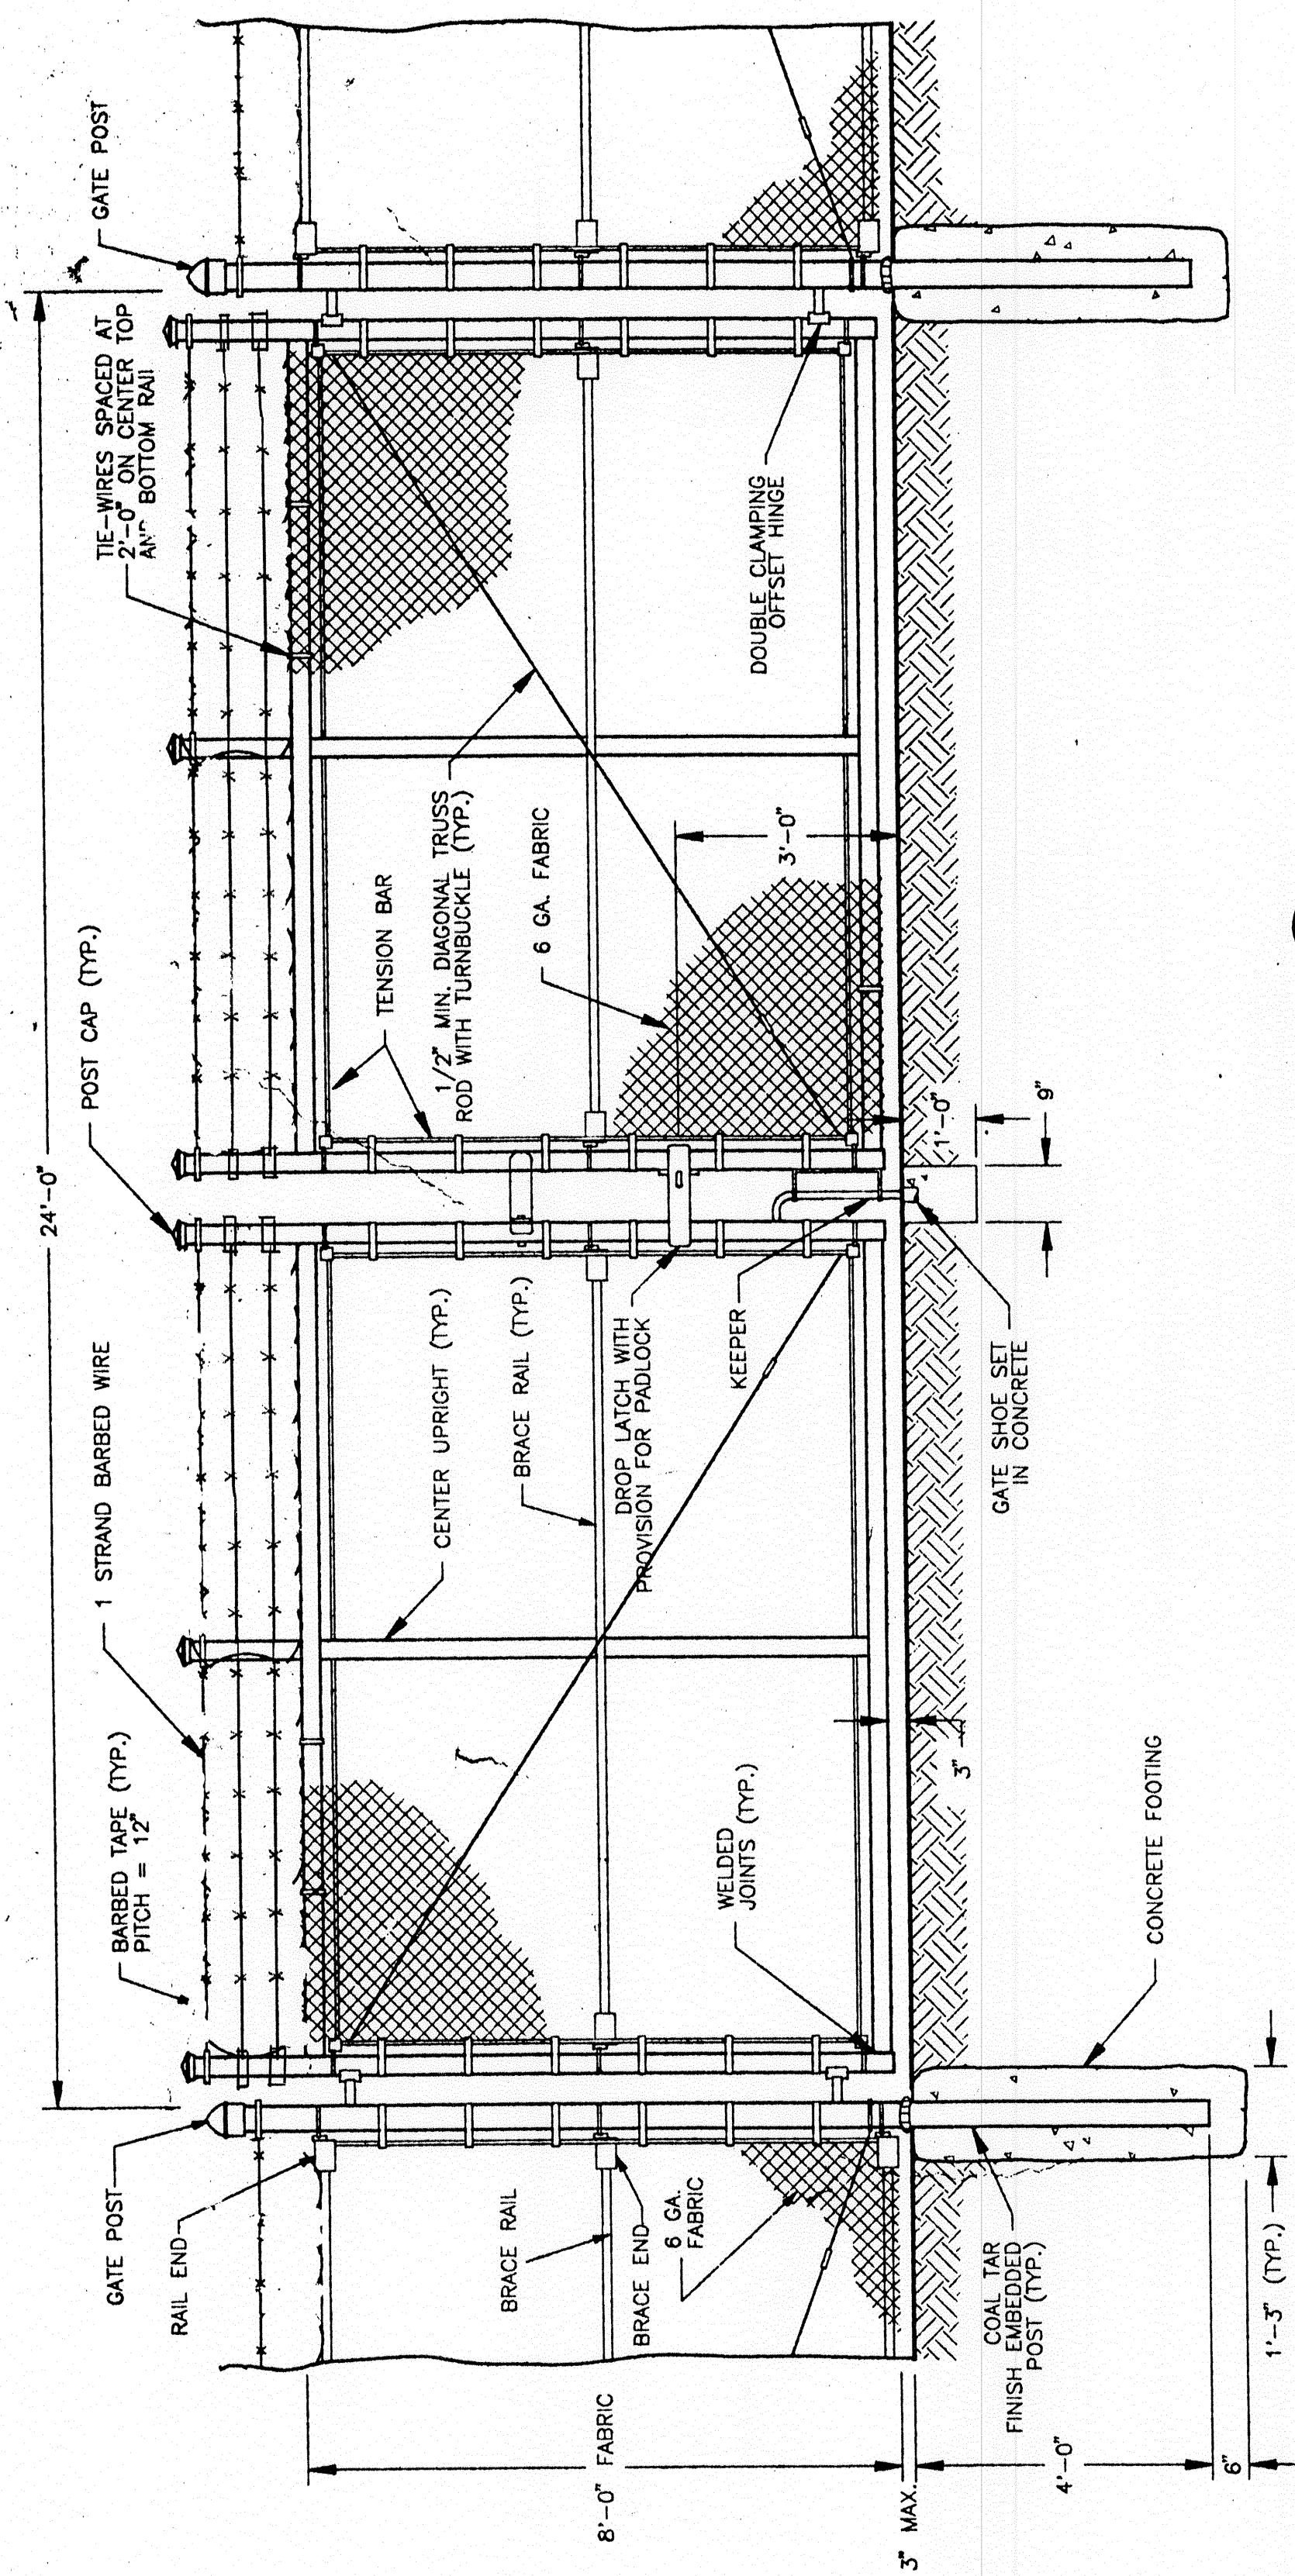

AS BUILT
DEPT FILE NO. 876HP-AB-C.18

THE CITY OF NEW YORK
DEPARTMENT OF
ENVIRONMENTAL
PROTECTION
BUREAU OF ENVIRONMENTAL ENGINEERING

DRAWING TITLE: FENCE

DESIGNED BY:	MITZ
DRAWN BY:	MVB
CHECKED BY:	MITZ
GROUP LEADER:	AJC

BRECO ENVIRONMENTAL CONTRACTORS, INC.
201 SAW MILL RIVER ROAD
YONKERS, NEW YORK 10701