

Certification Report

Remedial System Installation
AOC #5 Soil and
AOC #16 Groundwater and Soil

Farrell Road Site
Town of Geddes
Onondaga County, New York

Prepared for:

Martin Marietta Corporation
Syracuse, New York

April 1995

QUALITY

INTEGRITY

CREATIVITY

RESPONSIVENESS

RUST ENVIRONMENT &
INFRASTRUCTURE



TABLE OF CONTENTS

| Chapter | Page |
|--|------|
| 1.0 INTRODUCTION | 1 |
| 1.1 PROJECT BACKGROUND AND HISTORY | 1 |
| 1.2 SCOPE OF WORK | 1 |
| 2.0 IRM ACTIVITIES | 3 |
| 2.1 BASIS FOR DESIGN | 3 |
| 2.2 CONSTRUCTION ACTIVITIES | 3 |
| 2.2.1 General | 3 |
| 2.2.2 Site Preparation | 4 |
| 2.2.3 Well Drilling and Installation | 4 |
| 2.2.4 Soil Handling and Disposal | 5 |
| 2.2.5 Equipment Installation | 6 |
| 2.2.6 Project Photographs | 7 |
| 3.0 DESIGN MODIFICATIONS | 8 |
| 4.0 CERTIFICATION STATEMENT. | 9 |

LIST OF FIGURES

Figures

- 1-1 Site Location Map
- 1-2 Site Map

APPENDICES

Appendix

- A Record Drawings
- B Project Photographs

1.0 INTRODUCTION

This report summarizes remedial construction activities that were conducted at the Farrell Road Plant (FRP) from October - December 1994. The construction involved installation of a soil vapor extraction (SVE) system in a former solvent storage tank area (AOC #5) and installation of a SVE and groundwater recovery and treatment system at a former maintenance garage (AOC #16). Record drawings which show the completed installation are included in Appendix A. Project photographs are included as Appendix B.

1.1 PROJECT BACKGROUND AND HISTORY

The Farrell Road Plant (Site) is located on Farrell Road in the Town of Geddes, Onondaga County, New York (Figure 1). The Site consists of approximately 156 acres of which approximately 81 acres have been classified as a Class One wetland by the New York State Department of Environmental Conservation (NYSDEC). The property was developed in the early 1960s by General Electric Aerospace (GEA) as a manufacturing center, and was used as a design, manufacturing and assembly center for radar and sonar equipment. By December, 1992, GEA had moved all operations from the Site to other locations. Ownership was transferred to Martin Marietta Corporation (MMC) in April, 1993. In December, 1993, ownership was transferred to Syroco, Inc., which is an unrelated corporation who currently uses the buildings for storage and transfer of lawn furniture products manufactured at a local plant.

The 156 acre site includes four buildings: Building 1, Building 2, the Test Building, and the Maintenance Garage. The location of these buildings is shown on Figure 2. The four buildings are enclosed by a perimeter fence which is bordered by large paved parking areas on the east and west. The Site was listed by NYSDEC on the Registry of Inactive Hazardous Waste Disposal Sites (Site No. 734055). MMC entered into an Order on Consent ("Order") with NYSDEC (Index #A7-0308-93-10), dated 21 March, 1994, to conduct Interim Remedial Measures (IRMs) at the site.

Based on a Phase I Site Assessment Report prepared by ERM-Northeast, Inc. (ERM), sixteen areas of concern (AOC) were identified as needing further investigation. This Summary Report addresses construction activities for two IRMs which were conducted at AOC #5 and AOC #16. AOC #5 consists of the area associated with a former underground solvent storage tank area on the west side of Building No. 2. AOC #16 consists of the area associated with a former gasoline underground storage tank (T-68) near the former Maintenance Garage.

1.2 SCOPE OF WORK

An IRM Workplan was prepared in April and May 1994 by ERM for AOC #5 and AOC #16. Each Workplan provided a description of the following IRM activities:

- AOC site preparation,
- identification of the selected treatment technology,
- construction documents and design considerations,

- excavation activities,
- waste handling procedures (characterization, storage, transport and disposal),
- field implementation components,
- AOC specific sampling and monitoring program, and
- AOC site restoration.

A pilot test was performed by ERM in July, 1993 to determine the feasibility of employing the SVE technology in AOC #5 as well as to produce an approximate model of the effective radius of influence to determine the appropriate spacings for the proposed SVE wells. The results of the pilot test were summarized in the AOC #5 Workplan and were used for the design and location of the soil vapor extraction wells at AOC #5.

The Workplans also provided a design of the SVE system at AOC #5 and the SVE and groundwater recovery and treatment system at AOC #16. The design information included construction details such as record drawings, equipment lists, and pipe and equipment layout schematics. The basis for construction was provided on the drawings and equipment lists provided in the ERM Workplans for both areas.

2.0 IRM ACTIVITIES

2.1 BASIS FOR DESIGN

As detailed above, the design used for construction of the SVE system for AOC #5 and the SVE and groundwater recovery and treatment system for AOC #16 was developed by ERM and detailed in the IRM Workplans.

The contract document used for bidding the construction phase activities consisted of contract drawings, equipment lists, and pipe and equipment arrangement schematics produced by ERM in the AOC #5 and AOC #16 Workplans.

An addendum to the original bid document was prepared by ERM on August 26, 1994. The purpose of this addendum was to detail several items not included in the original document or items determined to be erroneous.

2.2 CONSTRUCTION ACTIVITIES

2.2.1 General

The construction contractor responsible for installation of the IRMs for AOC #5 and AOC #16 was R.E. Wright Associates (REW) of Middletown, Pennsylvania. REW performed construction activities including general labor, trench excavation, concrete saw-cutting, piping installation, forming and concrete work, and general equipment arrangement. Subcontractors used by REW included:

- Parratt Wolff, Inc. - drilling, well installation and development,
- Myriad Construction - electrical installation,
- Environmental Restoration Services (ERS) - equipment manufacture and installation,
- Rich and Gardner - treatment building installation, and
- Atlas Fence - fence installation.

RUST Environment & Infrastructure of New York (RUST) was responsible for performing engineering oversight during construction activities. RUST's responsibilities during construction included review of the contractor's installation to assure compliance with the design, review design modifications proposed by REW, maintain documentation of day to day activities, and report to MMC any discrepancies noted in application of health and safety or other standard working protocols. During construction, RUST maintained red-line copies of the construction drawings, coordinated project meetings, prepared daily and weekly reports and project meeting minutes, and documented all changes to the original design.

2.2.2 Site Preparation

REW and RUST mobilized equipment and personnel to the Site on October 3, 1994. A field office was set-up for RUST and REW within an abandoned guard building adjacent to Building 2. During the week of October 3, 1994, all site personnel attended MMC contractor health and safety training. All new personnel arriving on-site were required to show their updated MMC health and safety card, proof of OSHA 40 hour training and eight hour refresher, and sign in at the field office.

Prior to the start of work, REW personnel obtained the necessary building permits from the Town of Geddes. REW and RUST personnel marked out locations of the air injection, vapor recovery, monitoring and recovery wells at AOC #5 and AOC #16. ERM design drawings were used to scale off the locations. Where discrepancies were encountered or locations were altered based on physical restrictions within buildings, changes were verified with ERM design engineers and were noted on the red-line drawings.

Prior to initiating drilling or subsurface activities, a general meeting was held with Syroco representatives to review the construction schedule and activities to be performed within Building 2 and the garage. Priority was given to AOC #5 in order to minimize the time and storage space lost within the warehouse.

2.2.3 Well Drilling and Installation

Well drilling, installation, and development was performed by Parratt Wolff of Syracuse, New York. Other activities completed by Parratt Wolff included installation of protective well boxes and converting the AOC #5 pilot test (stick-up) well into a flush mount well adjacent to Building 2.

Prior to initiating any drilling or saw-cutting activities within Building 2, Parratt Wolff installed two exhaust venting holes through the wall of Building 2 to allow all gas-powered equipment to vent to the outside. REW personnel installed a third vent hole within Building 2 using a 4-inch diamond blade core saw. REW personnel cored through the concrete floor at well locations using a 6-inch diamond blade concrete corer. Well locations at AOC #5 and AOC #16 were varied slightly, typically less than 3 feet from design, to accommodate for the mast on the drill rig or to avoid active subgrade piping. Any well location changes were noted on the drawings.

During the initial boring and well drilling activities, ERM design hydrogeologists requested that the following well design change be implemented at the well locations where red till was encountered shallower than designed. The design change required that where red till was encountered shallower than 15 feet below grade, the well should be drilled 1 foot into the red till. The well would then be backfilled with 6-inches of bentonite and then 6-inches of sand, and would be completed as designed, reducing the length of PVC screen as necessary. The area in which the shallowest red till was encountered was in AOC #5, however, it was not necessary to install any wells with this new design criteria since the shallowest the red fill was encountered was approximately 13.5 to 14 feet below grade. These wells were completed as designed. According to Parratt Wolff, it was difficult to identify the exact depth of the red till because of the auger method used to advance the borings.

As discussed above, red till was encountered only at AOC #5 within wells VRW-206, 207, 208, 210, 211 and 212 and AIW-204, 206, 207, 208, 209 and 210. No red till was encountered to a depth of 15 feet within any wells at AOC #16. Groundwater in AOC #5 varied from approximately 10 feet below grade (VRW-211) to approximately 14 feet below grade (VRW-202). Groundwater in AOC #16 varied from approximately 6.5 feet below grade (RW-1) to approximately 12.5 feet below grade (RW-2).

Soil cuttings generated during drilling were screened with a Photovac MicroTIP Model HL200 photoionization detector (PID). PID readings varied at AOC #5 between below equipment detection (air injection well AIW-210 and vapor recovery wells VRW-205, 208, 209 and 210) to greater than 2,500 parts per million (ppm). PID readings varied at AOC #16 between below equipment detection (passive air injection well PV-1 and recovery wells RW-1 and RW-2) and approximately 500 ppm (vapor extraction well VE-7).

2.2.4 Soil Handling and Disposal

The procedures for handling soil, debris and other waste generated during construction activities were detailed in ERM's IRM Workplans for AOC #5 and AOC #16. The waste handling section described the handling, storage, sampling and disposal procedures for waste generated during excavation and trenching, drilling activities, monitoring well development and personal protection equipment (PPE) worn by personnel.

Soil generated during drilling of the wells, trenching for vapor piping and excavation of the two treatment building footings and pads was segregated into piles approximately 2 cubic yards in volume. Each pile was screened with a PID. Soil which was below 5 ppm was stockpiled on polyethylene sheeting on-site and covered with the same. Stockpile volumes ranged from approximately 5 cubic yards to approximately 20 cubic yards. Soil piles were stored at three separate locations. Soil generated from AOC #5 was temporarily stored across from Building 2 on the grassy area adjacent to the fence. Soil generated from AOC #16 was stored west of the garage and also on the pavement northeast of the garage building.

Soil screened with a PID which was greater than 5 ppm was stored in 17H 55-gallon steel drums provided by MMC. Drums were labeled appropriately with the date and proper classification.

Construction debris generated from concrete and pavement saw-cutting during trenching activities within Building 2 and the garage were similarly screened with a PID. All debris was screened with a PID and was determined to contain less than 5 ppm of VOCs. The debris was stockpiled on polyethylene sheeting and temporarily stored on the pavement northeast of the garage, adjacent to the soil stockpiles.

Parratt Wolff generated three 55-gallon drums of water during development of recovery wells RW-1, RW-2 and RW-3 as well as monitoring well (MW-N). Each drum was labeled appropriately with the contents and date of generation. A total of 76 drums of soil with PID readings greater than 5 ppm were generated during construction activities. One drum containing PPE was also generated.

Laidlaw was responsible for all waste characterization and removal of waste from the site and proper disposal. Laidlaw personnel collected analytical composite samples from drummed soil as well as stockpiled soil for disposal characterization and profiling. On November 15, 1994, 80 drums of waste soil, water and PPE were manifested, loaded and transported off-site for disposal by Laidlaw.

On November 30, 1994, approximately 140 tons of stockpiled soil and approximately 89 tons of concrete and asphalt debris were loaded and transported by Laidlaw for disposal at the Seneca Meadows Landfill in Seneca Falls, New York. All material being transported off-site was properly labelled and manifested.

2.2.5 Equipment Installation

Prior to installation of the SVE, groundwater treatment and electrical equipment, the treatment buildings were assembled on the concrete pads at both areas. Between November 28 and December 2, 1994, Rich and Gardner assembled the 12 foot by 12 foot by 8 foot high Butler brand metal treatment building at AOC #5. Upon completion of the frame assembly, ERS attached plywood to the south exterior wall to support the electrical distribution control panels, circuit boxes, autodialer, transformer and associated raceways. Myriad personnel ran wiring from Building 2 to the AOC #5 treatment building and installed control panels between December 8 and 17, 1994. ERS personnel installed the SVE equipment at AOC #5 between December 5 and 12, 1994. REW personnel installed the piping from the vapor extraction laterals through the treatment building and into the SVE equipment at AOC #5 during this week. Vacuum and pressure gauges, a differential pressure gauge control rack and sample ports were installed by REW personnel.

Between December 3 and 9, 1994, Rich and Gardner assembled the 15 foot by 15 foot by 8 foot high Butler brand metal treatment building on the concrete pad at AOC #16. Similar to AOC #5, plywood was attached to the east exterior wall of the treatment building to support the electrical distribution control panels. ERS and Myriad personnel installed the groundwater treatment and SVE control panels, circuit boxes, autodialer, transformer and associated raceways. On December 5 and 7, 1994, Myriad connected power from the electrical panel box located on the northwest garage wall and extended the conduit to the southwest corner where it exited the garage below grade to the treatment building. ERS wired the SVE and groundwater system equipment including all shut-off sensors and float controls into the appropriate control panels. REW ran the groundwater and SVE piping into the treatment building and connected to appropriate treatment equipment. REW similarly installed the chemical feed pump equipment and 55-gallon drum of approved sequestering agent for feeding into the groundwater treatment system. Vacuum and pressure gauges, sample ports and other associated appurtenances were also connected into the AOC #16 treatment system equipment.

An aluminum air discharge stack, approximately 35 feet in height was erected on the pavement, approximately 12 feet north of the AOC #16 treatment building. The 6-inch diameter PVC piping which exists from the air stripper tray through the roof of the treatment building was not connected to the emission stack, however, the stack does have a 6-inch diameter connection approximately 9 feet above grade for the stripper air exhaust piping. The 4-inch diameter SVE air discharge piping exits the AOC #16 treatment building and was capped approximately 6-inches out from the north exterior wall. The stack similarly contains a 4-inch diameter connection approximately 2-feet above grade for the future connection to the SVE system off-gas.

On December 29 and 30, 1994, ERS and REW personnel performed a system check of the SVE motors at AOC #5 and AOC #16. The dilution air valves were opened completely so that only atmospheric air would be drawn through the equipment. AOC #5 functioned normally and only required minor wiring adjustments. AOC #16 equipment required more involved rewiring which was performed on December 30, 1994.

2.2.6 Project Photographs

RUST personnel took photographs to document the construction activities. Appendix B includes photographs showing key activities throughout the project and the completed construction.

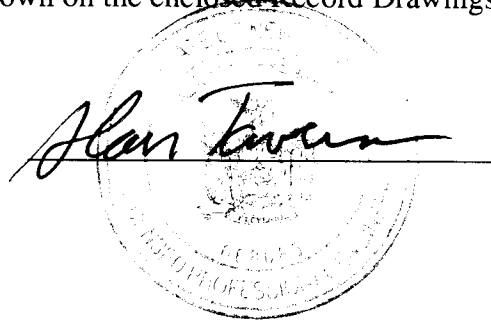
3.0 DESIGN MODIFICATIONS

The engineering design which was the basis for the construction and system installation for this project was prepared by ERM. Throughout the project, REW and RUST reviewed specific design criteria to determine any problems relating to the installation and future performance as well as alternative ways to improve the design. The procedure followed for implementing any change to the ERM design was to contact MMC personnel and the appropriate ERM design engineers/hydrogeologists. Once the proposed improvement was agreed upon, the NYSDEC representatives were contacted for verbal approval.


RUST continually up-dated the ERM design drawings throughout the construction activities, noting changes in specific design schematics.

4.0 CERTIFICATION STATEMENT

I hereby certify, as a Professional Engineer licensed in the State of New York, that RUST E&I of New York monitored the construction of IRMs in AOC #5 and AOC #16 of the Farrell Road Plant Site as described in the above report and that the work was conducted in general accordance with the NYSDEC approved plans and specifications and as shown on the enclosed Record Drawings.



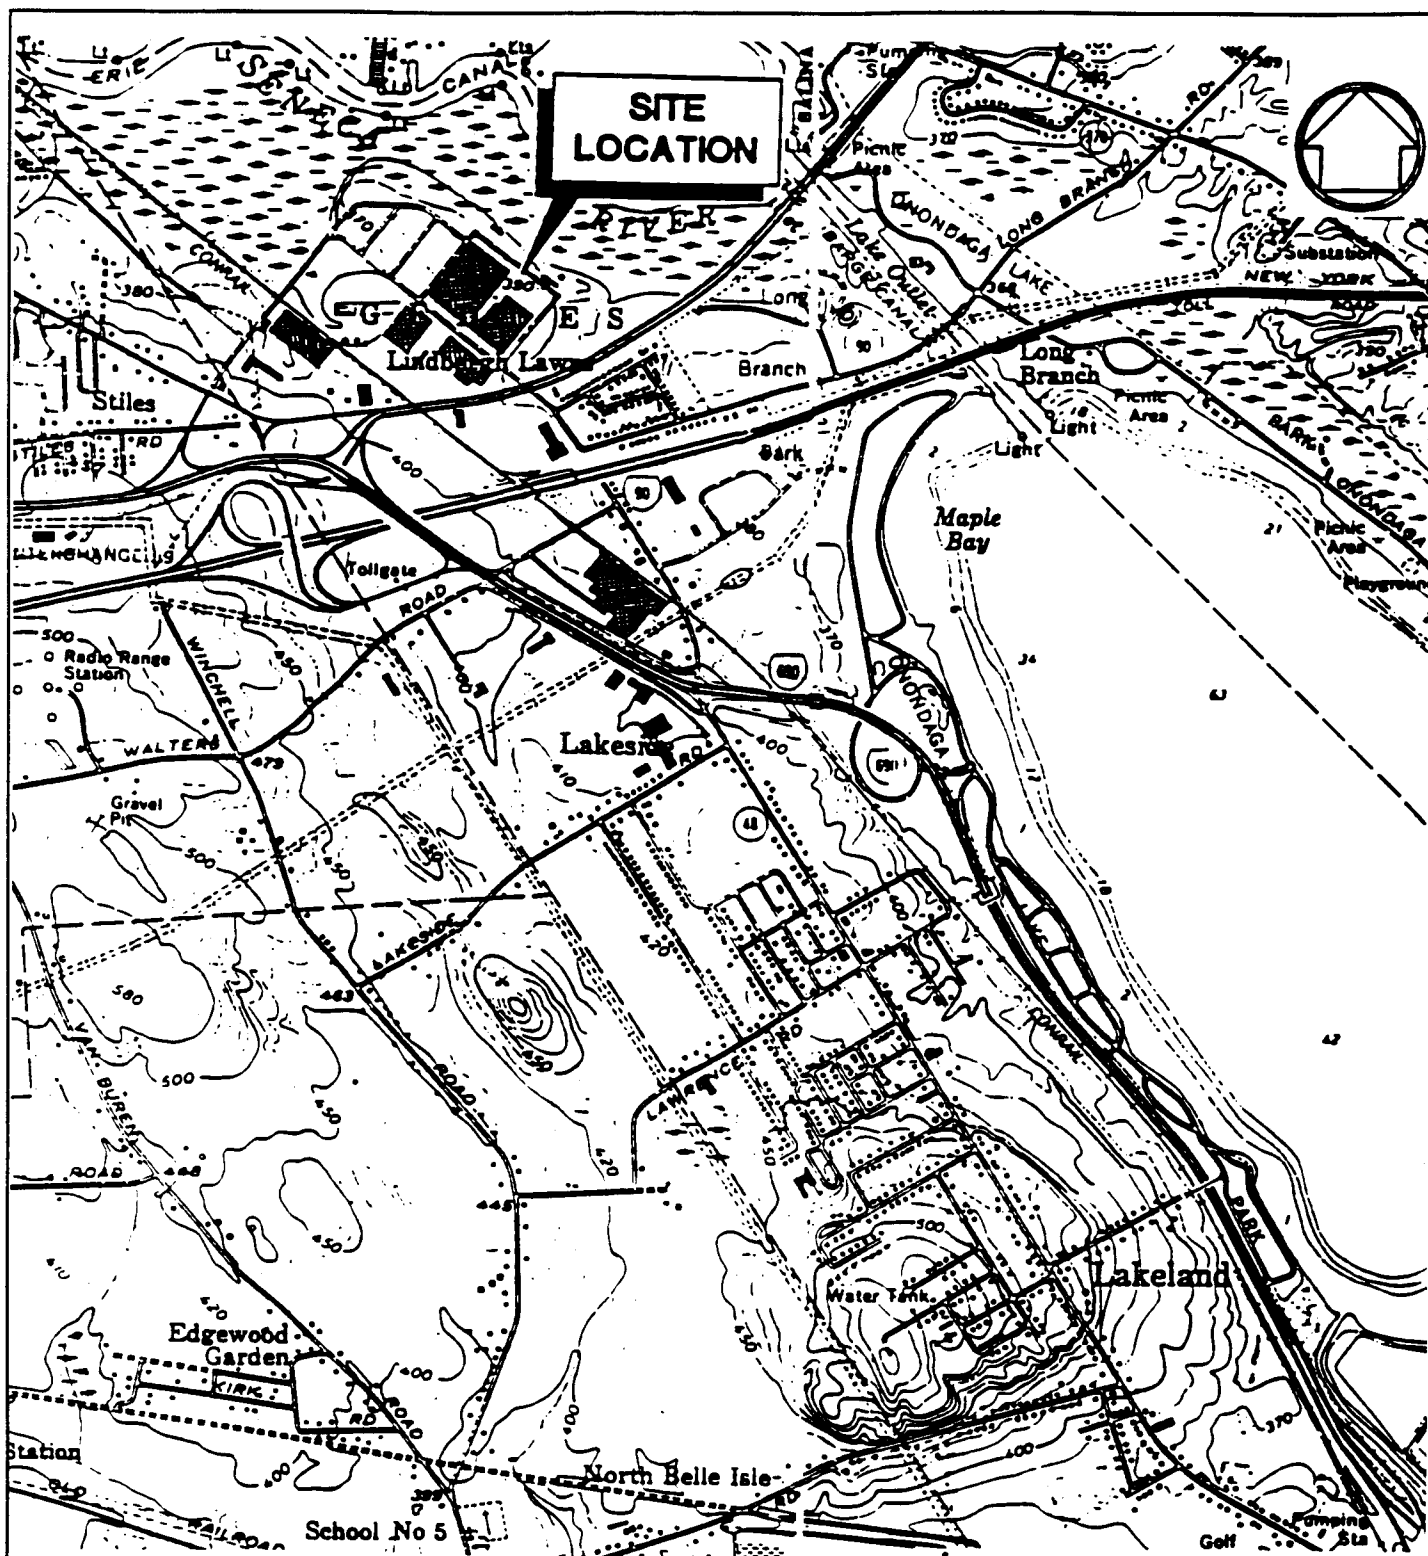A handwritten signature, "Alan T. Brown", is written in black ink over a circular professional seal. The seal is partially obscured by the signature and contains text that is difficult to read but appears to include "NEW YORK" and "PROFESSIONAL ENGINEER".



SOURCE: USGS 7.5 MINUTE QUADRANGLES CAMILLUS
AND SYRACUSE WEST, NY

RUST ENVIRONMENT &
INFRASTRUCTURE

SITE LOCATION MAP

MARTIN MARIETTA CORP.
FARRELL ROAD PLANT

TOWN OF GEDDES

NEW YORK


PROJECT NO. 38564.110

DATE 1/95

DWG. NO. 38564-00

SCALE 1"=2,000'

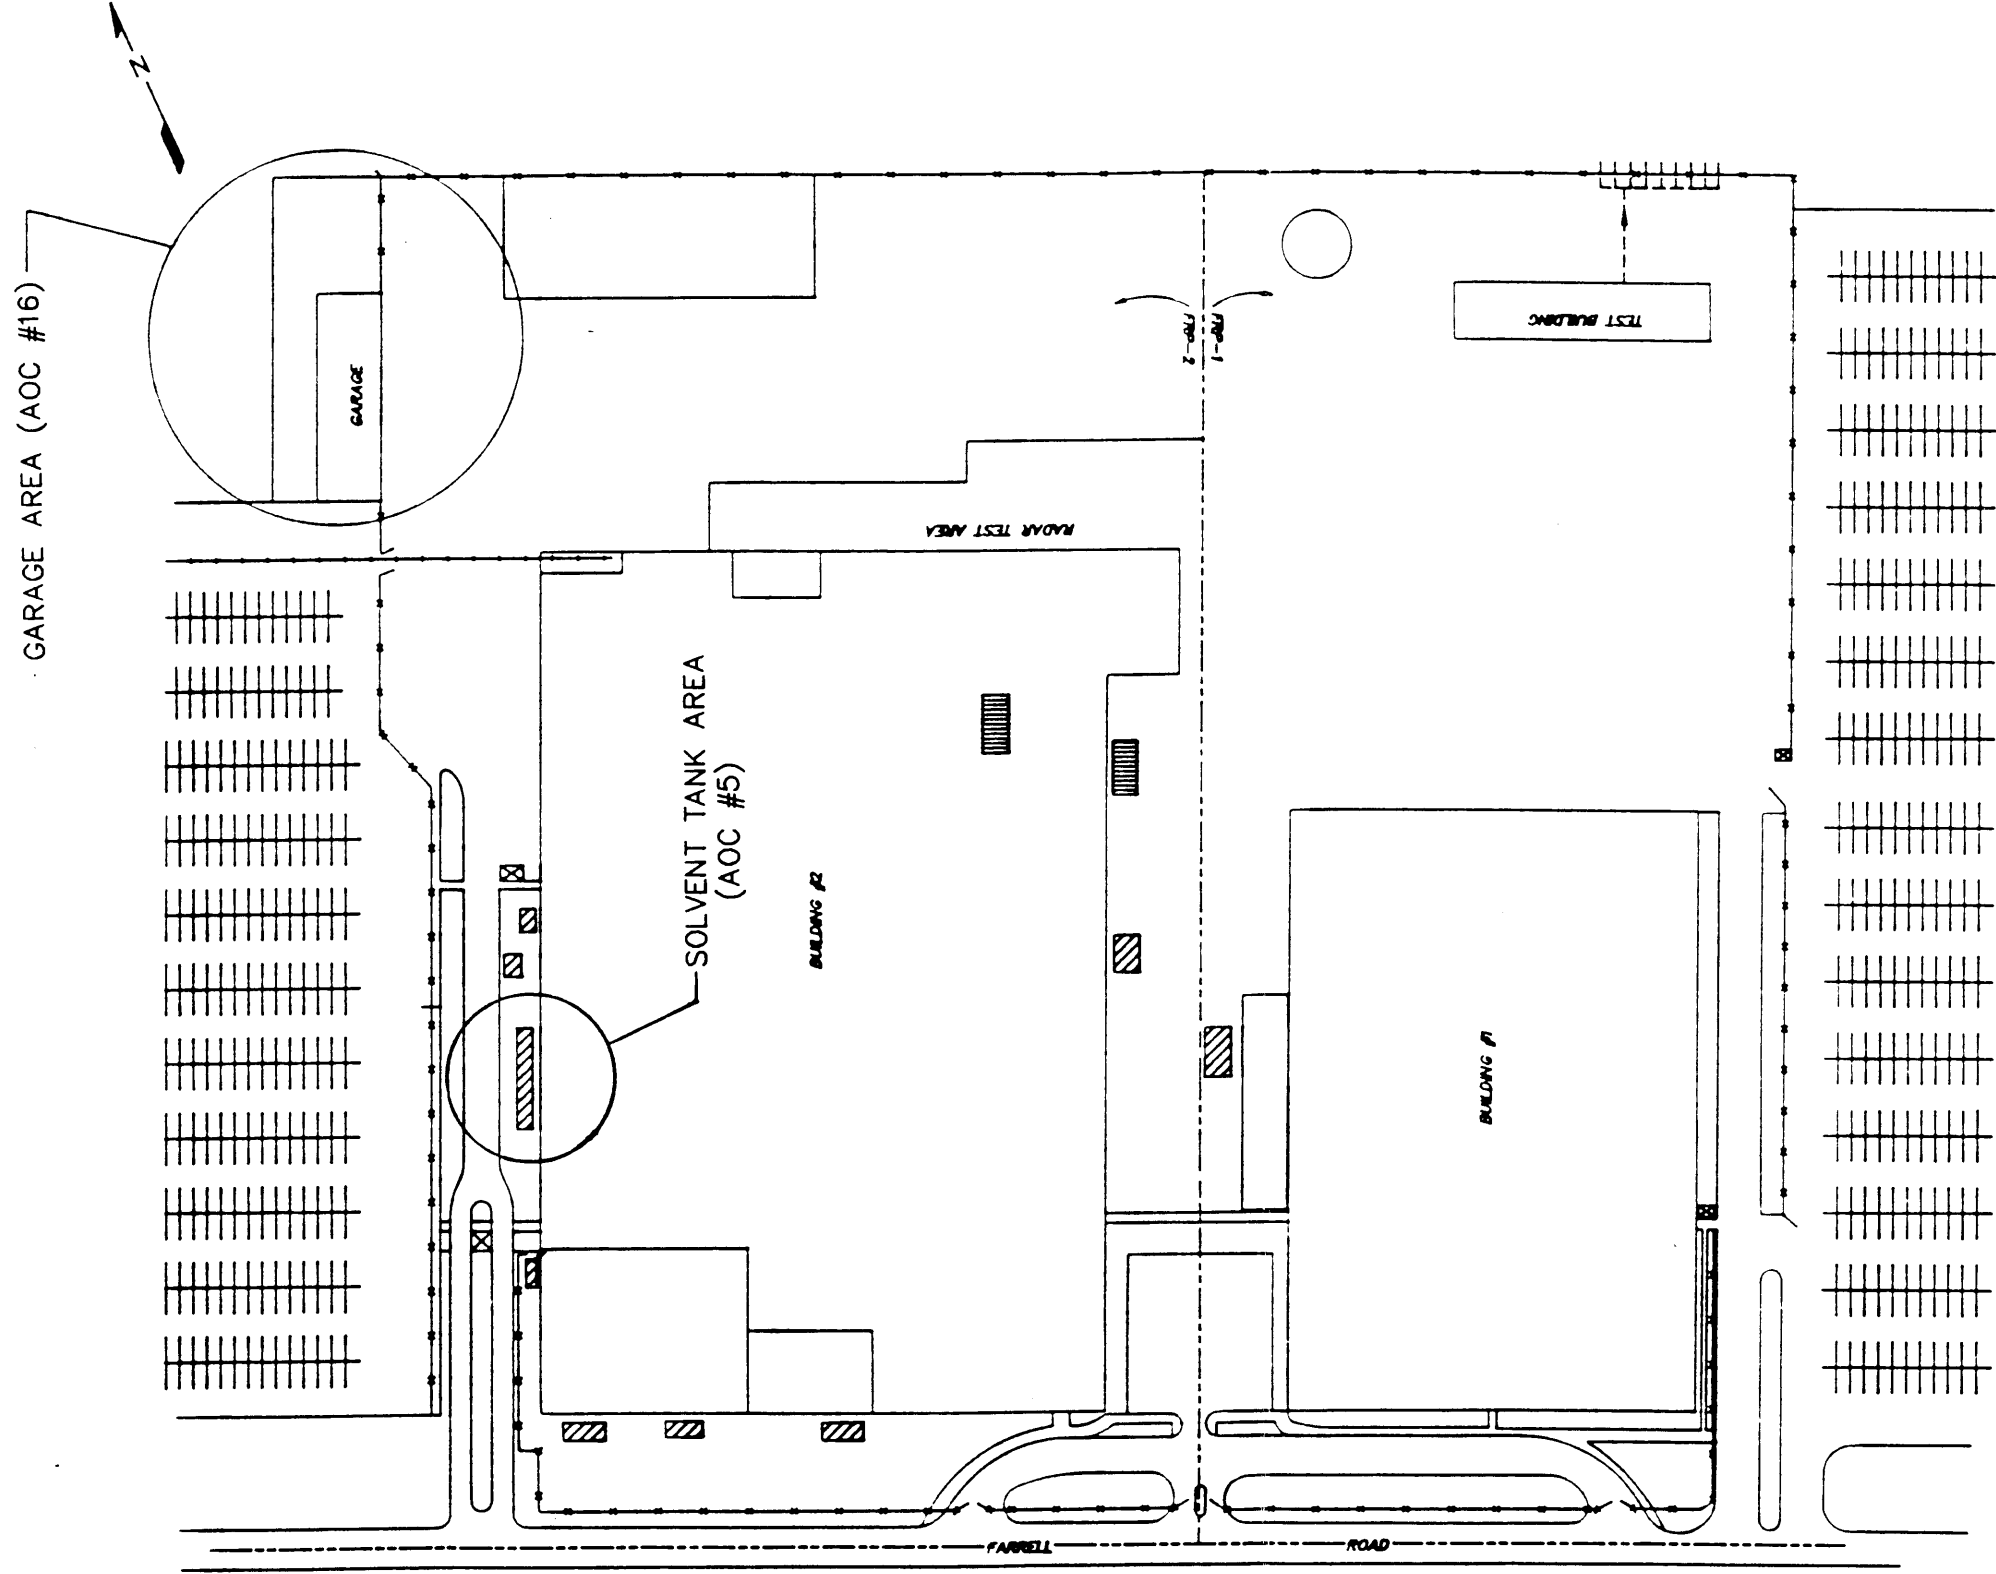FIGURE NO. 1




| | | | |
|--|--|---|--|
| RUST ENVIRONMENT & INFRASTRUCTURE | | SITE MAP | |
| PROJECT No. 38564.110 | | MARTIN MARIETTA CORP. FARRELL ROAD PLANT | |
| DATE 1/95 | | TOWN OF GEDDES | |
| | | DWG. No. 38564-00 | |
| | | SCALE AS SHOWN | |
| | | FIGURE No. 2 | |
| | | NEW YORK | |

RECORD DRAWINGS
GROUND WATER AND SOIL REMEDIATION SYSTEMS

MARTIN MARIETTA CORPORATION

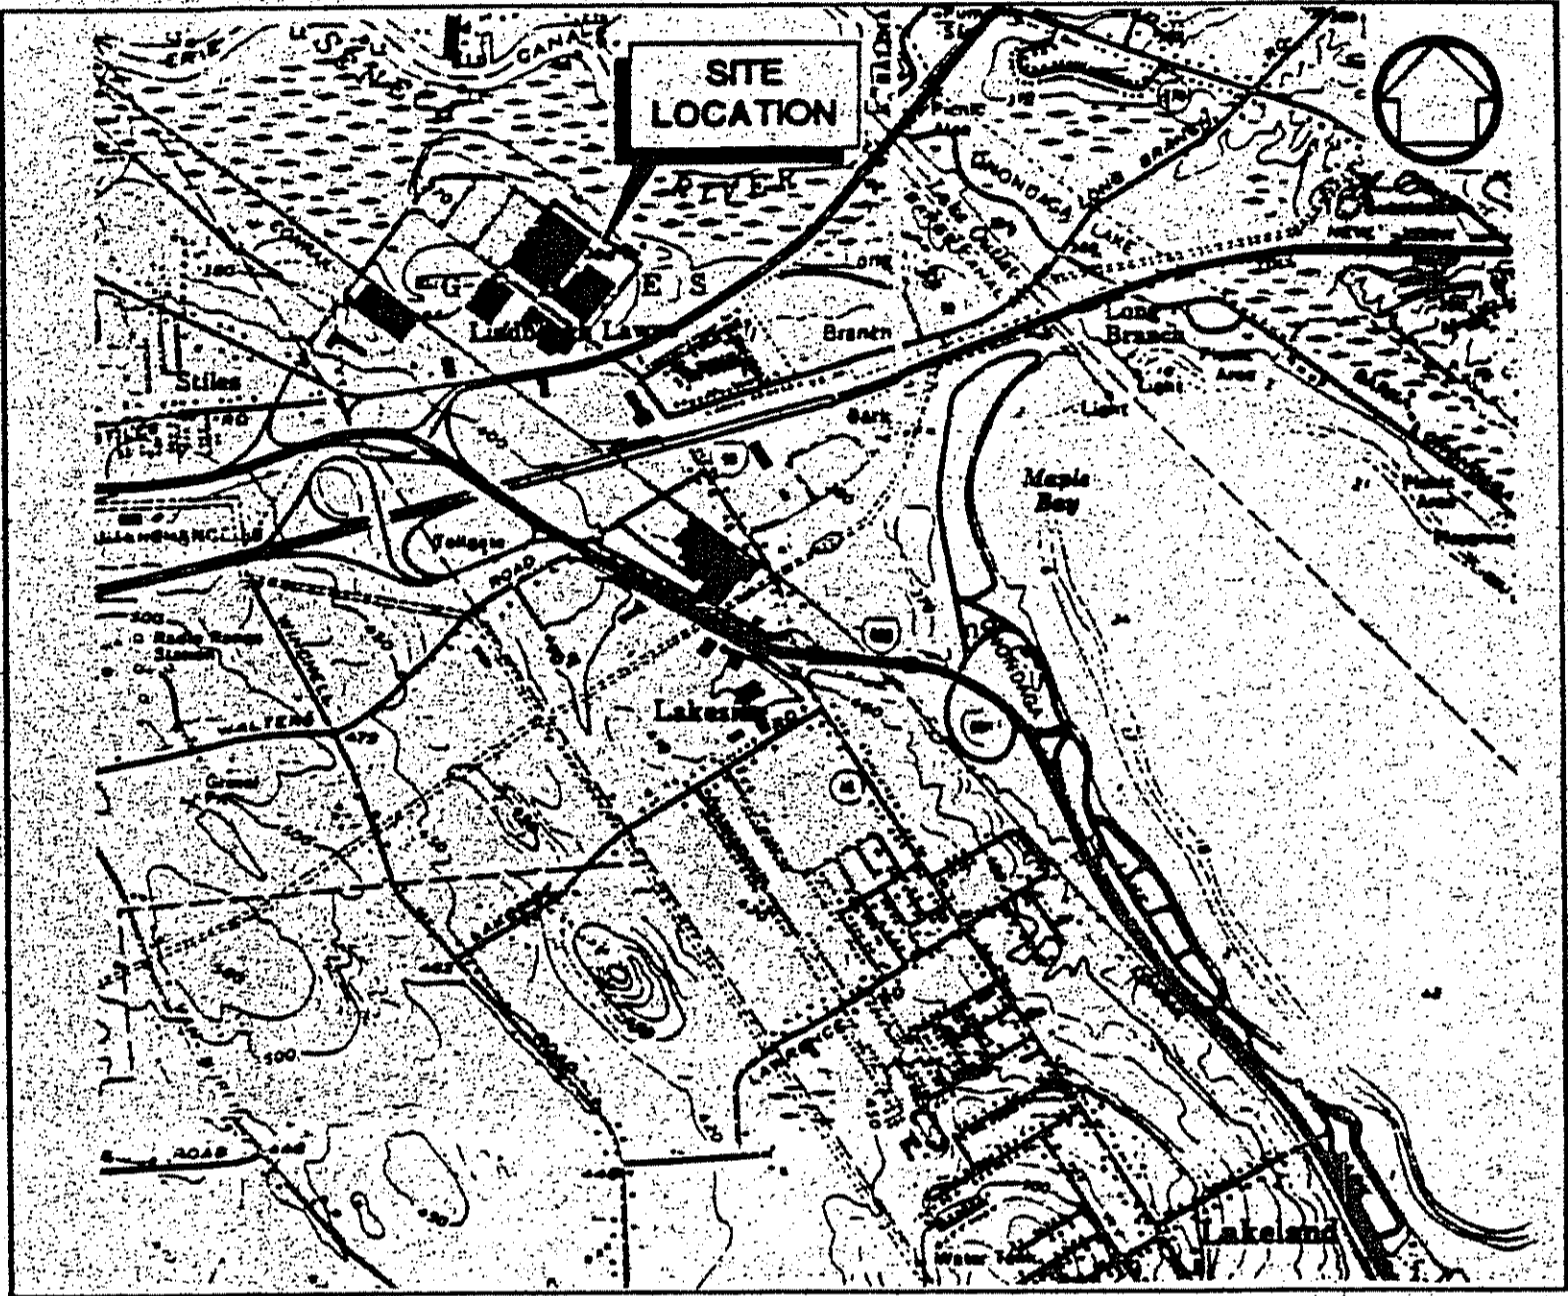FARRELL ROAD PLANT - SOLVENT TANK AREA (AOC #5) AND GARAGE AREA (AOC #16)
TOWN OF GEDDES, NY



SITE LOCATION MAP

SCALE: 1"= 2000'

DRAWING LIST

| DRAWING NUMBER | DRAWING TITLE | DRAWING NUMBER | DRAWING TITLE |
|----------------|--|----------------|--|
| | | | <u>GARAGE AREA</u> |
| SHEET 1 | COVER SHEET | SHEET 8 | SITE PLAN AND MISCELLANEOUS DETAILS |
| SHEET 2 | SYMBOLS & LEGEND, P & I DIAGRAM | SHEET 9 | WELL DETAILS AND GENERAL MISCELLANEOUS DETAILS |
| | <u>SOLVENT TANK AREA</u> | SHEET 10 | SOIL VAPOR FLOW SCHEMATIC |
| SHEET 3 | SITE PLAN AND PIPING PLAN | SHEET 11 | GROUNDWATER RECOVERY AND TREATMENT P & I DIAGRAM |
| SHEET 4 | SOLVENT TANK AREA & MISCELLANEOUS DETAILS | SHEET 12 | TREATMENT BUILDING AND CIVIL DETAILS |
| SHEET 5 | SOIL VAPOR EXTRACTION AND PASSIVE AIR INJECTION WELLS, P & I DIAGRAM | SHEET 13 | VAPOR DISCHARGE STACK (10" DIA. TAPERED) BASE & CONCRETE FOUNDATION DETAILS |
| SHEET 6 | TREATMENT BUILDING AND CONCRETE FOUNDATION, | SHEET 14 | GENERAL ELECTRICAL DETAILS |
| SHEET 7 | GENERAL ELECTRICAL DETAILS | SHEET 15 | ELECTRICAL SCHEMATIC AND ONELINE DIAGRAM |

| | | | | | |
|---|---|---|---|---|---|
| A | B | C | D | E | F |
|---|---|---|---|---|---|

Figure 1 consists of two bar charts. The left chart is titled 'All respondents' and the right chart is titled 'Respondents who are poor'. Both charts show the percentage of respondents for different levels of agreement with the statement 'The government should do more to help the poor'. The x-axis for both charts represents the level of agreement, ranging from 'Strongly disagree' to 'Strongly agree'. The y-axis represents the percentage of respondents, ranging from 0 to 100. The bars are stacked, with 'Strongly disagree' at the bottom and 'Strongly agree' at the top.

| Level of Agreement | All respondents (%) | Respondents who are poor (%) |
|--------------------|---------------------|------------------------------|
| Strongly disagree | ~10 | ~10 |
| Disagree | ~10 | ~10 |
| Neutral | ~10 | ~10 |
| Agree | ~10 | ~10 |
| Strongly agree | ~60 | ~60 |

| | |
|--|------------|
| | SUCCESSING |
|--|------------|

NOTES:

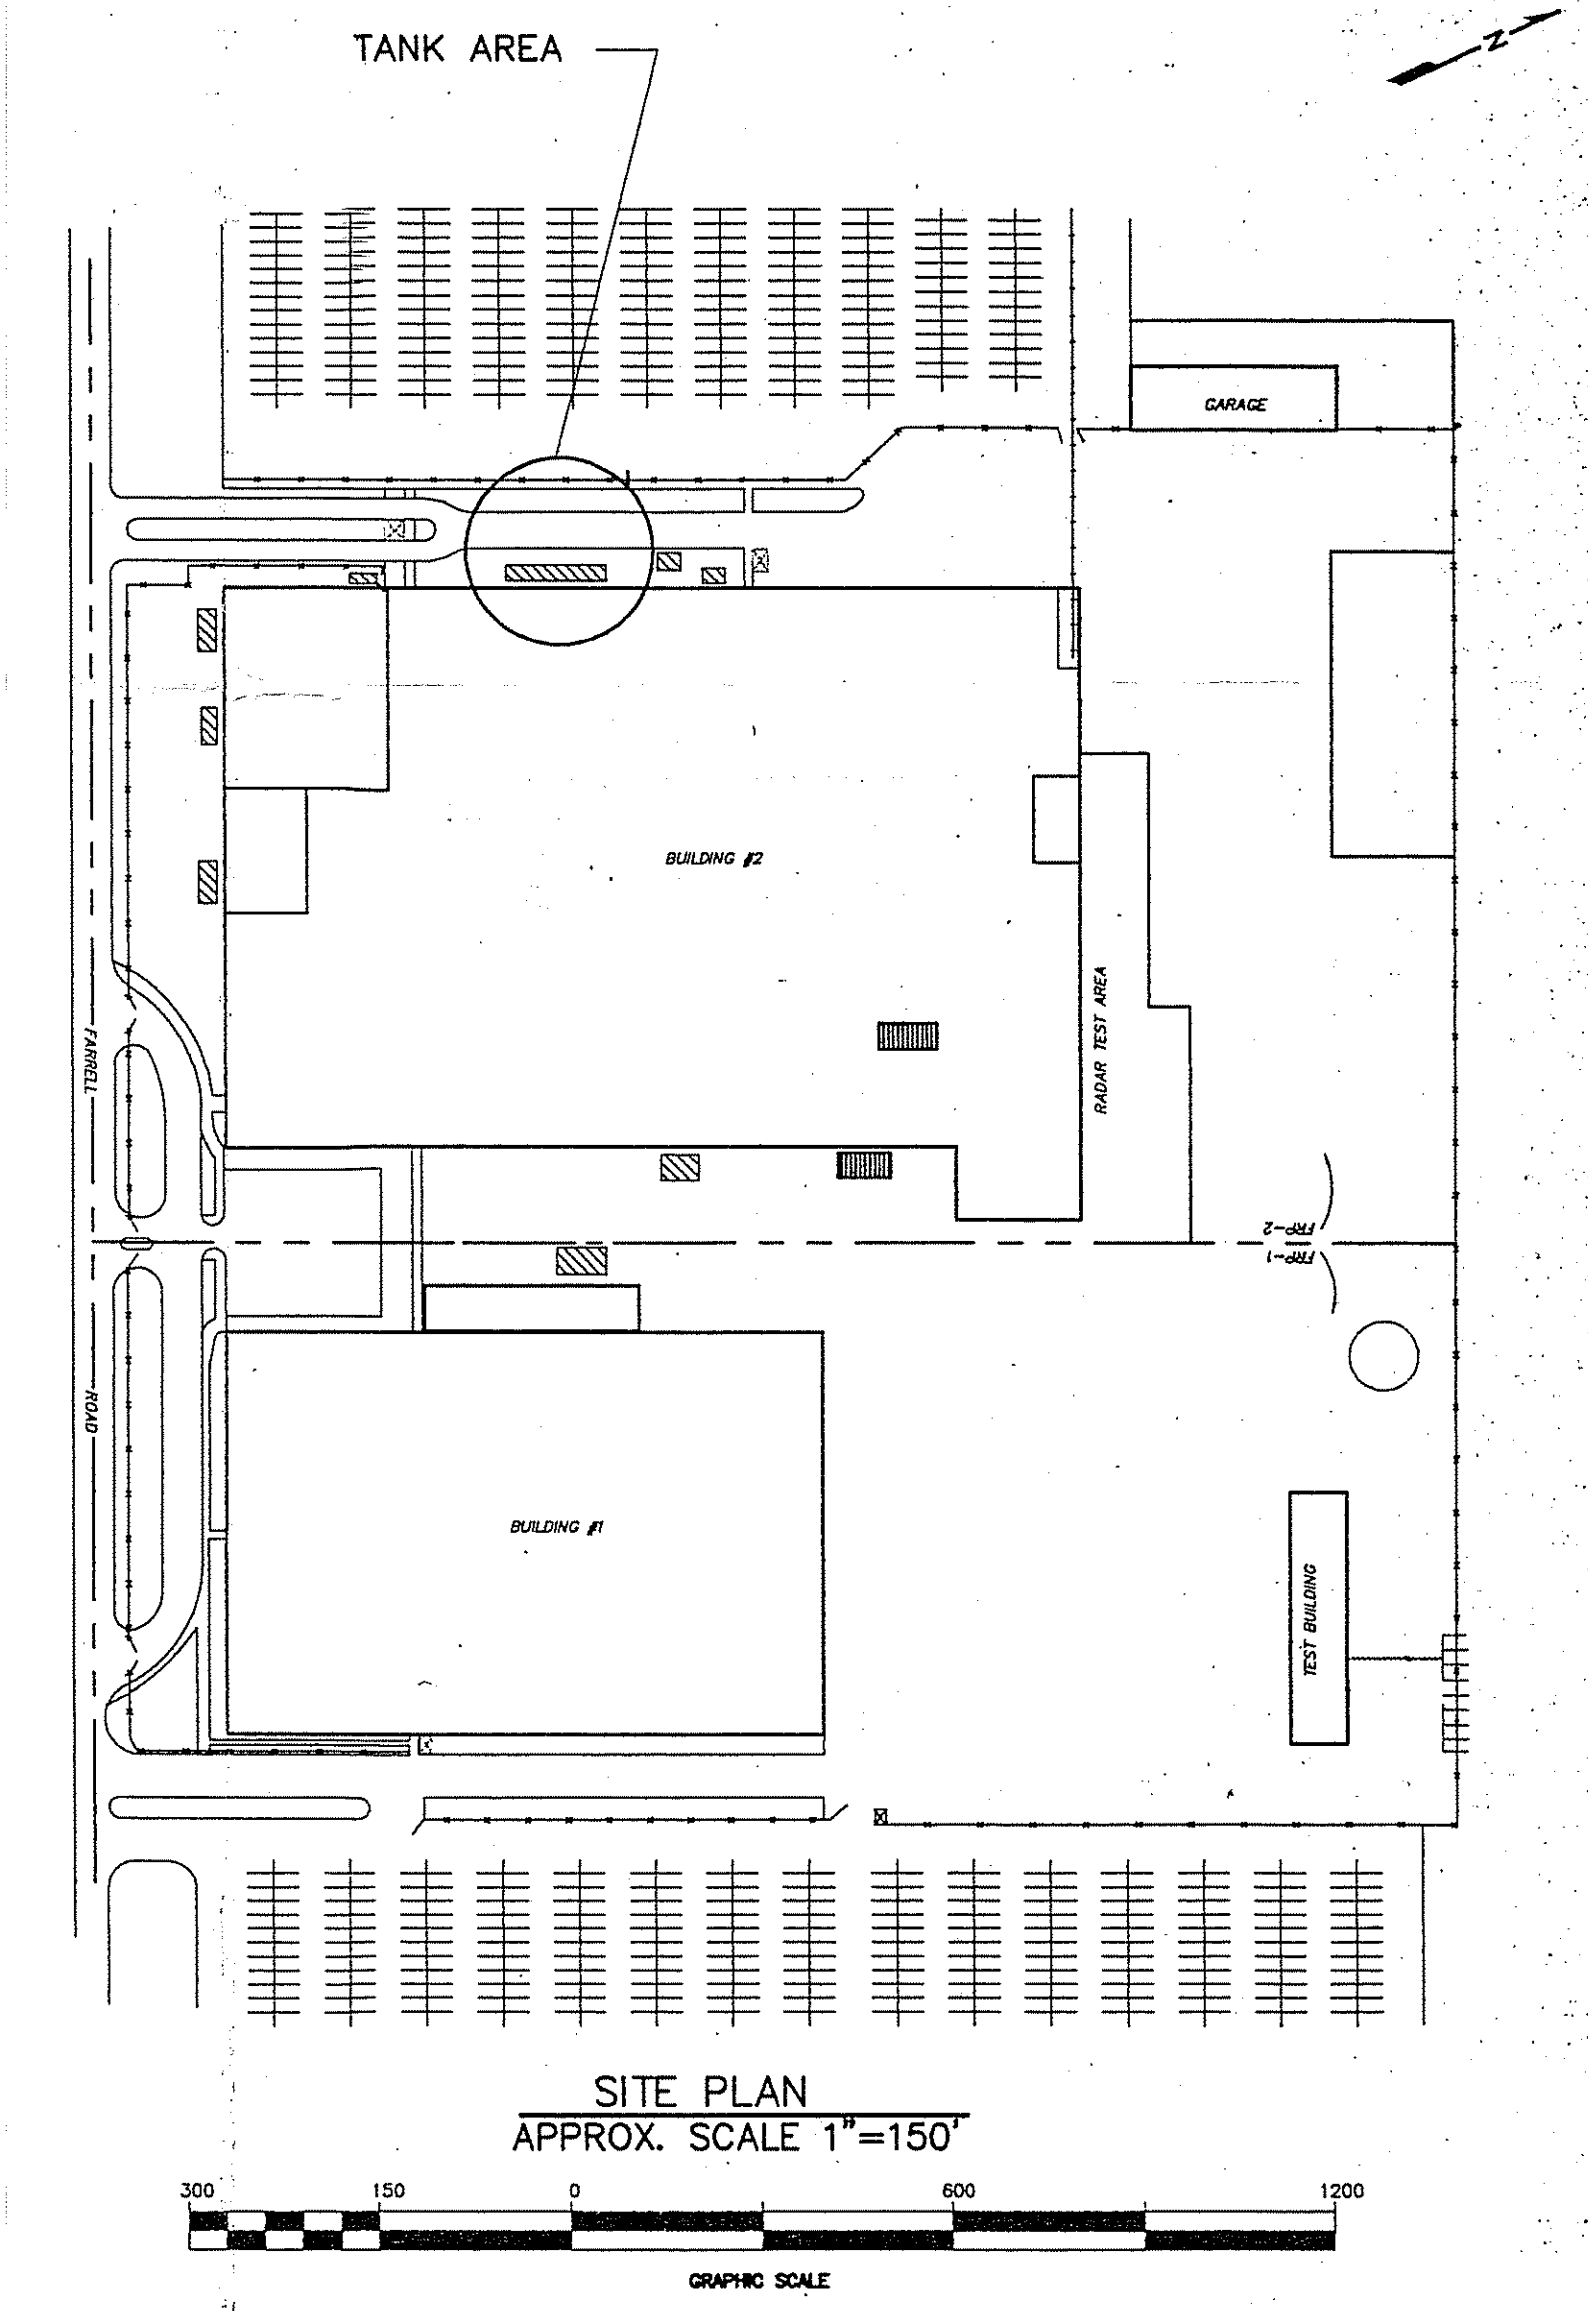
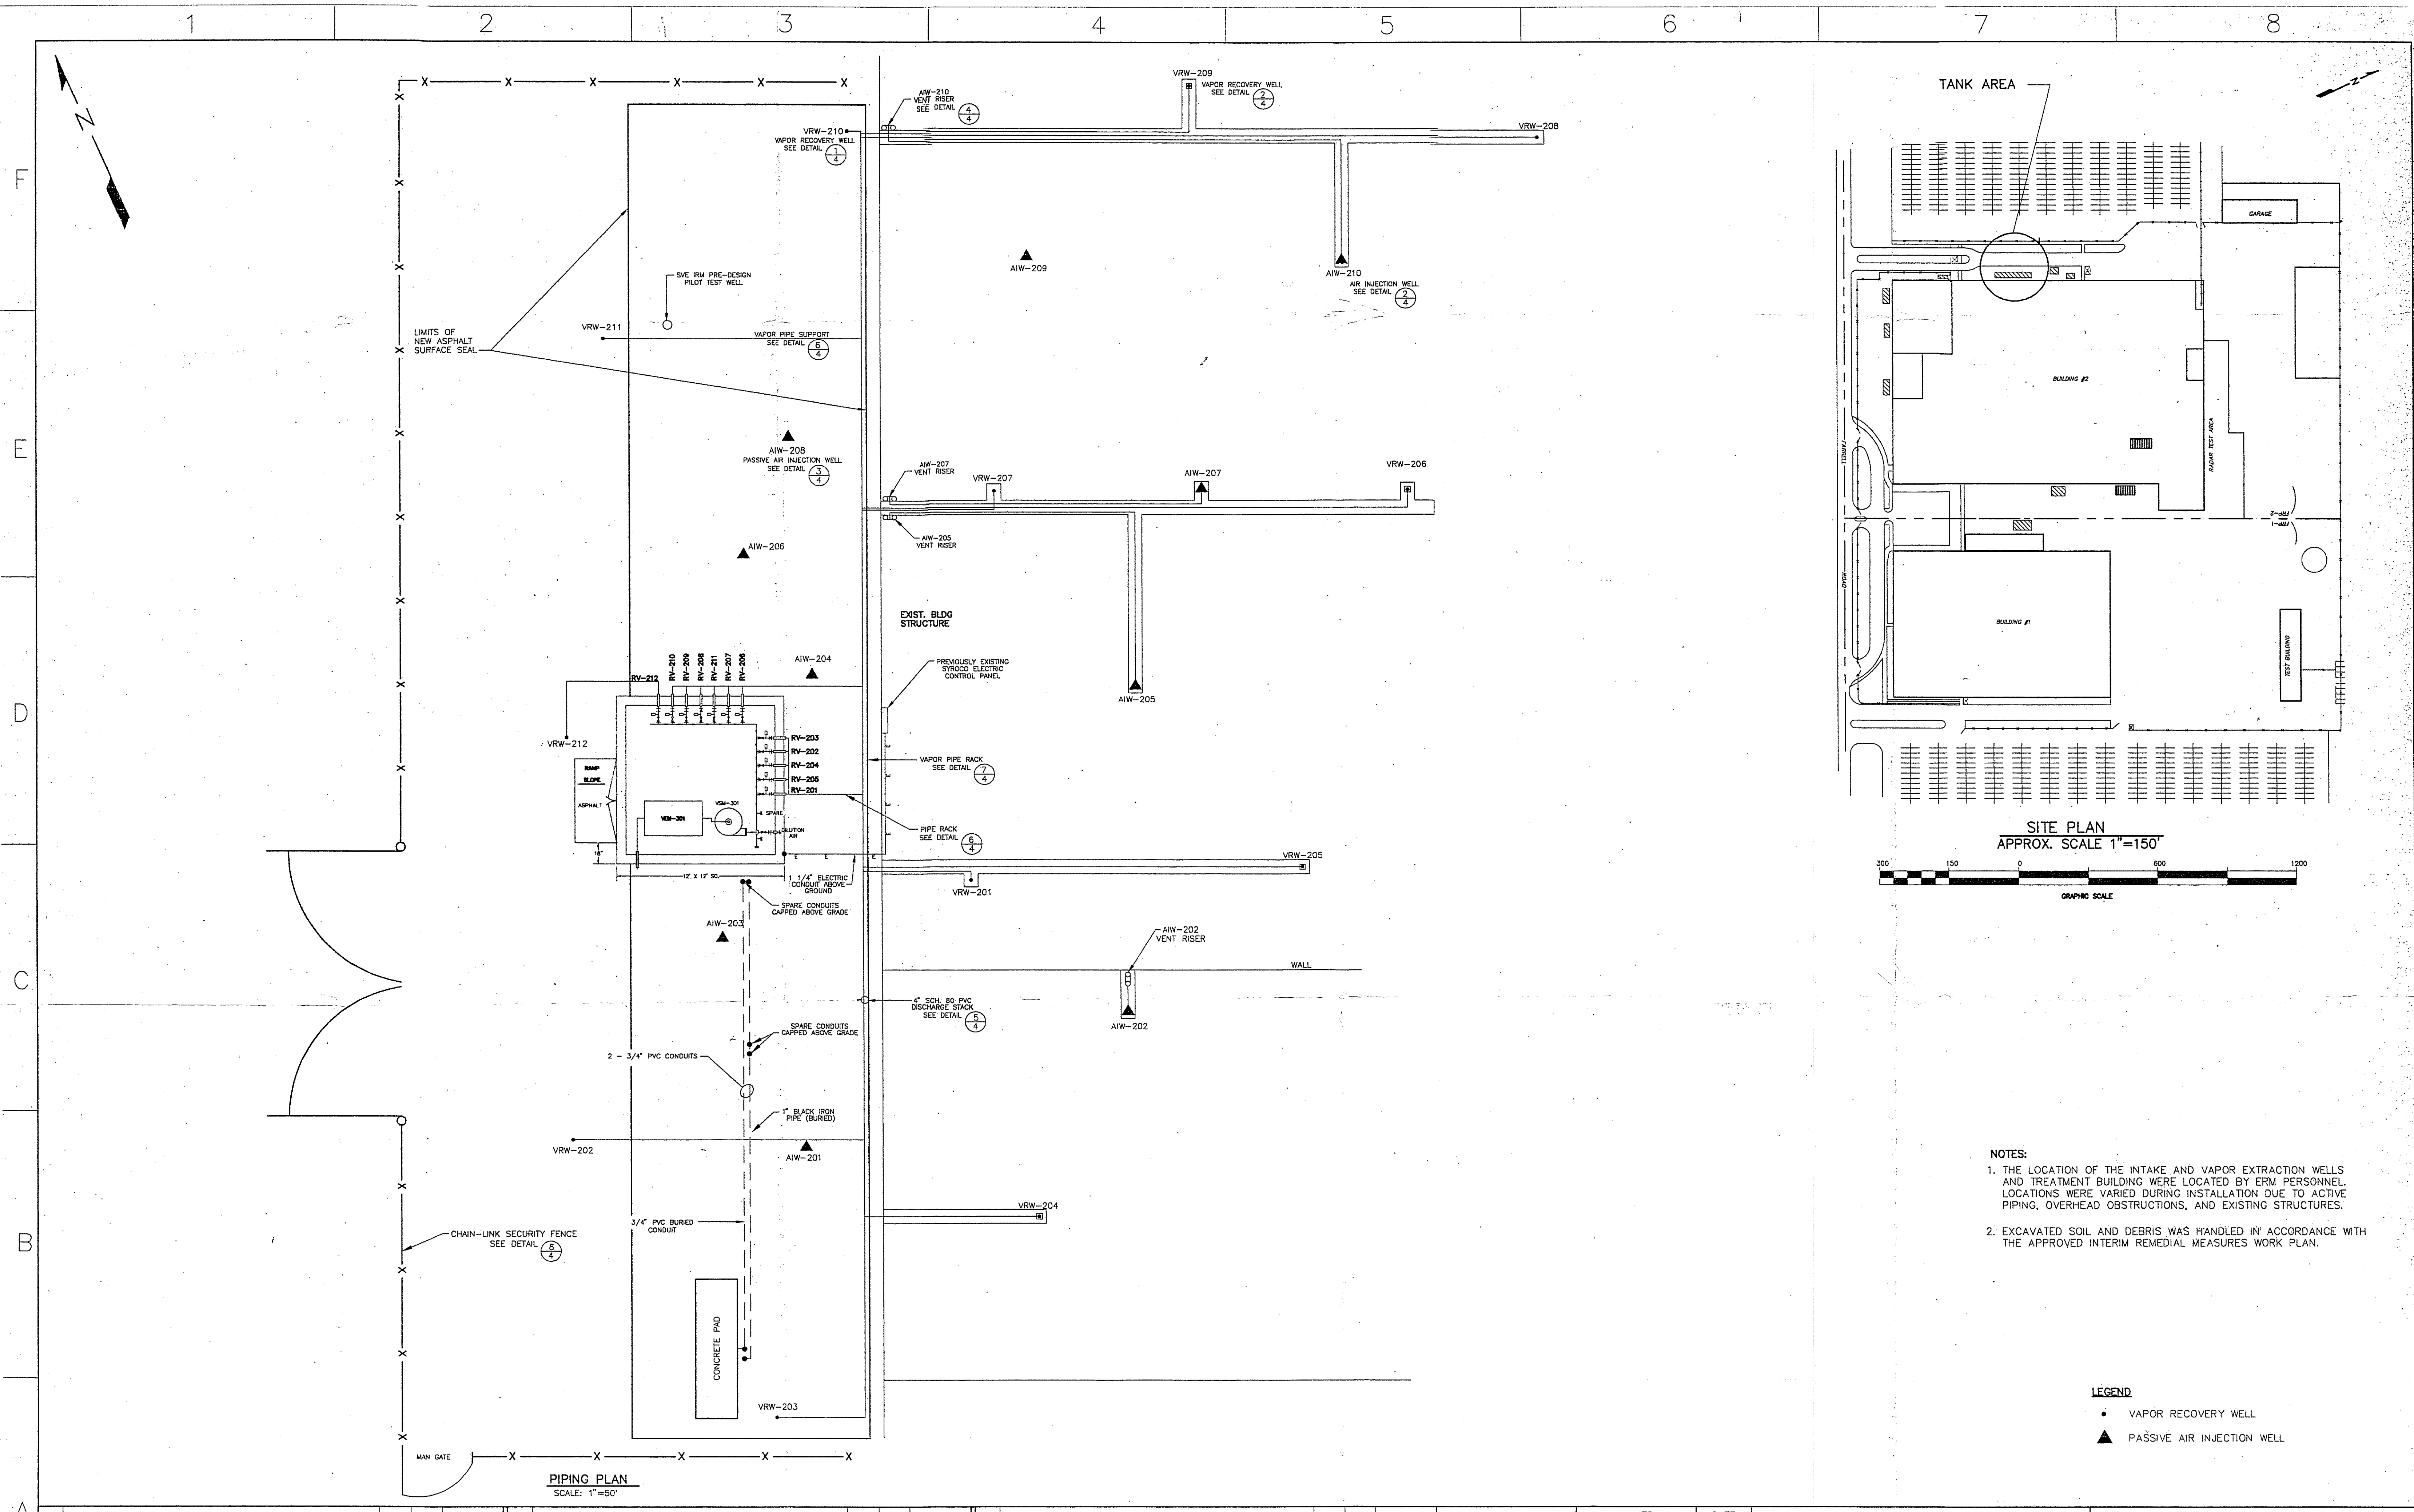
1. UNLESS OTHERWISE NOTED, ALL VALVES ARE LINE SIZE.

2. EXISTING LINES ARE INDICATED WITH A LIGHTER LINE DENSITY.

[illegible]

The drawings, specifications and other documents prepared by the Engineer for this project are instruments of the Engineer's service for use solely with respect to this project and, unless otherwise provided, the Engineer shall be deemed the author of these documents and shall retain all common law, statutory and other reserved rights, including the copyright.

CAD FILE NAME:
PLOT DATE: 2/21/95



NOTES:



1. THE LOCATION OF THE INTAKE AND VAPOR EXTRACTION WELLS AND TREATMENT BUILDING WERE LOCATED BY ERM PERSONNEL. LOCATIONS WERE VARIED DURING INSTALLATION DUE TO ACTIVE PIPING, OVERHEAD OBSTRUCTIONS, AND EXISTING STRUCTURES.
2. EXCAVATED SOIL AND DEBRIS WAS HANDLED IN ACCORDANCE WITH THE APPROVED INTERIM REMEDIAL MEASURES WORK PLAN.

LEGEND

- VAPOR RECOVERY WELL
- ▲ PASSIVE AIR INJECTION WELL





A

| |
|---|
| |
|---|

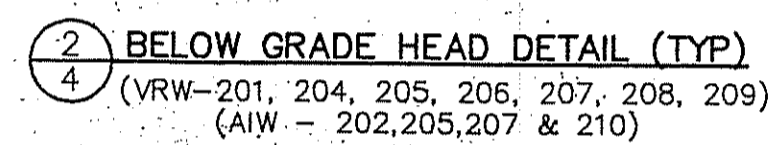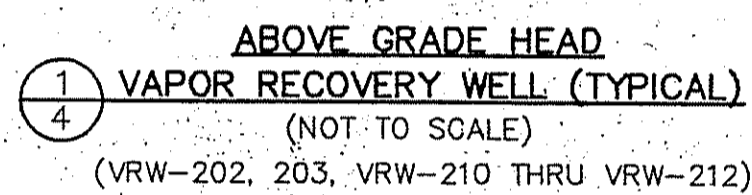

NOTE:

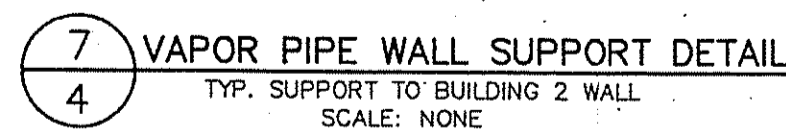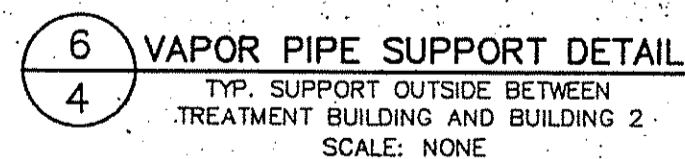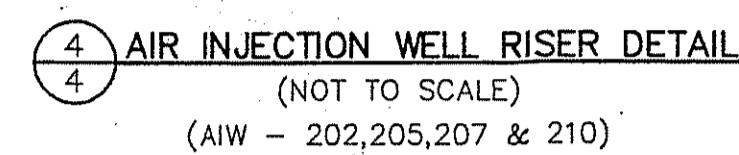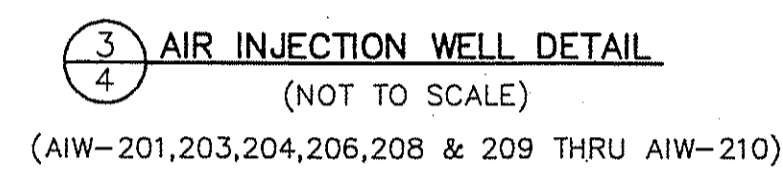1. UNDERGROUND CONSTRUCTION IS FOR TYPICAL VAPOR RECOVERY AND AIR INJECTION WELLS



STATE OF NEW YORK
ALAN H. TAVENNER
4-14-95
488063
LICENSED PROFESSIONAL ENGINEER

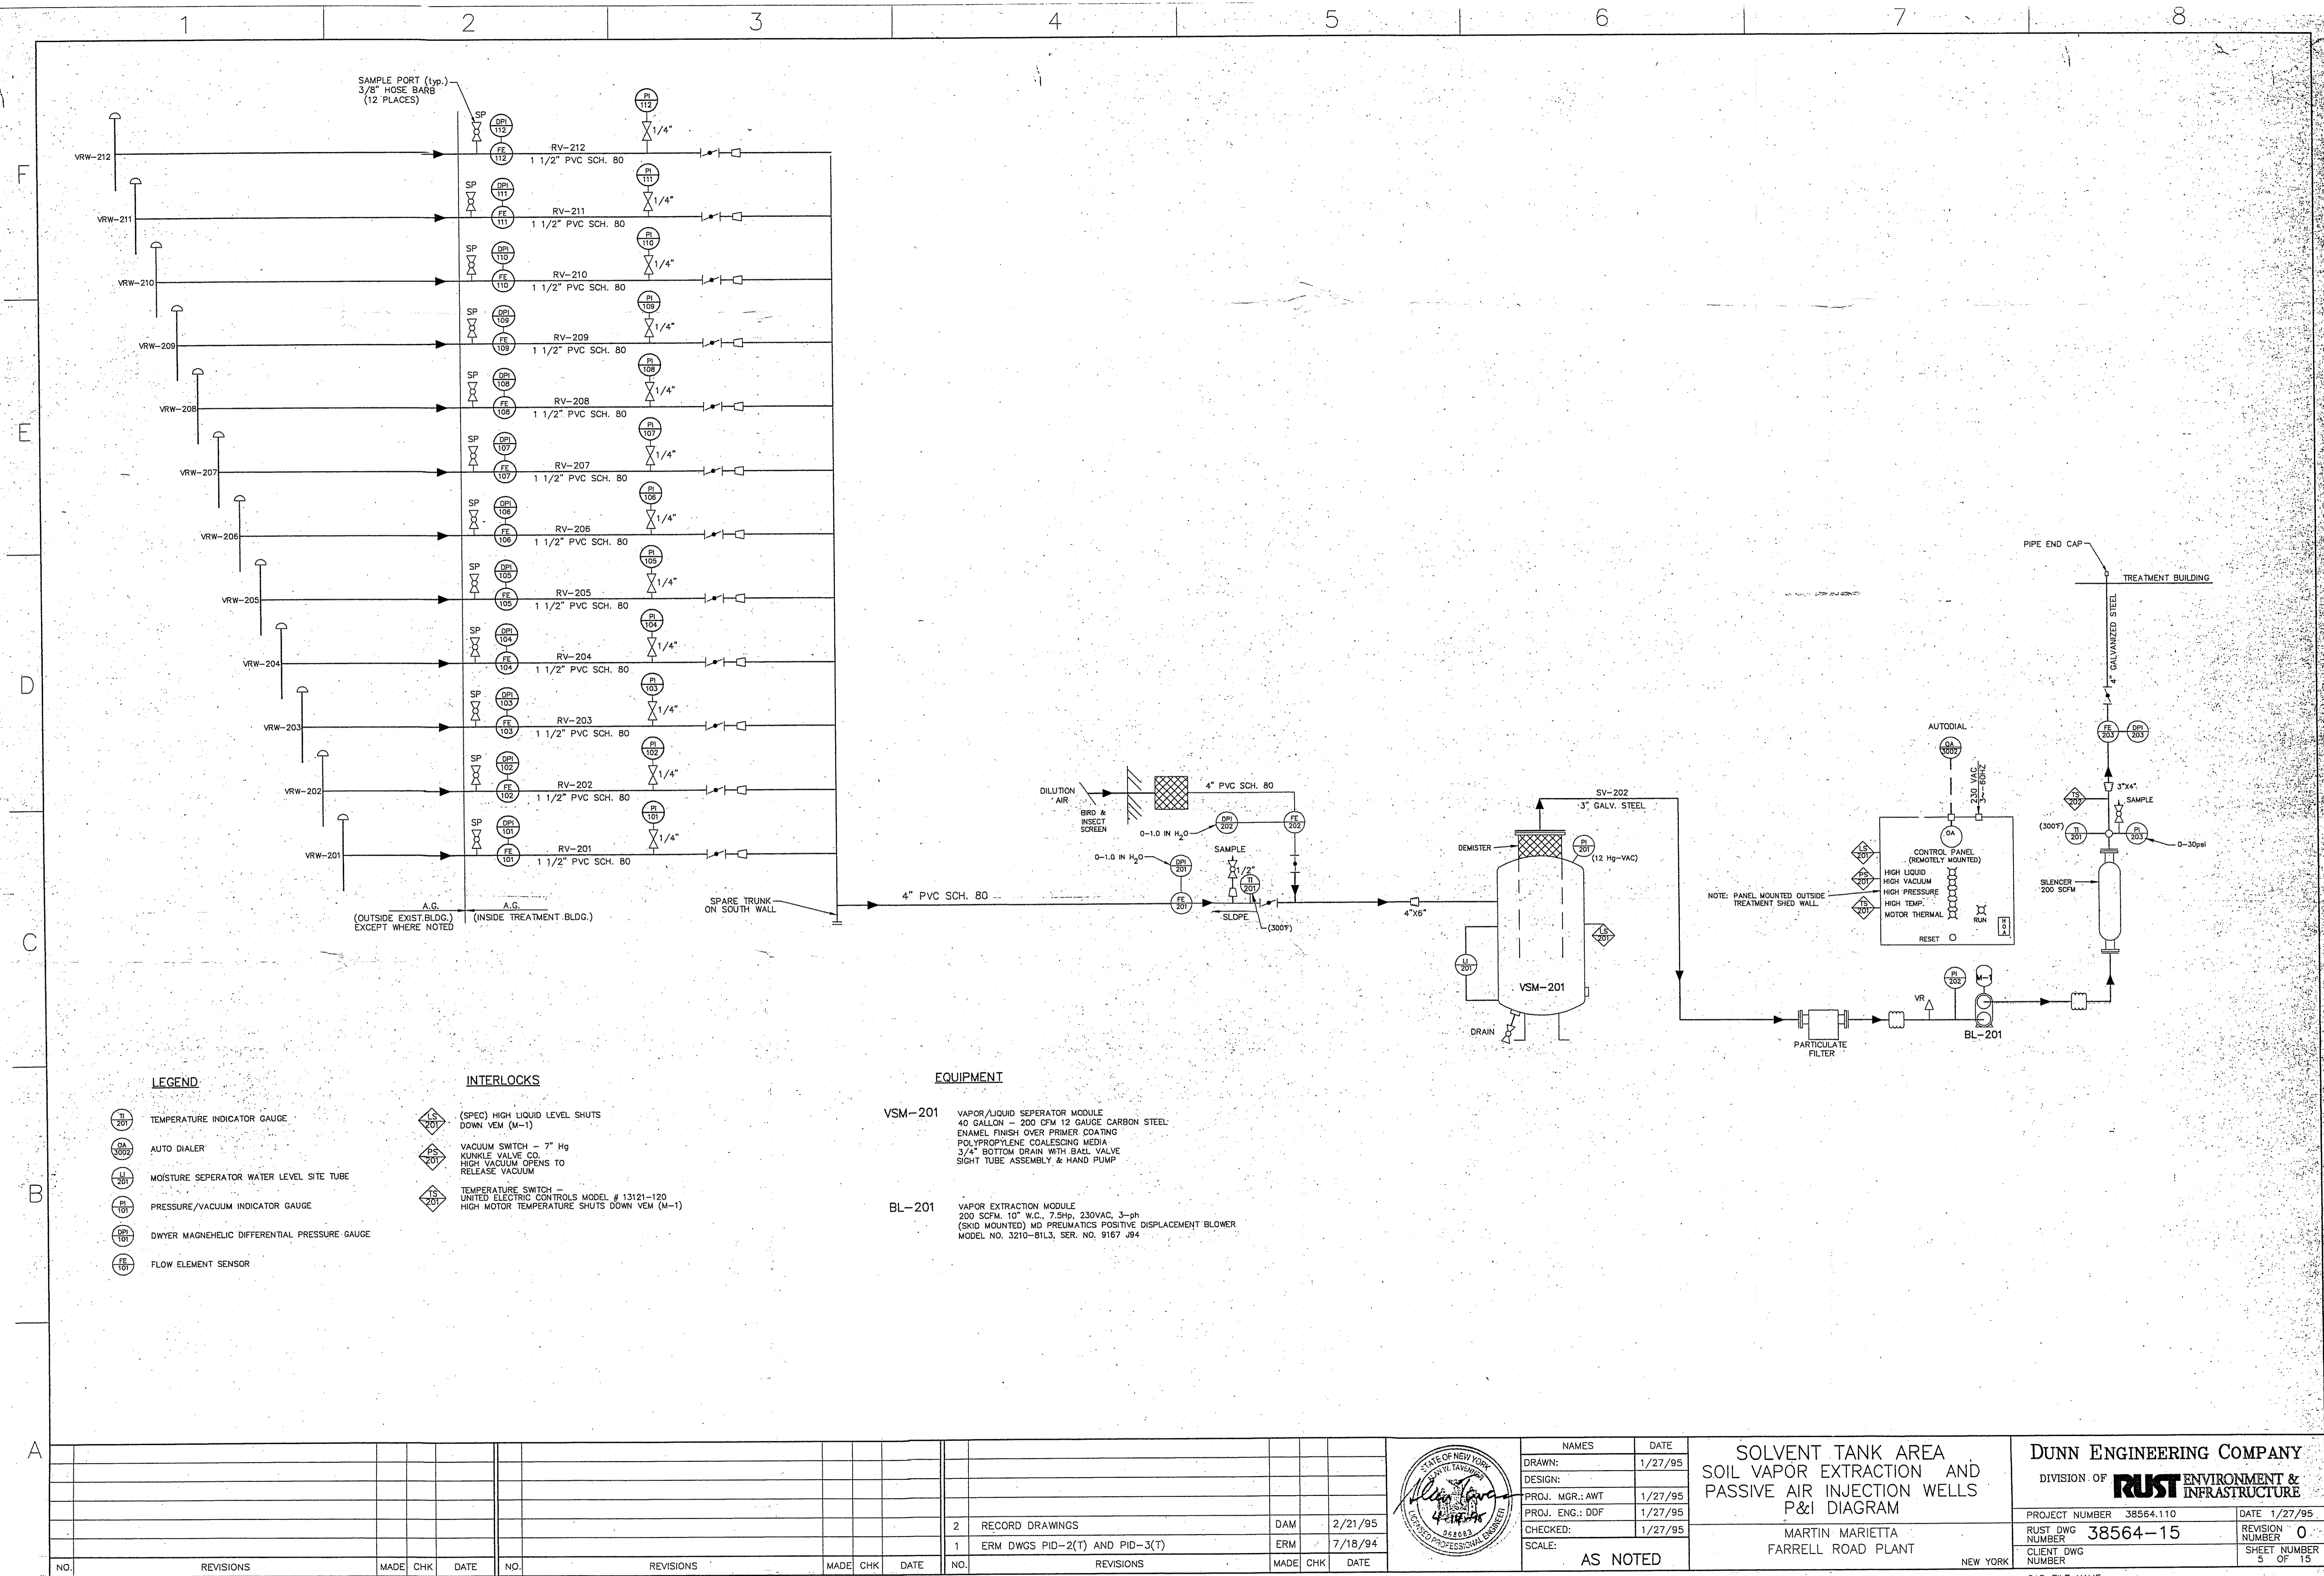
SOLVENT TANK AREA & MISCELLANEOUS DETAILS

MARTIN MARIETTA
FARRELL ROAD PLANT

NEW YORK

CAD FILE NAME:
PLOT DATE: 1/30/95

The drawings, specifications and other documents prepared by the Engineer for this project are instruments of the Engineer's service for use solely with respect to this project and, unless otherwise provided, the Engineer shall be deemed the author of these documents and shall retain all common law, statutory and other reserved rights, including the copyright.






CAD FILE NAME:
PLOT DATE: 1/31/95

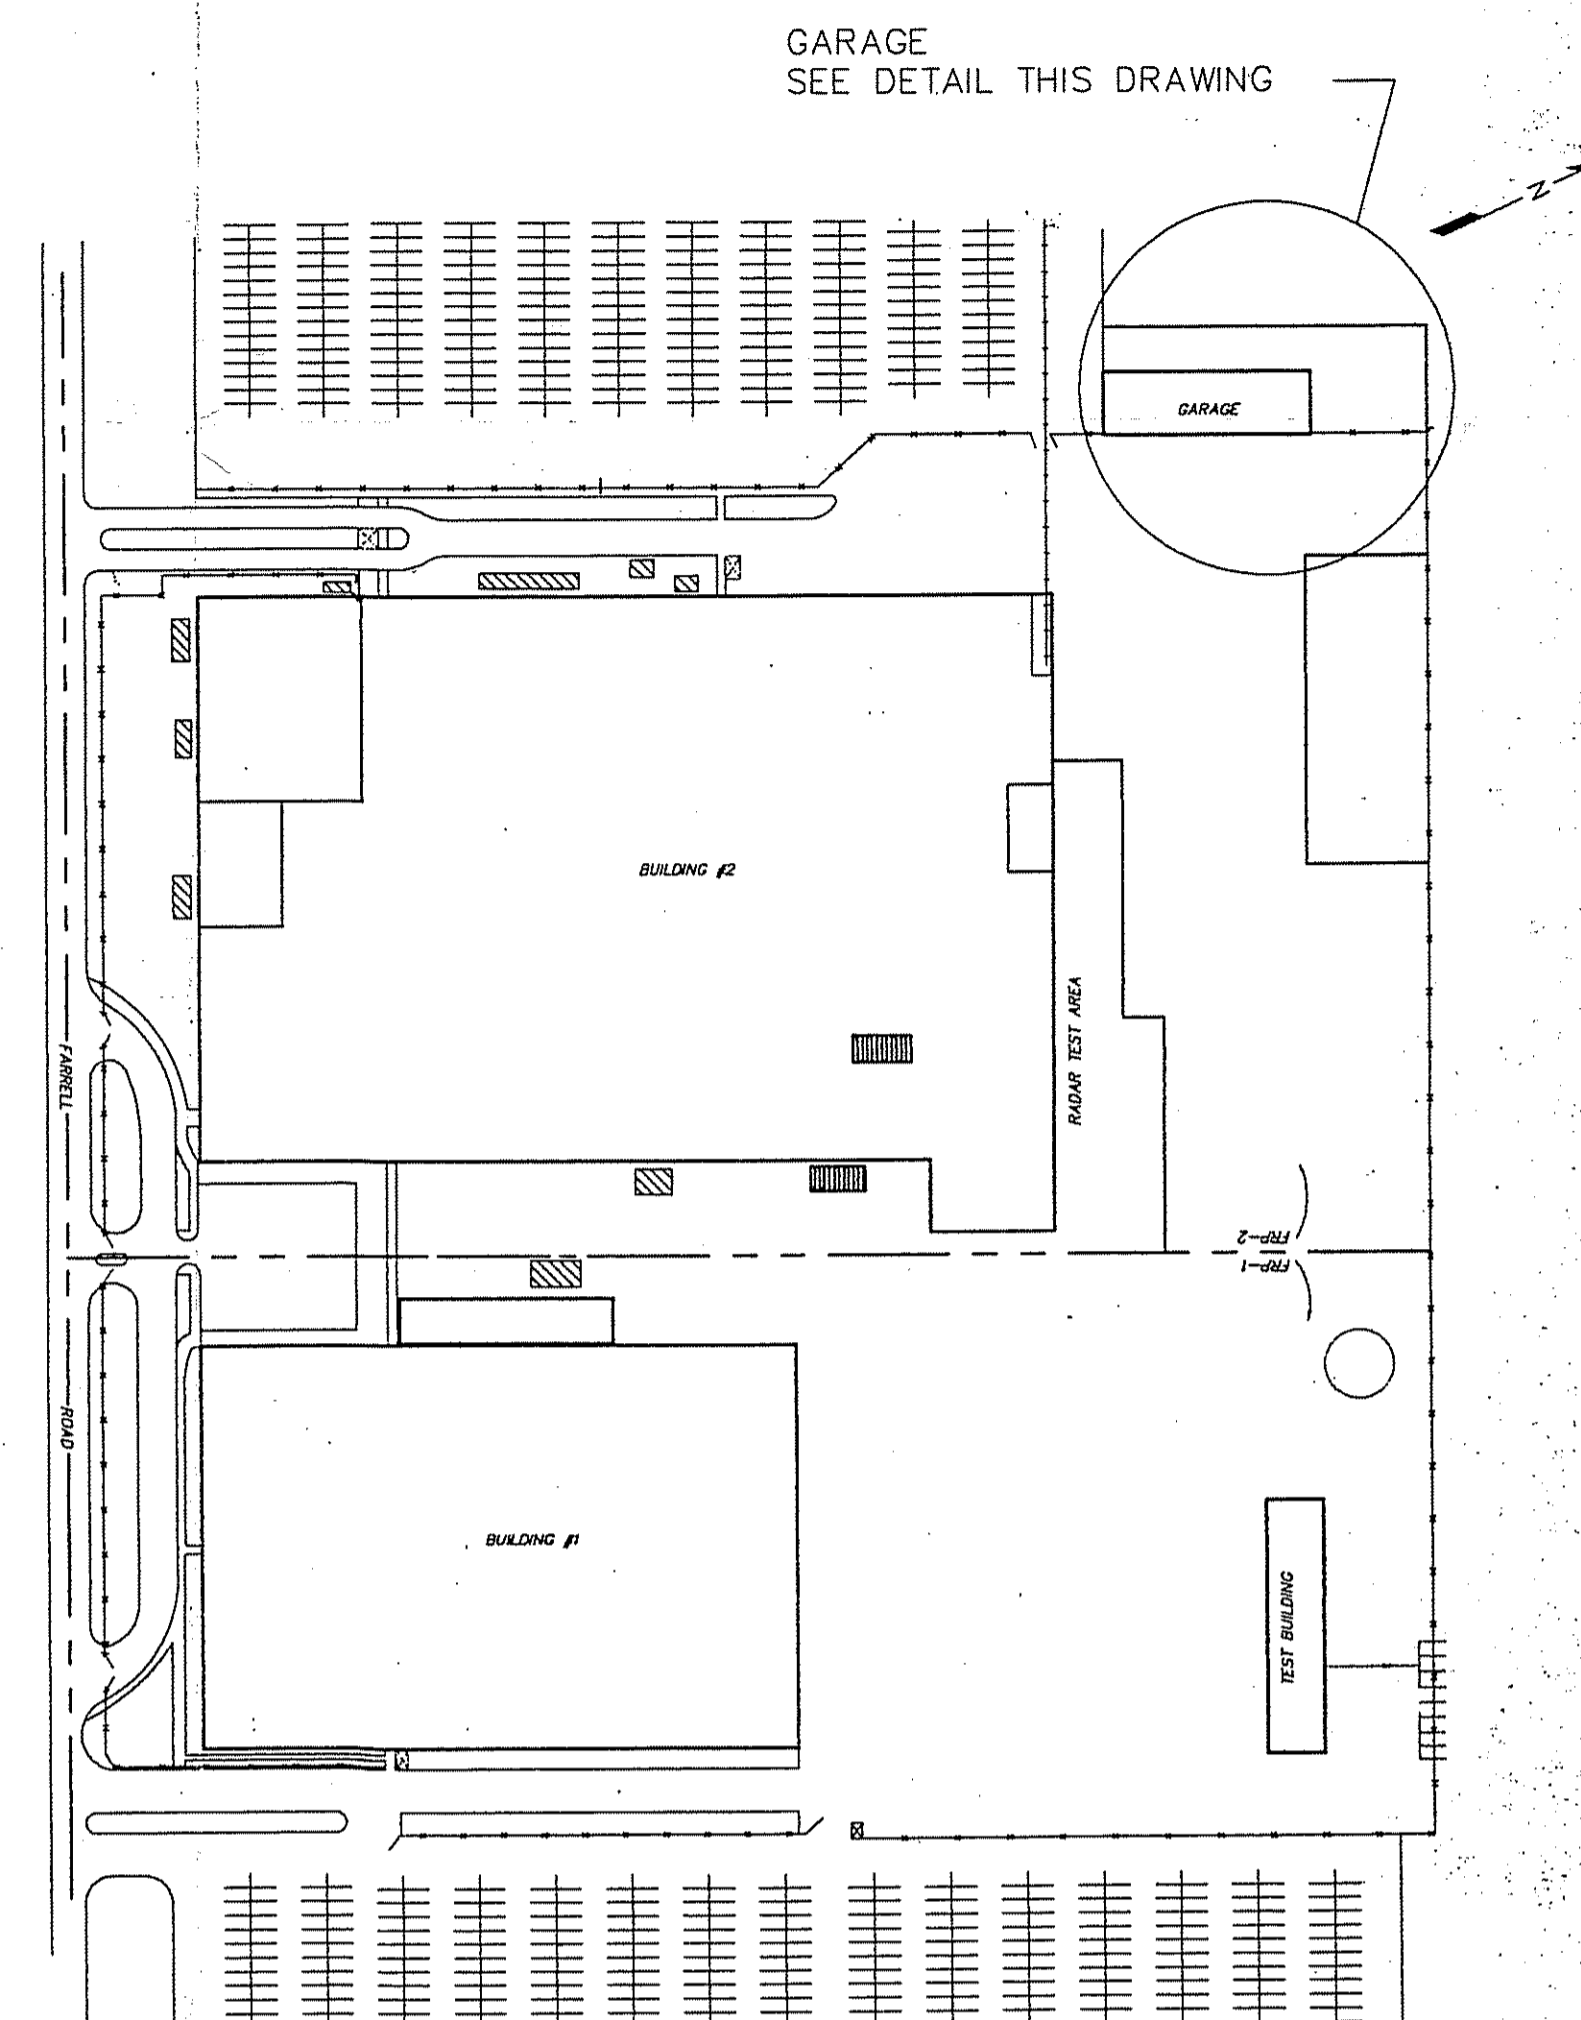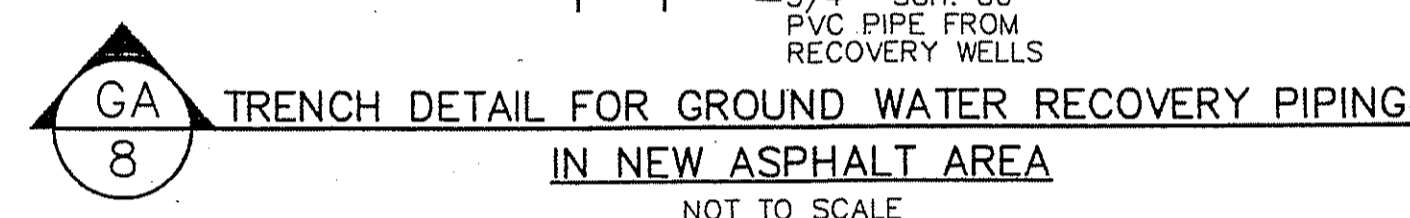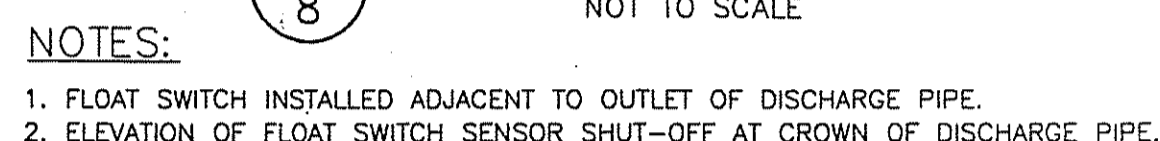1. OUTFALL TRENCH BACKFILLED WITH NATIVE SOIL PREVIOUSLY SCREENED WITH A PUD AND CONTAINING LESS THAN 5 PARTS PER MILLION (ppm). VERBAL APPROVAL RECEIVED FROM NYSDEC PRIOR TO BACKFILLING.
2. CONCRETE SLAB CONSTRUCTED MEASURING 10'-0" LONG BY 3'-0" WIDE BY 6" THICK, FOR THE FUTURE STORAGE OF PROPANE CYLINDERS IF REQUIRED.
3. 6'-0" HIGH VINYL COATED CYCLONE TYPE CHAIN-LINK FENCE INSTALLED AROUND NEW TREATMENT FACILITY AND ABOVE GROUND PIPING.
4. CONTRACTOR RESTORED ALL AREAS DISTURBED BY CONSTRUCTION ACTIVITIES TO AN "AS GOOD" CONDITION EXCEPT ASPHALT AREAS, SEE SECTION THREE SHEET.
5. ELECTRICAL CONDUITS NOT SHOWN ON PLAN VIEW.
6. VAPOR EXTRACTION PIPING OUTSIDE GARAGE SUPPORTED BY TYPICAL UNISTRUT PIPE SUPPORT.
7. ALL ABOVE GROUND WATER LINES INSIDE GARAGE AND THOSE EXPOSED PRIOR TO ENTERING TREATMENT BUILDING ARE HEAT TRACED AND INSULATED.
8. LENGTH OF OUTFALL PIPE TRENCH IS APPROXIMATELY 166 FEET LONG.



LOCATION MAP
APPROX. SCALE 1"=150'

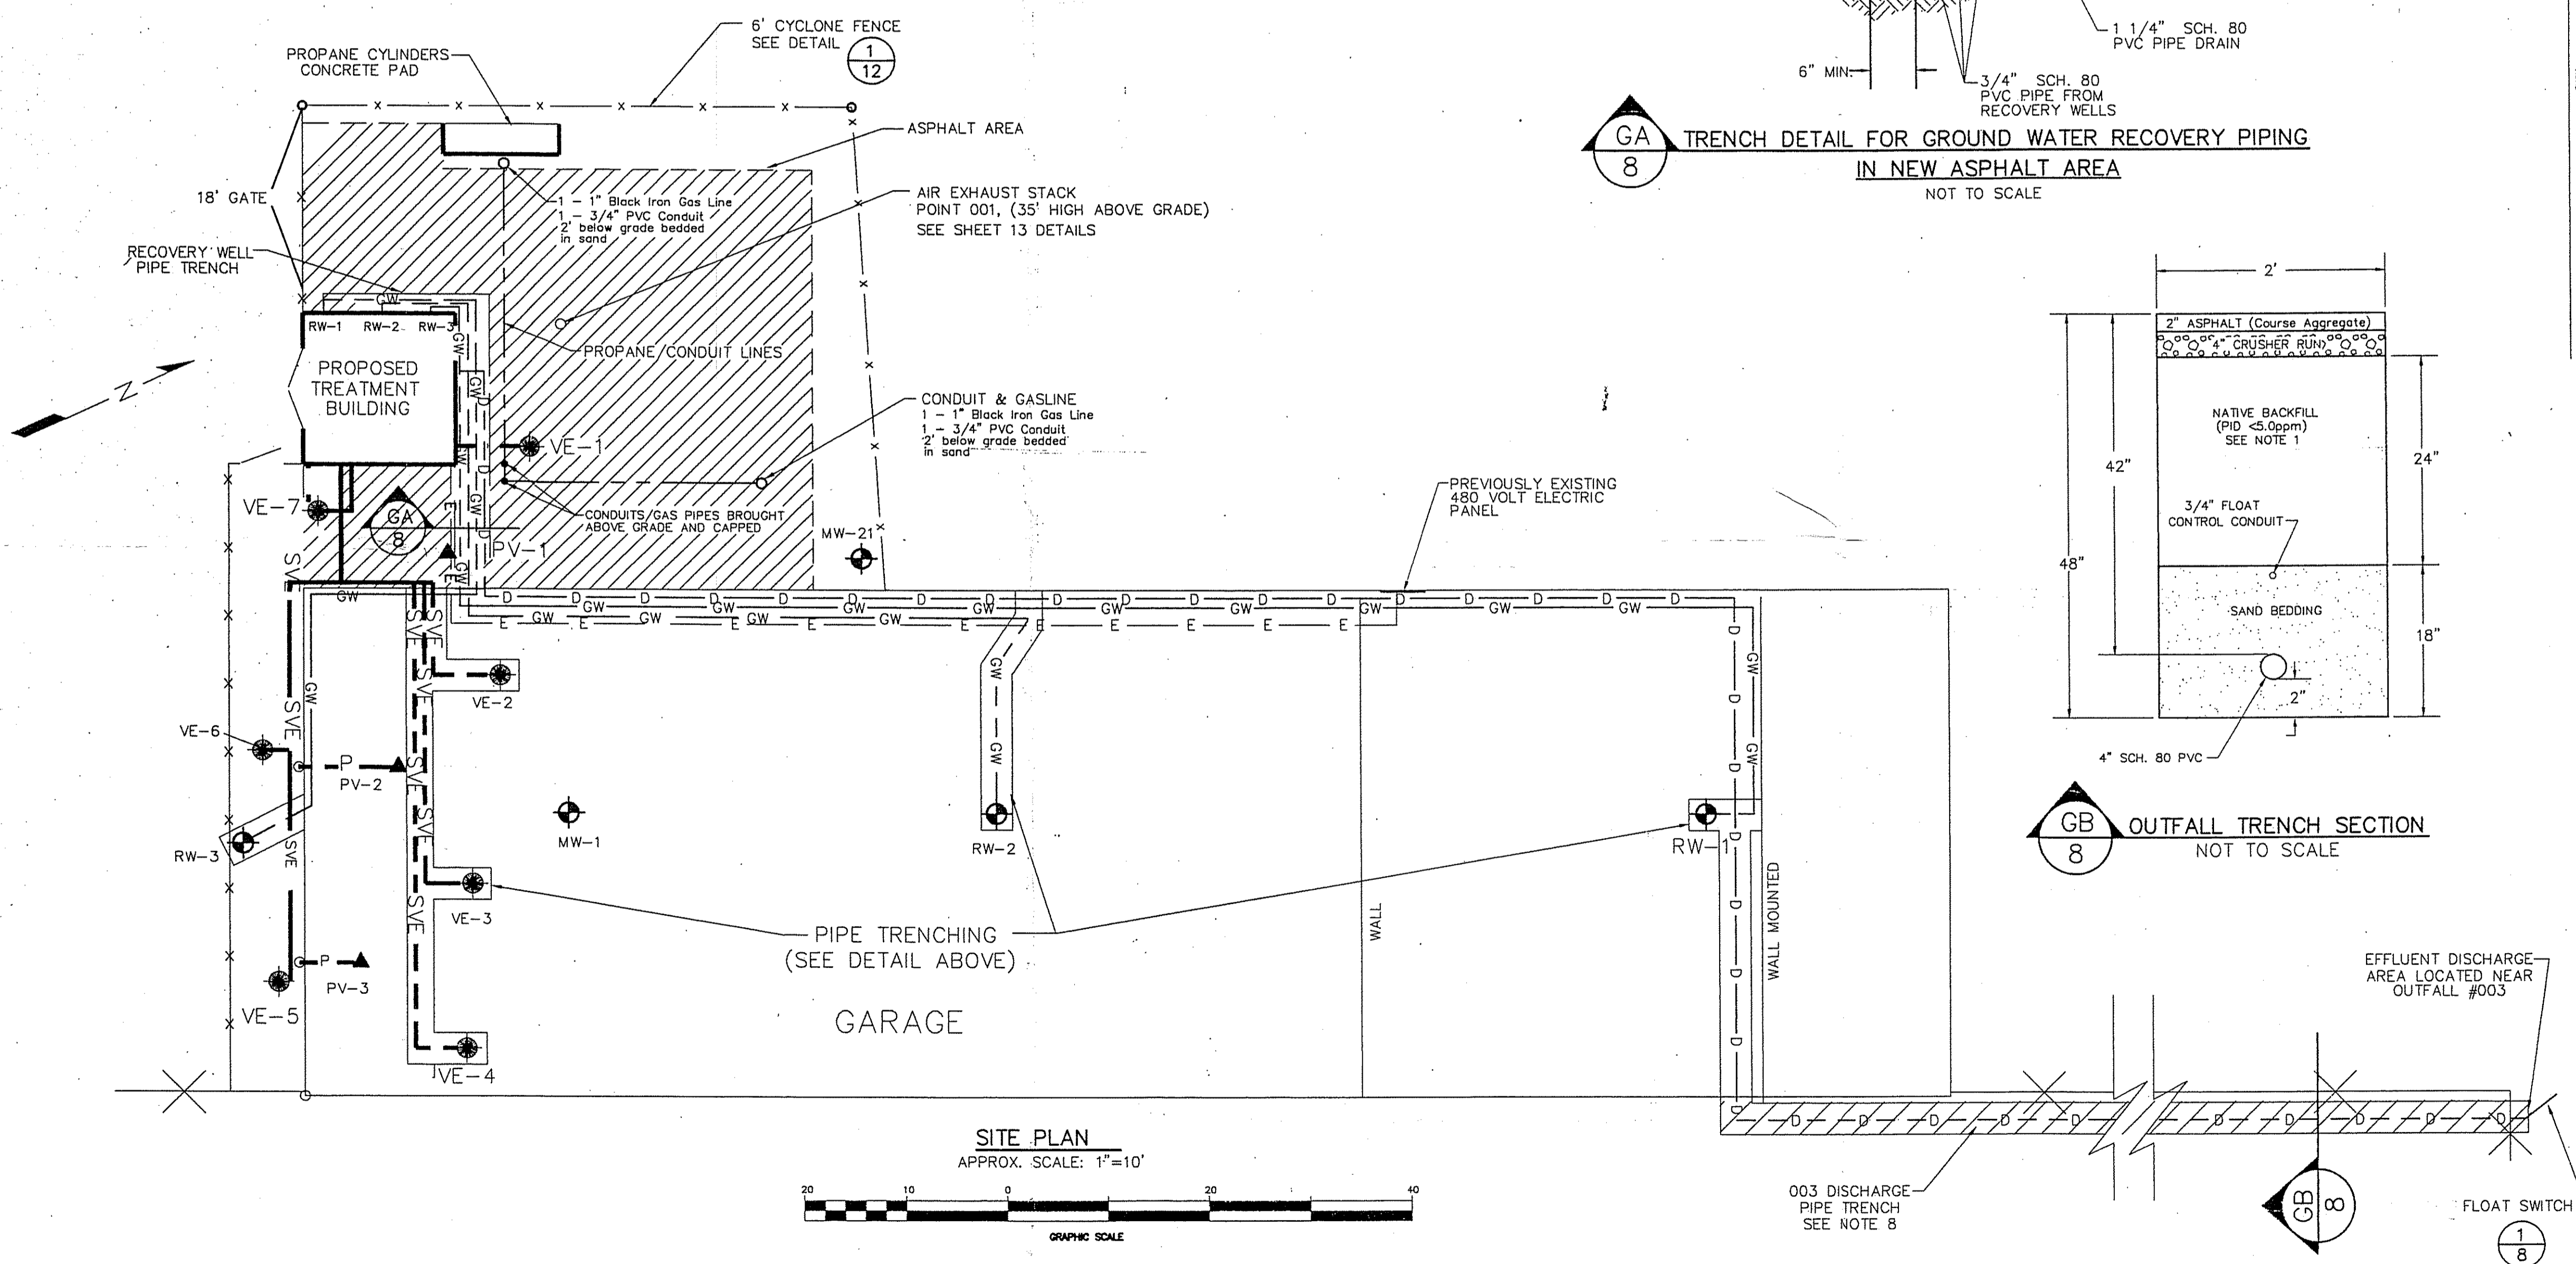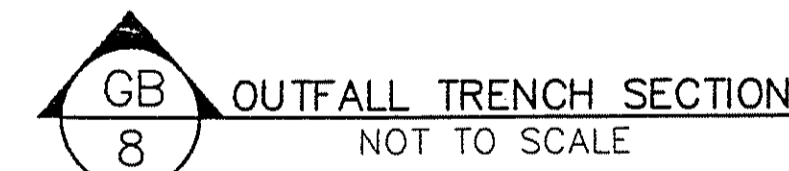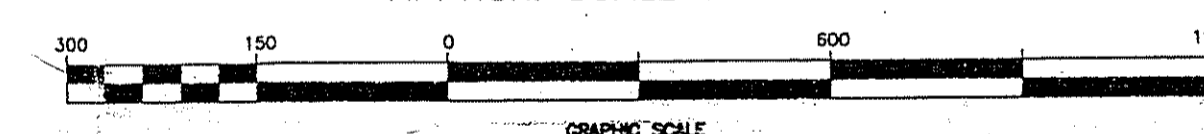[illegible]

| NAMES | DATE |
|-----------------|--------|
| DRAWN: | 1/26/9 |
| DESIGN: ERM | |
| PROJ. MGR.: AWT | 1/27/9 |
| PROJ. ENG.: DDF | 1/27/9 |
| CHECKED: | 1/27/9 |
| SCALE: | |


AS NOTED

| | | |
|---|---|--|
| 5 | <p style="text-align: center;">GARAGE AREA</p> <p>SITE PLAN AND MISCELLANEOUS DETAILS.</p> <p style="text-align: center;">MARTIN MARIETTA FARRELL ROAD PLANT</p> | |
| 5 | | |
| 5 | | |
| 5 | | |
| 5 | | |



| | |
|--------------------------|--|
| DUNN ENGINEERING COMPANY | |
| DIVISION OF | RUST ENVIRONMENT & INFRASTRUCTURE |
| PROJECT NUMBER | 38564.110 |
| RUST DWG NUMBER | 38564-04 |
| CLIENT DWG NUMBER | SHEET NUMBER 8 OF 15 |
| DATE | 1/26/97 |

The drawings, specifications and other documents prepared by the Engineer for this project are instruments of the Engineer's service for use solely with respect to this project and, unless otherwise provided, the Engineer shall be deemed the author of these documents and shall retain all common law, statutory and other reserved rights, including the copyright.

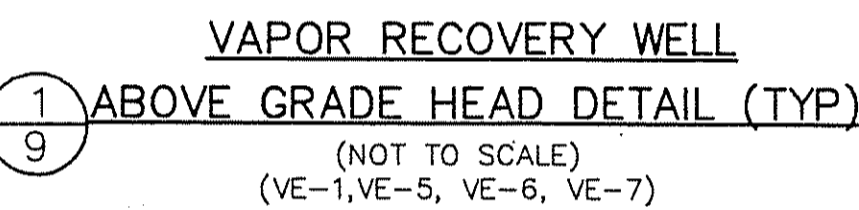CAD FILE NAME:
PLOT DATE: 1/26/95



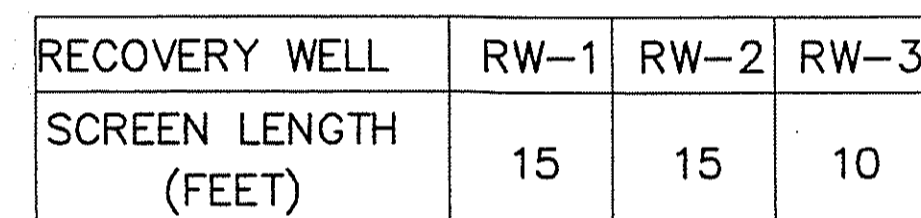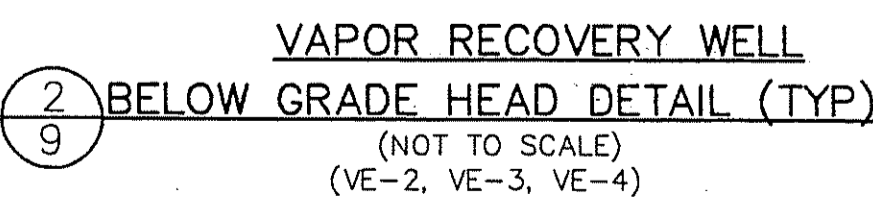
1. DOT COARSE SAND USED AS BACKFILL ABOVE AND BELOW AIR INJECTION AND VAPOR RECOVERY PIPE LATERALS.





3
9

GROUNDWATER RECOVERY WELL CONSTRUCTION DETAIL

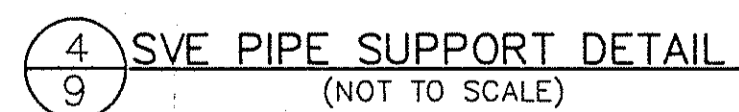
(NOT TO SCALE)



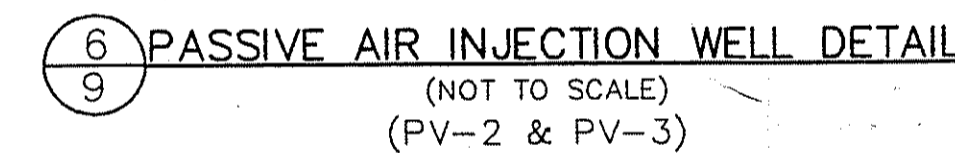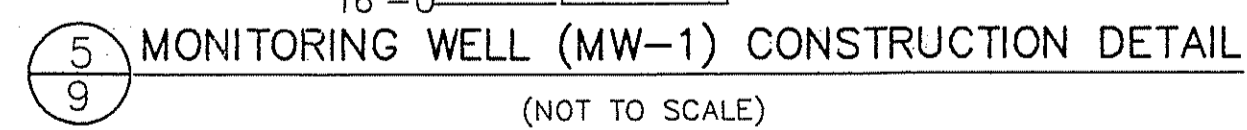
NOTE: OUTSIDE SUPPORT
WHERE WALL MOUNTED SUPPORT CAN NOT BE USED




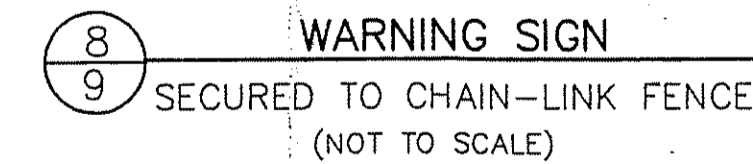7 PASSIVE AIR INJECTION WELL DETAIL
9 (NOT TO SCALE)
(PV-1)



| | | | | | | | | | |
|---|----------------|--|---------|---------------------------------------|--|--|--|----------------------|--|
|  | NAMES | | DATE | | GARAGE AREA WELL DETAILS AND GENERAL MISCELLANEOUS DETAILS | DUNN ENGINEERING COMPANY | | | |
| | DRAWN: | | 1/26/95 | | | DIVISION OF RUST ENVIRONMENT & INFRASTRUCTURE | | | |
| | DESIGN: ERM | | | | | | | | |
| | PROJ. MGR.:AWT | | 1/27/95 | | | | | | |
| | PROJ. ENG.:DDF | | 1/27/95 | | | | | | |
| | CHECKED: | | 1/27/95 | | | | | | |
| | SCALE: | | | | | | | | |
| AS SHOWN | | | | MARTIN MARIETTA FARRELL ROAD PLANT | | PROJECT NUMBER 38564.110 | | DATE 1/26/95 | |
| | | | | NEW YORK | | RUST DWG NUMBER 38564-05 | | REVISION NUMBER | |
| | | | | | | CLIENT DWG NUMBER | | SHEET NUMBER 9 OF 15 | |
| | | | | | | | | | |
| | | | | | | | | | |
| | | | | | | | | | |

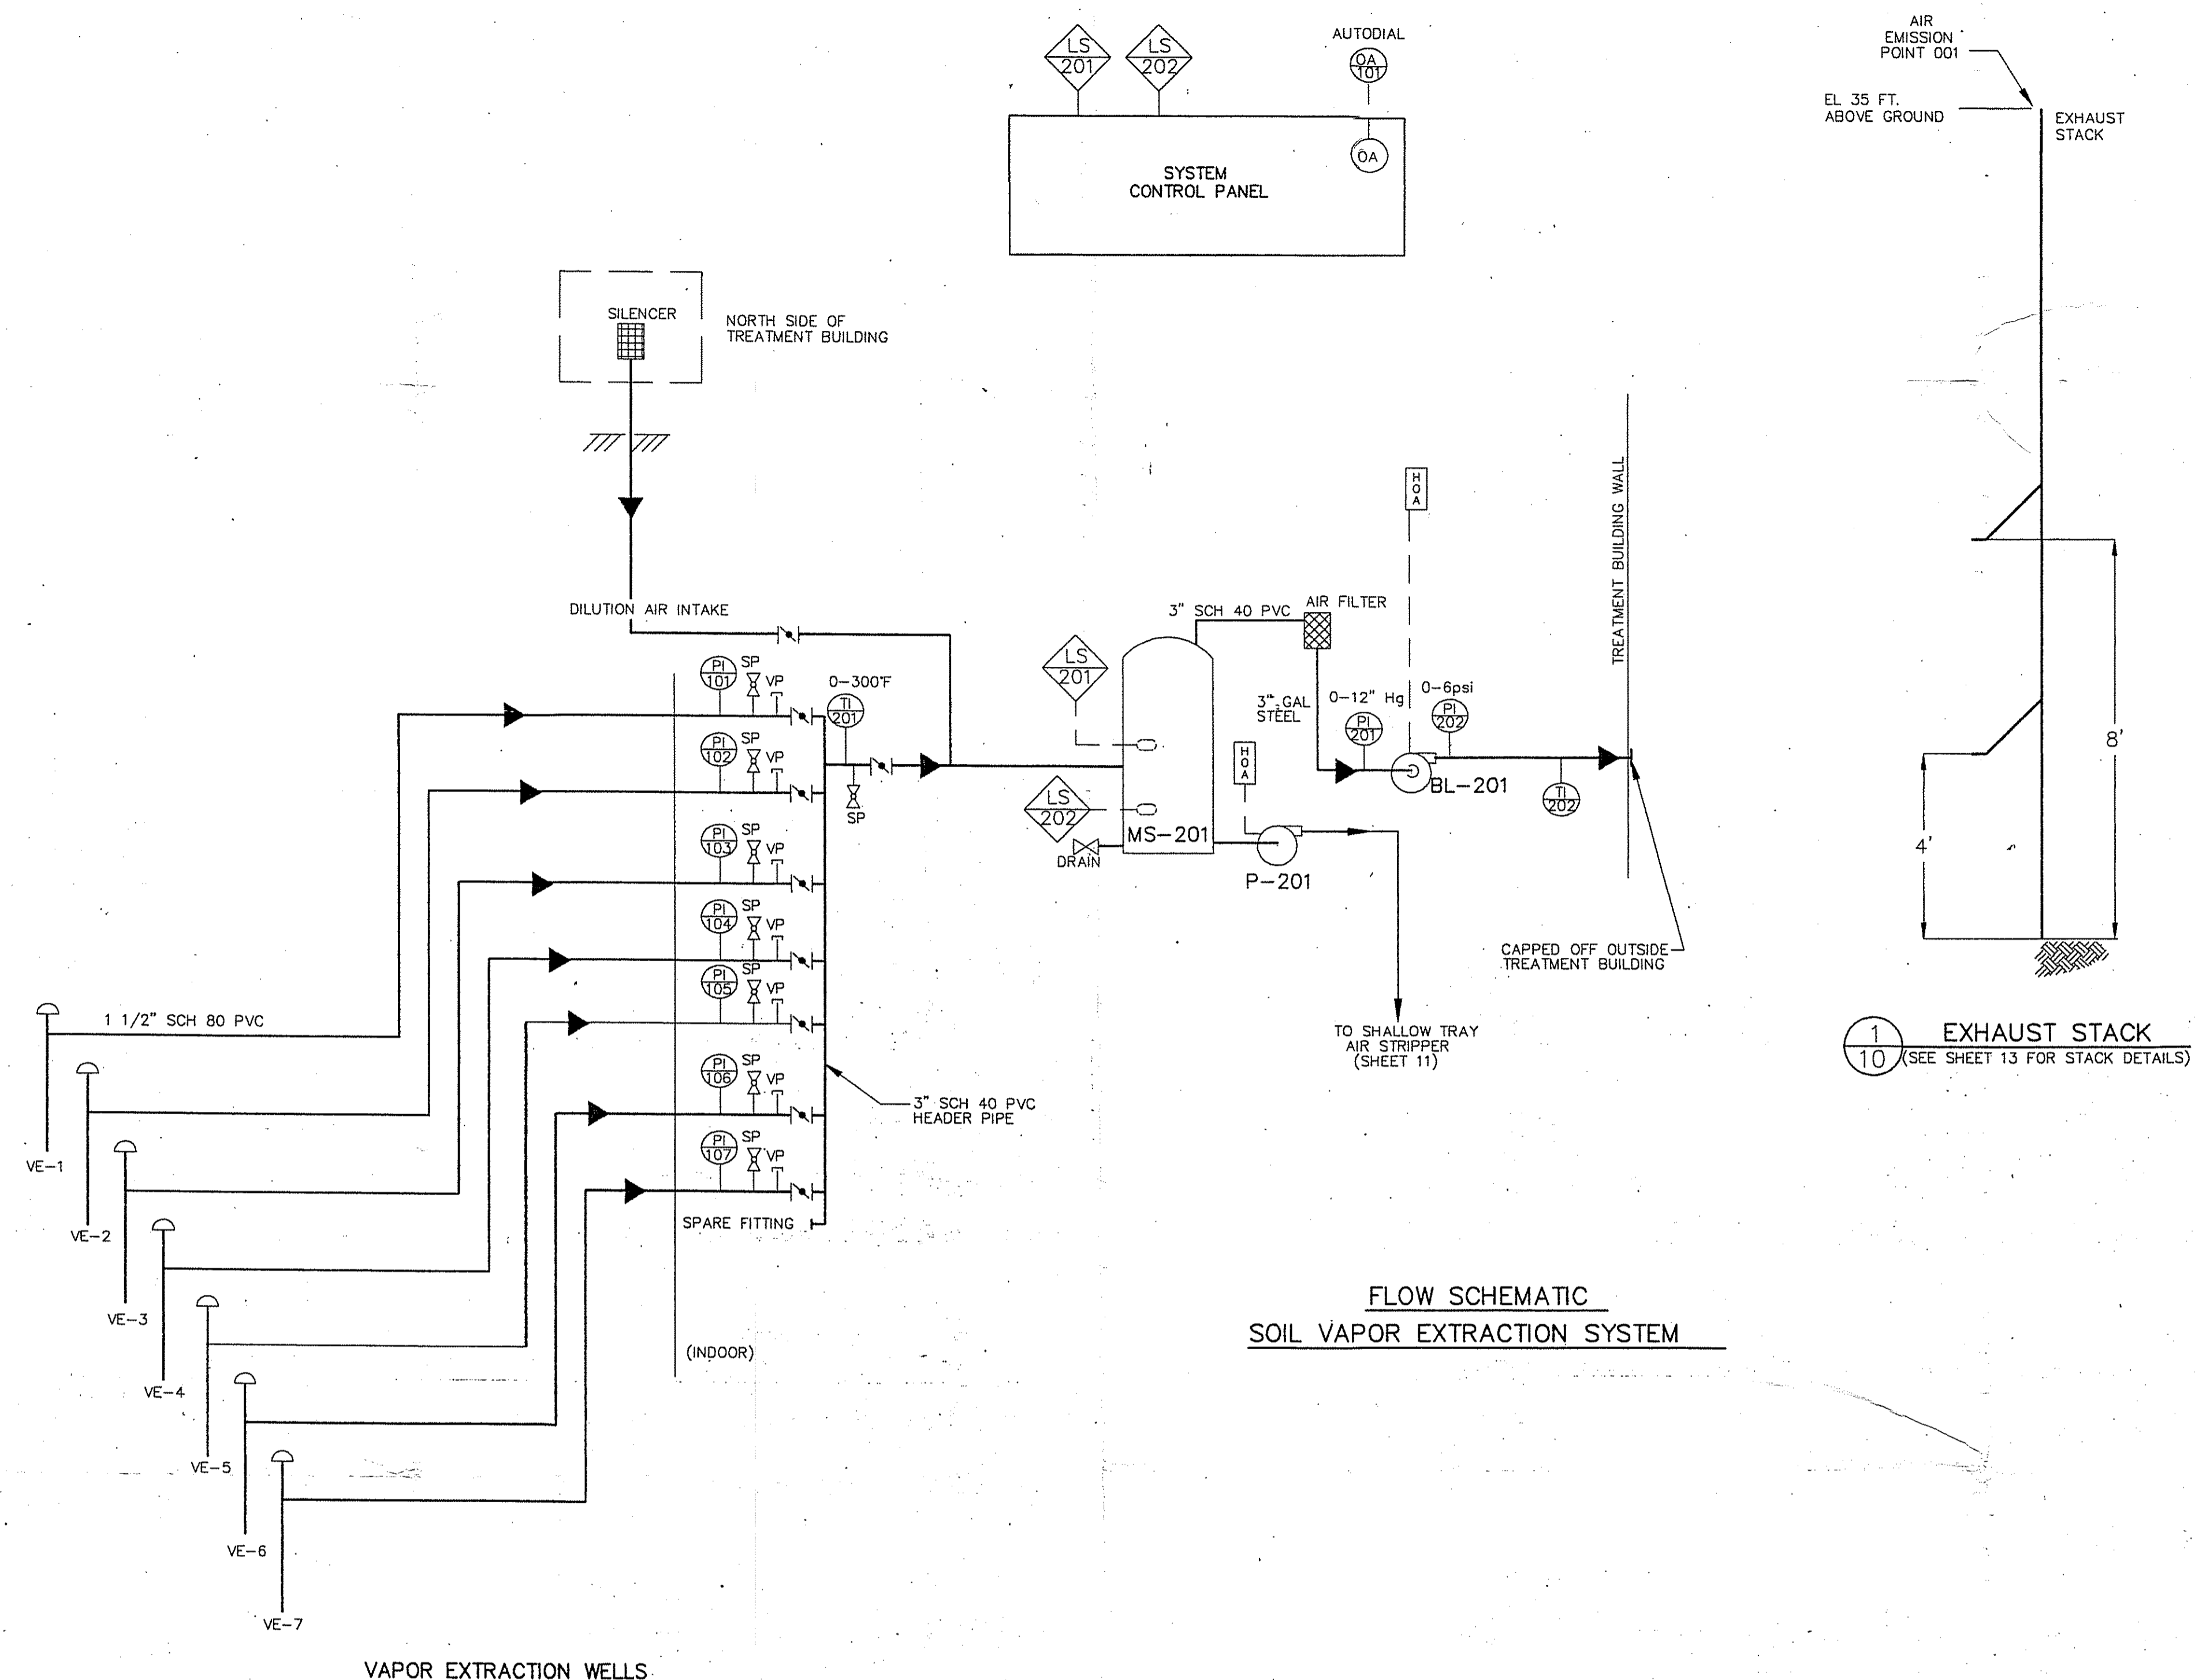The drawings, specifications and other documents prepared by the Engineer for this project are instruments of the Engineer's service for use solely with respect to this project and, unless otherwise provided, the Engineer shall be deemed the author of these documents and shall retain all common law, statutory and other reserved rights, including the copyright.



FLOW SCHEMATIC
SOIL VAPOR EXTRACTION SYSTEM

- NOTES:**
1. VACUUM GAUGES (PI-101 THROUGH PI-107) INSTALLED WITH 0-12 INCHES Hg AND 0-160 INCHES WATER.
 2. VAPOR EXTRACTION LATERALS INSTALLED AS 2 INCH SCH. 40 BELOW GRADE AND 1 1/2" SCH. 80 OUTSIDE GARAGE (ABOVE GRADE).
 3. EFFLUENT PIPE FROM SOIL VAPOR EXTRACTION NOT CONNECTED TO DISCHARGE STACK.

LEGEND

- (OA) SYSTEM ALARM AUTODIALER
- ◻ BUTTERFLY VALVE
- SP SAMPLE PORT
- ⋈ GATE VALVE
- H O A HAND-OFF-AUTO SWITCH
- VP VELOCITY MEASUREMENT PORT
- PI 101 PRESSURE OR VACUUM GAUGE
- TI 201 TEMPERATURE INDICATOR


INTERLOCK SCHEDULE

- LS 201 HIGH SEPARATOR WATER LEVEL SHUTS DOWN SYSTEM
- LS 202 HIGH-ON/LOW-OFF LIQUID LEVEL SWITCH PUMP OPERATOR (P-1) WITH MANUAL OVERRIDE SWITCH

EQUIPMENT

- MS-201 MOISTURE SEPARATOR
- P-201 CONDENSATE TRANSFER PUMP OBERDORFER CLOSE COUPLED ROTARY GEAR PUMP MODEL 991
- BL-201 REGENERATIVE BLOWER 5HP ROTRON MODEL 7073-XP

| |
|---|
| |</ |
|---|

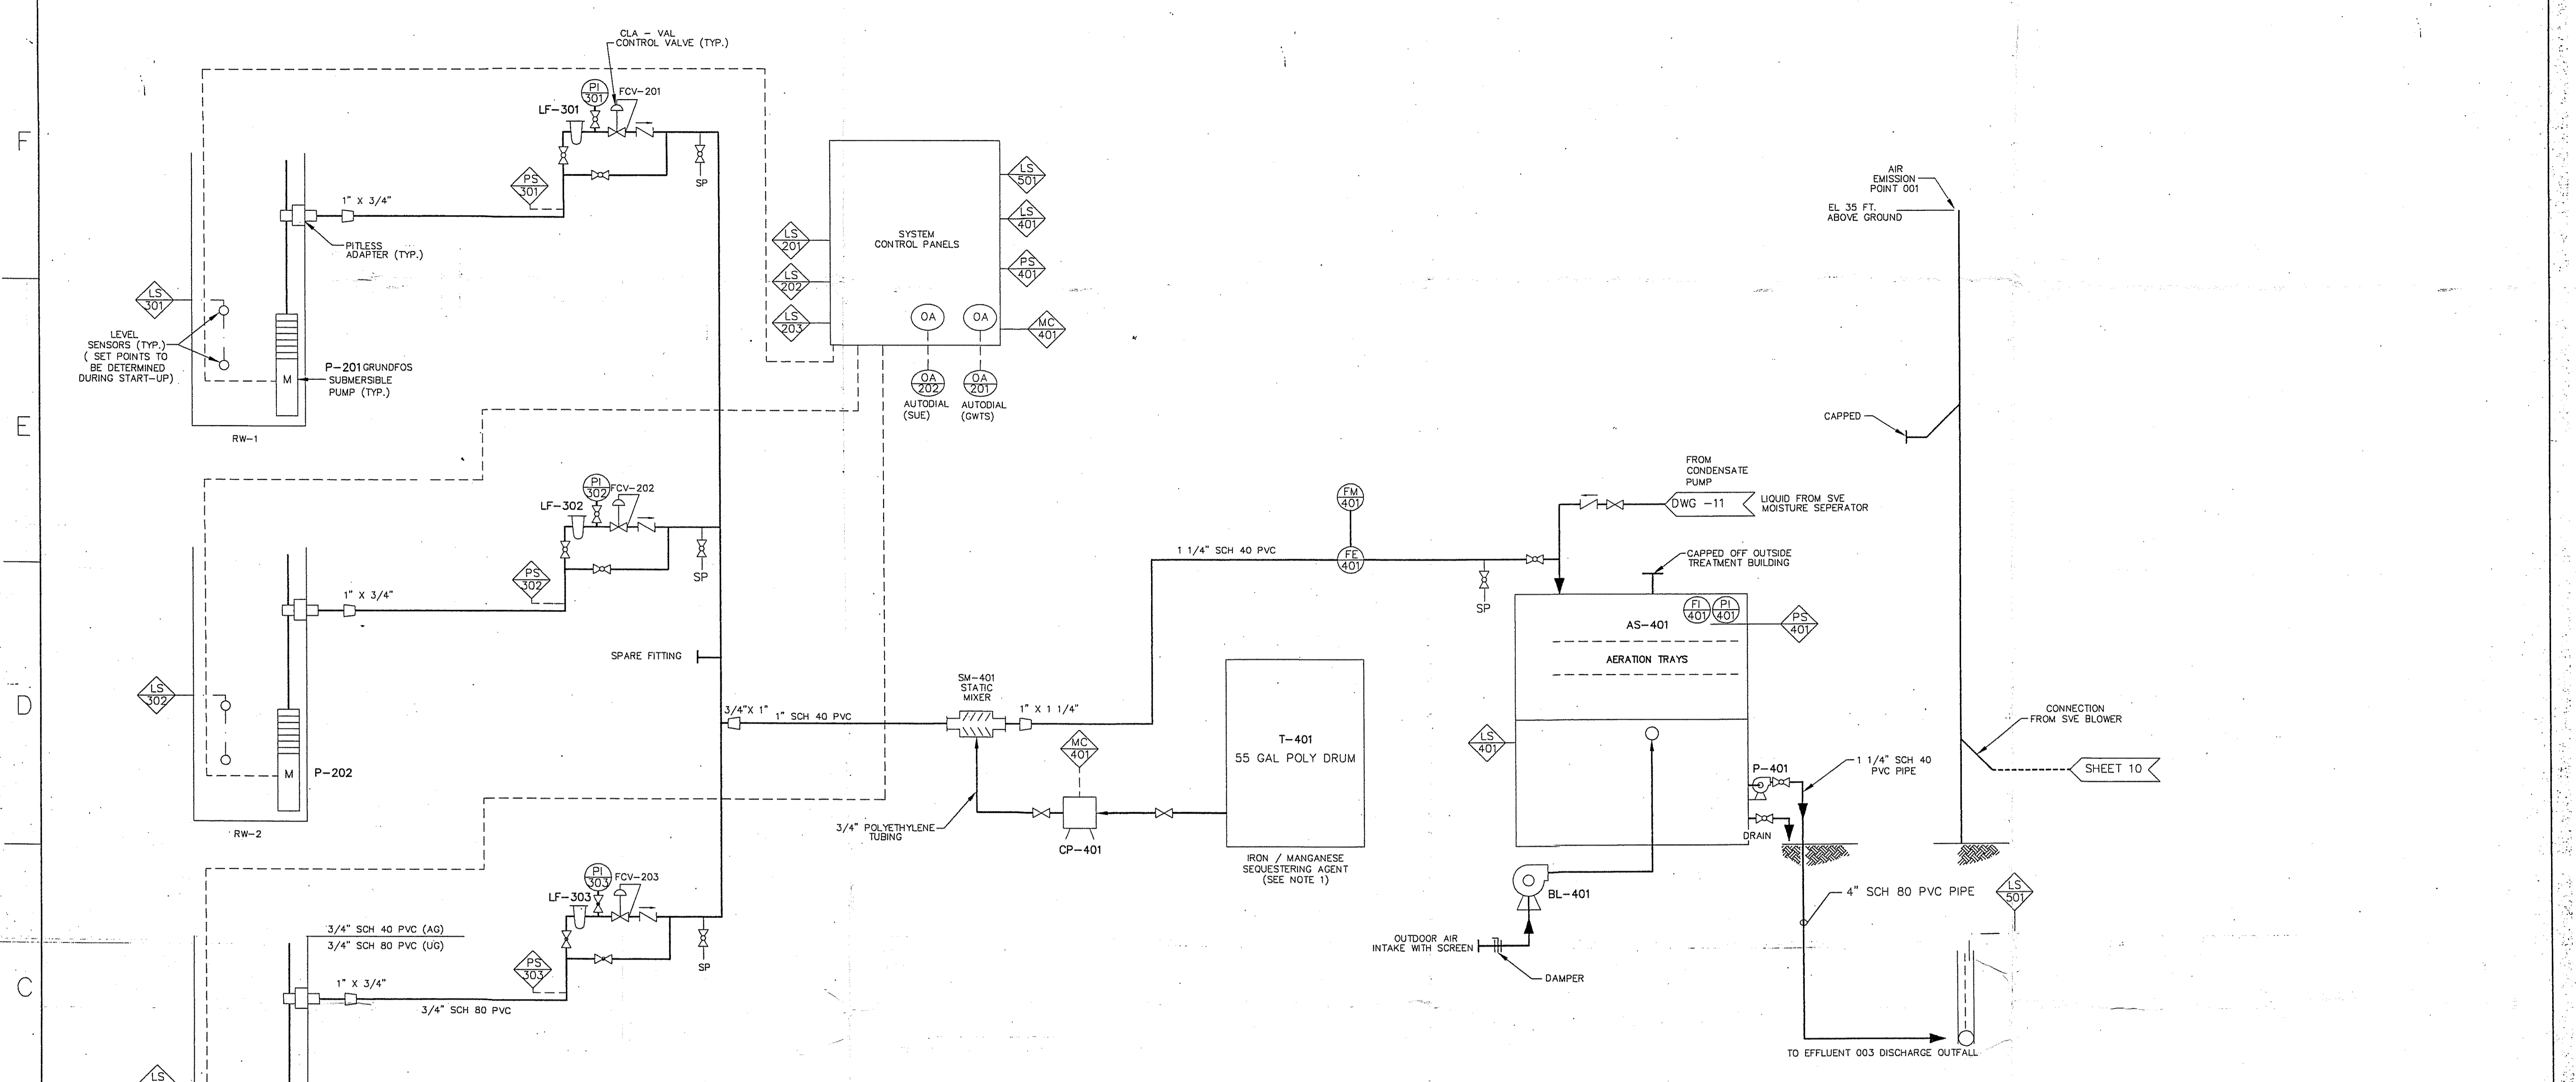

NOTES:
1. SEQUESTERING AGENT CONSISTS OF POLYCHEMICAL PRODUCTS ULTRATREAT C722S, APPROVED BY NYSDEC.


- LEGEND**
- PI 301 PRESSURE INDICATOR GAUGE
 - FM 401 FLOW METER (INDICATOR AND TOTALIZER)
 - FE 401 FLOW ELEMENT
 - FI 401 FLOW INDICATOR
 - FCV 401 FLOW CONTROL VALVE
 - HOA HAND-OFF-AUTO SWITCH
 - SP SAMPLE PORT
 - GATE VALVE
 - BALL VALVE
 - CHECK VALVE

- INTERLOCK SCHEDULE**
- LS 301, LS 302, LS 303: LEVEL SENSOR - WELL PUMP OPERATOR, TRANSDUCER/RELAY
 - PS 301, PS 302, PS 303: HIGH PRESSURE SHUT-OFF - SHUTS DOWN PUMP UPON HIGH PRESSURE IN PUMP DISCHARGE LINE, MERCOID SWITCH
 - LS 401: 3-POINT LEVEL SWITCHING - LOW LEVEL SHUTS DOWN P-401, HIGH LIQUID LEVEL, ACTIVATES P-401, HIGH-HIGH LEVEL IN AIR STRIPPER SUMP SHUTS DOWN RECOVERY WELLS TWO MERCURY FLOAT SWITCHES
 - PS 401: LOW AIR PRESSURE IN STRIPPER (L.T. 0.3"W.C.) SHUTS DOWN SYSTEM DWYER 1950-1 EXPLOSION PROOF
 - MC 401: MOTOR CONTROL - SHUT DOWN CHEMICAL FEED PUMP WHEN ALL THREE SUBMERSIBLE PUMPS ARE OFF
 - LS 501: SHUT DOWN ALL SUBMERSIBLE PUMPS ON OUTFALL HIGH LEVEL

- EQUIPMENT**
- P-201, P-202, P-203: GRUNDFOS REDI-FLO 4, 5gpm SUBMERSIBLE PUMP MODEL 5E, 1/3Hp, 240 VAC, 1ph
 - LF-201, LF-202, LF-203: LIQUID FILTER - BAG FILTER, 20gpm ROSEDALE MODEL 4-12
 - CP-401: CHEMICAL PUMP - LMI MODEL P14 0.1 - 1.0gph
 - BL-401: BLOWER - AMERICAN FAN COMPANY 3hp 240VAC, 3-ph, EXPL. SER. #AF15-1106-7 300 CFM min AT 14" W.C.
 - P-401: PUMP - DUNHAM BUSH 1hp TRANSFER PUMP MODEL R5- 1 INCH DISCHARGE, 3 7/8" IMPELLOR 240VAC, 3-ph, EXPL. 15gpm AT 50' TDH
 - AS-401: AIR STRIPPER - SHALLOW TRAY 8gpm 3-TRAY 304 L SS WITH WELDED STEEL FRAME

A


| |
|---|
| |
|---|

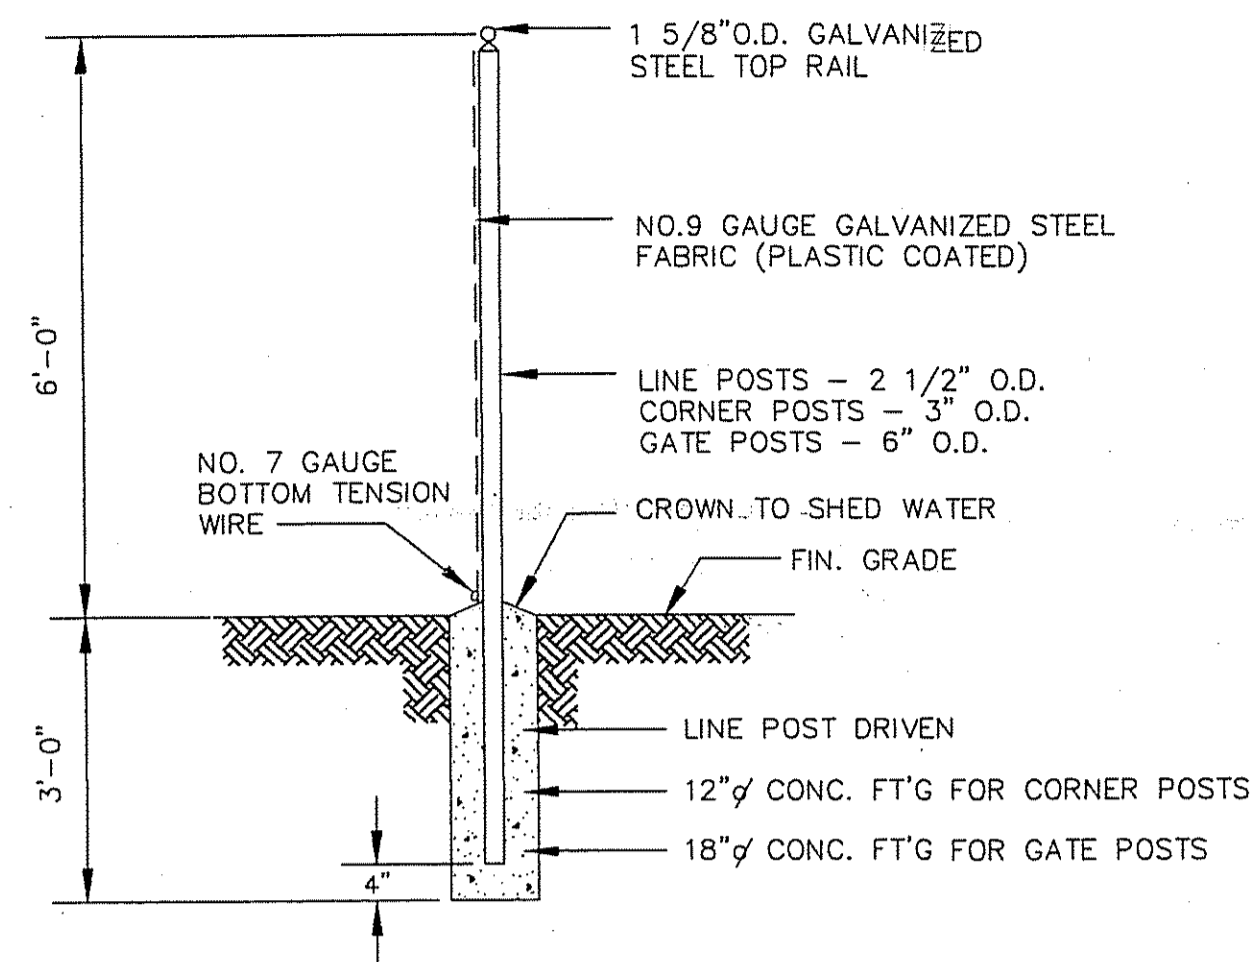


1
12
TYPICAL FENCE DETAIL
NO SCALE

NOTES:

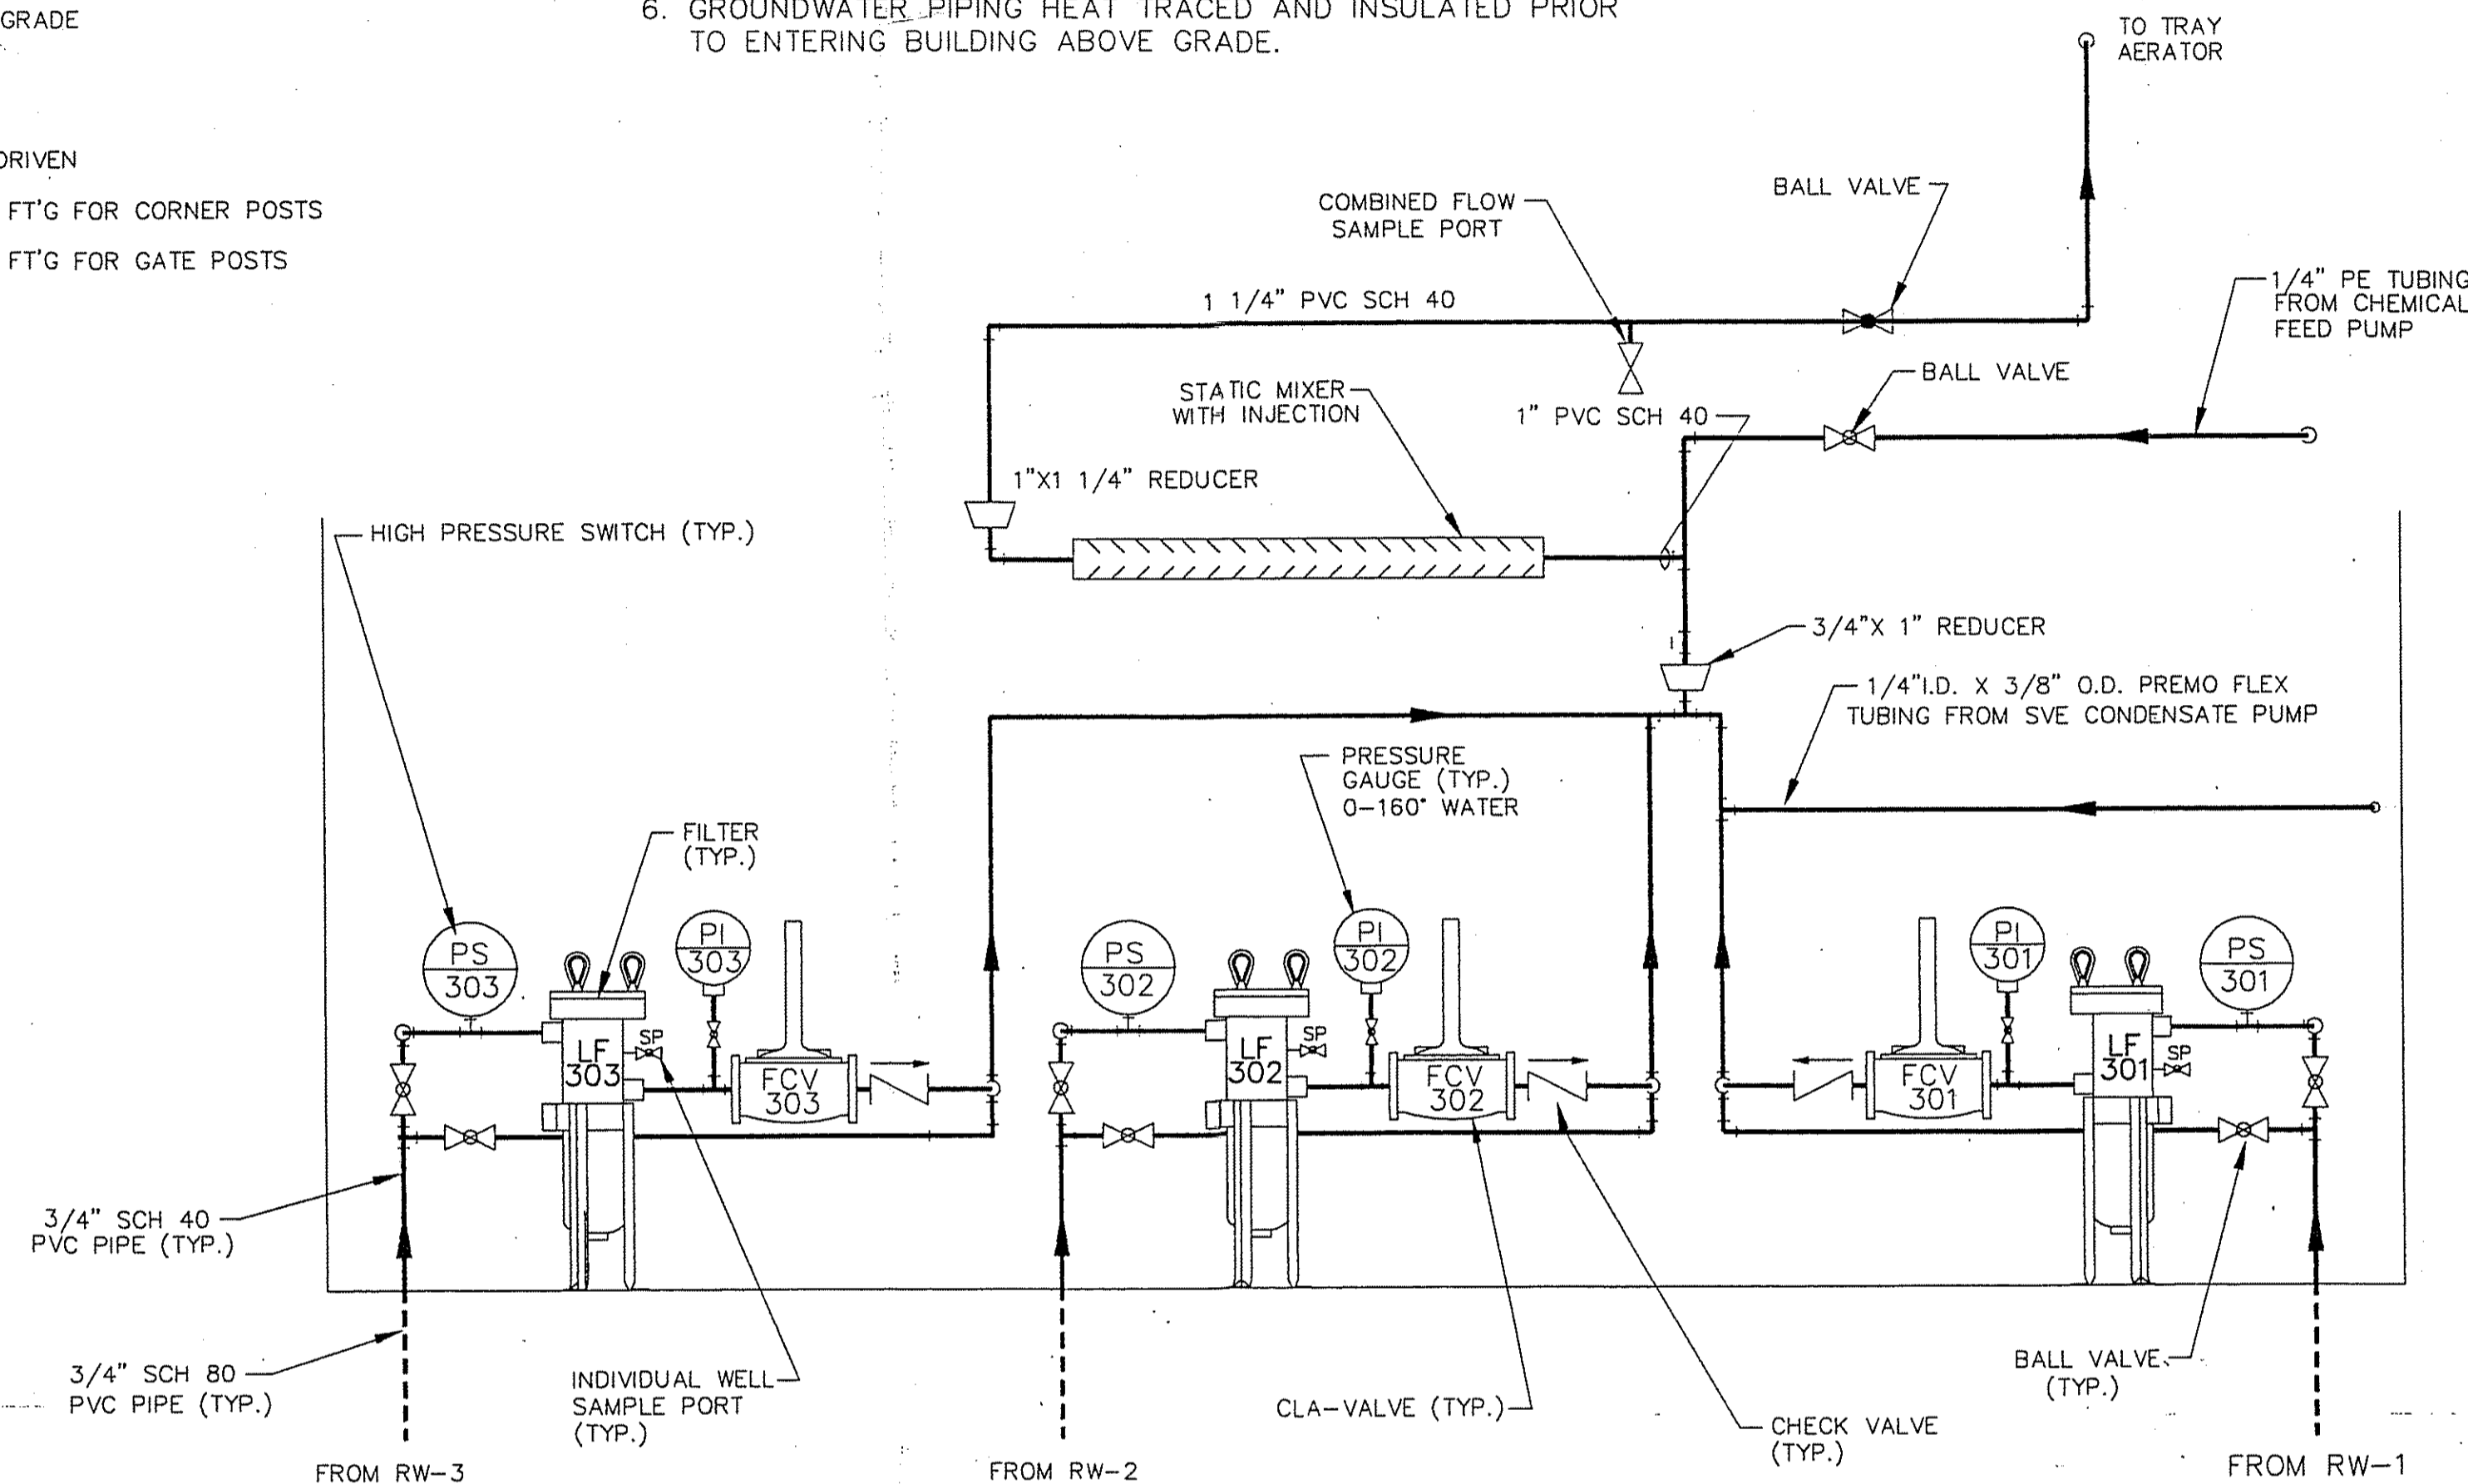- PIPE SUPPORTS MOUNTED TO UNISTRUT PIPE SUPPORTS BOLTED TO FLOOR
- PIPELINE EQUIPMENT SUCH AS FILTERS AND CONTROL VALVES FASTENED TO FLOOR OR SUPPORTED BY UNISTRUT.
- VALVES, REDUCERS, PLUGS NOT TO SCALE.
- ALL EQUIPMENT LOCATED INSIDE TREATMENT BUILDING IS EXPLOSION PROOF OR INTRINSICALLY SAFE RATED FOR OPERATION IN CLASS 1, DIV. 2 ATMOSPHERE.
- ALL CONTROL PANELS MOUNTED ON EAST EXTERIOR BUILDING WALL.
- GROUNDWATER PIPING HEAT TRACED AND INSULATED PRIOR TO ENTERING BUILDING ABOVE GRADE.



GC
12
SECTION
SCALE: 1\"/>

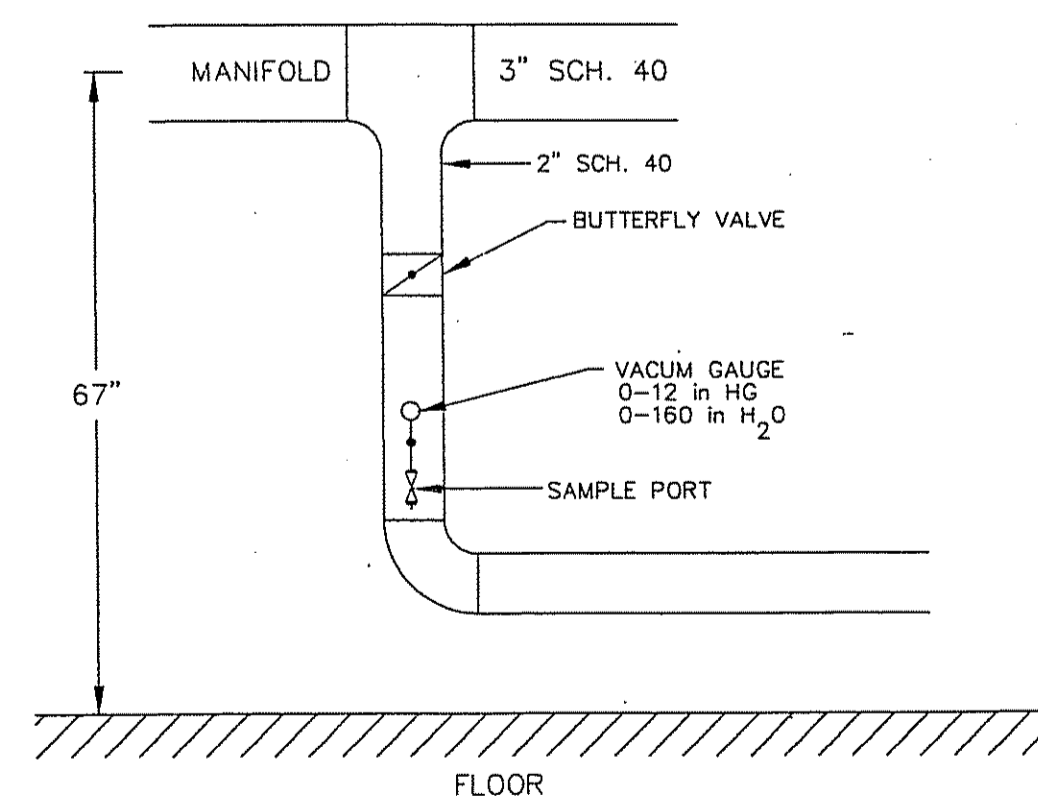

2
12
TYPICAL VAPOR EXTRACTION PIPE CONNECTION TO MANIFOLD
NO SCALE

GENERAL NOTE CONCRETE

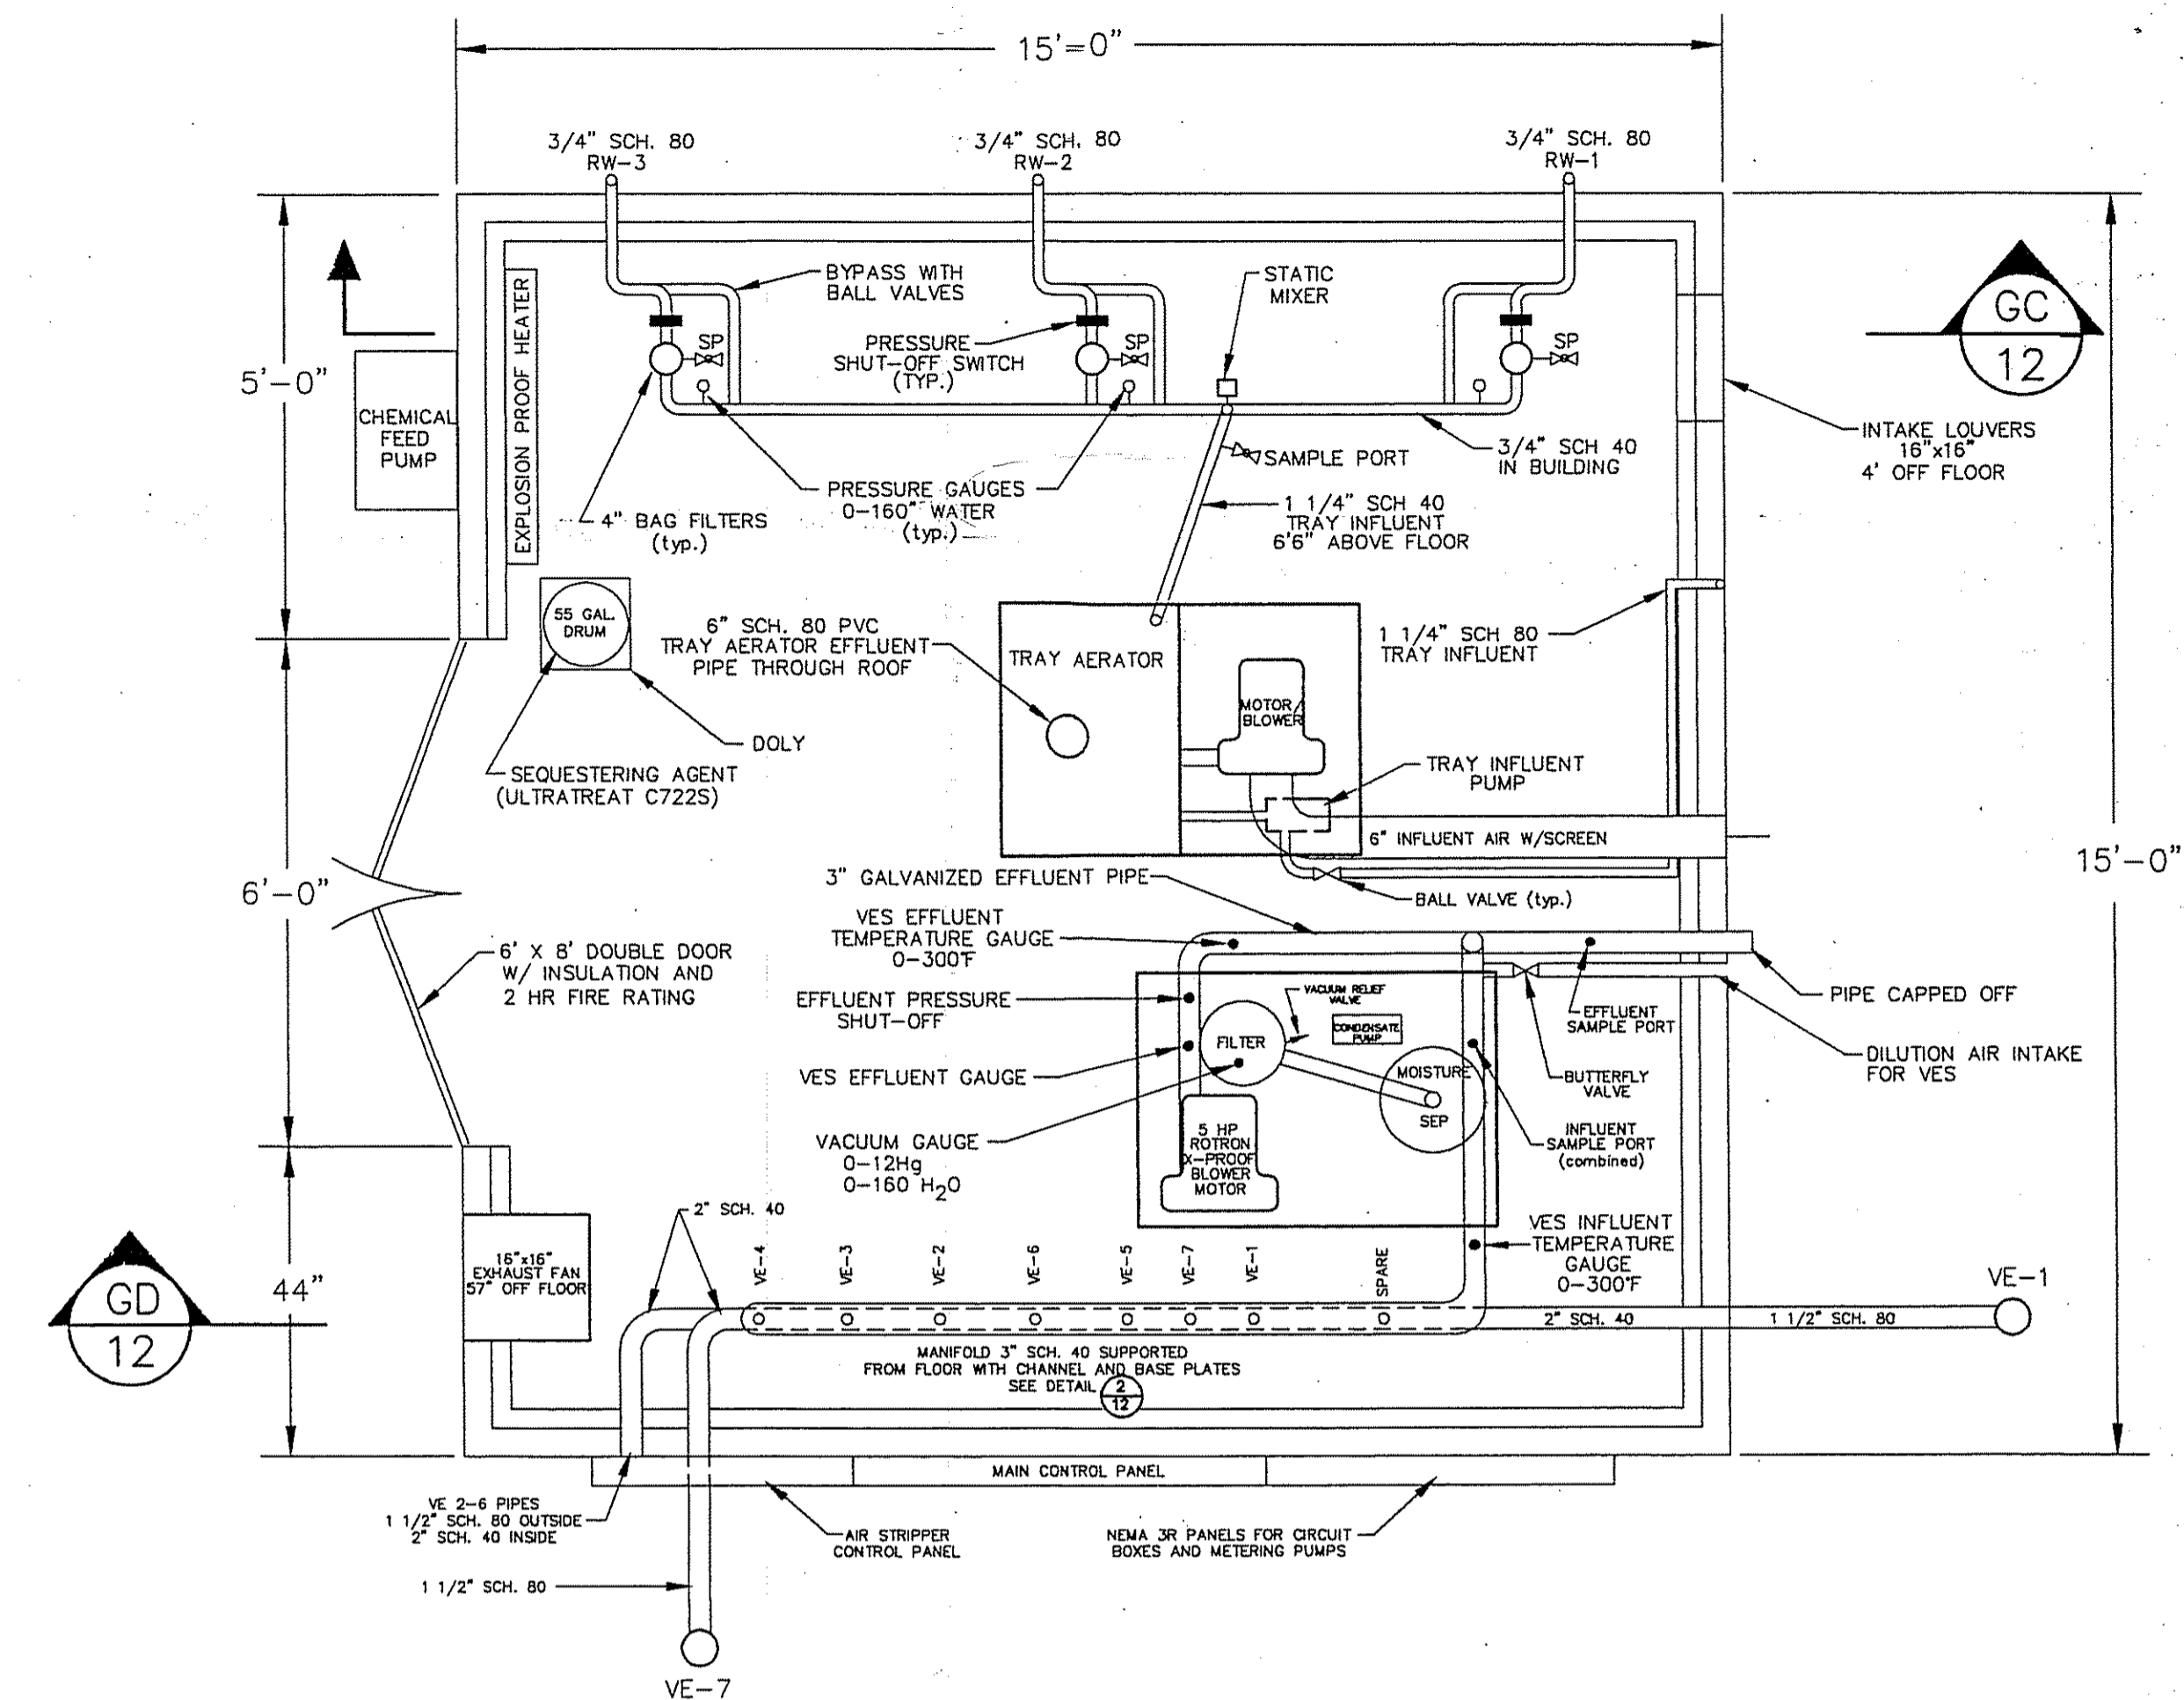
- THE CONCRETE USED OBTAINED MINIMUM COMPRESSIVE STRENGTH OF $f'_c = 4,000$ P.S.I. AT 28 DAYS.
- CHAMFERED ALL EXPOSED CONC. EDGES (ONE) 1" INCH
- CONCRETE NOT POURED ON MUDDY OR FROZEN GROUND.
- CONCRETE MIX AT POINT OF PLACEMENT WAS AT TEMPERATURE LESS THAN 85°F. CONCRETE MIX MINIMUM TEMPERATURE OF 50 F. OR OVER
- POLYPROPYLENE FIBRILLATED FIBER (70,000 P.S.I.) ADDED INTO CONC. MIX TO REDUCE PLASTIC CONC. SHRINKAGE. (APPROXIMATELY 1.5 LBS. OF FIBER/C.Y. OF CONCRETE)

SOIL:


- THE ENTIRE SOIL AREA UNDER CONC. PAD UNIFORMLY COMPACTED USING PLATE TAMPER. MINIMUM ALLOWABLE SOIL BEARING = 2,500 P.S.F. (or greater).

METAL BUILDING

- THE DESIGN LOADING OF METAL STRUCTURE SHALL BE IN ACCORDANCE WITH OFFICIAL COMPILATION OF CODES, RULES AND REGULATIONS OF THE STATE OF NEW YORK.



BUILDING PLAN VIEW
SCALE: 1/2\"/>

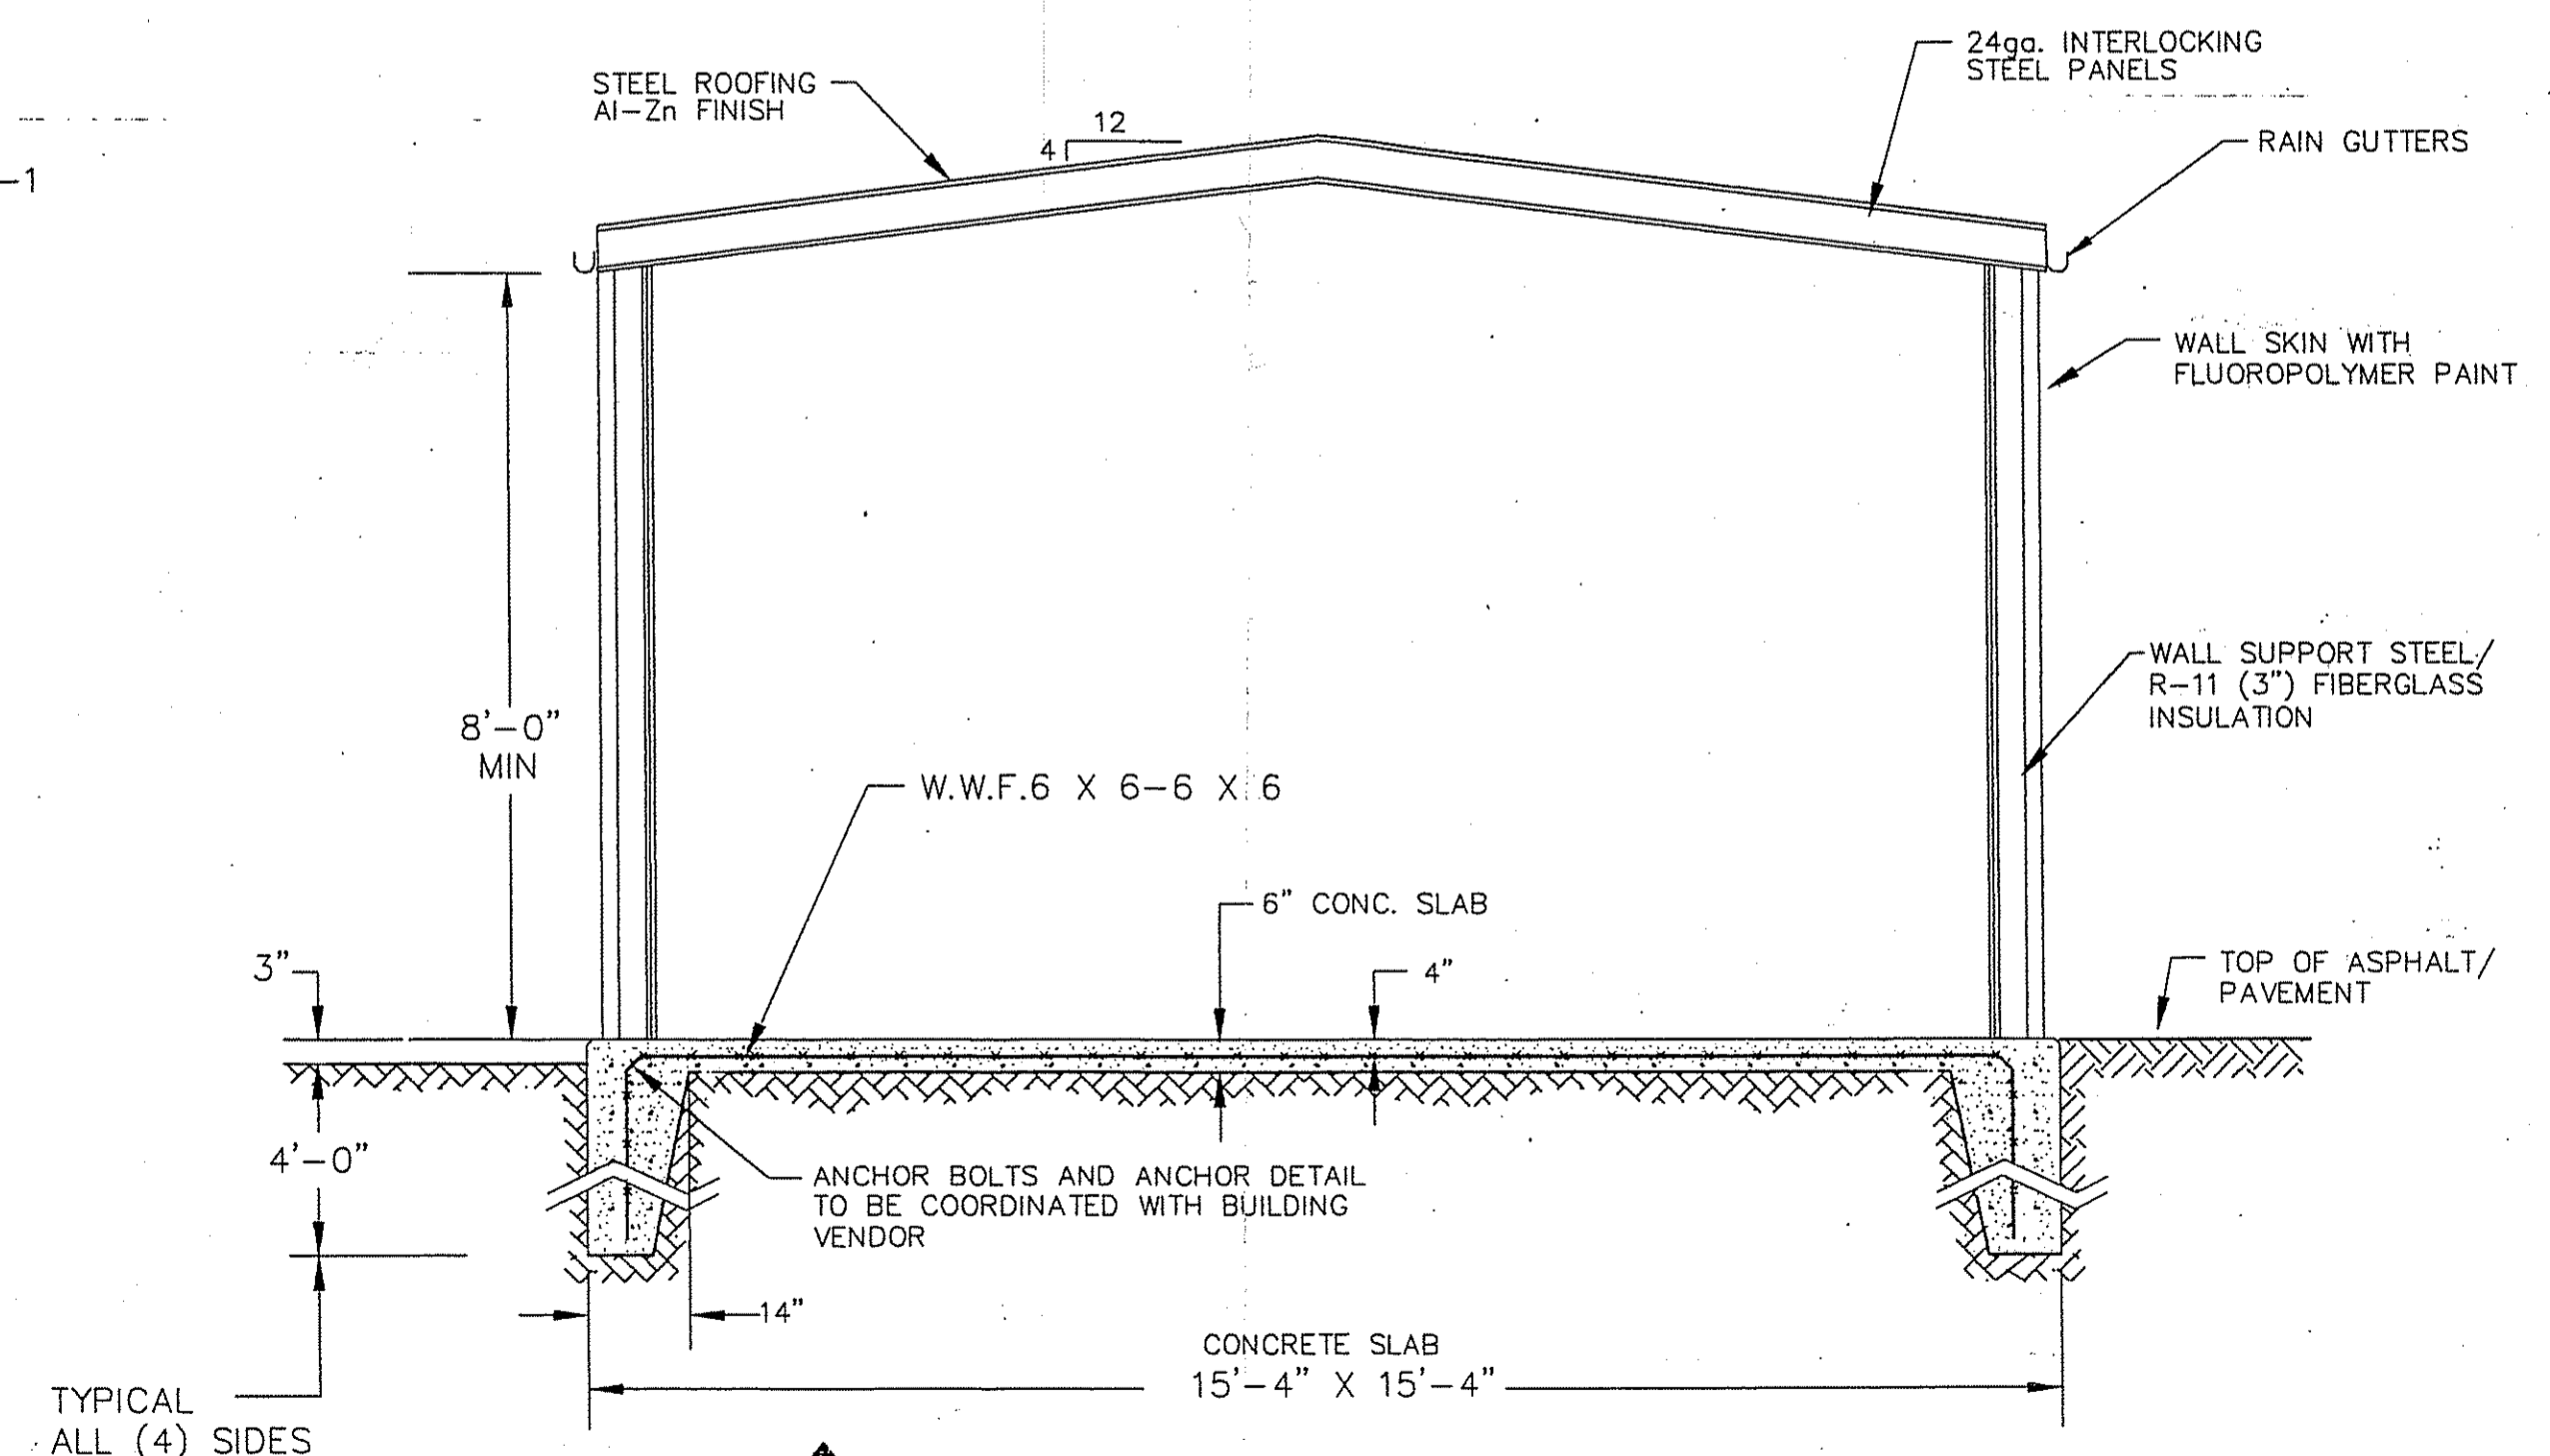


GC
12
SECTION
SCALE: 1/2\"/>

| NO. | REVISIONS | MADE | CHK | DATE | NO. | REVISIONS | MADE | CHK | DATE |
|-----|-----------|------|-----|------|-----|-----------|------|-----|------|
| | | | | | | | | | |
| | | | | | | | | | |
| | | | | |
|--|------------------|---------|--|---|
| | NAMES | DATE | GARAGE AREA TREATMENT BUILDING AND CIVIL DETAILS MARTIN MARIETTA FARRELL ROAD PLANT NEW YORK | DUNN ENGINEERING COMPANY DIVISION OF RUST ENVIRONMENT & INFRASTRUCTURE |
| | DRAWN: ERM | 1/27/95 | | |
| | DESIGN: ERM | 1/27/95 | | |
| | PROJ. MGR.: AWT | 1/27/95 | | |
| | PROJ. ENG.: DDF | 1/27/95 | | |
| | CHECKED: 1/27/95 | | | |
| | SCALE: AS NOTED | | | |
| | | | | |
| | | | | |
| | | | | |
| | | | | |

The drawings, specifications and other documents prepared by the Engineer for this project are instruments of the Engineer's service for use solely with respect to this project and, unless otherwise provided, the Engineer shall be deemed the author of these documents and shall retain all common law, statutory and other reserved rights, including the copyright.

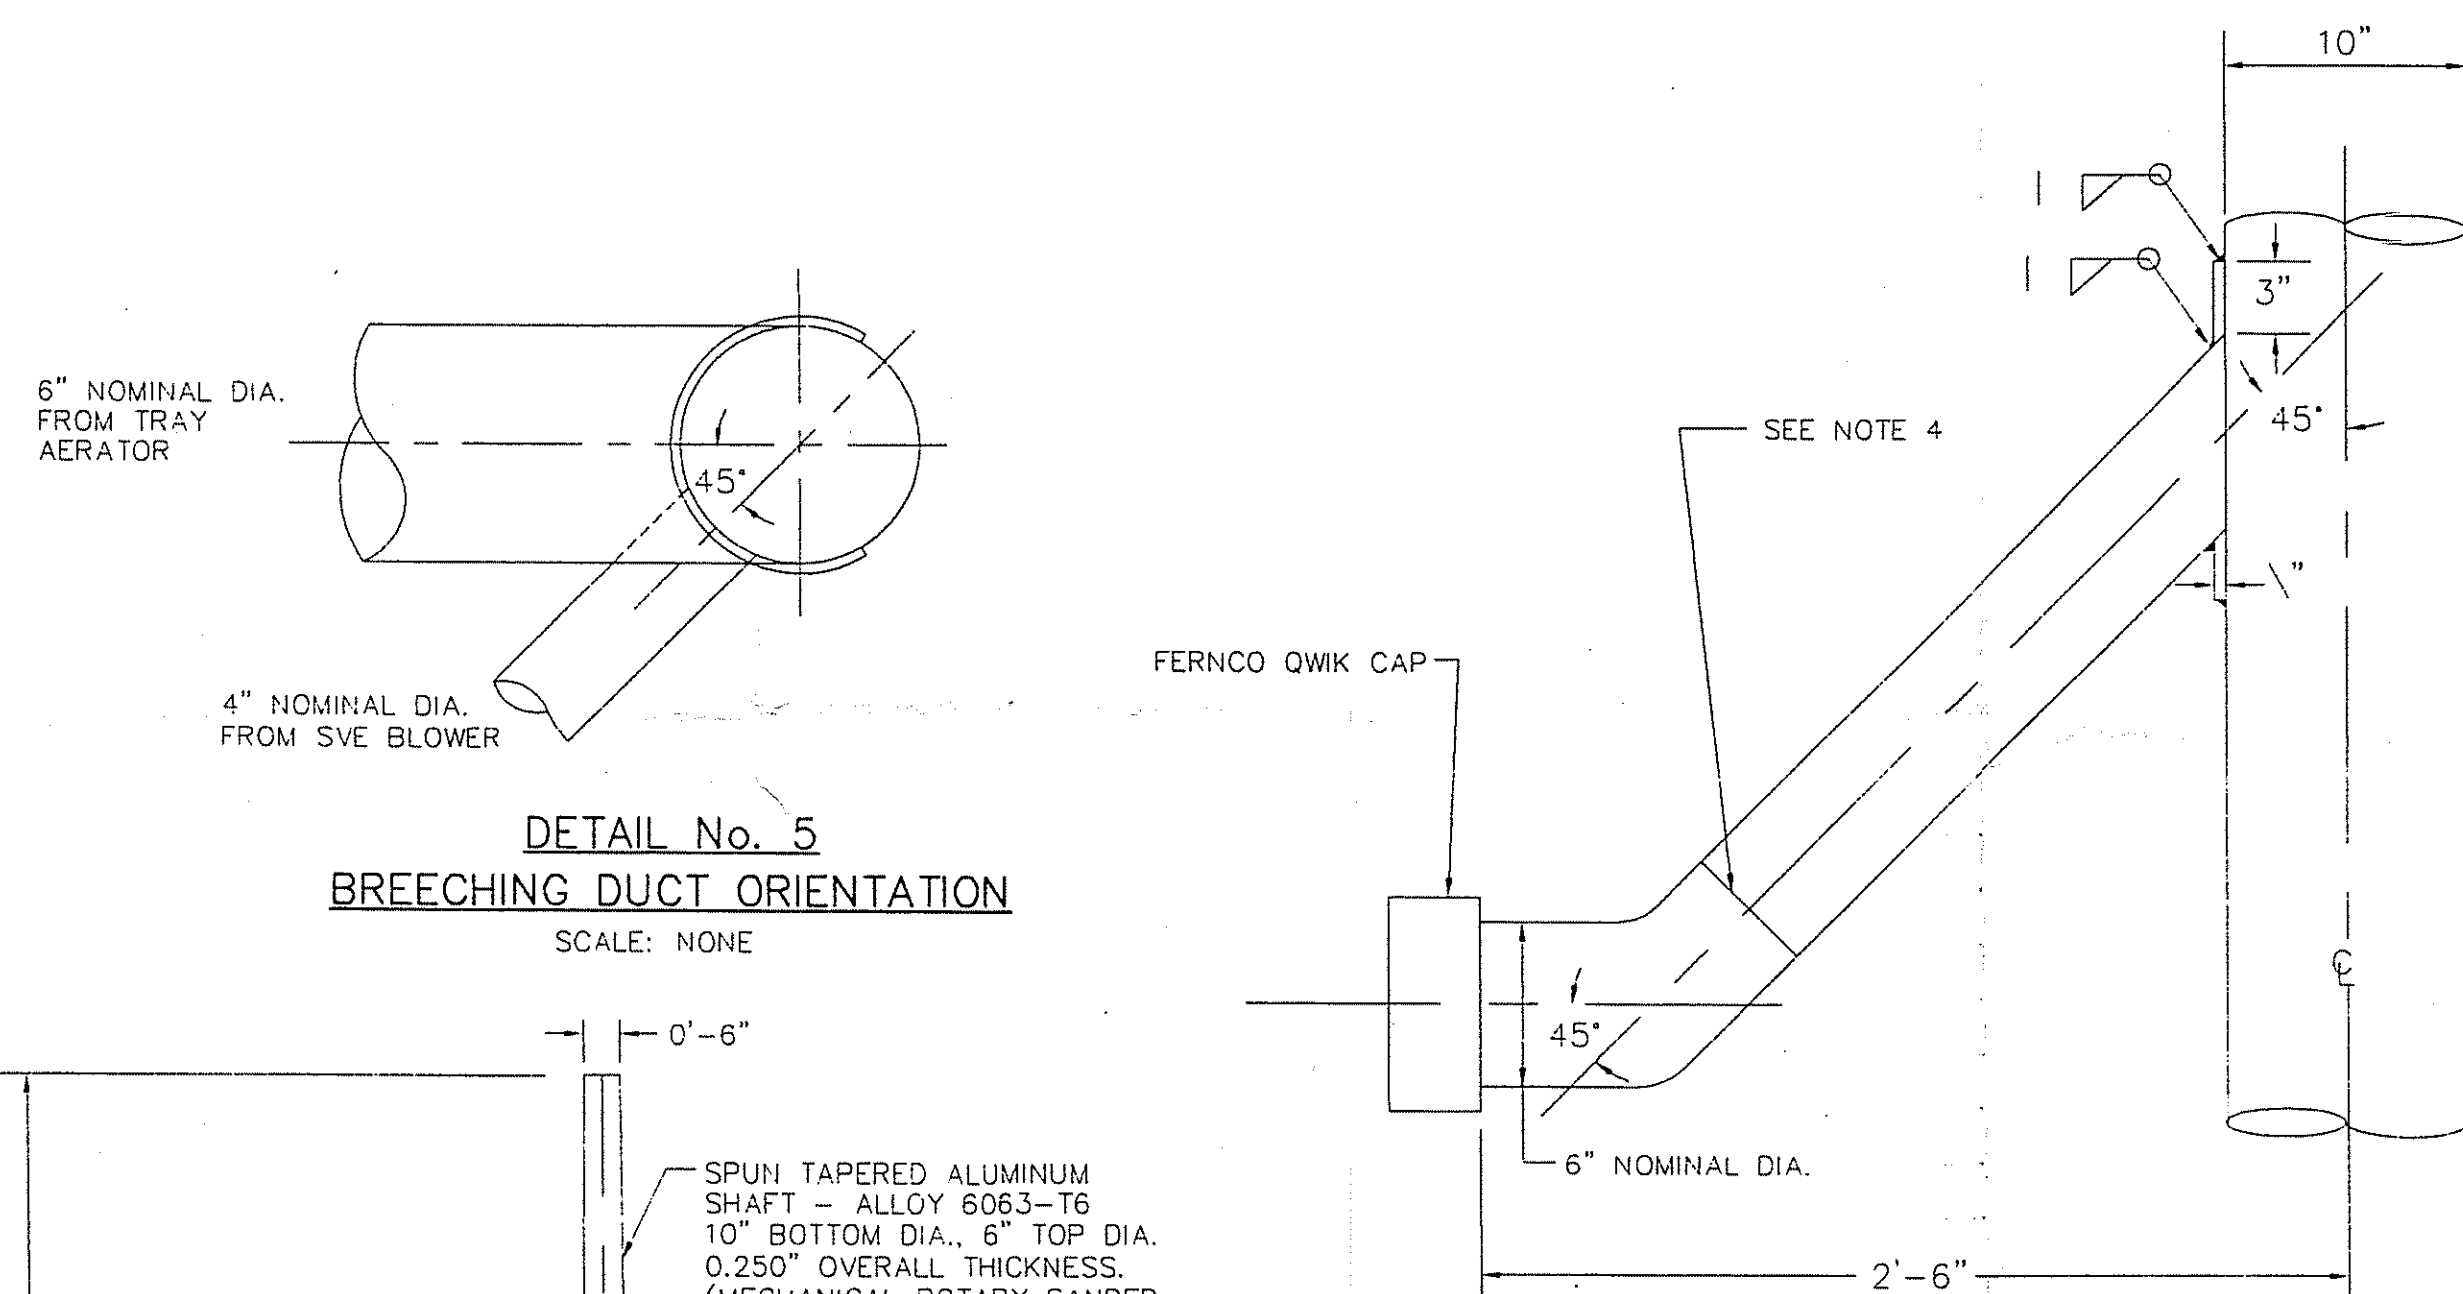
CAD FILE NAME:
PLOT DATE: 1/27/95



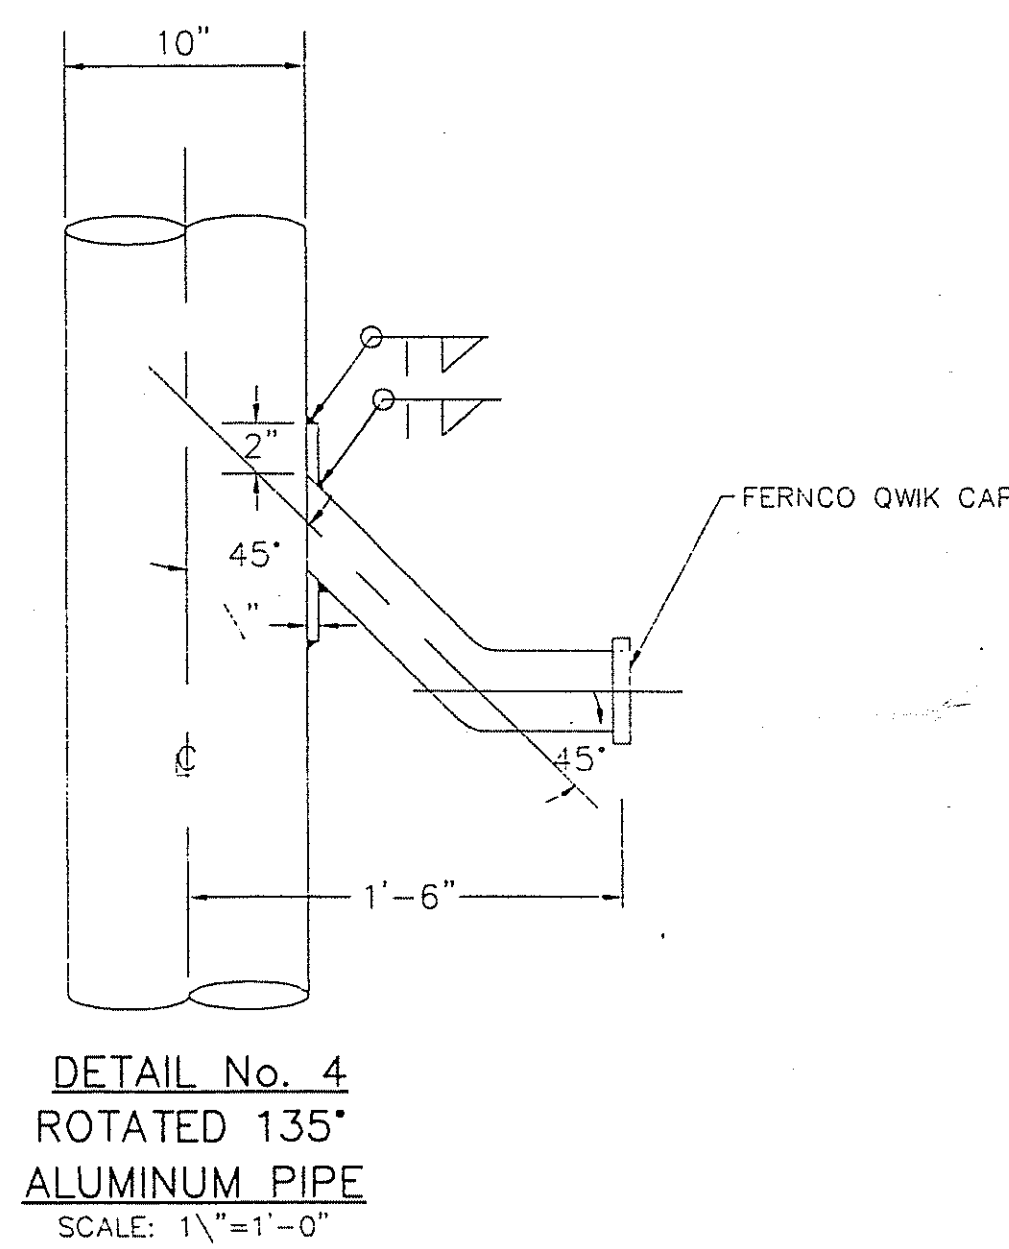DETAIL No. 5
BREECHING DUCT ORIENTATION
SCALE: NONE




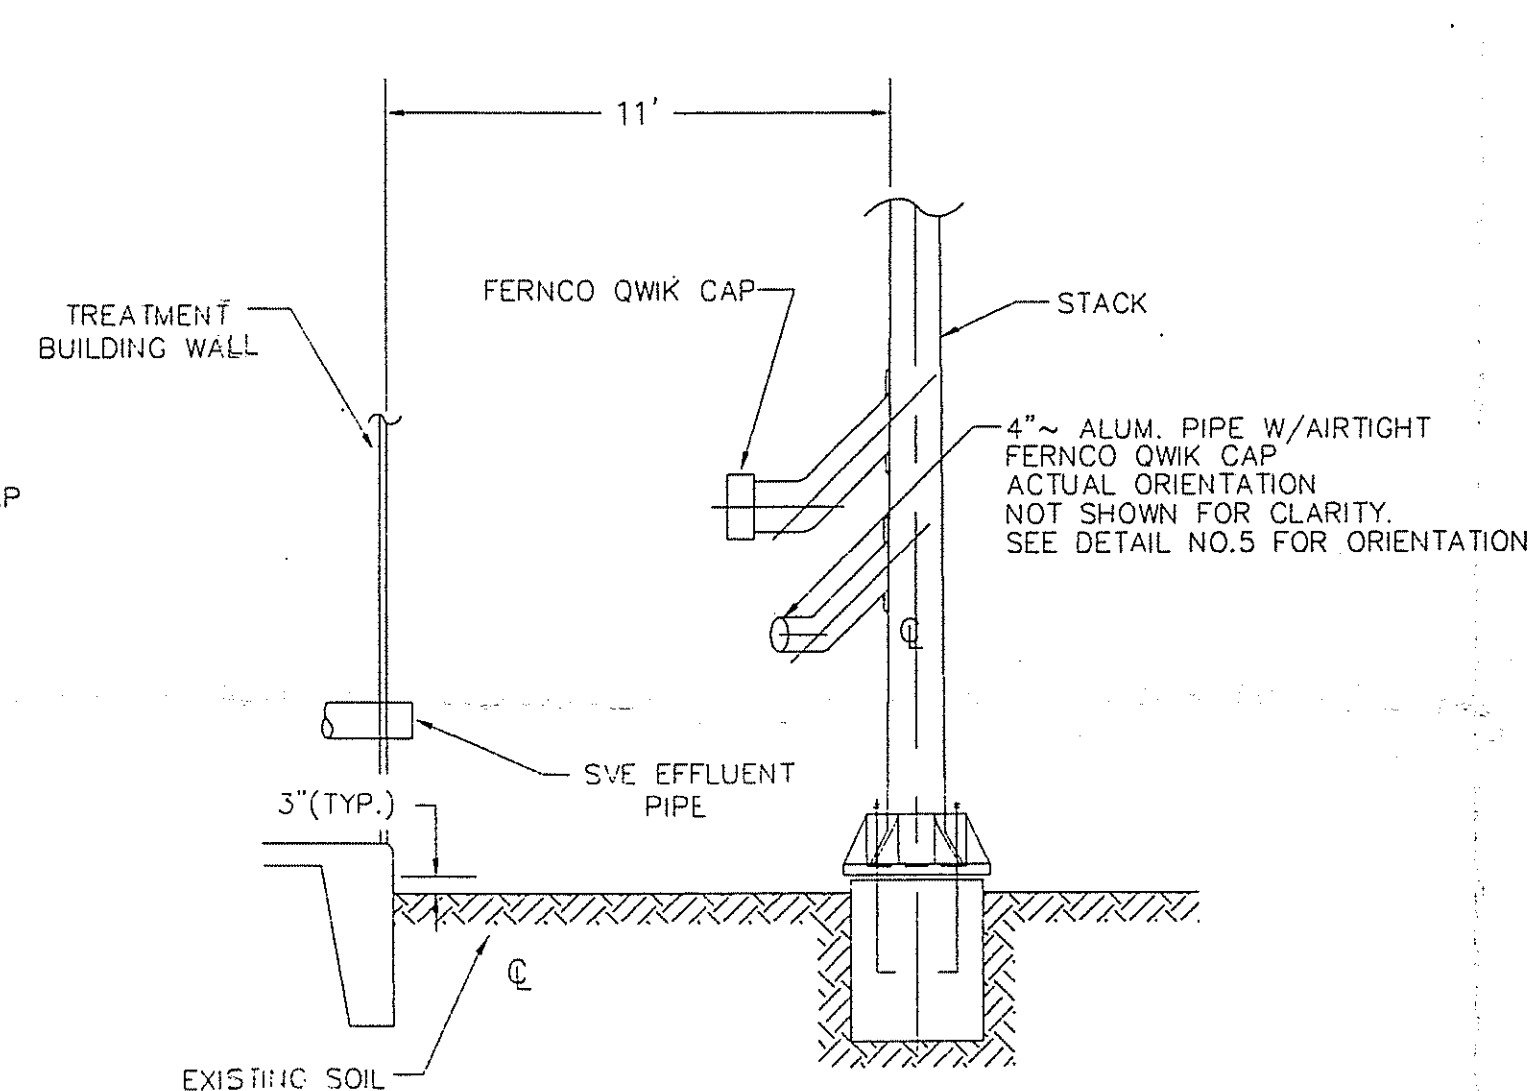DETAIL No. 4
ROTATED 135°
ALUMINUM PIPE
SCALE: 1"=1'-0"




SUPPORT DETAILS

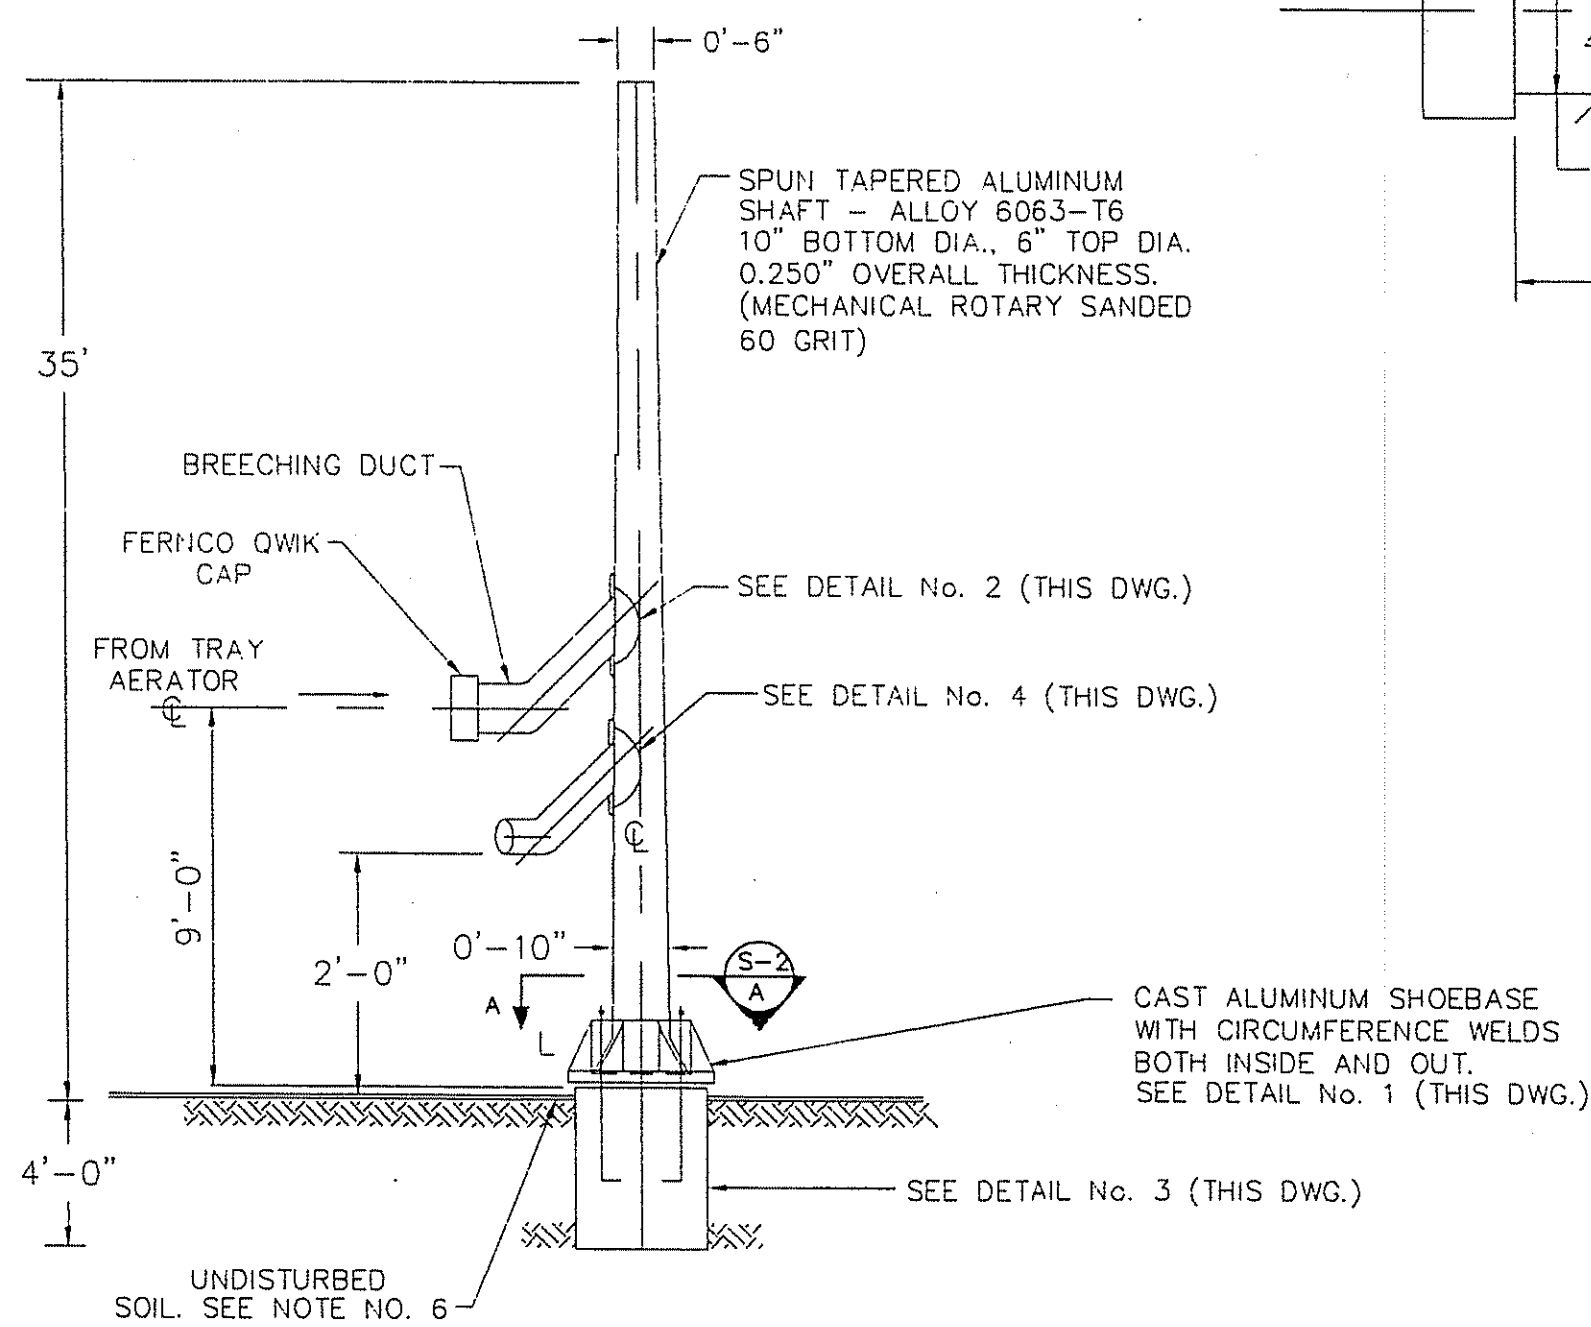
SCALE: NONE




STACK ELEVATION 1
SCALE: NONE 13

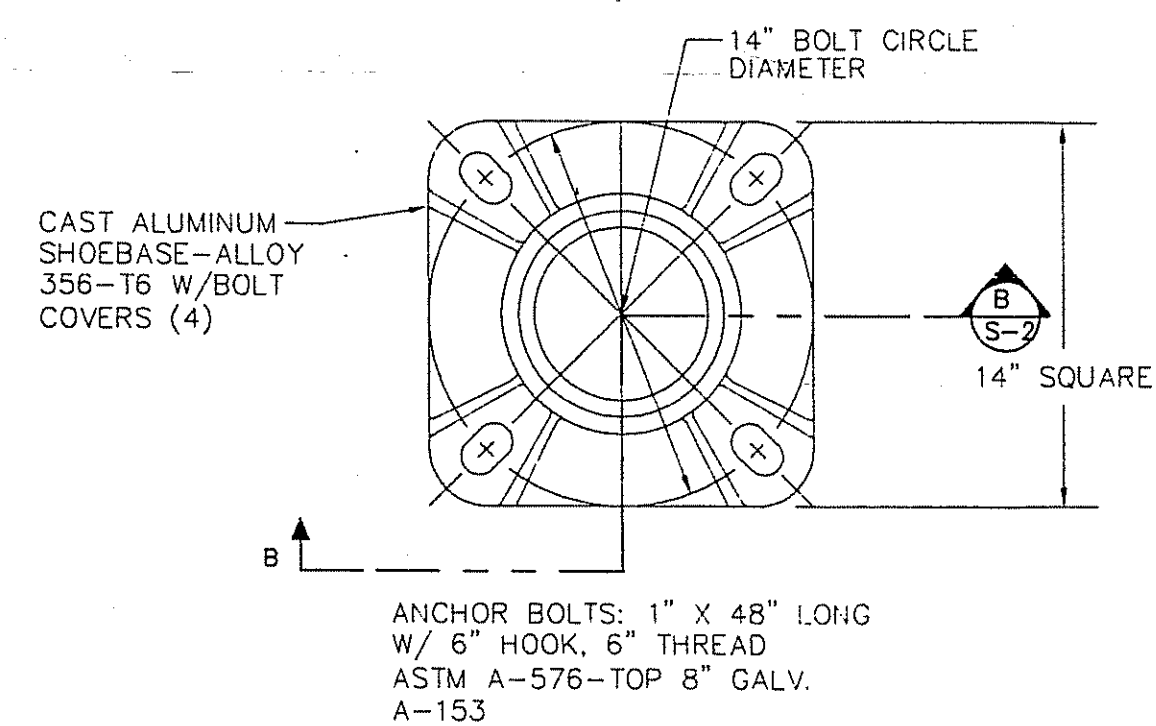


SECTION A-A
S-2

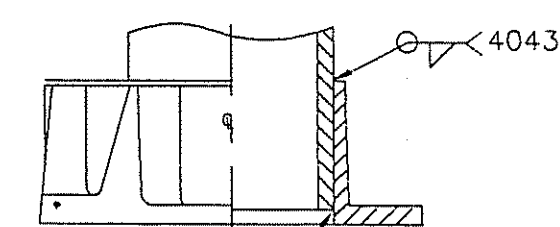




SECTION B-B
NOT TO SCALE S-2

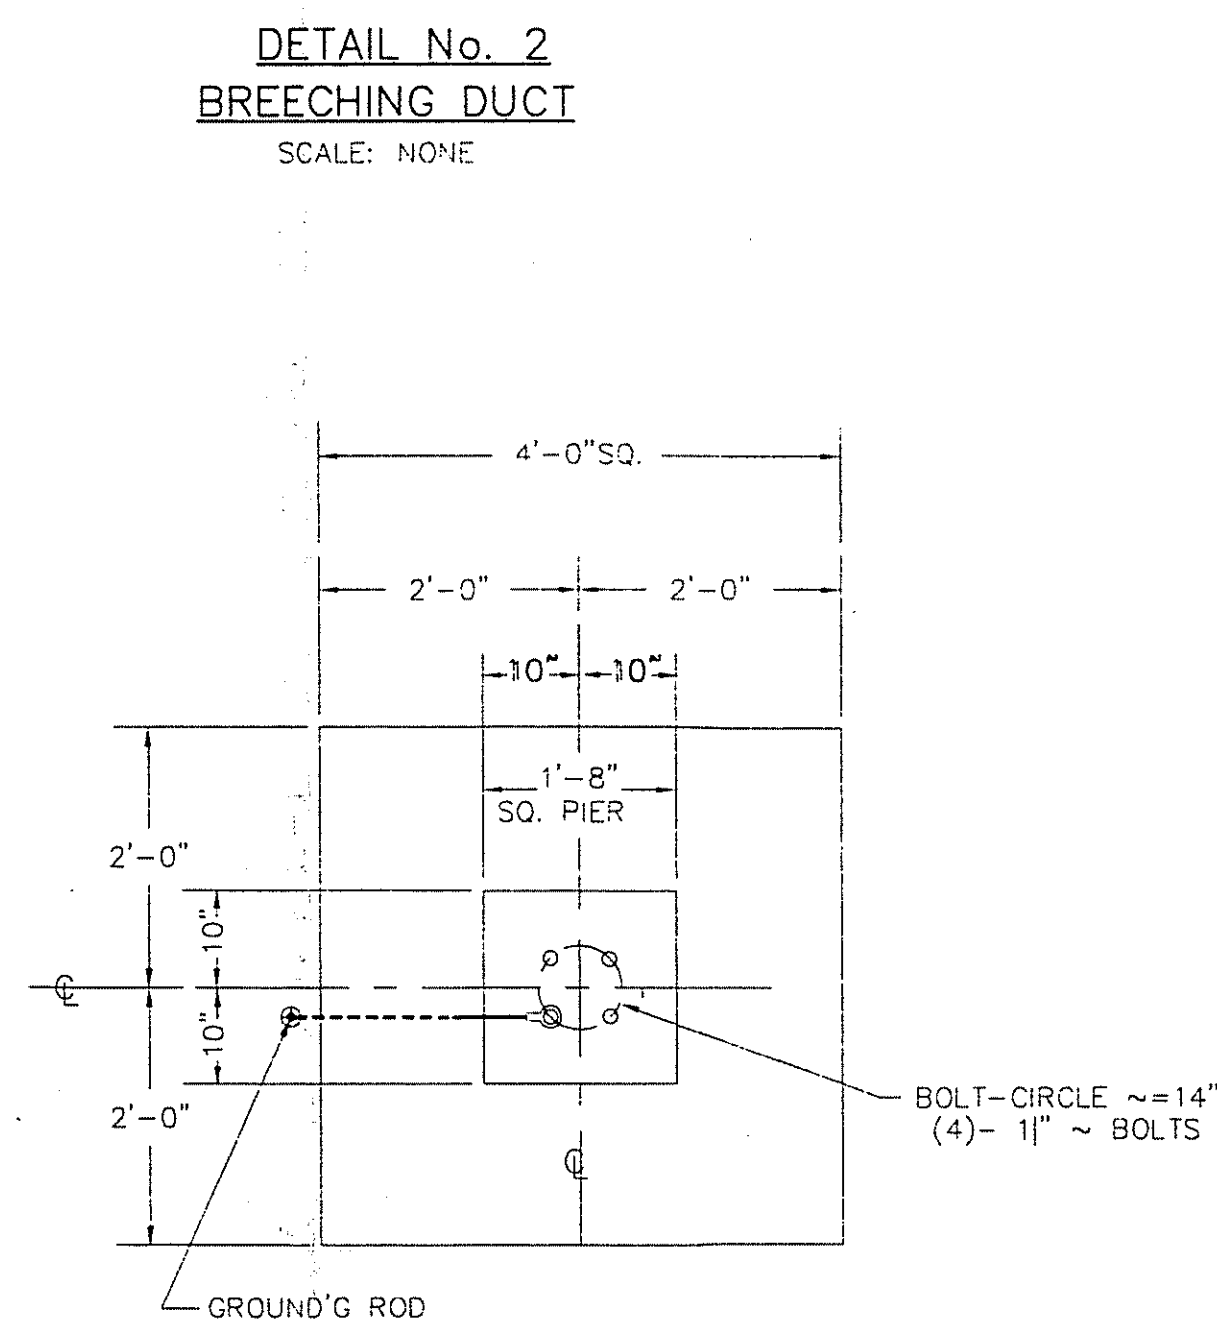

PLAN VIEW

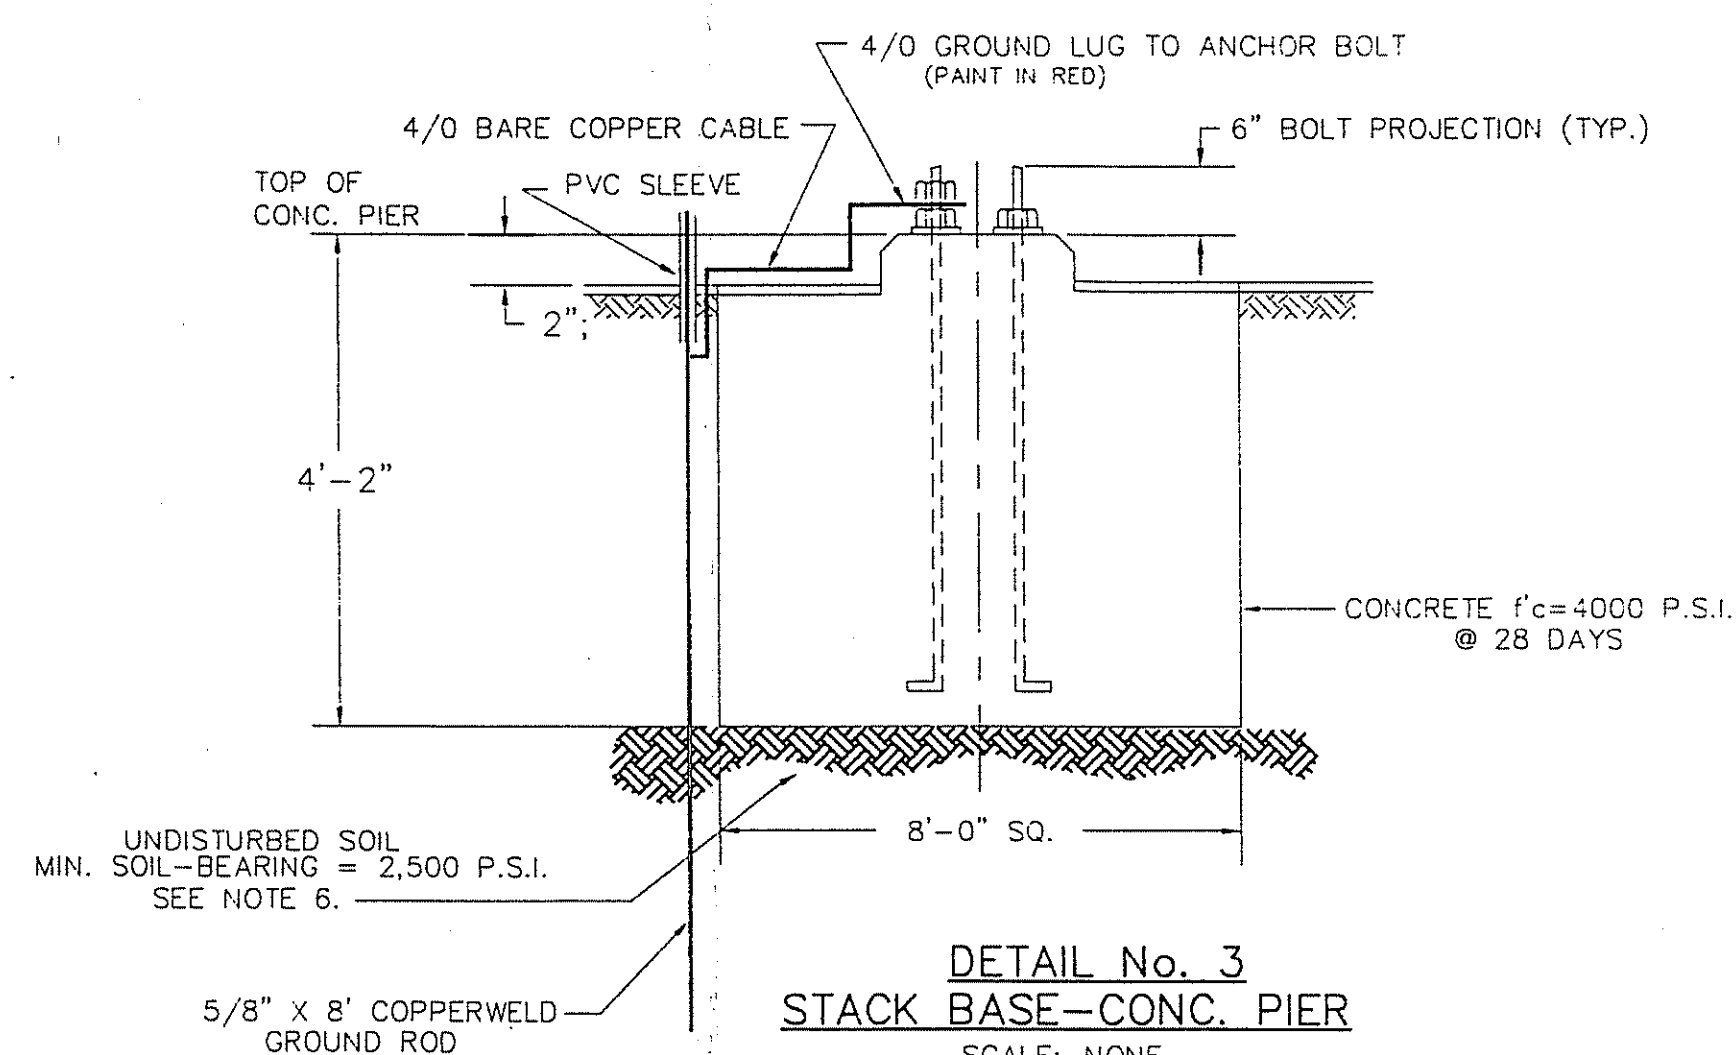


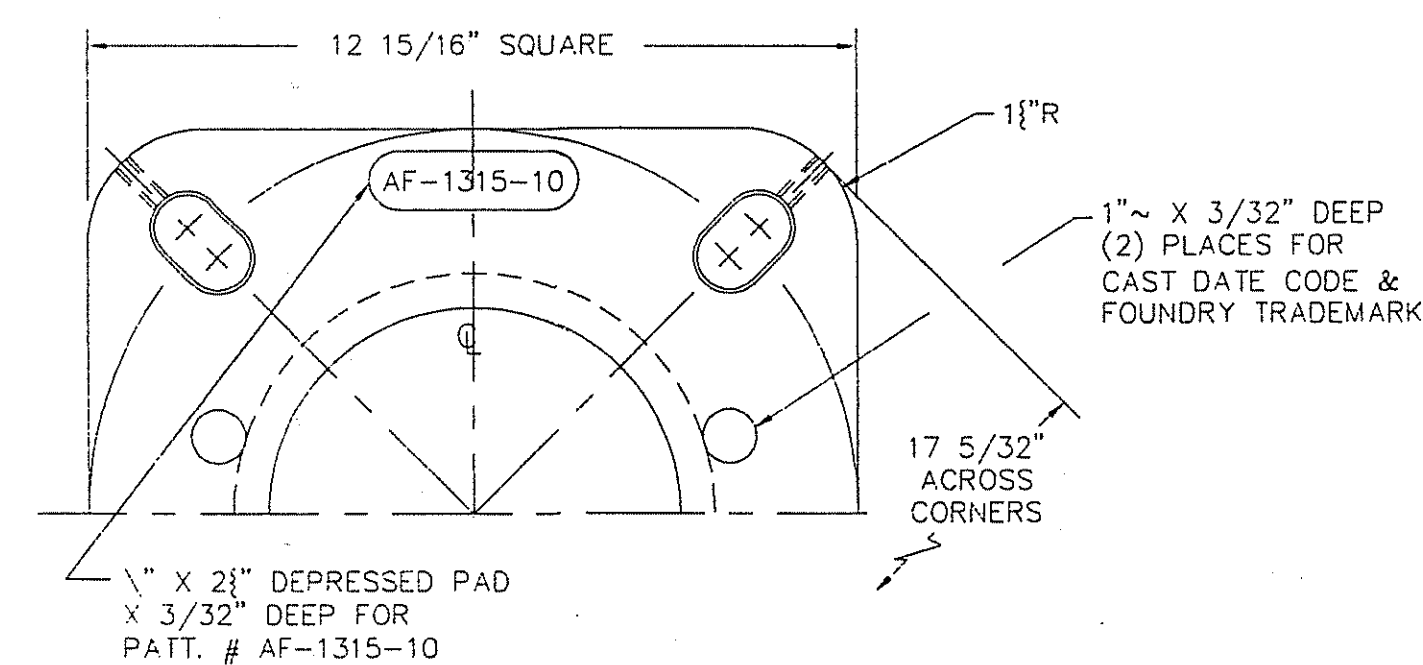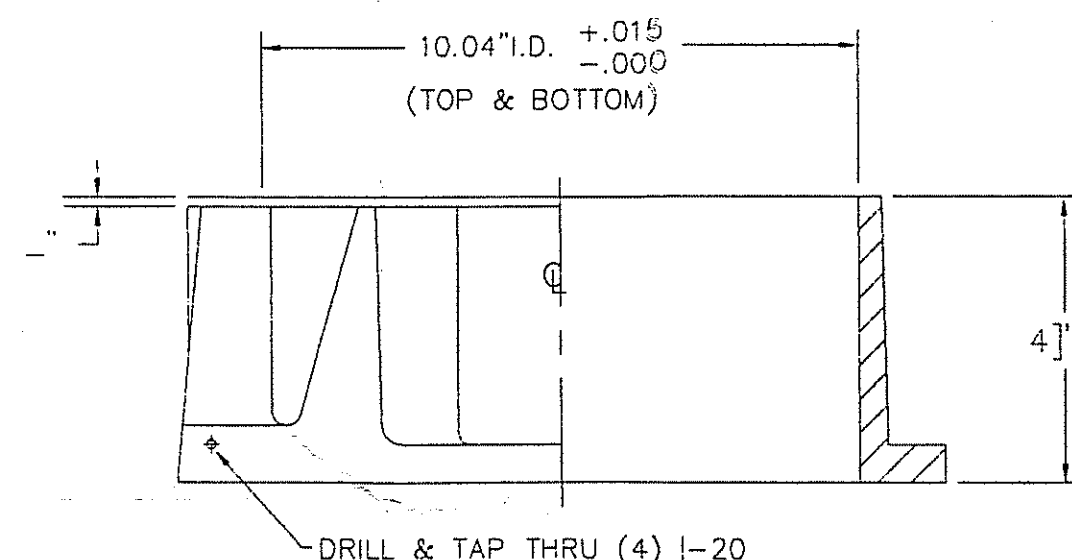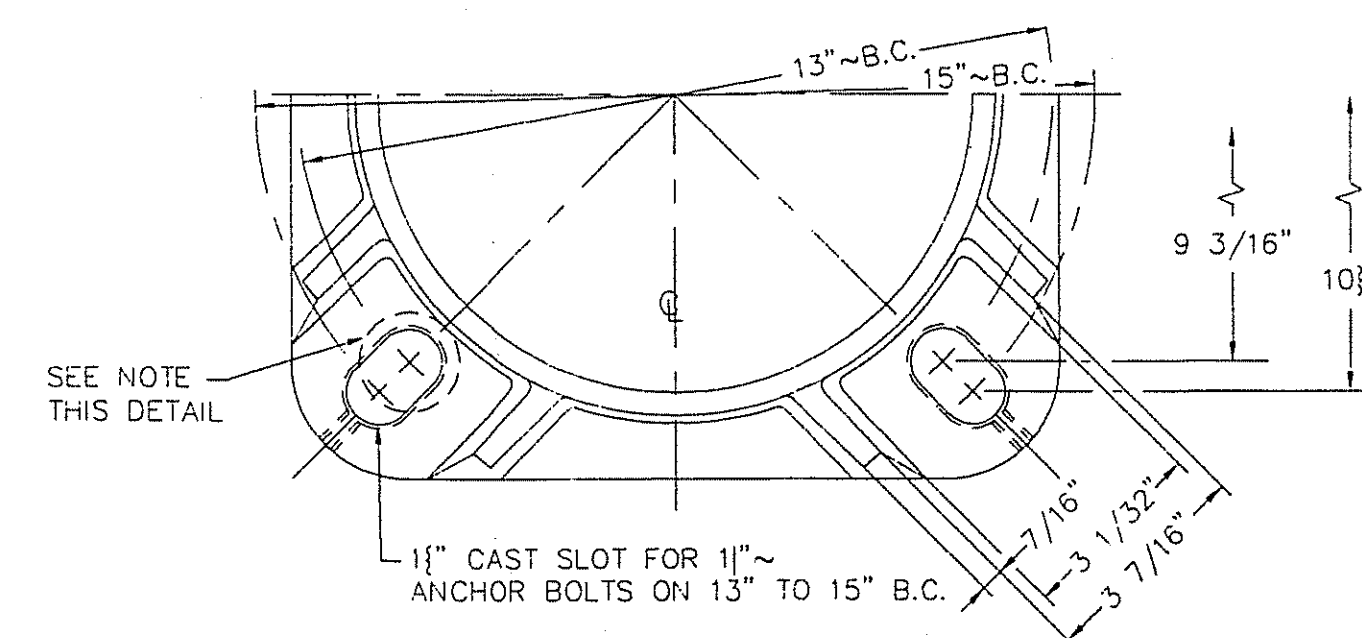DETAIL No. 3
STACK BASE-CONC. PIER
SCALE: NONE



NOTE:
2" O.D. FLATWASHER TO BE USED
ON 13" B.C. ONLY. STANDARD 2[" O.D.
FLATWASHER TO BE USED ON
15" B.C. & BOTTOM ANCHOR
ADJUSTMENT

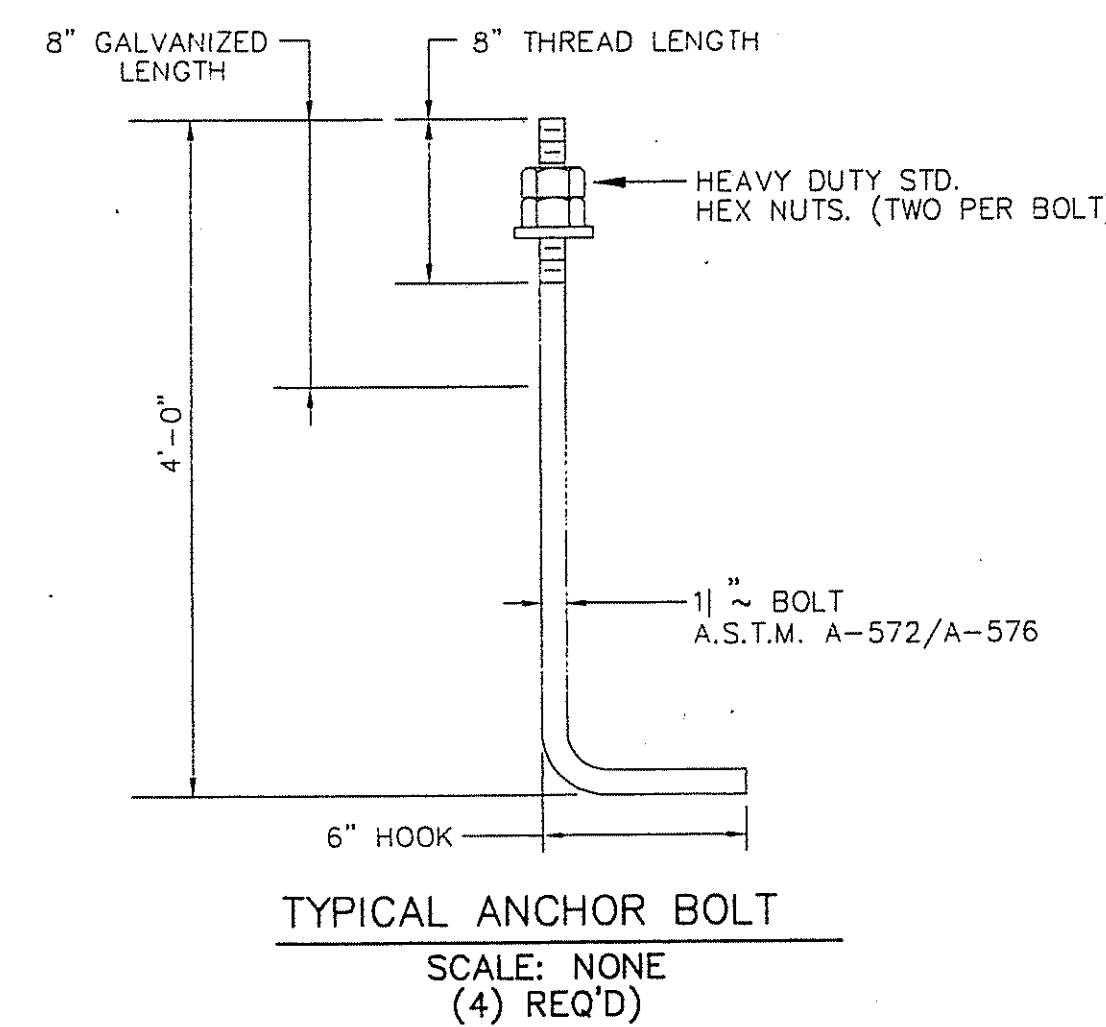
DETAIL No.1
SHOE BASE
SCALE: NONE



TYPICAL ANCHOR BOLT
SCALE: NONE
(4) REQ'D)

NOTES:

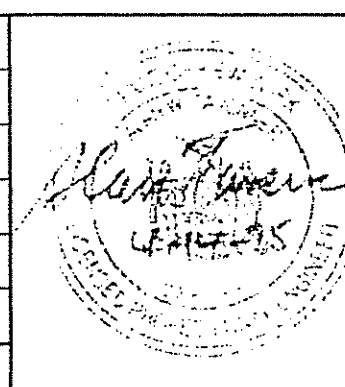1. ALL WELDING CONNECTIONS AIRTIGHT.
2. EMISSION STACK 4-INCH (SVE) AND 6-INCH (AIR STRIPPER) CONNECTIONS NOT CONNECTED.
3. STACK TO BE SUPPORTED WITH GUIDE WIRE CONNECTION TO GARAGE PRIOR TO SYSTEM START-UP.
4. BREECHING DUCT BENDED OR WELDED.
5. STACK BASE CONSTRUCTED BY EXCAVATING A 8'-0" SQUARE HOLE, 8'-0" DEEP, SET BOLTS & FILL WITH CONCRETE AGAINST VERTICAL SOIL CUTS. (NO FORMS). VERTICAL SOIL CUTS VIRGIN UNDISTURBED SOIL, NOT COMPACTED.

[illegible]

| NAMES | DATE |
|-----------------|----------|
| DRAWN: | 1/27/95 |
| DESIGN: ERM | |
| PROJ. MGR.: AWT | 1/27/95 |
| PROJ. ENG.: DDF | 1/27/95 |
| CHECKED: | 1/27/95 |
| SCALE: | AS SHOWN |

5 GARAGE AREA
VAPOR DISCHARGE STACK (10" DIA. TAPERED)
BASE AND CONCRETE FOUNDATION DETAILS

MARTIN MARIETTA
FARRELL ROAD PLANT



NEW YORK

DUNN ENGINEERING COMPANY

DIVISION OF **RUST** ENVIRONMENT & INFRASTRUCTURE


| | |
|-----------------------------|--------------------------|
| PROJECT NUMBER 38564 | DATE 1/27/95 |
| RUST DWG NUMBER 38564-10 | REVISION NUMBER 0 |
| CLIENT DWG NUMBER | SHEET NUMBER 13 OF 15 |

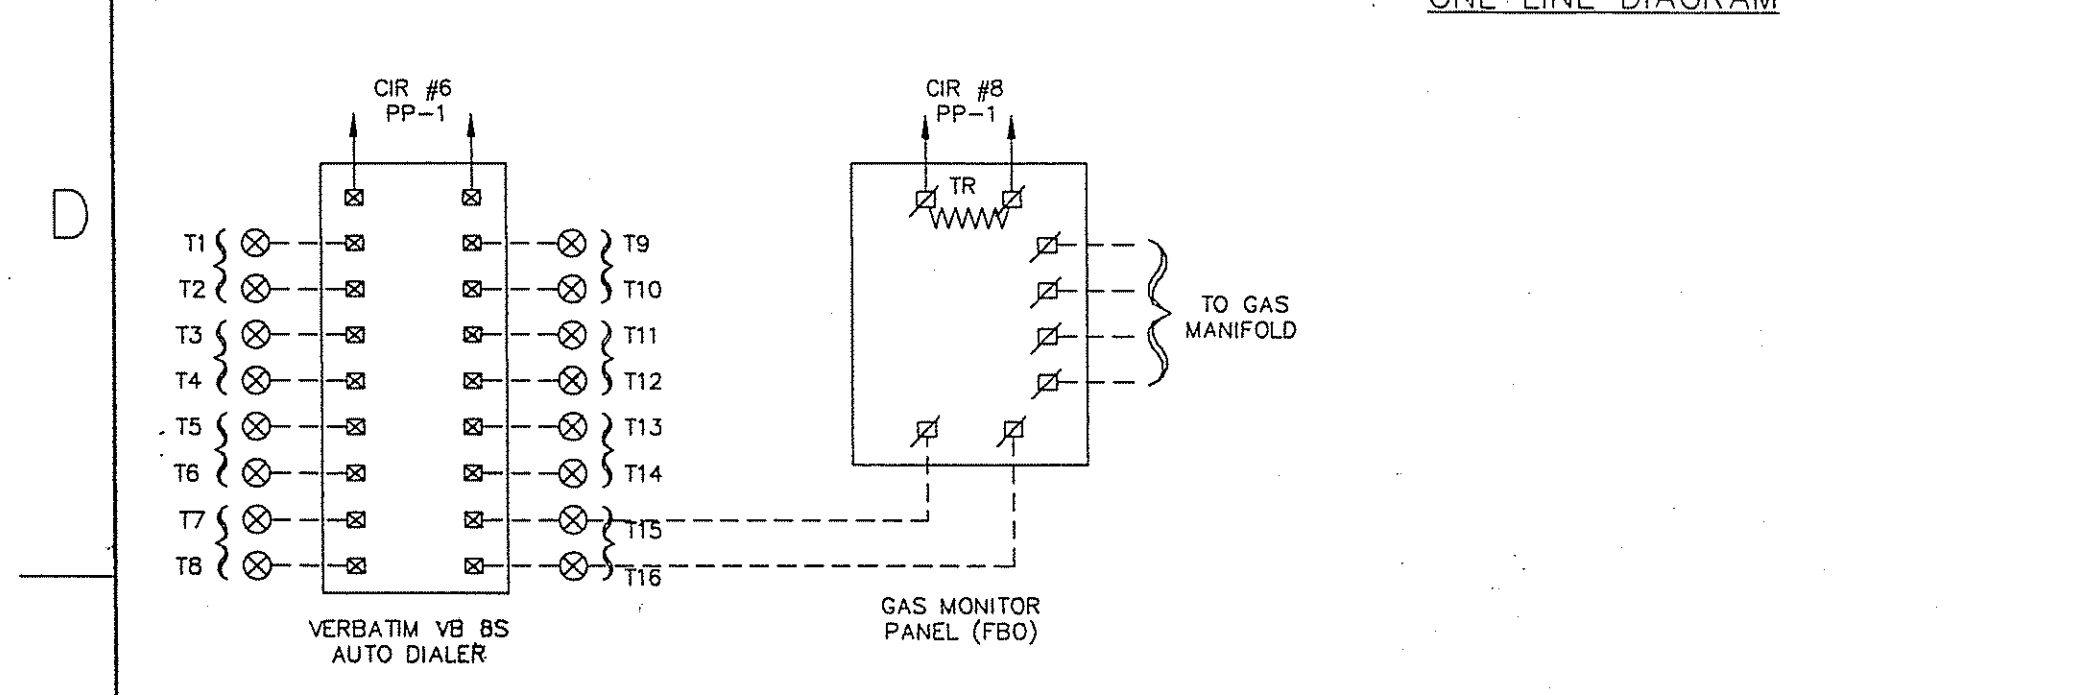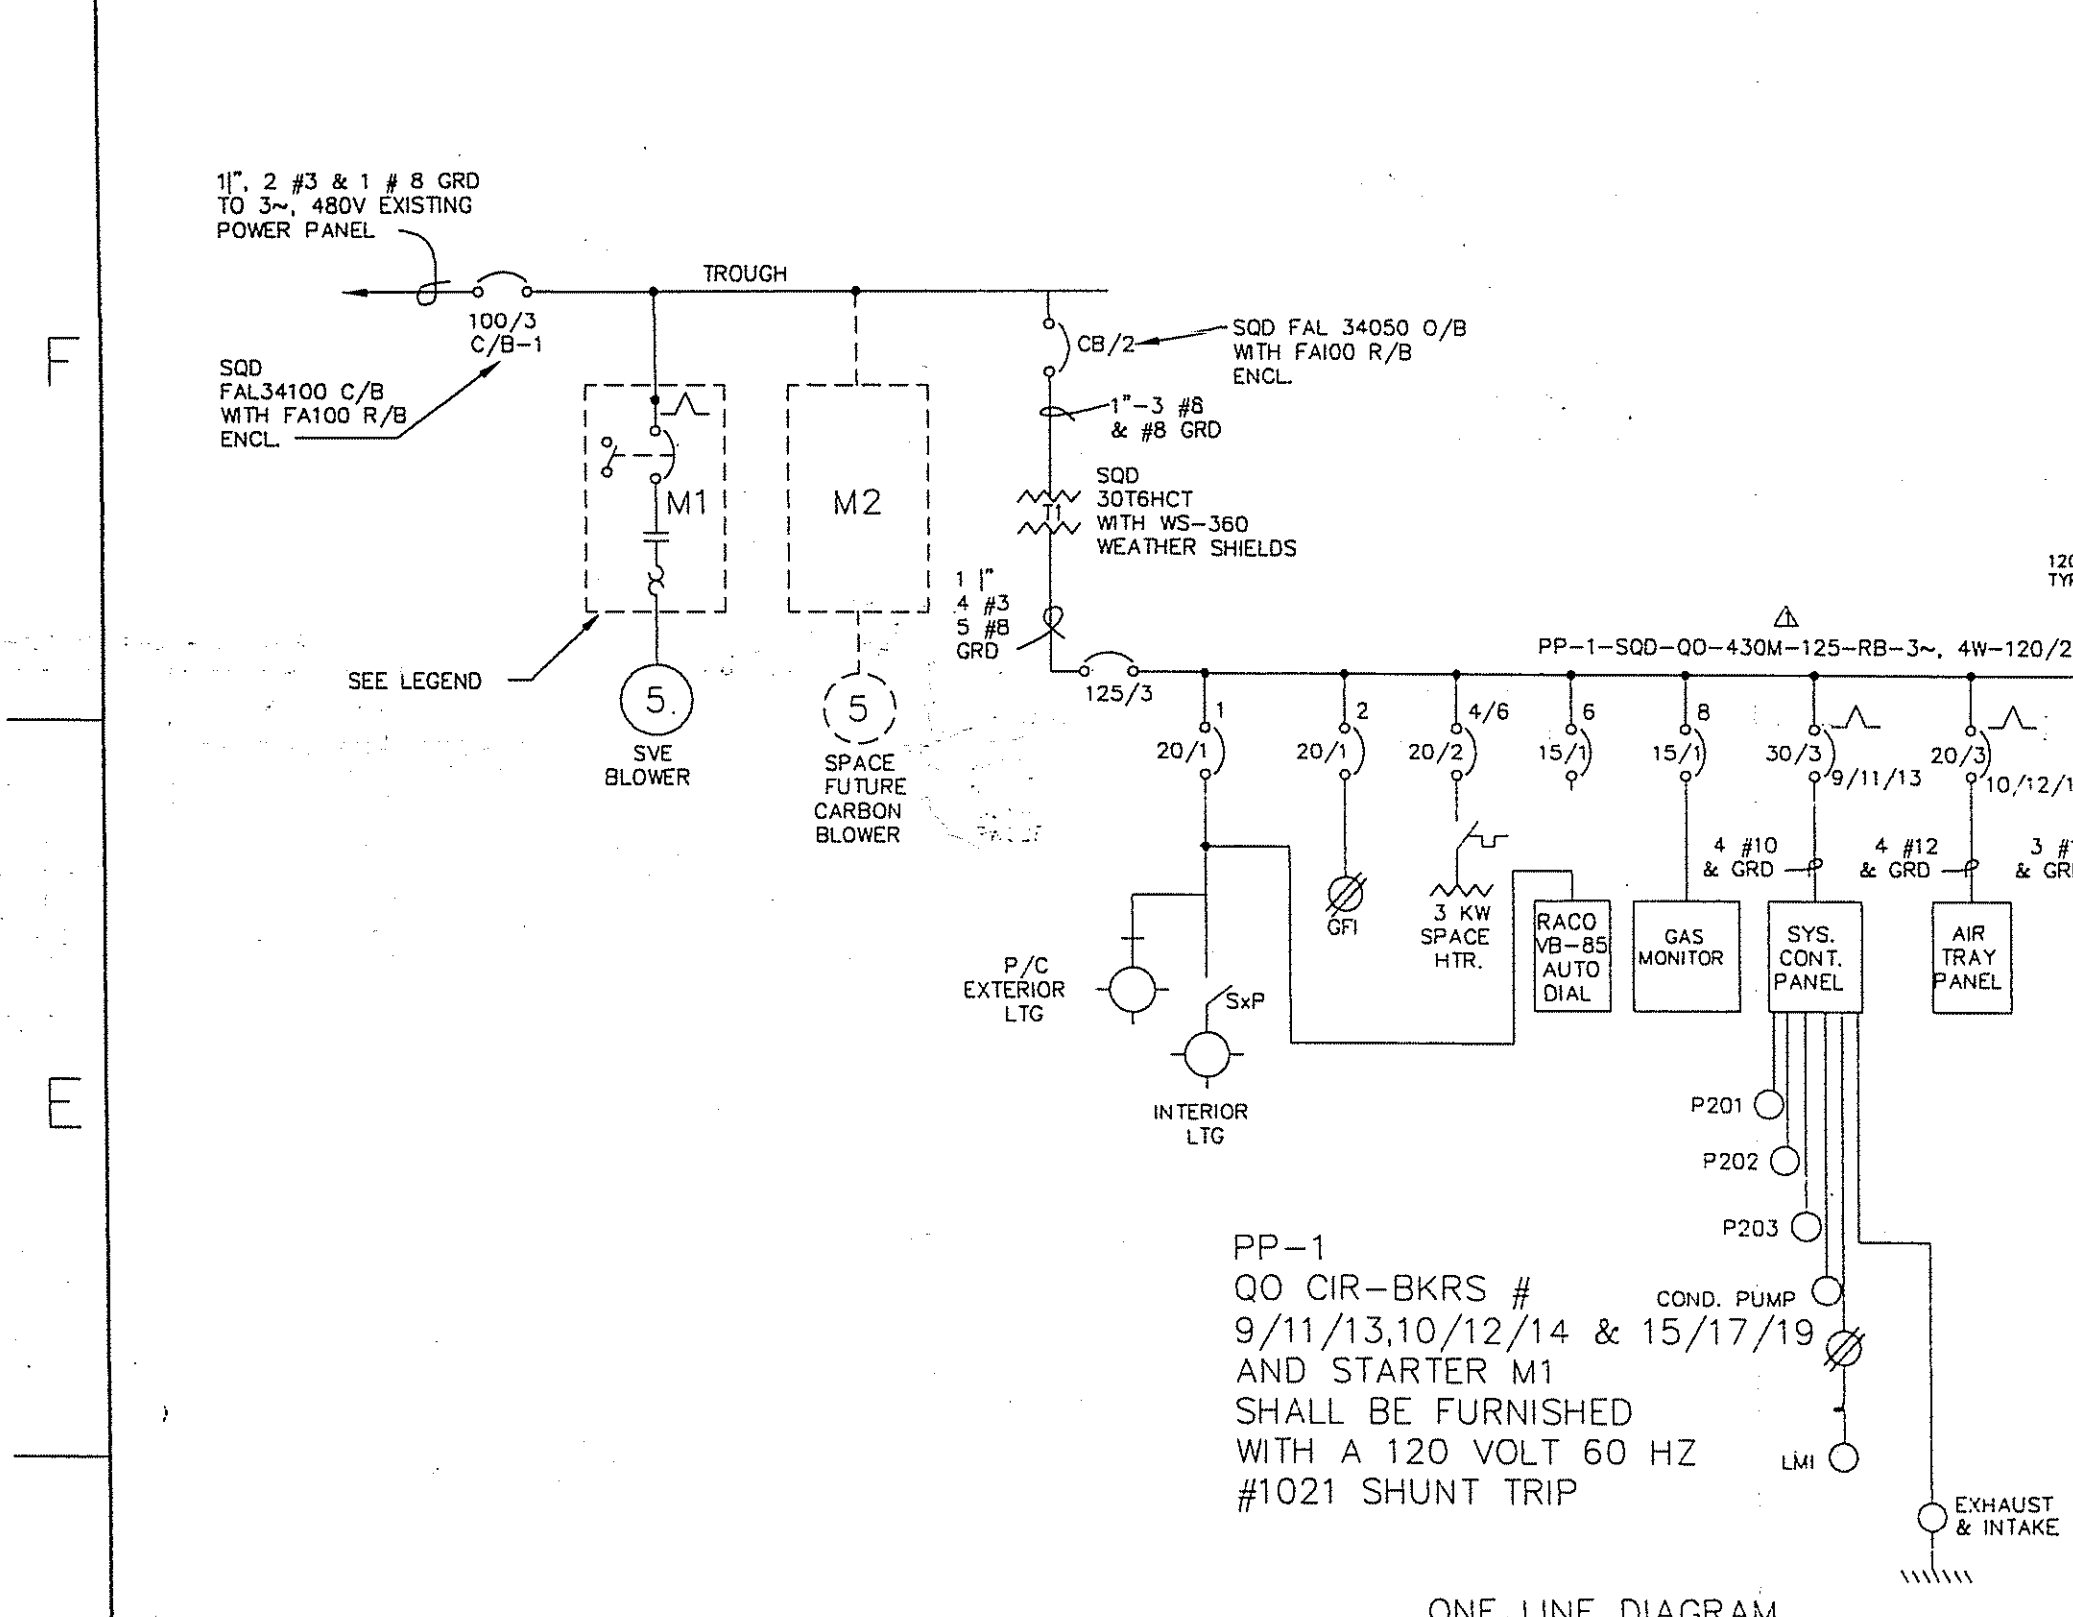CAD FILE NAME:
PLOT DATE: 1/27/95




- LEGEND**
- Δ DENOTES DEVICE OR EQUIP. REMOTE FROM CONTROL PANEL & DIST'R. AREA
 - M1 ALLEN BRADLEY 513-B0BD-6-40 WITH 1-N/O AUX CONTACT & 120 VOLT 60 HZ SHUNT TRIP ON CIR BKR & AUX ALARM CONTACT ON O/L
 - P4 & M3 ALLEN BRADLEY - 700HG45A1
 - P1, P2 & P3 ALLEN BRADLEY - 509-AOXD WITH 2 N/O AUX CONTACTS & AUX ALARM CONTACT ON O/L
 - R1 TO R8 OMRON MK3P-S-120V-3P-DT
 - R2A, R7A, R8A & AR OMRON MK2P-S-120V-3P-DT
 - RR ALLEN BRADLEY - 700N-800A1
 - SS-1,2,4,5,6 & 7 ALLEN BRADLEY - 800HUR2A - "HAND-OFF-AUTO"
 - PB-1 ALLEN BRADLEY - 800HR1A4 - RESET
 - MS-1 GE THC-3100AFC WITH GE # 343L296G2 AUX. SW
 - ⊕ HIGH PRESSURE SWITCH - MERCOID DA-31-153-8 F-B-O (PUMPS)
 - ⊕ HIGH TEMP. SWITCH - MERCOID - DAH-35-153-5 F-B-O (SVE BLOWER)
 - IS-1 TO IS-5 WARRICK INT. SAFE LEVEL CONTROLS & PROBES F-B-O
 - ⚡ AUX. CONTACT ON DISCONNECT OF COMBINATION MAGNETIC MOTOR STARTER
 - IS-6,7,8,9,10 & 16EMS #A-144800 INT. SAFE RELAYS
 - PL-1 TO PL-16 ALLEN BRADLEY-800H-PR16-LENS COLOR AND LEGENDS AS INDICATED
 - TD-1 ATC #407A-500-F-3-X OFF DELAY TIMER
 - TD-2 ATC #339A-200-Q-2-X ON DELAY TIMER
- NOTES**
- INTERIOR AREA OF BUILDING CLASSIFIED CLASS #1 DIVISION
 - ALL WIRING THEREIN CONFORMS TO ARTICLE 500 OF THE NATIONAL ELECTRIC CODE.
 - ALL INTERIOR LINE VOLTAGE WIRING CONTAINED IN RIGID THREADED HEAVY WALL GALVANIZED OR ALUMINUM CONDUIT. INTRINSIC SAFE WIRING SHALL UTILIZE EMT CONDUIT.
 - FLEXIBLE TERMINATIONS WHERE REQUIRED FOR MOVEMENT OR SERVICING ON ALL NON INTRINSIC SAFE, SWITCHING OR SPARK PRODUCING DEVICES OR EQUIPMENT MADE USING EXPLOSION PROOF BRAID FLEX. INTRINSIC SAFE WIRING SHALL UTILIZE LIQUIDTITE FLEX.
 - ALL CONDUCTORS STRANDED, COPPER, TYPE THHN/THWN, #14 MINIMUM FOR CONTROL, #12 MIN. FOR POWER.
 - JUNCTION BOXES AND FITTINGS INSTALLED AS REQUIRED AND SHALL BE APPROVED FOR THE AREA CLASSIFICATION IN WHICH THEY ARE INSTALLED. JUNCTION BOXES FOR INTRINSIC SAFE WIRING WILL BE PRESSED STEEL, SCREW COVER UNLESS OTHERWISE NOTED.
 - ALL RACEWAYS SEALED USING TYPE EYS SEAL FITTINGS AT ALL POINTS AS FOLLOWS:
A- WHEN ENTERING OR LEAVING THE CLASSIFIED AREA.
B- WHEN ENTERING OR LEAVING ANY NON INTRINSIC SAFE SWITCHING OR SPARK PRODUCING DEVICE OR EQUIPMENT.
 - INSTALLATION CONFORMS WITH ALL NATIONAL, STATE, LOCAL AND UTILITY CODES AND SPECIFICATIONS.
 - ALL RACEWAYS CONTAIN A CIRCUIT SIZE GROUND CONDUCTOR.
 - ALL POWER & CONTROL WIRING TO WELLS AND OUTFALL LEVEL SWITCH INSTALLED WITHOUT SPLICES EXCEPT AT CONNECTION TO THE PUMPS AND DEVICES.

| NO. | REVISIONS | MADE | CHK | DATE | NO. | REVISIONS | MADE | CHK | DATE |
|-----|-----------------|------|-----|------|-----|----------------|------|-----|------|
| 2 | RECORD DRAWINGS | | | | 1 | ERM DWG E-2(G) | | | |
| 1 | ERM DWG E-2(G) | | | | | | | | |

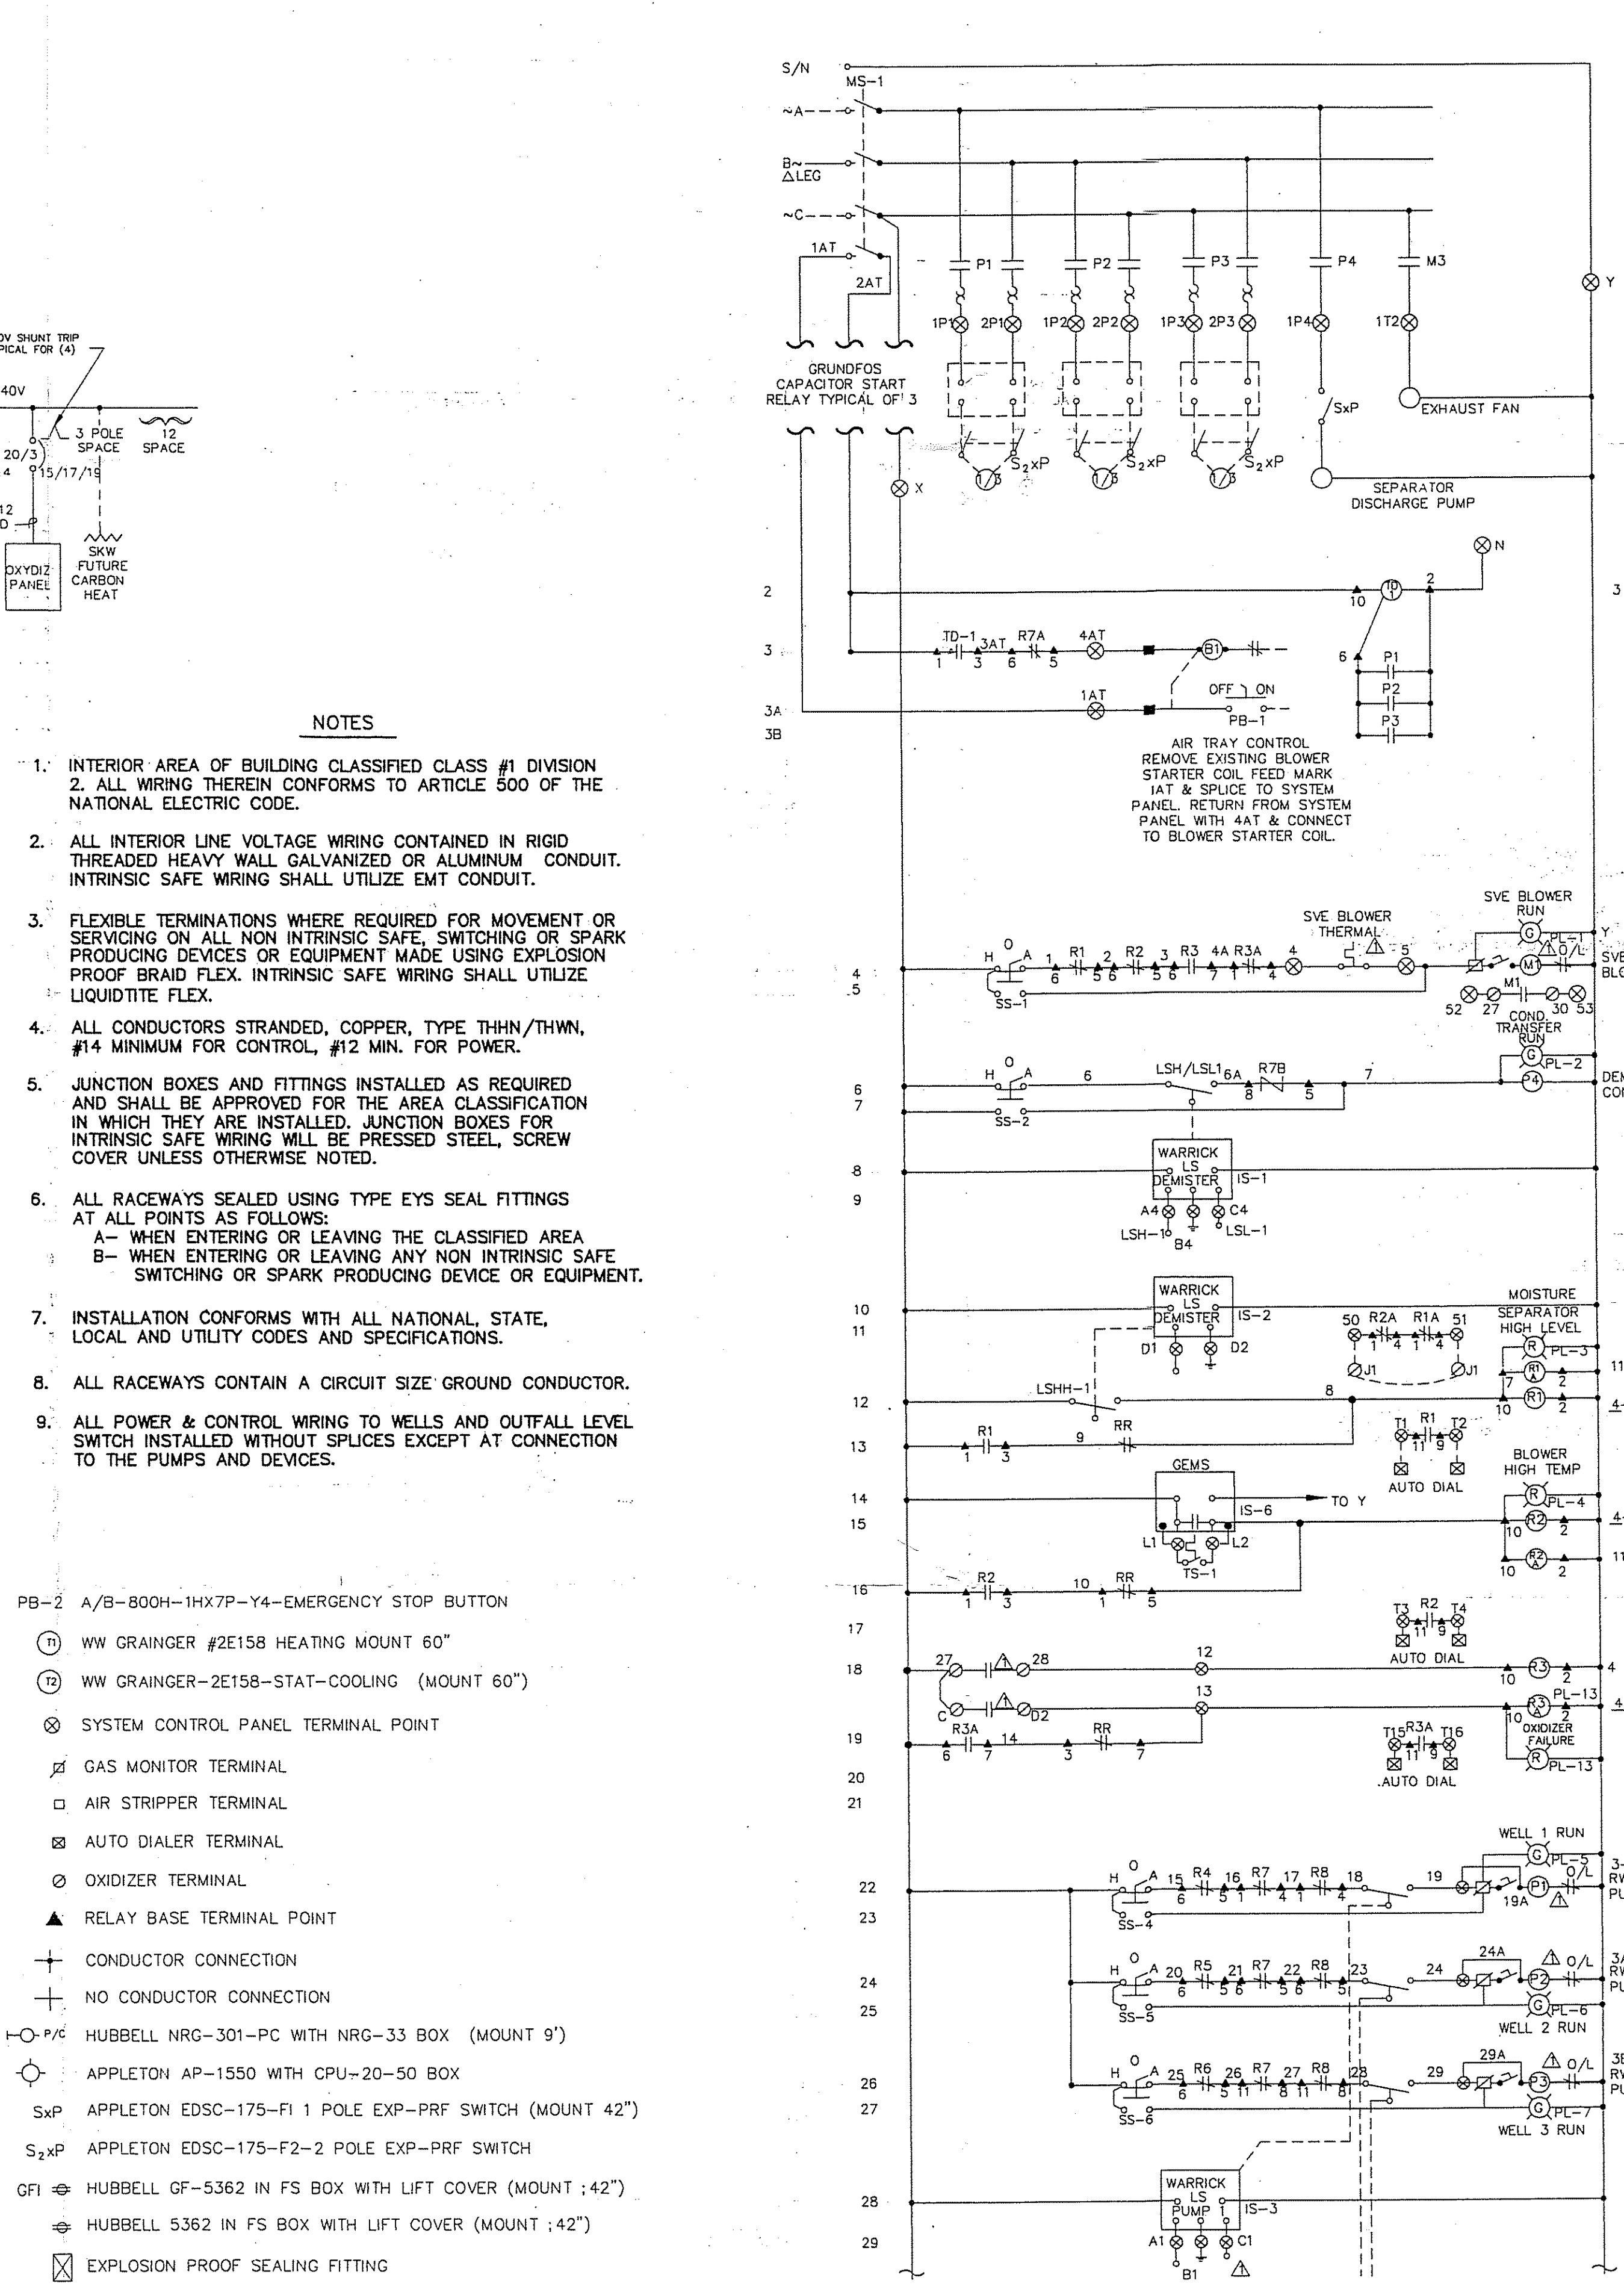

| NO. | REVISIONS | MADE | CHK | DATE |
|-----|-----------------|------|-----|------|
| 2 | RECORD DRAWINGS | | | |
| 1 | ERM DWG E-2(G) | | | |

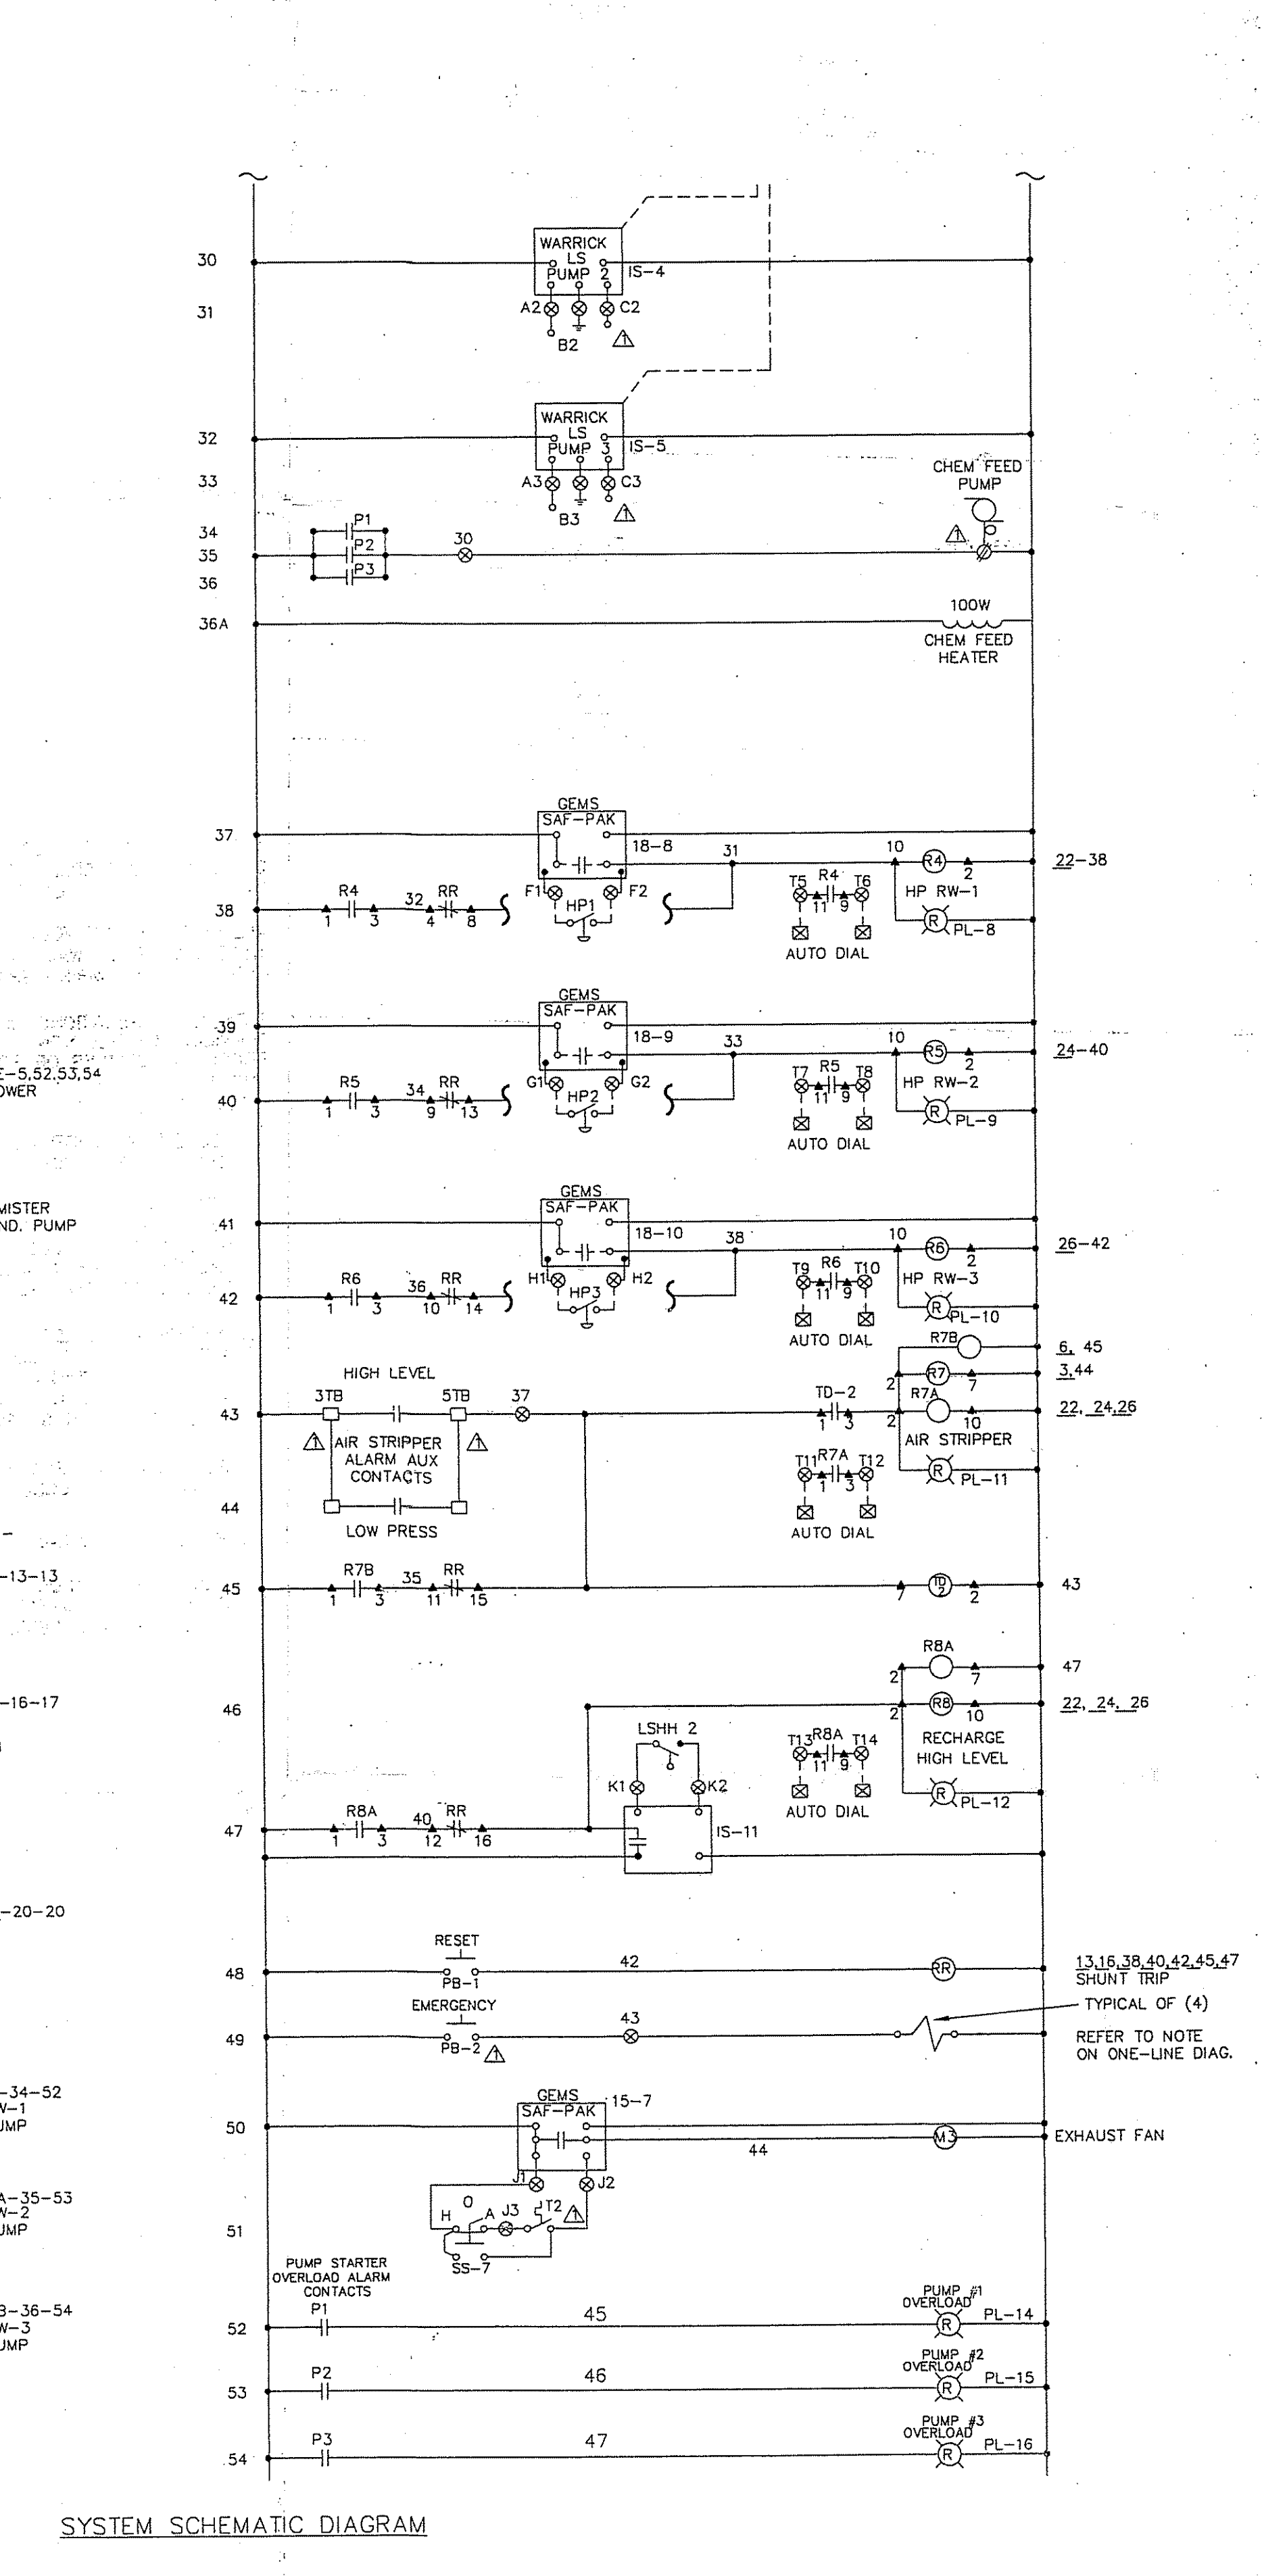

| NO. | REVISIONS | MADE | CHK | DATE |
|-----|-----------------|------|-----|------|
| 2 | RECORD DRAWINGS | | | |
| 1 | ERM DWG E-2(G) | | | |

A

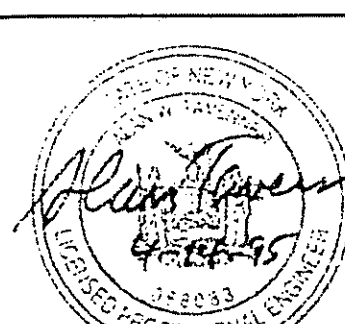
B

C

D

E

F



| NAMES | DATE |
|----------------|----------|
| DRAWN: ERM | 1/27/95 |
| DESIGN: ERM | 1/27/95 |
| PROJ. MGR: AWT | 1/27/95 |
| PROJ. ENG: DDF | 1/27/95 |
| CHECKED: DDF | 1/27/95 |
| SCALE: | AS NOTED |

GARAGE AREA
ELECTRICAL SCHEMATIC AND
ONE LINE DIAGRAM

MARTIN MARIETTA
FARRELL ROAD PLANT
NEW YORK


| DUNN ENGINEERING COMPANY | |
|---|-----------------------|
| DIVISION OF RUST ENVIRONMENT & INFRASTRUCTURE | |
| PROJECT NUMBER 38564.110 | DATE 2/21/95 |
| RUST DWG NUMBER 38564-11 | REVISION NUMBER 0 |
| CLIENT DWG NUMBER | SHEET NUMBER 15 OF 15 |



P-1 Excavated soil and debris (<5 ppm) stored on polyethylene sheeting east of the garage (AOC #16).



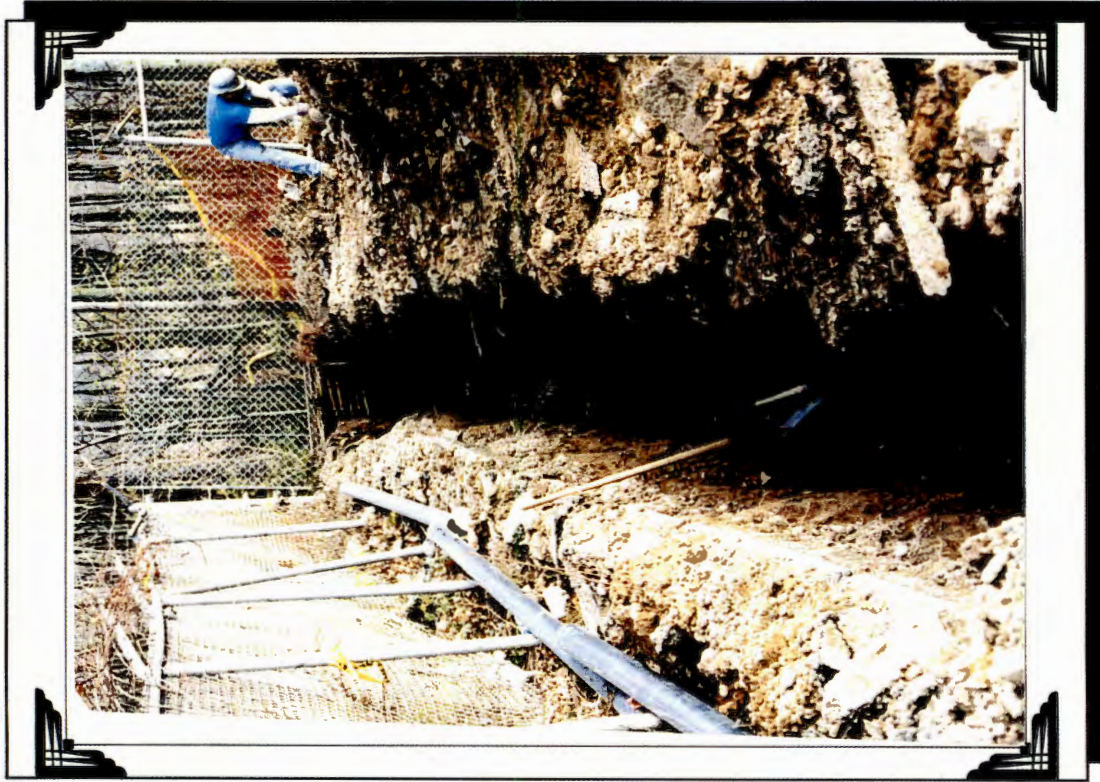P-2 Loading of stockpiled soil (<5 ppm) onto trucks for off-site disposal.



P-3 Excavation of groundwater discharge trench (AOC #16).



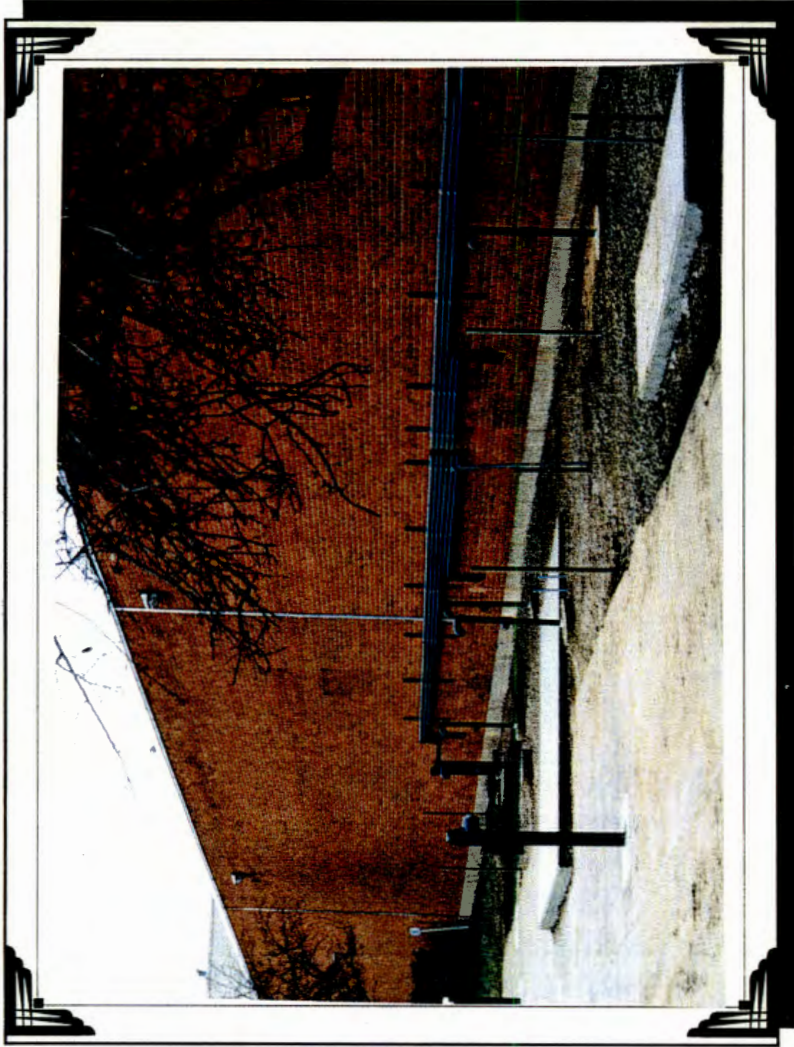
P-4 Groundwater discharge pipe with higher high water float sensor (southern view).




P-5 Equipment used for excavation of AOC #5 treatment building footings and pad as well as asphalt seal.




P-6 Installation of vapor recovery and air injection piping within trench in previous polysulfide room (AOC #5).



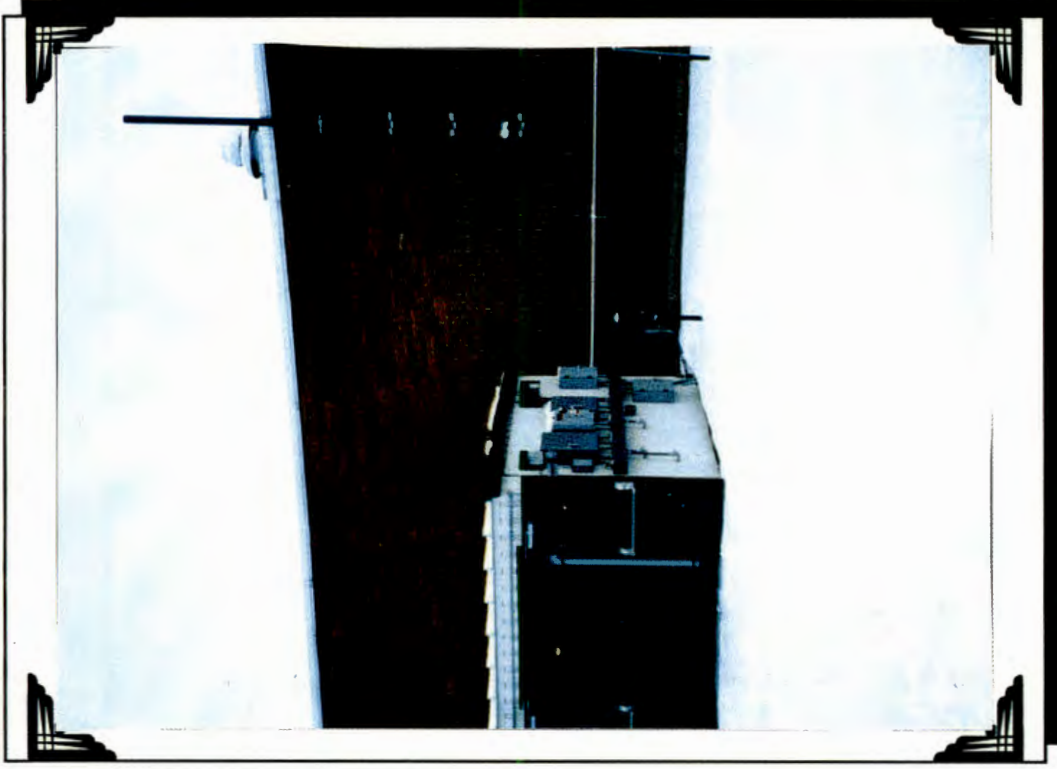
P-7 Vapor recovery piping supported along Building 2. Building 2. Also view of treatment building.



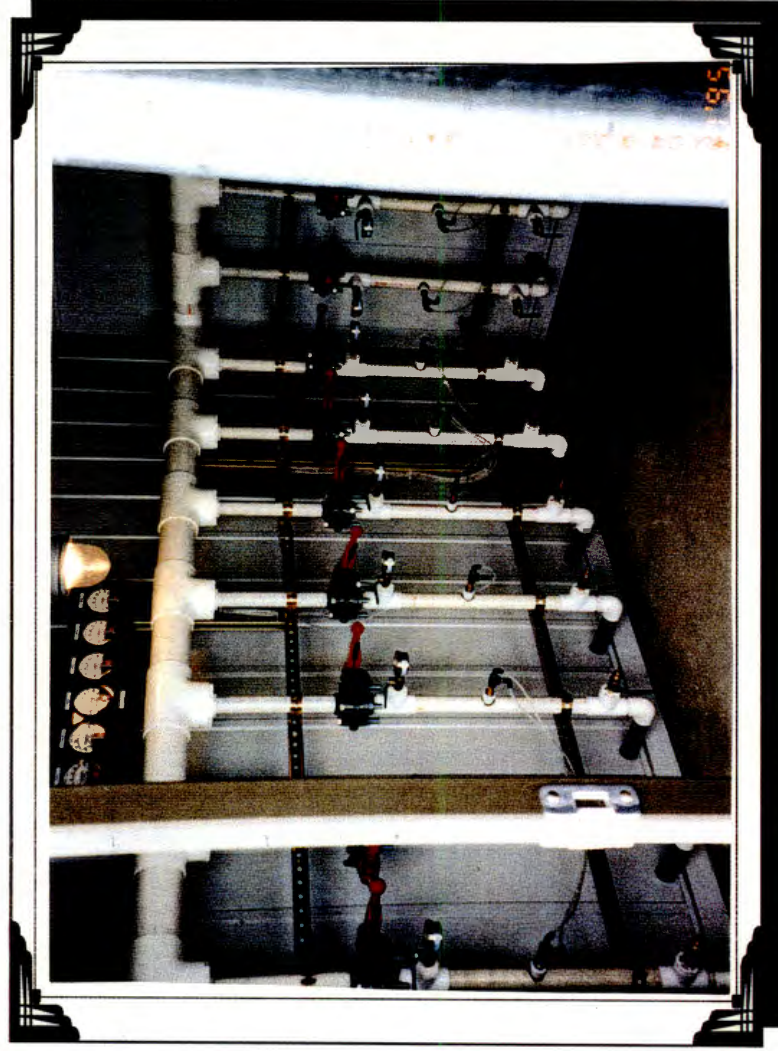
P-8 Treatment building with view of control and circuit panels. Also air emission discharge stack supported to Building 2 (AOC #5).



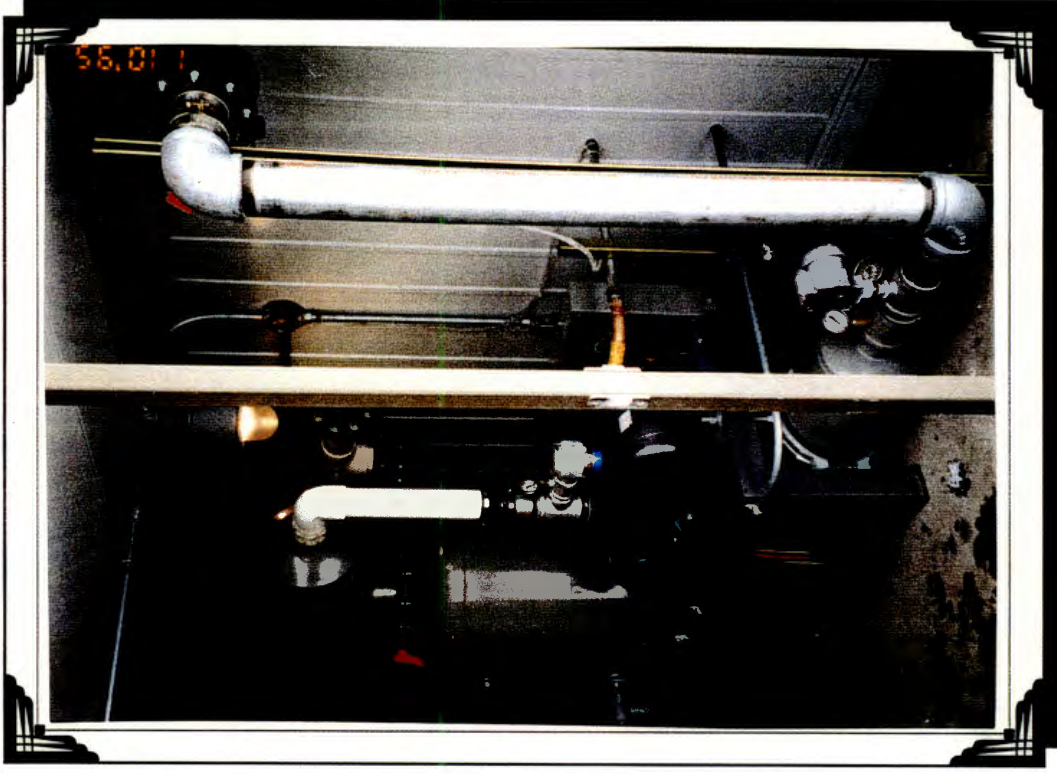
P-9 Vapor extraction piping connecting to PVC manifold within AOC #5 treatment building. Includes view of sample ports, pressure gauges, and magnetic sensors and gauges.



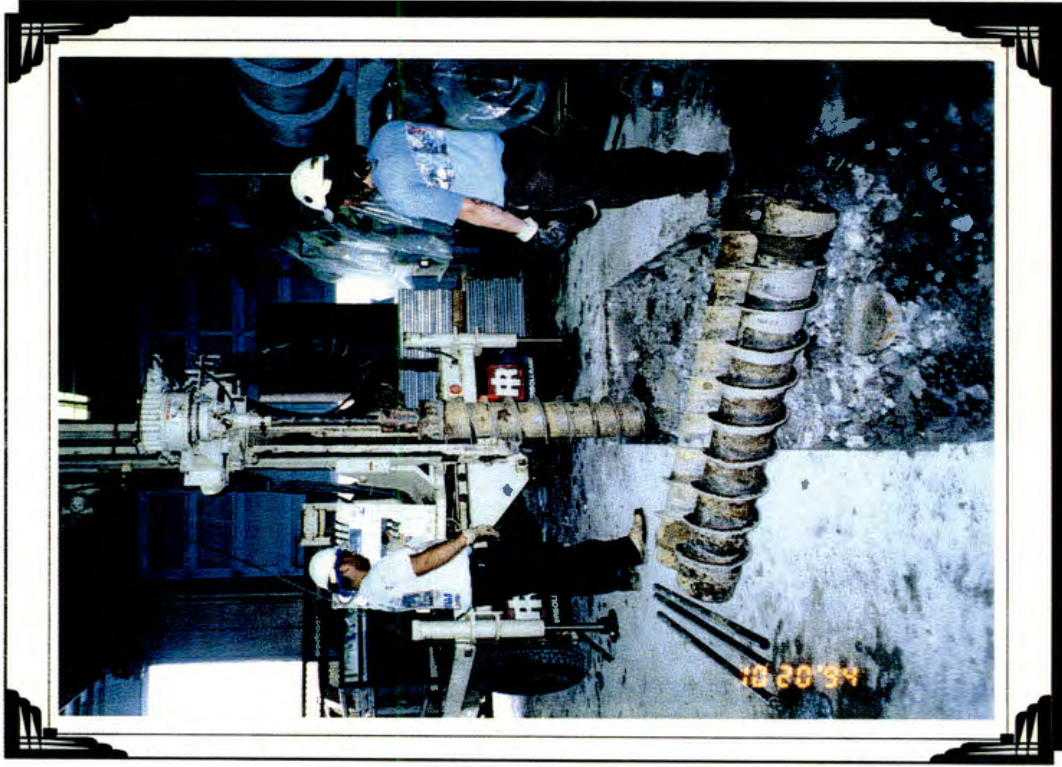P-10 Soil vapor extraction equipment within AOC #5 treatment building. Effluent discharge pipe exiting building can be seen in foreground.



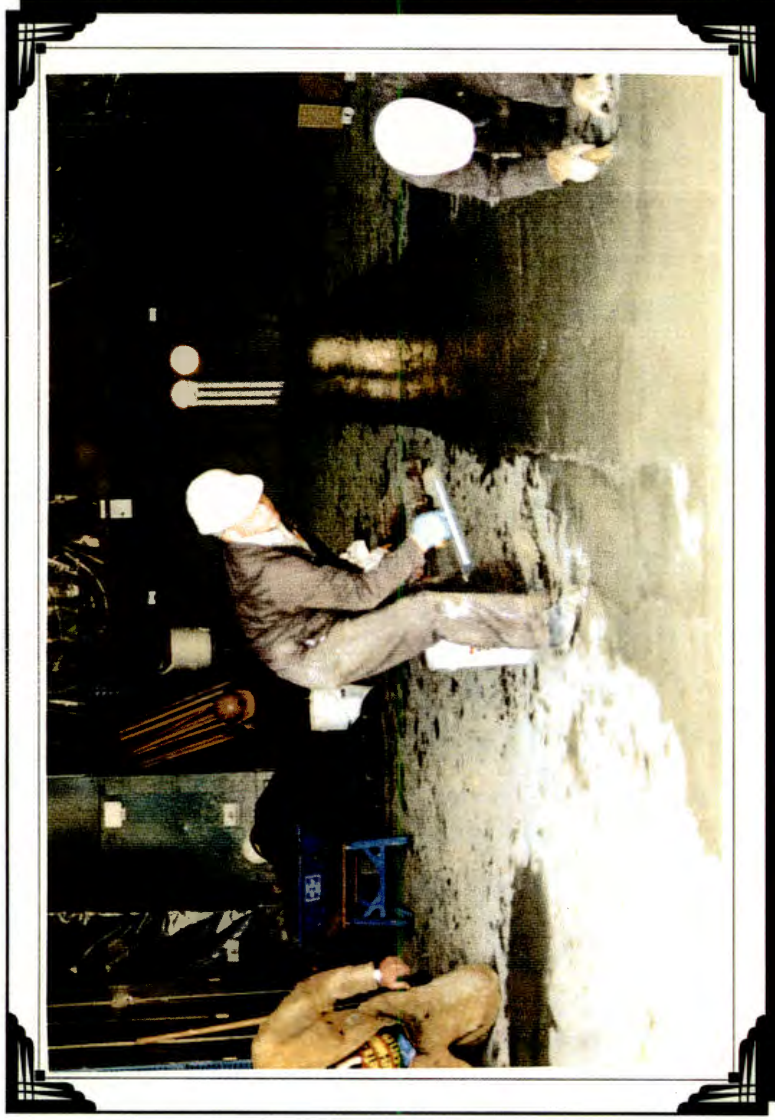P-11 Parratt Wolff drilling RW-2 within corresponding pipe trench (AOC #16).




P-12 REW personnel finishing surface of concrete for PV-1, PV-2, VE-2, VE-3, and VE-4 pipe trenches (AOC #16).




P-13 REW personnel installing recovery well piping along north side of treatment building pad (AOC #16).



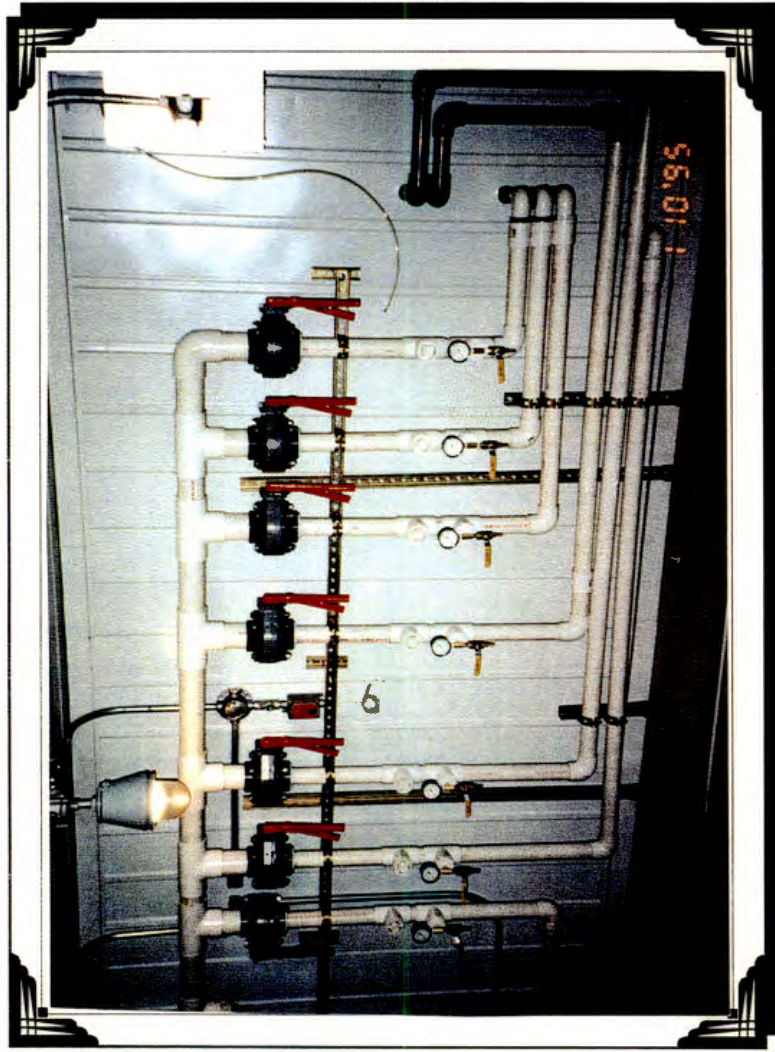
P-14 Control panels and circuit boxes supported to east wall of treatment building (AOC #16). Vapor extraction laterals VE-2, VE-3, VE-4, VE-5, VE-6, and VE-7 can be seen entering into building in foreground.



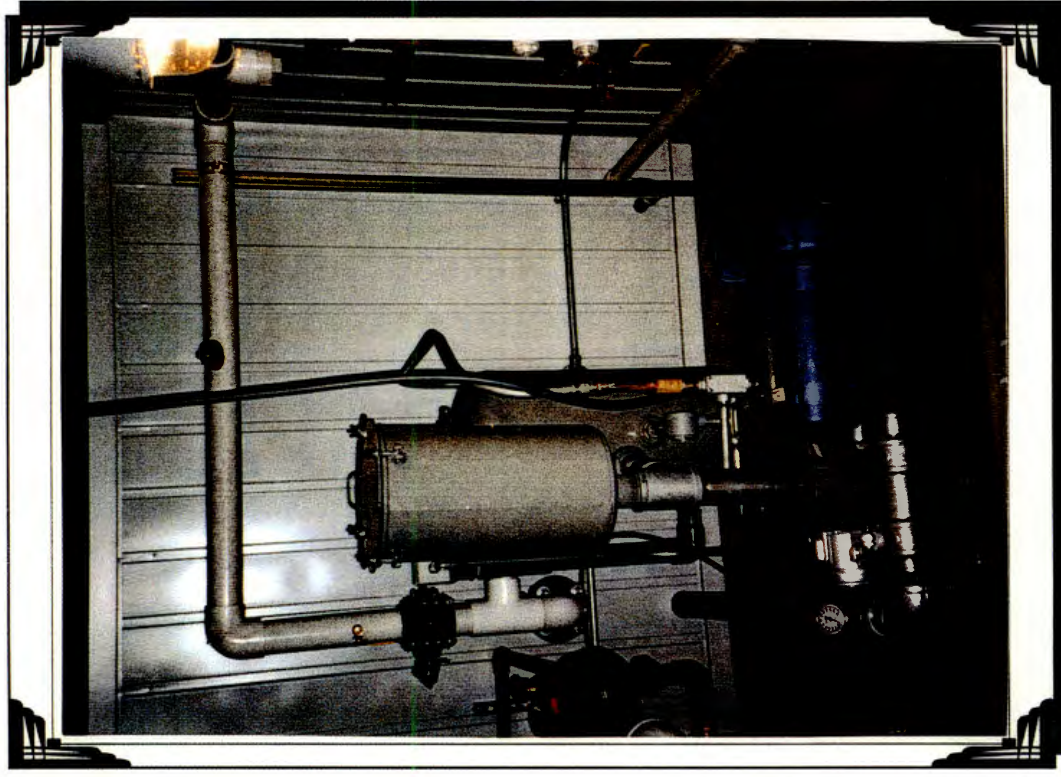P-15 Vapor extraction piping entering PVC manifold within AOC #16 treatment building. View of sample ports, pressure gauges, and butterfly valves on laterals.



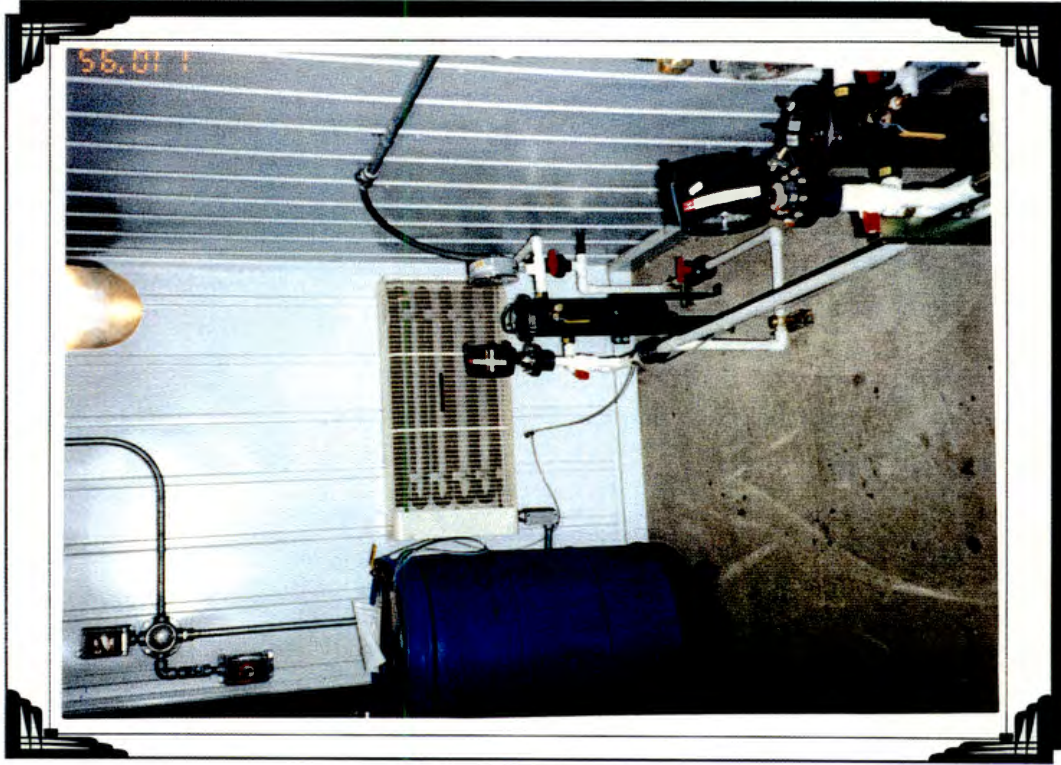
P-16 AOC #16 soil vapor extraction system.



P-17 Recovery well RW-2 and RW-3 piping enter building into corresponding filters. Sequestering agent 55-gallon drum feeding into groundwater influent line (AOC #16).



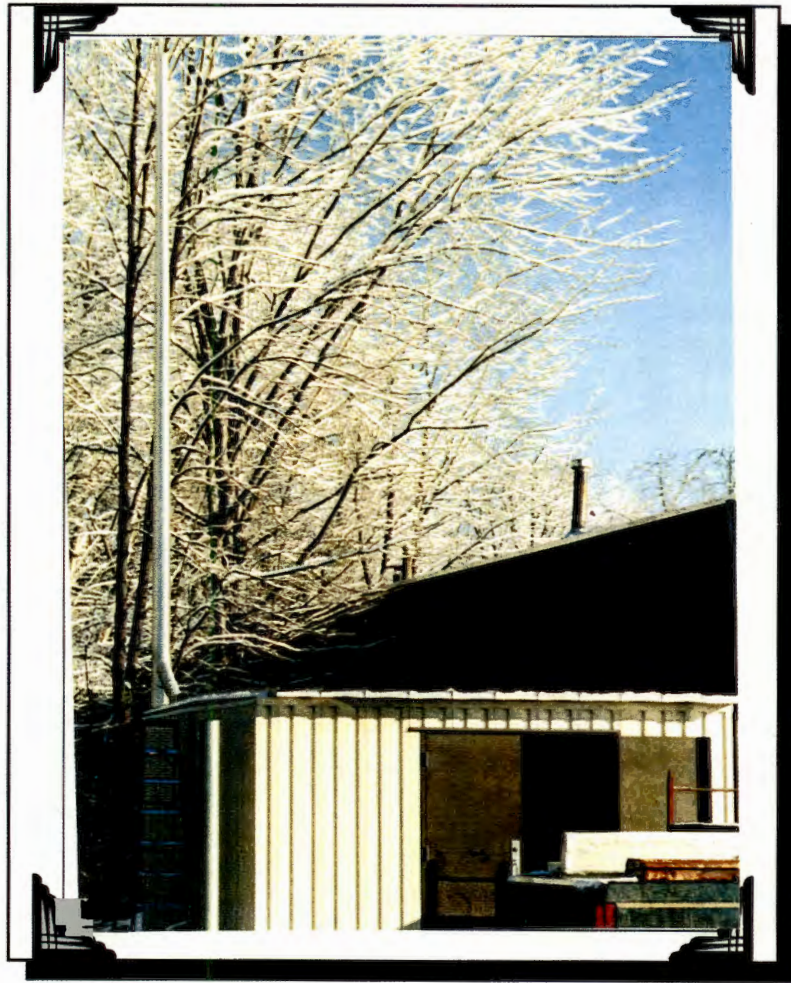P-18 Three-tray air stripper (AOC #16).



P-19 AOC # 16 treatment building with view of the air emission discharge stack.