

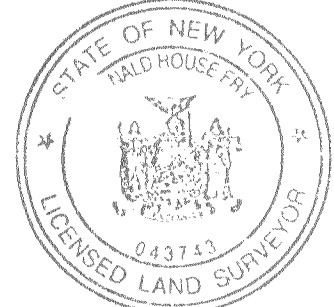
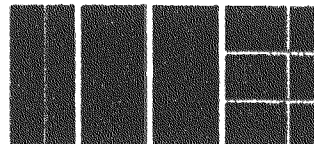



LEGEND	
— 90 —	INDEX CONTOUR
- - - 89 - - -	INTERMEDIATE CONTOUR

NOTES

CONTROL DATA WAS NOT SUPPLIED TO MODI ENGINEERING.  
HORIZONTAL AND VERTICAL DATUM IS ASSUMED.  
HORIZONTAL POSITIONING ON SITE HAD TO BE DETERMINED  
BY LOCATING PHYSICAL FEATURES ON SITE.  
FIELD SURVEY WAS COMPLETED ON VARIOUS DATES  
IN SEPTEMBER AND OCTOBER OF 1998.  
EXISTING BUILDINGS WERE SCALED OFF CONTRACT DRAWINGS.

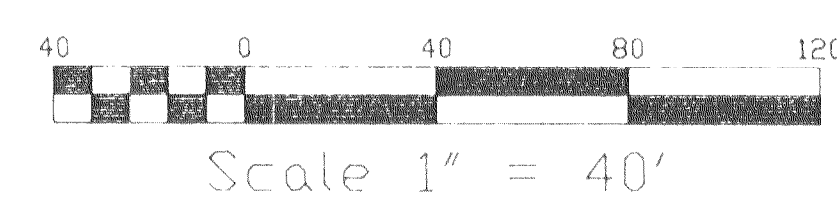

REVISIONS	The undersigned hereby certifies that this is a correct map made from an actual survey.  <div> DONALD H. FRY L.S. # 43743 LICENSED LAND SURVEYOR  </div>	SITE REMEDIATION INTERMEDIATE SURVEY OSWEGO CASTING OSWEGO, NEW YORK OSWEGO COUNTY			
			modi engineering & land surveying, p.c. CONSULTING ENGINEERS & LAND SURVEYORS 7730 FRONTAGE ROAD OSWEGO, N.Y. 13039 (315)458-8980		
NO ALTERATION PERMITTED HEREON EXCEPT AS PROVIDED UNDER SECTION 7209 SUBDIVISION 2 OF THE NEW YORK STATE EDUCATION LAW		DATE 12/4/98	SCALE 1"=40'	PROJECT NO. 9829	DWG. NO. 98029EXC.DWG

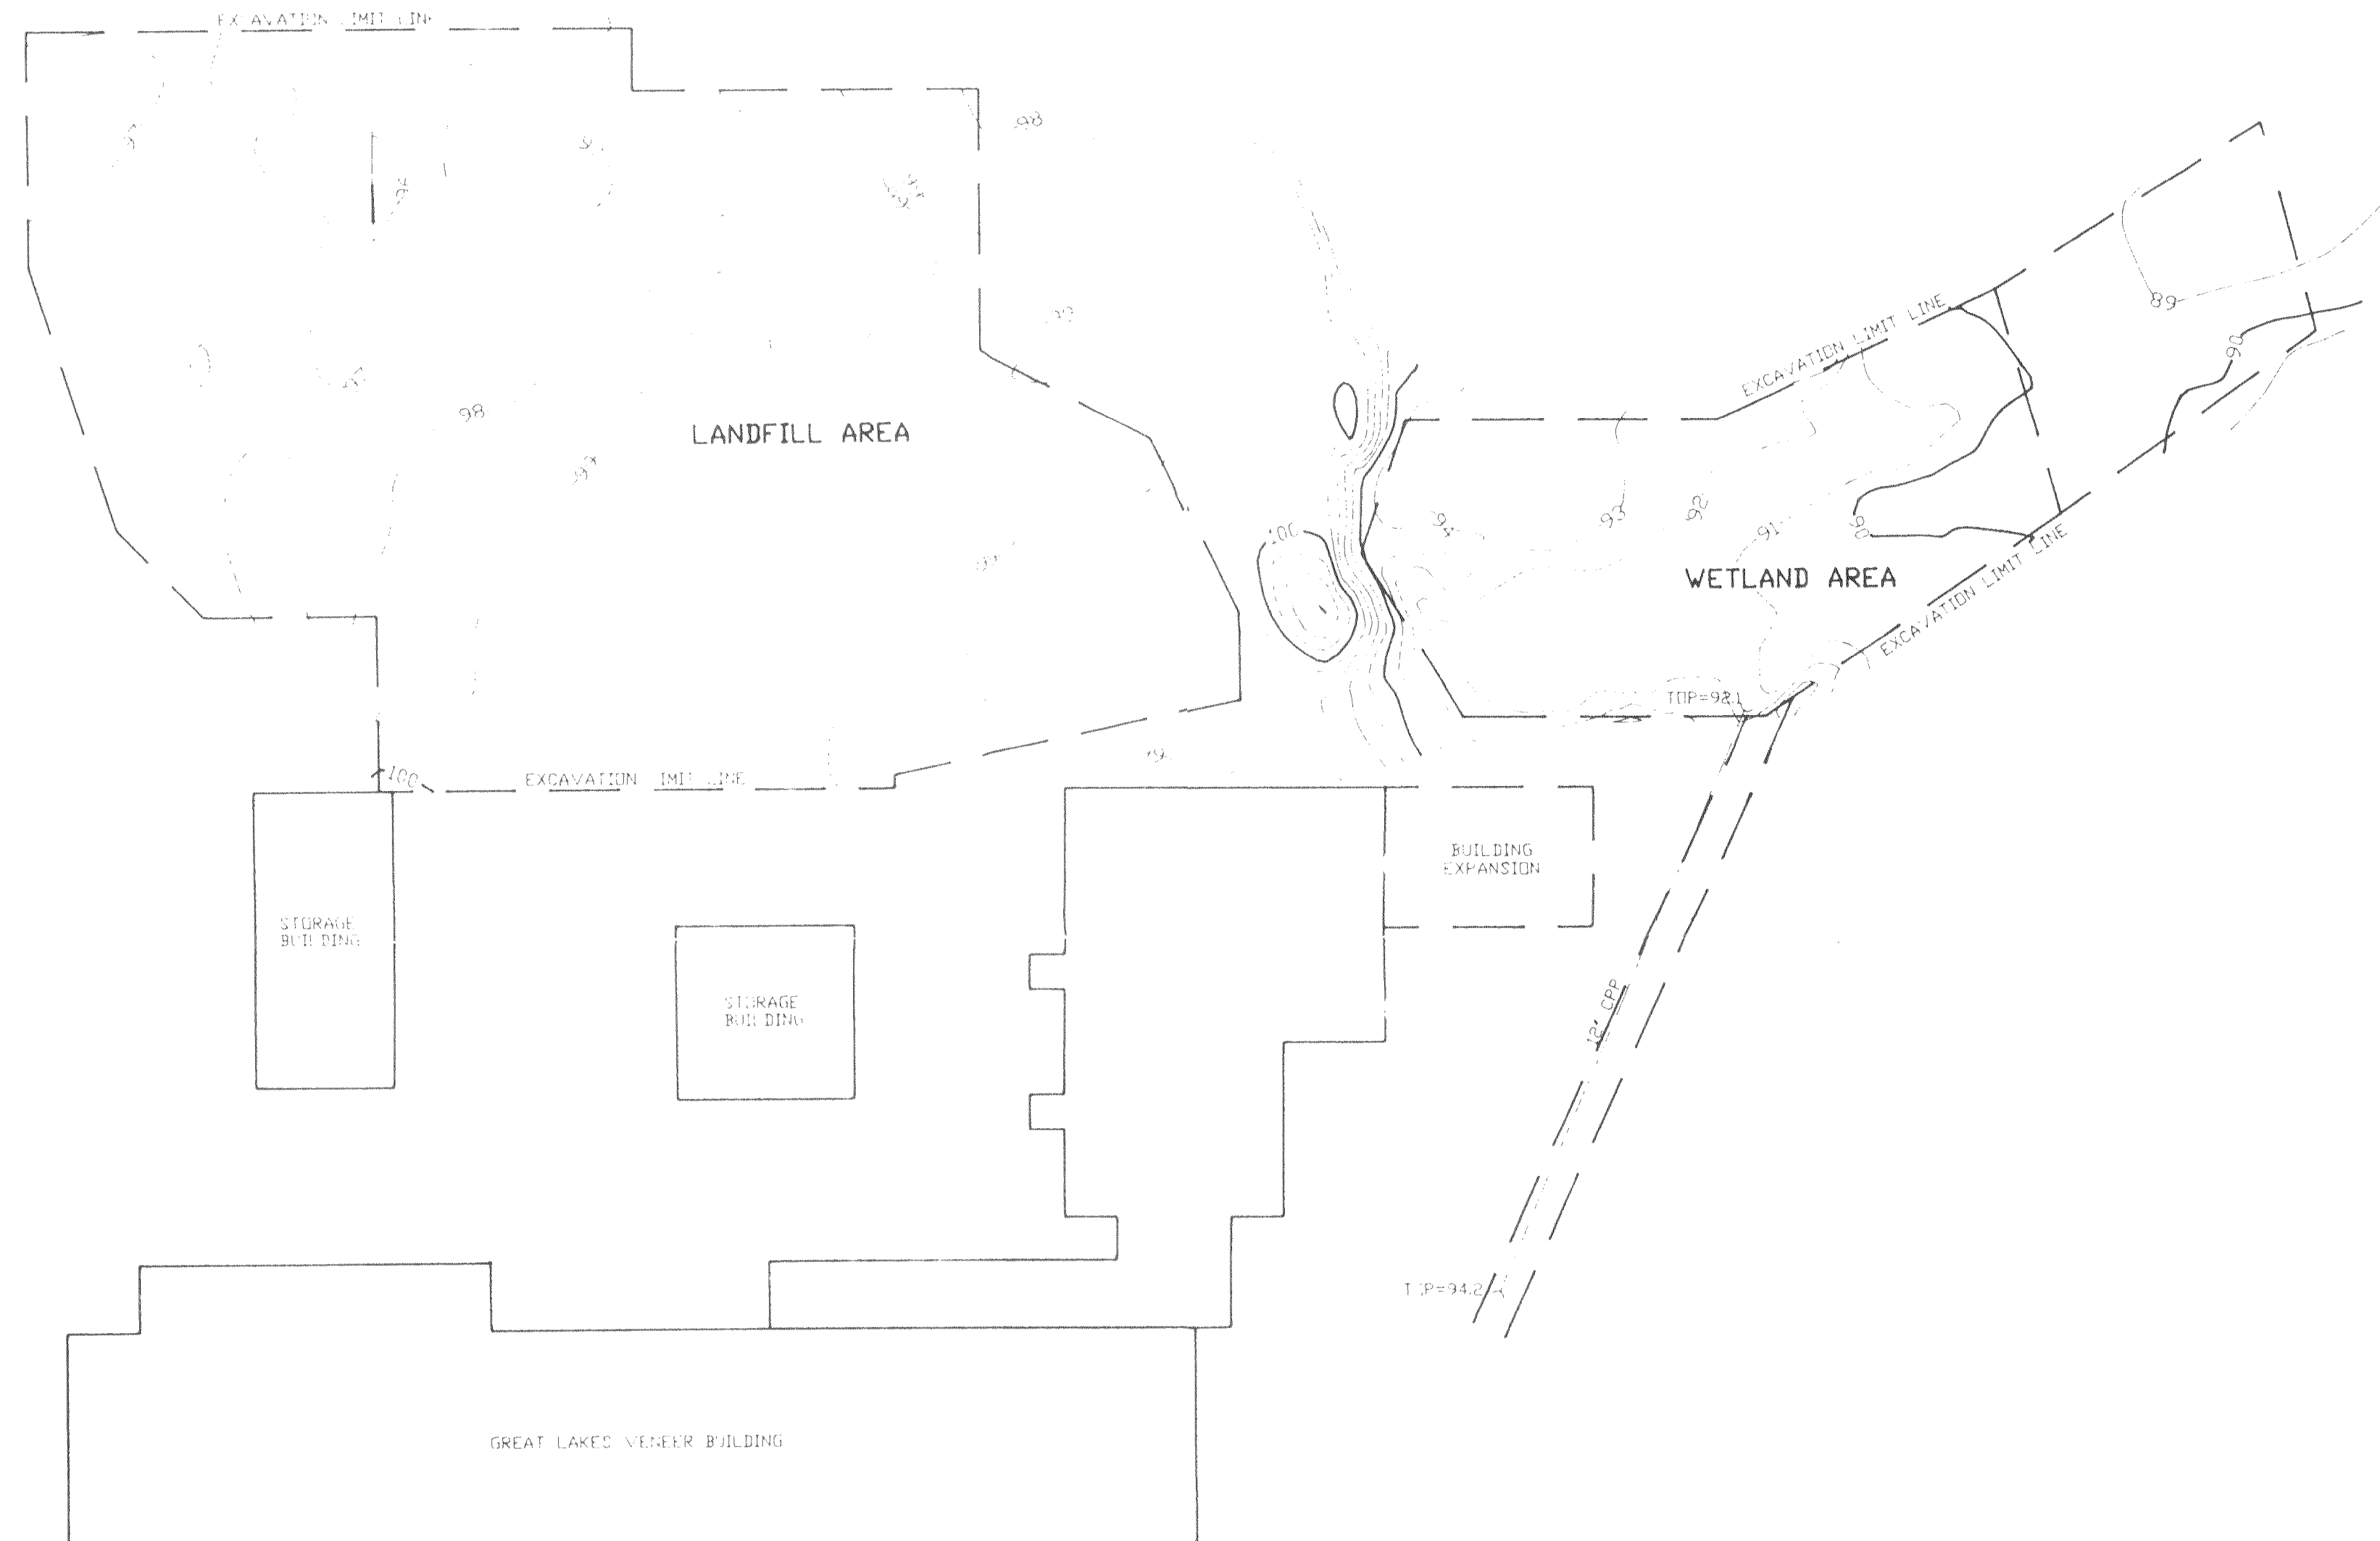





LEGEND

- 90 INDEX CONTOUR
- 89 INTERMEDIATE CONTOUR

NOTES

CONTROL DATA WAS NOT SUPPLIED TO MODI ENGINEERING.  
HORIZONTAL AND VERTICAL DATUM IS ASSUMED.  
HORIZONTAL POSITIONING ON SITE HAD TO BE DETERMINED  
BY LOCATING PHYSICAL FEATURES ON SITE.  
FIELD SURVEY WAS COMPLETED ON VARIOUS DATES  
IN JULY AND AUGUST OF 1998.  
EXISTING BUILDINGS WERE SCALED OFF CONTRACT DRAWINGS.

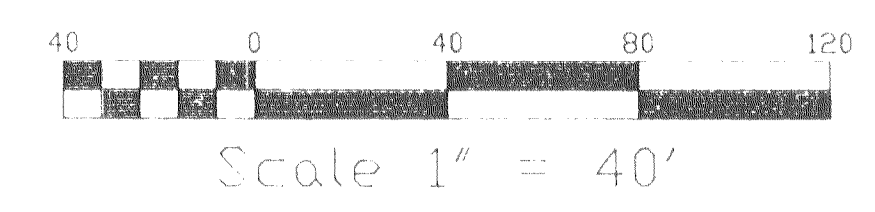

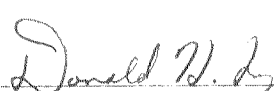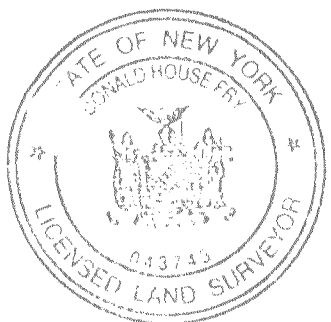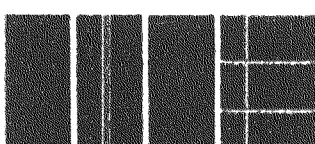REVISIONS	<p>The undersigned hereby certifies that this is a correct map made from an actual survey.</p> <p> DONALD H. FRY LS # 43743 LICENSED LAND SURVEYOR</p> <p></p>	<p>SITE REMEDIATION EXISTING CONDITIONS OSWEGO CASTING OSWEGO, NEW YORK OSWEGO COUNTY</p>			
		<p> <b>modi engineering &amp; land surveying, p.c.</b> CONSULTING ENGINEERS &amp; LAND SURVEYORS 7730 FRONTAGE ROAD OSWEGO, N.Y. 13039 (315)458-8980</p>			
		NO ALTERATION PERMITTED HEREON EXCEPT AS PROVIDED UNDER SECTION 72(9) SUBDIVISION 2 OF THE NEW YORK STATE EDUCATION LAW	DATE 12/4/98	SCALE 1"=40'	PROJECT NO. 9829



#### LEGEND

90	INDEX CONTOUR
89	INTERMEDIATE CONTOUR

#### NOTES

CONTROL DATA WAS NOT SUPPLIED TO MODI ENGINEERING.  
HORIZONTAL AND VERTICAL DATUM IS ASSUMED.  
HORIZONTAL POSITIONING ON SITE HAD TO BE DETERMINED  
BY LOCATING PHYSICAL FEATURES ON SITE.  
FIELD SURVEY WAS COMPLETED ON VARIOUS DATES  
IN OCTOBER AND NOVEMBER OF 1998.  
EXISTING BUILDINGS WERE SCALED OFF CONTRACT DRAWINGS.




Scale 1" = 40'

#### REVISIONS

The undersigned hereby certifies that this is a correct map  
made from an actual survey.

*Donald H. Fry*  
DONALD H. FRY LS # 43743  
LICENSED LAND SURVEYOR

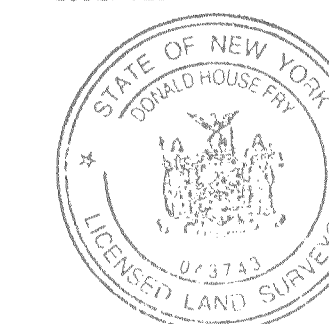

NO ALTERATION PERMITTED HEREON EXCEPT AS PROVIDED  
UNDER SECTION 7209 SUBDIVISION 2 OF THE NEW YORK  
STATE EDUCATION LAW

SITE REMEDIATION  
FINAL CONDITIONS SURVEY  
OSWEGO CASTING  
OSWEGO, NEW YORK  
OSWEGO COUNTY

**modi engineering  
& land surveying, p.c.**  
CONSULTING ENGINEERS & LAND SURVEYORS  
7730 FRONTAGE ROAD  
OSWEGO, N.Y. 13639 (315)458-8980

DATE  
12/4/98

SCALE  
1"=40'

PROJECT NO.  
9829

DWG. NO.  
98029FIN.DWG