



Existing Sealed Construction Joint

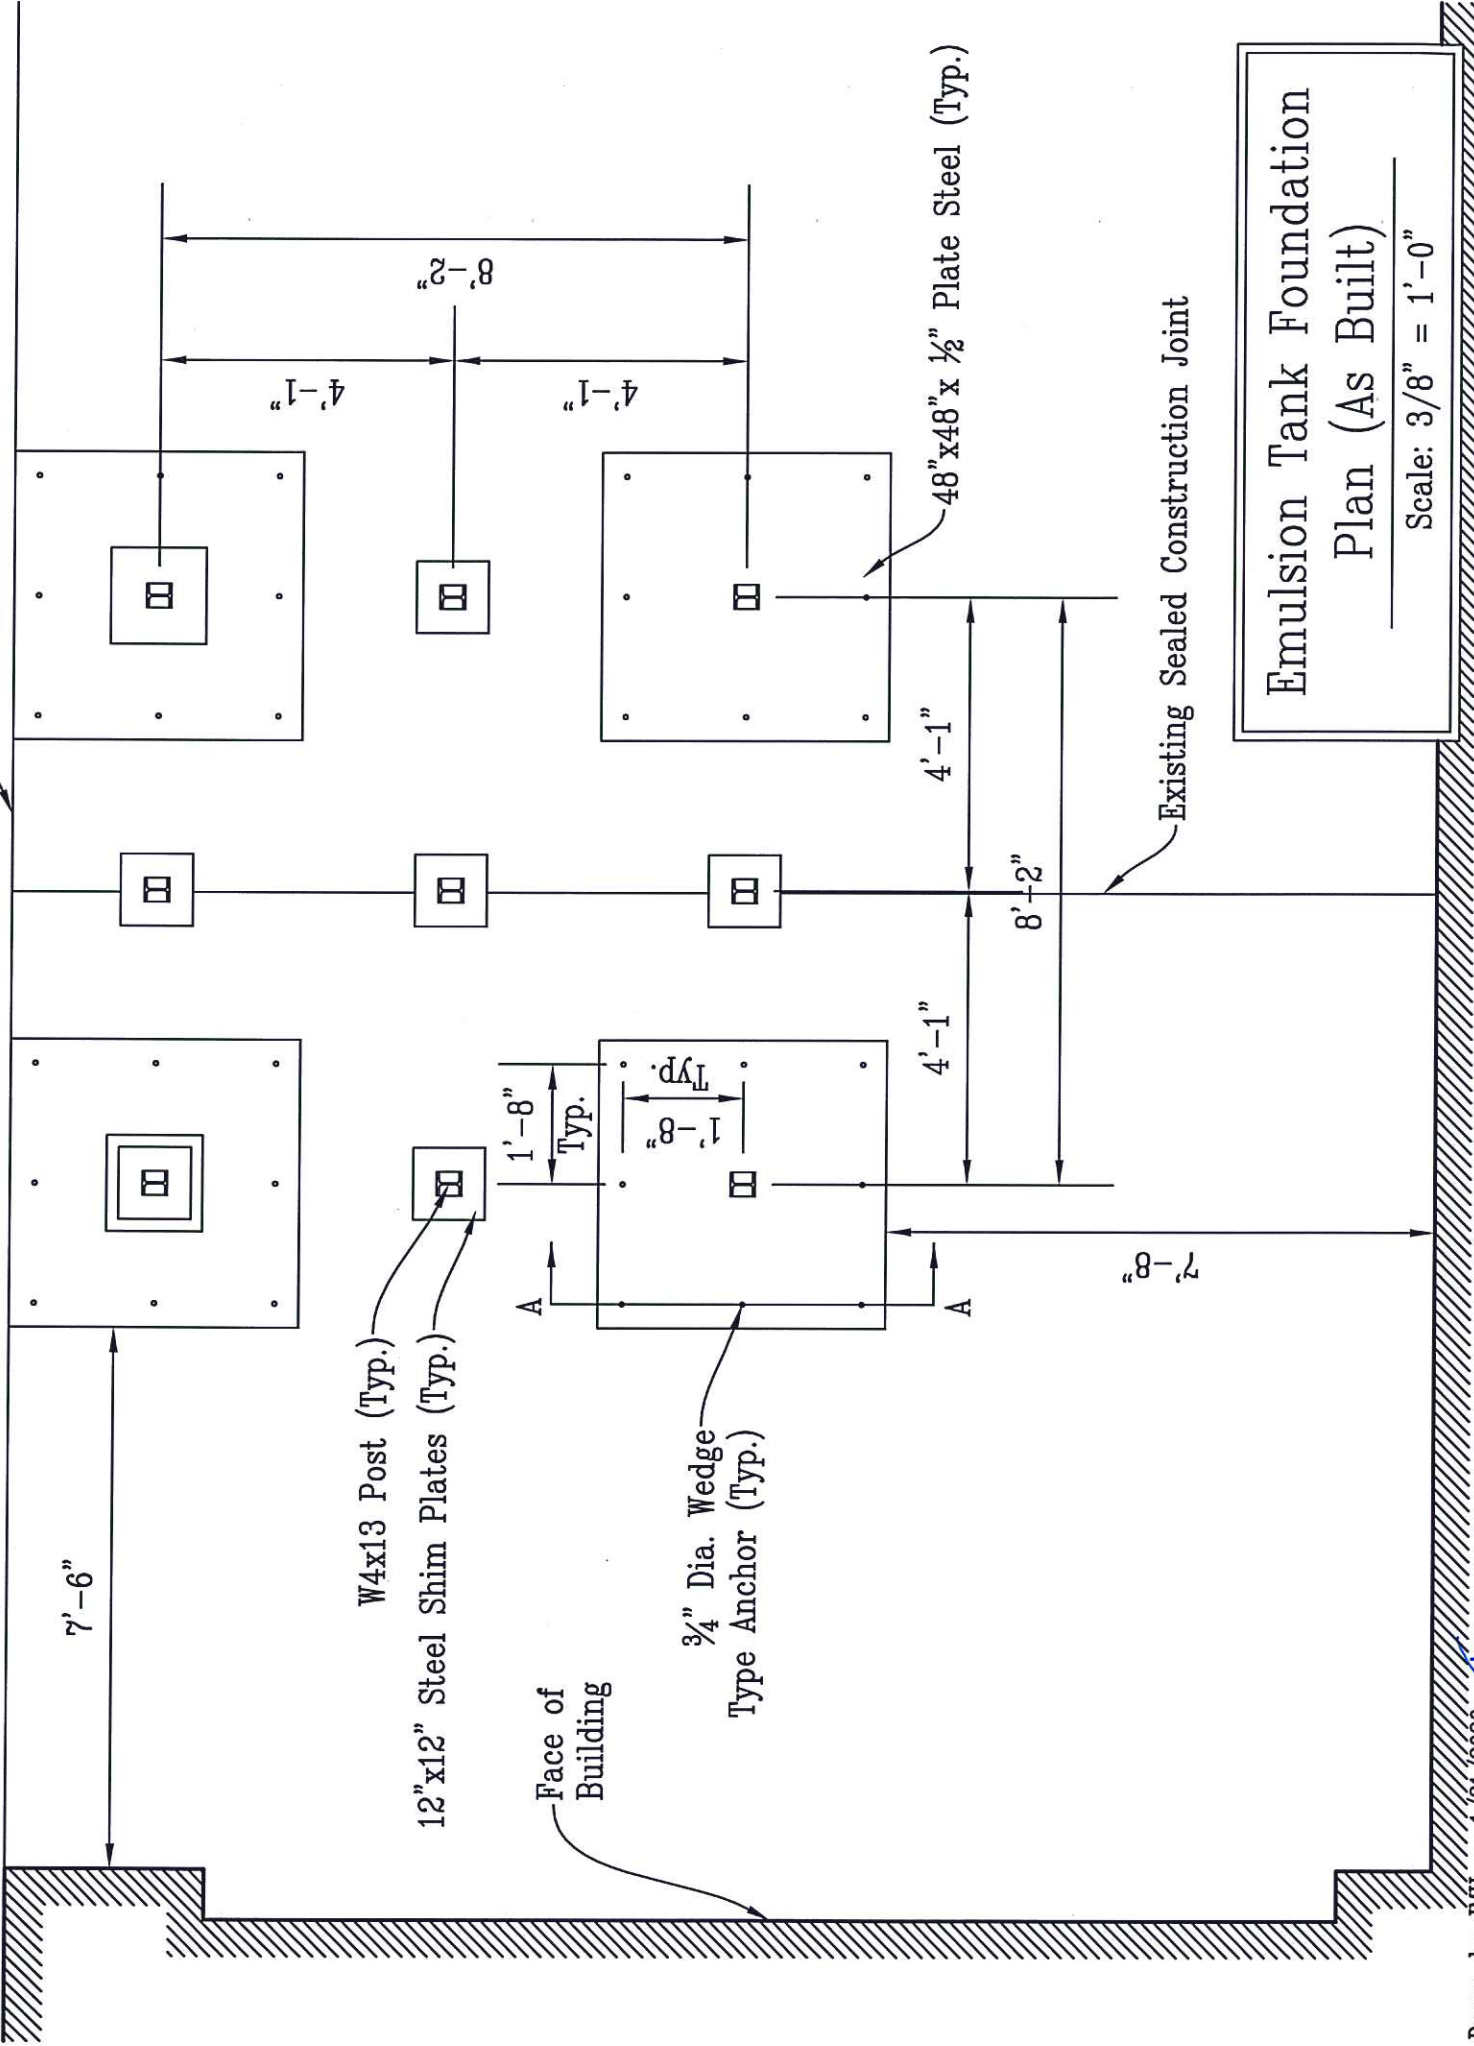

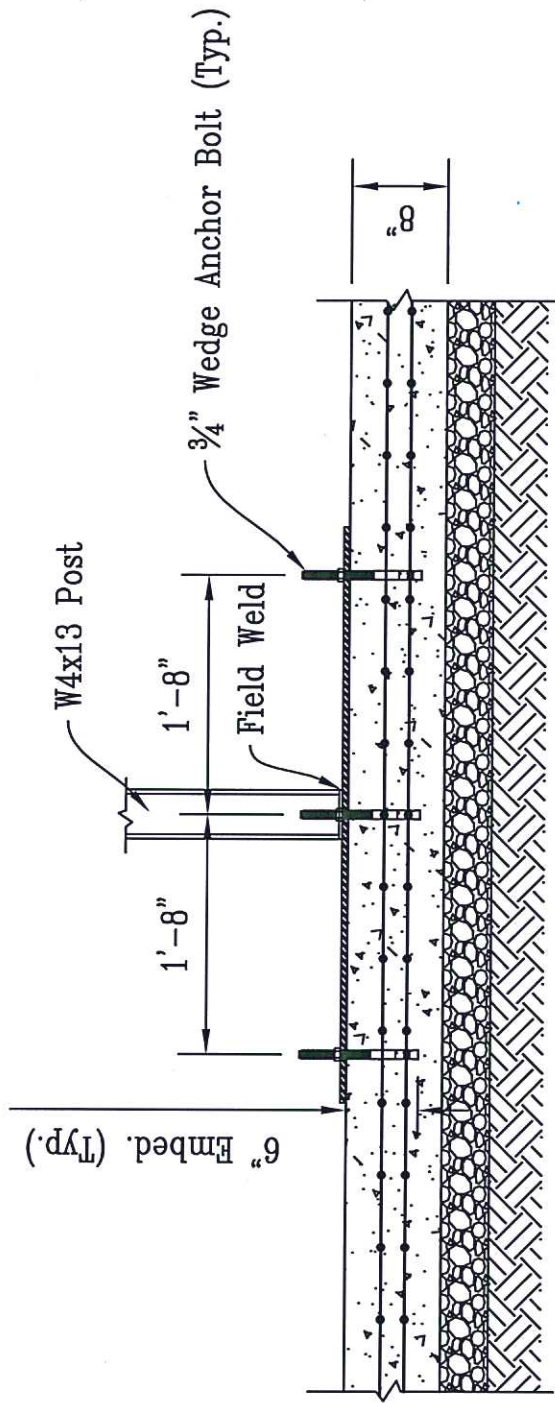

Note: According to records obtained from the NYSDEC, the existing concrete is a minimum of 8" thick with a min. compressive strength of 4000 psi. The concrete is reinforced with 2 layers of 6x6x¹⁰/₁₀ WWF, with 3" of cover.

Emulsion Tank Foundation Section A-A (As Built)

Scale: 3/4" = 1'-0"