NEW YORK STATE DEPARTMENT OF ENVIRONMENTAL CONSERVATION

Division of Environmental Permits, Region 8 6274 East Avon-Lima Road, Avon, NY 14414-9516 P: (585) 226-5400 | F: (585) 226-2830 www.dec.ny.gov

IMPORTANT NOTICE TO ALL PERMITTEES

The permit you requested is enclosed. <u>Please read it carefully and note the conditions that</u> <u>are included in it</u>. The permit is valid for only those activities expressly authorized therein. Work beyond the scope of the permit and the approved project plans may be considered a violation of the law and be subject to appropriate enforcement action. Granting of this permit does not relieve the permittee of the responsibility of obtaining any other permission, consent, or approval from any other Federal, State or local government which may be required. Please be sure to check with the local municipality regarding the potential need for local approval.

PLEASE NOTE: You must submit a <u>Notice of Intent to Commence Work</u> (attached) prior to starting work and similar notification must also be made upon completion of project as noted in the permit conditions. If a <u>Permit Notice Sign</u> is enclosed, you must post it at the work site with appropriate weather protection, as well as a copy of the permit per General Condition #1.

Please note the <u>expiration date</u> of the permit. If you need additional time to complete your project, you must submit your request for permit renewal, in writing, prior to expiration of the permit (minimum of 30 days) and submitted to the Regional Permit Administrator at the above address. Provide an explanation of why additional time is needed and how much additional time you are requesting. Please refer to the general conditions listed in the permit for specific instructions. For SPDES, solid Waste and Hazardous Waste Permits, renewal applications must be made at least 180 days prior to the expiration date.

The DEC permit number & Program ID number noted on page 1 under "Permit Authorization" of the permit are important and should be retained for your records. These numbers should be referenced on all correspondence related to the permit, and on any future applications for permits associated with this facility/project area.

For many projects involving work in and around streams, lakes and wetlands the US Army Corps of Engineers (USACE) may have regulatory authority in addition to this Department. If you have not already done so, you should contact their Buffalo District Regulatory Branch office at 716-879-4330 to obtain any required federal authorizations prior to commencing work. Also, as a reminder, be sure to verify whether any local approvals are required for the project.

If you have any questions on the extent of the work authorized or your obligations under the permit, please feel free to contact me at 585-226-5382.

Sincerely,

Francer Knighnelyon

Frances Knickmeyer Environmental Analyst





PERMIT Under the Environmental Conservation Law (ECL)

Permittee and Facility Information

Permit Issued To: NYS Dept of Environmental Conservation

625 BROADWAY ALBANY, NY 12233 Facility: GENESEE RIVER REMEDIAL RIVER DREDGING GENESEE RIVER - N OF ST RTE 104 ROCHESTER, NY

Facility Location: in ROCHESTER in MONROE COUNTYVillage: RochesterFacility Principal Reference Point:NYTM-E: 287.604NYTM-N: 4788.707Latitude:43°13'16.6"Longitude: 77°36'54.6"

Project Location: Genesee River, between Turning Point Park & King's Landing WWTP **Authorized Activity:** Remediate portions of the Lower Genesee River and its adjacent wetlands by conducting environmental dredging and excavation to remove sediments contaminated from the historic releases of silver from Kodak's former operations at the Eastman Business Park located adjacent to the Lower Genesee River. The site includes approximately 2.5 miles of the Lower Genesee River and adjoining wetland and floodplain.

In-river dredging to a depth of 2.5 feet will occur at two separate locations totaling 2.9 acres. The inriver dredge area includes regulated Adjacent Area for NYS Freshwater Wetland RH-8. Approximately 14,500 CY will be removed at in-river locations. An isolation cap will be placed over dredged areas of the riverbed to minimize changes in surface elevation. Wetland excavation to a depth of 2.5 feet over 2.2 acres (9,400 CY) will occur in NYS Regulated Freshwater Wetland RH-21. To minimize changes in surface elevation, backfill will be placed in excavated areas of the wetlands.

As specified in Natural Resources Special Condition 5, the following in-water work restrictive periods apply:

- For the protection of warm/cool water species, **dredging and filling is prohibited from April 15 through June 30** in the main river channel (AOC-1 and AOC-2).
- For the protection of migratory Lake Ontario salmonoid species and hatchery raised lake sturgeon, in-river work (dredging and filling) is prohibited from October 1 through November 30.

MODIFICATION 1: Revisions to the design of Wetland C, including deeper access channels to facilitate dredge access and to support variable finished topography (Attachment A). The channels will consist of variable edges. During 2021, the in-river work restrictive period specified in Natural Resources Special Condition 5.b. is October 31 through November 30.

Permit Authorizations

Water Quality Certification - Under Section 401 - Clean Water Act

Permit ID 8-2614-00963/00002

New Permit Modification # 1 Effective Date: <u>11/18/2020</u> Effective Date: <u>5/20/2021</u> Expiration Date: $\frac{12/31/2022}{12/31/2022}$

NYSDEC Approval

By acceptance of this permit, the permittee agrees that the permit is contingent upon strict compliance with the ECL, all applicable regulations, and all conditions included as part of this permit.

Permit Administrator: ROBERT B CALL, Deputy Permit Administrator Address: NYSDEC Region 8 Headquarters 6274 E Avon-Lima Rd Avon, NY 14414

Authorized Signature:

Date 05/19/2021

Permit Components

NATURAL RESOURCE PERMIT CONDITIONS

WATER QUALITY CERTIFICATION SPECIFIC CONDITION

GENERAL CONDITIONS, APPLY TO ALL AUTHORIZED PERMITS

NOTIFICATION OF OTHER PERMITTEE OBLIGATIONS

NATURAL RESOURCE PERMIT CONDITIONS - Apply to the Following Permits: WATER QUALITY CERTIFICATION

1. Conformance With Plans All activities authorized by this permit must be in strict conformance with the approved plans submitted by the applicant or applicant's agent as part of the permit application. Such approved plans were prepared by Parsons, contained within Attachment H of the NYSDEC permit application package, as cited in Natural Resources Special Condition 2.

2. Conformance with Plans - Addenda In addition to plans referenced in the Condition titled "Conformance with Plans," the activities authorized by this permit must be in strict conformance with the following approved plans and/or submissions made as part of the permit application:

NEW YORK STATE DEPARTMENT OF ENVIRONMENTAL CONSERVATION Facility DEC ID 8-2614-00963



- a. Plans prepared by Parsons, titled "Lower Genesee River Corrective Measures Remedial Construction", drawing numbers 448923-G-001, 448923-G-002, 448923-C-001 through 448923-C-008, 448923-C-010, 448923-C-011, 448923-C-013, 448923-C-014, 448923-C-017, 448923-C-019, and 448923-C-020 dated June 25, 2020, last revised October 8, 2020, received by NYSDEC October 19, 2020.
- Plans prepared by Parsons, titled "Lower Genesee River CMS, Section XI, Supplemental Specs", sections "02 21 00 Surveys", "02 22 00 Pre- and Post-Condition Surveys", "02 51 00 Decon Procedures", and "31 11 00 Clearing & Grubbing", dated June 23, 2020, received by NYSDEC October 19, 2020.
- c. Plans prepared by Parsons, titled "Lower Genesee River CMS, Section XI, Supplemental Specs", section "02 72 00 Construction Water Management", dated June 24, 2020, received by NYSDEC October 19, 2020.
- d. Plans prepared by Parsons, titled "Lower Genesee River CMS, Section XI, Supplemental Specs", sections "02 81 00 Off-Site Transportation & Disposal", "31 25 00 Erosion & Sediment Control", "32 72 00 Wetland Restoration", "35 20 23 Dredging", "35 20 30 Dredge Material Management & Processing", "35 20 50 Backfilling and Capping", and "35 80 00 Turbidity Controls and Monitoring", dated June 23, 2020, last revised August 13, 2020, received by NYSDEC October 19, 2020.
- e. Plans prepared by Parsons, titled "Lower Genesee River CMS, Section XI, Supplemental Specs", section "01 74 19 Waste Removal, Handling and Storage", dated June 23, 2020, last revised October 5, 2020, received by NYSDEC October 19, 2020.
- f. Plans prepared by Parsons, titled "Lower Genesee River CMS, Section XI, Supplemental Specs", section "35 00 00 Waterway & Marine Construction", dated June 23, 2020, last revised July 29, 2020, received by NYSDEC October 19, 2020.
- g. Plans prepared by Parsons, titled "Lower Genesee River CMS, Section XI, Supplemental Specs", section "01 11 13 Summary of Work", dated June 23, 2020, last revised October 8, 2020, received by NYSDEC October 19, 2020.
- Plans prepared by Parsons, titled "Lower Genesee River Corrective Measures Remedial Construction", drawing numbers 448923-C-009, 448923-C-012, 448923-C-015, and 448923-C-018, dated November 24, 2020, last revised May 14, 2021, received by NYSDEC May 14, 2021 (Attachment A).
- i. Plans prepared by Parsons, titled "Lower Genesee River Corrective Measures Remedial Construction", drawing number 448923-C-016, dated November 24, 2020, last revised April 30, 2021, received by NYSDEC May 14, 2021 (Attachment A).

3. Notice of Intent to Commence Work The permittee shall submit a Notice of Intent to Commence Work to the Region 8 Division of Environmental Permits, Attention: Frances Knickmeyer (frances.knickmeyer@dec.ny.gov) at least 48 hours in advance of the time of commencement and shall also notify them promptly in writing of the completion of work.



4. Post Permit Sign The permit sign enclosed with this permit shall be posted in a conspicuous location on the worksite and adequately protected from the weather.

5. In-Water Work Restrictive Periods

- a. For the protection of warm/cool water species, dredging and filling is prohibited from April 15 through June 30 in the main river channel (AOC-1 and AOC-2).
- b. For the protection of migratory Lake Ontario salmonoid species and hatchery raised lake sturgeon, in-river work (dredging and filling) is prohibited from October 1 through November 30.
 - i. For 2021, in-river work is prohibited from October 31 through November 30.
- c. In-river work related to site mobilization is permitted between April 15 and June 30; this includes the installation of temporary shoreline support features and mooring points.
- d. Work within Wetland C will be permitted from June 1 through April 14. This includes clearing and wetland soil removal. Removed soil may be transported by barge to the site staging area.

6. Best Management Practices Best management practices will be employed and maintained for the duration of the project to prevent the loss of construction materials, debris and sediment from entering the wetlands or waterways. Such practices may include, but are not limited to construction fencing, staked hay bales, silt fencing, and turbidity curtains.

7. Seed and Mulch Disturbed Areas All areas of soil disturbance resulting from this project shall be stabilized immediately following project completion or prior to permit expiration, whichever comes first. The approved methodologies are as follows:

- a. Stabilization of the entire disturbed area with appropriate vegetation (grasses, etc.);
- b. Stabilized as per specifications identified on approved plans;
- c. Temporarily stabilized with straw or hay mulch or jute matting or other similar natural fiber matting within 7 days of final grading.

Temporary stabilization shall be maintained until a mature vegetative cover is established to the Department's satisfaction.

8. Clean Fill Material Only Fill material must consist only of clean inorganic sand, gravel, stone, or soil. No other materials are to be used unless specifically authorized by this permit.

9. Dredged Material Dewatering and Disposal Dredged and excavated material must be dewatered on-site in floating scows or onshore in the sediment loading and staging area within a delineated material handling area. Dewatered material must be disposed of at an offsite landfill.

10. Minimize Adverse Impacts to Wetlands, Wildlife, Water All work must be performed in a manner which minimizes adverse impacts to wetlands, wildlife, water quality and natural resources.



11. No Interference With Navigation There shall be no unreasonable interference with navigation by the work herein authorized.

12. Precautions Against Contamination of Waters All necessary precautions shall be taken to preclude contamination of any wetland or waterway by suspended solids, sediments, fuels, solvents, lubricants, epoxy coatings, paints, concrete, leachate or any other environmentally deleterious materials associated with the project.

13. Prior Approval of Changes If the Permittee desires to make any changes in construction techniques, species to be planted, the site plan, any mitigation plan, scheduling or staging of construction, or any other aspect of this project, the Permittee shall submit a written request to the Regional Permit Administrator to make such proposed changes and shall not make such changes unless authorized in writing by the Department.

14. Failure to Meet Permit Conditions Failure of the permittee to meet all the conditions of this permit is a violation of this permit and grounds for an order to immediately cease the permitted activity at the project site.

WATER QUALITY CERTIFICATION SPECIFIC CONDITIONS

1. Water Quality Certification The authorized project, as conditioned pursuant to the Certificate, complies with Section 301, 302, 303, 306, and 307 of the Federal Water Pollution Control Act, as amended and as implemented by the limitations, standards, and criteria of state statutory and regulatory requirements set forth in 6 NYCRR Section 608.9(a). The authorized project, as conditioned, will also comply with applicable New York State water quality standards, including but not limited to effluent limitations, best usages and thermal discharge criteria, as applicable, as set forth in 6 NYCRR Parts 701, 702, 703, and 704.

2. Water Quality Certification The authorized project, as conditioned pursuant to the Certificate, complies with Section 301, 302, 303, 306, and 307 of the Federal Water Pollution Control Act, as amended and as implemented by the limitations, standards, and criteria of state statutory and regulatory requirements set forth in 6 NYCRR Section 608.9(a). The authorized project, as conditioned, will also comply with applicable New York State water quality standards, including but not limited to effluent limitations, best usages and thermal discharge criteria, as applicable, as set forth in 6 NYCRR Parts 701, 702, 703, and 704.

GENERAL CONDITIONS - Apply to ALL Authorized Permits:

1. Facility Inspection by The Department The permitted site or facility, including relevant records, is subject to inspection at reasonable hours and intervals by an authorized representative of the Department of Environmental Conservation (the Department) to determine whether the permittee is complying with this permit and the ECL. Such representative may order the work suspended pursuant to ECL 71- 0301 and SAPA 401(3).

The permittee shall provide a person to accompany the Department's representative during an inspection to the permit area when requested by the Department.

A copy of this permit, including all referenced maps, drawings and special conditions, must be available for inspection by the Department at all times at the project site or facility. Failure to produce a copy of the permit upon request by a Department representative is a violation of this permit.

2. Relationship of this Permit to Other Department Orders and Determinations Unless expressly provided for by the Department, issuance of this permit does not modify, supersede or rescind any order or determination previously issued by the Department or any of the terms, conditions or requirements contained in such order or determination.

3. Applications For Permit Renewals, Modifications or Transfers The permittee must submit a separate written application to the Department for permit renewal, modification or transfer of this permit. Such application must include any forms or supplemental information the Department requires. Any renewal, modification or transfer granted by the Department must be in writing. Submission of applications for permit renewal, modification or transfer are to be submitted to:

Regional Permit Administrator NYSDEC Region 8 Headquarters 6274 E Avon-Lima Rd Avon, NY14414

4. Submission of Renewal Application The permittee must submit a renewal application at least 30 days before permit expiration for the following permit authorizations: Water Quality Certification.

5. Permit Modifications, Suspensions and Revocations by the Department The Department reserves the right to exercise all available authority to modify, suspend or revoke this permit. The grounds for modification, suspension or revocation include:

- a. materially false or inaccurate statements in the permit application or supporting papers;
- b. failure by the permittee to comply with any terms or conditions of the permit;
- c. exceeding the scope of the project as described in the permit application;
- d. newly discovered material information or a material change in environmental conditions, relevant technology or applicable law or regulations since the issuance of the existing permit;
- e. noncompliance with previously issued permit conditions, orders of the commissioner, any provisions of the Environmental Conservation Law or regulations of the Department related to the permitted activity.

6. Permit Transfer Permits are transferrable unless specifically prohibited by statute, regulation or another permit condition. Applications for permit transfer should be submitted prior to actual transfer of ownership.



NOTIFICATION OF OTHER PERMITTEE OBLIGATIONS

Item A: Permittee Accepts Legal Responsibility and Agrees to Indemnification

The permittee, excepting state or federal agencies, expressly agrees to indemnify and hold harmless the Department of Environmental Conservation of the State of New York, its representatives, employees, and agents ("DEC") for all claims, suits, actions, and damages, to the extent attributable to the permittee's acts or omissions in connection with the permittee's undertaking of activities in connection with, or operation and maintenance of, the facility or facilities authorized by the permit whether in compliance or not in compliance with the terms and conditions of the permit. This indemnification does not extend to any claims, suits, actions, or damages to the extent attributable to DEC's own negligent or intentional acts or omissions, or to any claims, suits, or actions naming the DEC and arising under Article 78 of the New York Civil Practice Laws and Rules or any citizen suit or civil rights provision under federal or state laws.

Item B: Permittee's Contractors to Comply with Permit

The permittee is responsible for informing its independent contractors, employees, agents and assigns of their responsibility to comply with this permit, including all special conditions while acting as the permittee's agent with respect to the permitted activities, and such persons shall be subject to the same sanctions for violations of the Environmental Conservation Law as those prescribed for the permittee.


Item C: Permittee Responsible for Obtaining Other Required Permits

The permittee is responsible for obtaining any other permits, approvals, lands, easements and rights-ofway that may be required to carry out the activities that are authorized by this permit.


Item D: No Right to Trespass or Interfere with Riparian Rights

This permit does not convey to the permittee any right to trespass upon the lands or interfere with the riparian rights of others in order to perform the permitted work nor does it authorize the impairment of any rights, title, or interest in real or personal property held or vested in a person not a party to the permit.



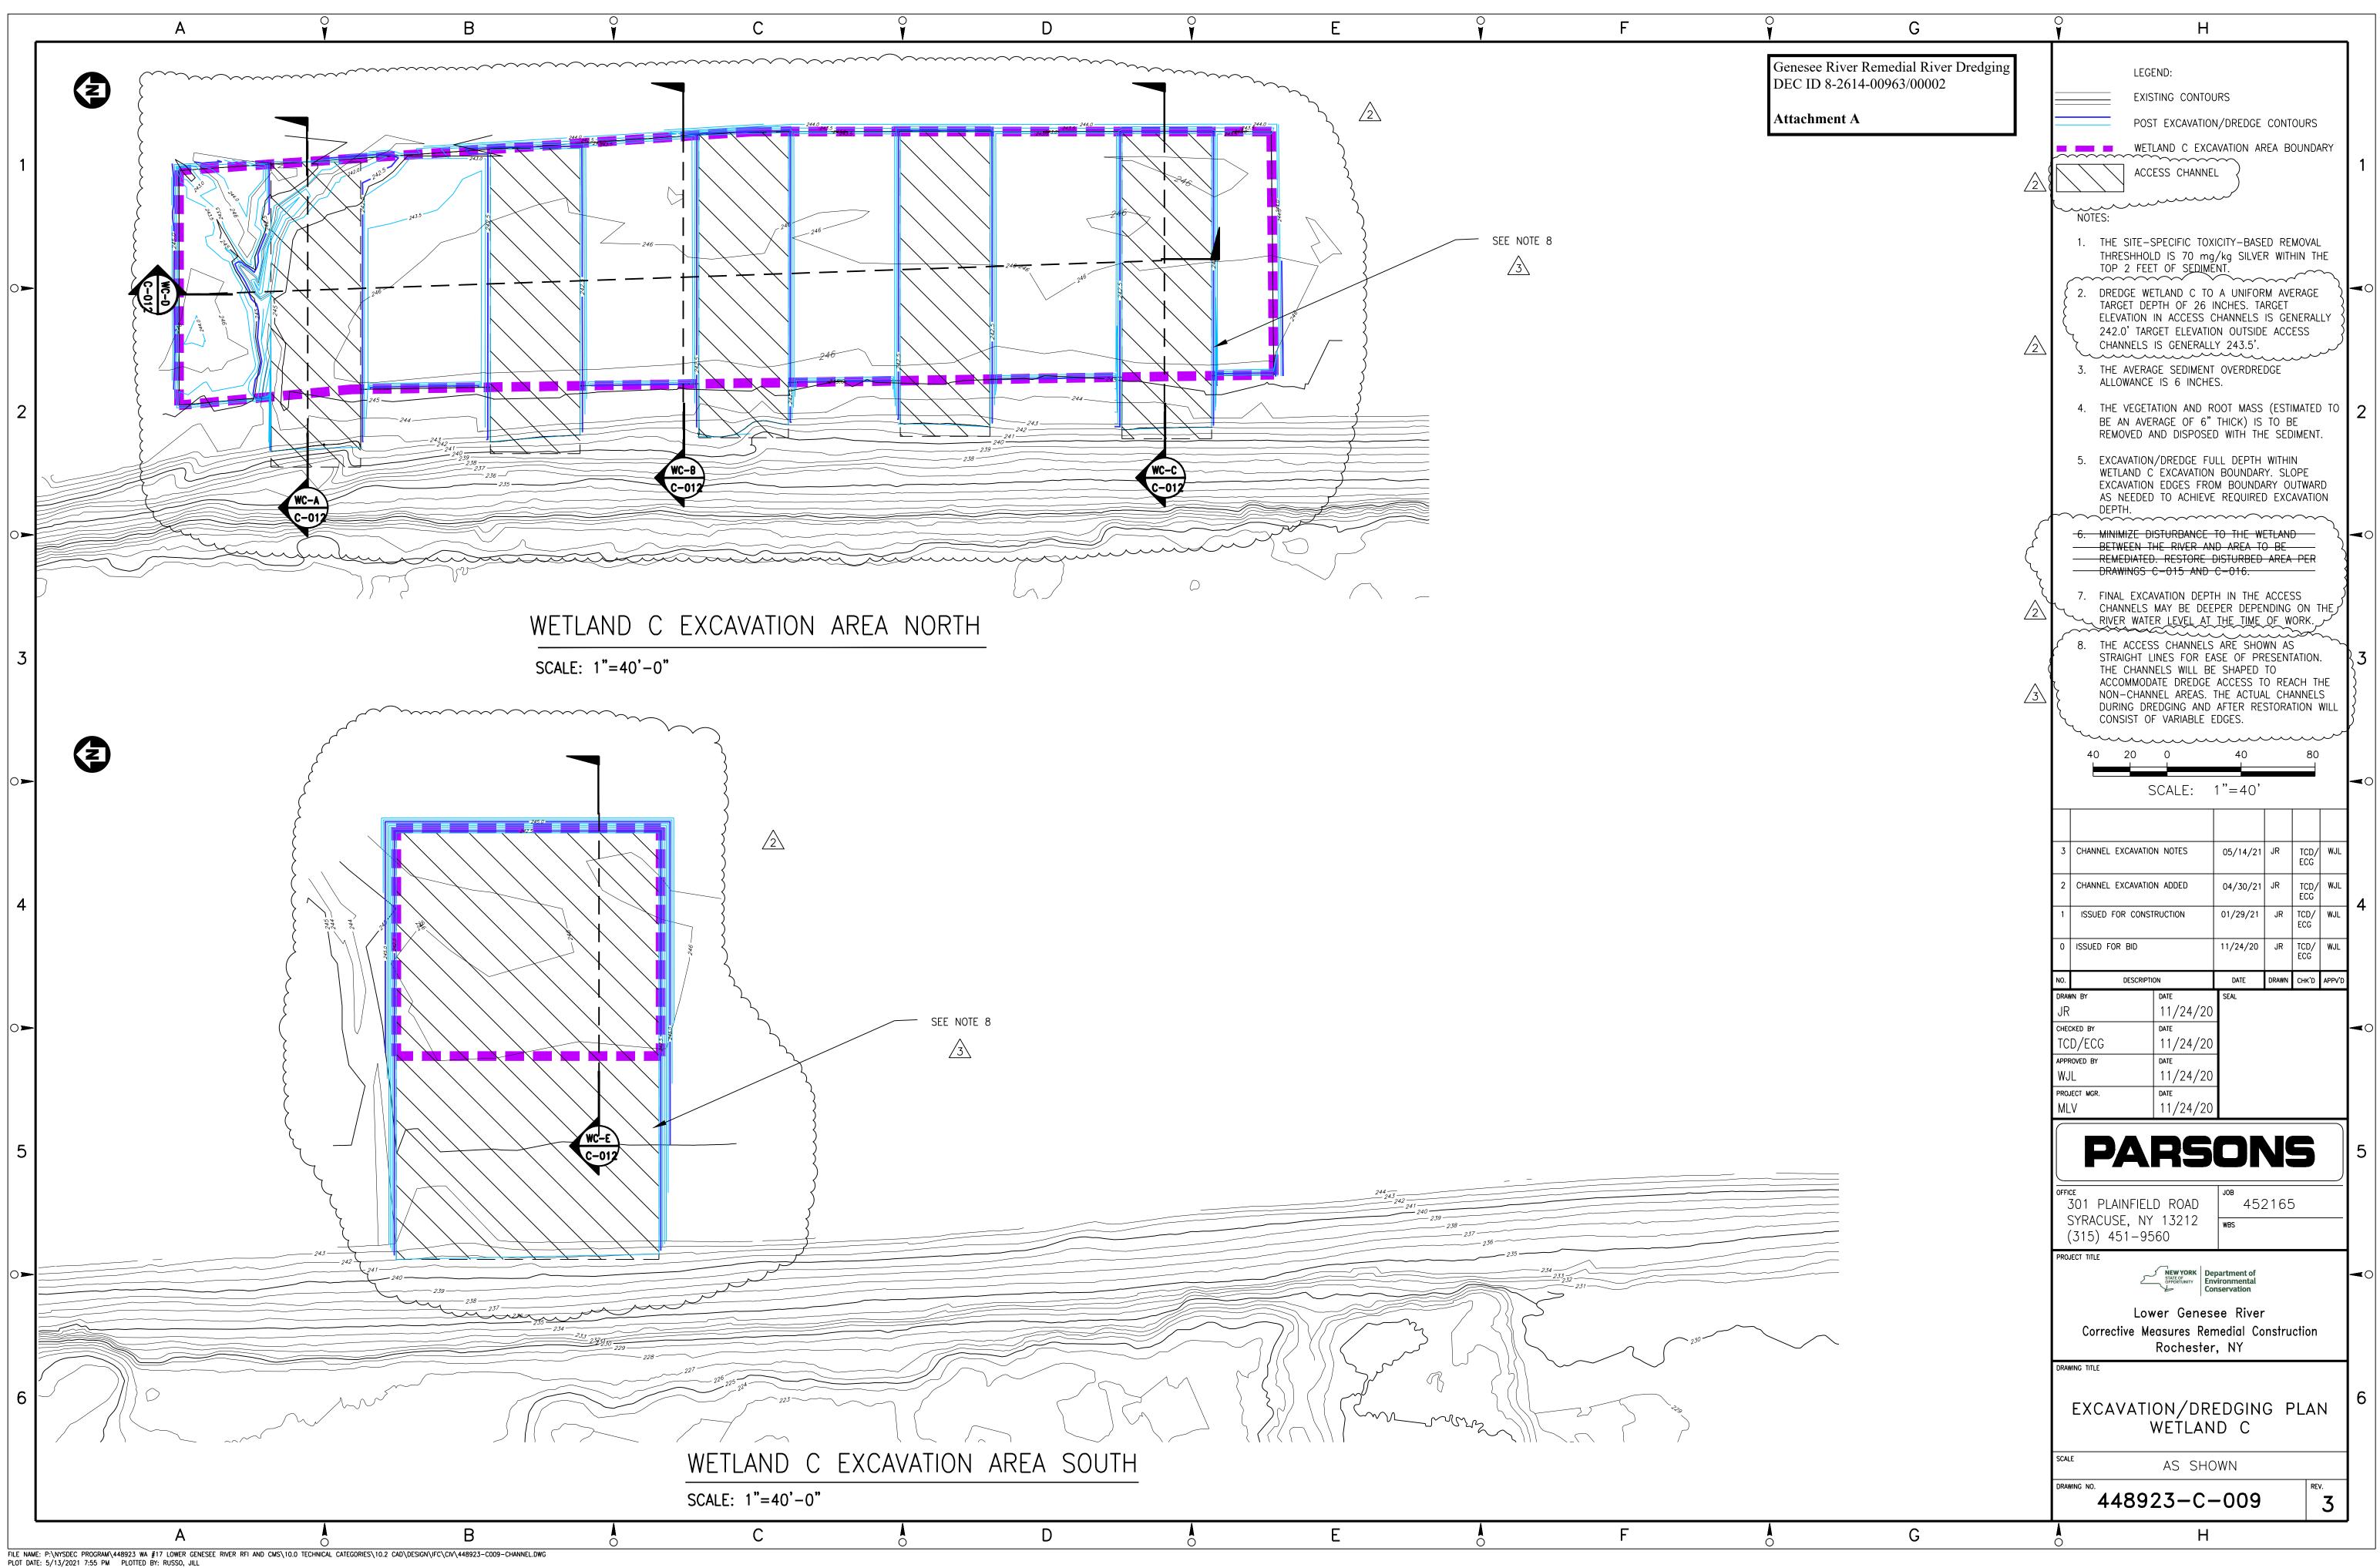


		_		_		
					A	
Ċ		U i	<u>`</u>			1
L L)	()	(5	

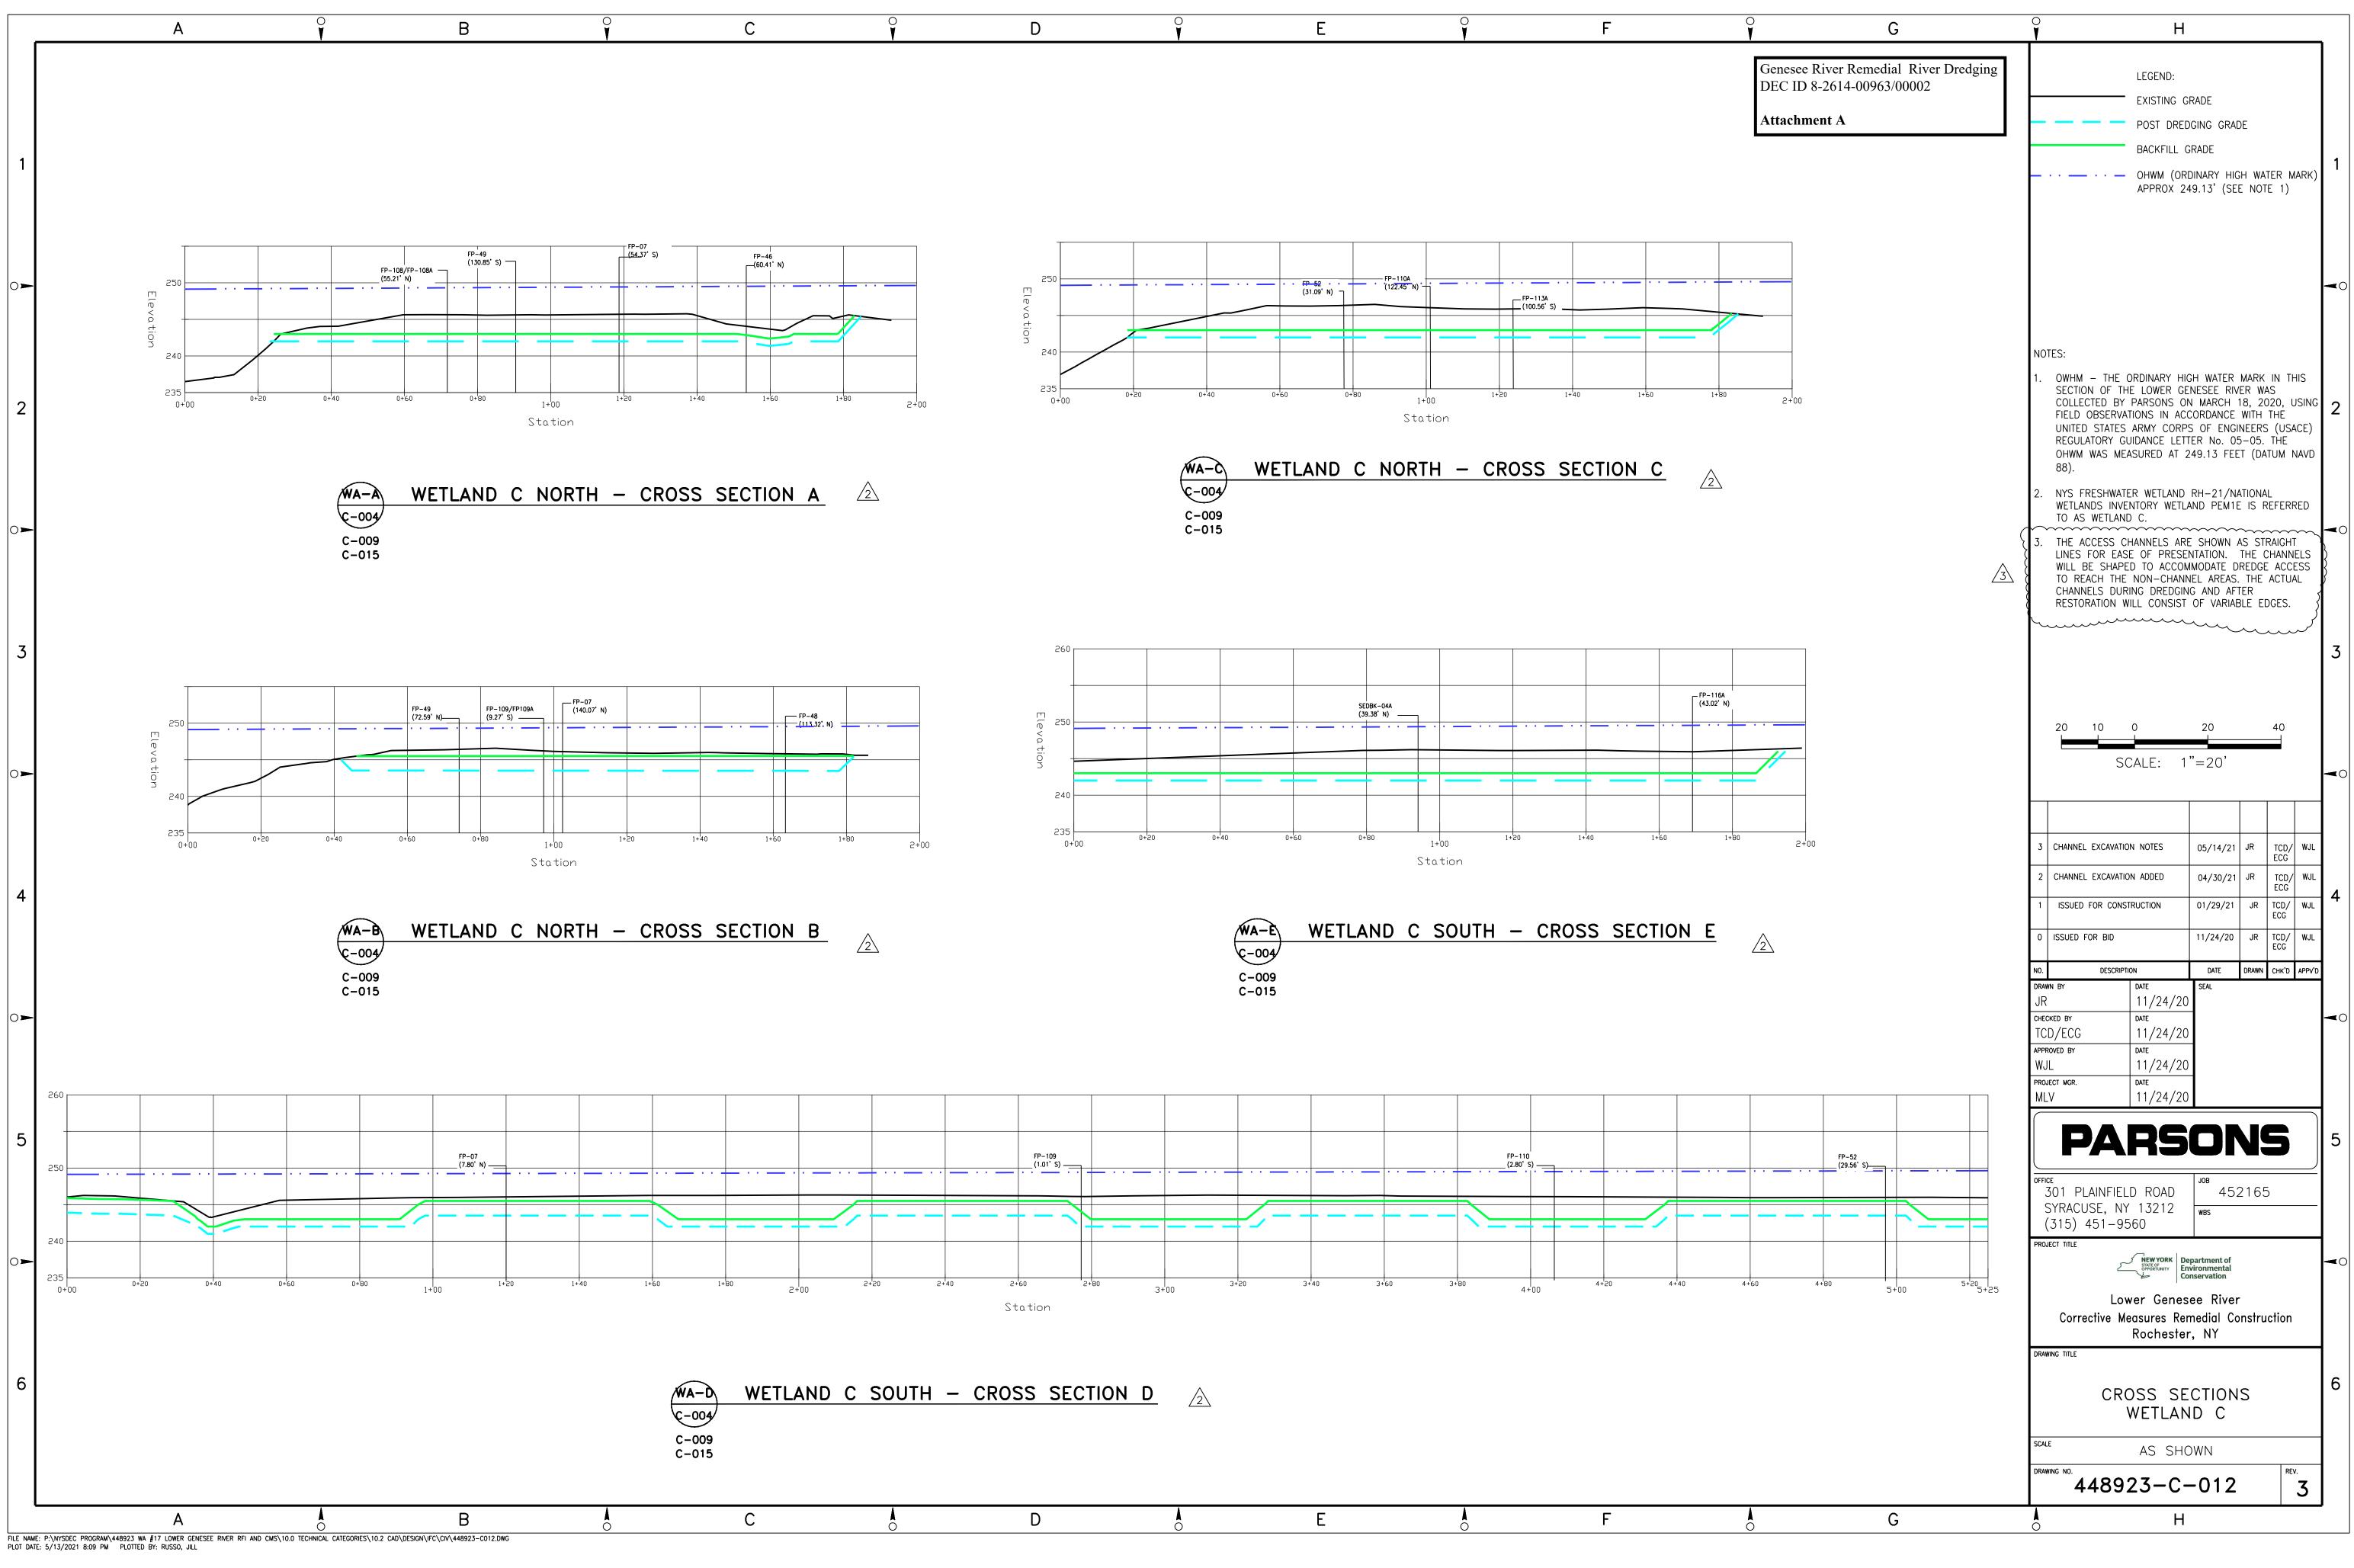

0		0	Г	0	Г	
¥	D	Y	E	¥	F	

WA-E	WETLAND	С	SOUTH	—	CROSS	SECTION	E
C-004							
C-009							
C-015							

D	Å	E	\mathbf{A}	F	

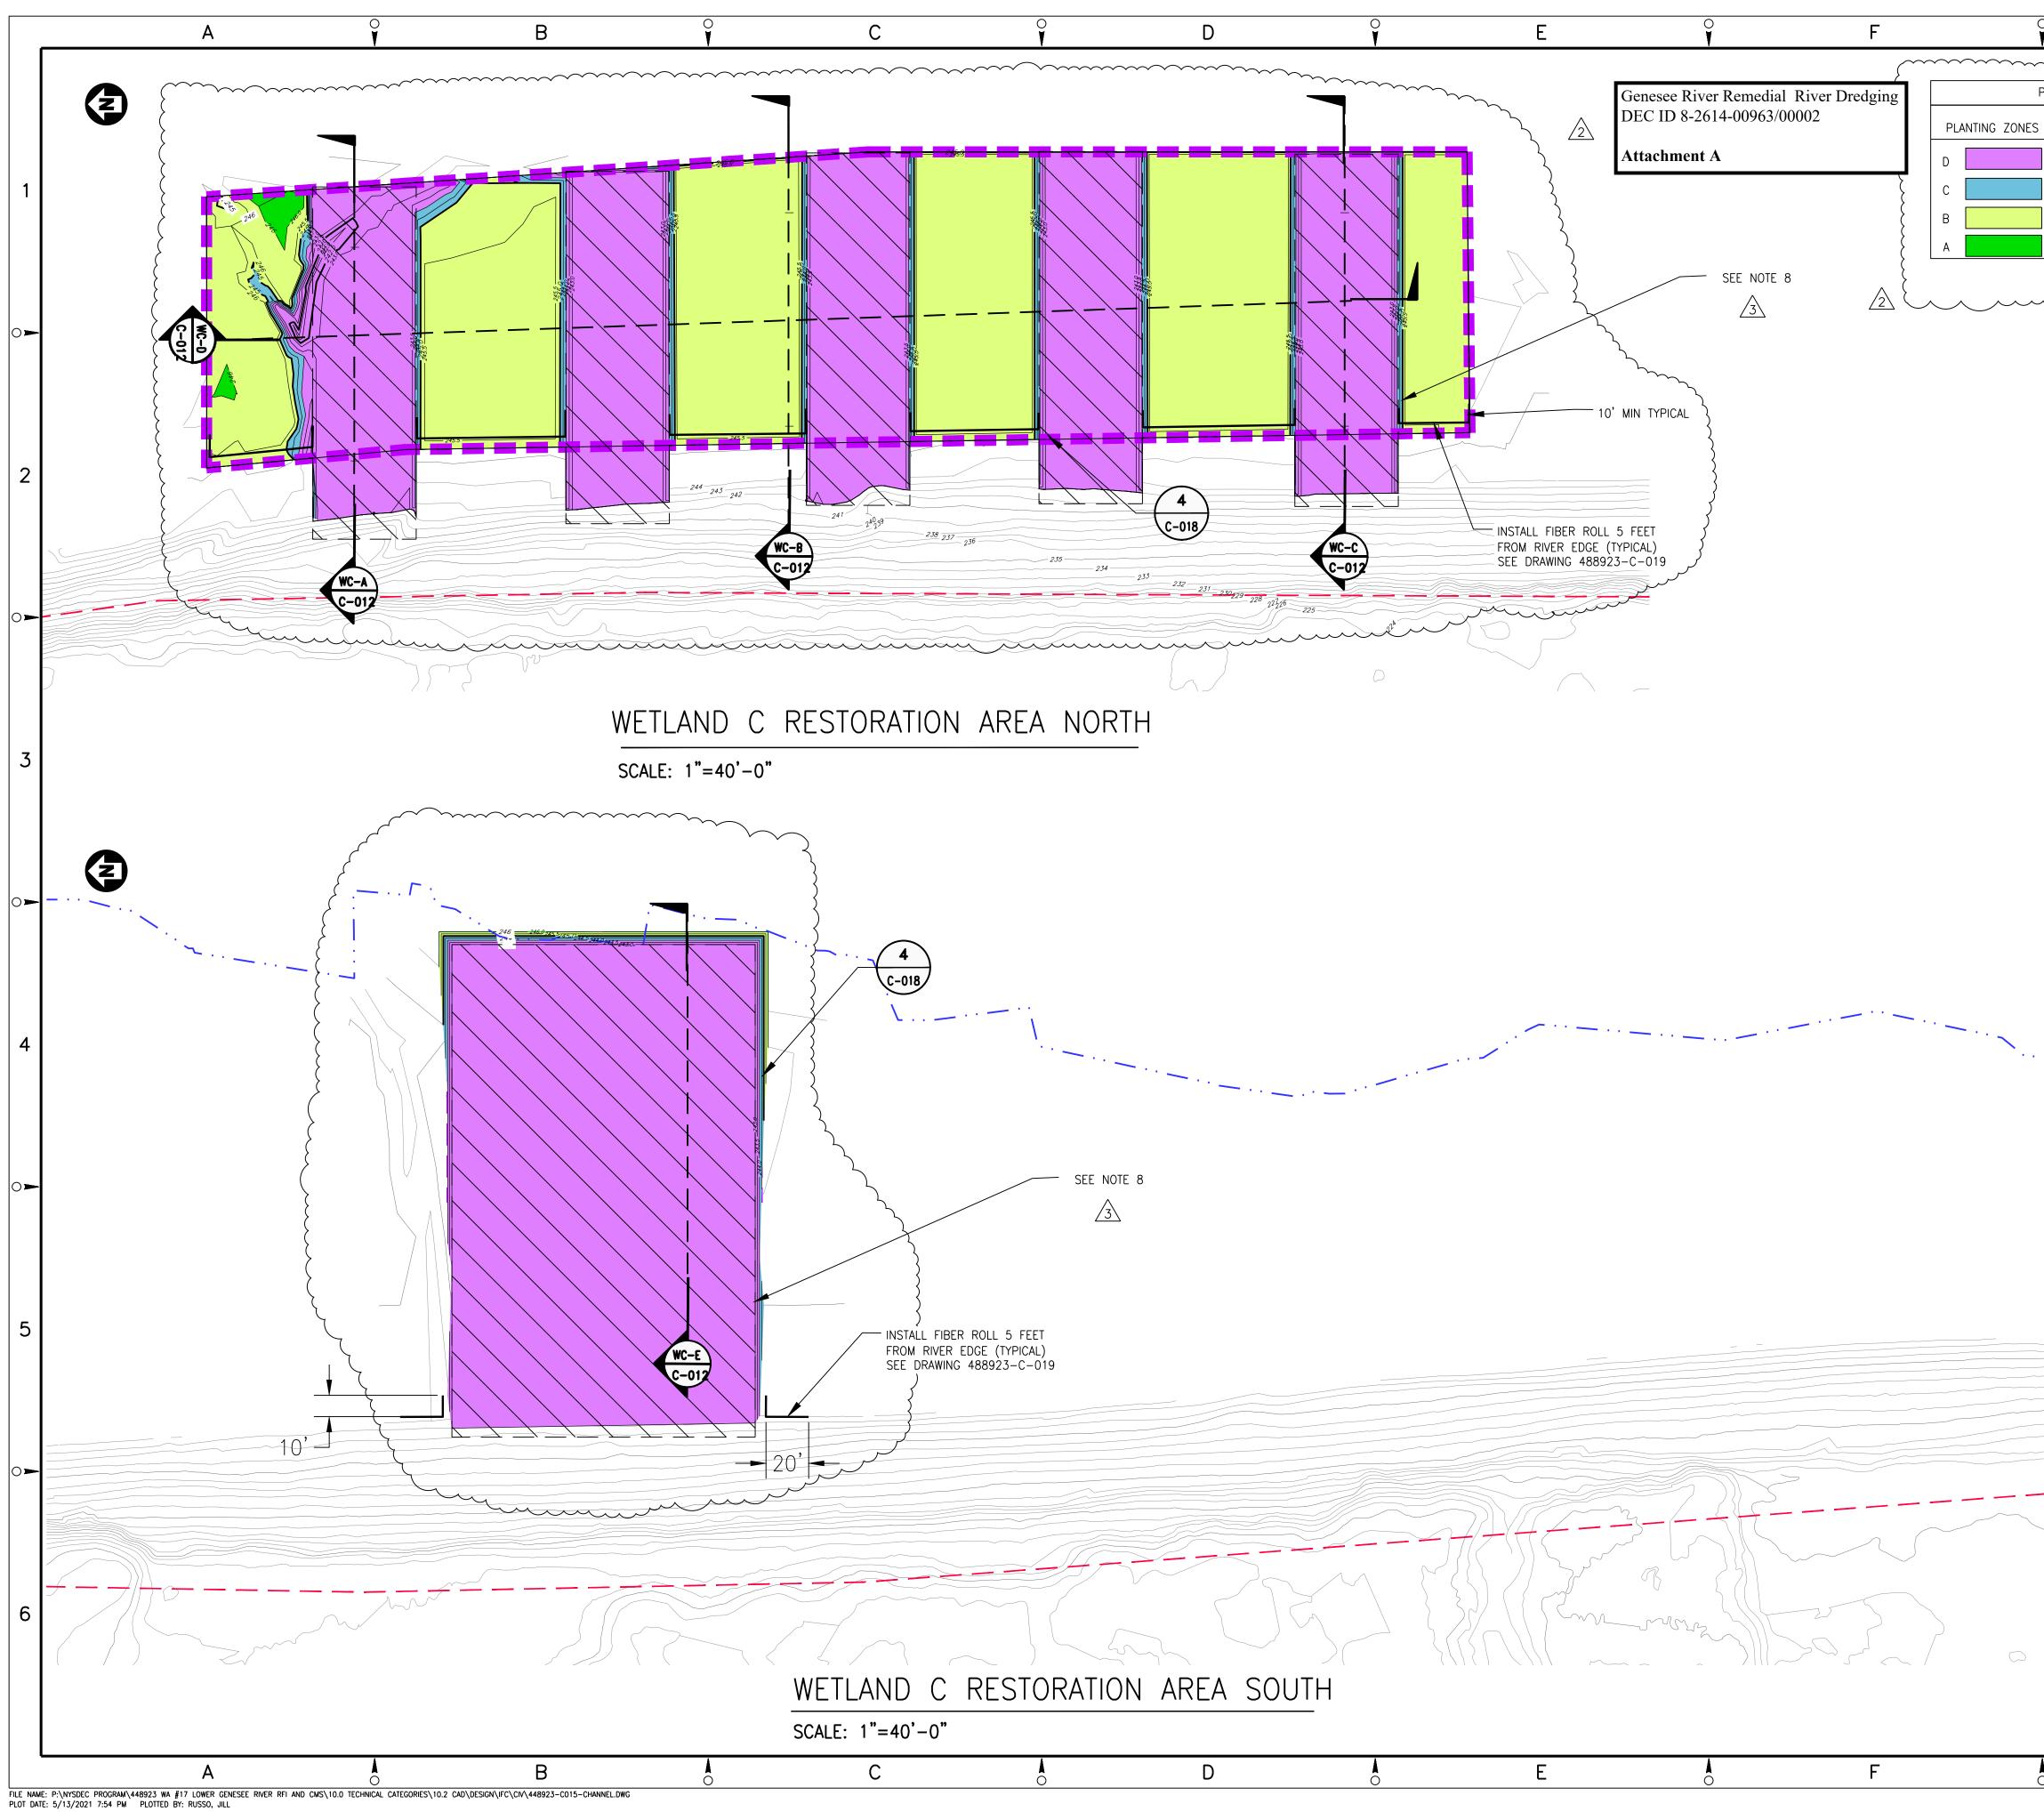

		D		F		F
(5	D	Ô	E, ,	Ô	F

G		° H	
~~~~~~~~~~~~~~~~~~~~~~~~~~~~~~~~~~~~~~~		LEGEND:	
PLANTING ZONE ACREAGE WETLAND C WETLAND C	ł		
S ELEVATIONS NORTH SOUTH	ź	WETLAND C BOUNDARY       FINAL GRADE	
<244		PINAL GRADE	
244 TO 245         0.09         0.02           245 TO 246         0.94         0.01	Ş	MARK) APPROX 249.13'	1
>246 0.01 0.00	}	NAVIGATIONAL CHANNEL	
AREA TOTALS 1.93 0.79	$\sum$	ACCESS CHANNEL	
······		NOTES:	
			- 2
		3. SEE DRAWING C-016 FOR PLANTING SCHEDULES.	
		4. EXCAVATION/DREDGING AND BACKFILL/RESTORATION 	Z
	2	AND 1 CONSTRUCTION SEASON.	+
		REMEDIATION AREA WSING ZONE B SEED MIX.	3
		6. VERIFY FINAL BACKFILL ELEVATIONS HAVE BEEN MET PRIOR TO BEGINNING PLANTING AND SEEDING. TYPE D PLANTING ZONES (D1 OR D2) WILL BE BASED ON FINAL ELEVATIONS_DURING_CONSTRUCTION	
	<u>{</u>	8. THE ACCESS CHANNELS ARE SHOWN AS STRAIGHT LINES FOR EASE OF PRESENTATION. THE CHANNELS WILL BE SHAPED TO ACCOMMODATE DREDGE ACCESS TO REACH THE NON-CHANNEL AREAS. THE ACTUAL	3
	<u> </u>	CHANNELS DURING DREDGING AND AFTER	1
		40 20 0 40 80	
		SCALE: 1"=40'	-
		SCALE. 1 -40	
		3 CHANNEL EXCAVATION NOTES 05/14/21 JR TCD/ WJL ECG	
		2 CHANNEL EXCAVATION ADDED 04/30/21 JR TCD/ WJL ECG	4
		1 ISSUED FOR CONSTRUCTION 01/29/21 JR TCD/ WJL ECG	-7
· ·		0 ISSUED FOR BID 11/24/20 JR TCD/ WJL ECG	
		NO. DESCRIPTION DATE DRAWN CHK'D APPV'D	
		JR 11/24/20	- (
		TCD/ECG 11/24/20	
		APPROVED BY DATE WJL 11/24/20	
		PROJECT MGR. DATE MLV 11/24/20	
		PARSONS	5
		301 PLAINFIELD ROAD SYRACUSE, NY 13212 (315) 451-9560	
		PROJECT TITLE	-(
		Lower Genesee River Corrective Measures Remedial Construction Rochester, NY	
		DRAWING TITLE	
		BACKFILL/RESTORATION PLAN WETLAND C	6
		scale AS SHOWN	
		DRAWING NO. 448923-C-015 Z	
		448923-0-015   3	

	A		O Y	В		O Y	С
	PARTICLE SIZE DISTRIBUT AND WETLAND	ION FOR CHEMICAI BACKFILL LAYERS		PA		DISTRIBUTION FOR I PROTECTION LAYER	
1		MEETING THE FOLLOW #200 SIEVE) TO 0.3 MM WITH $\geq$ 14		GRAV SIZE 4 INC	′EL WITH A D ₅₀ (D85/D15 <u>&lt;</u> 2. CHES. THE GRAV	DTECTION LAYER WILL ≥ 40 MM, A RELATIV 5) AND A MAXIMUM P/ EL SHALL BE EQUAL ATE GRADATION SHOWN	ELY UNIFORM STON ARTICULAR SIZE OF TO OR COARSER
	AND $\leq$ 15% PASS • D60/D15 $\leq$ 10	ING #80 SIEVE					
	PROTECTION LAYER	DR 1.0 FOOT THICK H R. (NOTE: IF D85 $\geq$ 2	2.3 MM FOR THE			Table 2	
	PROTECTION LAYER	L, INCREASE THE HAB			Grain Size (inches)	Grain Size (mm)	Percent Passing (Dry Weight Basis
	• FALL BETWEEN TH		MUM GRADATIONS		4	100	100
2	SHOWN IN TABLE	1:			2 1/2	63	<u>&lt;</u> 85
		Table 1			1 1/2	40	<u>≺</u> 50
		Grain Size (mm)	Percent Passing (Dry		1	25	<u>&lt;</u> 15
	Sieve Size) 3/4	191	Weight Basis) 100		1/2	13	0 TO 3
	3/8	0	85-100				
	#4	4.76	70-100				
	#8	2.38	55-100				
3	#16	1.19	42-63				
	#30	0.595	28-44				
	#50	0.297	<u>&gt;</u> 15				
-	#80	0.177	<u>&lt;</u> 15				
	No. 200	>0.075	<u></u> 5				
						TERIALS	
4	KINC	GS LANDING AREA SUF	RVEY		NOT	TO SCALE	
4	KINC POINT NORTHIN CB10 1167569 CB20 1167818 CB30 1167742 CB40 1168137	NG EASTING 9.5461 1404356.863 8.5910 1404159.966 2.2008 1404024.543	ELEVATION 254.050 30 250.910 35 265.691	ВМ (Х ВМ	DINT NOR 1–1 1167 –CUT ON NORTH	<u>RIVER_SURVEY</u> HING EASTING 477.30 1404354.8	1 266.11
	POINT NORTHIN CB10 1167569 CB20 1167818 CB30 1167742	IG EASTING 9.5461 1404356.863 8.5910 1404159.966 2.2008 1404024.543 7.5659 1403728.457	ELEVATION 254.050 30 250.910 35 265.691	ВМ (Х (В	DINT NOR 1-1 1167 -CUT ON NORTH 1-2 1167 OX CUT)	<u>RIVER_SURVEY</u> HING EASTING 477.30 1404354.8 H RIM MH)	1 266.11
5	POINT NORTHIN CB10 1167569 CB20 1167818 CB30 1167742	IG EASTING 9.5461 1404356.863 3.5910 1404159.966 2.2008 1404024.543 7.5659 1403728.457	ELEVATION 254.050 250.910 265.691 78 271.864 SURVEY CON	BN (X BN (B TROL PEYS CONDUC DN, NJ ON SI 2-24, 2019. URVEYS CONE ENFIELD, NY (	DINT NOR A-1 1167 -CUT ON NORTH A-2 1167 OX CUT) POINTS TED BY EPTEMBER DUCTED BY	<u>RIVER_SURVEY</u> HING EASTING 477.30 1404354.8 H RIM MH)	1 266.11
	POINT NORTHIN CB10 1167569 CB20 1167818 CB30 1167742	IG EASTING 9.5461 1404356.863 3.5910 1404159.966 2.2008 1404024.543 7.5659 1403728.457	ELEVATION 50 254.050 53 250.910 55 265.691 78 271.864 SURVEY NOTES: 1. BATHYMETRIC RIVER SURV AQUA SURVEY, FLEMINGTO 8–9, 2015 AND JULY 22 2. KLWWTP STAGING AREA S POPLI DESIGN GROUP, P	BN (X BN (B TROL PEYS CONDUC DN, NJ ON SI 2-24, 2019. URVEYS CONE ENFIELD, NY (	DINT NOR A-1 1167 -CUT ON NORTH A-2 1167 OX CUT) POINTS TED BY EPTEMBER DUCTED BY	<u>RIVER_SURVEY</u> HING EASTING 477.30 1404354.8 H RIM MH)	

0

PARTICLE SIZE DISTRIBUTION FOR TOPSOIL LAYER

TOPSOIL: TOPSOIL SHALL BE NATURAL OR MANUFACTURED, FRIABLE AND FERTILE SOIL THAT MEETS THE USDA BASIC SOIL TEXTURE CLASSES OF LOAM, SILT LOAM OR SANDY LOAM TO BE RECOVERED FROM THE A HORIZON OF AN IN-PLACE SOIL. TOPSOIL SHALL BE CAPABLE OF SUSTAINING HEALTHY PLANT LIFE AND BE REASONABLY FREE OF SUBSOIL, HEAVY OR STIFF ( CLAY, BRUSH, ROOTS, WEEDS, OTHER OBJECTIONABLE PLANT MATTER, FOREIGN MATERIAL, STONES LARGER THAN 4 INCHES IN GREATEST DIMENSION, AND ANY OTHER MATERIALS UNSUITABLE OR HARMFUL FOR PLANT GROWTH. TOPSOIL AS DELIVERED TO THE SITE OR STOCKPILED SHALL MEET THE FOLLOWING REQUIREMENTS:

- 1. WELL GRADED WITH A MAXIMUM PARTICLE SIZE OF 4 INCHES, 85 TO 100 PERCENT PASSING 1 INCH, 65 TO 100 PERCENT PASSING 1/4 INCH, AND 15 TO 80 PERCENT PASSING A NUMBER 200 SIEVE. THE 2-MICRON PARTICLE SIZE SHALL NOT BE GREATER THAN 20 PERCENT OF THE TOTAL SAMPLE MASS, AS DETERMINED BY HYDROMETER ANALYSIS.
- 2. ORGANIC MATERIALS USED IN THE MANUFACTURE OF TOPSOIL SHALL MEET THE REQUIREMENTS OF NYSDOT 713–05.
- 3. PH BETWEEN 5.5 AND 7.6.


 $\odot$ 

- 4. PERCENT ORGANIC MATTER: TOPSOIL SHALL CONTAIN GREATER THAN 4 PERCENT AND LESS THAN 20 PERCENT ORGANIC MATTER AS DETERMINED BY LOSS OF IGNITION OF MOISTURE-FREE SAMPLES DRIED AT 100° TO 110° CELSIUS.
- 5. CONTAINS NO NUISANCE WEEDS INCLUDING SEEDS, STEMS OR RHIZOMES OF PURPLE LOOSESTRIFE, PHRAGMITES, JAPANESE KNOTWEED OR ANY PLANTS ON THE FEDERAL NOXIOUS WEEDS LIST.

Deaterstin		Species	Charle T	Installation rate	Restoration Area	Se
Restoration Area		Calentific Name	Stock Type	(# per acre)	<u> </u>	Common Name
•	Common Name	Scientific Name	O" Diug	250	A	Water plantain
Α	Sweetflag	Acorus americanus	2" Plug			Swampmilkweed
(Elevation 246' to	Water plantain	Alisma subcordatum	2" Plug	250	(Elevation 246' to	Nodding beggar-ticks
247')	Water sedge	Carex aquatilis	2" Plug	250	. 247')	Lake sedge
	Lake sedge Water willow	Carex lacustris Decodon verticillatus	2" Plug 2" Plug	250 750		Blunt broom sedge
	Willow weed	Justicia americana	2" Plug	750		Fox sedge Rice cutgrass
	Arrow arum	Peltandra virginica	2" Plug	250		Spikerush
	Water smartweed	Persicaria amphibia	2" Plug	2,500		Riverbank wild rye
	Pickerel-weed	Pontederia cordata	2" Plug	2,500		Fowl mannagrass
	Arrowhead	Sagittaria latifolia	2" Plug	300		Common sneezewee
	Deep water potato	Sagittaria rigida	2" Plug	500		Soft rush
	Hardstem bulrush	Schoenoplectus acutus	2" Plug	500		Great blue lobelia
	Three-square	Schoenoplectus pungens	2" Plug	350		Fowl bluegrass
	Soft-stem bulrush	Schoenoplectus tabernaemontani	2" Plug	500		Green bulrush
	Green bulrush	Scirpus atrovirens	2" Plug	500		Woolgrass
	Eastern burreed	Sparganium americanum	2" Plug	300		Leafy bulrush
	Giant burreed	Sparganium eurycarpum	2" Plug	300		Giant burreed
	Wetland Seed Mix A ¹		Seed (lbs)	25		Blue vervain
	Winter Rye	Secale cereal	Seed (lbs)	15		14/-1
	Wild rice ⁴	Zizania aquatica	Seed (lbs)	75	В	Water plantain
В	Water willow	Decodon verticillatus	2" Plug	1,000		Swampmilkweed
Elevation 245' to	Willow weed	Justicia americana	2" Plug	1,000	(Elevation 245' to 246')	Nodding beggar-ticks
246')	Yellow water lily	Nuphar lutea	2" Plug/Tuber	500	240)	Lake sedge Blunt broom sedge
	White water lily	Nymphaea odorata	2" Plug/Tuber	500		Fox sedge
	Water smartweed	Persicaria amphibia	2" Plug	3,000		Spikerush
	Pickerel-weed Deep water potato	Pontederia cordata Sagittaria rigida	2" Plug 2" Plug	3,000		Riverbank wild rye
	Soft-stem bulrush	Schoenoplectus tabernaemontani	2" Plug	250		Fowl mannagrass
	Green bulrush	Scirpus atrovirens	2" Plug	250		Common sneezewee
	Eastern burreed	Sparganium americanum	2" Plug	250		Soft rush
	Giant burreed	Sparganium eurycarpum	2" Plug	250		Rice cutgrass
	Narrow leaf cattail	Typha angustifolia	2" Plug	900		Green bulrush
	Wetland Seed Mix B ¹		Seed (lbs)	25		Woolgrass
	Winter Rye	Secale cereal	Seed (lbs)	15		Leafy bulrush
	Wild rice ⁴	Zizania aquatica	Seed (lbs)	75		Giant burreed
С	Water willow	Decodon verticillatus	2" Plug	1,000		Blue vervain
Elevation 244' to	Willow weed	Justicia americana	2" Plug	1,500		
245')	Yellow water lily	Nuphar lutea	2" Plug/Tuber	2,500	C (Elevation 244' to	
	White water lily	Nymphaea odorata	2" Plug/Tuber	2,500	(Elevation 244 to 245')	
	Water smartweed	Persicaria amphibia	2" Plug	2,500	D1 and D2	
	Pickerel-weed	Pontederia cordata	2" Plug	1,000	(Elevation <244")	
	Wild rice ⁴	Zizania aquatica or palustris	Seed (lbs)	100	For the river acce	ss area, use the w
D1	Coontail	Ceratophyllum demersum	Whole Plant/Tuber	1,500		ove Zone A (246'
(Elevation 243' to	Yellow water lily	Nuphar lutea	2" Plug/Tuber	1,750		
244")	White water lily	Nymphaea odorata	2" Plug/Tuber	1,750	1	
	Sago pondweed	Stuckenia pectinata	Whole Plant/Tuber	1,500		
	Wild celery	Vallisneria americana	Whole Plant/Tuber	1,500	4	
50	Wild rice ⁴	Zizania aquatica or palustris	Seed (lbs)	100	1	
D2	Coontail Vollow water like	Ceratophyllum demersum	Whole Plant/Tuber	2,400	4	
(Elevation <243")	Yellow water lily White water lily	Nuphar lutea Nymphaea odorata	2" Plug/Tuber 2" Plug/Tuber	400	4	
	Sago pondweed	Stuckenia pectinata	Whole Plant/Tuber	2,400	1	
	Wild celery	Vallisneria americana	Whole Plant/Tuber	2,400	1	
	Wild rice ⁴	Zizania aquatica or palustris	Seed (lbs)	100	1	
	¹ Refer to	Table 32 72 00-2 for species composit	ion of seed mix.			

		Å	F	Å	F	-
C	) D	0	L	C	) I	

E			~~~~~	F~~~~~		0	G		0 ⊀	Н				
	nd Restoration Area Plantings and	• • •				Restoration Seed Mix Species			) ) Gen	esee River Remedi	al River I	Dredo	no	]
Wetlan	Species	Stock Type	Installation rate	Restoration Area	Seed	Mix Composition	Quantity (Pounds/Acre)	Percent		C ID 8-2614-00963		neagi	115	
ommon Name veetflag	Scientific Name Acorus americanus	2" Plug	(# per acre) 250	Α	Common Name Water plantain	Scientific Name Alisma subcordatum	0.8	3.10%	Att	achment A				
ater plantain	Alisma subcordatum	2" Plug	250	(Elevation 246' to	Swamp milkweed Nodding beggar-ticks	Asclepias incarnata Bidens cernua	0.2	0.60%	5					
ater sedge ike sedge	Carex aquatilis Carex lacustris	2" Plug 2" Plug	250 250	247)	Lake sedge Blunt broom sedge	Carex Iurida Carex scoparia	1.6 1.6	6.30% 6.30%	3					1
ater willow illow weed	Decodon verticillatus Justicia americana	2" Plug 2" Plug	750 750		Fox sedge Rice cutgrass	Carex vulpinoidea Leersia oryzoides	3.1 3.1	12.50% 12.50%	ζ	)				
row arum ater smartweed	Peltandra virginica Persicaria amphibia	2" Plug 2" Plug	250 2,500		Spikerush Riverbank wild rye	Eleocharis palustris Elymus riparius	1.6 3.1	6.30% 12.50%		Z				
ckerel-weed rowhead	Pontederia cordata Sagittaria latifolia	2" Plug 2" Plug	2,500 300		Fowl mannagrass Common sneezeweed	Glyceria striata Helenium autumnale	0.2	0.60% 0.60%		3				
eep water potato ardstem bulrush	Sagittaria rigida Schoenoplectus acutus	2" Plug 2" Plug	500 500		Soft rush Great blue lobelia	Juncus effusus Lobelia siphilitica	1.6 0.2	6.30% 0.60%		<pre>}</pre>				
iree-square oft-stem bulrush	Schoenoplectus pungens Schoenoplectus tabernaemontani	2" Plug 2" Plug	350 500		Fowl bluegrass Green bulrush	Poa palustris Scirpus atrovirens	1.6 0.8	6.30% 3.10%		$\langle$				<b>~</b> 0
een bulrush astern burreed	Scirpus atrovirens Sparganium americanum	2" Plug 2" Plug	500 300		Woolgrass Leafy bulrush	Scirpus cyperinus Scirpus polyphyllus	0.8	3.10% 3.10%		$\langle$				
ant burreed	Sparganium eurycarpum	2" Plug Seed (lbs)	300 25		Giant burreed	Sparganium eurycarpum	3.1	12.50%		$\leq$				
etland Seed Mix A ¹ inter Rye	Secale cereal	Seed (lbs) Seed (lbs)	15 75		Blue vervain	Verbena hastata Tota		3.10% 100%		5				
ild rice ⁴ ater willow	Zizania aquatica Decodon verticillatus	2" Plug	1,000		Water plantain Swamp milkweed	Alisma subcordatum Asclepias incarnata	2.3 0.2	9.40% 0.60%		)				
illow weed ellow water lily	Justicia americana Nuphar lutea	2" Plug 2" Plug/Tuber	1,000 500	246')	Nodding beggar-ticks Lake sedge	Bidens cernua Carex Iurida	0.2 0.8	0.60%		$\langle$				
hite water lily ater smartweed	Nymphaea odorata Persicaria amphibia	2" Plug/Tuber 2" Plug	500 3,000		Blunt broom sedge Fox sedge	Carex scoparia Carex vulpinoidea	0.8 0.8	3.10% 3.10%		Ş				2
ckerel-weed eep water potato	Pontederia cordata Sagittaria rigida	2" Plug 2" Plug	3,000 100		Spikerush Riverbank wild rye	Eleocharis palustris Elymus riparius	3.1 1.6	12.50% 6.30%		)				
oft-stem bulrush een bulrush	Schoenoplectus tabernaemontani Scirpus atrovirens	2" Plug 2" Plug	250 250		Fowl mannagrass Common sneezeweed	Glyceria striata Helenium autumnale	0.3	1.30% 0.60%						
astern burreed ant burreed	Sparganium americanum Sparganium eurycarpum	2" Plug 2" Plug	250 250		Soft rush Rice cutgrass	Juncus effusus Leersia oryzoides	1.6 3.1	6.30% 12.50%		$\langle$				
arrow leaf cattail	Typha angustifolia	2" Plug	900		Green bulrush Woolgrass	Scirpus atrovirens Scirpus cyperinus	1.6 0.8	6.30% 3.10%		$\langle$				
etland Seed Mix B ¹ inter Rye	Secale cereal	Seed (lbs) Seed (lbs)	25 15		Leafy bulrush Giant burreed	Scirpus polyphyllus	0.8	3.10% 25.00%		}				-0
ild rice ⁴ ater willow	Zizania aquatica Decodon verticillatus	Seed (lbs) 2" Plug	75 1,000		Blue vervain	Sparganium eurycarpum Verbena hastata	0.8	3.10%						
illow weed ellow water lily	Justicia americana Nuphar lutea	2" Plug 2" Plug/Tuber	1,500 2,500	С		Tota	1	100%						
hite water lily ater smartweed	Nymphaea odorata Persicaria amphibia	2" Plug/Tuber 2" Plug	2,500 2,500	(Elevation 244' to 245')		No seed m	IX			5				
ckerel-weed ild rice ⁴	Pontederia cordata Zizania aquatica or palustris	2" Plug Seed (lbs)	1,000 100	D1 and D2 (Elevation <244")		No seed m	ix		5	5				
oontail	Ceratophyllum demersum	Whole Plant/Tuber	1,500			and seed mix that is appropriat 247') with a general lawn mix.	e for the final elevation. P	lant areas with a	كر					
ellow water lily hite water lily	Nuphar lutea Nymphaea odorata	2" Plug/Tuber 2" Plug/Tuber	1,750 1,750					بىر	س ر					3
ago pondweed ild celery	Stuckenia pectinata Vallisneria americana	Whole Plant/Tuber Whole Plant/Tuber	1,500 1,500					کر ر						
ild rice ⁴ pontail	Zizania aquatica or palustris Ceratophyllum demersum	Seed (lbs) Whole Plant/Tuber	100 2,400					کر						
ellow water lily hite water lily	Nuphar lutea Nymphaea odorata	2" Plug/Tuber 2" Plug/Tuber	400 400				7	}						
ago pondweed ild celery	Stuckenia pectinata Vallisneria americana	Whole Plant/Tuber Whole Plant/Tuber	2,400 2,400				/م							
ild rice ⁴	Zizania aquatica or palustris able 32 72 00-2 for species compositio	Seed (lbs)	100				کر							-0
							کر				<del></del>			_
							مر م							
							٢							
	2	NOT TO		SIURAI	ION PLA	NTING5	کر		2 CHAN	NEL EXCAVATION ADDED	04/30/21	JR ⁻	TCD/ WJL	
			JUALL			- م ا							ECG	4
						ر			1 ISSUE	ED FOR CONSTRUCTION	01/29/21		CD/ WJL CG	·
- Lun	um								0 ISSUE	) FOR BID	11/24/20	JR T	CD/ WJL	-
		$\sim$	$\overline{\ }$	~~~	$\sim$			-					CG	_
								-	NO. DRAWN BY	DESCRIPTION	DATE	DRAWN C	HK'D APPV	D
									JR	11/24/20	)			
									CHECKED BY	G 11/24/20	)			-0
									APPROVED BY	DATE				
									WJL	11/24/20	)			
									project mgr. MLV	DATE	)			
									(	I	•			1
										PARS		JC	5	5
														J
									OFFICE 301	PLAINFIELD ROAD	_{јов} 452	2165		
									SYRA	CUSE, NY 13212	WBS			-
									,	451-9560				
									PROJECT TITLE		epartment of			-0
											nvironmental onservation			
										Lower Genes	see River			
									Cor	rective Measures Re		nstruct	ion	
										Rocheste	r, NY			_
									DRAWING TITLE					
														6
										DETAIL S	SHEET			
									SCALE					_
									SCALE	NON	E		<b></b>	
									DRAWING NO.	448923–C·	-016		REV.	
						<b>k</b>	-		4					
E		0		F	(	0	G		0	Н				

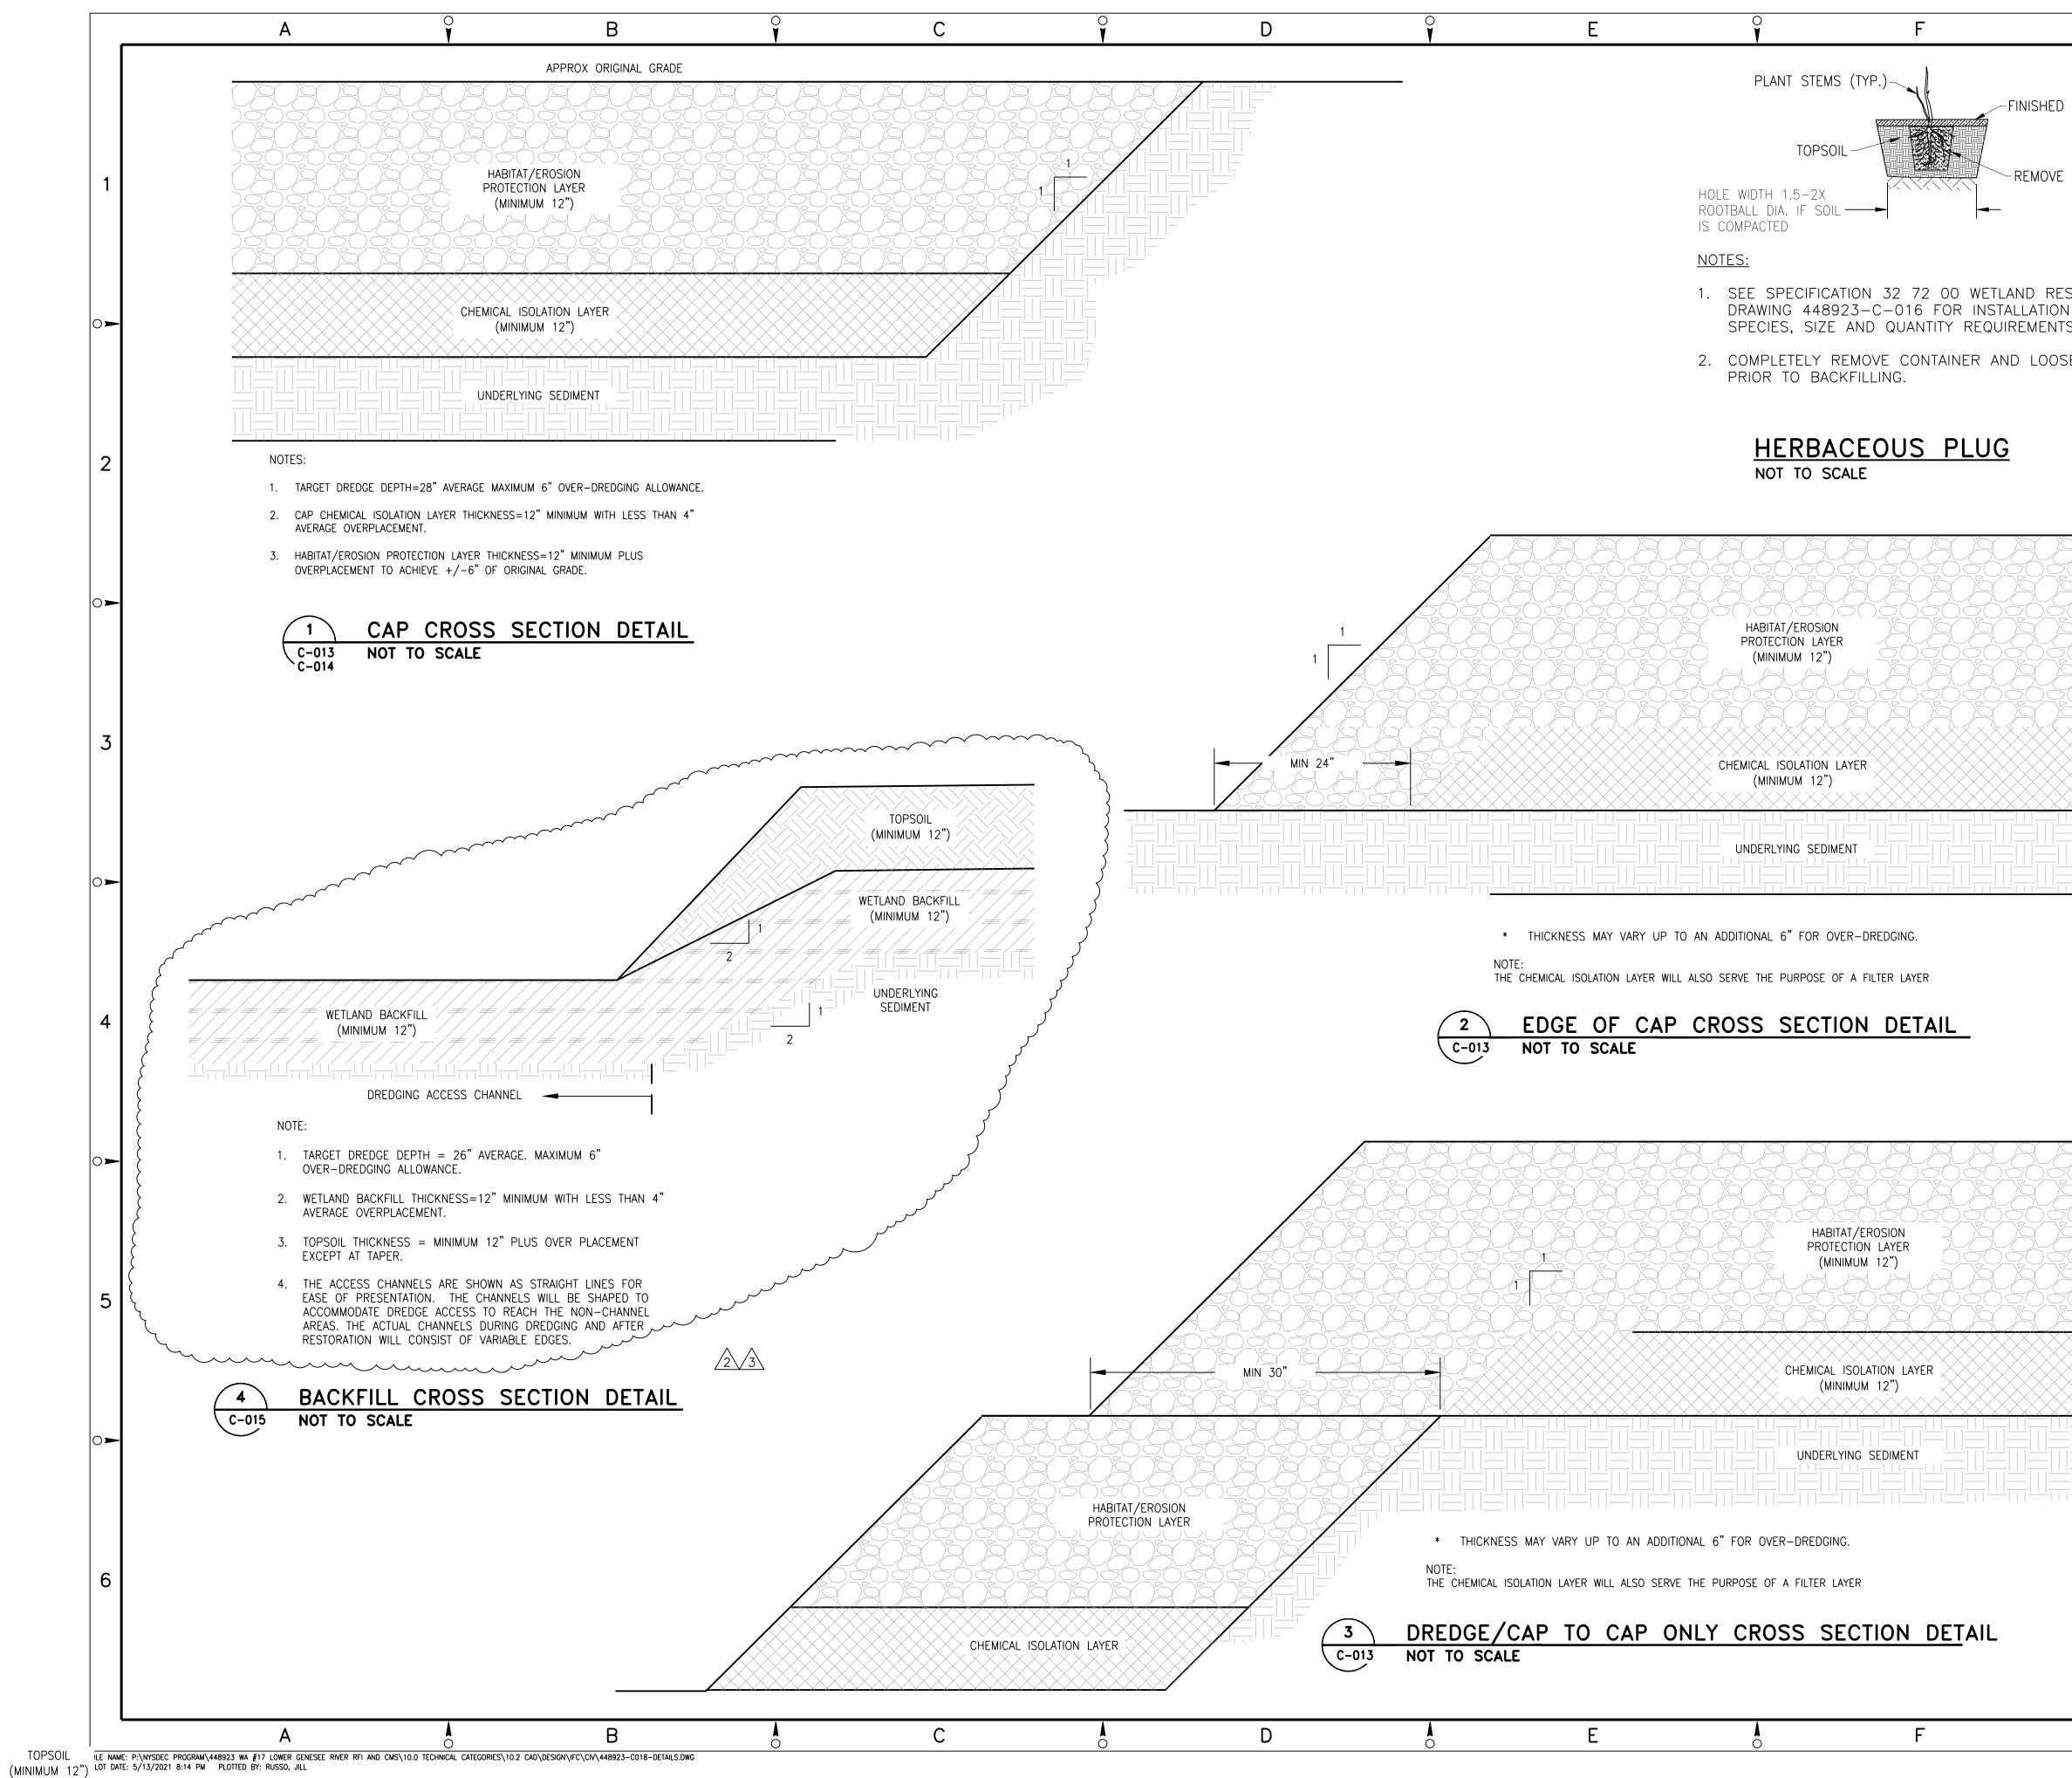

⊖ ▼	G	Ŷ	Н			•
CDADE	Genesee River Remedial Riv DEC ID 8-2614-00963/0000					
GRADE	Attachment A					
CONTAINER						1
STORATION AND I DETAILS AND S.						-0
EN ROOTBALL						
						2
<u></u>						
						-0
						-0
						3
						<b>~</b> 0
		3 CHANNEL EXC	CAVATION ADDED	05/14/21 JR	TCD/ WJL ECG	
			CAVATION ADDED	04/30/21 JR 01/29/21 JR	TCD/ WJL ECG TCD/ WJL	4
		0 ISSUED FOR	BID	11/24/20 JR	ECG TCD/ WJL ECG	
~~~~~		no. c drawn by JR	DESCRIPTION DATE 11/24/20	DATE DRAW	N CHK'D APPV'D	
		checked by TCD/ECG approved by	DATE 11/24/20 DATE			-0
		WJL project mgr. MLV	<u>11/24/20</u> date 11/24/20			
			ARS	ON	5	5
		OFFICE	IFIELD ROAD	^{јов} 45216)	
		SYRACUSE (315) 45 PROJECT TITLE	, NY 13212 1-9560	WBS		
				partment of vironmental nservation		-0
		Correctiv	Lower Genes e Measures Ren Rochester	nedial Constr	uction	
		DRAWING TITLE				6
			DETAIL S	HEET		
		SCALE DRAWING NO.			REV.	
	G		8923-С- н	-010	3	J
		-				

NEW YORK STATE DEPARTMENT OF ENVIRONMENTAL CONSERVATION

Divsion of Environmental Permits, Region 8 6274 East Avon-Lima Road, Avon, NY 14414-9516 P: (585) 226-5400 I F: (585) 226-2830 www.dec.ny.gov

NOTICE OF INTENT TO COMMENCE WORK

Date:

NYS Department of Environmental Conservation **Division of Environmental Permits** 6274 East Avon-Lima Road Avon, NY 14414

Re: 401 Water Quality Certification DEC Permit No. 8-2614-00963/00002

In accordance with Condition #3 of the referenced permit, I hereby serve notice to commence ____, 20____. Notice of project completion will be submitted work on or about within one week after termination of all work.

This is also to certify that, having read in entirety the permit, I am fully aware of and understand the general, supplemental and special conditions, and agree to comply in all respects to those requirements. I further understand that prior to undertaking any modification to the authorized project, I must seek and receive the written approval of the Regional Permit Administrator.

Signature of Permittee

WARNING

The Permittee and the contractor (if any) are required to follow all permit conditions. Violation of permit conditions may lead to legal action, including the imposition of substantial monetary fines and corrective work.

Signature of Contractor (if any)

Contractor's Address

Contractor's Telephone Number

Signature of Landowner(s)

Attention Permittee and/or Contractor: Please fold as noted on the back and return.



Environmental Conservation

(Fold # 2)

Place Stamp Here

NYS Department of Environmental Conservation Attn: Environmental Permits 6274 E Avon-Lima Rd Avon, NY 14414

(Fold # 1 – Staple Here)



Department of Environmental Conservation

NOTICE

The Department of Environmental Conservation (DEC) has issued permit(s) pursuant to the Environmental Conservation Law for work being conducted at this site. For further information regarding the nature and extent of work approved and any Departmental conditions on it, contact the Regional Permit Administrator listed below. Please refer to the permit number shown when contacting the DEC.

Regional Permit Administrator

Permit Number

8-2614-00963/00002

Expiration Date

12/31/2022

Thomas P Haley 6274 E Avon-Lima Rd Avon, NY 14414 (585) 226-5400

NOTE: This notice is **NOT** a permit