



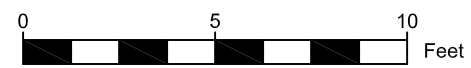

2019 DREDGE BOUNDARY

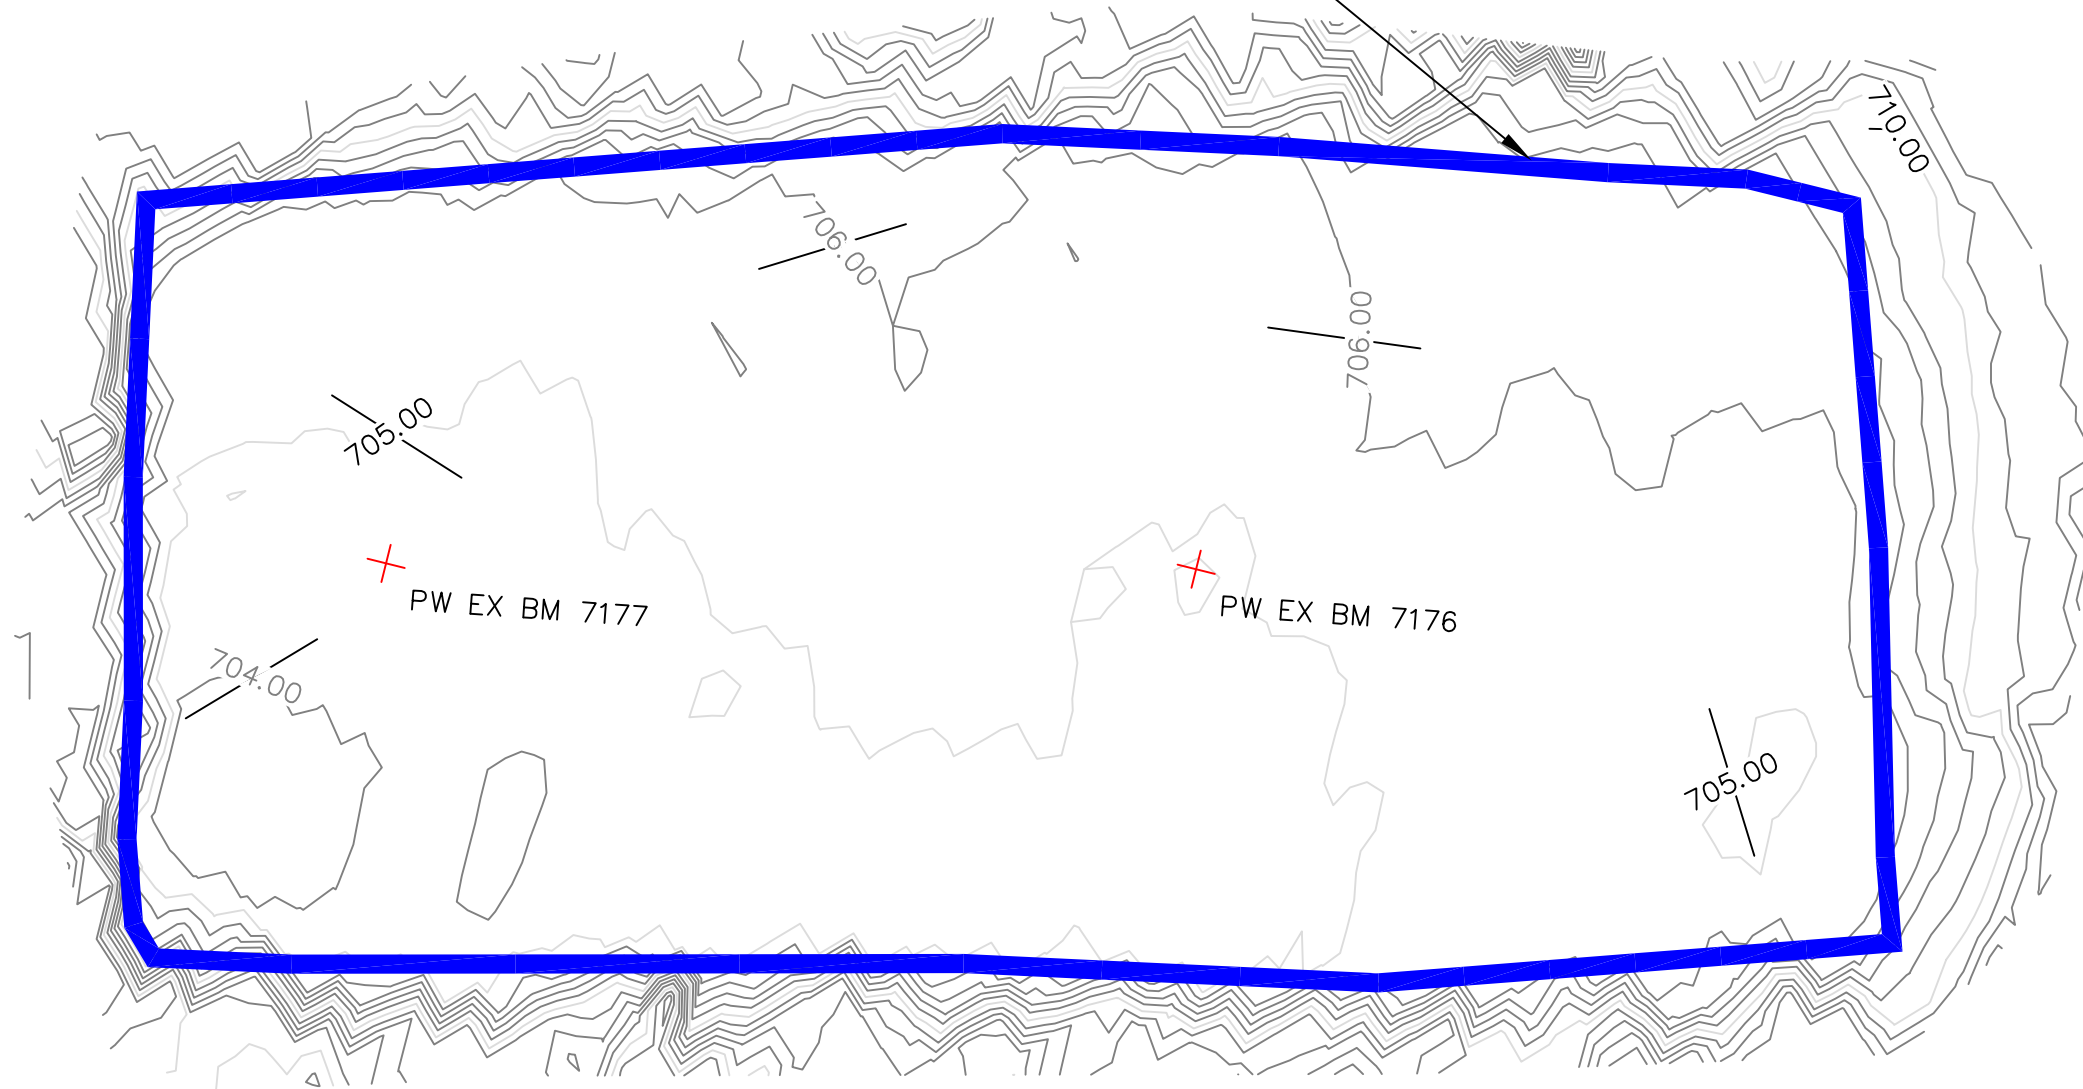

PENN YAN 2019 POST DREDGE

PENN YAN

PENN YAN, NY



DRAWING 1	DATE:	10-17-19
	DRAWN BY:	RPK
	CHECKED BY:	
	CAD FILE:	Post Dredge
	SCALE:	AS SHOWN