


PHASE	DATE	INITIALS
10		
20		
30		
40		
50		
60		
70		

FOR OFFICE USE ONLY

Copyright © Foit - Albert Associates, all rights reserved. No portion of this drawing may be reproduced, stored, or transmitted by any means without prior written permission of the architect. Alterations to this document are illegal except when made in accordance with the New York State Education Law, Section 7209, Subdivision 2.

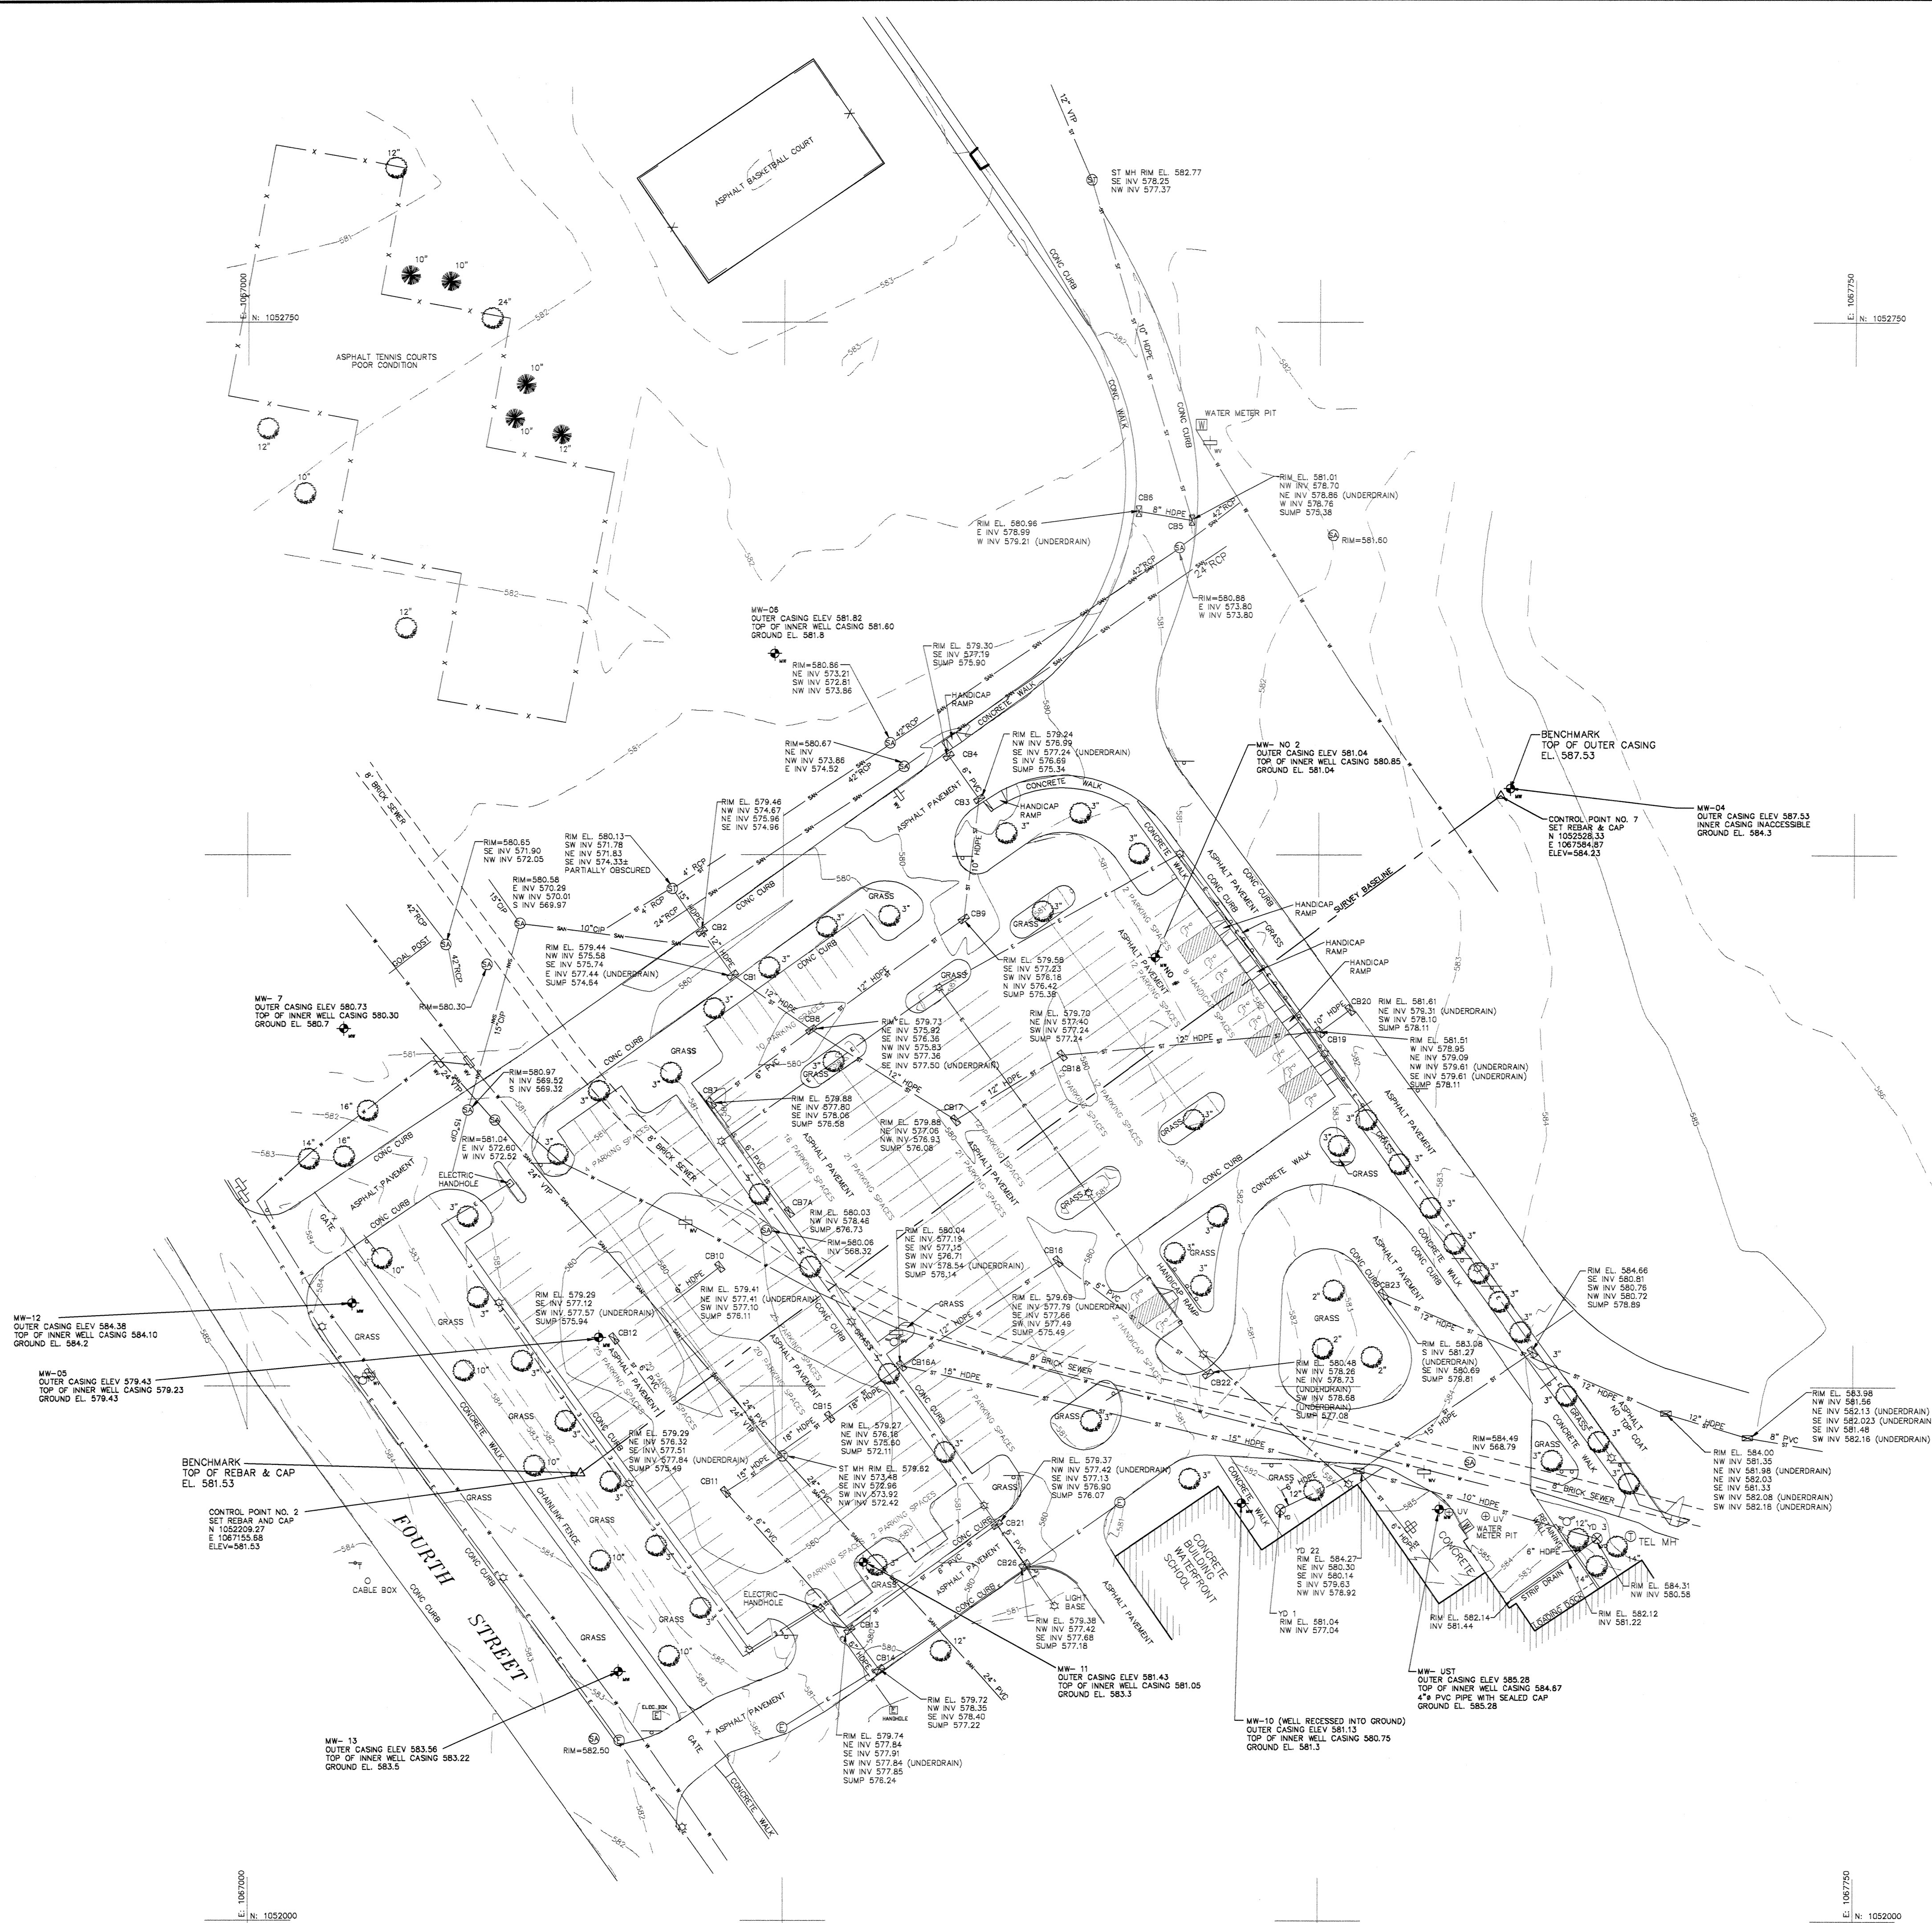

- LEGEND:**
- BENCHMARK
 - CENTERLINE
 - CLEANOUT
 - 3" DECIDUOUS TREE & (TRUNK DIAMETER)
 - 12" CONIFEROUS TREE & (TRUNK DIAMETER)
 - DRAINAGE MANHOLE (STORM)
 - DRAINAGE STRUCTURE (CATCH BASIN)
 - ELECTRIC MANHOLE
 - ELECTRIC (UNDERGROUND)
 - FIRE HYDRANT
 - GASLINE (UNDERGROUND)
 - GAS LINE MARKER
 - GAS VALVE
 - HORIZONTAL CONTROL POINT
 - MONITORING WELL
 - POLE w/LIGHT
 - SANITARY SEWER
 - SEWER MANHOLE (SANITARY)
 - SIGN 2 POSTS
 - SIGN
 - STORM SEWER
 - TELEPHONE (UNDERGROUND)
 - WATERLINE (UNDERGROUND)
 - WATER METER PIT
 - WATER VALVE
 - ELECTRIC HANDHOLE
 - CABLE BOX
 - UTILITY HANDHOLE
 - UNKNOWN UTILITY VALVE

- ABBREVIATIONS:**
- ASP ASPHALT
 - CONC CONCRETE
 - CL CENTERLINE
 - CIP CAST IRON PIPE
 - ELEV ELEVATION
 - EP EDGE OF PAVEMENT
 - HDPE HIGH DENSITY POLYETHYLENE
 - INV INVERT
 - PVC POLY-VINYL CHLORIDE
 - RCP REINFORCED CONCRETE PIPE
 - RCMP ROUND CORRUGATED METAL PIPE
 - ROW RIGHT OF WAY
 - TYP TYPICAL
 - VTP VITRIFIED TILE PIPE
 - MW-UST MONITORING WELL UNDERGROUND STORAGE TANK

NOTES:

THE UNDERGROUND UTILITIES SHOWN ARE ONLY THOSE THAT WERE IDENTIFIED AND ENCOUNTERED OR CONSTRUCTED DURING THIS PROJECT. END POINTS OF INDICATED UTILITIES ARE ONLY SHOWN FOR LOCATION AND DIRECTION OF ASSUMED EXISTING AND/OR ABANDONED UTILITIES. THE SURVEYOR MAKES NO GUARANTEE THAT THE UNDERGROUND UTILITIES SHOWN COMPRISE ALL SUCH UTILITIES IN THE AREA, EITHER IN SERVICE OR ABANDONED. THE SURVEYOR FURTHER DOES NOT WARRANT THAT THE UNDER GROUND UTILITIES SHOWN ARE IN THE EXACT LOCATION INDICATED. ALTHOUGH THEY ARE LOCATED AS ACCURATELY AS POSSIBLE FROM RECORD INFORMATION AVAILABLE, THE SURVEYOR HAS NOT PHYSICALLY LOCATED THE UNDERGROUND UTILITIES.


ELEVATIONS ARE REFERENCED TO THE SITE VERTICAL DATUM AS SHOWN ON A MAP PREPARED BY 'ECOLOGY AND ENVIRONMENT ENGINEERING, P.C.', ENTITLED "FOURTH STREET REMEDIATION PROJECT", SHEET 4 OF 5, DATED 2-11-05 AND ARE BASED ON NGVD 1929 DATUM.

COORDINATES ARE REFERENCED TO THE NEW YORK STATE PLANE COORDINATE SYSTEM WEST ZONE - NAD83/98 HORIZONTAL DATUM.

UNAUTHORIZED ALTERATION OR ADDITION TO ANY SURVEY, DRAWING, DESIGN, SPECIFICATION, PLAN OR REPORT IS A VIOLATION OF SECTION 7209, PROVISION 2 OF THE NEW YORK STATE EDUCATION LAW.

THIS MAP IS BASED ON A FIELD SURVEY COMPLETED JUNE 22, 23, 26, 2006

ALL UNDERDRAIN ON SITE ARE CONSTRUCTED WITH 4" HDPE UNDERDRAINS WHICH DISCHARGE TO LOCALIZED CATCH BASINS

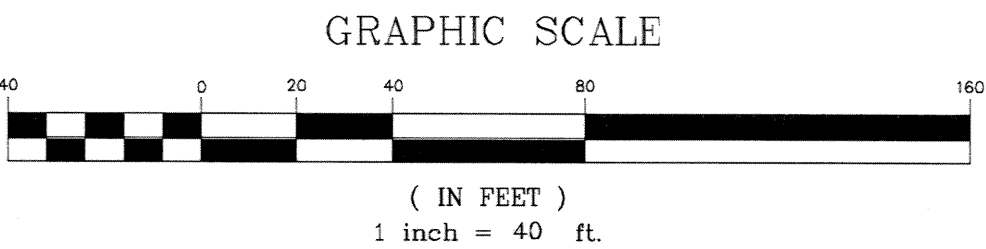

Earth Tech - Remediation Services

40 British American Blvd

Latham, NY 12110

Phone: 518-951-2200

Fax: 518-951-2300

Consultant

Foit-Albert Associates

Architecture, Engineering and Surveying, P.C.

763 Main Street

Buffalo, New York 14203

Phone: (716) 856-3933

Fax: (716) 856-3961

FINAL TOPOGRAPHIC SURVEY

FOURTH STREET REMEDIATION PROJECT

NYDEC SITE NUMBER: 9-15-167

DESIGN CONTRACT NUMBER: D005197

CITY OF BUFFALO, COUNTY OF ERIE, STATE OF NEW YORK

STATE OF NEW YORK

MICHAEL JOSEPH POHL

NO. 049015

REGISTERED LAND SURVEYOR

Seal:

Revision Number

Revision Date

7/3/06

REVISED PER REQUEST

8/14/06

REVISED PER REQUEST

Scale:

1"=40'

Date:

6/23/06

Project Manager:

M. FOHL

Drawn By:

G. McEWEEN

Checked By:

M. FOHL

Project:

05033.00

File Name:

05033-FINAL AS-BUILT.DWG

Sheet:

TS101