



E.G.H. YOUNGMANN EXPRESSWAY (NYS&DOT)

LAMAR ADVERTISING

DKP BUFFALO

GE

COKE

MILENS ROAD


- LEGEND**
- BUILDING FOOTPRINT
 - CHAIN LINK FENCE
 - PROPERTY LINE
 - LIMITS OF EXCAVATION
 - BLACKTOP SURFACE PATCH
 - MONITORING WELL
 - TRENCH DRAIN
 - SUMP
 - CATCH BASIN
 - STORM DRAIN MANHOLE
 - SANITARY MANHOLE
 - FLOOR DRAIN
 - ROOF DRAIN
 - 2015 REMOVED SANI
 - 2015 4" SAN FILLED
 - NEW STORM SEWER LINE
 - 4" BURST LINED SAN
 - REMOVED STORM SEWER LINE

- SAMPLE TYPES**
- ◆ - BASE OF EXCAVATION
 - ◆ - UPPER SIDEWALL
 - ◆ - LOWER SIDEWALL

- NOTES**
1. SAMPLE LOCATIONS AND LIMITS OF EXCAVATION ARE APPROXIMATE.
 2. EXCAVATION TO 1 FOOT EXCEPT AS NOTED.
 3. NOT ALL ROOF DRAINS AND UTILITIES ARE SHOWN.

SOURCES:

1. "MAP OF GENERAL ELECTRIC SERVICE CENTER PROPERTY, PART OF LOT 453, TOWNSHIP 12, RANGE 10, WEST OF THE MERIDIAN, WEST COUNTY, NEW YORK," KREBEL ASSOCIATES, JULY 29, 1998.
2. SURVEY BY NUSSBAUMER & CLARK, INC.
3. FIELD OBSERVATIONS.

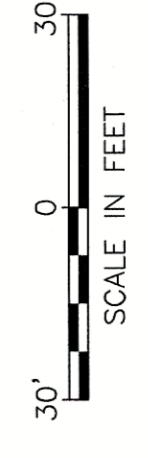

Engineer:
 URS CORPORATION - NEW YORK
 40 BRITISH AMERICAN BOULEVARD
 LATHAM, NEW YORK 12110
 T: 518.951.2200 F: 518.951.2300

REFERENCE:
 NYS&DOT SITE NUMBER 91544
 US&P ID #W08655894

WARNING:
 THIS DOCUMENT IS THE PROPERTY OF URS CORPORATION. IT IS TO BE USED ONLY FOR THE PROJECT AND SITE SPECIFICALLY IDENTIFIED HEREIN. ANY REUSE OR ALTERATION OF THIS DOCUMENT WITHOUT THE WRITTEN PERMISSION OF URS CORPORATION IS STRICTLY PROHIBITED. THE USER ASSUMES ALL LIABILITY FOR ANY ERRORS OR OMISSIONS IN THIS DOCUMENT. THE USER SHALL BE RESPONSIBLE FOR OBTAINING ALL NECESSARY PERMITS AND REGULATORY APPROVALS. THE USER SHALL BE RESPONSIBLE FOR OBTAINING ALL NECESSARY INFORMATION FROM THE APPROPRIATE AGENCIES AND UTILITIES. THE USER SHALL BE RESPONSIBLE FOR OBTAINING ALL NECESSARY INFORMATION FROM THE APPROPRIATE AGENCIES AND UTILITIES. THE USER SHALL BE RESPONSIBLE FOR OBTAINING ALL NECESSARY INFORMATION FROM THE APPROPRIATE AGENCIES AND UTILITIES.

Title:	CORRECTIVE MEASURE IMPLEMENTATION AS-BUILT
Location:	175 MILENS ROAD, TONAWANDA, NEW YORK
Client:	GENERAL ELECTRIC INTERNATIONAL, INC.
Drawn:	DATE: May 2016
Checked:	DATE: May 2016
Job No.:	60442945
Sheet No.:	22 X 34
DRAWING 1	

