

The electronic version of this file/report should have the file name:

Report. HW. 932052. 1995-06-16. Onsite_GW_Extraction -
System - As-built - CCR - Vol 2. pdf

Type of document . Site Number . Year-Month . File Year-Year or Report name . pdf

_____ . _____ . File _____ . pdf

example: letter . Year-Month . File Year-Year . pdf

_____ . _____ . _____ . pdf

example: report . Site Number . Year-Month . Report Name . pdf

Project Site numbers will be preceded by the following:

Municipal Brownfields - B

Superfund - HW

Spills - SP

ERP - E

VCP - V

BCP - C

Golder Associates Inc.

210 John Glenn Drive, Suite 1
Amherst, NY USA 14228
Telephone (716) 691-1156
Fax (716) 691-5109



REPORT ON

**ON-SITE GROUND WATER EXTRACTION SYSTEM
AS-BUILT DOCUMENTATION AND
CONSTRUCTION CERTIFICATION
BELL AEROSPACE TEXTRON
WHEATFIELD, NEW YORK**

VOLUME II OF II

Submitted to:

**Bell Aerospace Textron
P.O. Box One
Buffalo, New York 14240**

DISTRIBUTION:

**8 Copies - Mr. John Devic; Bell Aerospace Textron; Buffalo, New York
2 Copies - Golder Associates Inc.; Buffalo, New York**

June 1995

933-9068

TABLE OF CONTENTS

VOLUME I

Cover Letter

Statement of Certification

i

Table of Contents

ii

SECTIONPAGE

1. INTRODUCTION	1
1.1 General	1
1.2 General Site Geology/Hydrogeology	2
1.3 Project Organization	2
1.4 Project Execution	3
1.5 Purpose and Scope of the Certification Report	4
2. DESIGN OVERVIEW	5
2.1 General	5
2.2 System Components	5
3. SUMMARY OF CONSTRUCTION AND CONSTRUCTION QUALITY	
ASSURANCE (CQA) ACTIVITIES	7
3.1 General	7
3.2 Extraction Wells	7
3.3 Trench Excavation/Backfill	9
3.4 Piping/Pumping System	12
3.5 Electrical	13
3.6 Building Shell Structure	14
3.7 Health and Safety	14
4. DESIGN MODIFICATIONS AND CLARIFICATIONS	15
5. SUMMARY	16
REFERENCES	17

TABLE OF CONTENTS (Continued)

In Order
Following
Page 17

TABLE 1	-	Extraction Well Rising Head Test Summary
TABLE 2	-	Trench Dimensions
TABLE 3	-	In-Place Field Moisture/Density Testing Summary
TABLE 4	-	Summary of Design Modification and Clarifications
FIGURE 1	-	Bell Aerospace Textron Facility Location
FIGURE 2	-	Location of On-Site System
DRAWING PACKAGE	-	Sheets B-1 through B-6 Golder Associates Sheets D93-048747-00 through D93-048747-07, Butler Manufacturing Company
APPENDIX A	-	Golder Associates Inc. Field Reports
APPENDIX B	-	Certification Letter
APPENDIX C	-	Wendel Engineers, P.C., Electrical Inspection Report
APPENDIX D	-	Products List
APPENDIX E	-	Well Boring and Installation Logs
APPENDIX F	-	Rising Head Test Results
APPENDIX G	-	#1A Stone Grain Size Distribution
APPENDIX H	-	#1A Stone Laboratory Compaction Test Results
APPENDIX I	-	Nuclear Densimeter Test Results #1A Stone
APPENDIX J	-	Survey Data
APPENDIX K	-	Pressure Test Procedure and Pressure Test Results
APPENDIX L	-	Air Monitoring Forms
APPENDIX M	-	Design Modification/Clarification Forms

VOLUME II

ATTACHMENT II - Conformed Drawings (from Appendix C)

APPENDIX C

WENDEL ENGINEERS, P.C.
ELECTRICAL INSPECTION REPORT

VOLUME I

ATTACHMENT I
Field Reports

VOLUME II

ATTACHMENT II
Conformed Drawings

Attachment II
Conformed Drawings


DRAWING INDEX

DWG. N°		REV. N°	DATE	TITLE
D-0273	SHT. 1	2	11/16/94	VAULT EW-7 CONTROL PANEL LAYOUT
D-0273	SHT. 2	5	11/16/94	EW-7 CONTROL PANEL SCHEMATIC
D-0273	SHT. 3	2	11/16/94	VAULT EW-8 CONTROL PANEL LAYOUT
D-0273	SHT. 4	5	11/16/94	EW-8 CONTROL PANEL SCHEMATIC
D-0273	SHT. 5	2	11/16/94	VAULT DW-9 CONTROL PANEL LAYOUT
D-0273	SHT. 6	5	11/16/94	DW-9 CONTROL PANEL SCHEMATIC
D-0273	SHT. 7	2	11/16/94	VAULT DW-10 CONTROL PANEL LAYOUT
D-0273	SHT. 8	5	11/16/94	DW-10 CONTROL PANEL SCHEMATIC
D-0273	SHT. 9	2	11/16/94	VAULT DW-11 CONTROL PANEL LAYOUT
D-0273	SHT. 10	5	11/16/94	DW-11 CONTROL PANEL SCHEMATIC
D-0273	SHT. 11	2	11/16/94	VAULT DW-12 CONTROL PANEL LAYOUT
D-0273	SHT. 12	5	11/16/94	DW-12 CONTROL PANEL SCHEMATIC
D-0273	SHT. 13	2	11/16/94	FEED CONTROL PANEL (FCP) LAYOUT
D-0273	SHT. 14	5	11/16/94	FEED CONTROL PANEL (FCP) SCHEMATIC
D-0273	SHT. 15	3	11/16/94	BACKWASH CONTROL PANEL LAYOUT/SCHEMATIC
D-0273	SHT. 16	2	11/16/94	SECONDARY CONTROL PANEL (SCP) LAYOUT
D-0273	SHT. 17	4	11/16/94	SECONDARY CONTROL PANEL (SCP) SCHEMATIC
D-0273	SHT. 18	4	11/16/94	RTU WIRING (EW-7)
D-0273	SHT. 19	4	11/16/94	RTU WIRING (EW-8)
D-0273	SHT. 20	4	11/16/94	RTU WIRING (DW-9)
D-0273	SHT. 21	4	11/16/94	RTU WIRING (DW-10)
D-0273	SHT. 22	4	11/16/94	RTU WIRING (DW-11)
D-0273	SHT. 23	4	11/16/94	RTU WIRING (DW-12)
D-0273	SHT. 24	3	11/16/94	RTU WIRING (TREATMENT PLANT)
D-0273	SHT. 25	4	11/16/94	RTU TO PC INTERFACE DRAWING
D-0273	SHT. 26	3	11/16/94	ELECTRICAL INTERCONNECTING LAYOUT
D-0273	SHT. 27	3	11/16/94	ELECTRICAL INTERCONNECTING SCHEDULE
D-0273	SHT. 28	3	11/16/94	ELECTRICAL INTERCONNECTING SCHEDULE
D-0273	SHT. 29	1	11/16/94	ELECTRICAL INTERCONNECTING LAYOUT
D-0273	SHT. 30	1	11/16/94	ELECTRICAL INTERCONNECTING SCHEDULE
D-0273	SHT. 31	2	11/16/94	RTU WIRING (FCP, SCP, STCP)
D-0273	SHT. 32	2	11/16/94	RTU WIRING (PRESSURE TRANSMITTERS)

ELECTRICAL DRAWINGS
GROUNDWATER TREATMENT
PLANT

BELL AEROSPACE TEXTRON
WHEATFIELD, NEW YORK


Engineer: Treatek - CRATM COMPANY

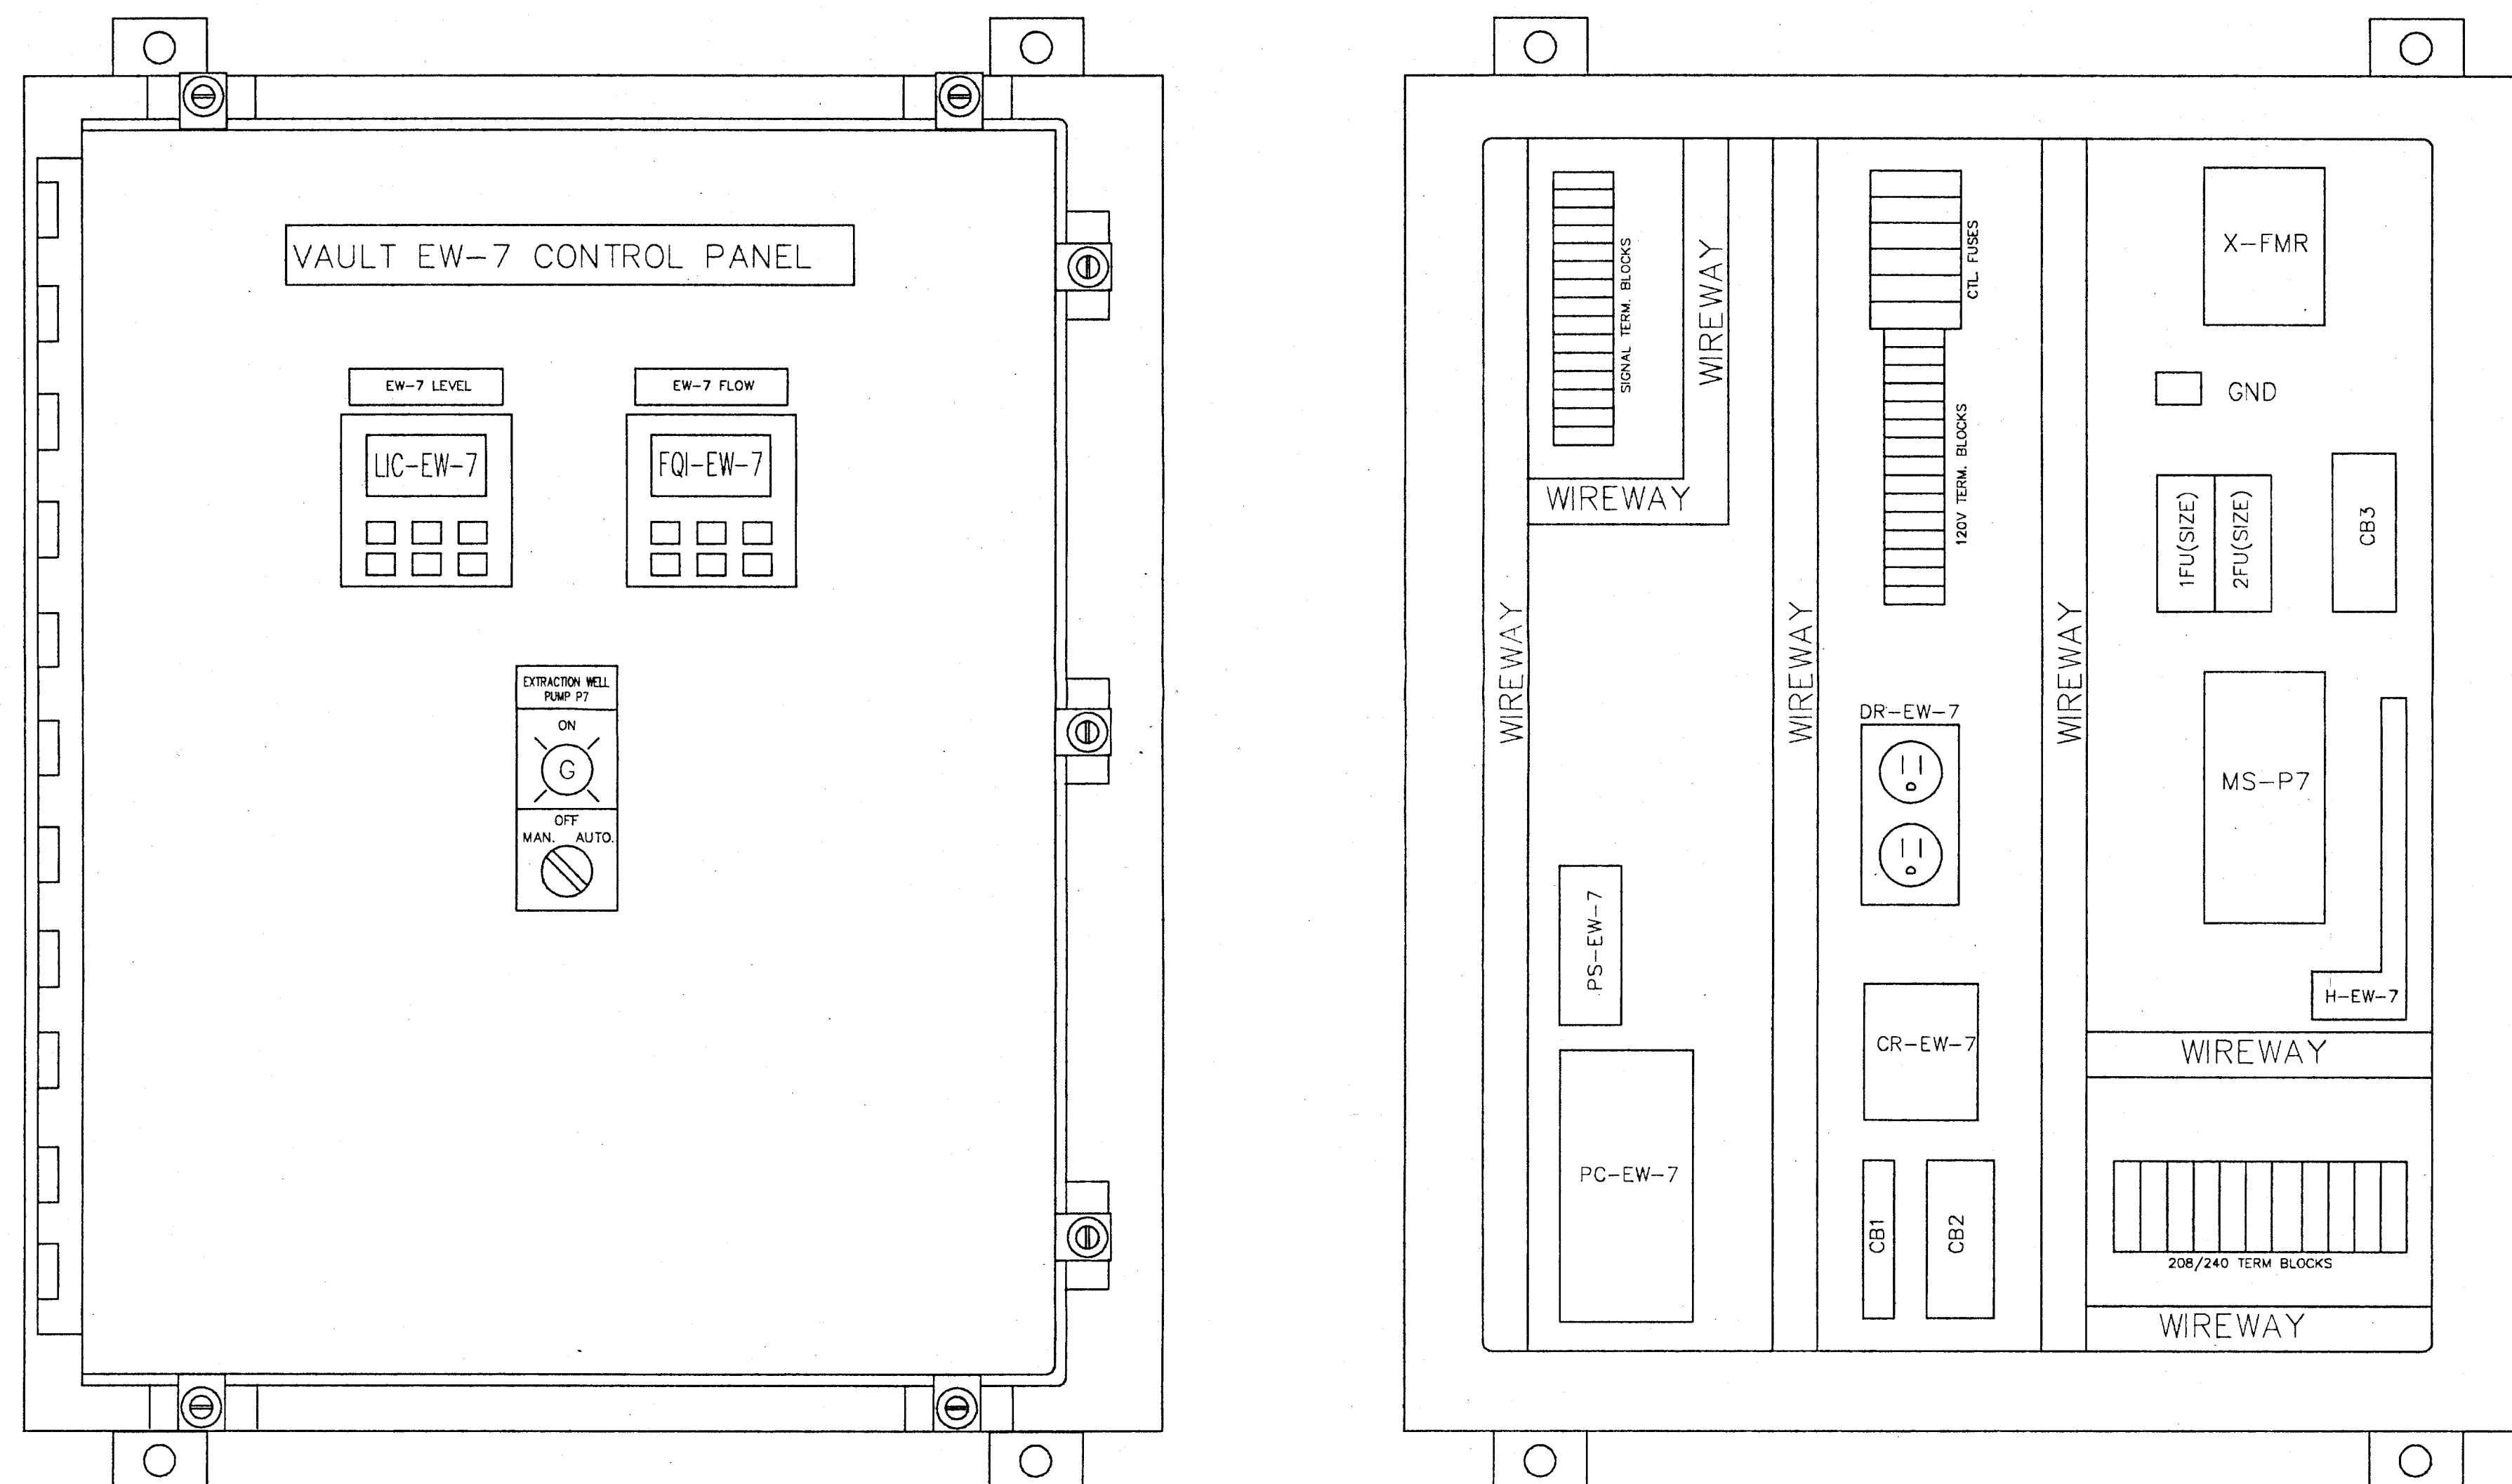

VAULT EW-7 CONTROL PANEL
 SIZE: 30" X 24" X 8"

--	--	

THIS DRAWING INCLUDING THE INFORMATION, DATA AND DESIGN IS THE PROPERTY OF TREATEK - CRA. IT IS NOT TO BE COPIED, REPRODUCED OR ITS CONTENTS DIVULGED WITHOUT THE WRITTEN PERMISSION OF TREATEK - CRA.

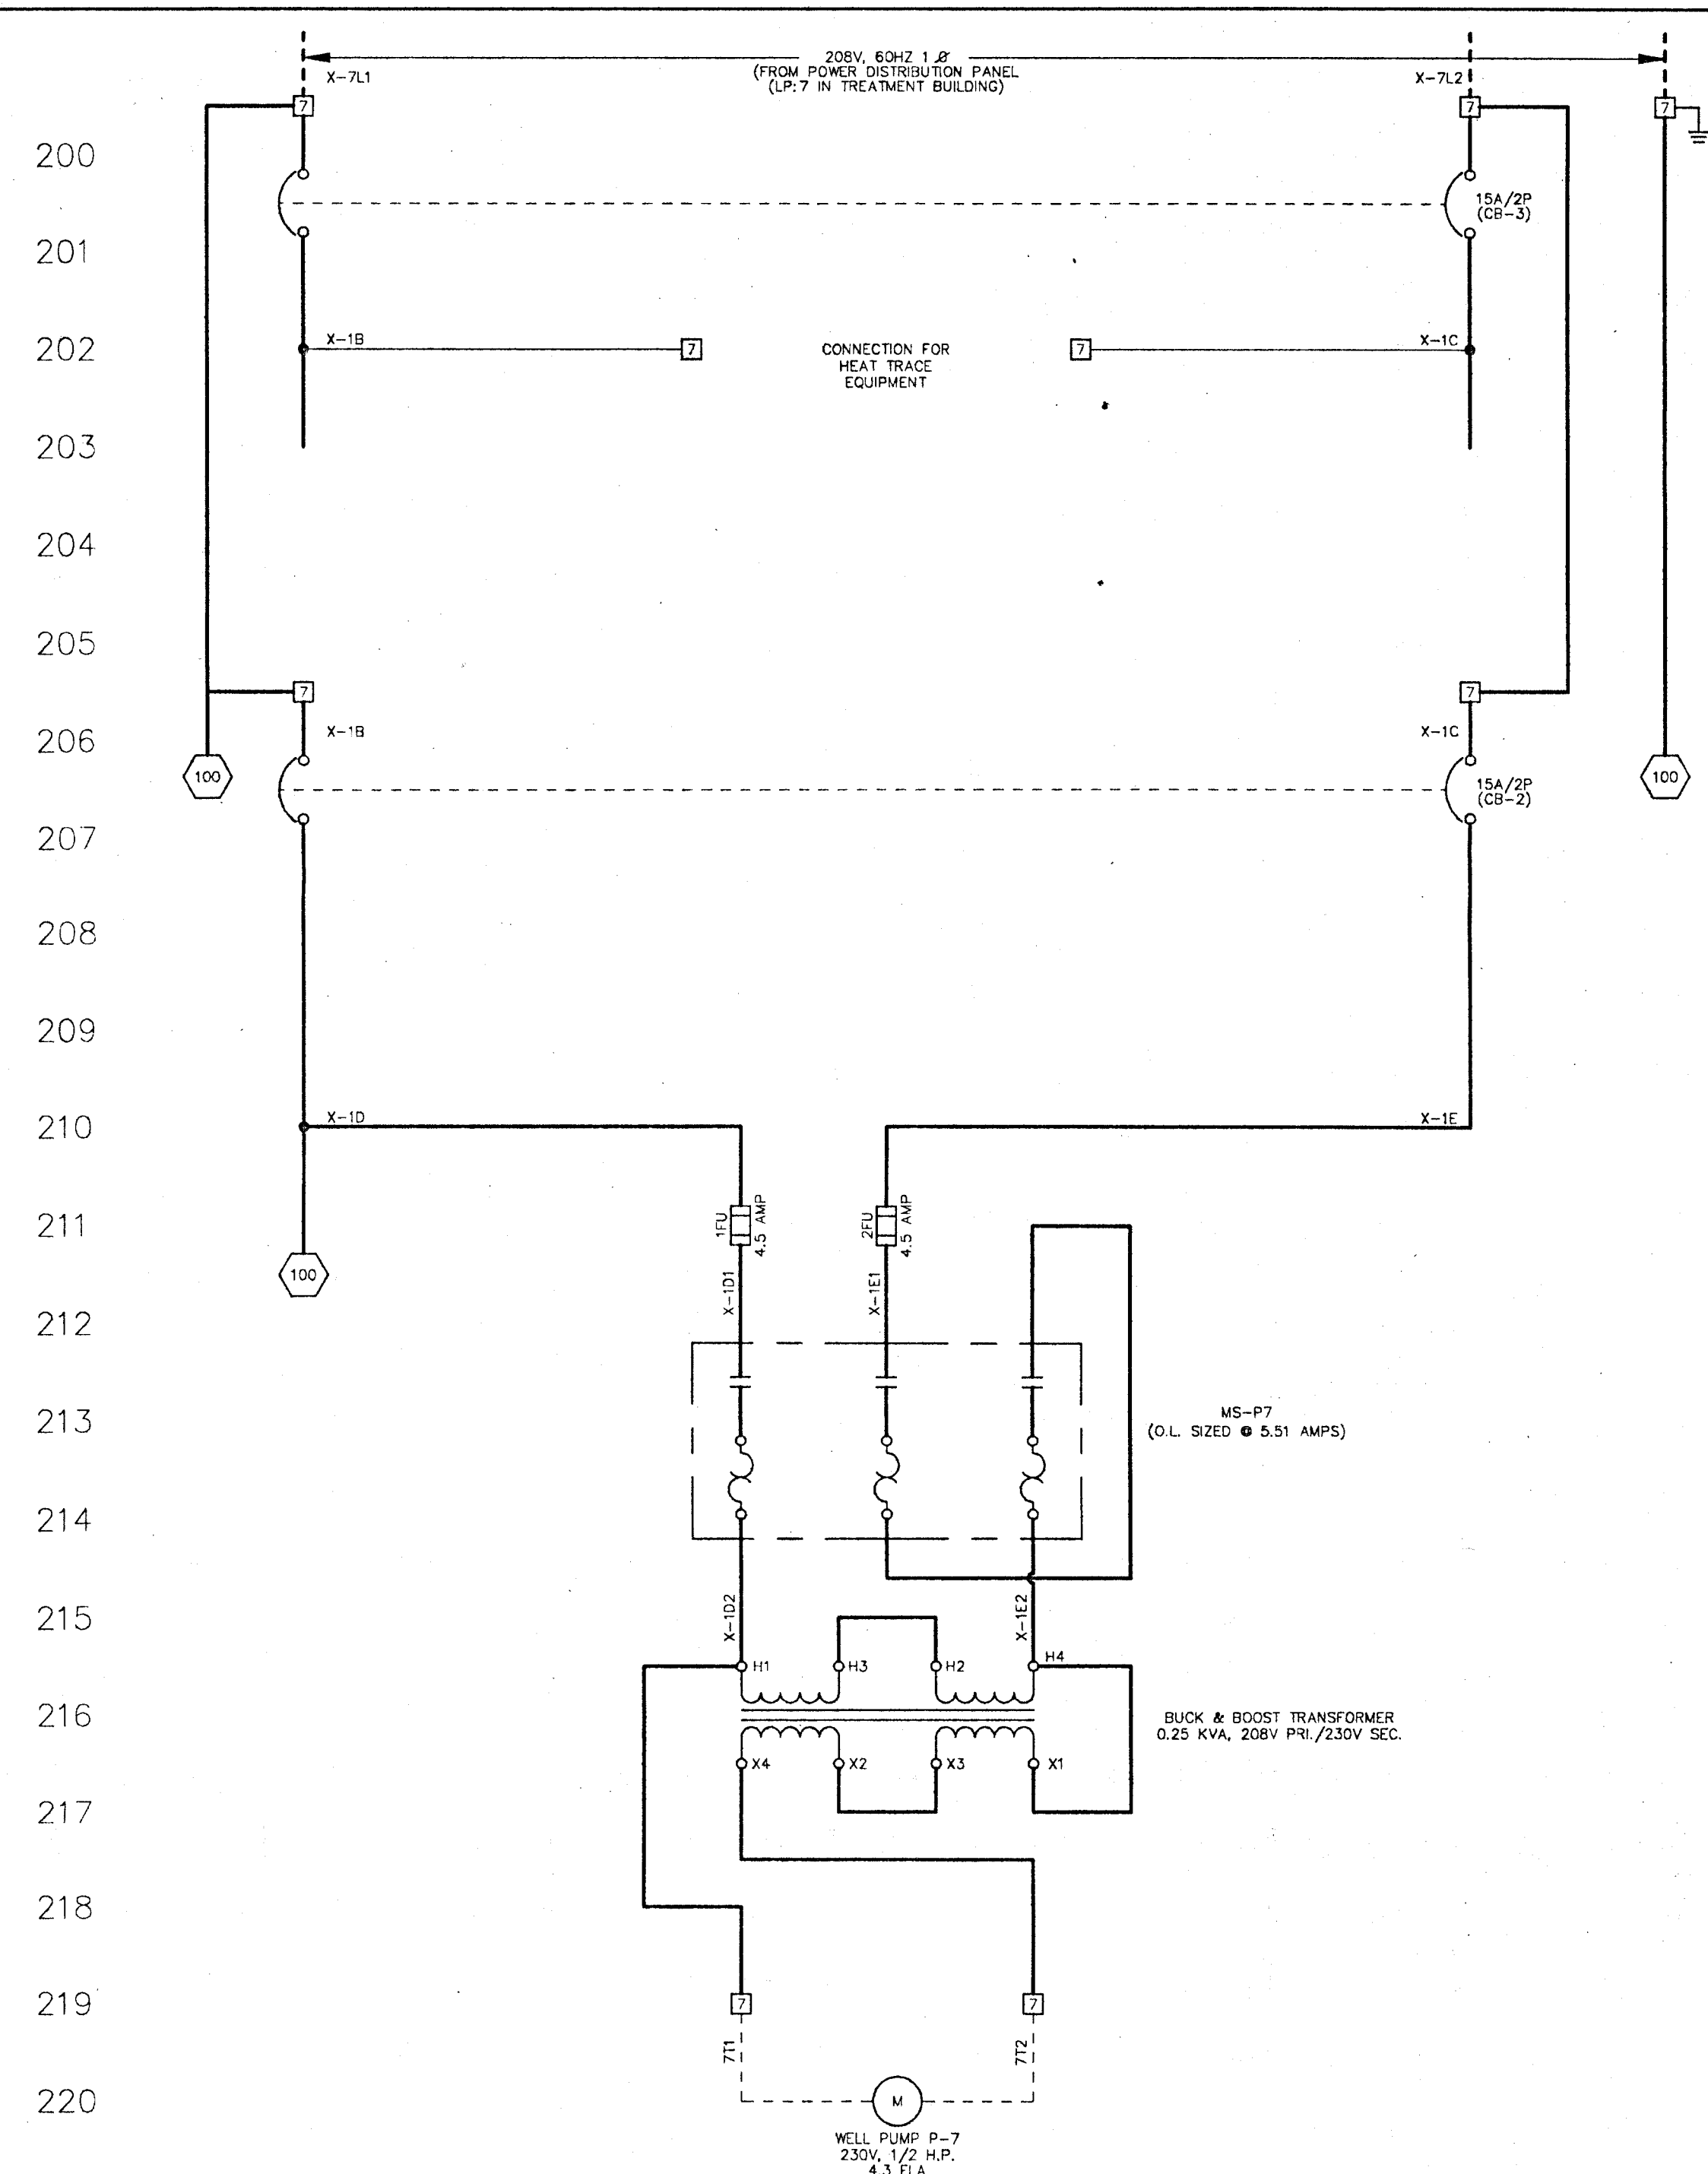

KEY:

7	TERMINAL BLOCK LOCATED IN PANEL FOR INSTALLING CONTRACTOR CONNECTION
-----	INDICATES WIRING INTERNAL TO PANEL
- - - - -	INDICATES WIRING EXTERNAL TO PANEL



THIS DRAWING INCLUDING THE INFORMATION, DATA AND DESIGN IS THE PROPERTY OF TREATEK - CRA. IT IS NOT TO BE COPIED, REPRODUCED OR ITS CONTENTS DIVULGED WITHOUT THE WRITTEN PERMISSION OF TREATEK - CRA.

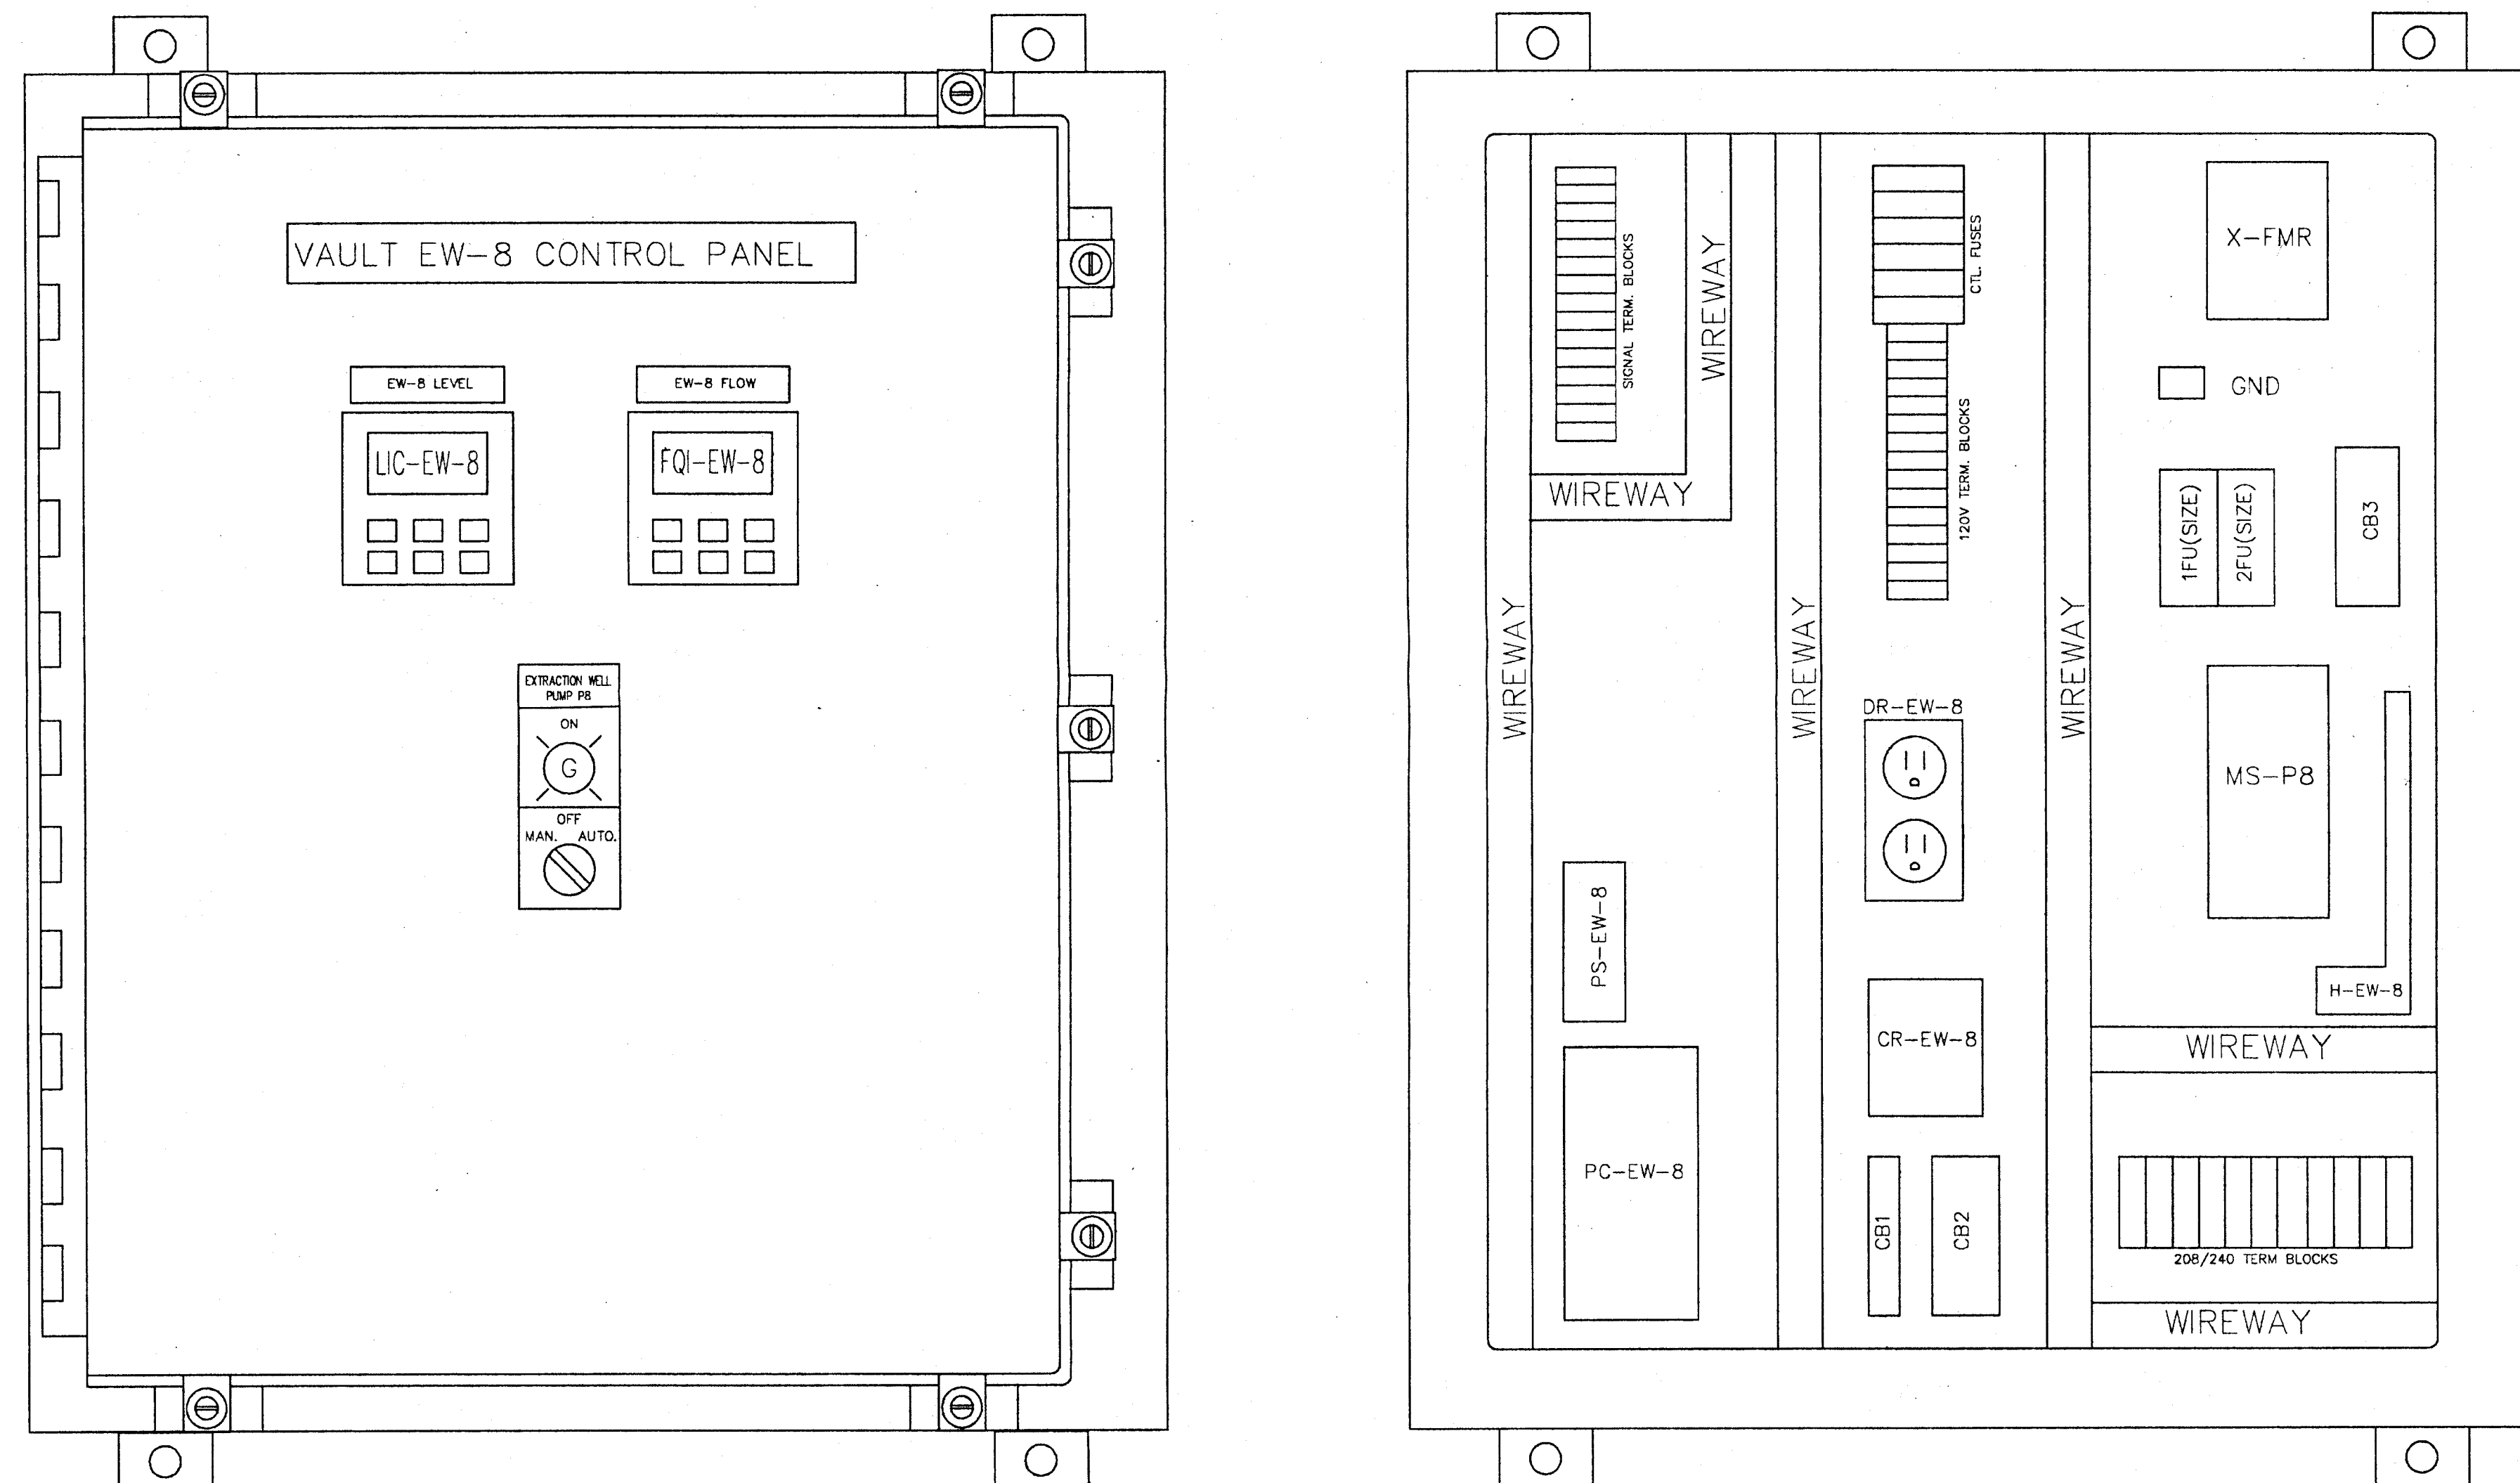

VAULT EW-8 CONTROL PANEL
SIZE: 30" X 24" X 8"

				FILE NAME: 0273e013				0273
				Treatek - CRA TM COMPANY				
				BELL AEROSPACE TEXTRON GROUNDWATER TREATMENT PLANT				
				VAULT EW-8 CONTROL PANEL LAYOUT				
				SCALE NONE				
				DWG. D-0273				SHT. 3

THIS DRAWING INCLUDING THE INFORMATION, DATA AND DESIGN IS THE PROPERTY OF TREATEK - CRA. IT IS NOT TO BE COPIED, REPRODUCED OR ITS CONTENTS DIVULGED WITHOUT THE WRITTEN PERMISSION OF TREATEK - CRA.

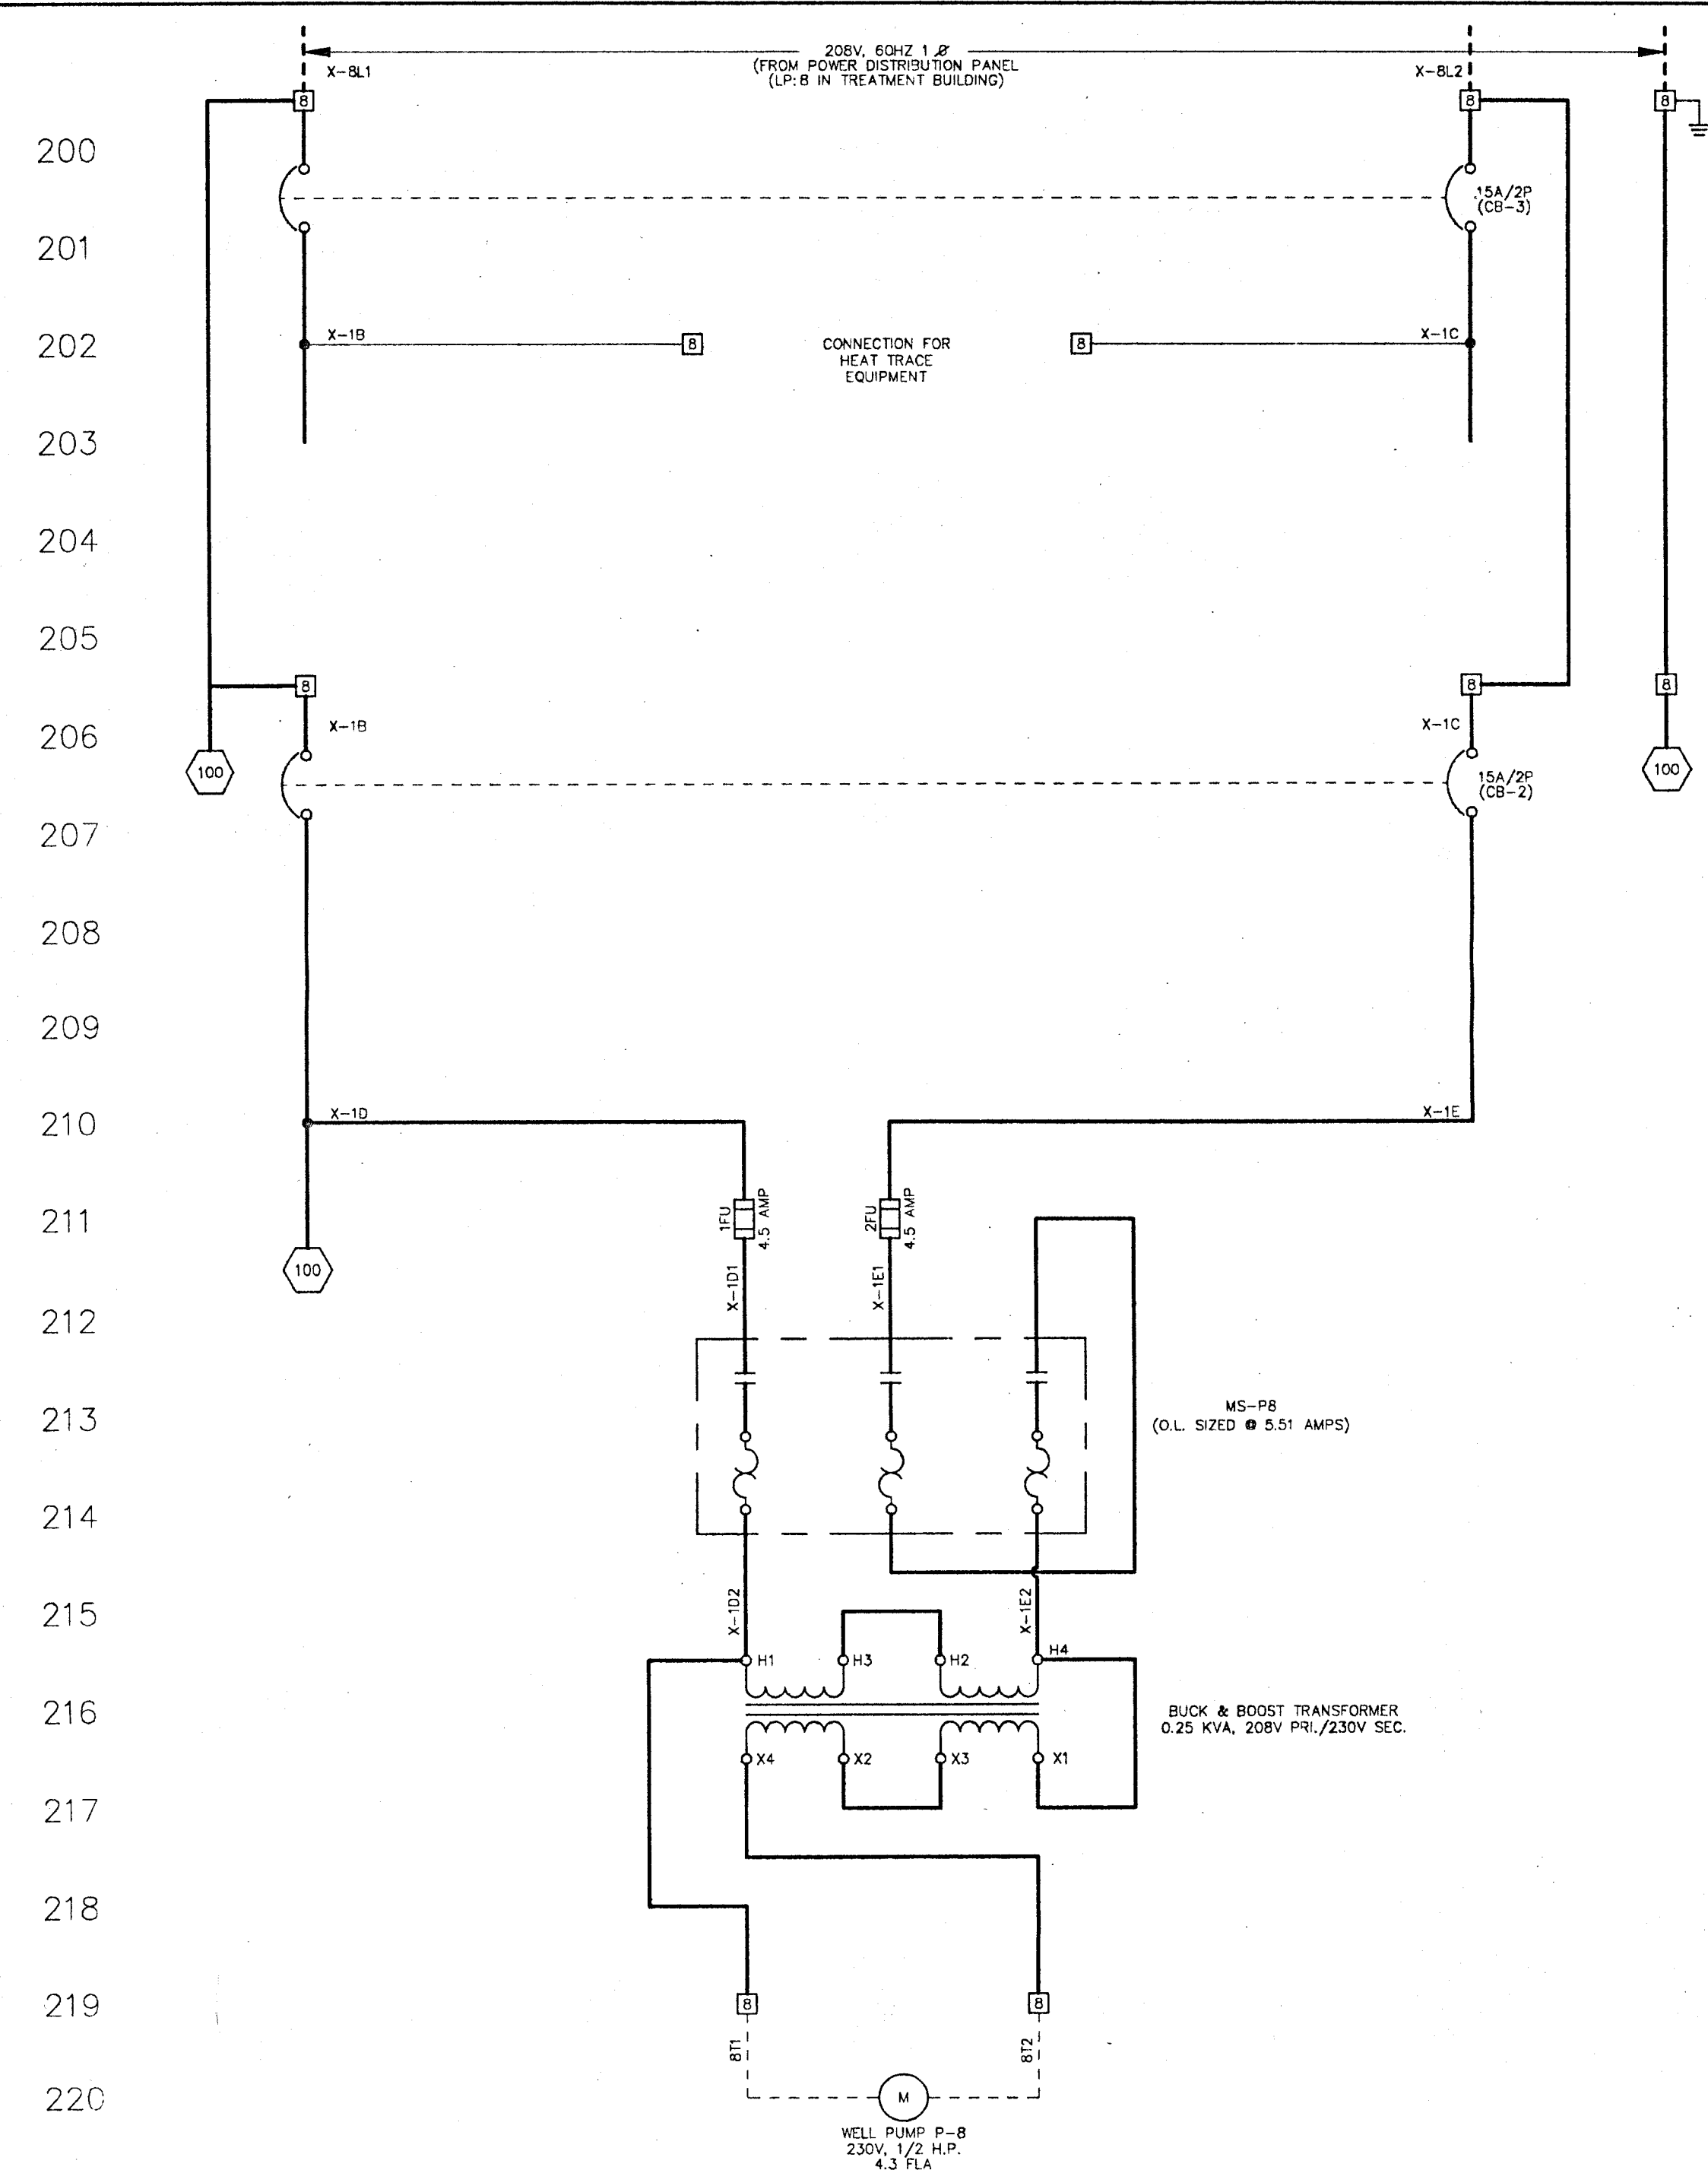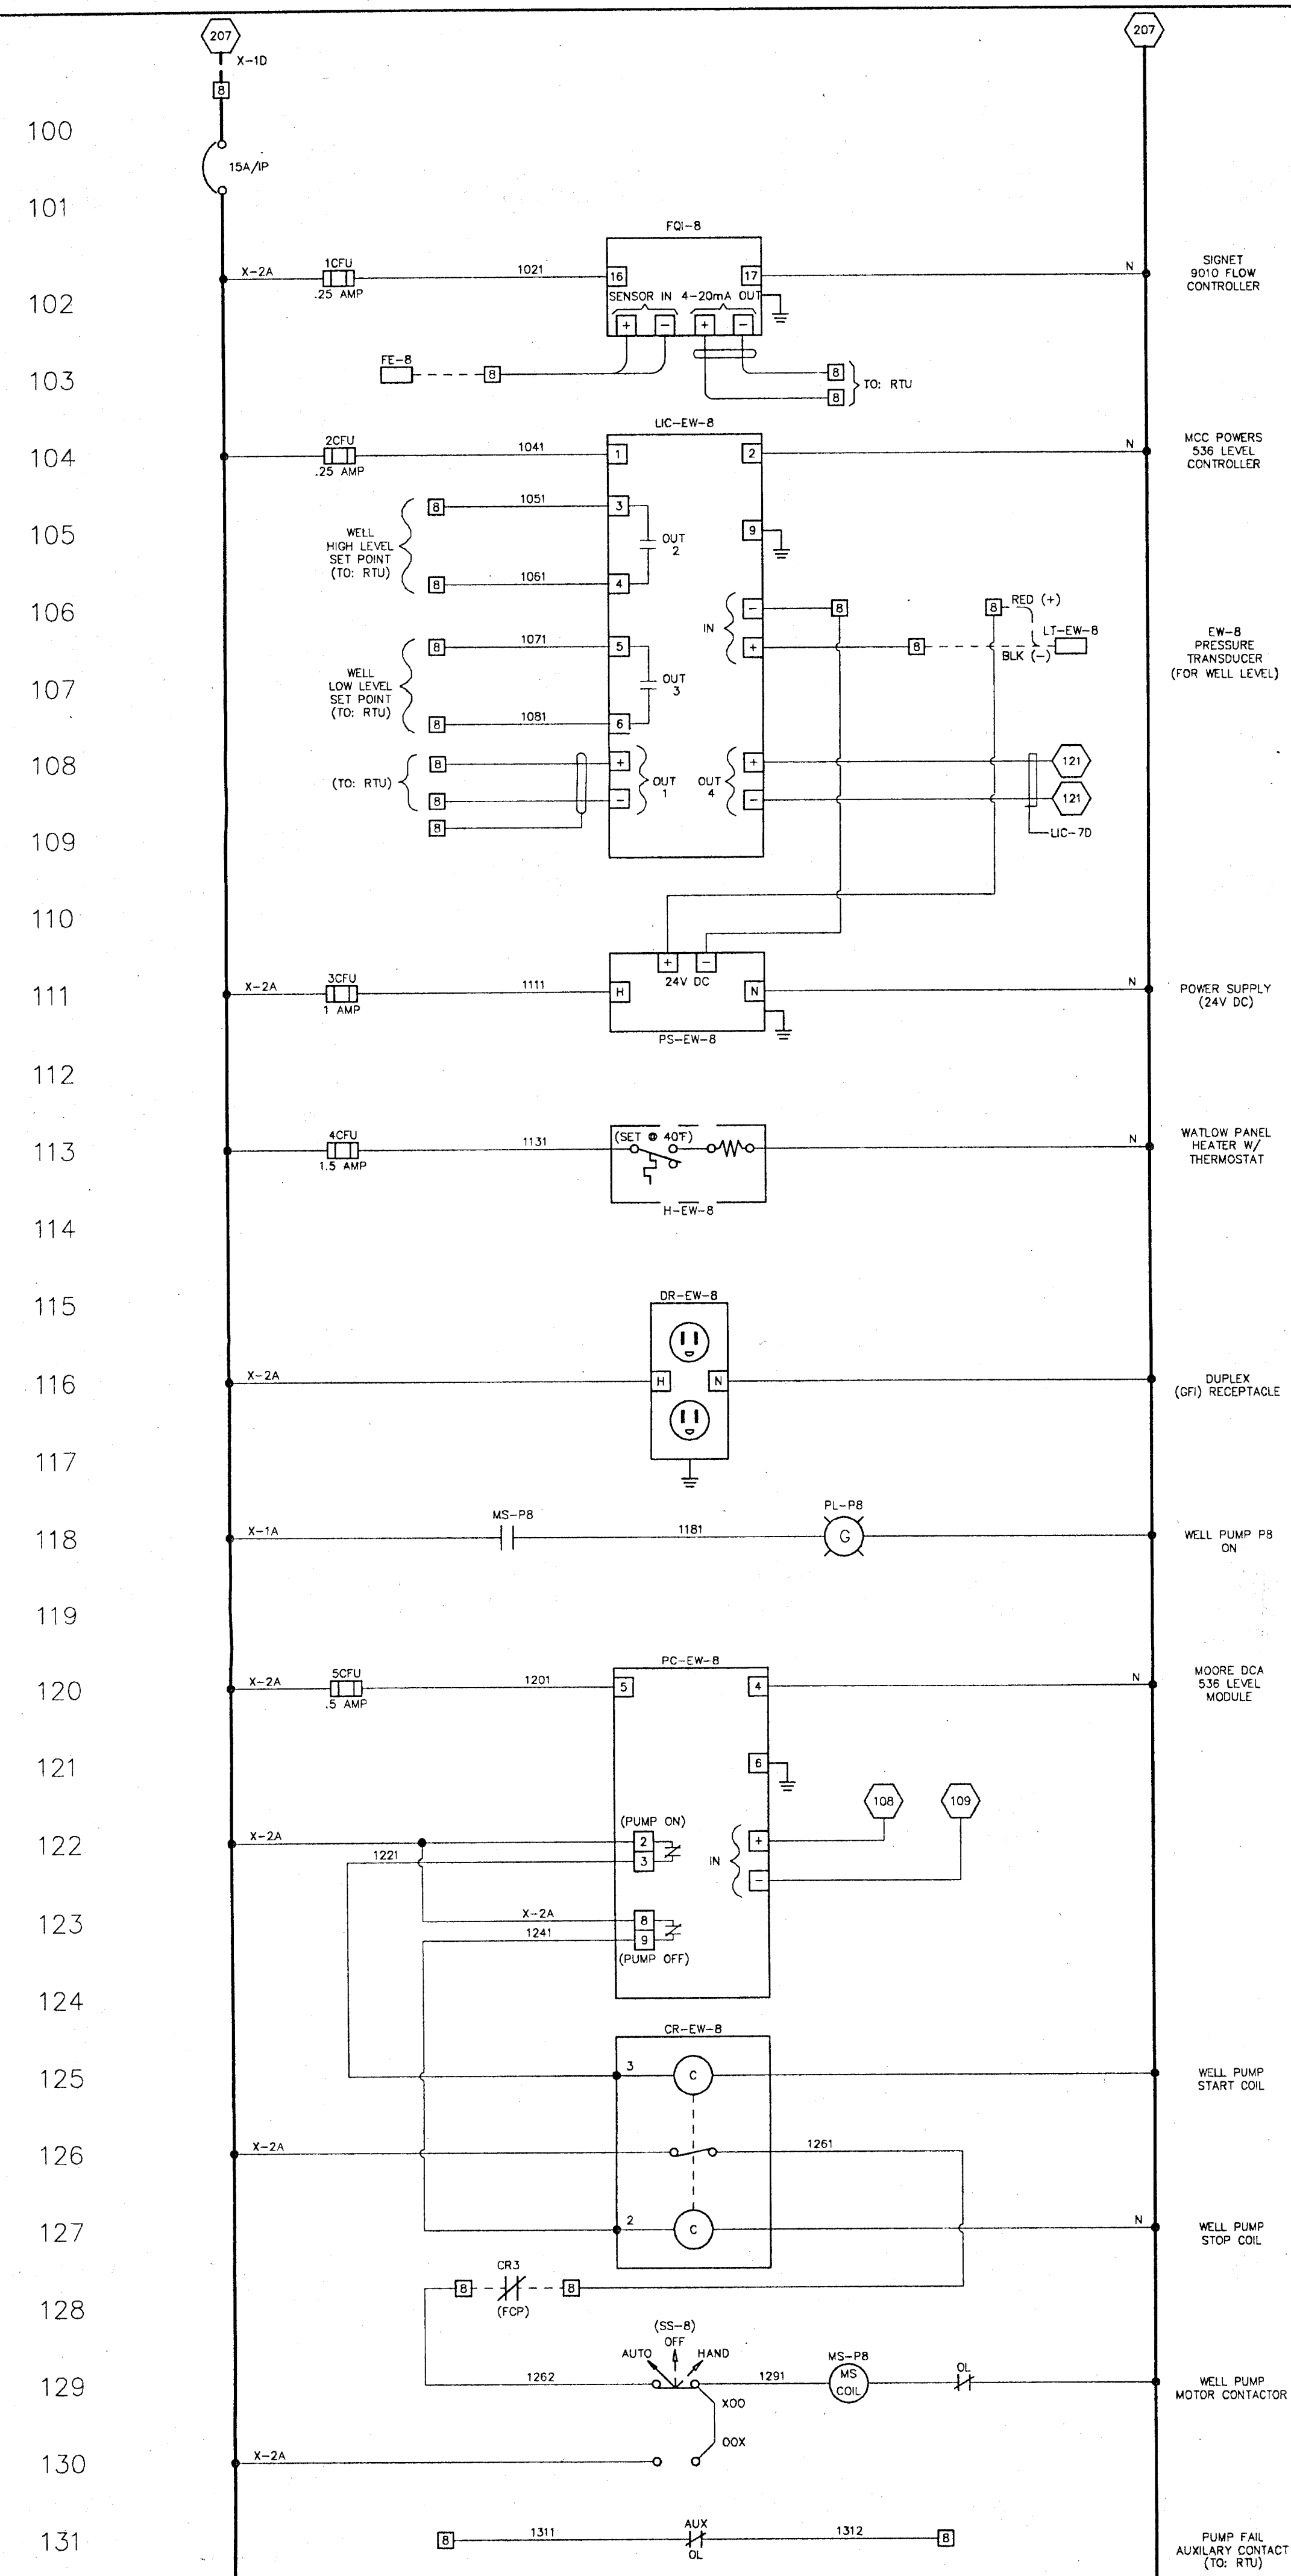


(EW-8) VAULT PANEL SCHEMATIC

KEY:

8	TERMINAL BLOCK LOCATED IN PANEL FOR INSTALLING CONTRACTOR CONNECTION
-----	INDICATES WIRING INTERNAL TO PANEL
-----	INDICATES WIRING EXTERNAL TO PANEL

				APPROVAL	MANAGER	ENGR.	DATE	
5	AS BUILT	BAB		STR. AND CIVIL MECHANICAL				
4	GENERAL REVISION	BAB		ELECT. & INST.	JMF	JMF	1-7-94	
3	CERTIFIED FOR CONSTRUCTION	BAB		PROCESS				
2	SUBMITTAL REVIEW REVISION	BAB		PROJECT	ACY		1-7-94	
1	GENERAL REVISION	JMF		DRAWN BY B.A. BEEBE DSGN. CALBY J. FLEISCHMAN	DATE 11-5-93 DATE 11-1-93			
NO.	REVISIONS	DRAWN	CHKD.	APP.	DATE	CHECKED BY B.A. BEEBE	DATE 1-7-94	SCALE NONE DWG. D-0273 SHT. 4

THIS DRAWING INCLUDING THE INFORMATION, DATA AND DESIGN IS THE PROPERTY OF TREATEK - CRA. IT IS NOT TO BE COPIED, REPRODUCED OR ITS CONTENTS DIVULGED WITHOUT THE WRITTEN PERMISSION OF TREATEK - CRA.


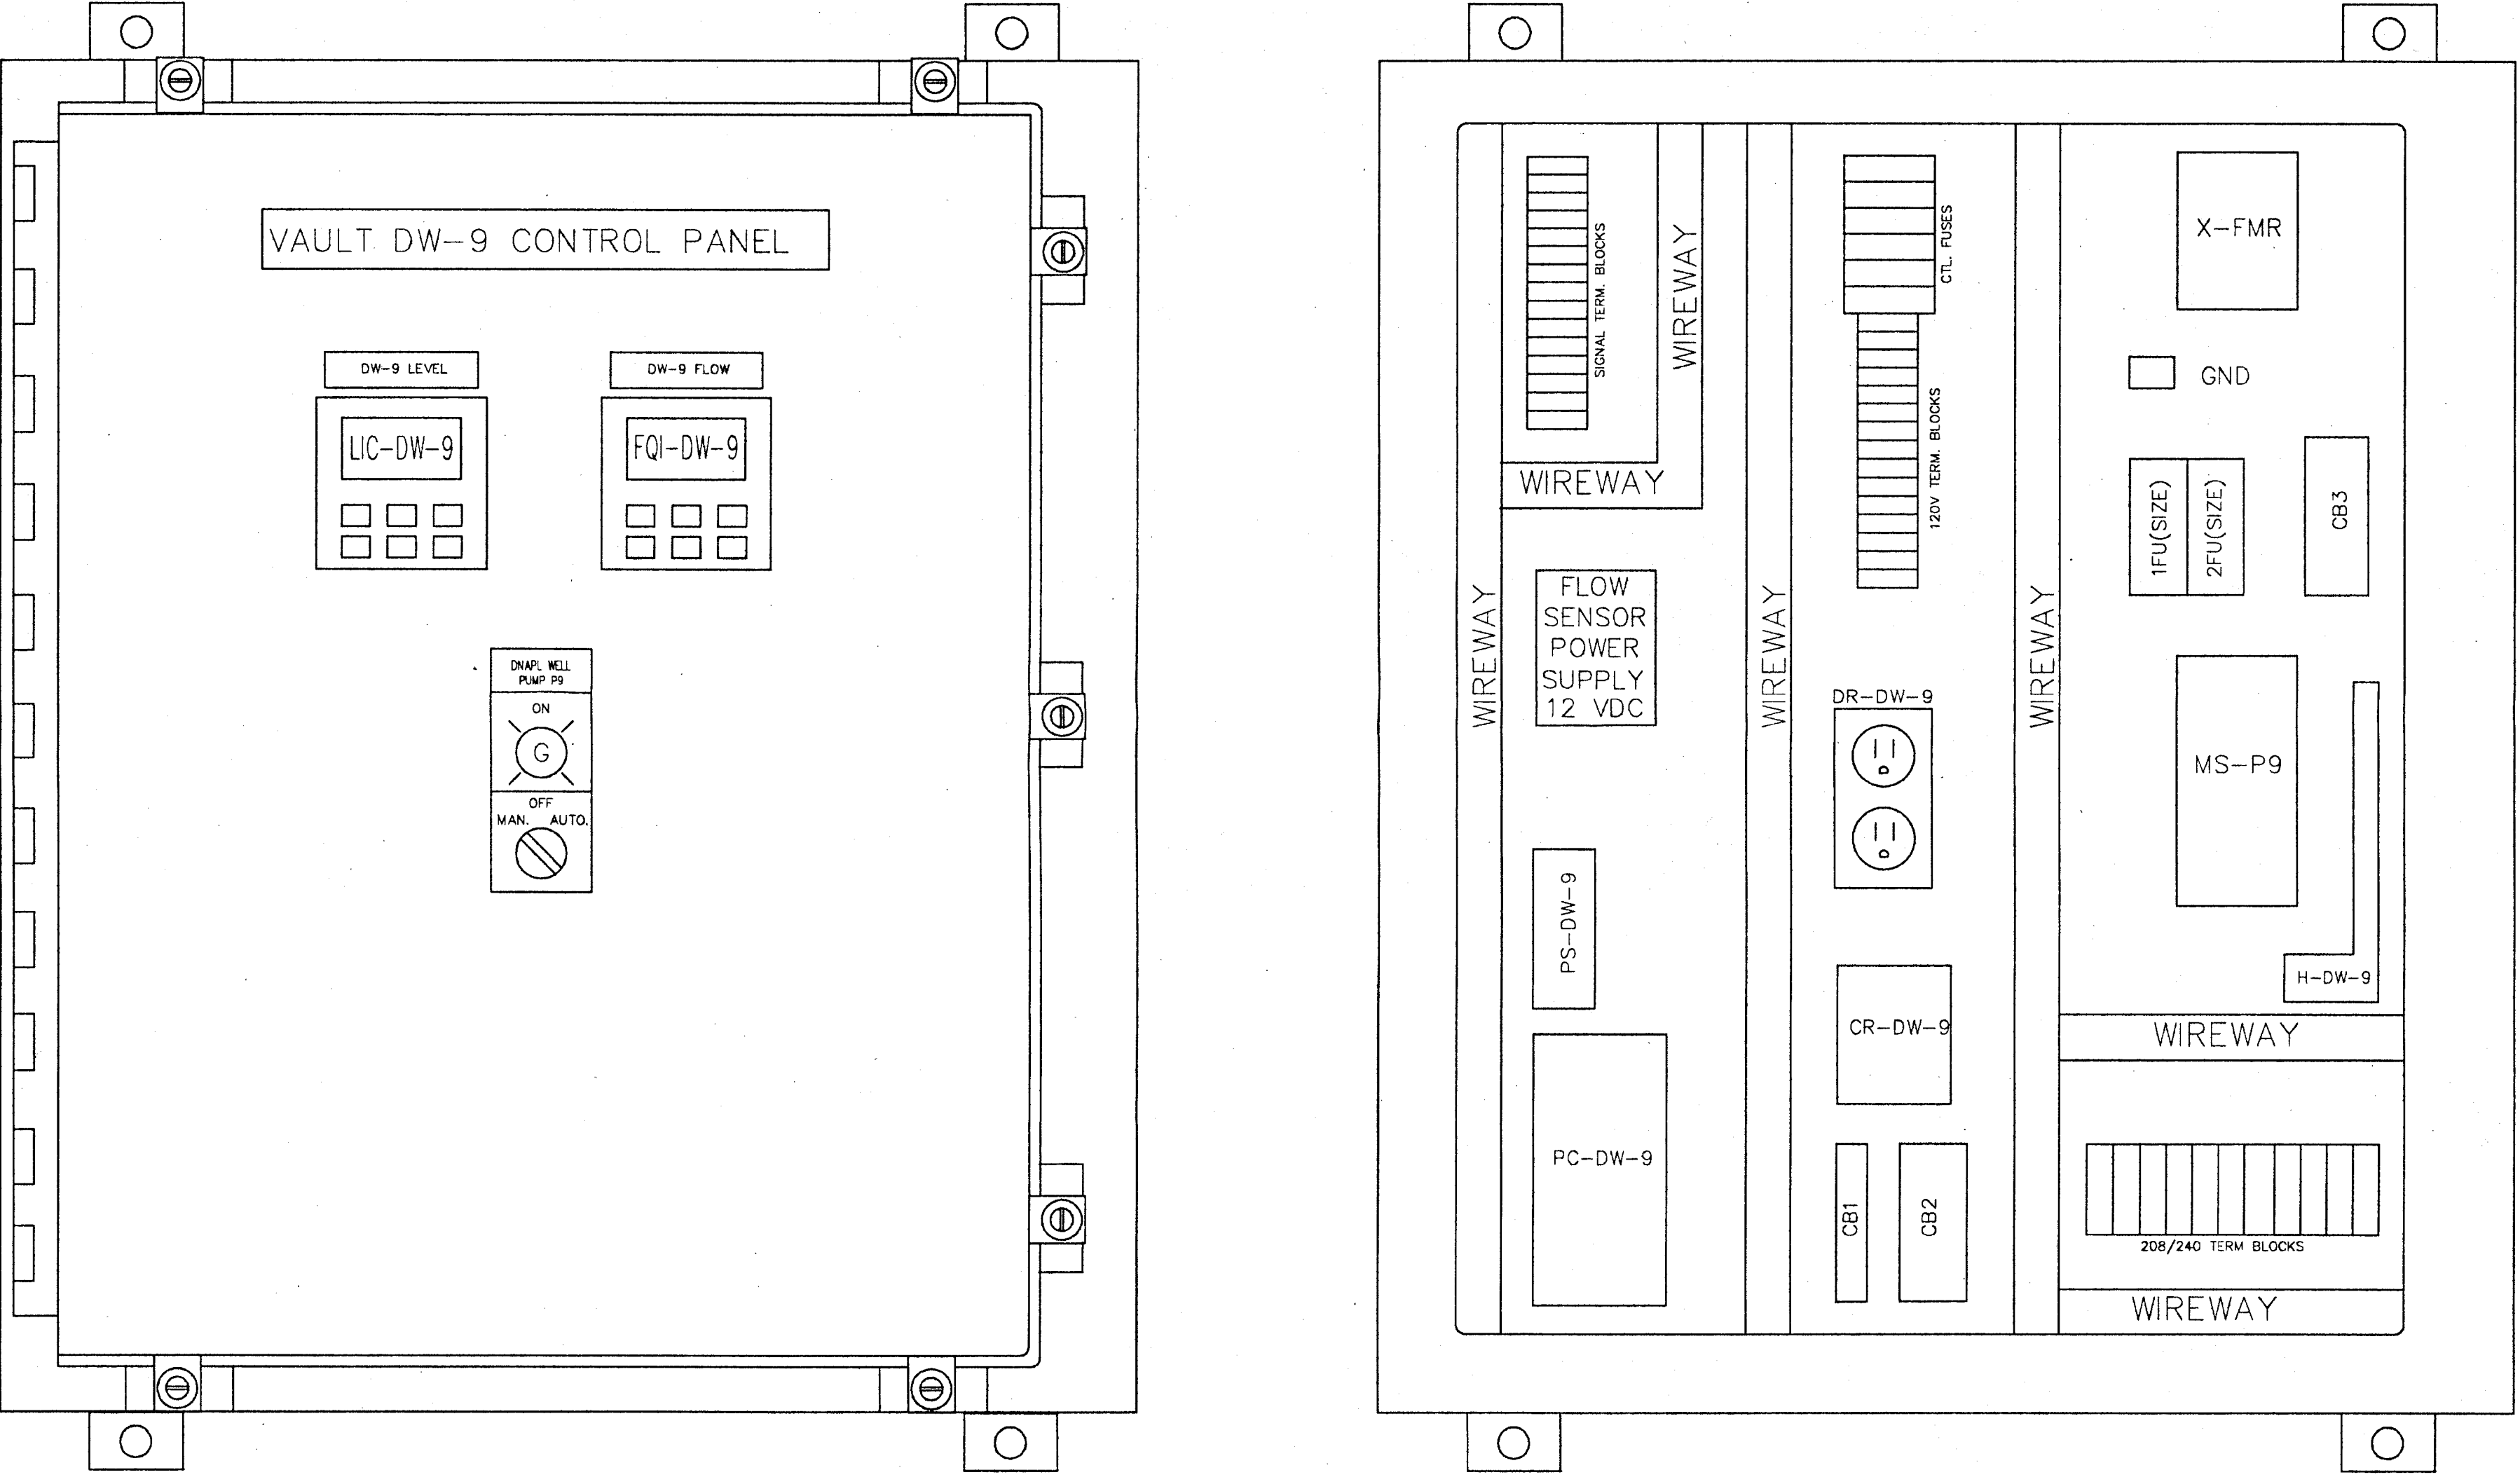


VAULT DW-9 CONTROL PANEL

SIZE: 30" X 24" X 8"

						FILE NAME: 0273e014		0273	
						Treatek - CRA TM COMPANY			
						BELL AEROSPACE TEXTRON GROUNDWATER TREATMENT PLANT			
						VAULT DW-9 CONTROL PANEL LAYOUT			
						SCALE NONE		DWG. D-0273	
						SHT. 5			

THIS DRAWING INCLUDING THE INFORMATION, DATA AND DESIGN IS THE PROPERTY OF TREATEK - CRA. IT IS NOT TO BE COPIED, REPRODUCED OR ITS CONTENTS DIVULGED WITHOUT THE WRITTEN PERMISSION OF TREATEK - CRA.

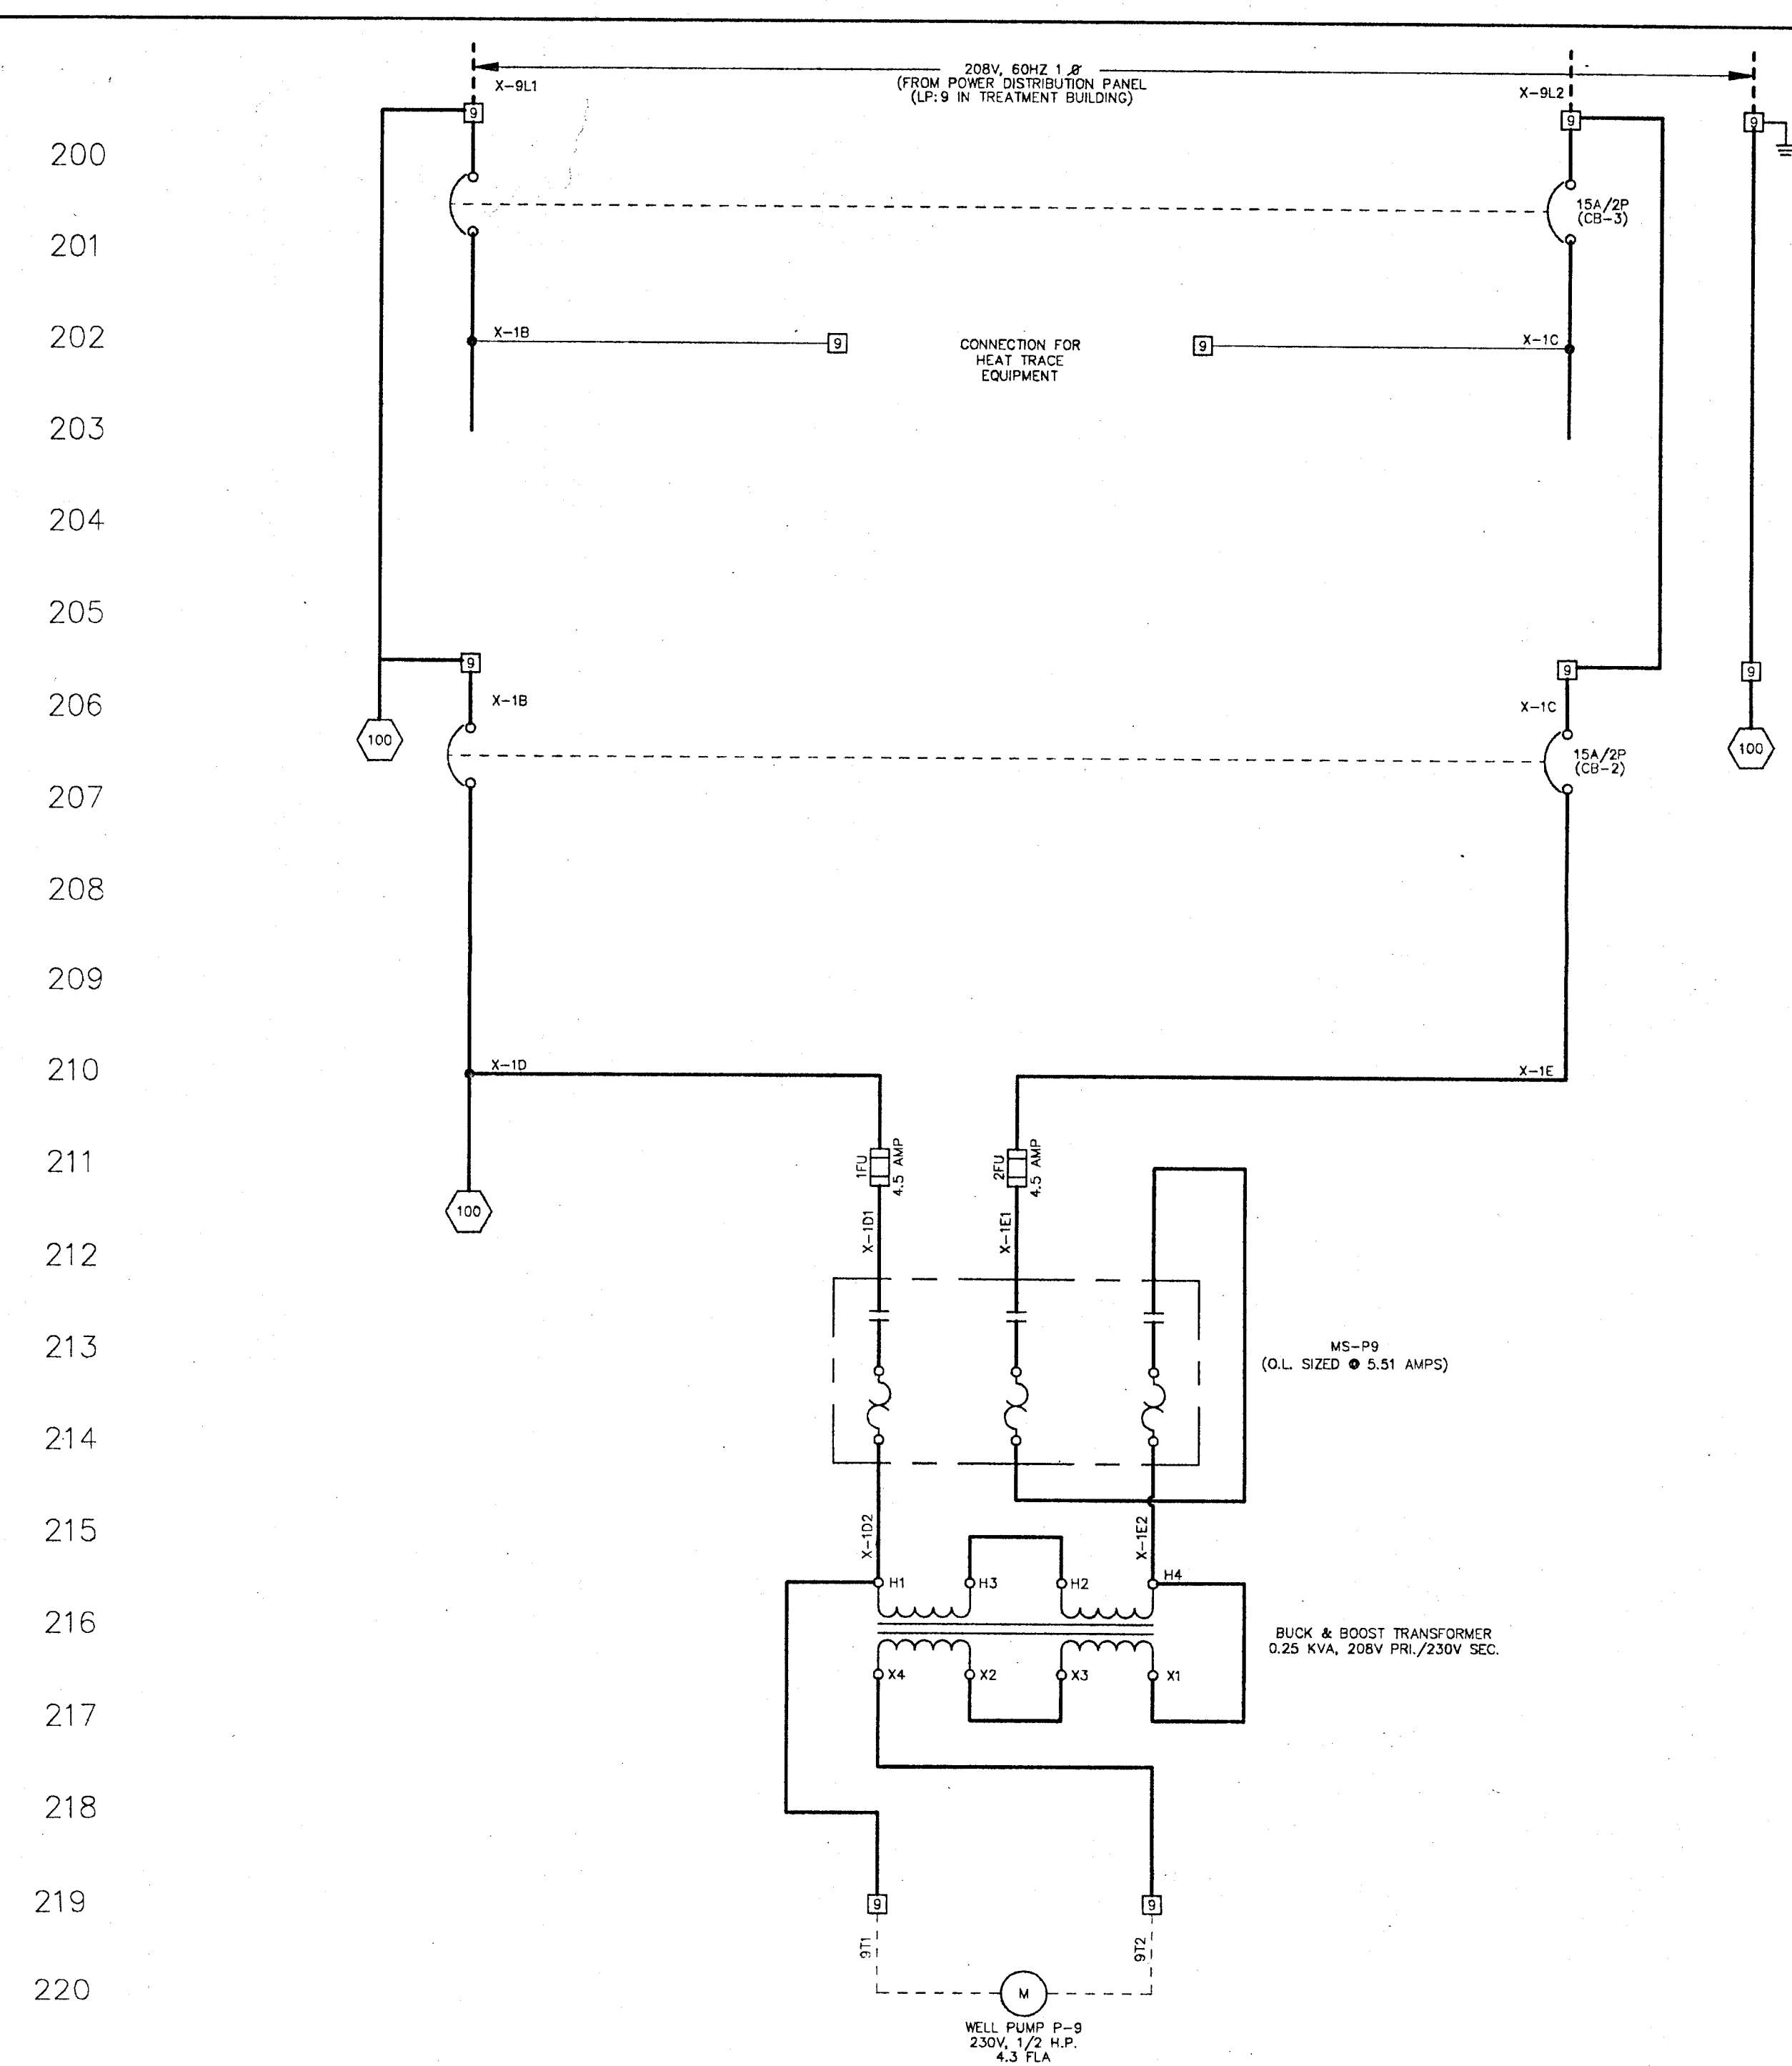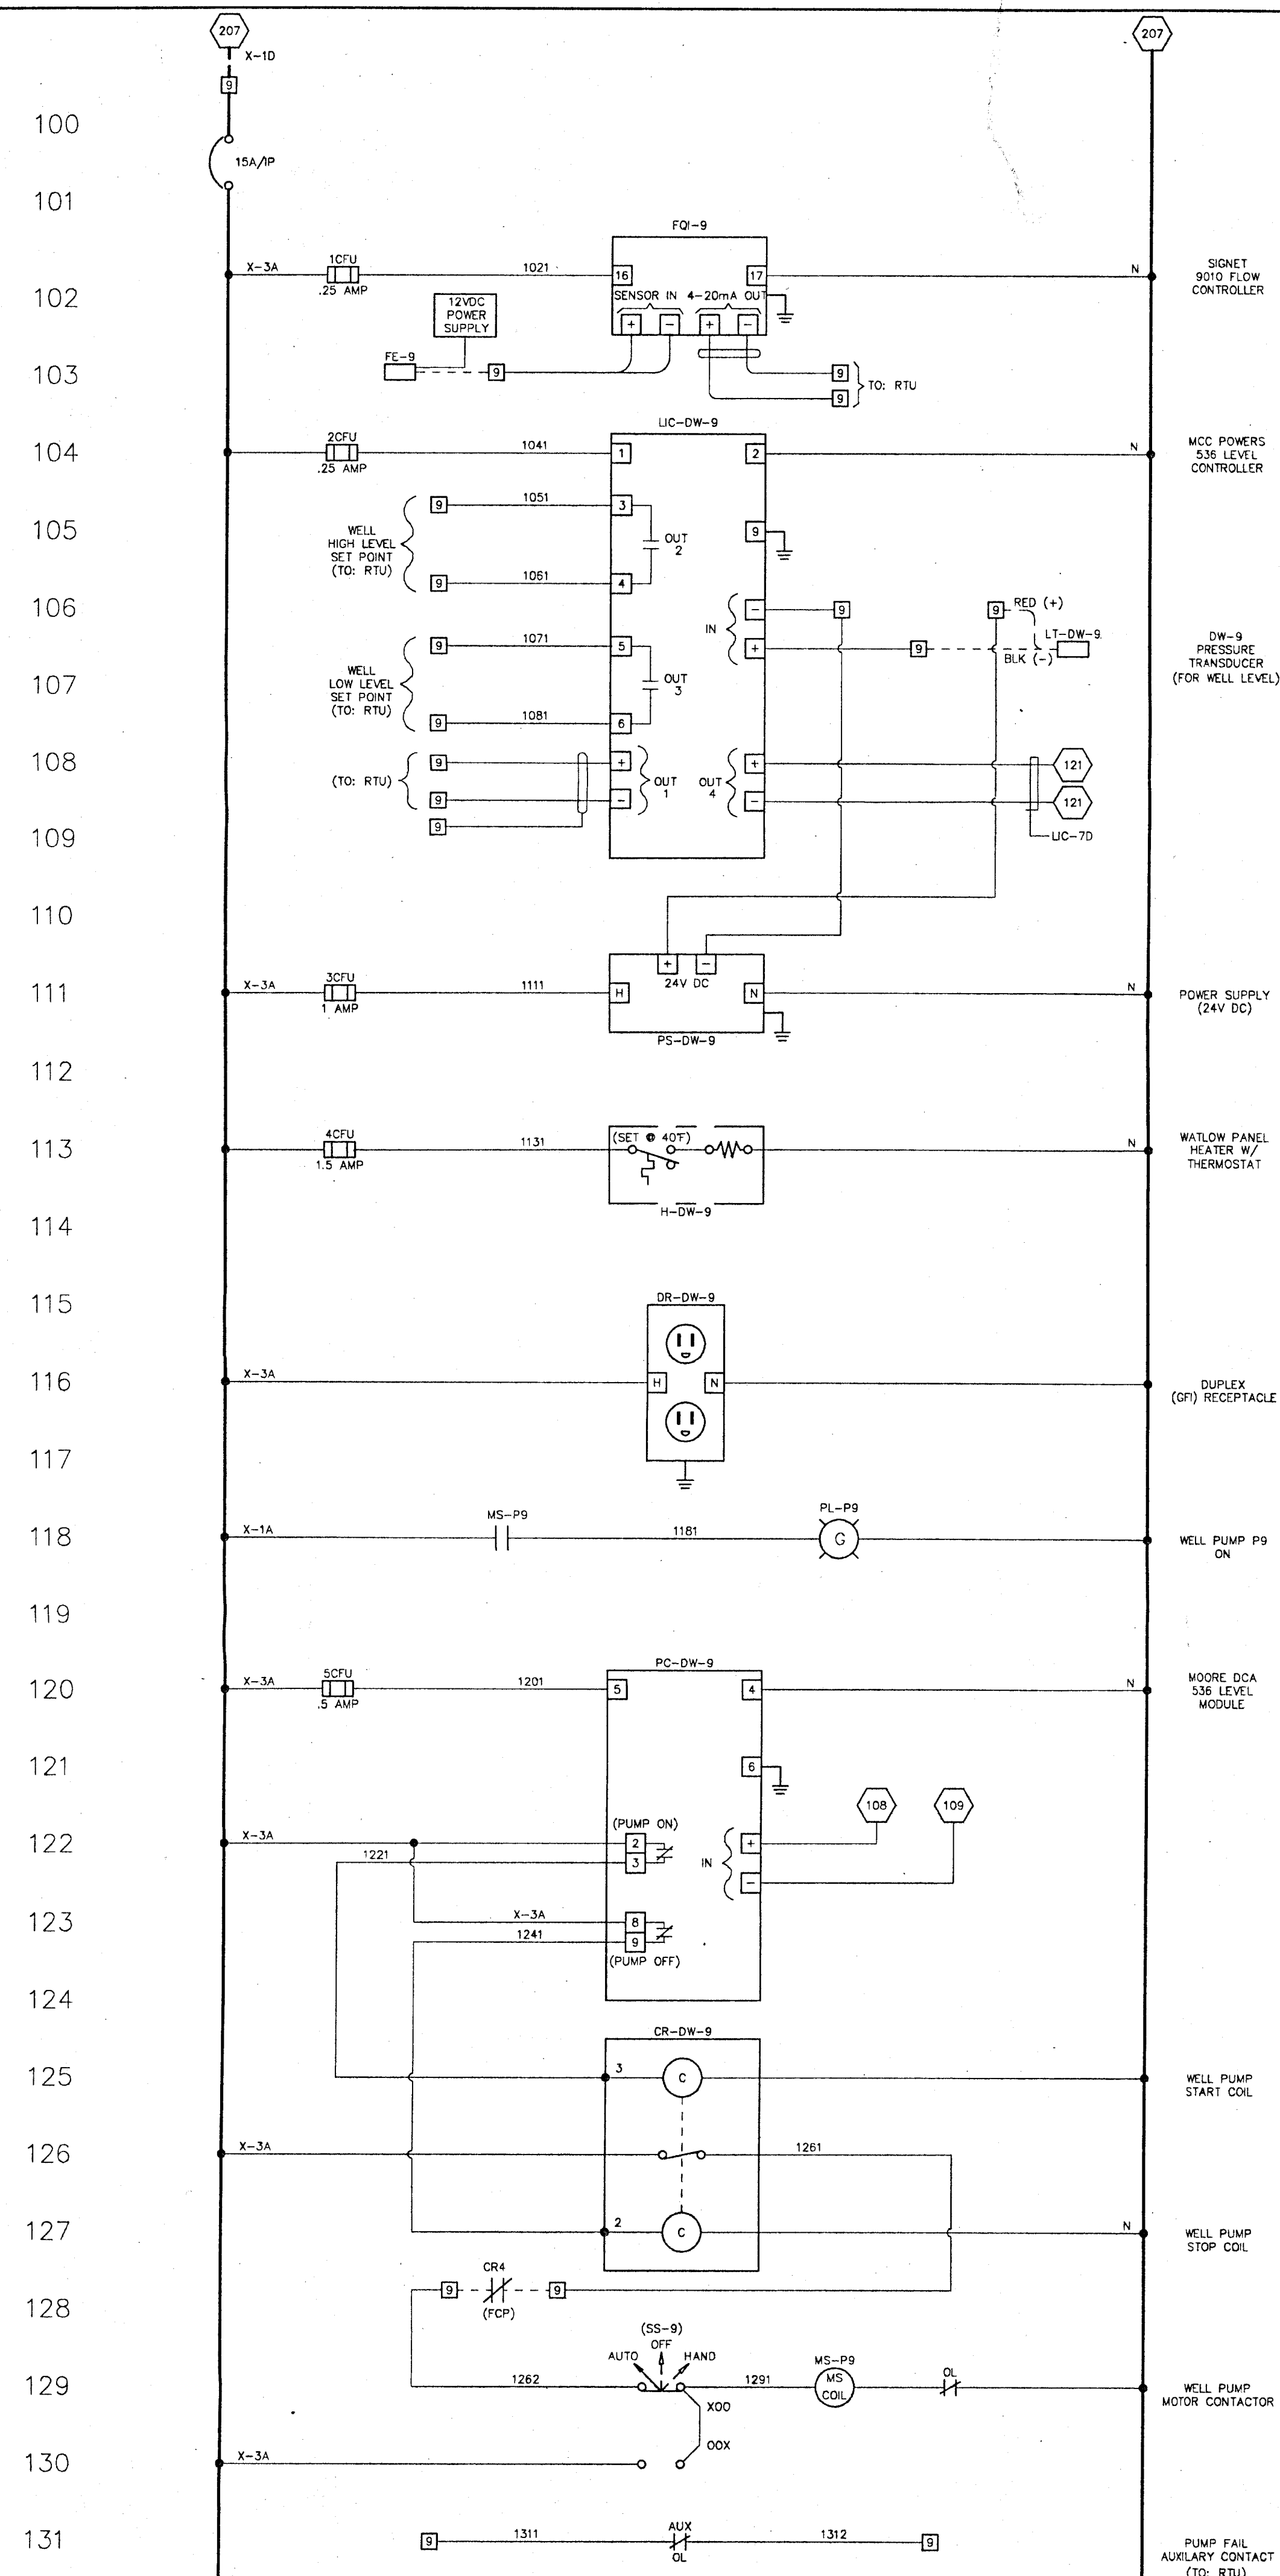


(DW-9) VAULT PANEL SCHEMATIC

KEY:

- 9** . TERMINAL BLOCK LOCATED IN PANEL FOR
 INSTALLING CONTRACTOR CONNECTION
 ————— INDICATES WIRING INTERNAL TO PANEL
 - - - - - INDICATES WIRING EXTERNAL TO PANEL


					FILE NAME: 0273e003			0273	
									
5	AS BUILT	BAB			11-16-94	STR. AND CIVIL MECHANICAL			
4	GENERAL REVISION	BAB			4-6-94	ELECT. & INST.	JMF	JMF	1-7-94
3	CERTIFIED FOR CONSTRUCTION	BAB			1-10-94	PROCESS			
2	SUBMITTAL REVIEW REVISION	BAB			1-7-94	PROJECT	ACY		1-7-94
1	GENERAL REVISION	JMF			11/22/93	DRAWN BY B.A. BEEBE		DATE	11-6-93
						DSGN. CAL BY J. FLEISCHMAN		DATE	11-1-93
						CHECKED BY B.A. BEEBE		DATE	1-7-94
NO.	REVISIONS	DRAWN	CHKD.	APP.	DATE				
SCALE NONE DWG. D-0273 SHT. 6									

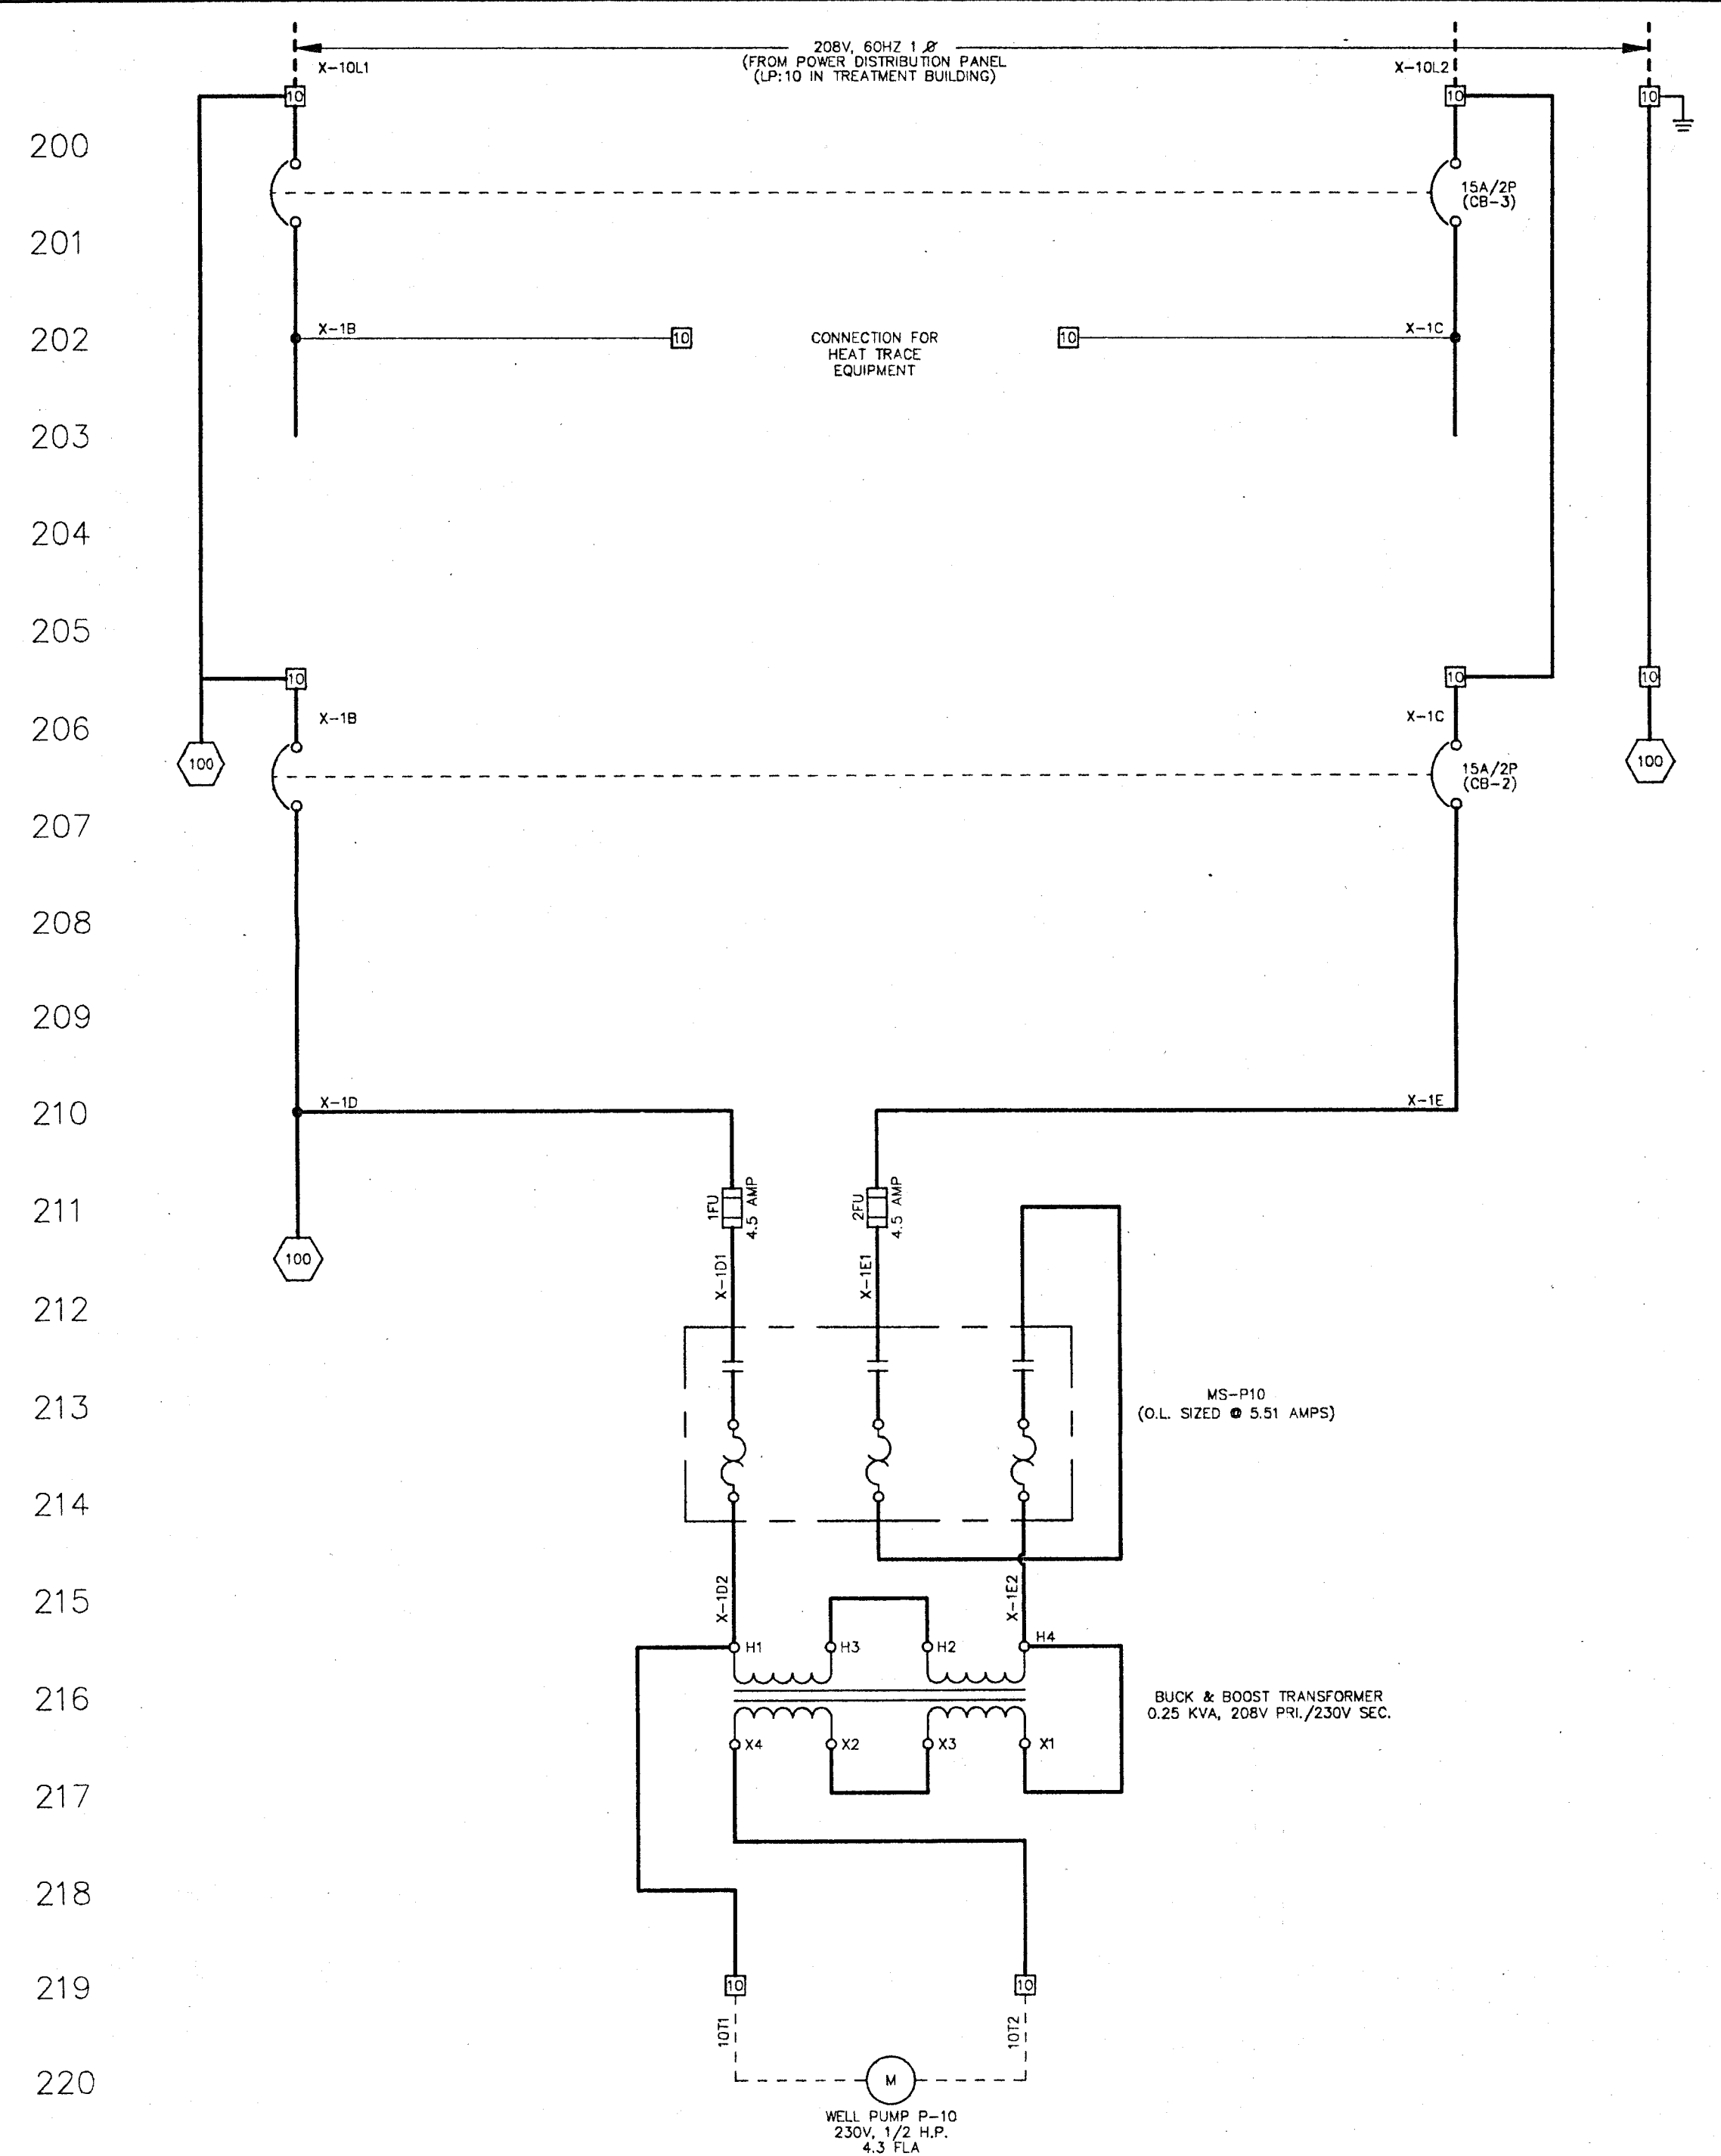

KEY:

	TERMINAL BLOCK LOCATED IN PANEL FOR INSTALLING CONTRACTOR CONNECTION
—————	INDICATES WIRING INTERNAL TO PANEL
— — — —	INDICATES WIRING EXTERNAL TO PANEL



THIS DRAWING INCLUDING THE INFORMATION, DATA AND DESIGN IS THE PROPERTY OF TREATEK - CRA. IT IS NOT TO BE COPIED, REPRODUCED OR ITS CONTENTS DIVULGED WITHOUT THE WRITTEN PERMISSION OF TREATEK - CRA.

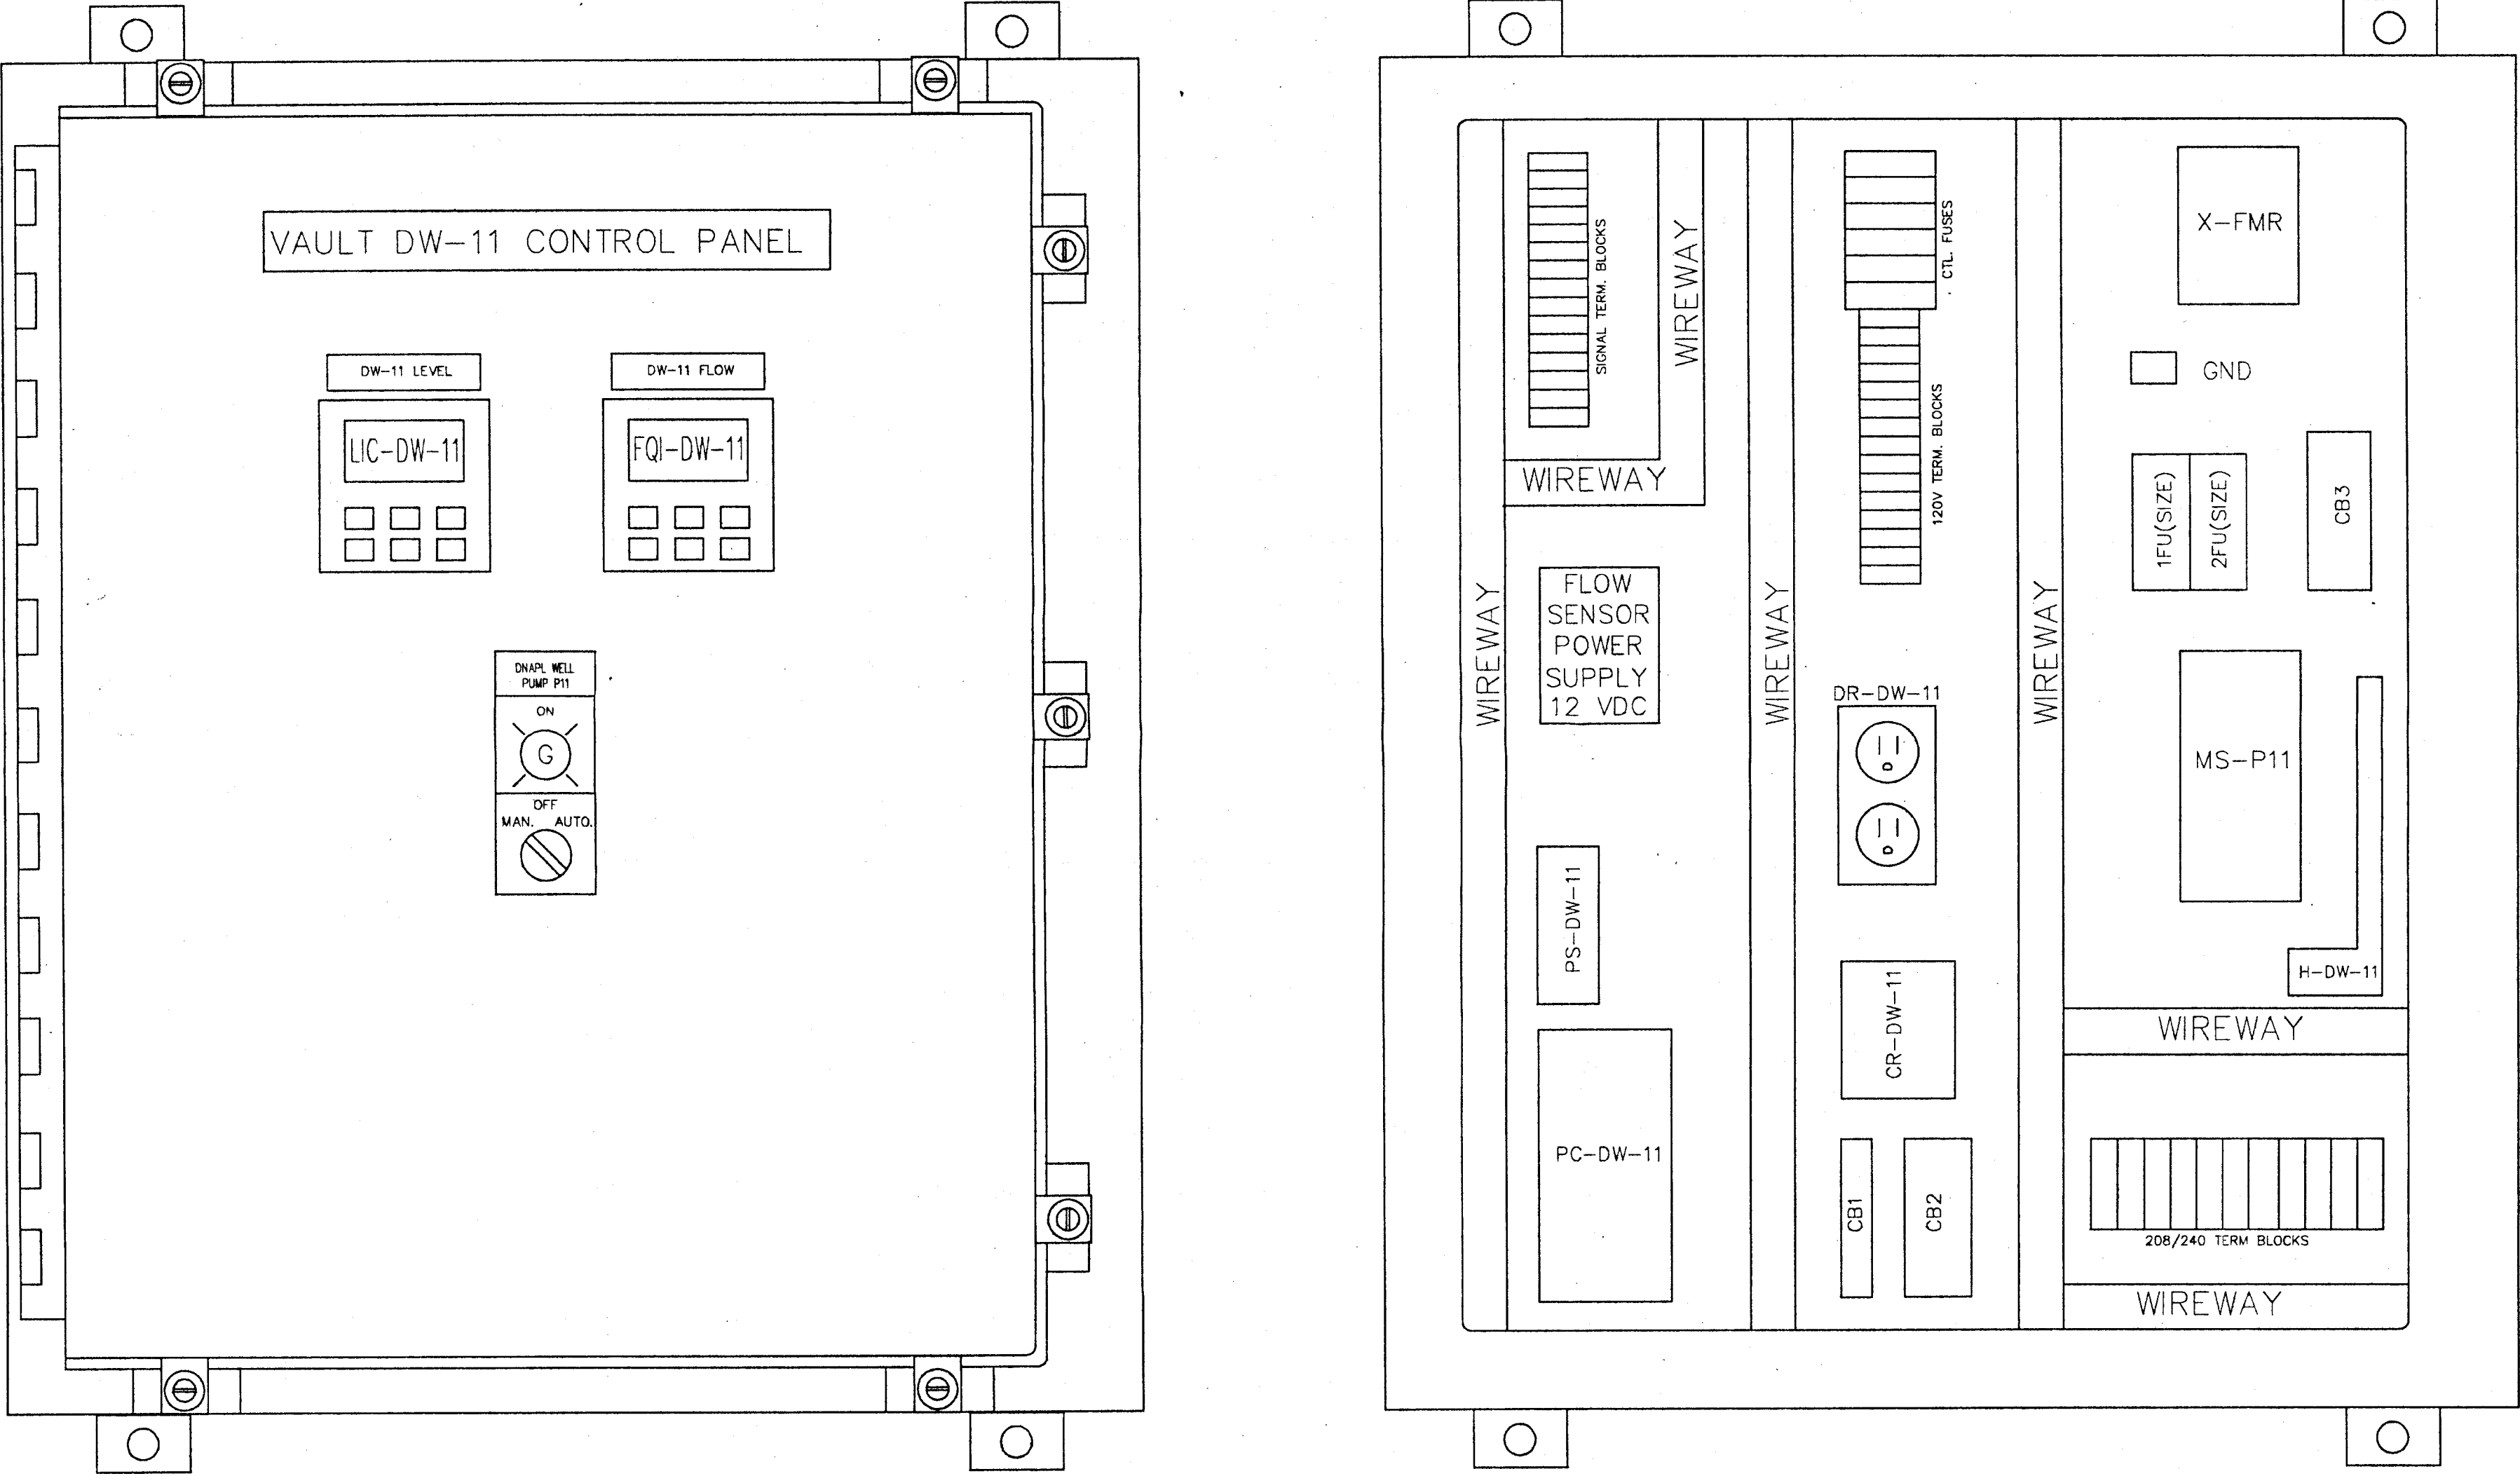

VAULT DW-11 CONTROL PANEL
SIZE: 30" X 24" X 8"

								FILE NAME: 0273e016		0273
								TreatTek - CRA TM COMPANY		
								BELL AEROSPACE TEXTRON GROUNDWATER TREATMENT PLANT VAULT DW-11 CONTROL PANEL LAYOUT		
								SCALE NONE		DWG. D-0273 SHT. 9
THIS DRAWING INCLUDING THE INFORMATION, DATA AND DESIGN IS THE PROPERTY OF TREATEK - CRA. IT IS NOT TO BE COPIED, REPRODUCED OR ITS CONTENTS DIVULGED WITHOUT THE WRITTEN PERMISSION OF TREATEK - CRA.										

						APPROVAL	MANAGER	ENGR.	DATE
						STR. AND CIVIL MECHANICAL			
						ELECT. & INST. PROCESS	JMF	JMF	1-7-94
						PROJECT	ACY		1-7-94
2	AS BUILT		BAB		11-16-94	DRAWN BY	J. FLEISCHMAN	DATE	11-5-93
1	CERTIFIED FOR CONSTRUCTION		BAB		1-10-94	DSGN. CAL. BY	J. FLEISCHMAN	DATE	11-1-93
NO.	REVISIONS		DRAWN	CHKD.	APP.	DATE	CHECKED BY	B.A. BEEBE	DATE 1-7-94

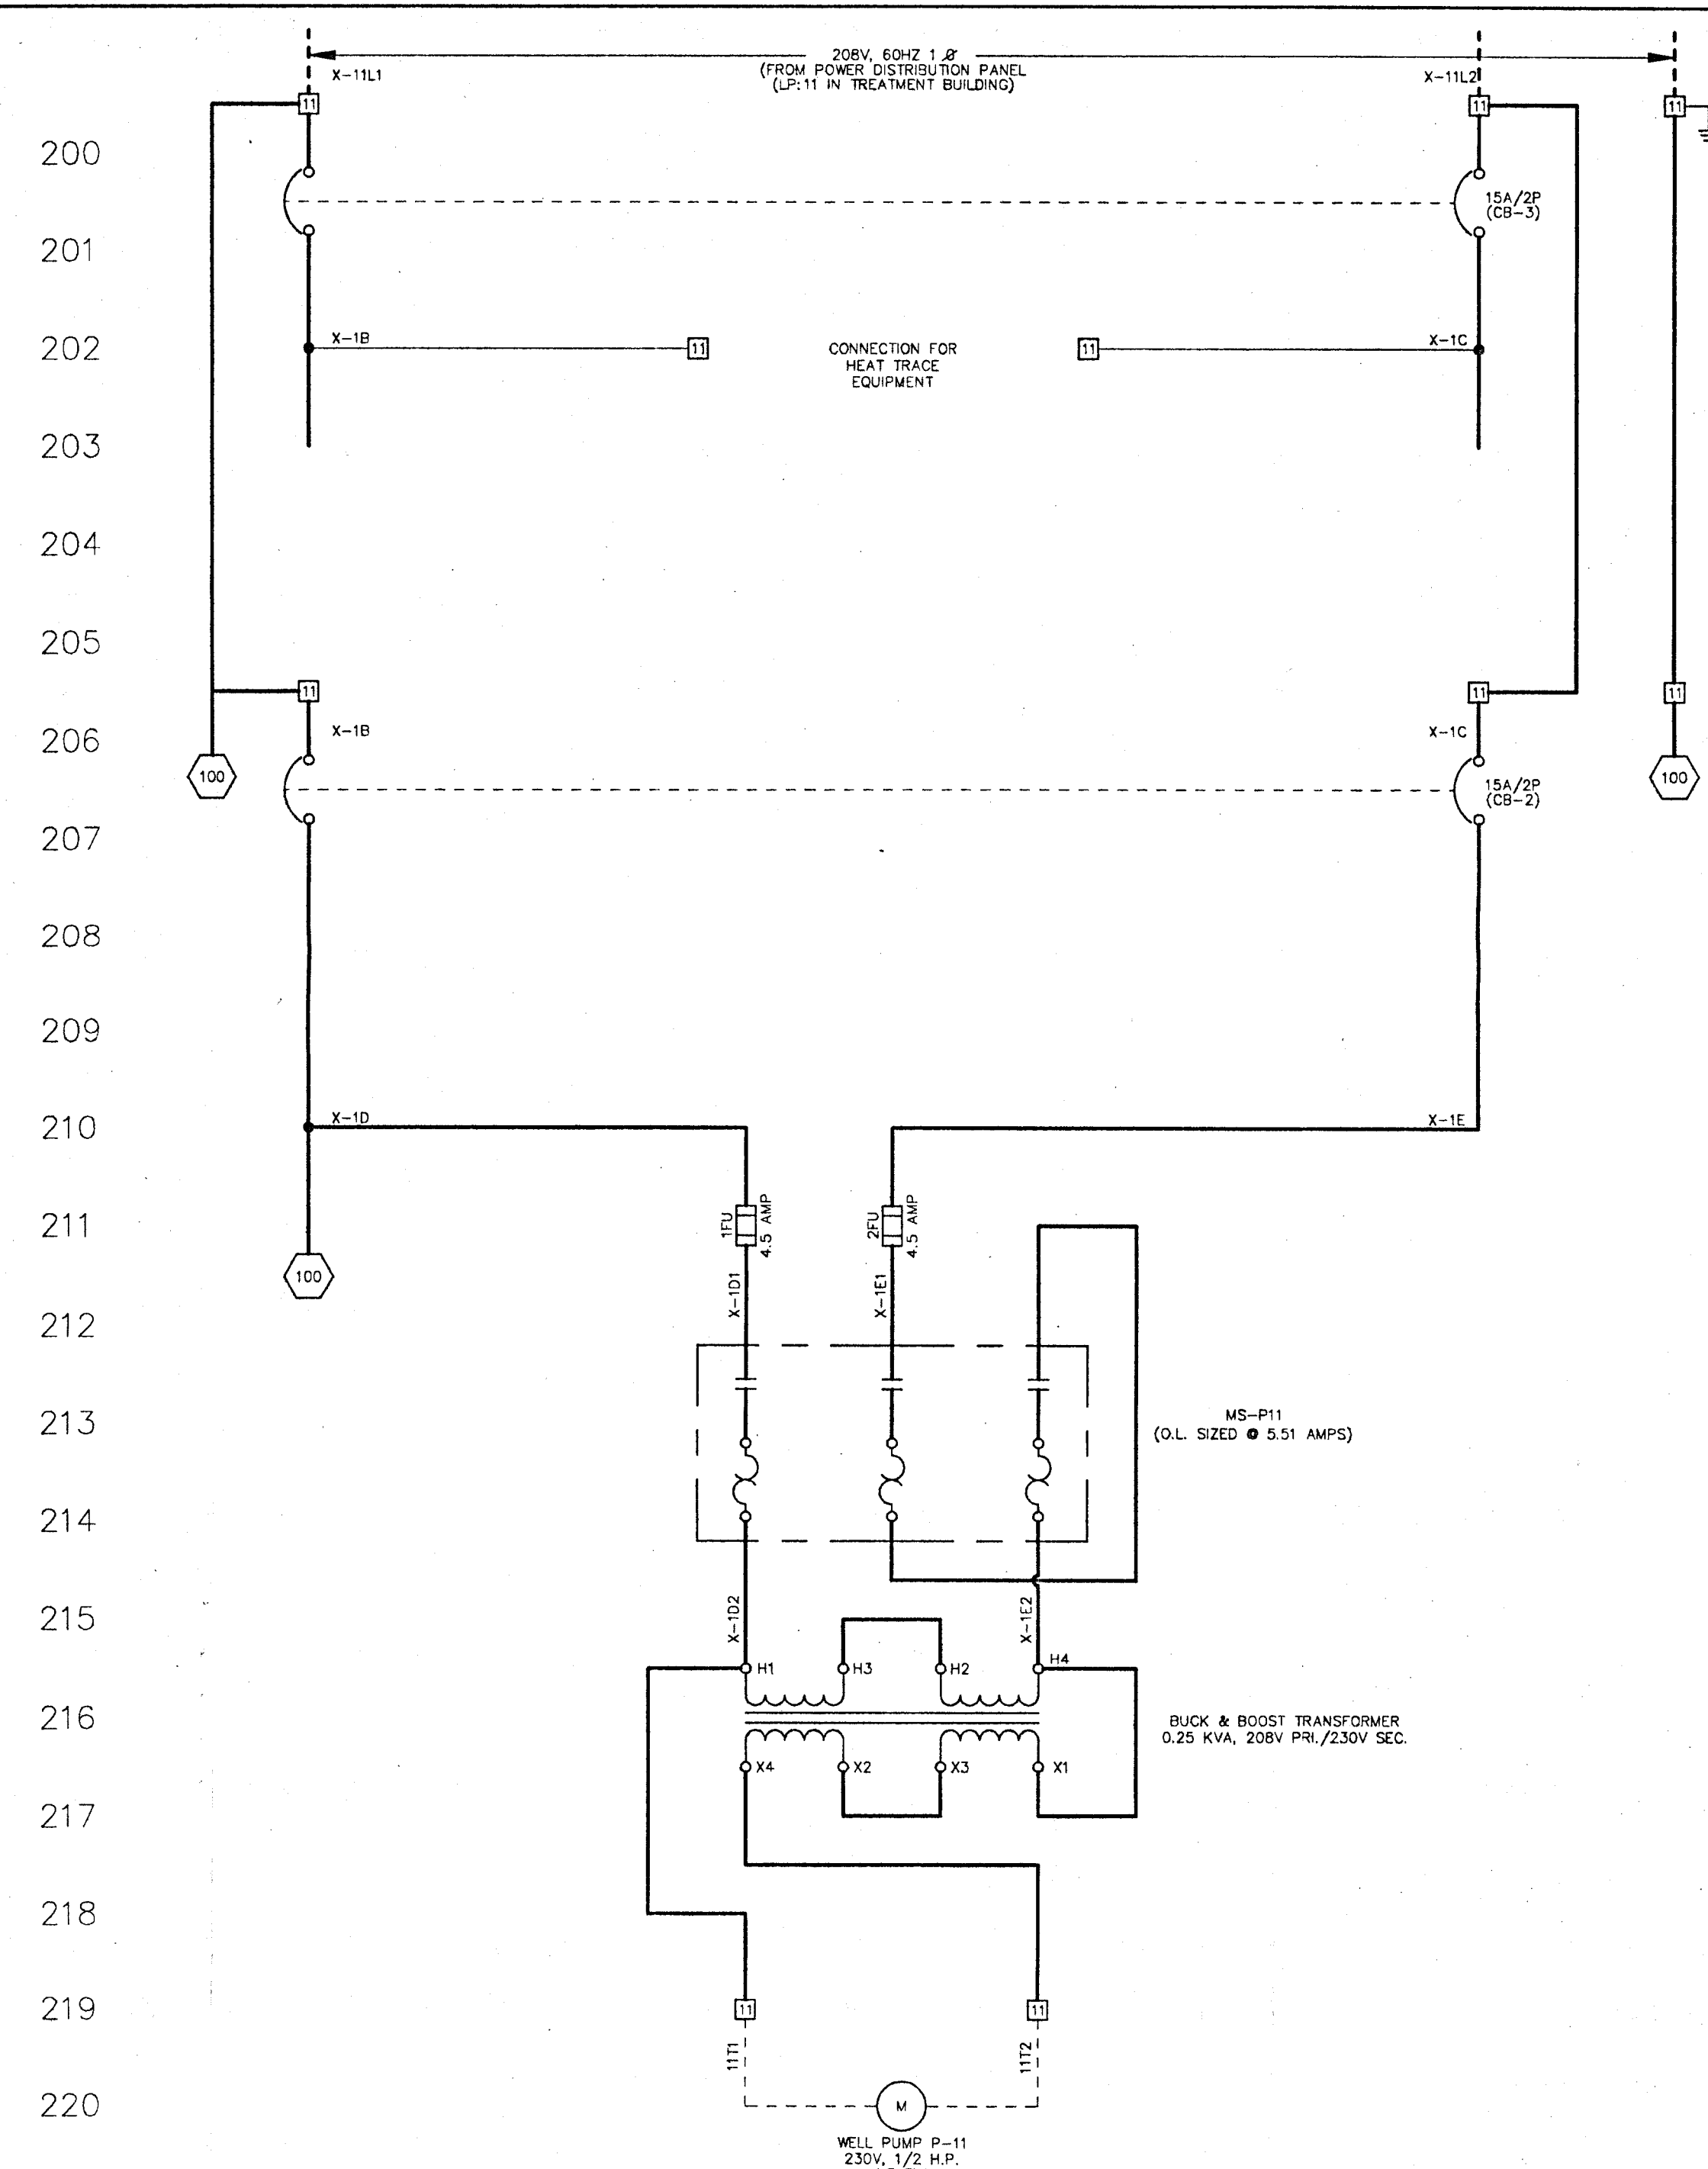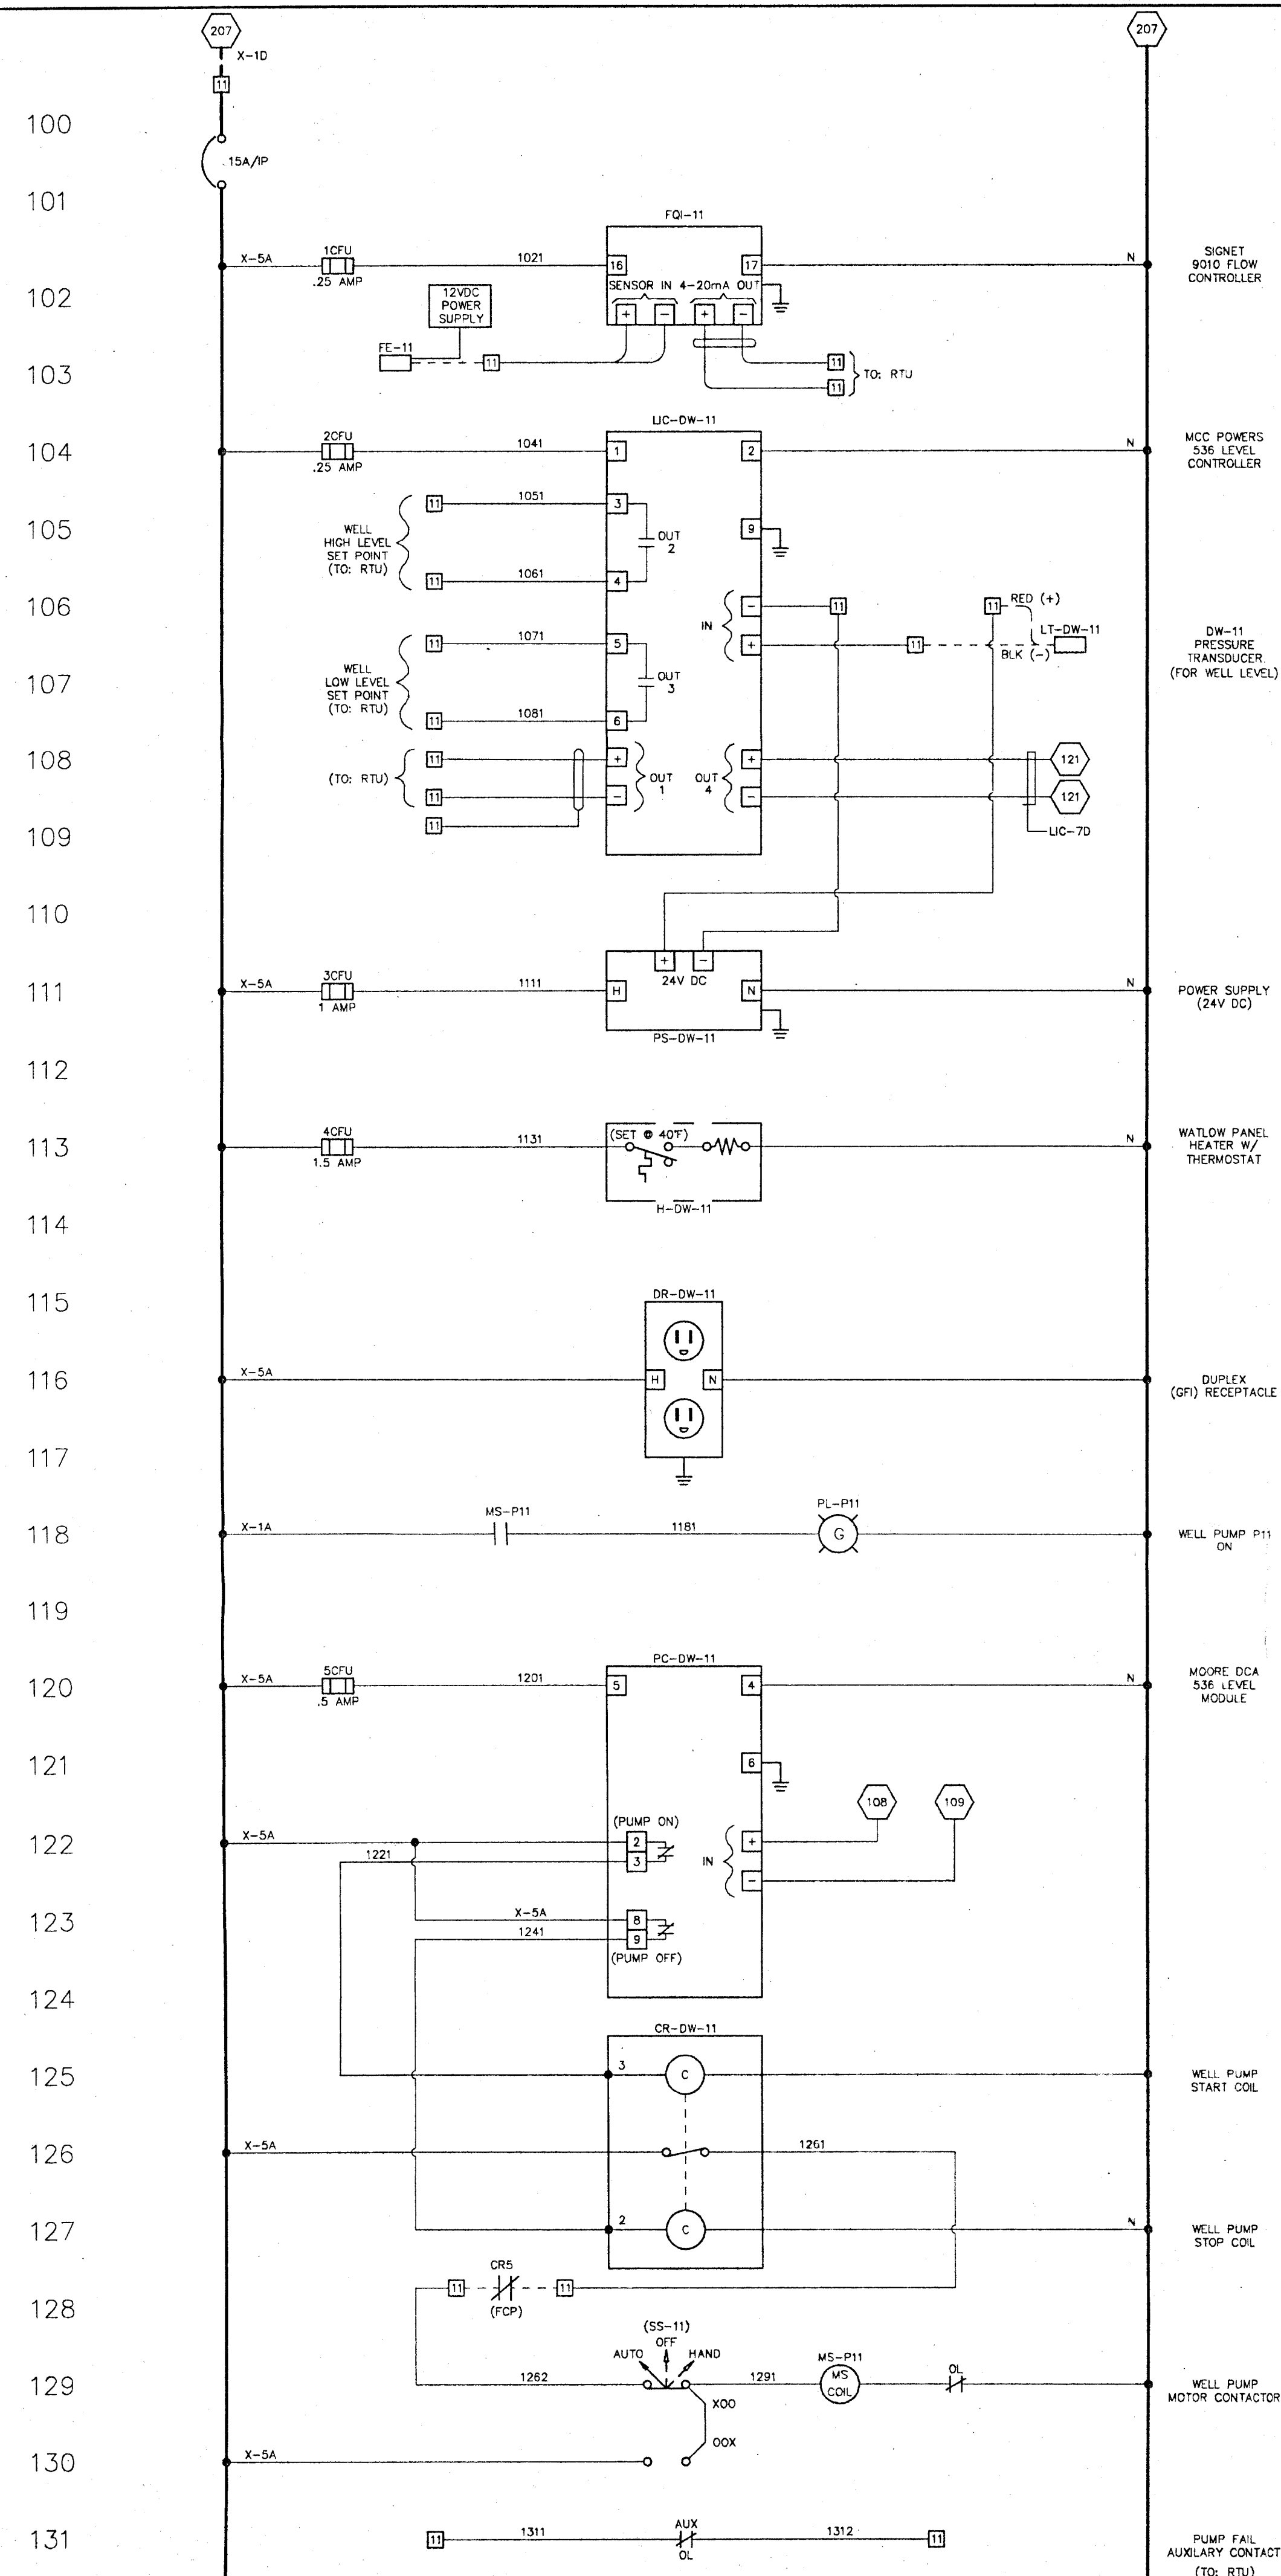


(DW-11) VAULT PANEL SCHEMATIC

KEY:

- 11** TERMINAL BLOCK LOCATED IN PANEL FOR
INSTALLING CONTRACTOR CONNECTION
- INDICATES WIRING INTERNAL TO PANEL
- — — — — INDICATES WIRING EXTERNAL TO PANEL

				FILE NAME: 02736005			0273		
									
5	AS BUILT	BAB		11-16-94	STR. AND CIVIL MECHANICAL	MANAGER	ENGR.	DATE	
4	GENERAL REVISION	BAB		4-6-94	ELECT. & INST.	JMF	JMF	1-7-94	
3	CERTIFIED FOR CONSTRUCTION	BAB		1-10-94	PROCESS				
2	SUBMITTAL REVIEW REVISION	BAB		1-7-94	PROJECT	ACY		1-7-94	
1	GENERAL REVISION	JMF		11/22/93	DRAWN BY B.A. BEEBE	DATE	11-5-93		
					DSGN. CAL BY J. FLEISCHMAN	DATE	11-1-93		
					CHECKED BY B.A. BEEBE	DATE	1-7-94		
NO.	REVISIONS	DRAWN	CHKD.	APP.	DATE	SCALE			NONE
						DWG. D-0273			SHT. 10


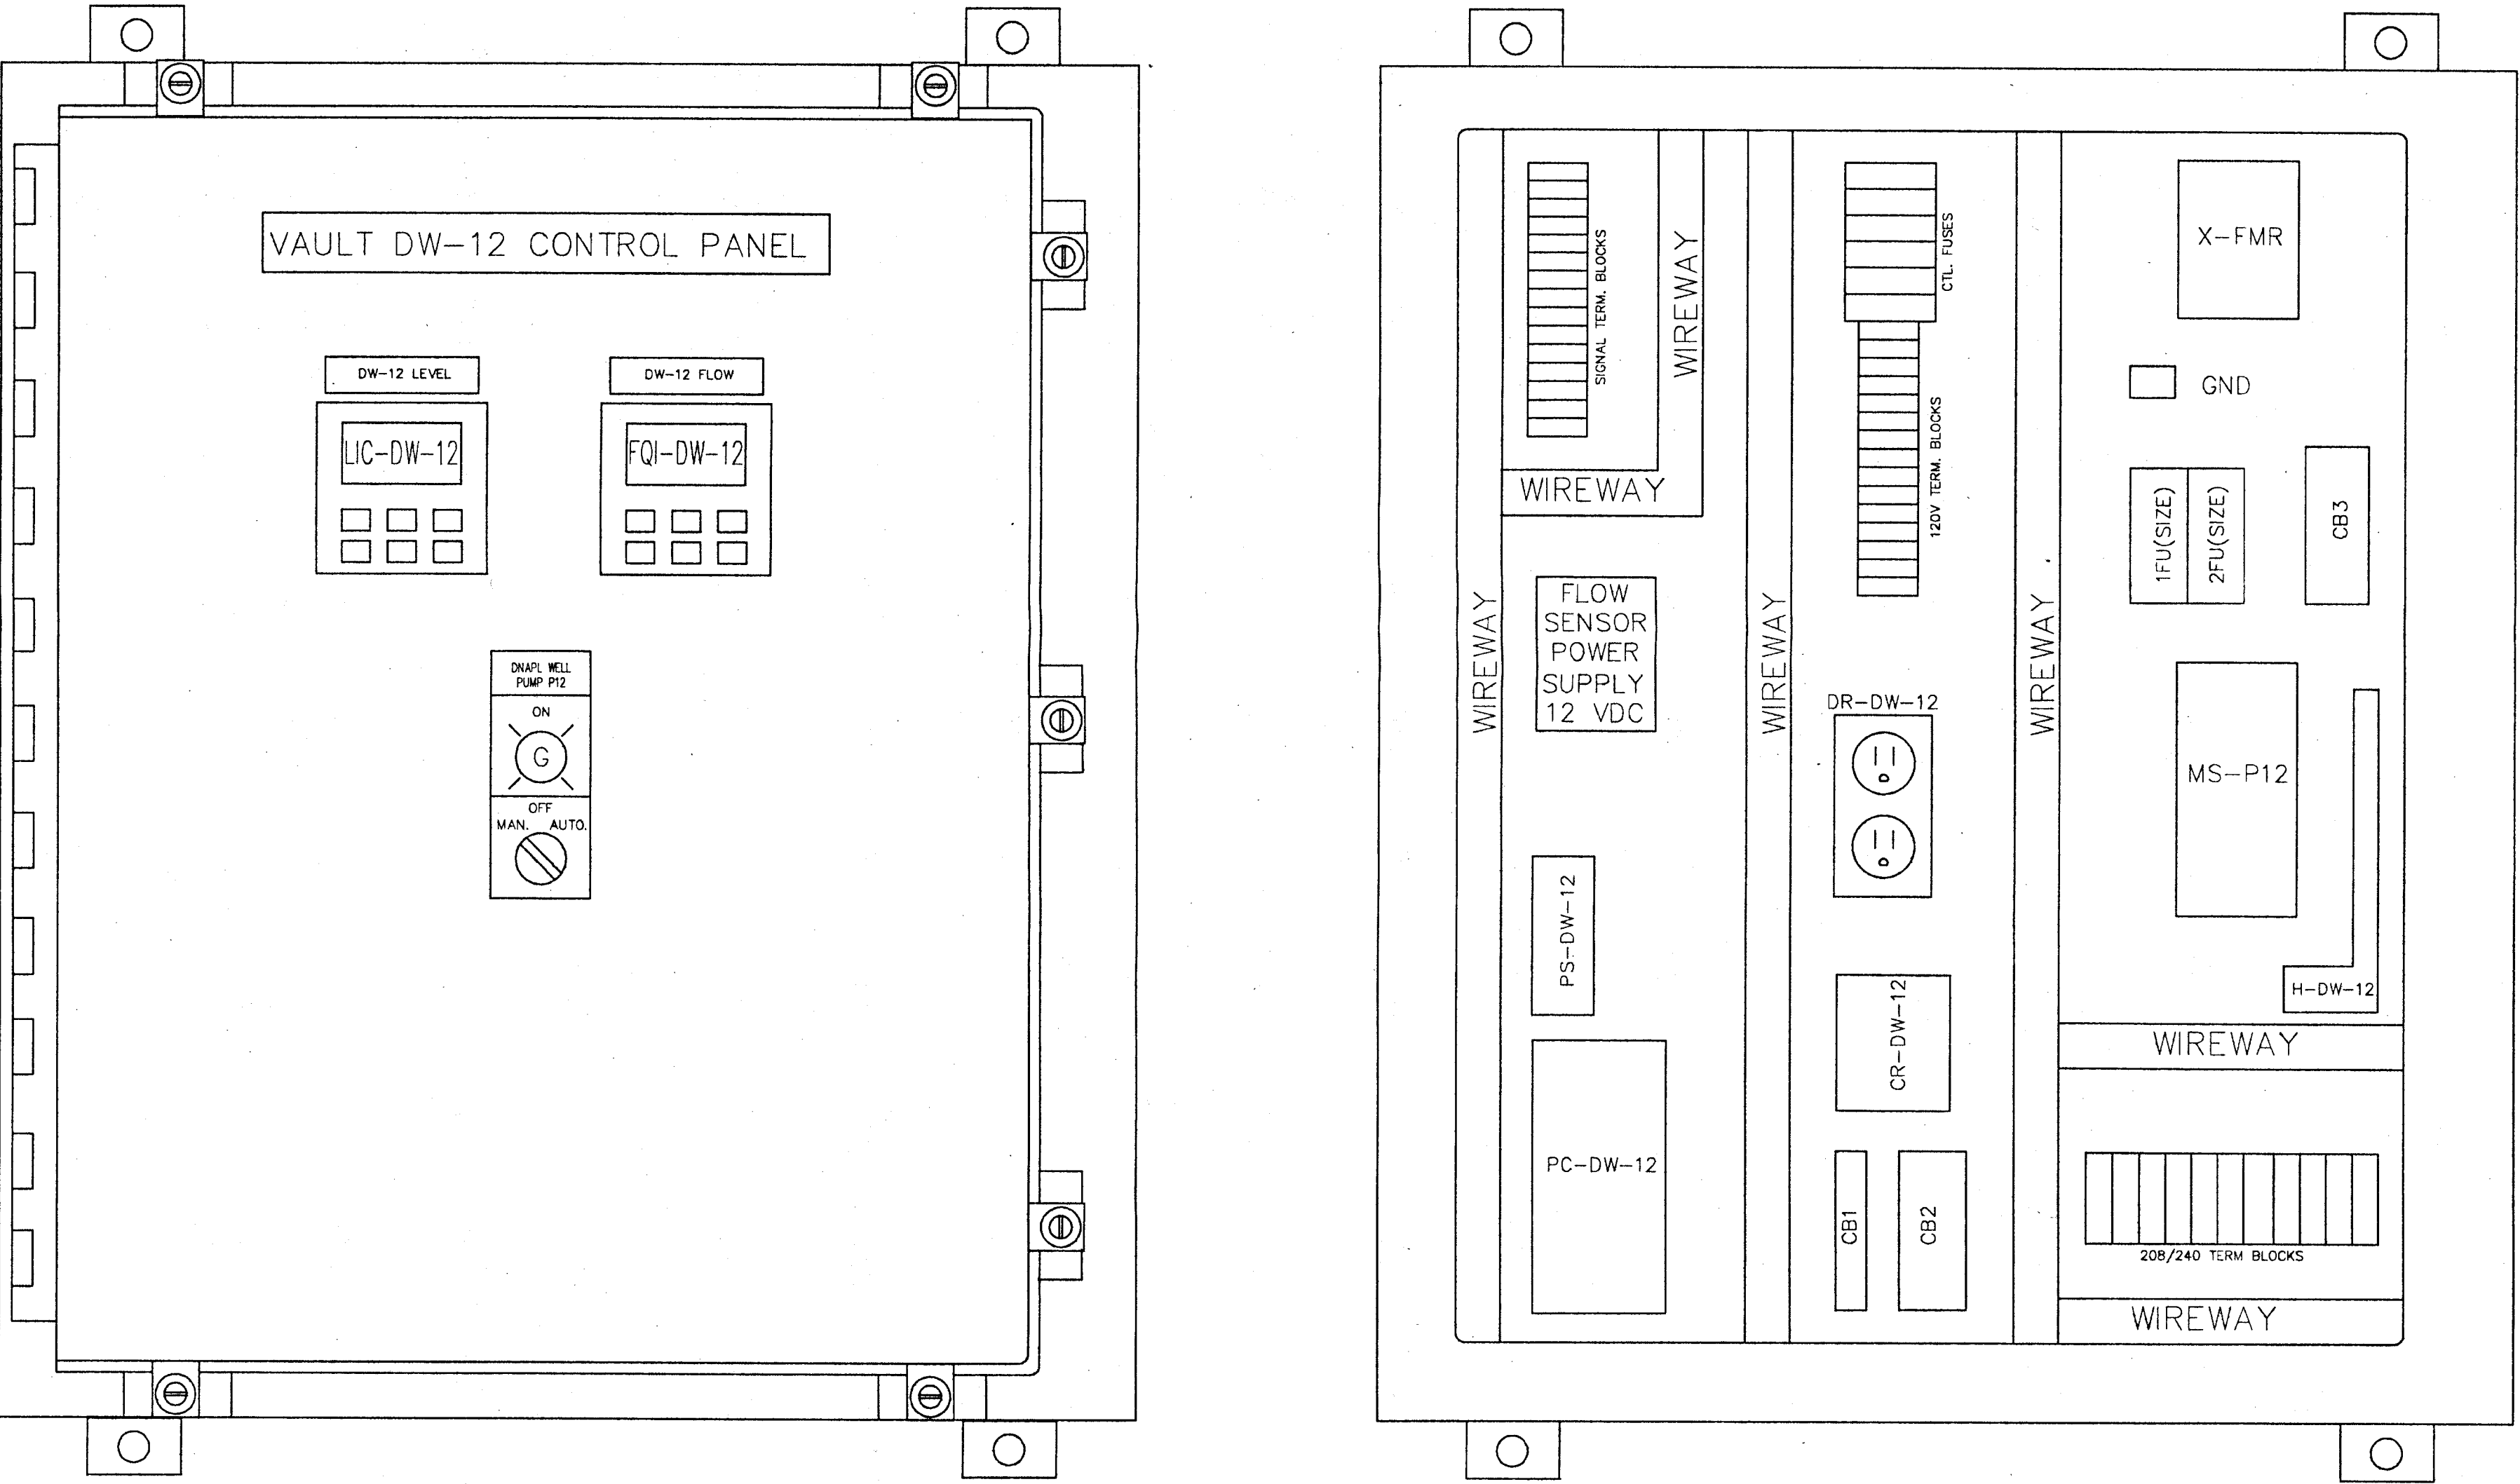


VAULT DW-12 CONTROL PANEL
SIZE: 30" X 24" X 8"

								FILE NAME: 0273e017		0273
								Treatek - CRA TM COMPANY		
								BELL AEROSPACE TEXTRON GROUNDWATER TREATMENT PLANT VAULT DW-12 CONTROL PANEL LAYOUT		
								SCALE NONE DWG. D-0273 SHT. 11		

2	AS BUILT	BAB			11-16-94	APPROVAL	MANAGER	ENGR.	DATE
	CERTIFIED FOR CONSTRUCTION	BAB			1-10-94	STR. AND CIVIL			
						MECHANICAL			
						ELECT. & INST.	JMF	JMF	1-7-94
1						PROCESS			
						PROJECT	ACY		1-7-94
						DRAWN BY	J. FLEISCHMAN	DATE	11-5-93
						DSGN. CAL. BY	J. FLEISCHMAN	DATE	11-1-93
NO.		REVISIONS	DRAWN	CHKD.	APP.	DATE	CHECKED BY	B.A. BEEBE	DATE 1-7-94

THIS DRAWING INCLUDING THE INFORMATION, DATA AND DESIGN IS THE PROPERTY OF TREATEK - CRA. IT IS NOT TO BE COPIED, REPRODUCED OR ITS CONTENTS DIVULGED WITHOUT THE WRITTEN PERMISSION OF TREATEK - CRA.

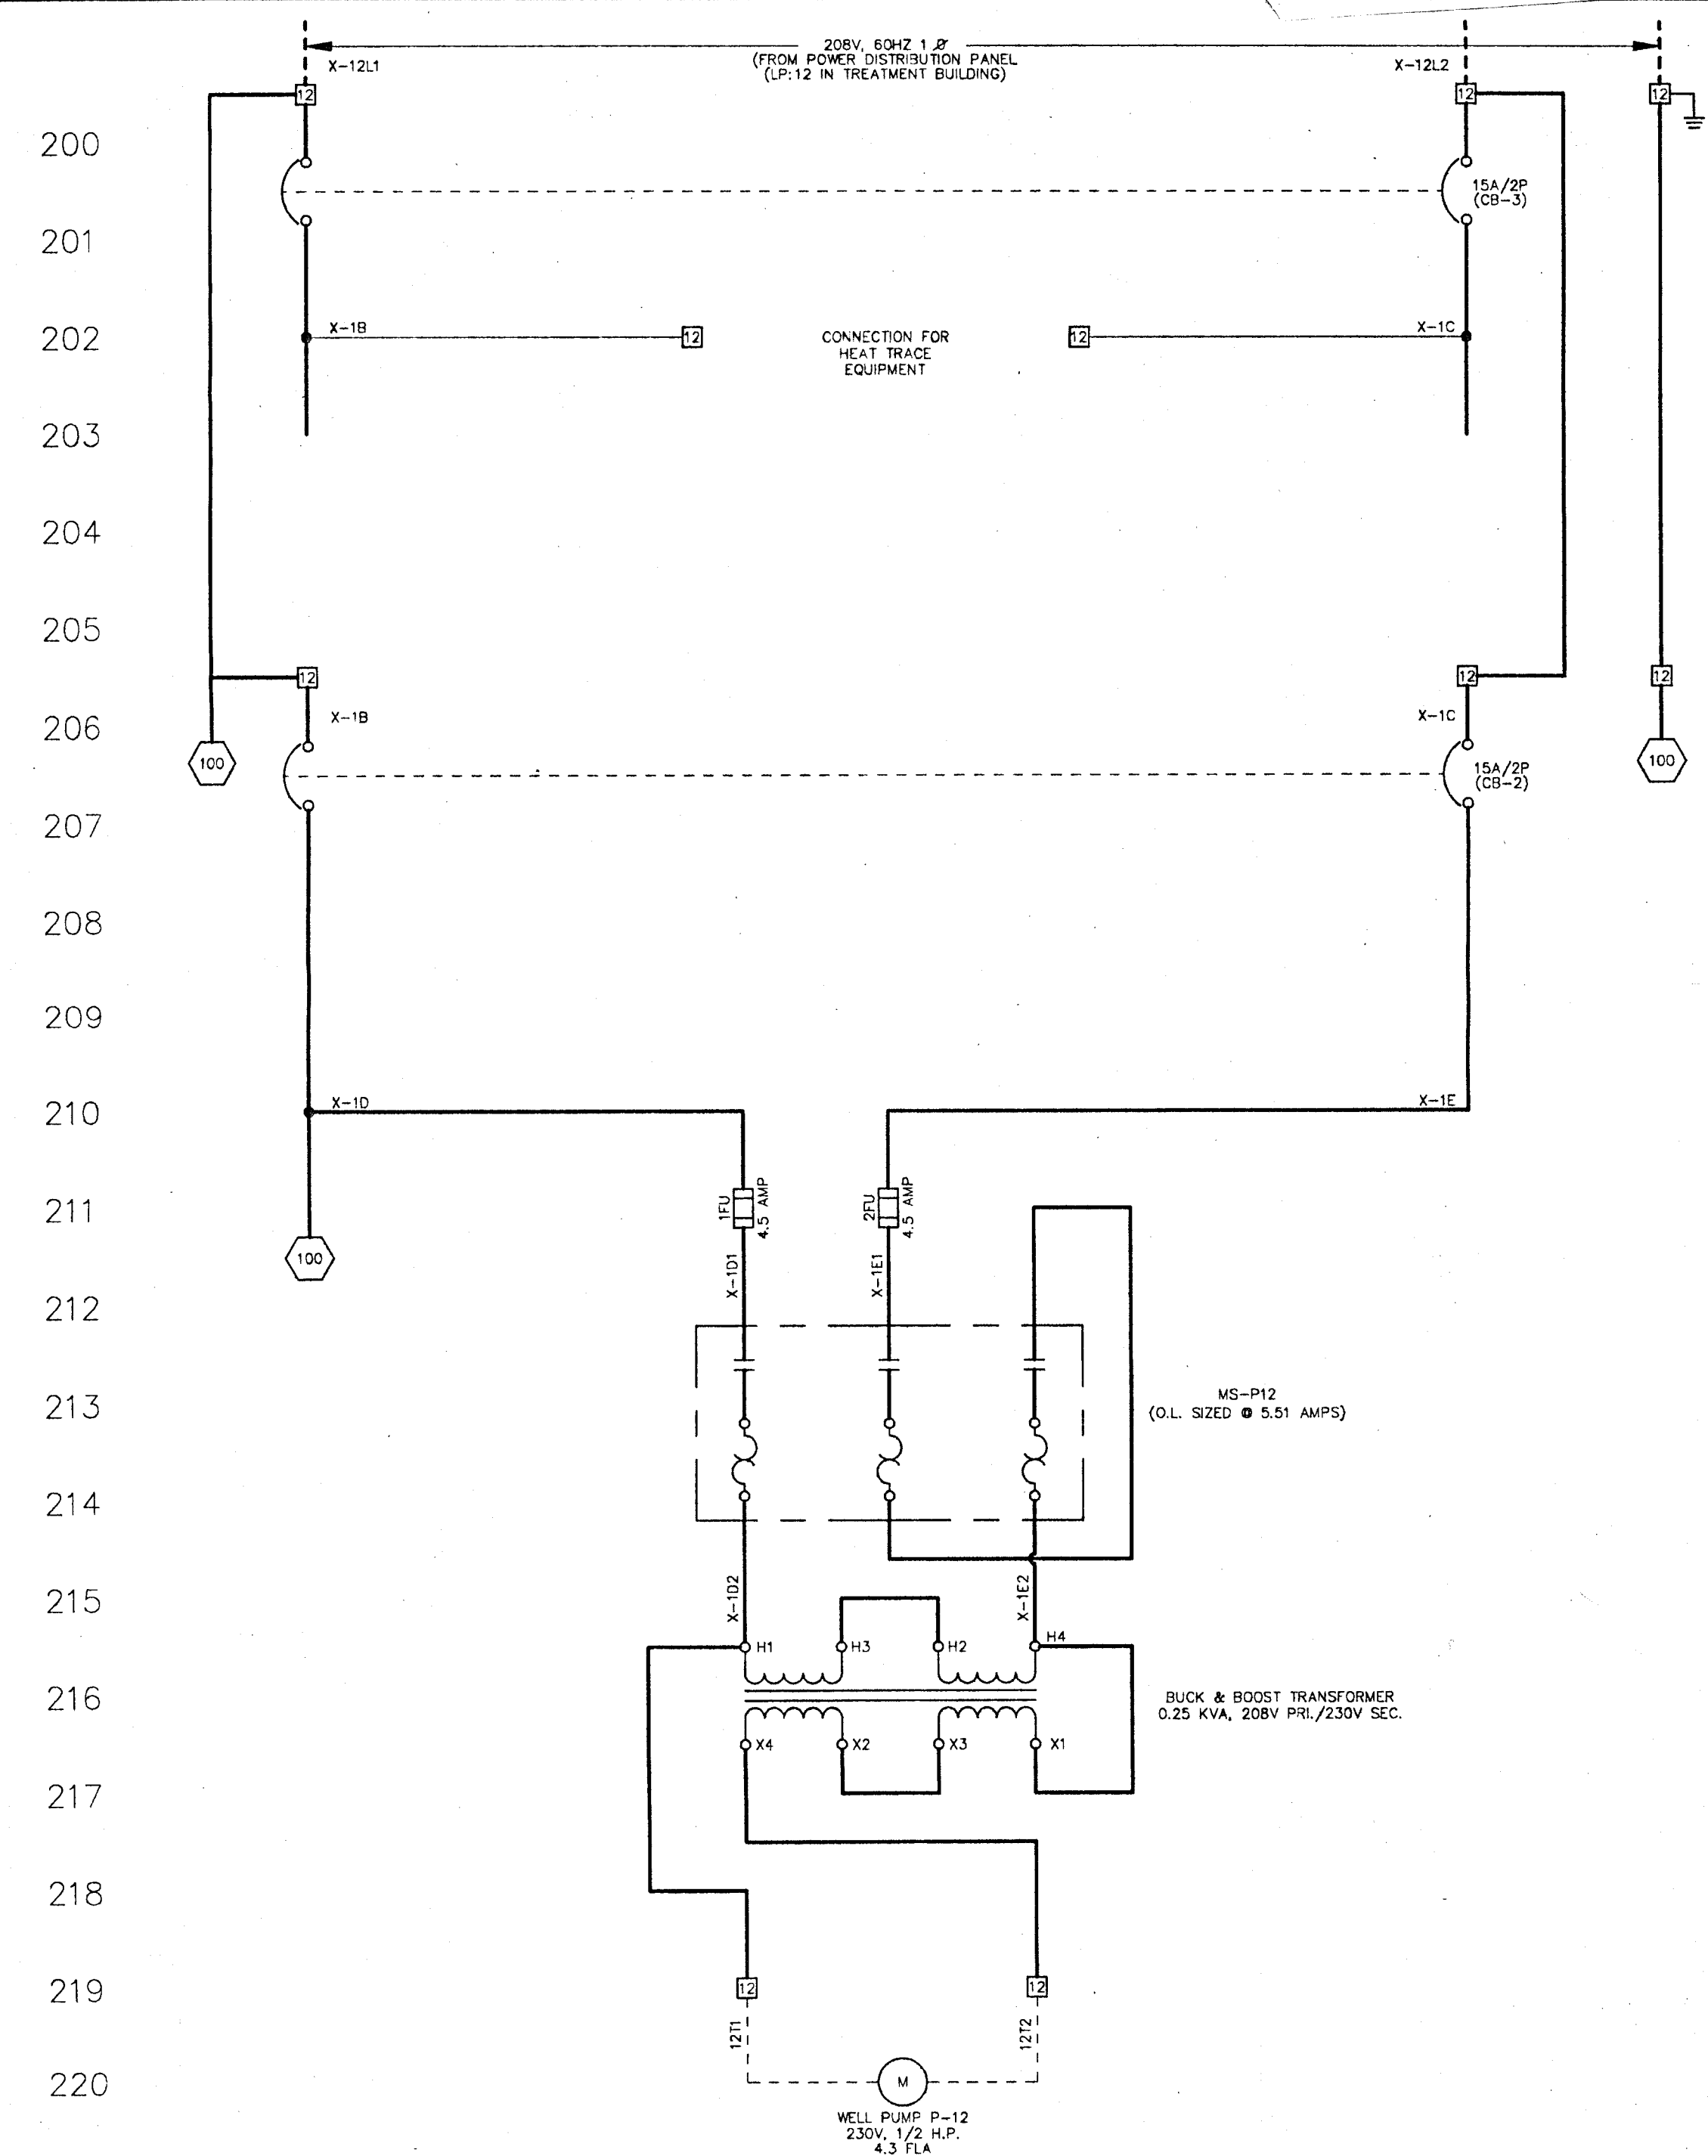
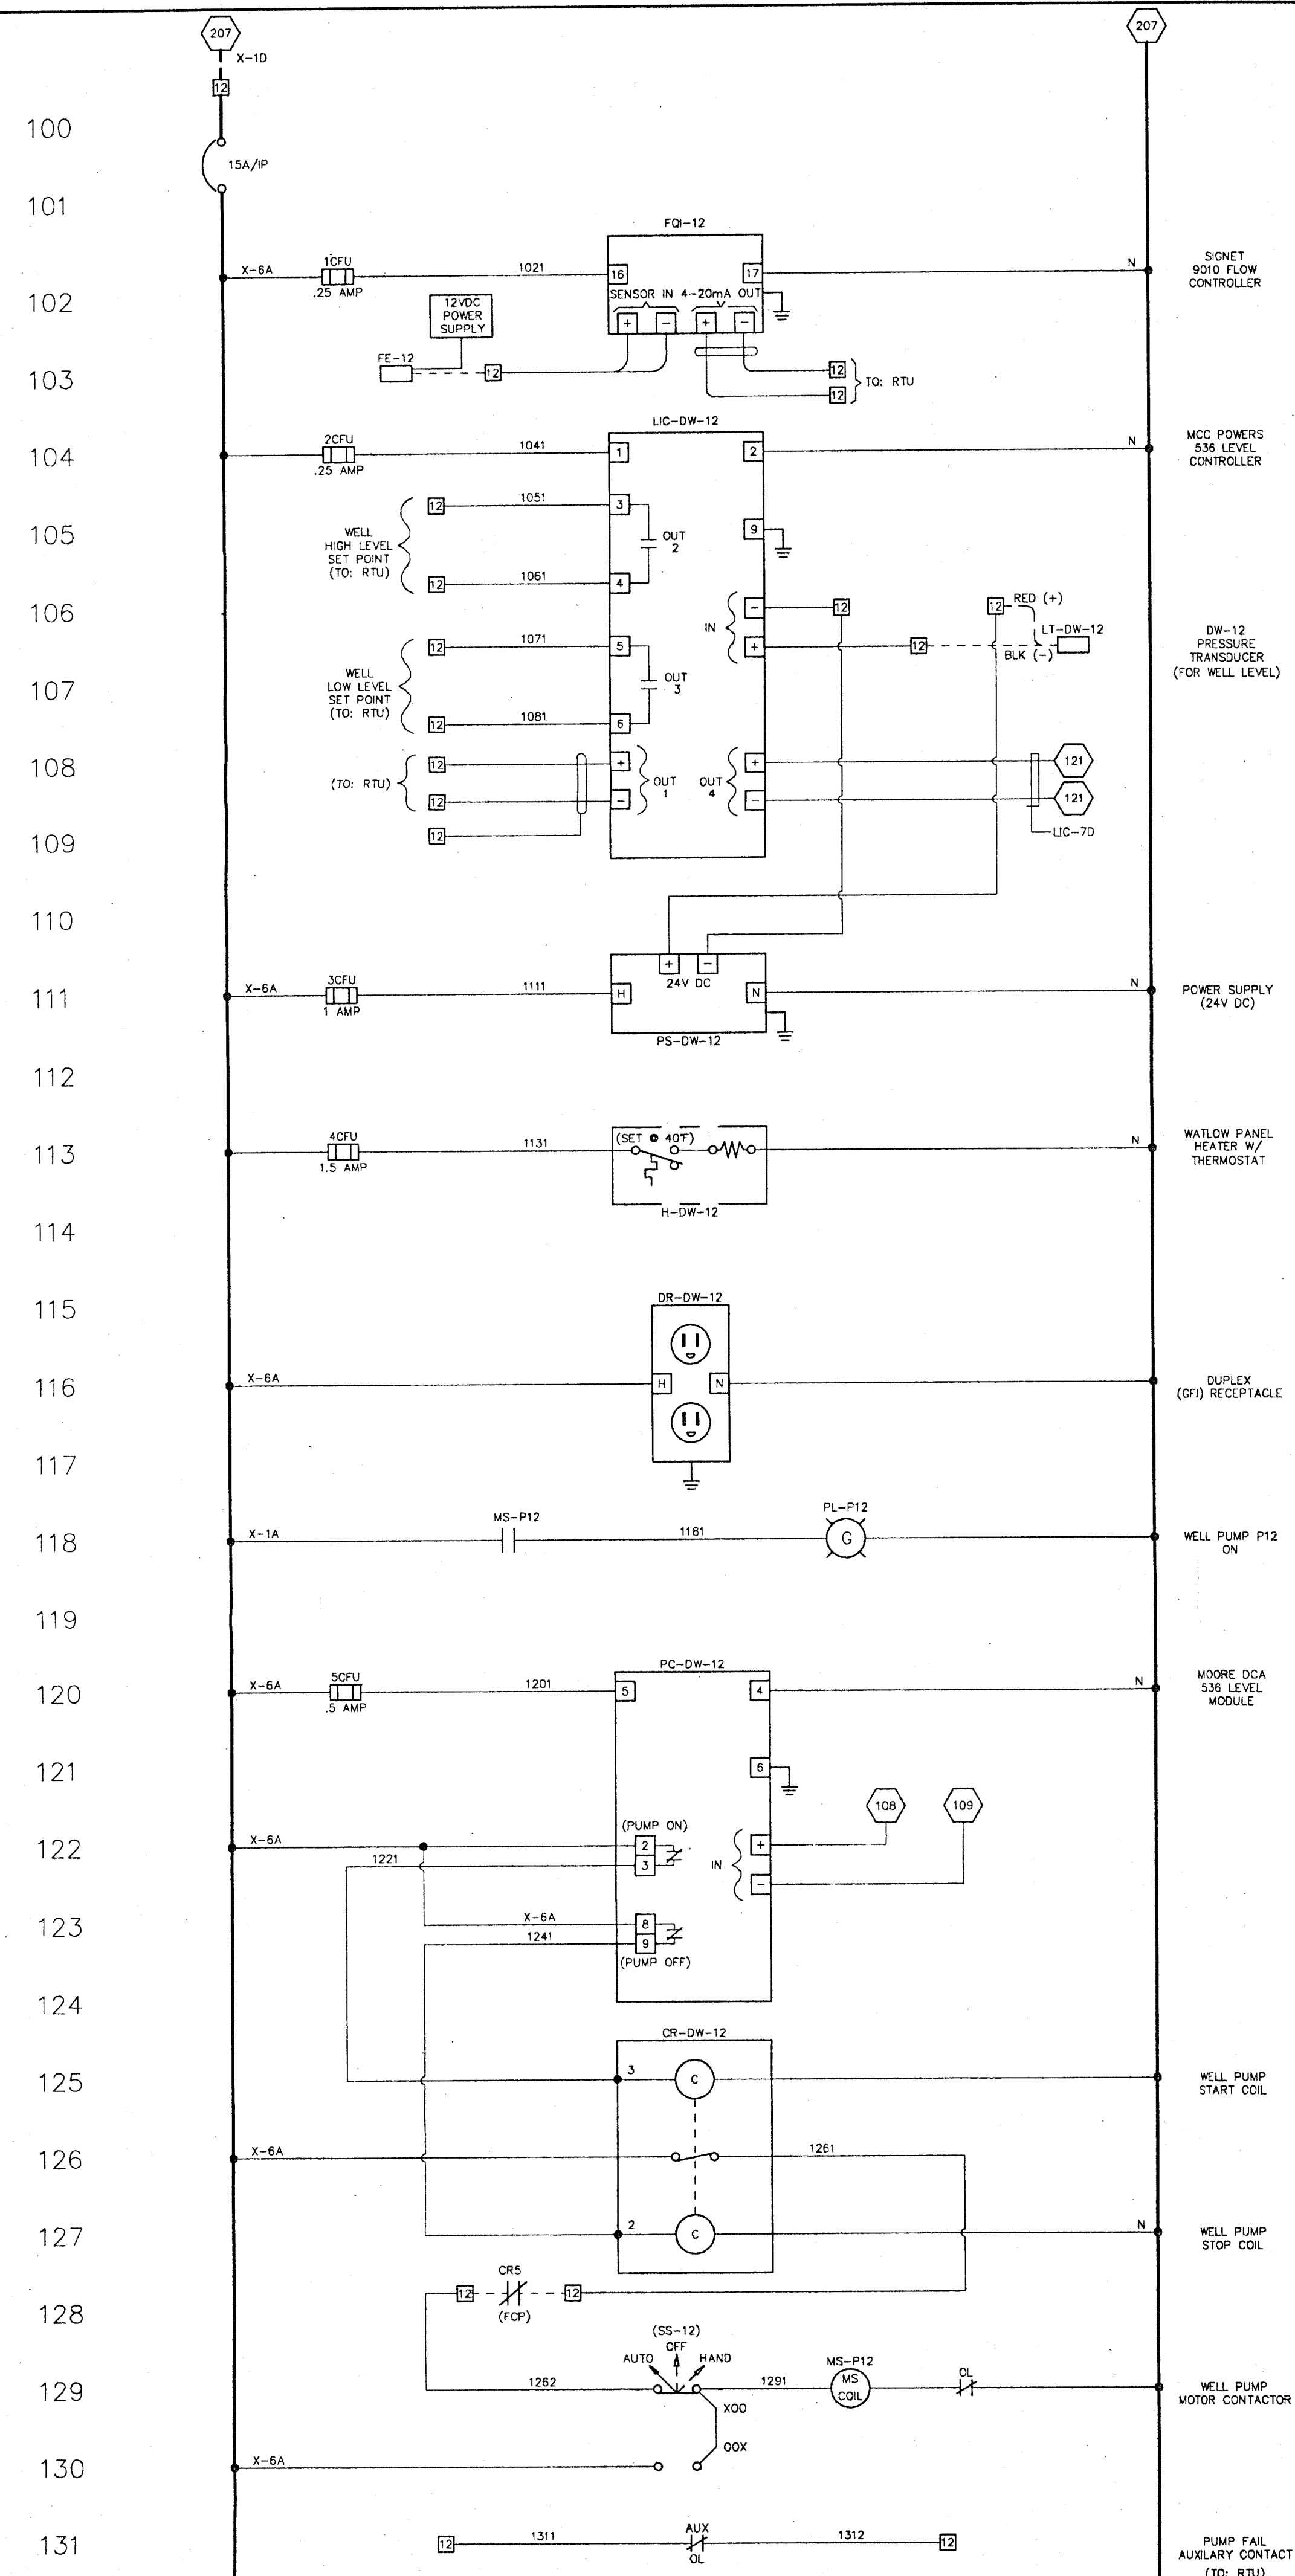


(DW-12) VAULT PANEL SCHEMATIC

KEY:

12 TERMINAL BLOCK LOCATED IN PANEL FOR
 INSTALLING CONTRACTOR CONNECTION
 ————— INDICATES WIRING INTERNAL TO PANEL
 - - - - - INDICATES WIRING EXTERNAL TO PANEL


						APPROVAL	MANAGER	ENGR.	DATE	FILE NAME: 0275000 0275 		
5	AS BUILT	BAB			11-16-94	STR. AND CIVIL MECHANICAL						
4	GENERAL REVISION	BAB			4-6-94	ELECT. & INST.	JMF	JMF	1-7-94			
3	CERTIFIED FOR CONSTRUCTION	BAB			1-10-94	PROCESS						
2	SUBMITTAL REVIEW REVISION	BAB			1-7-94	PROJECT	ACY		1-7-94			
1	GENERAL REVISION	JMF			11/22/93	DRAWN BY B.A. BEEBE		DATE 11-5-93				
NO.	REVISIONS	DRAWN	CHKD.	APP.	DATE	DSGN. CAL BY J. FLEISCHMAN	DATE 11-1-93	CHECKED BY B.A. BEEBE	DATE 1-7-94	SCALE NONE	DWG. D-0273	SHT. 12

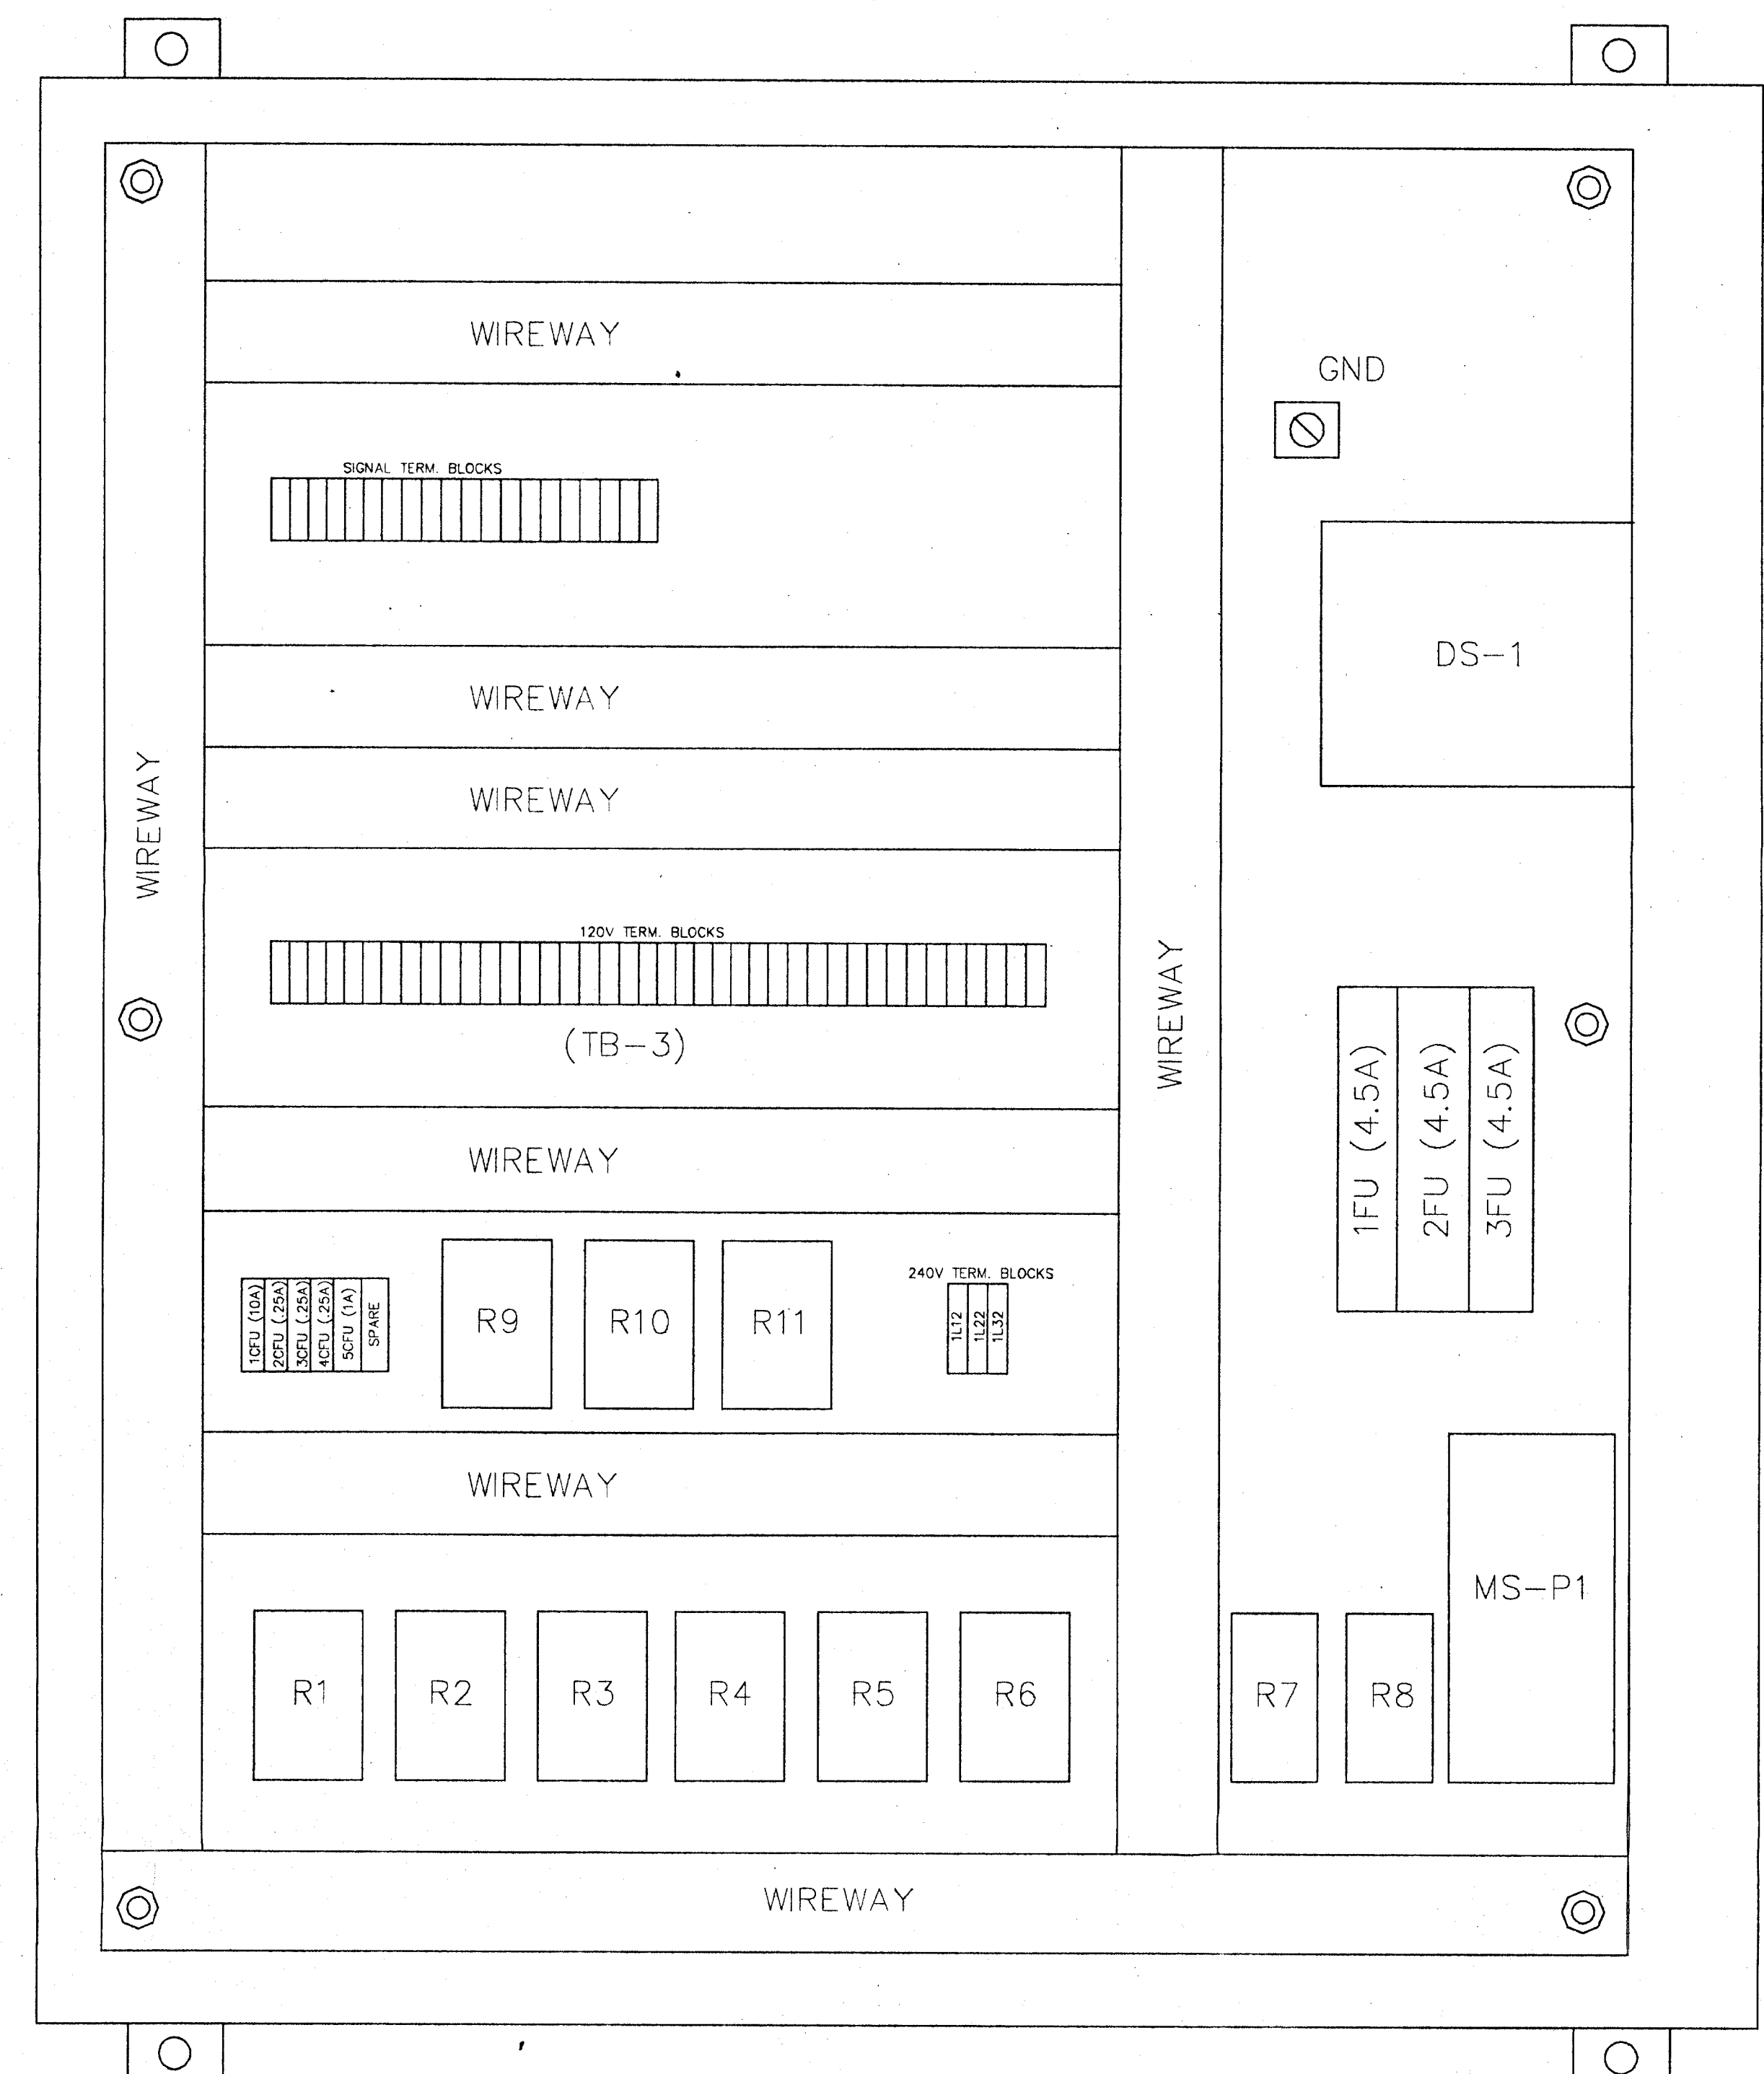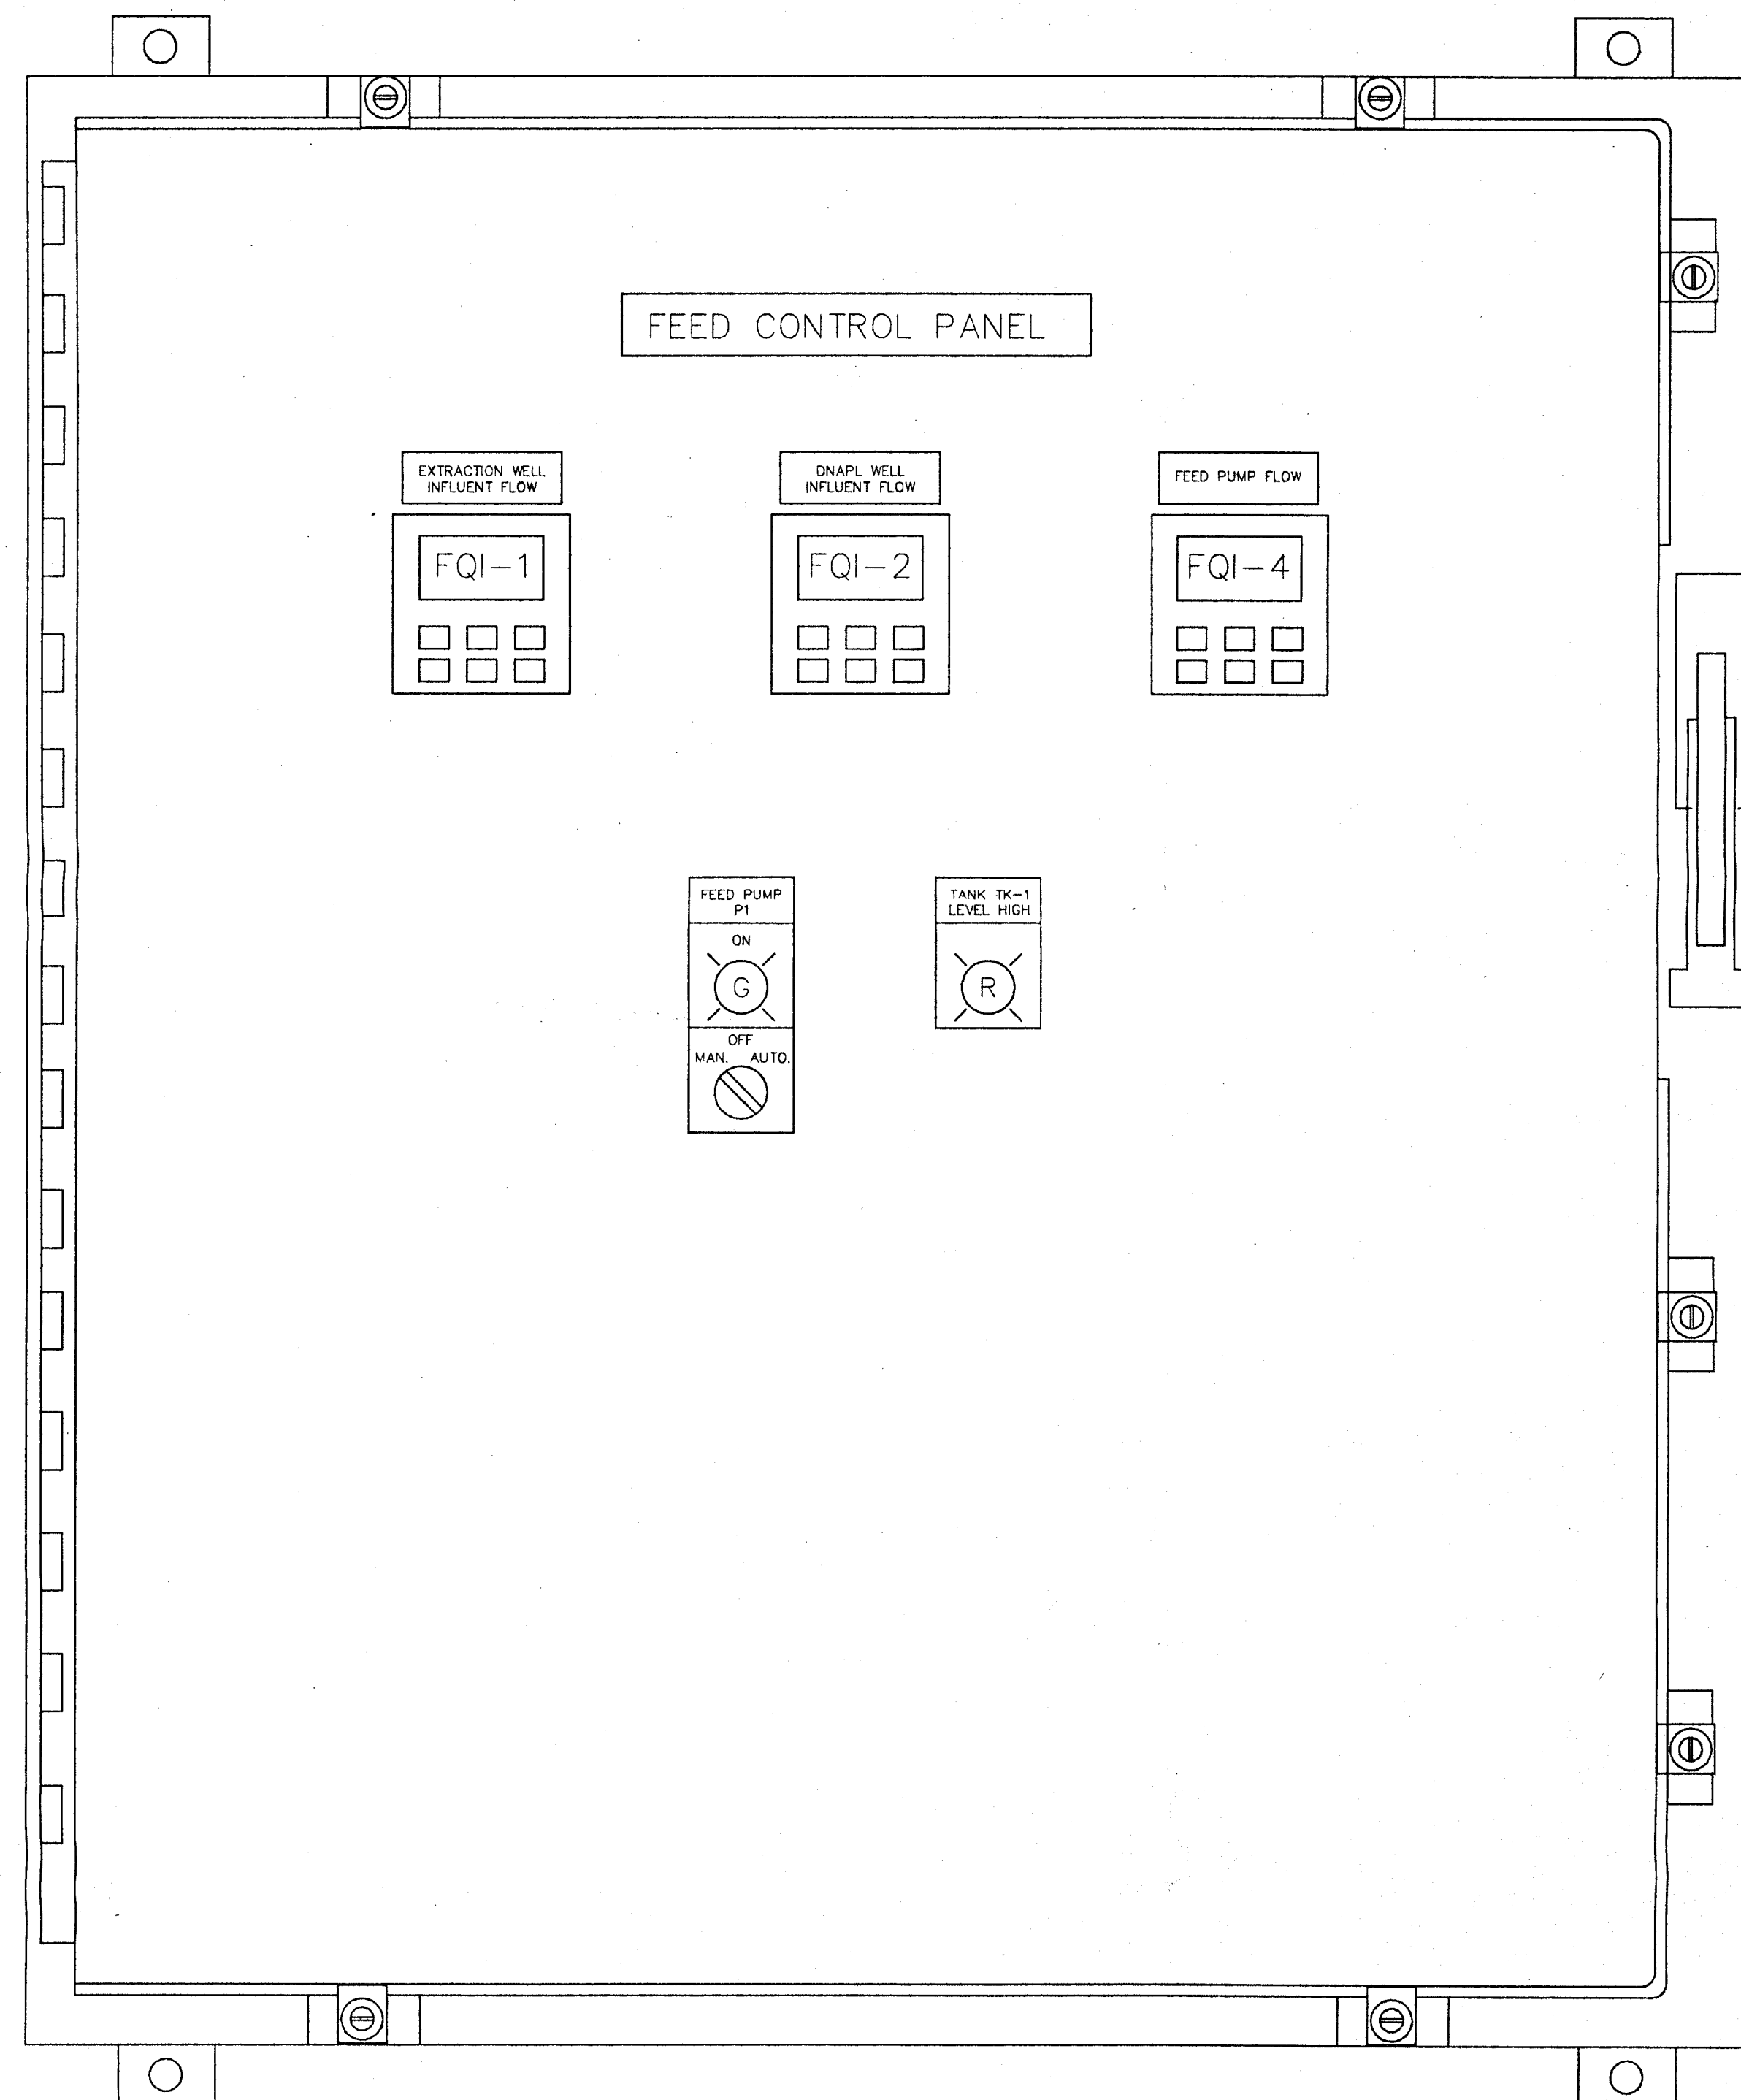

FEED CONTROL PANEL
 SIZE: 42" X 37.38" X 12"




																																																																																																																																																																																																																																																																																																																																																																																																																																																																																																																																																																																																																																																																																																																																																																																																																																																																																																																																																																																																																																																																																																																																																																																																																																																																																																																																																																																																																																					</
--	--	----

THIS DRAWING INCLUDING THE INFORMATION, DATA AND DESIGN IS THE PROPERTY OF TREATEK - CRA. IT IS NOT TO BE COPIED, REPRODUCED OR ITS CONTENTS DIVULGED WITHOUT THE WRITTEN PERMISSION OF TREATEK - CRA.

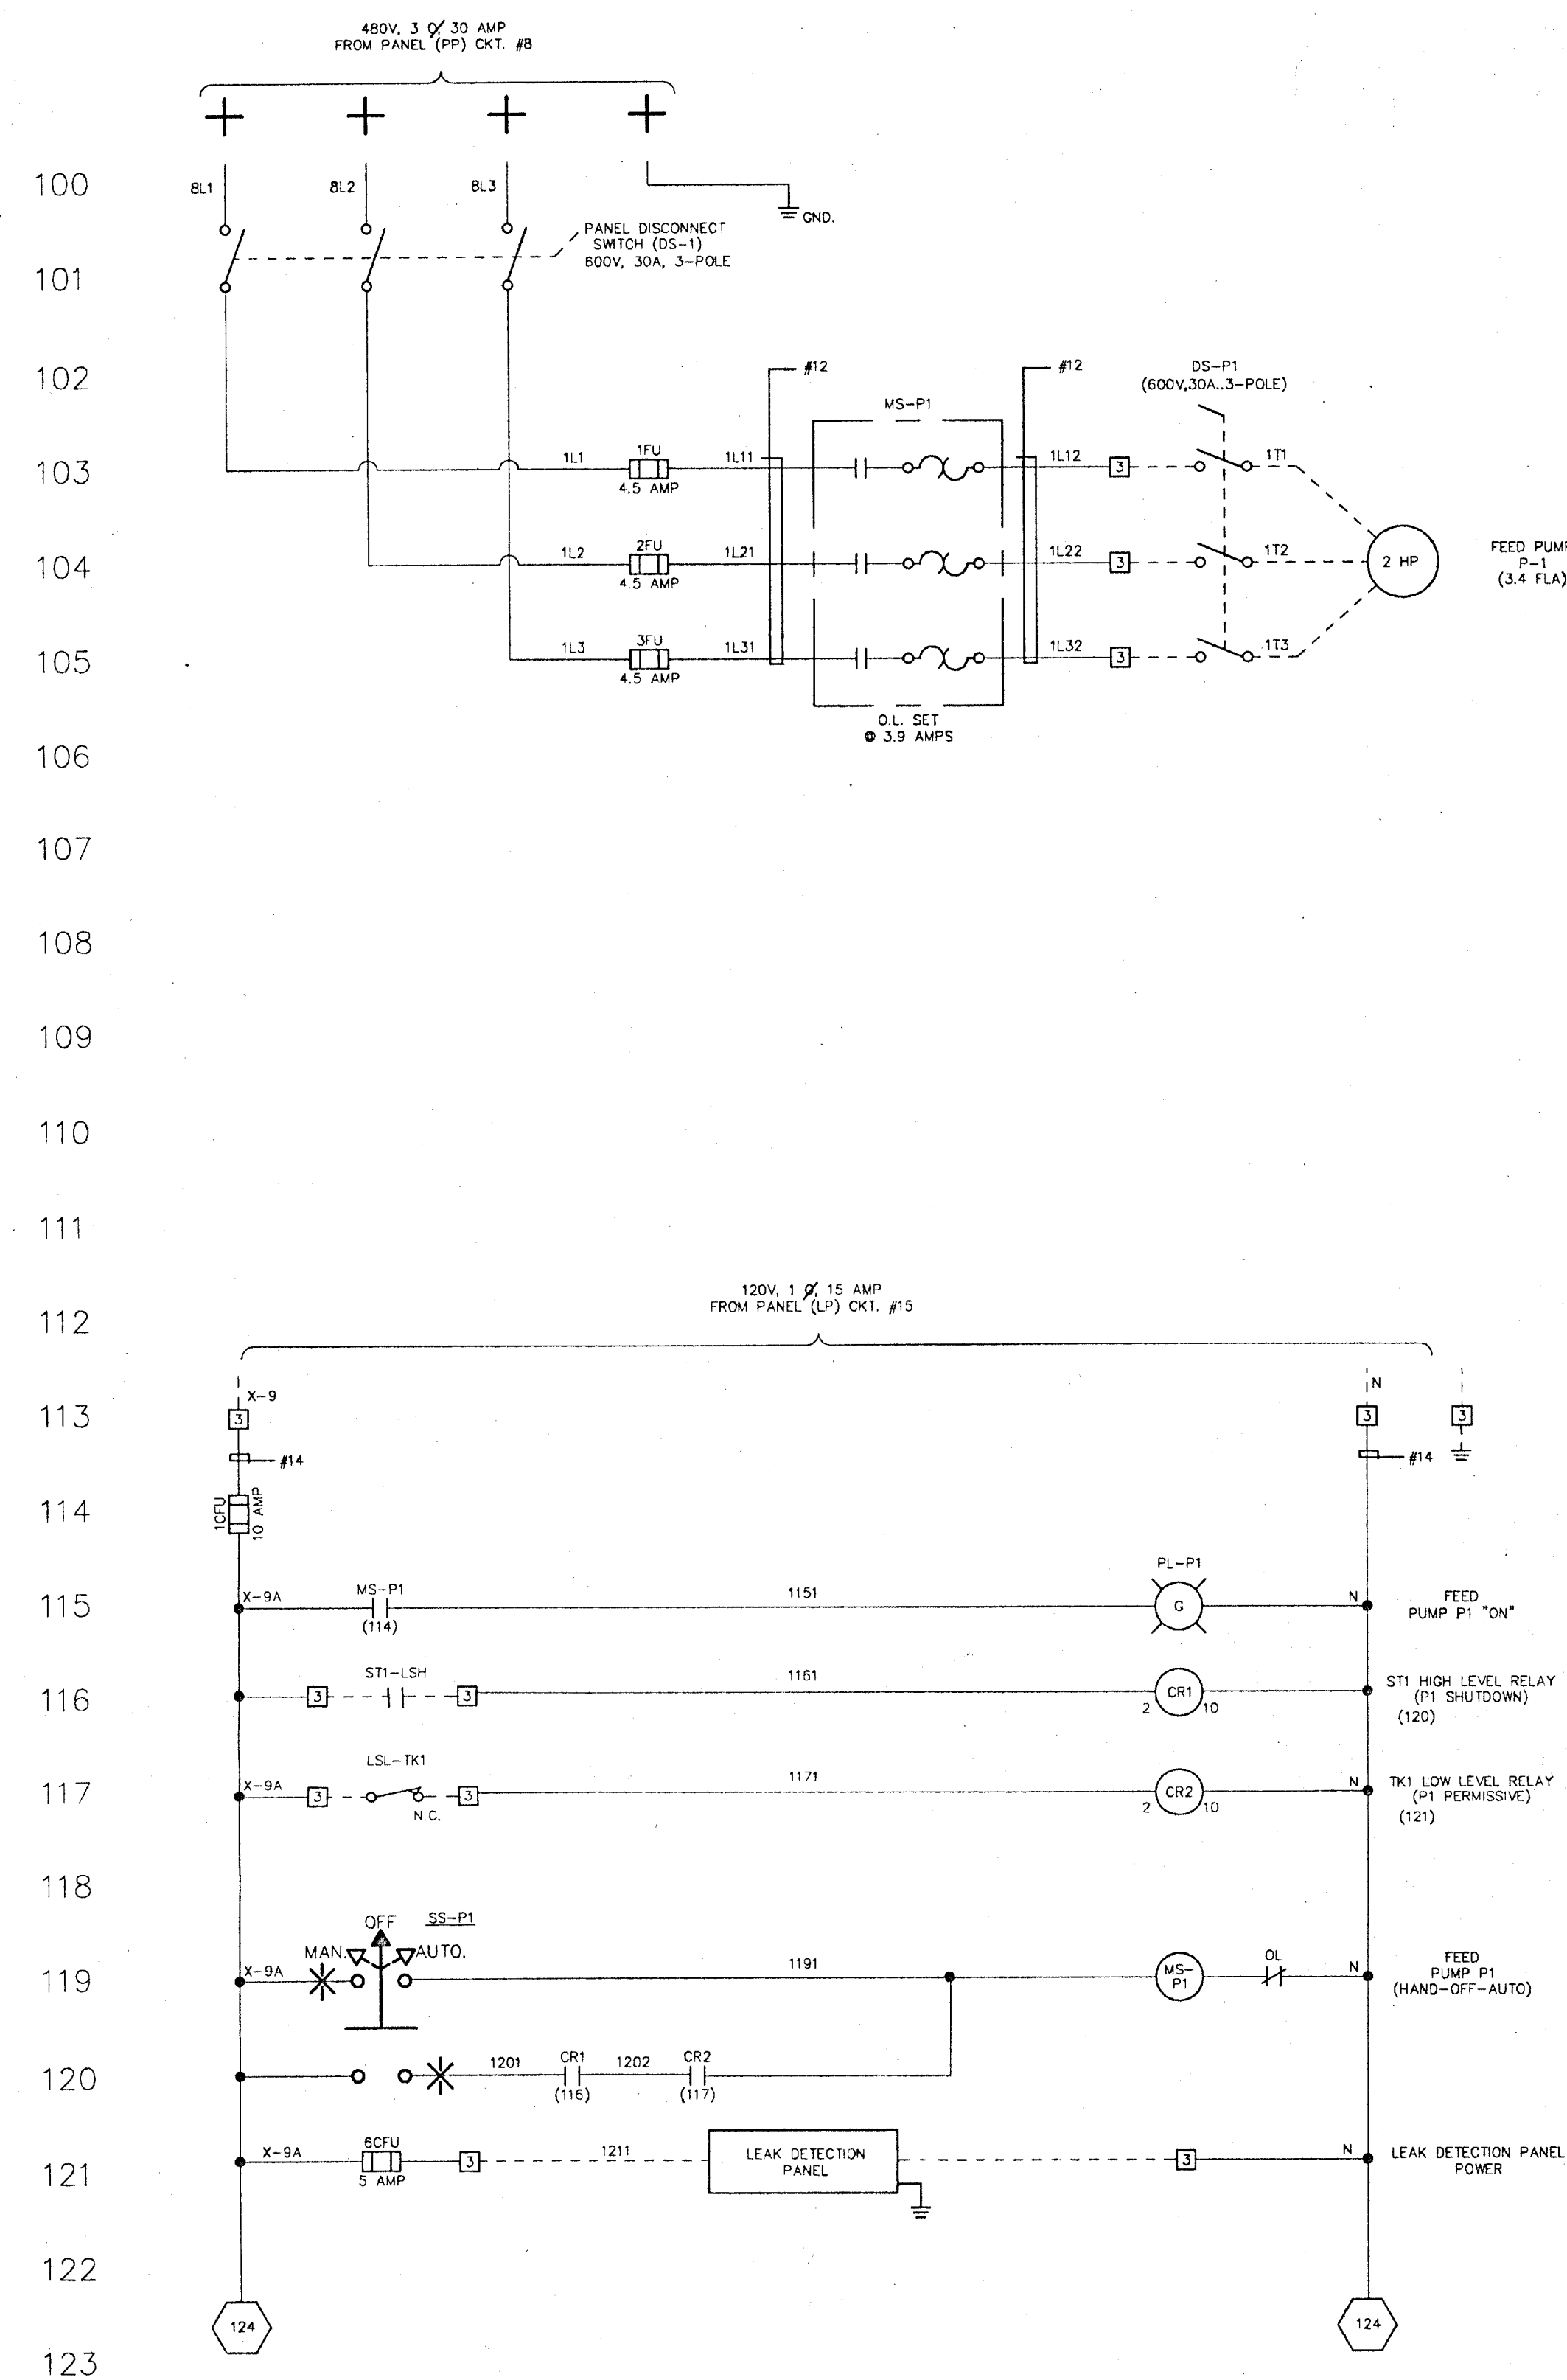

FEED CONTROL PANEL SCHEMATIC



KEY:
 [] TERMINAL BLOCK LOCATED IN PANEL FOR
 INSTALLING CONTRACTOR CONNECTION
 ——— INDICATES WIRING INTERNAL TO PANEL
 - - - - - INDICATES WIRING EXTERNAL TO PANEL

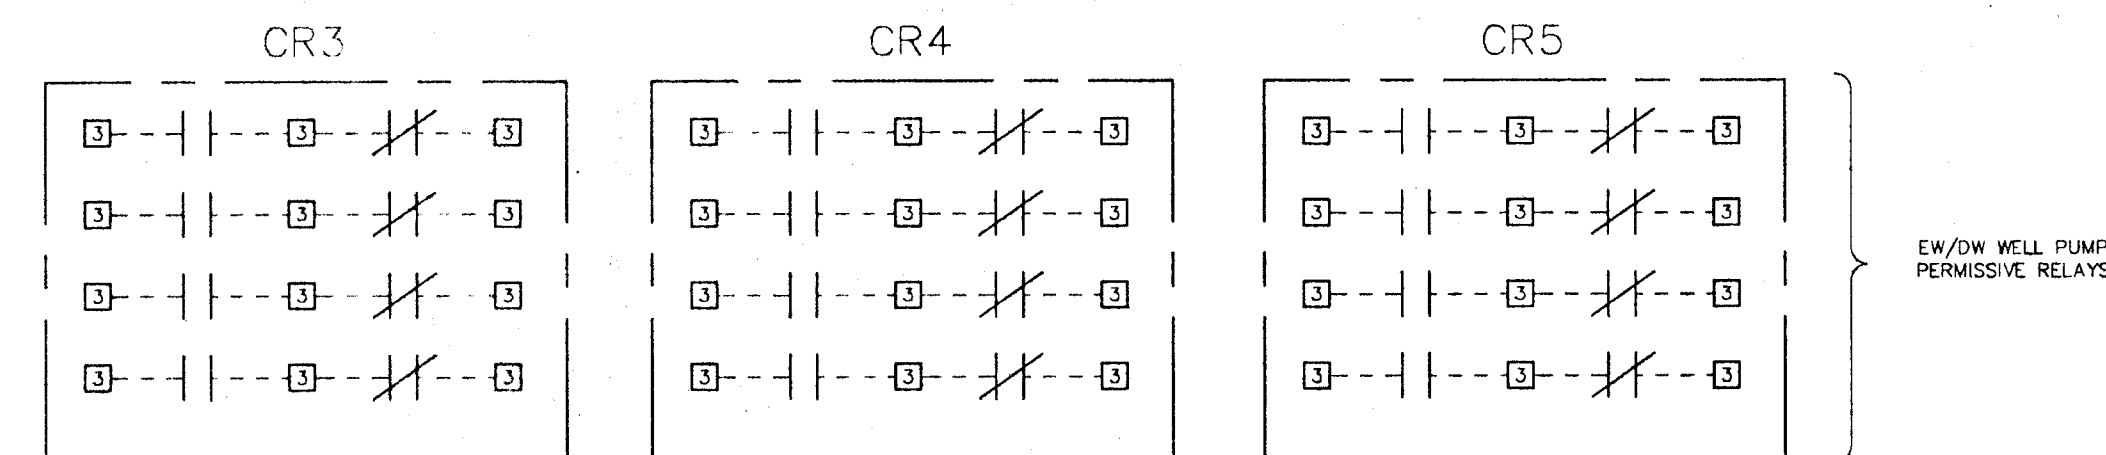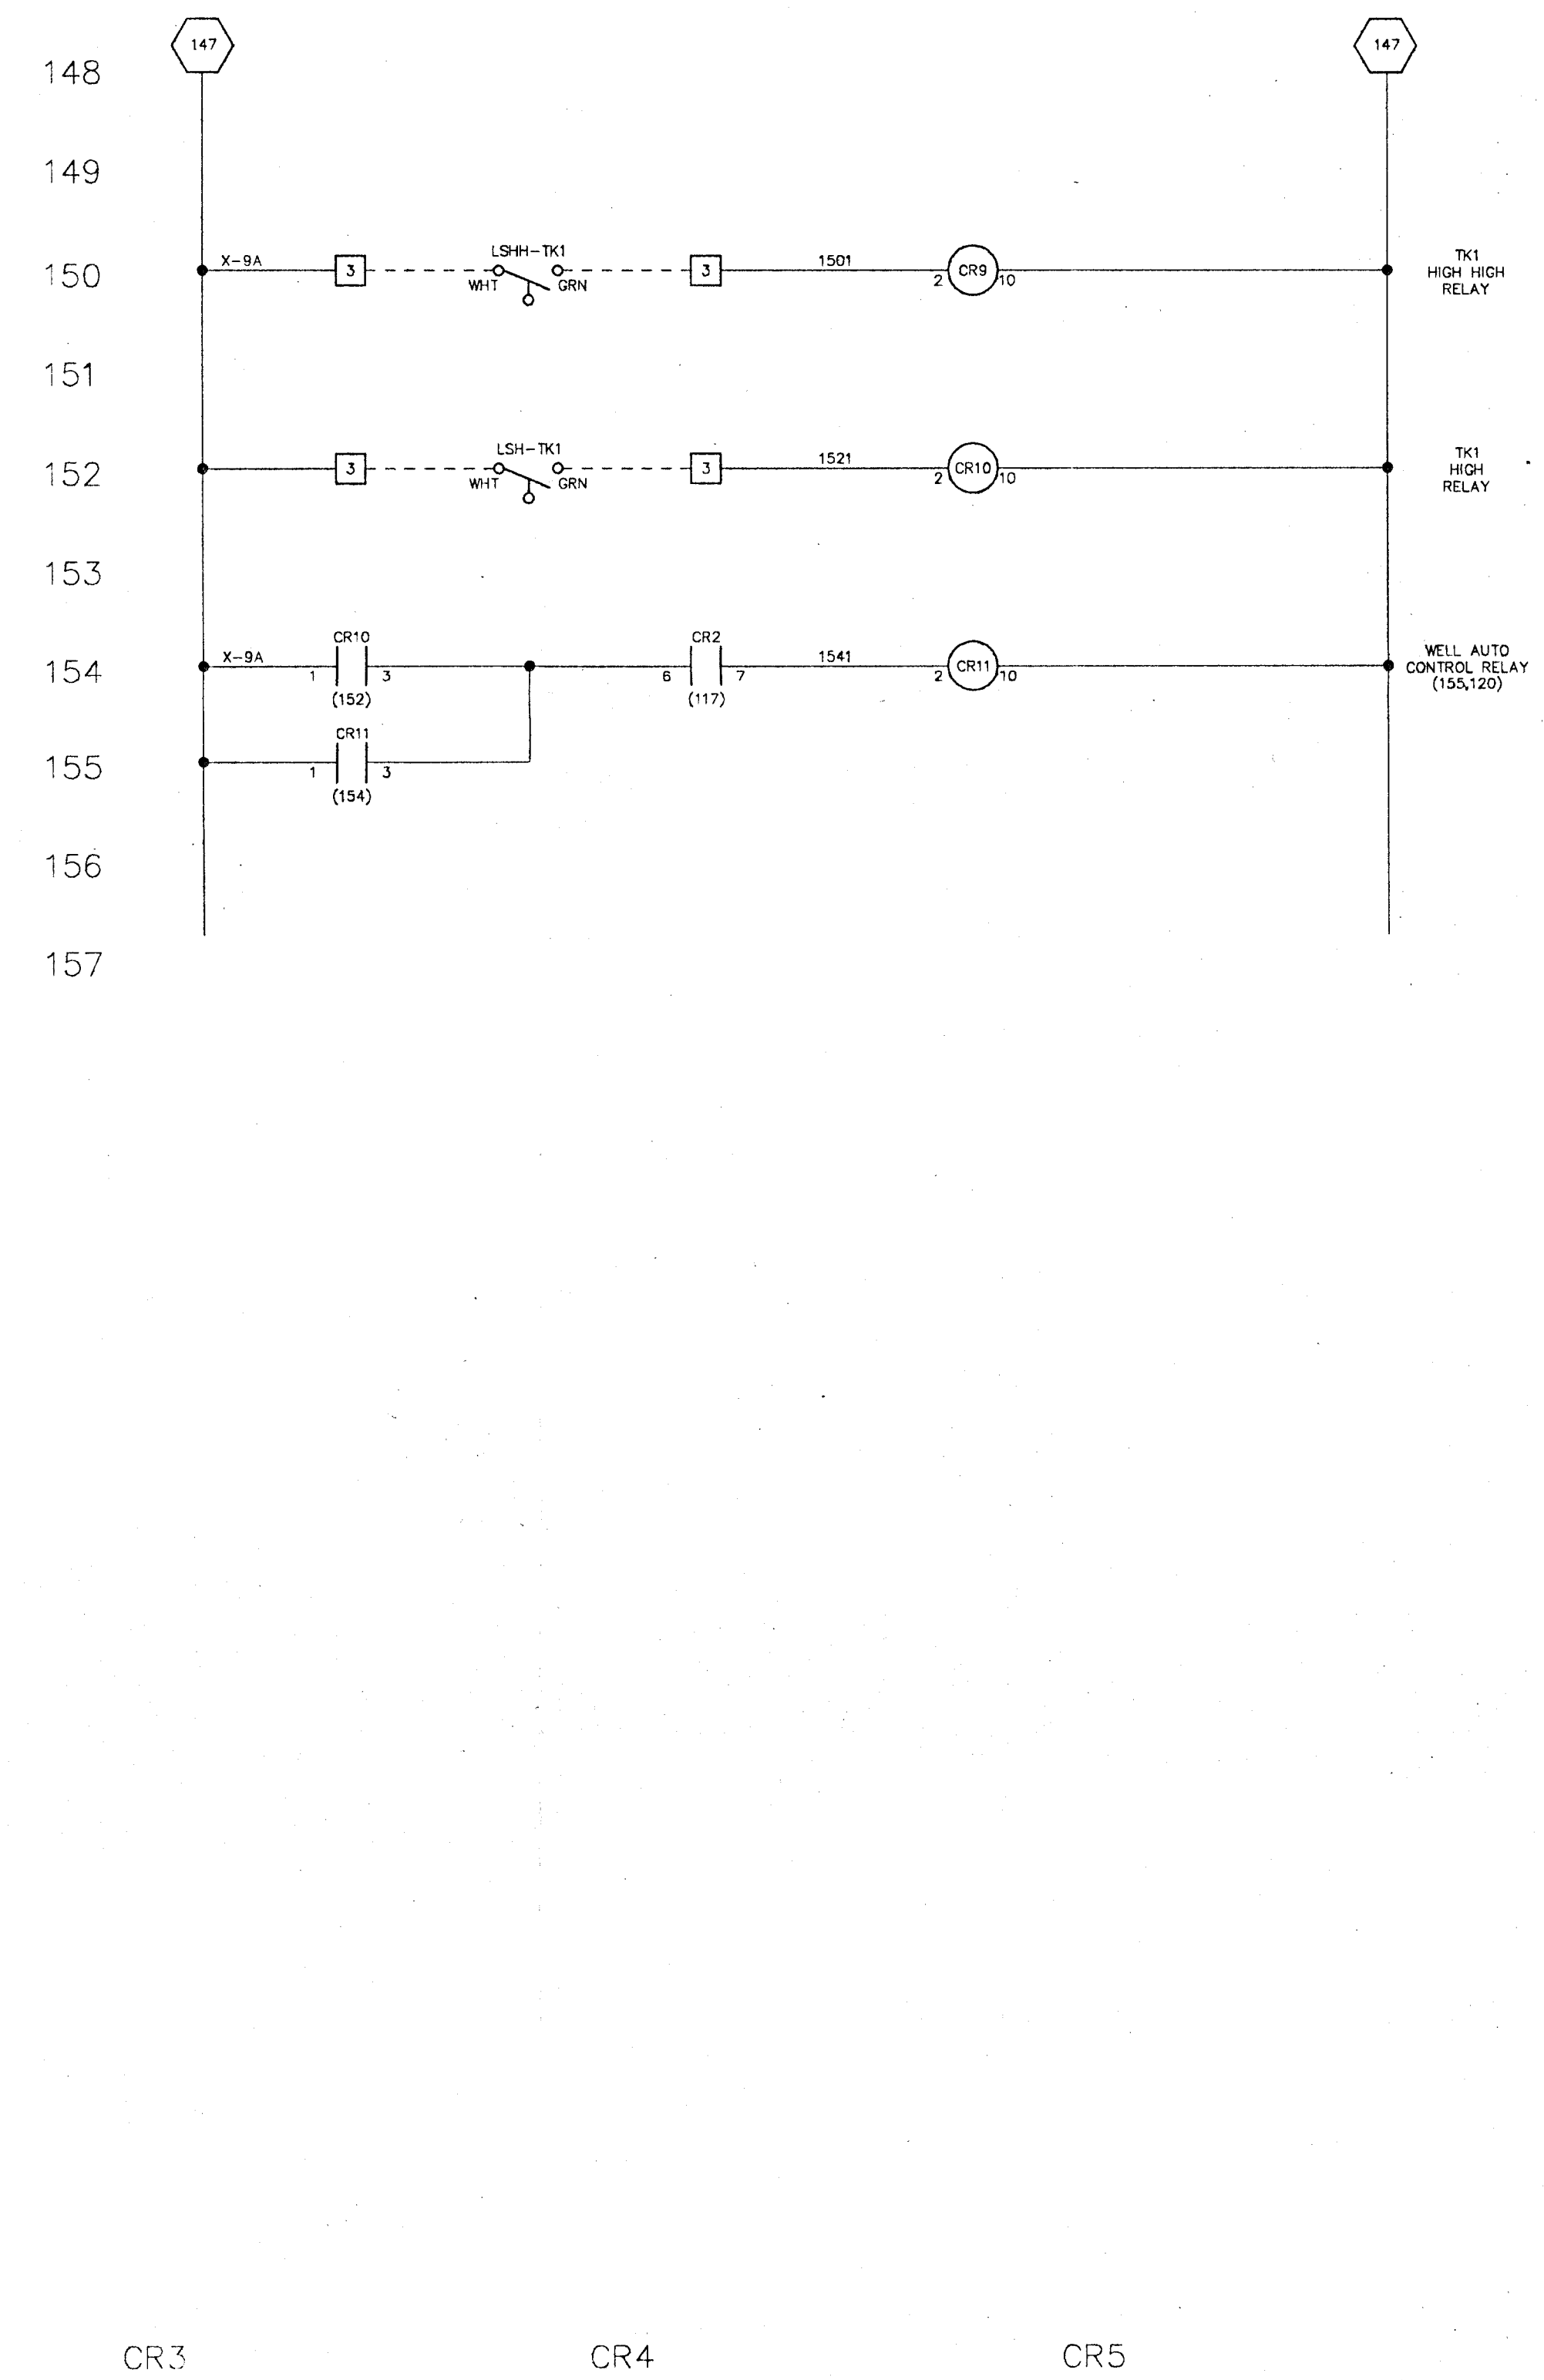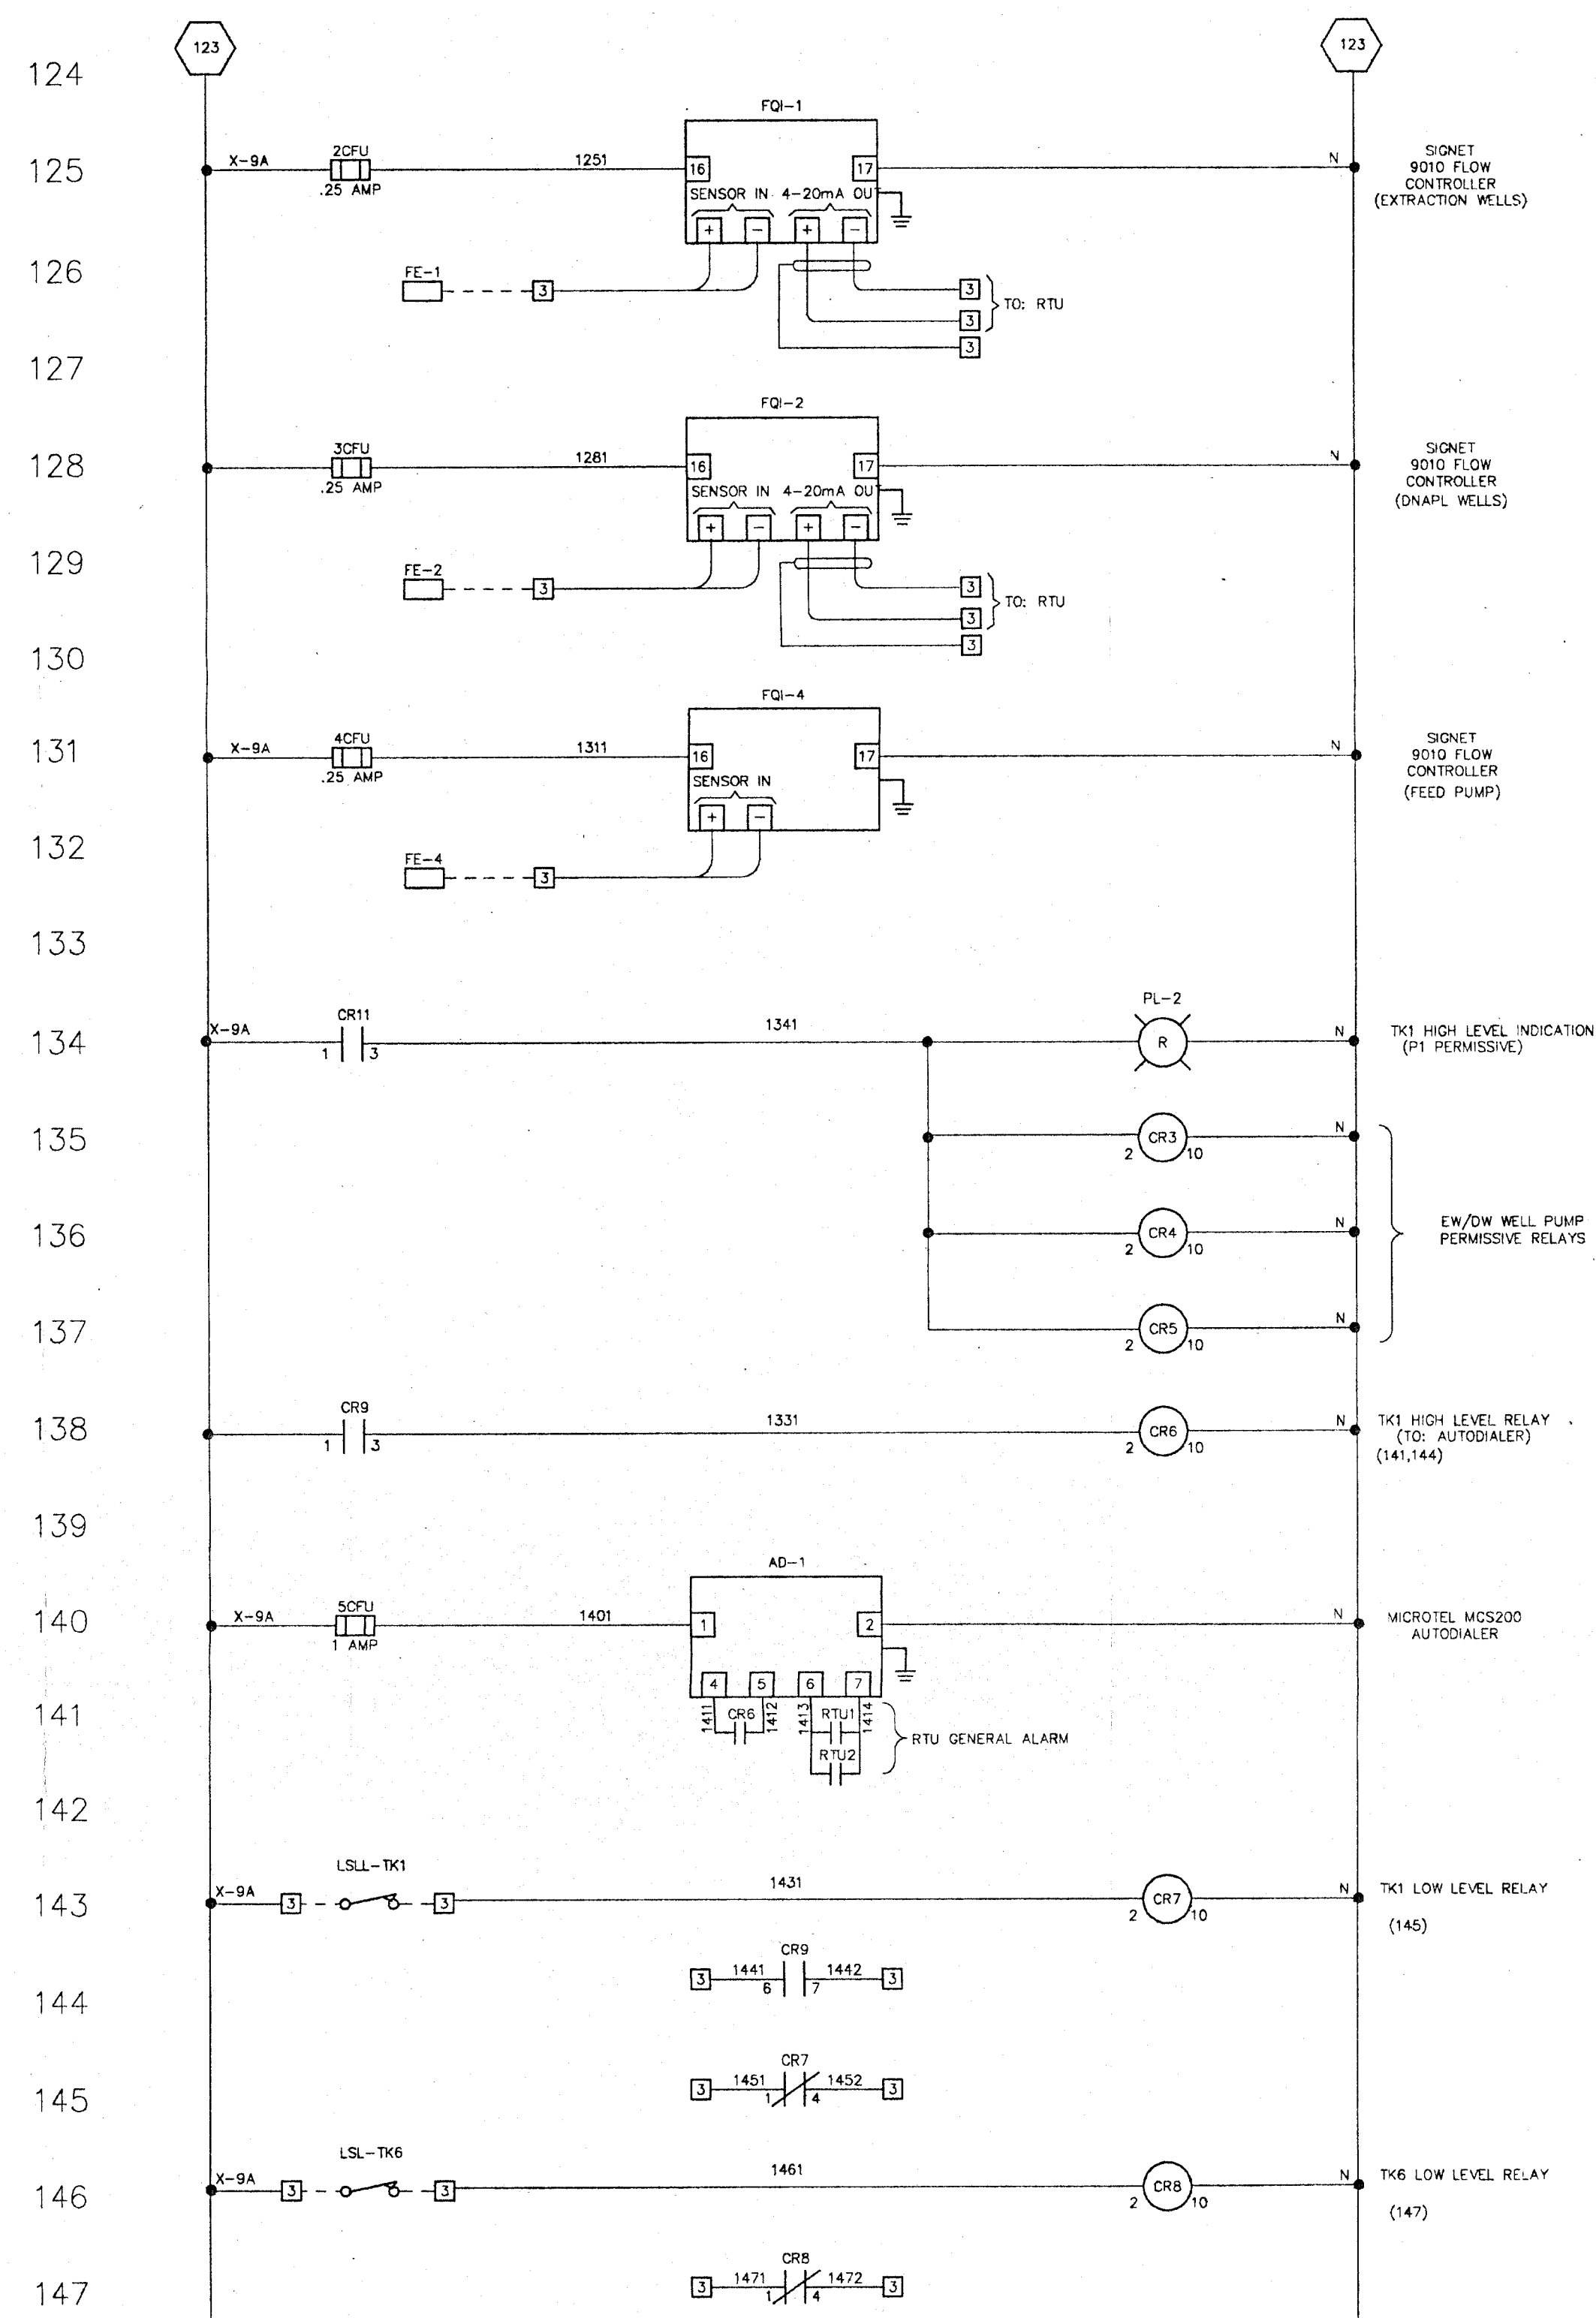

										FILE NAME: 0273e009		0273					
										Treatek - CRATM COMPANY							
										BELL AEROSPACE TEXTRON GROUNDWATER TREATMENT PLANT							
										FEED CONTROL PANEL (FCP) SCHEMATIC							
										SCALE		NONE		DWG. D-0273		SHT. 14	
										DRAWN BY		J. FLEISCHMAN		DATE		11-5-93	
										DSGN.CAL BY		J. FLEISCHMAN		DATE		11-1-93	
										CHECKED BY		B.A. BEEBE		DATE		1-7-94	

										APPROVAL		MANAGER		ENGR.		DATE	
5		AS BUILT		BAB				11-16-94		STR. AND CIVIL							
4		CONTROL SYSTEM UPGRADE REVISION		JMF				8-1-94		MECHANICAL		JMF		JMF		1-7-94	
3		GENERAL REVISION		JMF				4-5-94		ELECT. & INST.							
2		CERTIFIED FOR CONSTRUCTION		BAB				1-10-94		PROCESS							
1		GENERAL REVISION		JMF				11/28/93		PROJECT		ACY				1-7-94	
NO.		REVISIONS		DRAWN		CHKD.		APP.		DATE		DRAWN BY		J. FLEISCHMAN		DATE 11-5-93	
												DSGN.CAL BY		J. FLEISCHMAN		DATE 11-1-93	
												CHECKED BY		B.A. BEEBE		DATE 1-7-94	

THIS DRAWING INCLUDING THE INFORMATION, DATA AND DESIGN IS THE PROPERTY OF TREATEK - CRA. IT IS NOT TO BE COPIED, REPRODUCED OR ITS CONTENTS DIVULGED WITHOUT THE WRITTEN PERMISSION OF TREATEK - CRA.

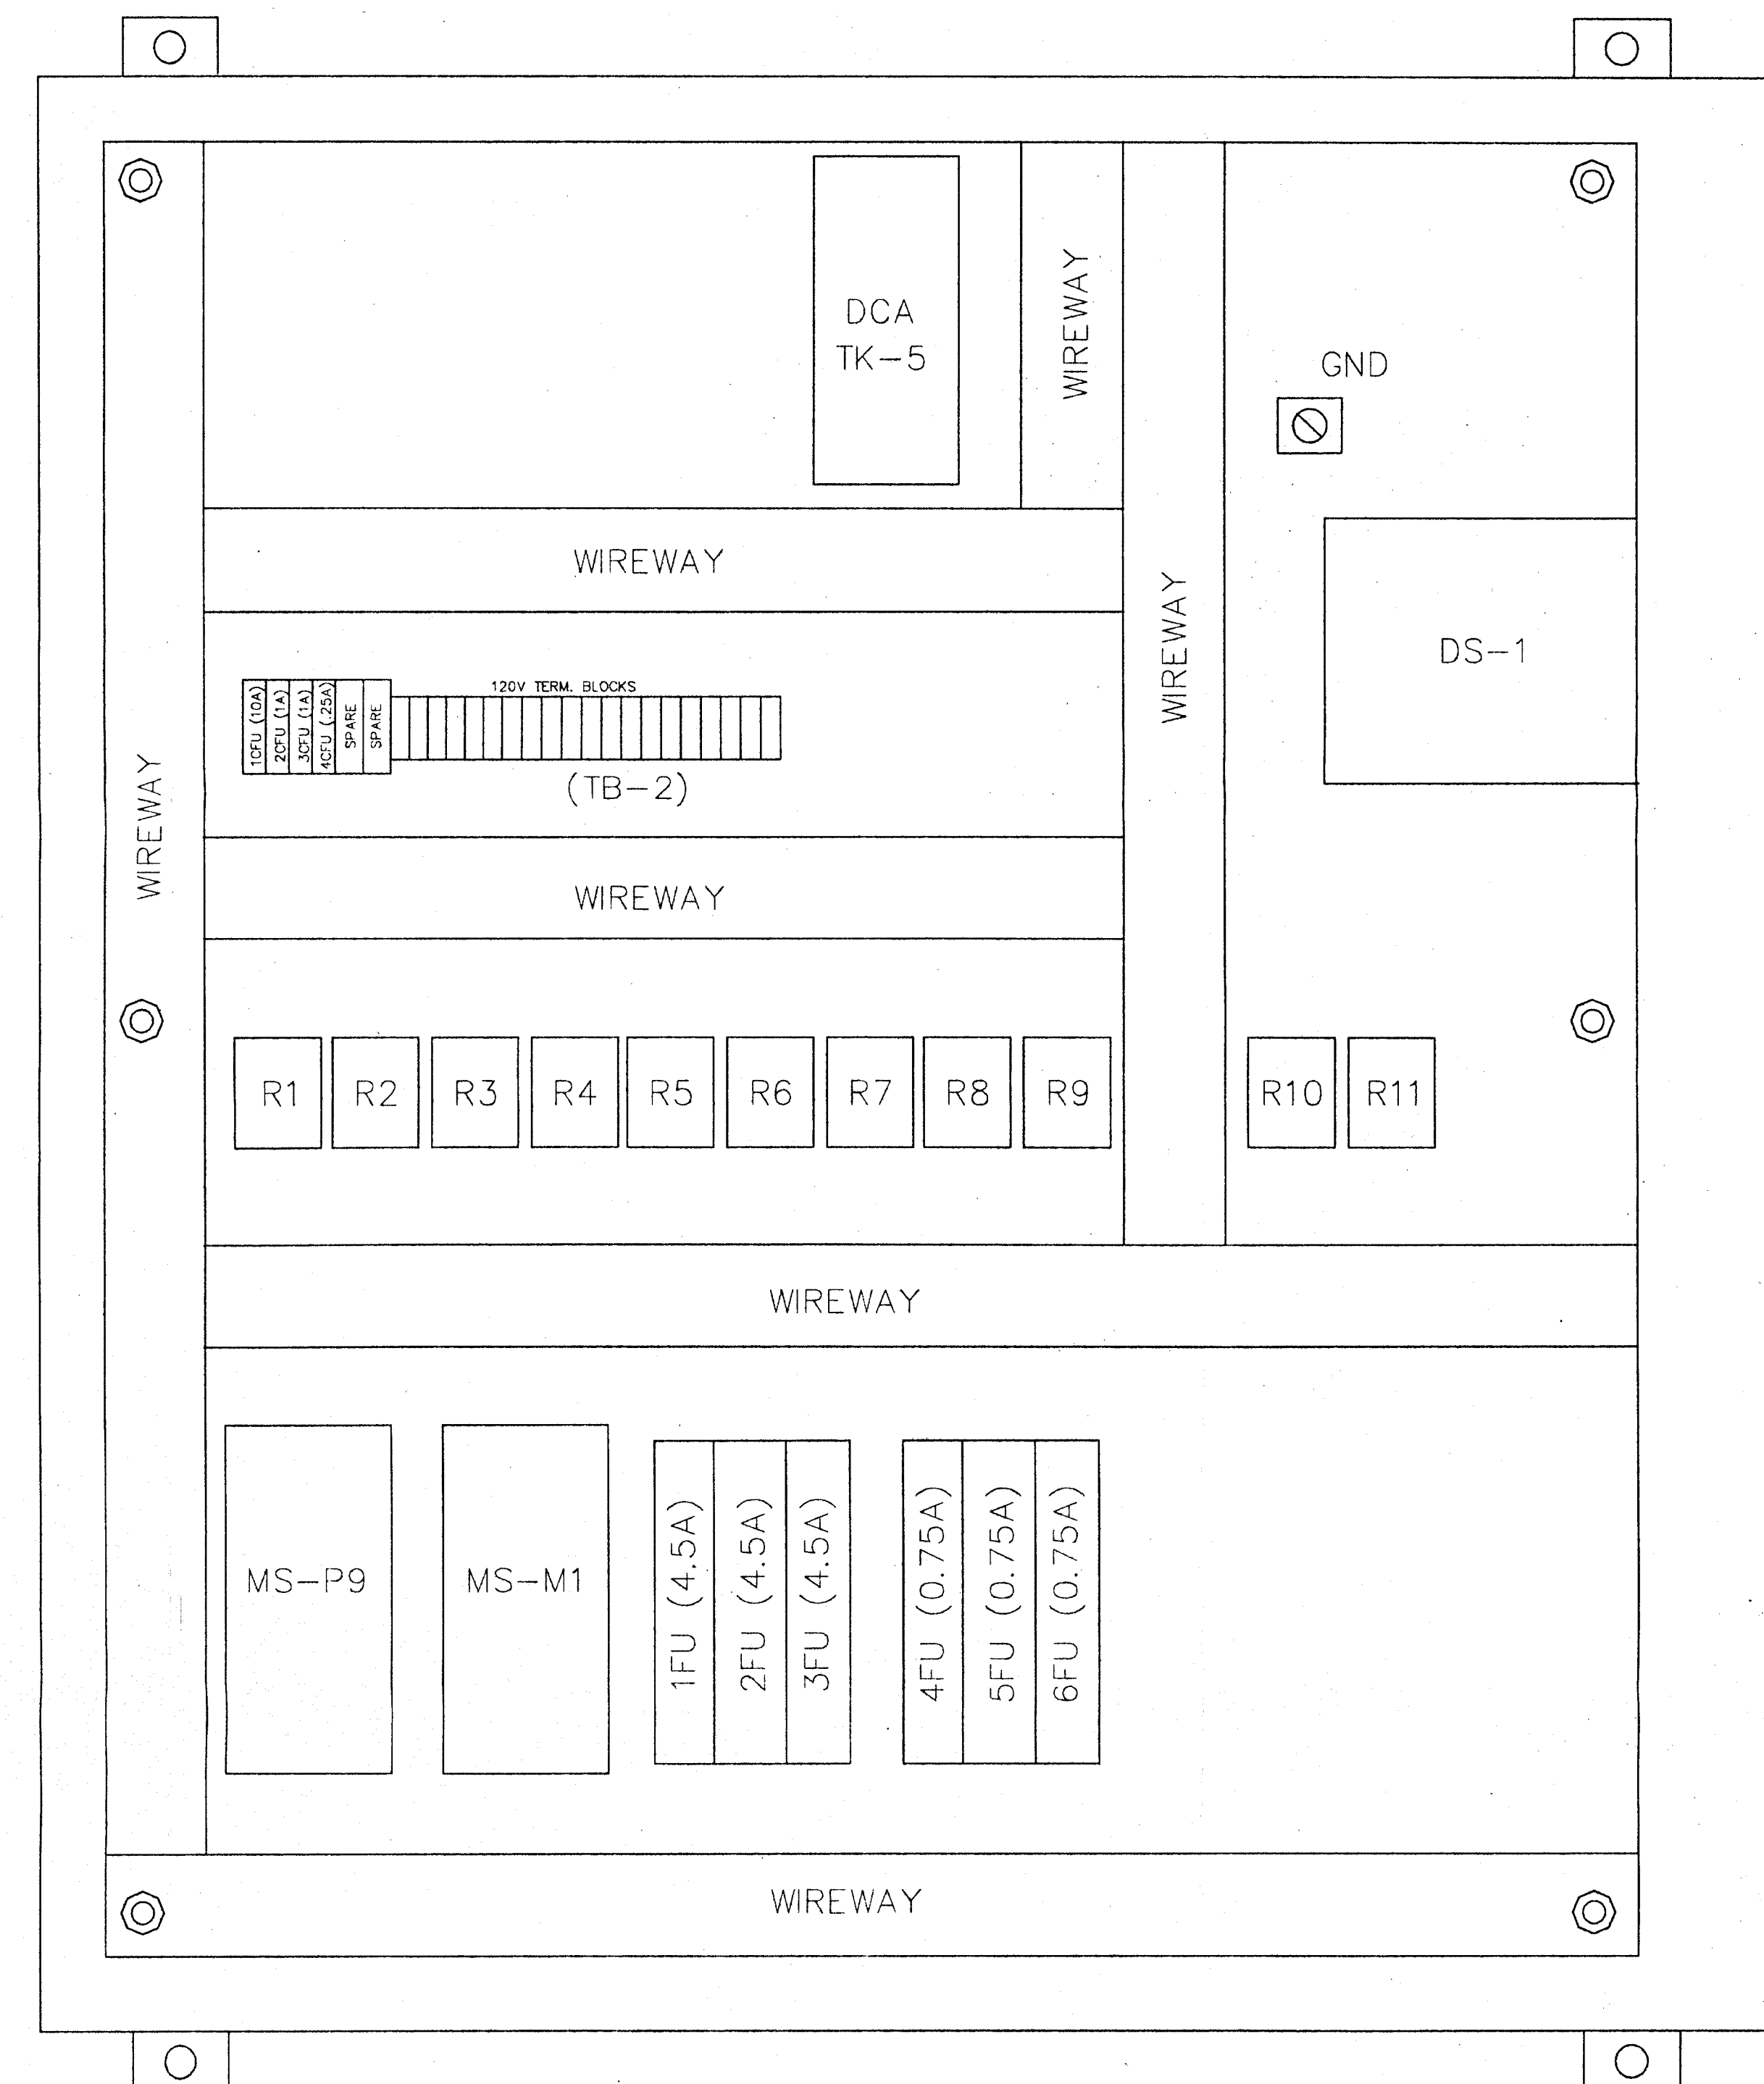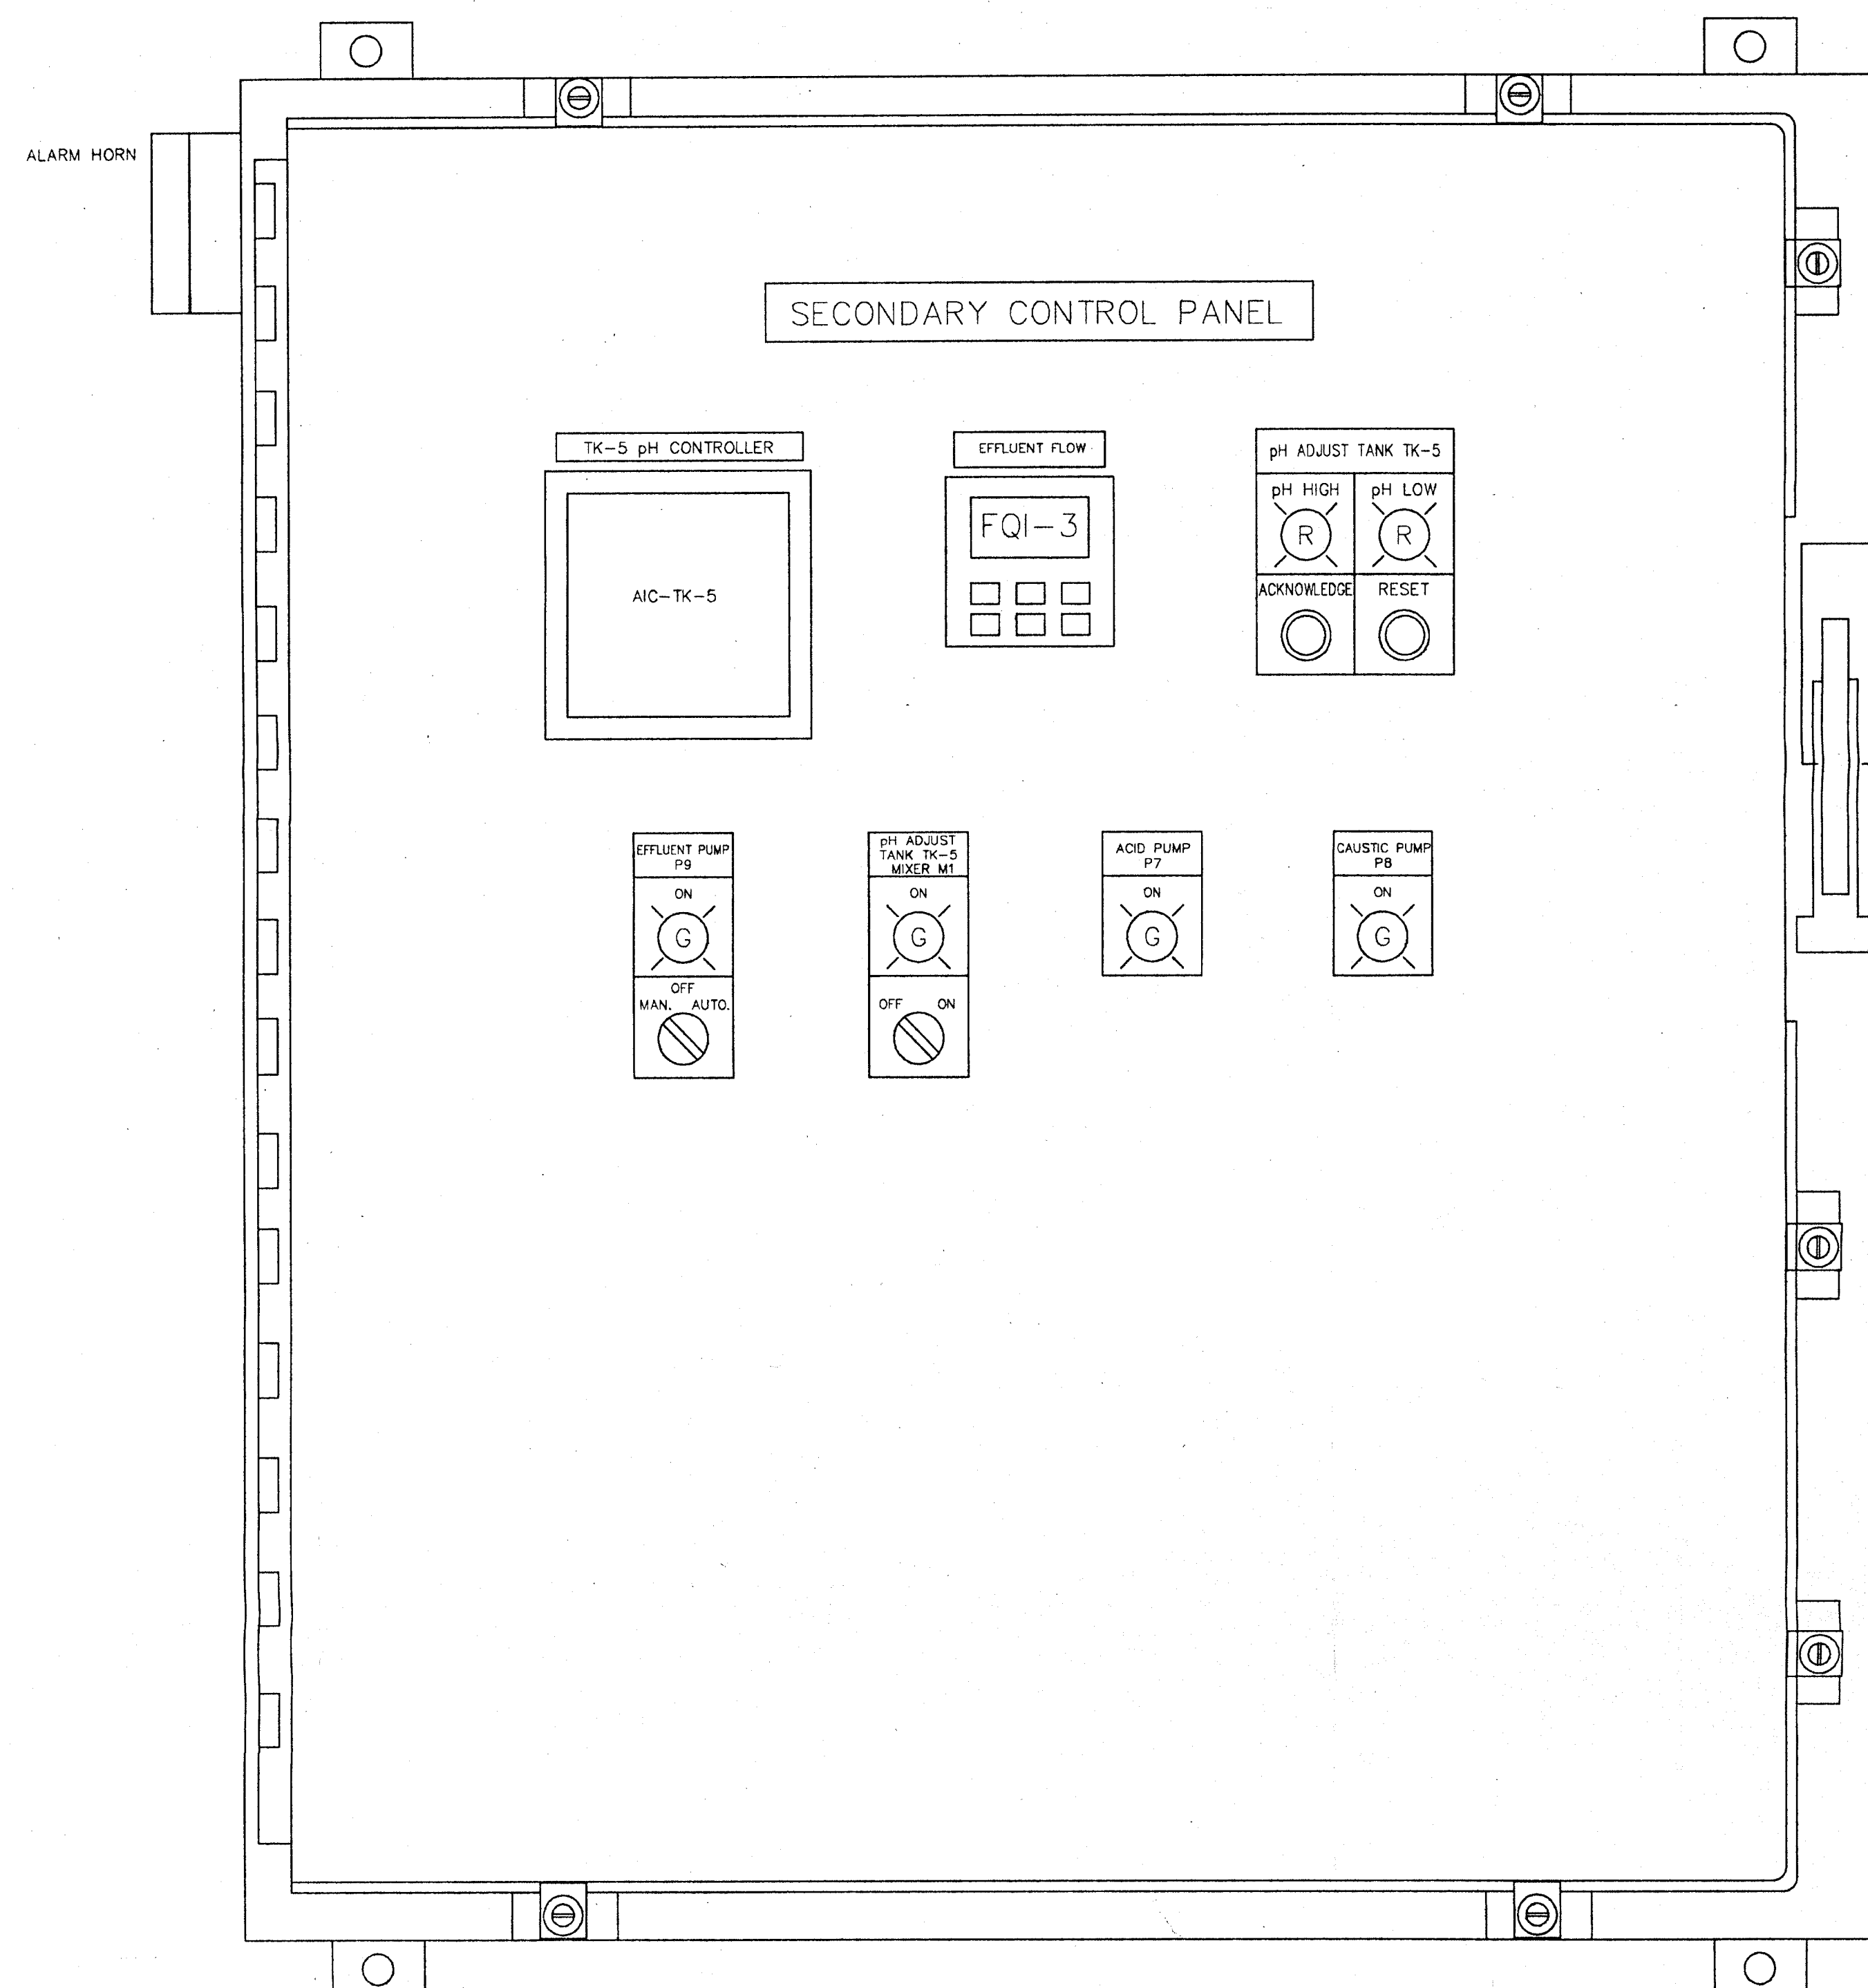


SECONDARY CONTROL PANEL


SIZE: 42" X 37.38" X 12"

								FILE NAME: 0273e011		0273	
								TreatTek - CRA TM COMPANY			
						STR. AND CIVIL MECHANICAL ELECT. & INST. PROCESS PROJECT		MANAGER JMF JMF ACY		ENGR. JMF JMF ACY	
								DATE 1-7-94 1-7-94 1-7-94			
2		AS BUILT		BAB		11-16-94		DRAWN BY J. FLEISCHMAN		DATE 11-5-93	
1		CERTIFIED FOR CONSTRUCTION		BAB		1-10-94		DSGN. CAL BY J. FLEISCHMAN		DATE 11-1-93	
NO.		REVISIONS		DRAWN		CHKD.		APP.		DATE	
								CHECKED BY B.A. BEEBE		DATE 1-7-94	
								SCALE		NONE	
								DWG. D-0273		SHT. 16	

THIS DRAWING INCLUDING THE INFORMATION, DATA AND DESIGN IS THE PROPERTY OF TREATEK - CRA. IT IS NOT TO BE COPIED, REPRODUCED OR ITS CONTENTS DIVULGED WITHOUT THE WRITTEN PERMISSION OF TREATEK - CRA.

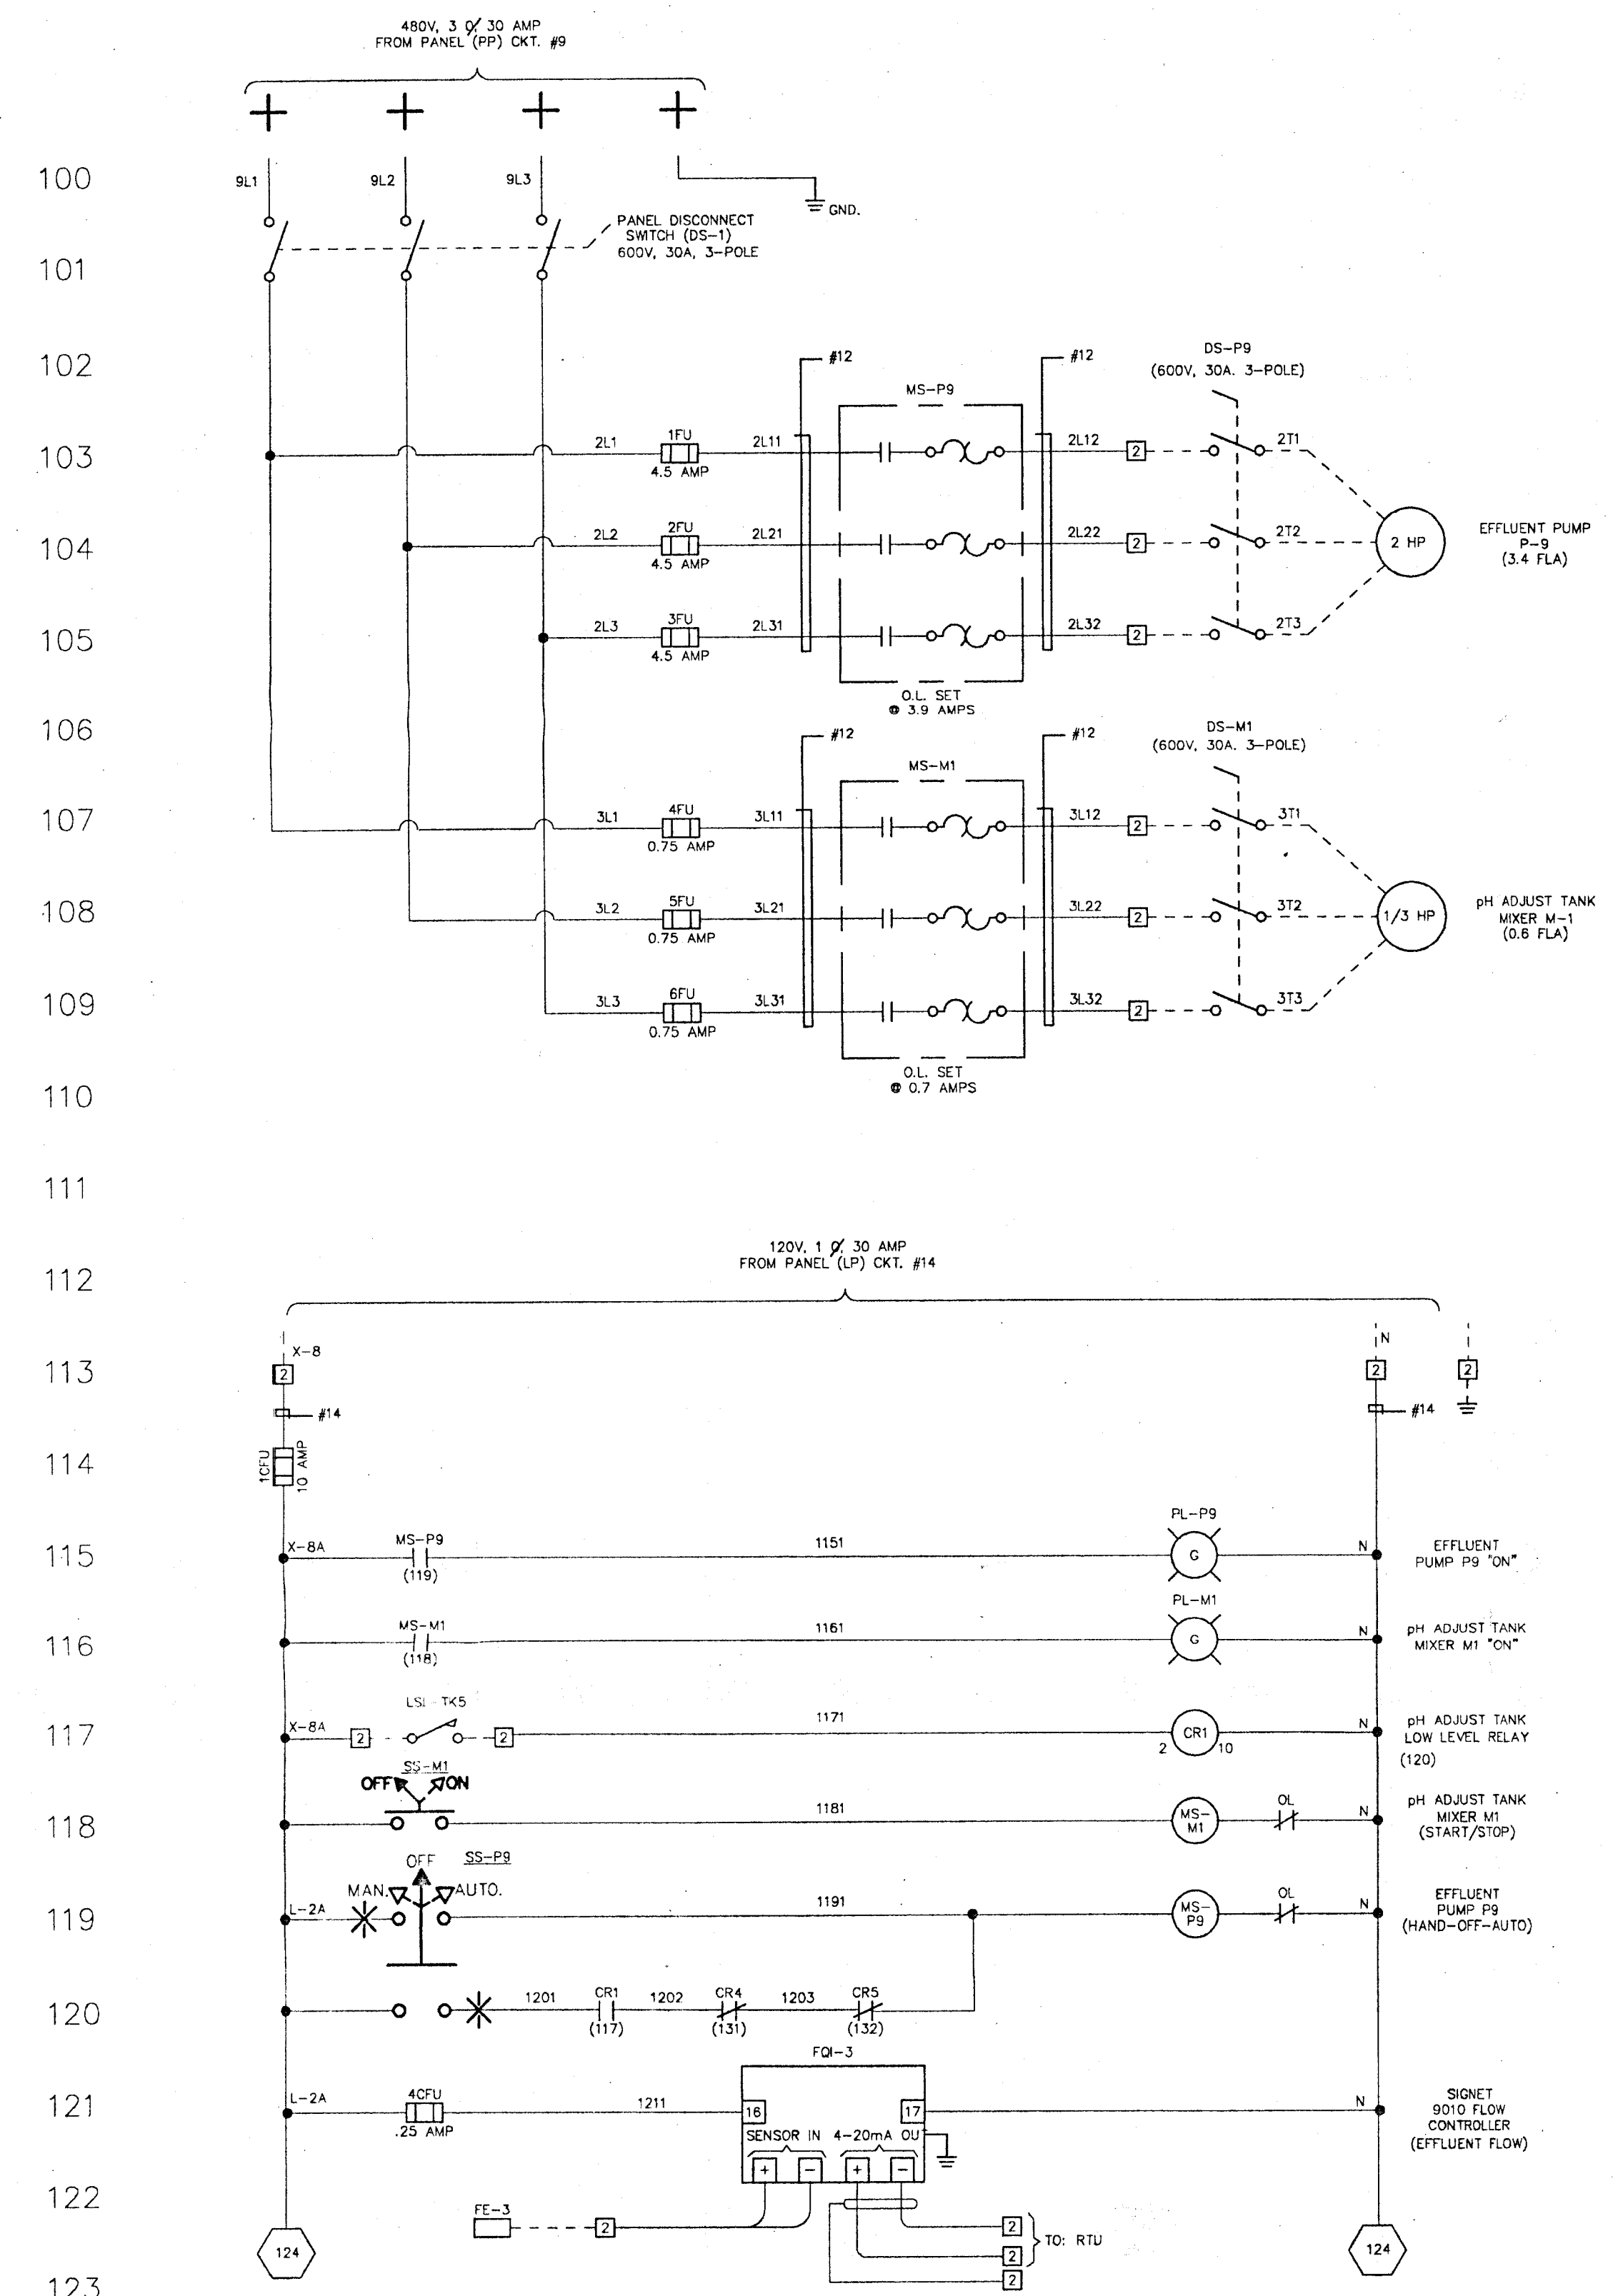

SECONDARY CONTROL PANEL SCHEMATIC

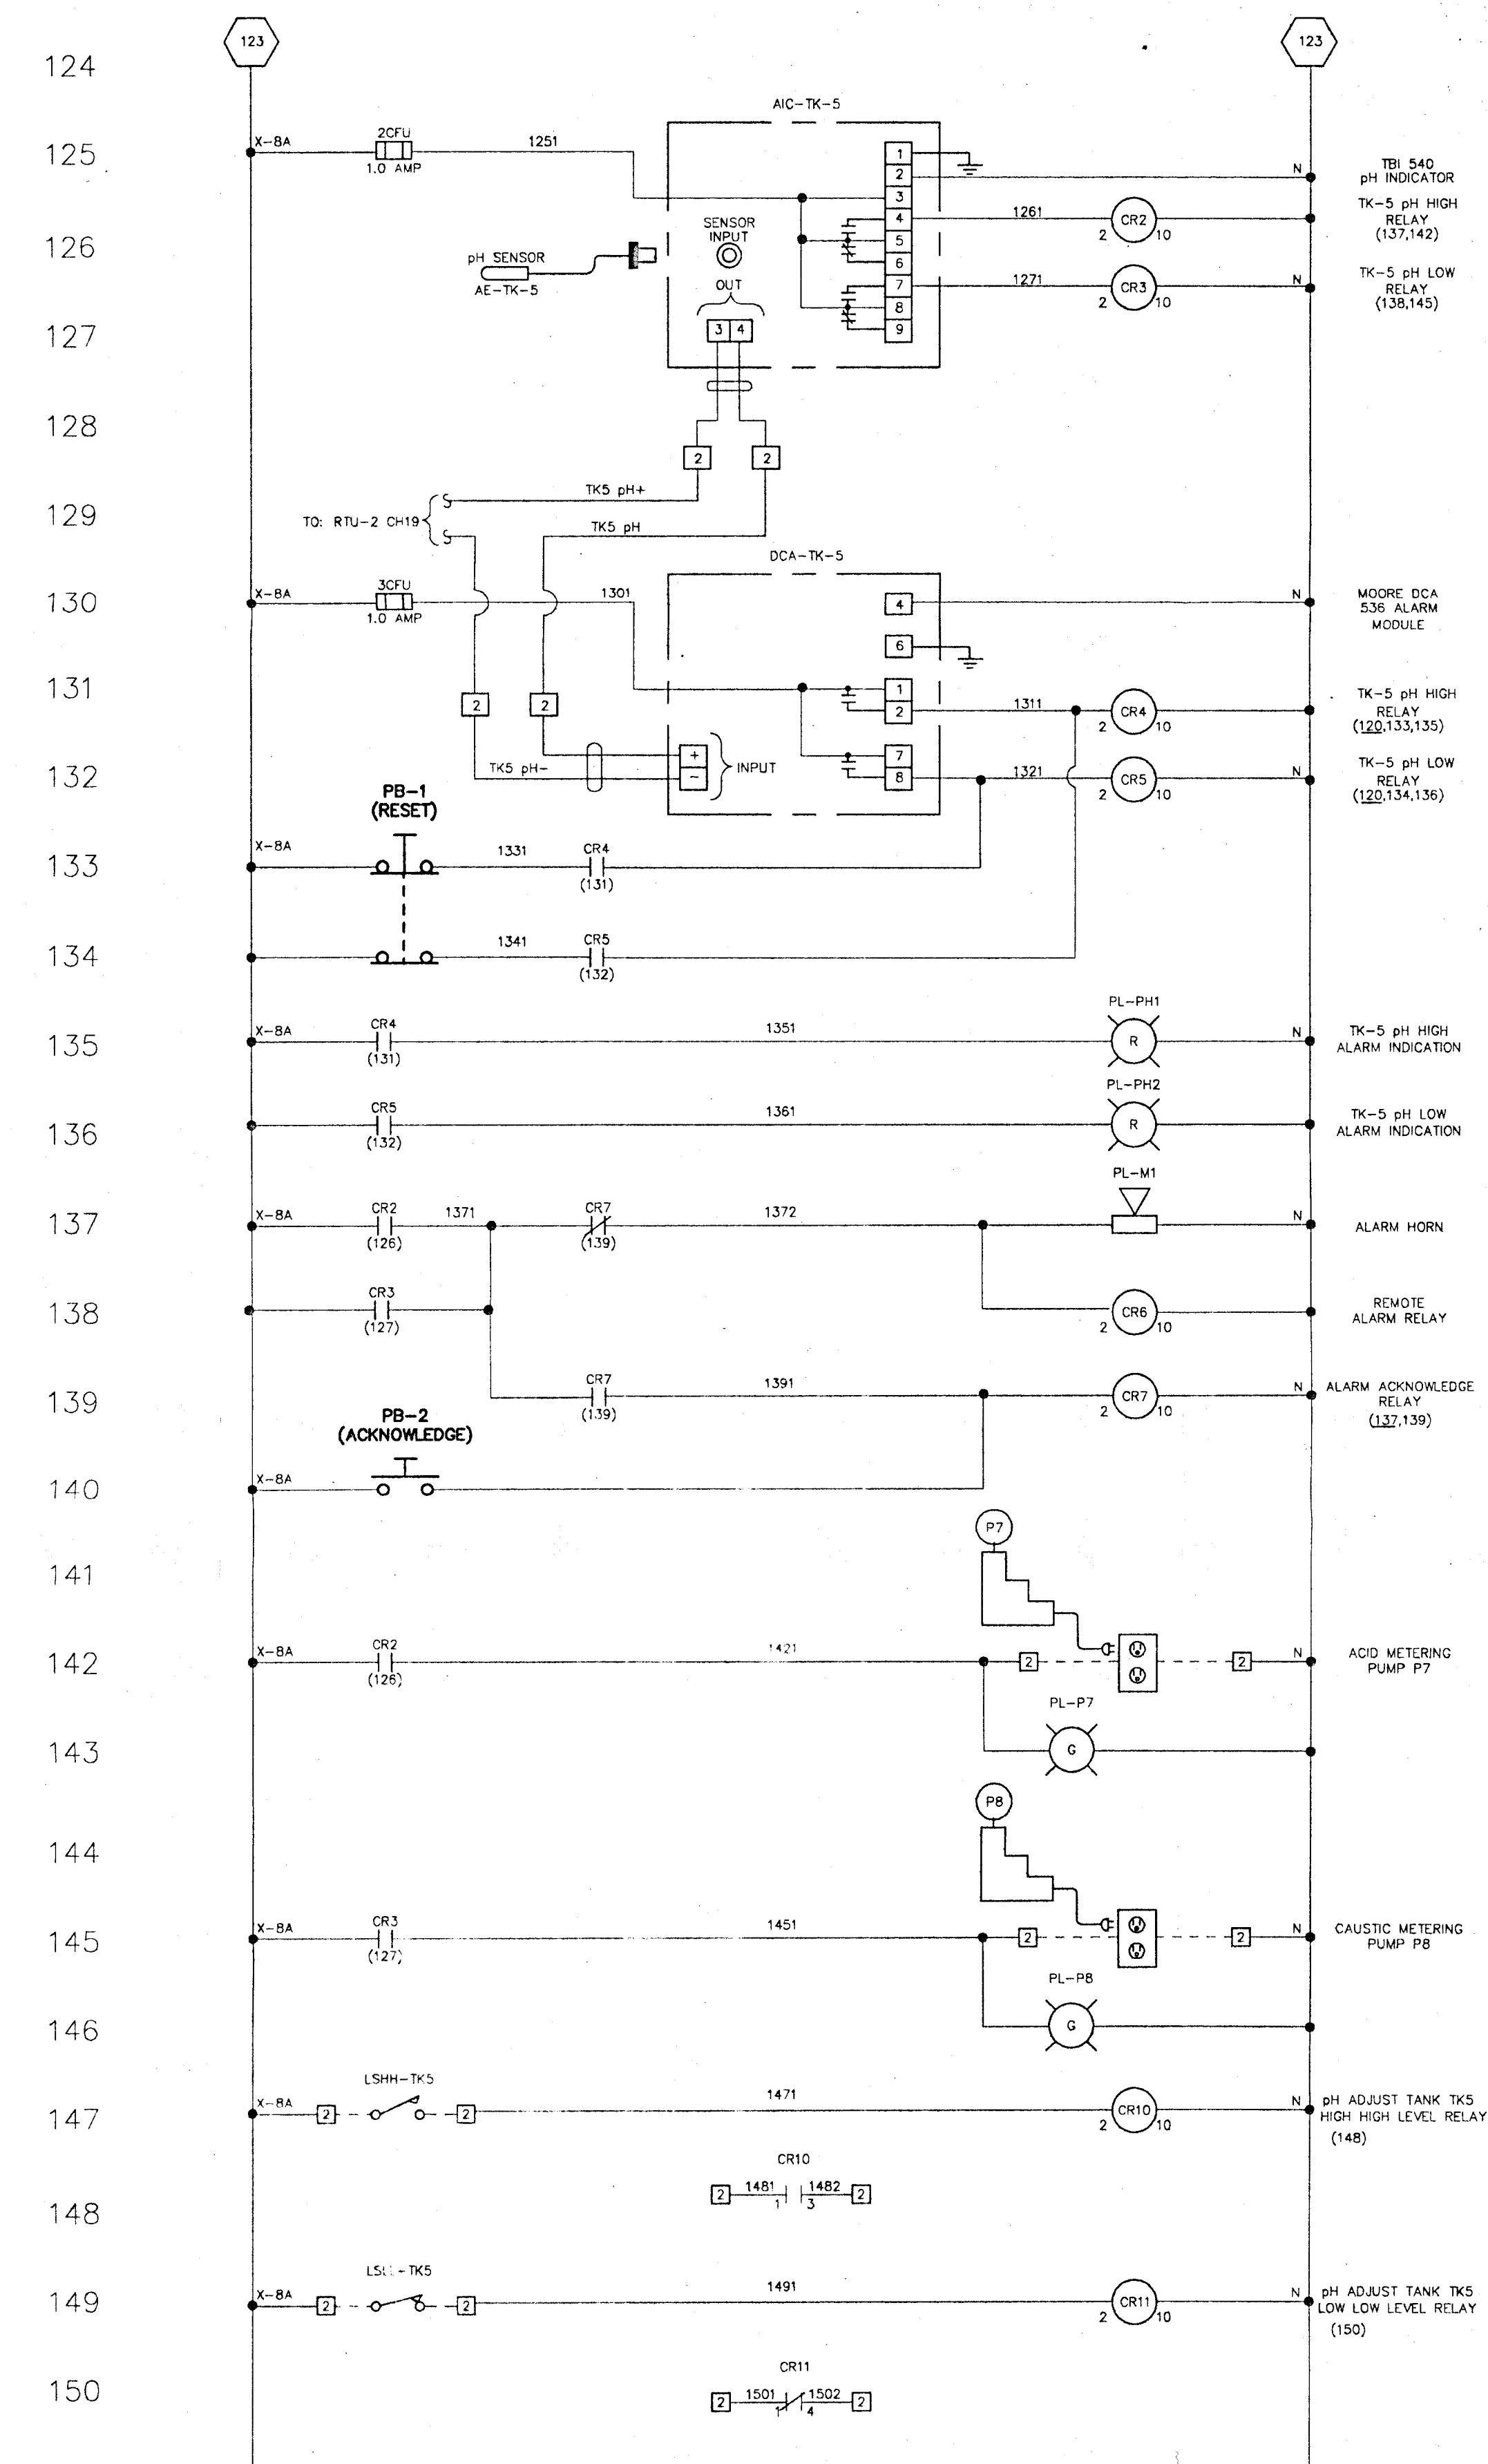

				FILE NAME: 0273e008		0273
				STRAND CIVIL	MANAGER	ENGR.
				ELECT. & INST.	JMF	JMF
				PROCESS	ACY	
				PROJECT		
				DRAWN BY	J. FLEISCHMAN	DATE 11-5-93
				DATE	11-1-93	
				CHECKED BY	B.A. BEEBE	DATE 1-7-94
				SCALE	NONE	
				DWG. D-0273		SHT. 17

THIS DRAWING INCLUDING THE INFORMATION, DATA AND DESIGN IS THE PROPERTY OF TREATEK - CRA. IT IS NOT TO BE COPIED, REPRODUCED OR ITS CONTENTS DIVULGED WITHOUT THE WRITTEN PERMISSION OF TREATEK - CRA.

(LOCATED IN TREATMENT PLANT CONTROL ROOM)

(EW-7 VAULT PANEL)



TAG: LE-7
MFG: KELLER
MODEL: 200S
CAL: RANGE 0-15 PSI
4-20mA = 0-34.5ft.

TAG: LIC-EW-7
MFG: POWERS
MODEL: 535-2112-000000
CAL: 4-20mA = 0-34.5ft.

TAG: FQI-EW-7
MFG: SIGNET
MODEL: 9010
CAL: 4-20mA = 0-20GPM


FIELD WIRING BY CONTRACTOR
(CABLE SUPPLIED WITH SENSOR)

TAG: FE-7
MFG: SIGNET
MODEL: P51530-PO
OUTPUT: 5-6 Hz PER FT./SEC.
RANGE: 1-30 FT./SEC.

THIS DRAWING INCLUDING THE INFORMATION, DATA AND DESIGN IS THE PROPERTY OF TREATEK - CRA. IT IS NOT TO BE COPIED, REPRODUCED OR ITS CONTENTS DIVULGED WITHOUT THE WRITTEN PERMISSION OF TREATEK - CRA.

RTU-1&2
(LOCATED IN TREATMENT PLANT CONTROL ROOM)

EW-8
(EW-8 VAULT PANEL)

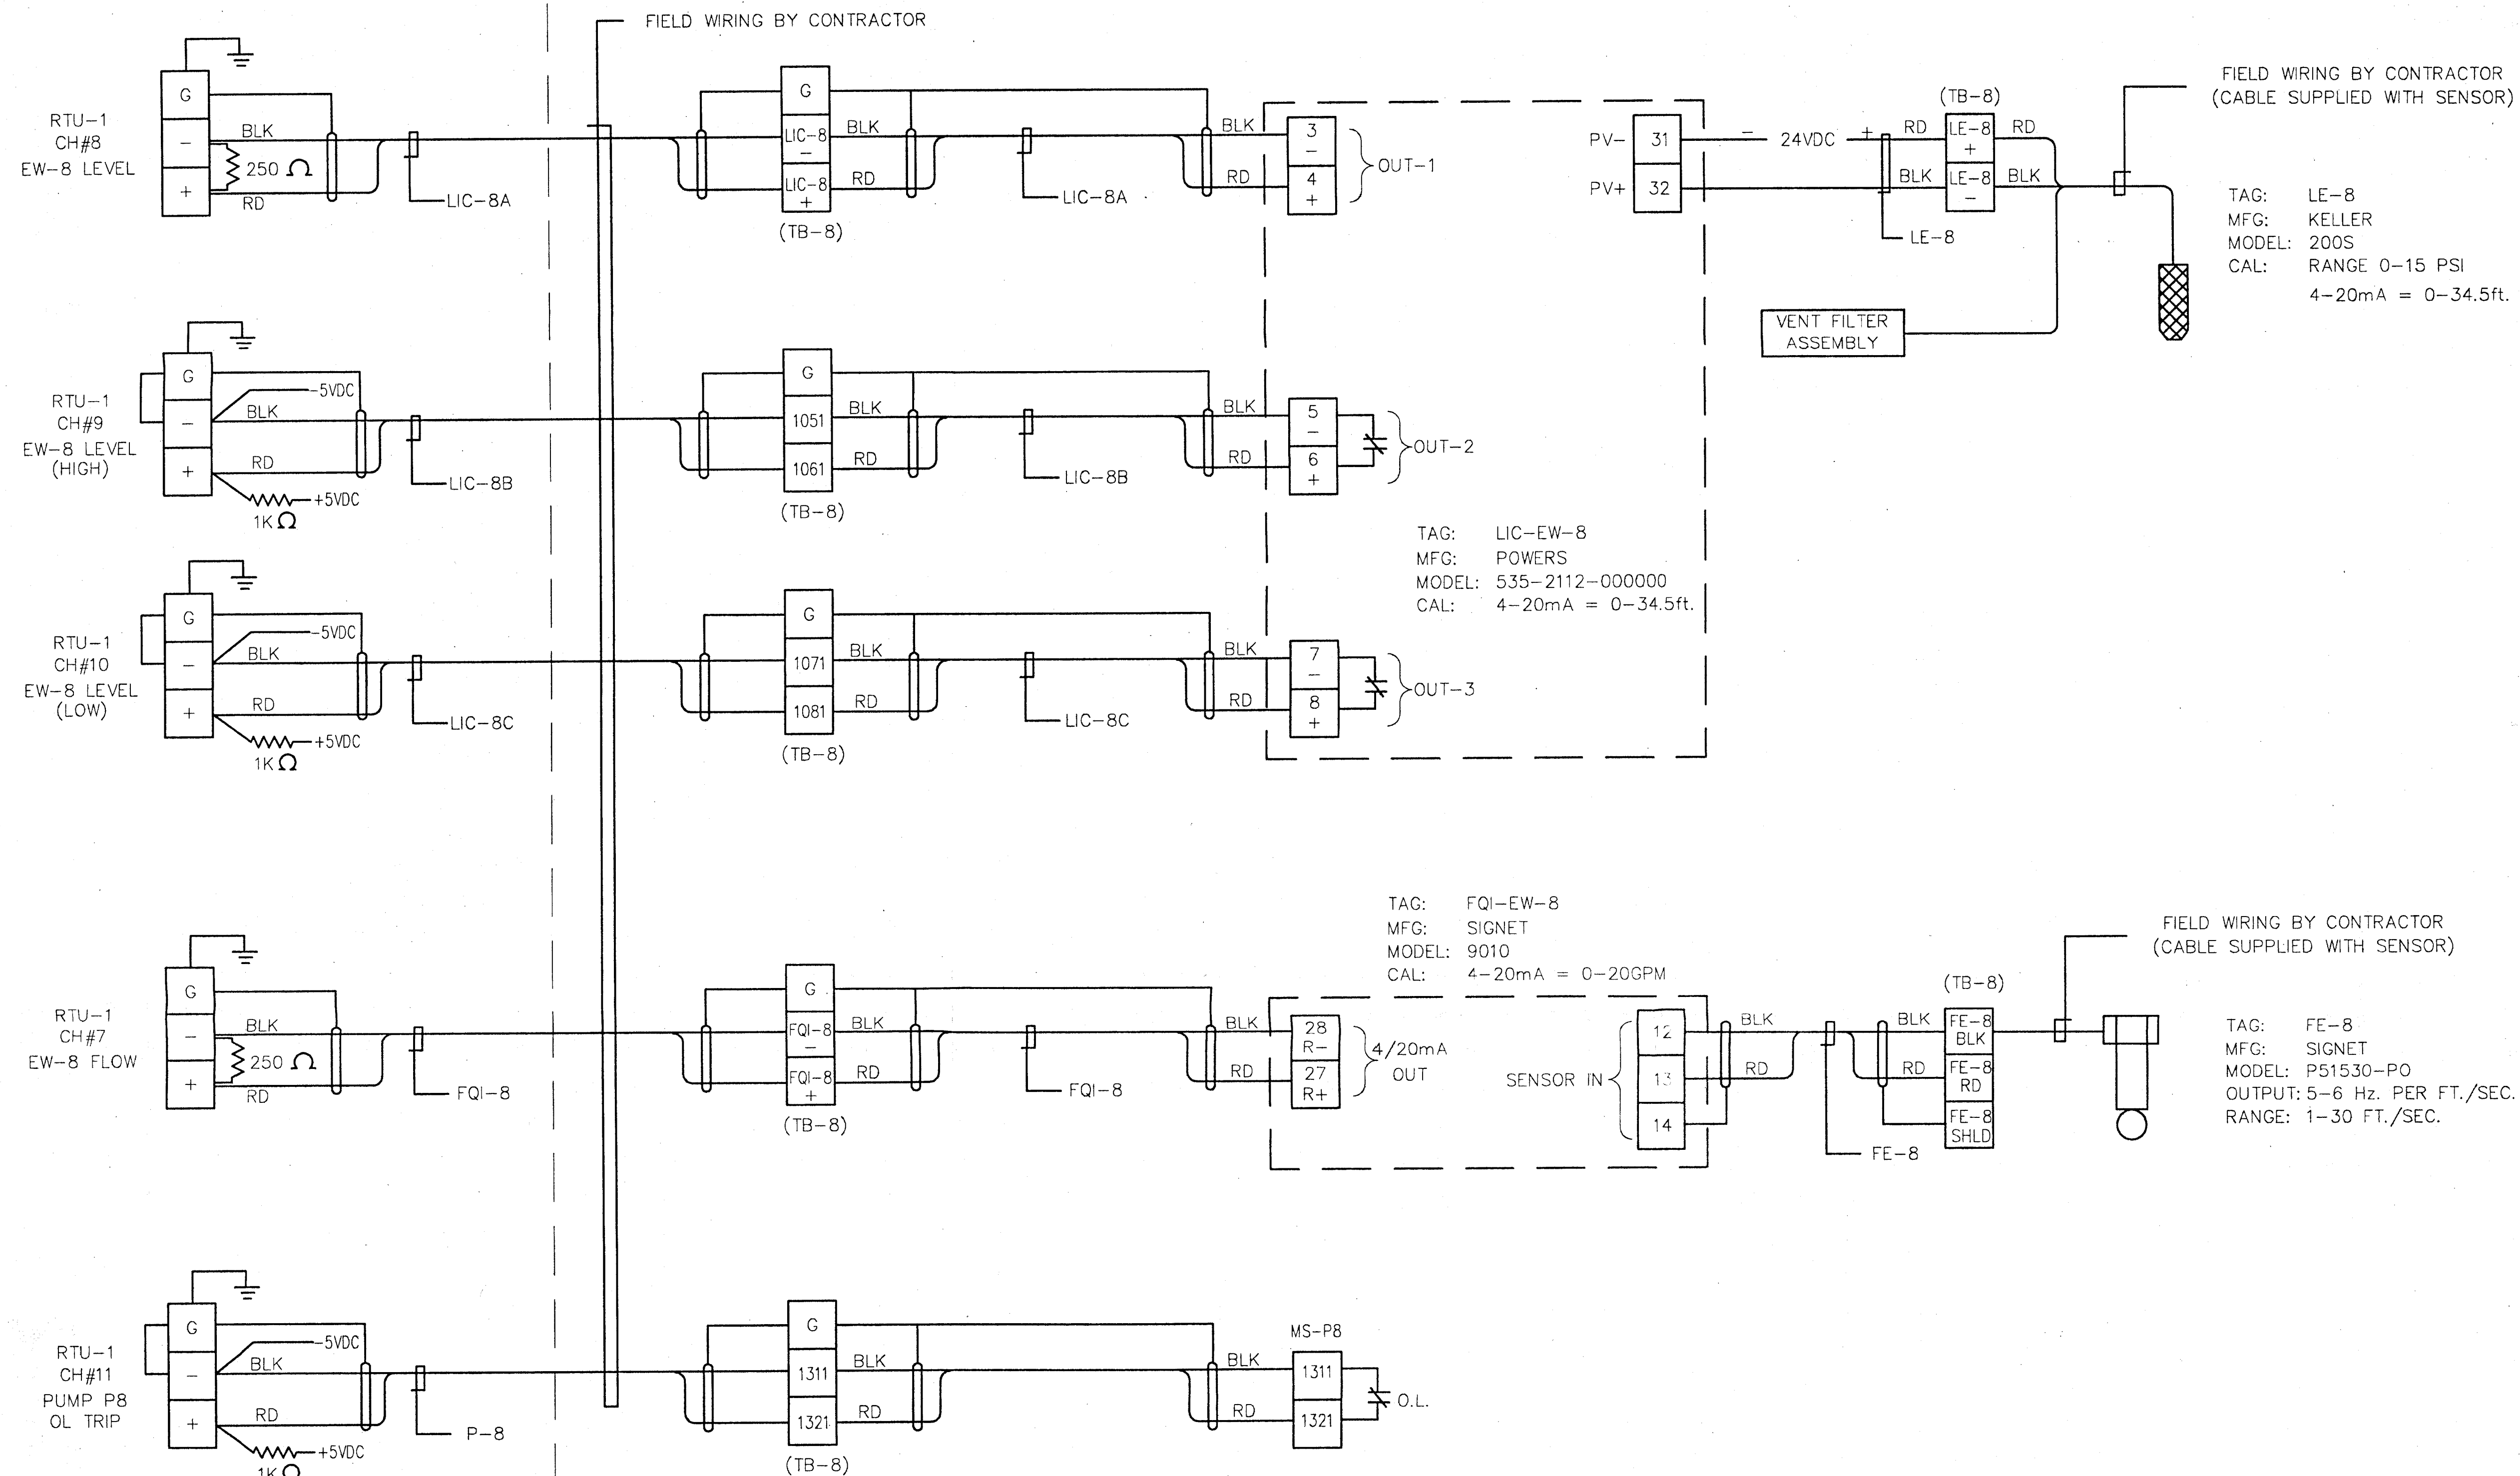

																		FILE NAME: 0273e019				0273			
																						TreatTek - CRATM COMPANY			
																						BELL AEROSPACE TEXTRON GROUNDWATER TREATMENT PLANT RTU WIRING (EW-8)			
																						SCALE			
																						DWG. D-0273			
																						SHT. 19			


																		FILE NAME: 0273e019				0273			
																						TreatTek - CRATM COMPANY			
																						BELL AEROSPACE TEXTRON GROUNDWATER TREATMENT PLANT RTU WIRING (EW-8)			
																						SCALE			
																						DWG. D-0273			
																						SHT. 19			

																		FILE NAME: 0273e019				0273			
																						TreatTek - CRATM COMPANY			
																						BELL AEROSPACE TEXTRON GROUNDWATER TREATMENT PLANT RTU WIRING (EW-8)			
																						SCALE			
																						DWG. D-0273			
																						SHT. 19			

THIS DRAWING INCLUDING THE INFORMATION, DATA AND DESIGN IS THE PROPERTY OF TREATEK - CRA. IT IS NOT TO BE COPIED, REPRODUCED OR ITS CONTENTS DIVULGED WITHOUT THE WRITTEN PERMISSION OF TREATEK - CRA.

RTU-1&2
(LOCATED IN TREATMENT PLANT CONTROL ROOM)

DW-9
(DW-9 VAULT PANEL)

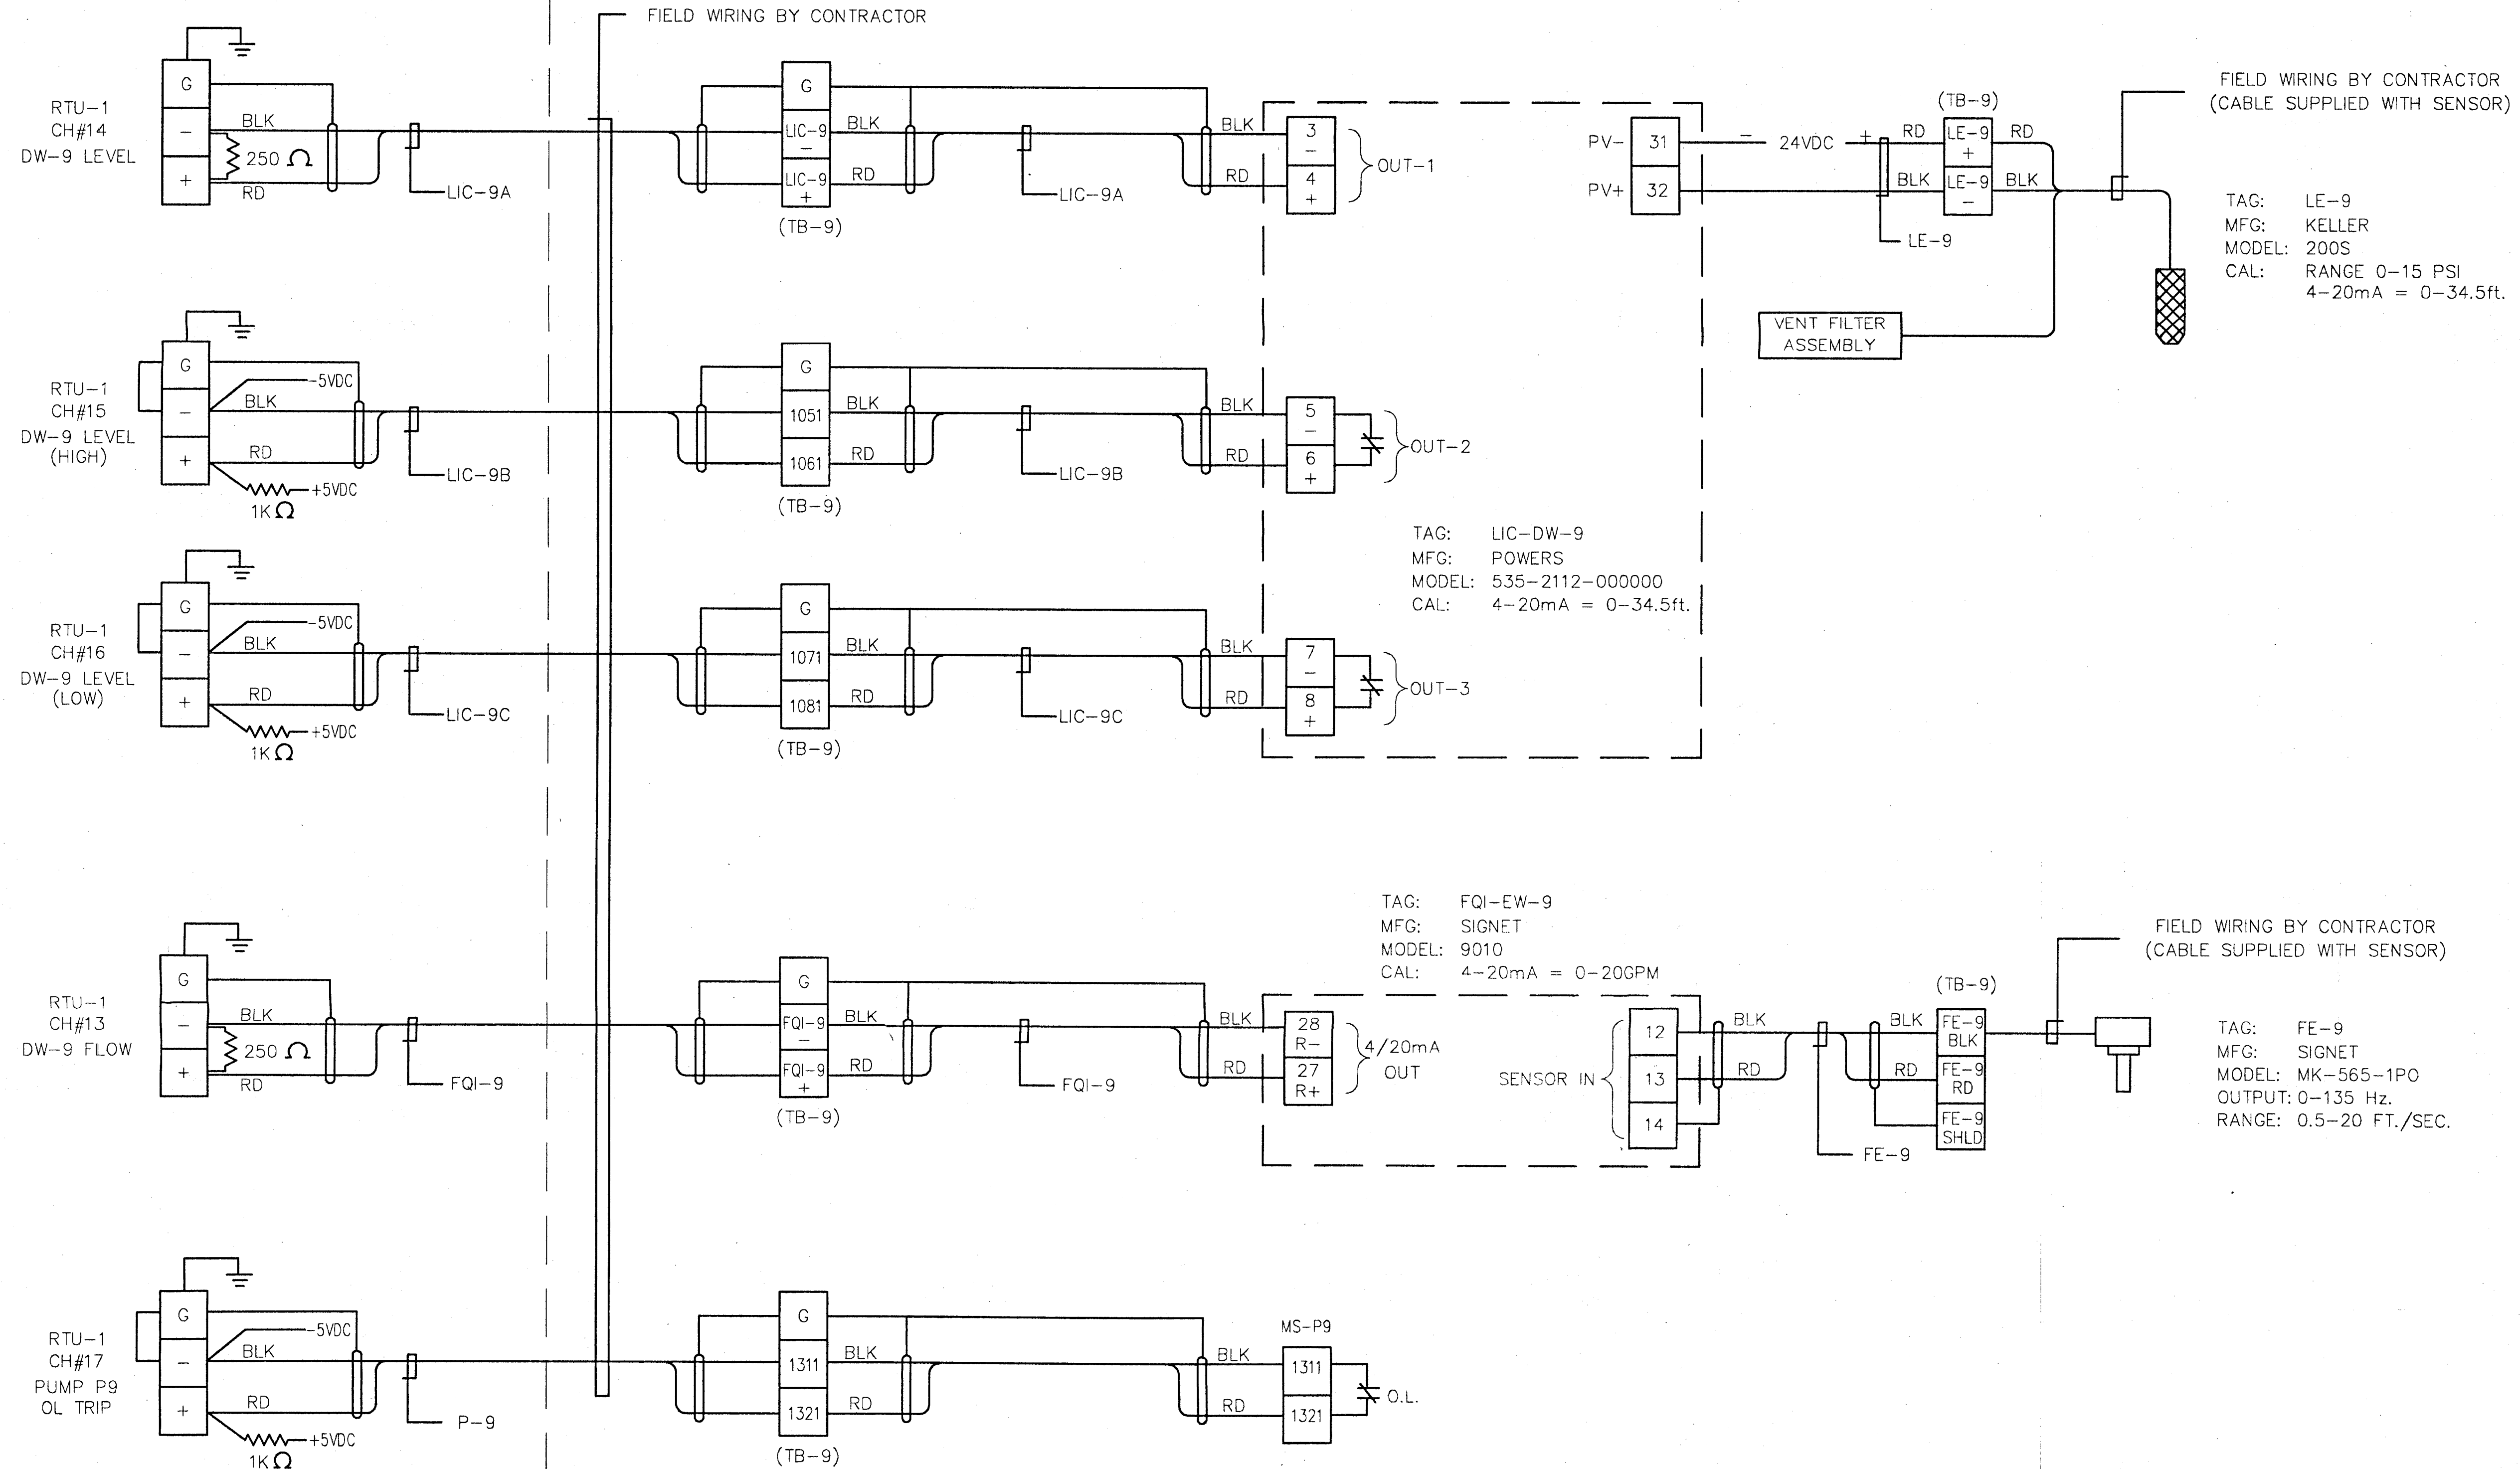

REVISIONS				REVISIONS				REVISIONS			
NO.	DATE	APP.	CHKD.	DRAWN	NO.	DATE	APP.	CHKD.	DRAWN	NO.	DATE
4	AS BUILT				4	AS BUILT				4	AS BUILT
3	GENERAL REVISION				3	GENERAL REVISION				3	GENERAL REVISION
2	CERTIFIED FOR CONSTRUCTION				2	CERTIFIED FOR CONSTRUCTION				2	CERTIFIED FOR CONSTRUCTION
1	SUBMITTAL REVIEW REVISION				1	SUBMITTAL REVIEW REVISION				1	SUBMITTAL REVIEW REVISION


APPROVAL				MANAGER				ENGR.				DATE			
STR. AND CIVIL	MECHANICAL	ELECT. & INST.	PROCESS	MANAGER	ENGR.	DATE	MANAGER	ENGR.	DATE	MANAGER	ENGR.	DATE	MANAGER	ENGR.	DATE
				JMF	JMF	1-7-94									
				ACY		1-7-94									
DRAWN BY J. FLEISCHMAN				DATE 11/30/93				CHECKED BY B.A. BEEBE				DATE 1-7-94			

FILE NAME: 0273e020	0273
Treatek - CRA COMPANY	
BELL AEROSPACE TEXTRON GROUNDWATER TREATMENT PLANT	
RTU WIRING (DW-9)	
SCALE	DWG. D-0263 SHT. 20

THIS DRAWING INCLUDING THE INFORMATION, DATA AND DESIGN IS THE PROPERTY OF TREATEK - CRA. IT IS NOT TO BE COPIED, REPRODUCED OR ITS CONTENTS DIVULGED WITHOUT THE WRITTEN PERMISSION OF TREATEK - CRA.

RTU-1&2
(LOCATED IN TREATMENT PLANT CONTROL ROOM)

DW-10
(DW-10 VAULT PANEL)

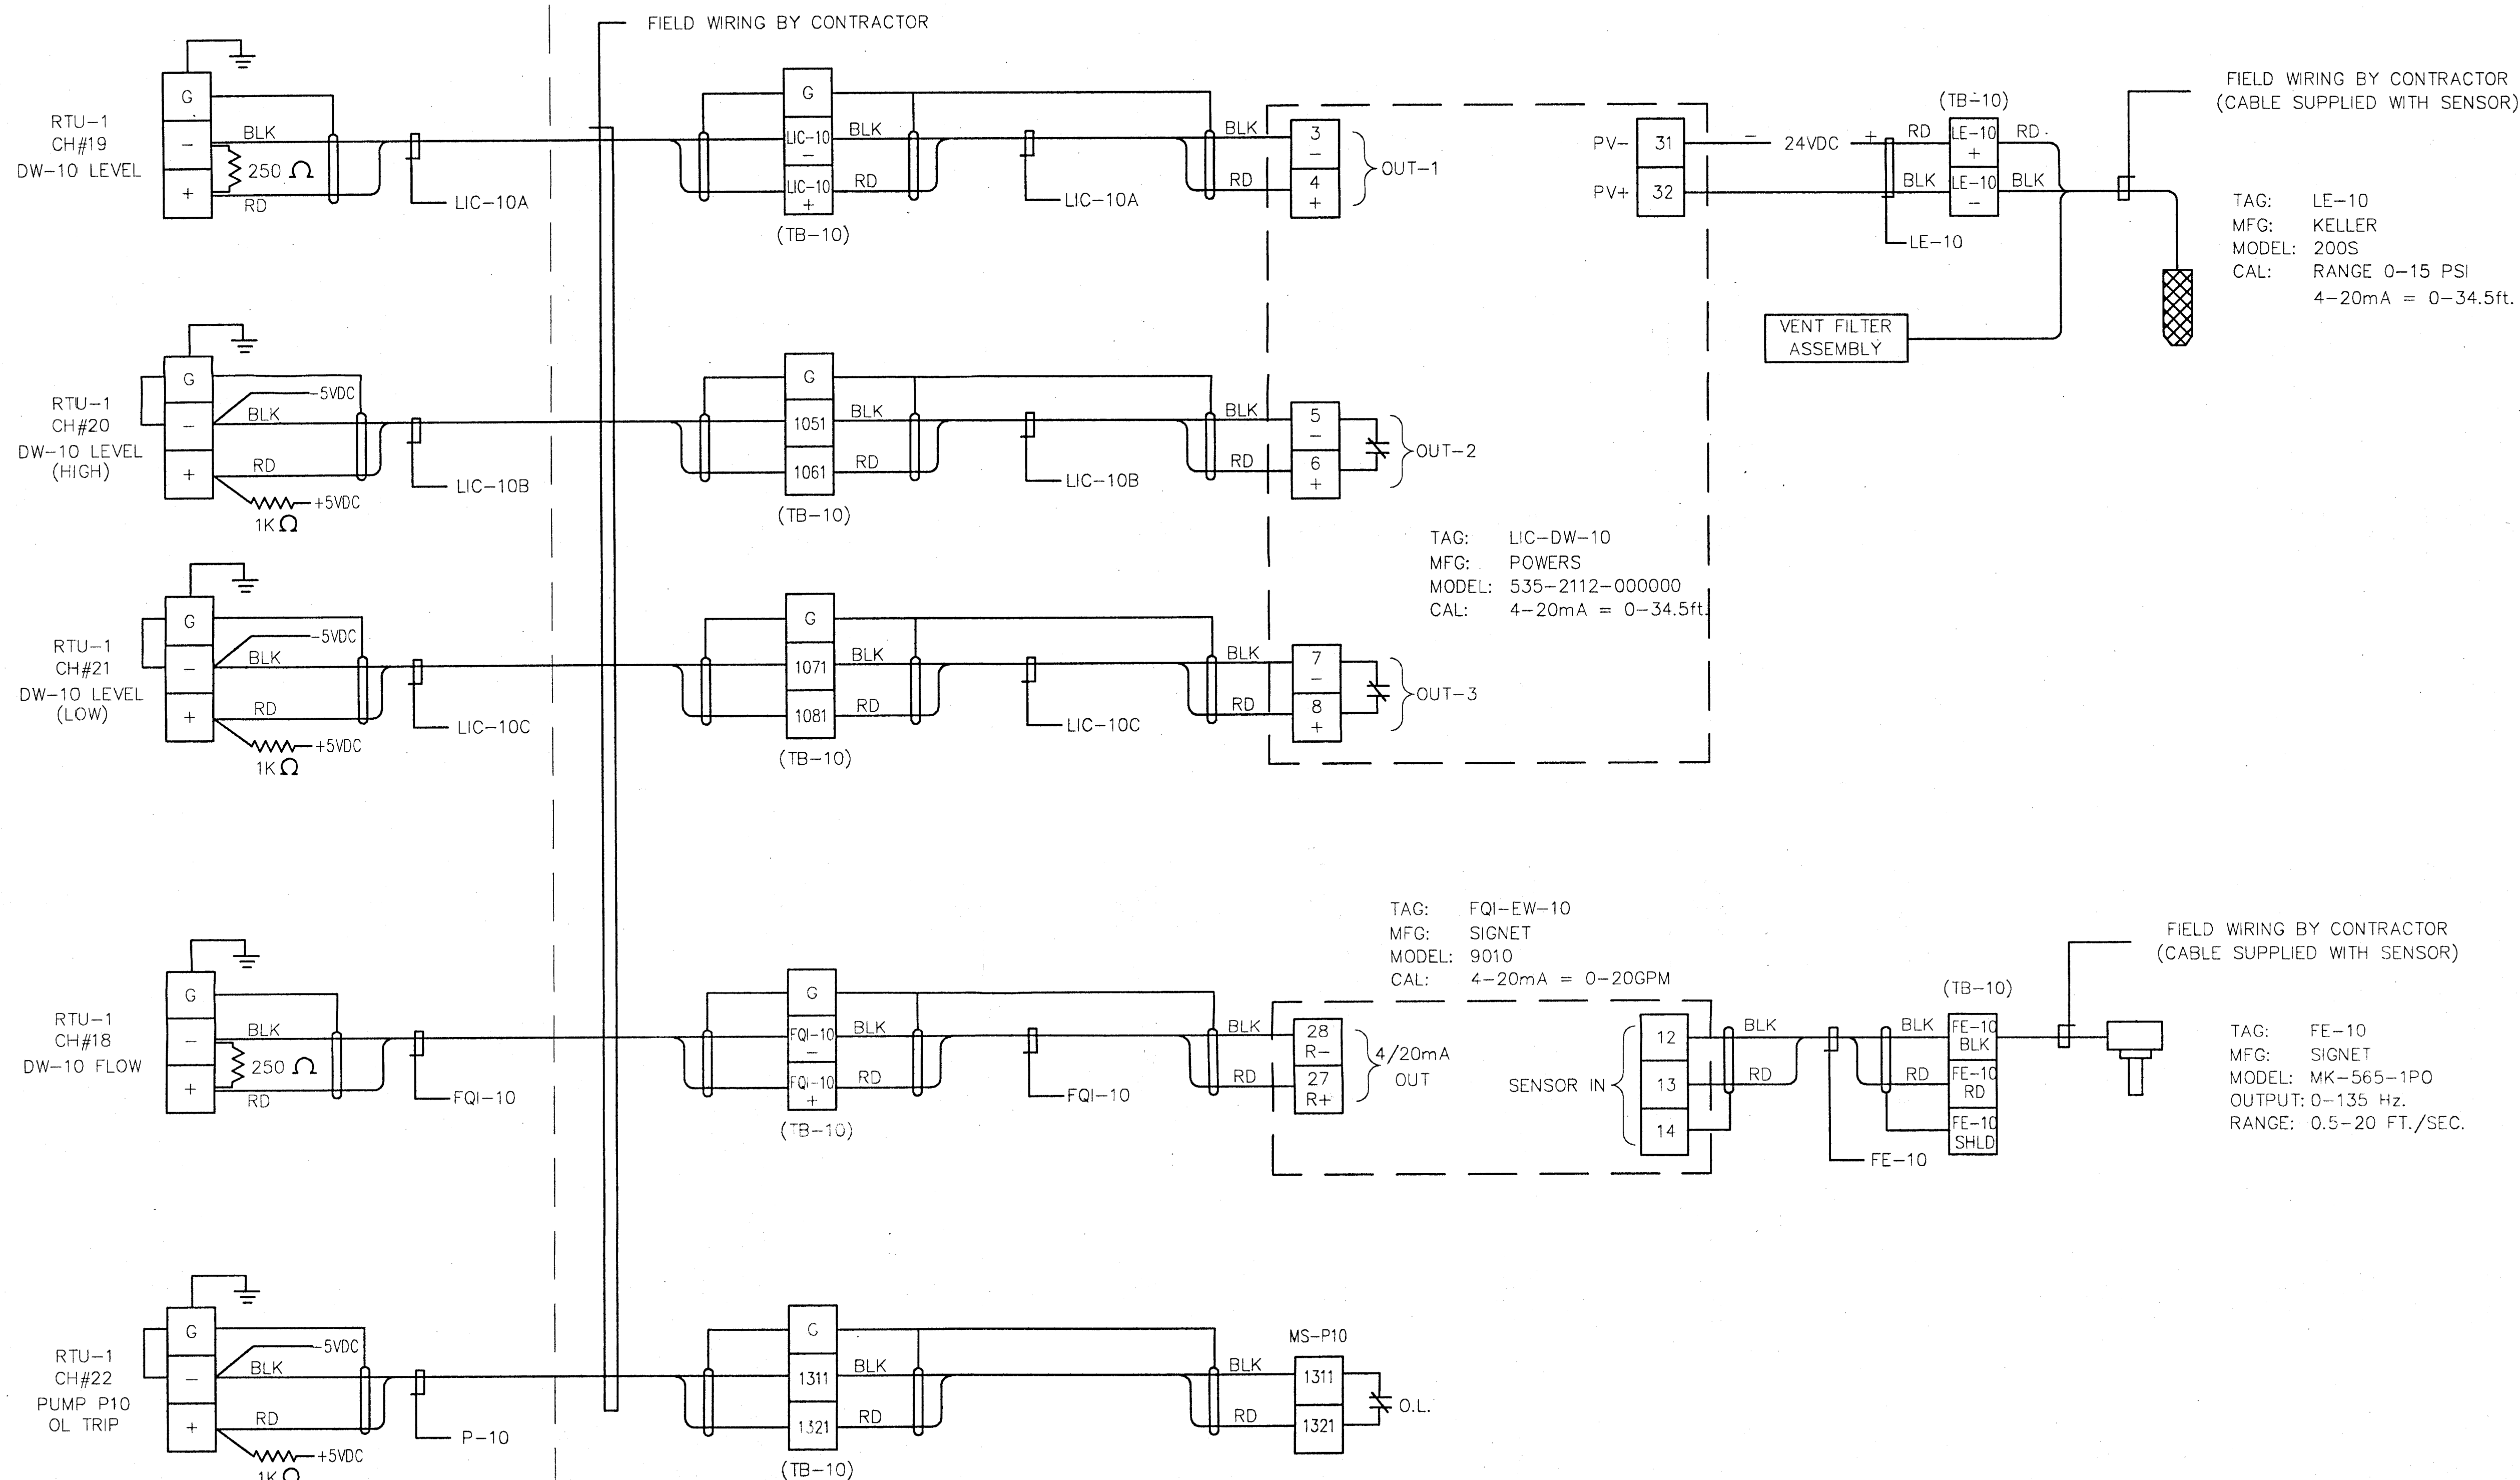

REVISIONS					REVISIONS					REVISIONS				
NO.	DATE	APP.	CHKD.	DRAWN	NO.	DATE	APP.	CHKD.	DRAWN	NO.	DATE	APP.	CHKD.	DRAWN
4	11-16-94				4	11-16-94				4	11-16-94			
3	4-6-94				3	4-6-94				3	4-6-94			
2	1-10-94				2	1-10-94				2	1-10-94			
1	1-7-94				1	1-7-94				1	1-7-94			


APPROVAL	MANAGER	ENGR.	DATE
STRAND CIVIL			
ELECT. & INST.	JMF	JMF	1-7-94
PROJECT	ACY		1-7-94
DRAWN BY	J. FLEISCHMAN	DATE	11/30/93
DSGN. CAL. BY	J. FLEISCHMAN	DATE	11/30/93
CHECKED BY	B.A. BEEBE	DATE	1-7-94

FILE NAME:	0273e021	0273
Treatek - CRA COMPANY		
BELL AEROSPACE TEXTRON GROUNDWATER TREATMENT PLANT RTU WIRING (DW-10)		
SCALE	DWG. D-0273	SHT. 21

THIS DRAWING INCLUDING THE INFORMATION, DATA AND DESIGN IS THE PROPERTY OF TREATEK - CRA. IT IS NOT TO BE COPIED, REPRODUCED OR ITS CONTENTS DIVULGED WITHOUT THE WRITTEN PERMISSION OF TREATEK - CRA.

(LOCATED IN TREATMENT PLANT CONTROL ROOM)


(DW-11 VAULT PANEL)

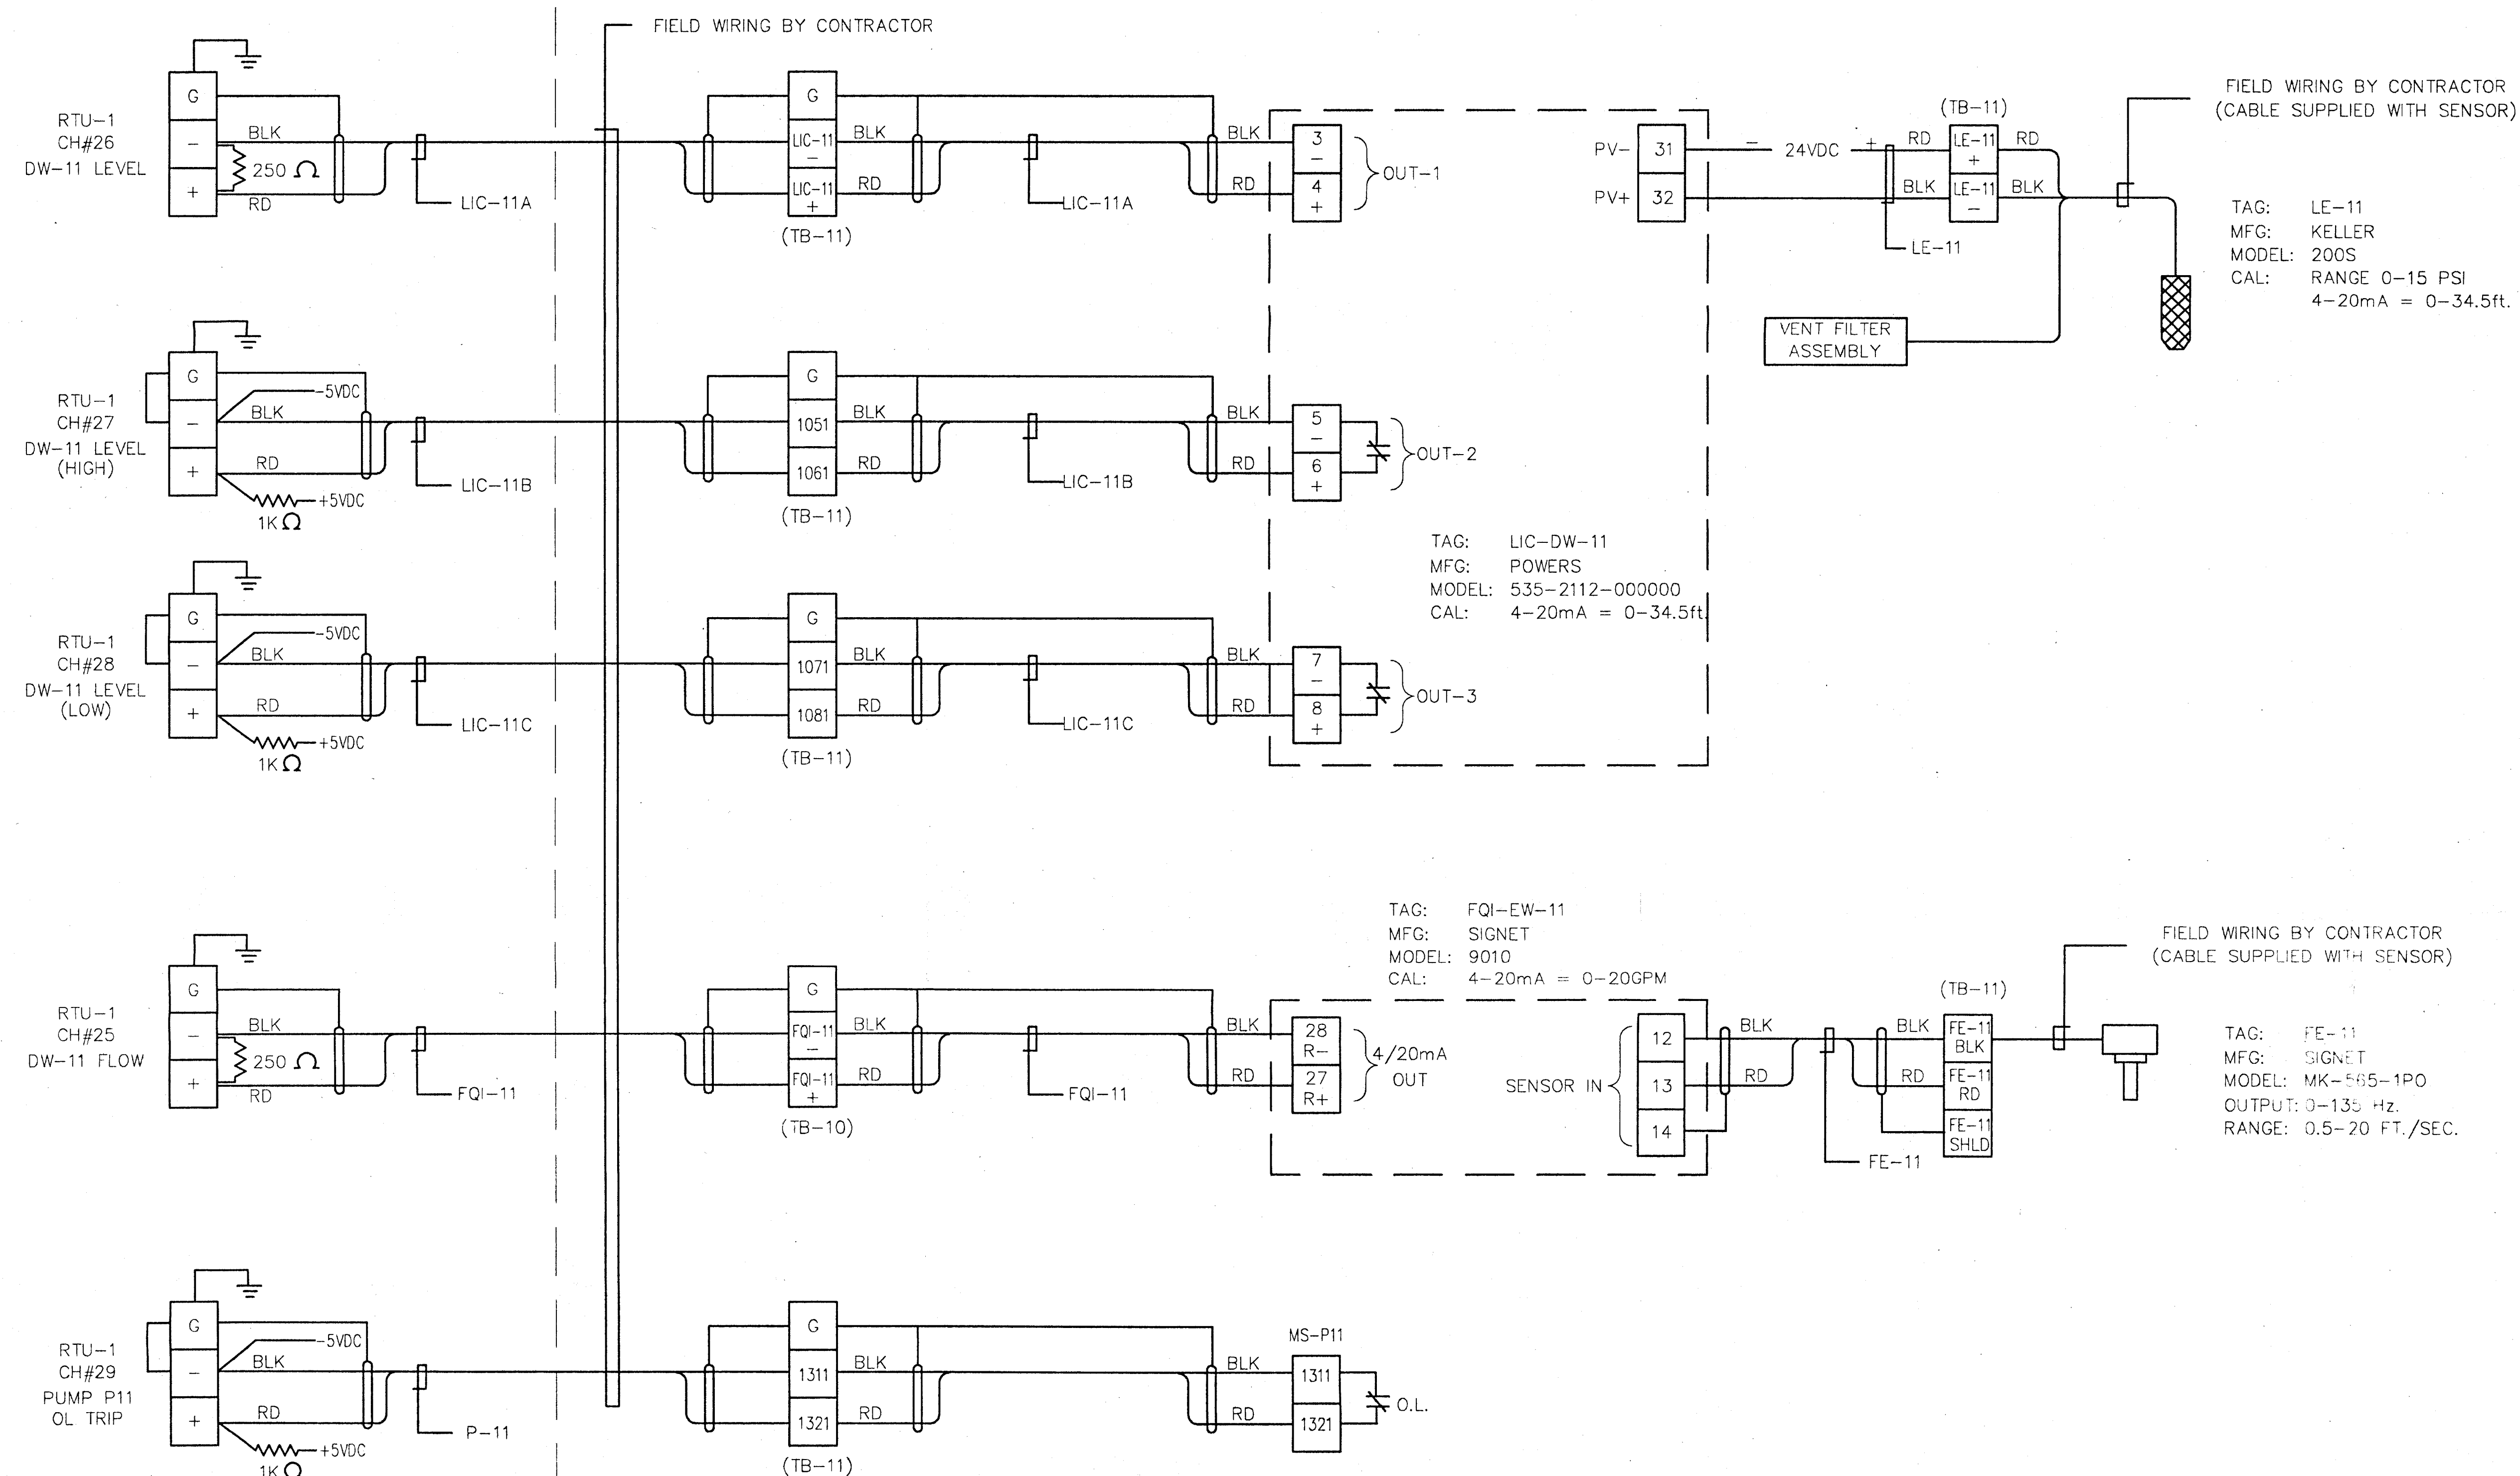[illegible]

THIS DRAWING INCLUDING THE INFORMATION, DATA AND DESIGN IS THE PROPERTY OF TREATEK - CRA. IT IS NOT TO BE COPIED, REPRODUCED OR ITS CONTENTS DIVULGED WITHOUT THE WRITTEN PERMISSION OF TREATEK - CRA.

(LOCATED IN TREATMENT PLANT CONTROL ROOM)


(DW-12 VAULT PANEL)

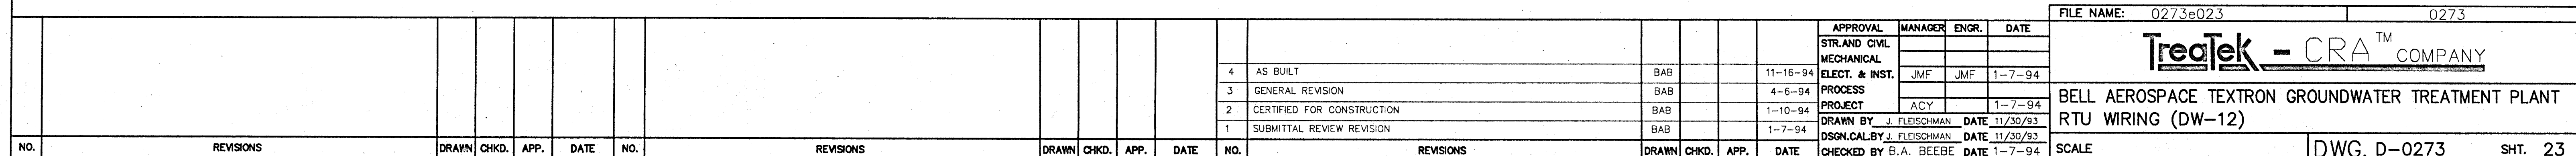


THIS DRAWING INCLUDING THE INFORMATION, DATA AND DESIGN IS THE PROPERTY OF TREATEK - CRA. IT IS NOT TO BE COPIED, REPRODUCED OR ITS CONTENTS DIVULGED WITHOUT THE WRITTEN PERMISSION OF TREATEK - CRA.

(LOCATED IN TREATMENT PLANT CONTROL ROOM)




FIELD WIRING BY CONTRACTOR

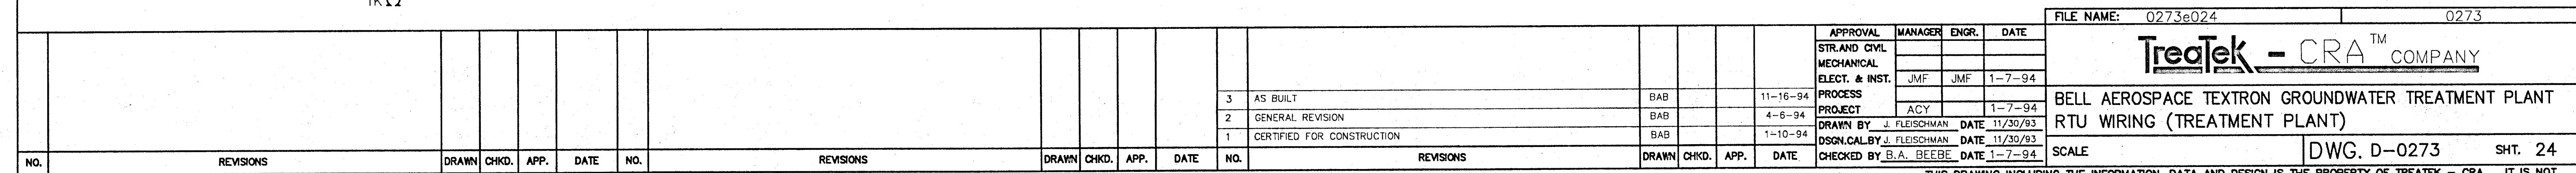

THIS DRAWING INCLUDING THE INFORMATION, DATA AND DESIGN IS THE PROPERTY OF TREATEK - CRA. IT IS NOT TO BE COPIED, REPRODUCED OR ITS CONTENTS DIVULGED WITHOUT THE WRITTEN PERMISSION OF TREATEK - CRA.

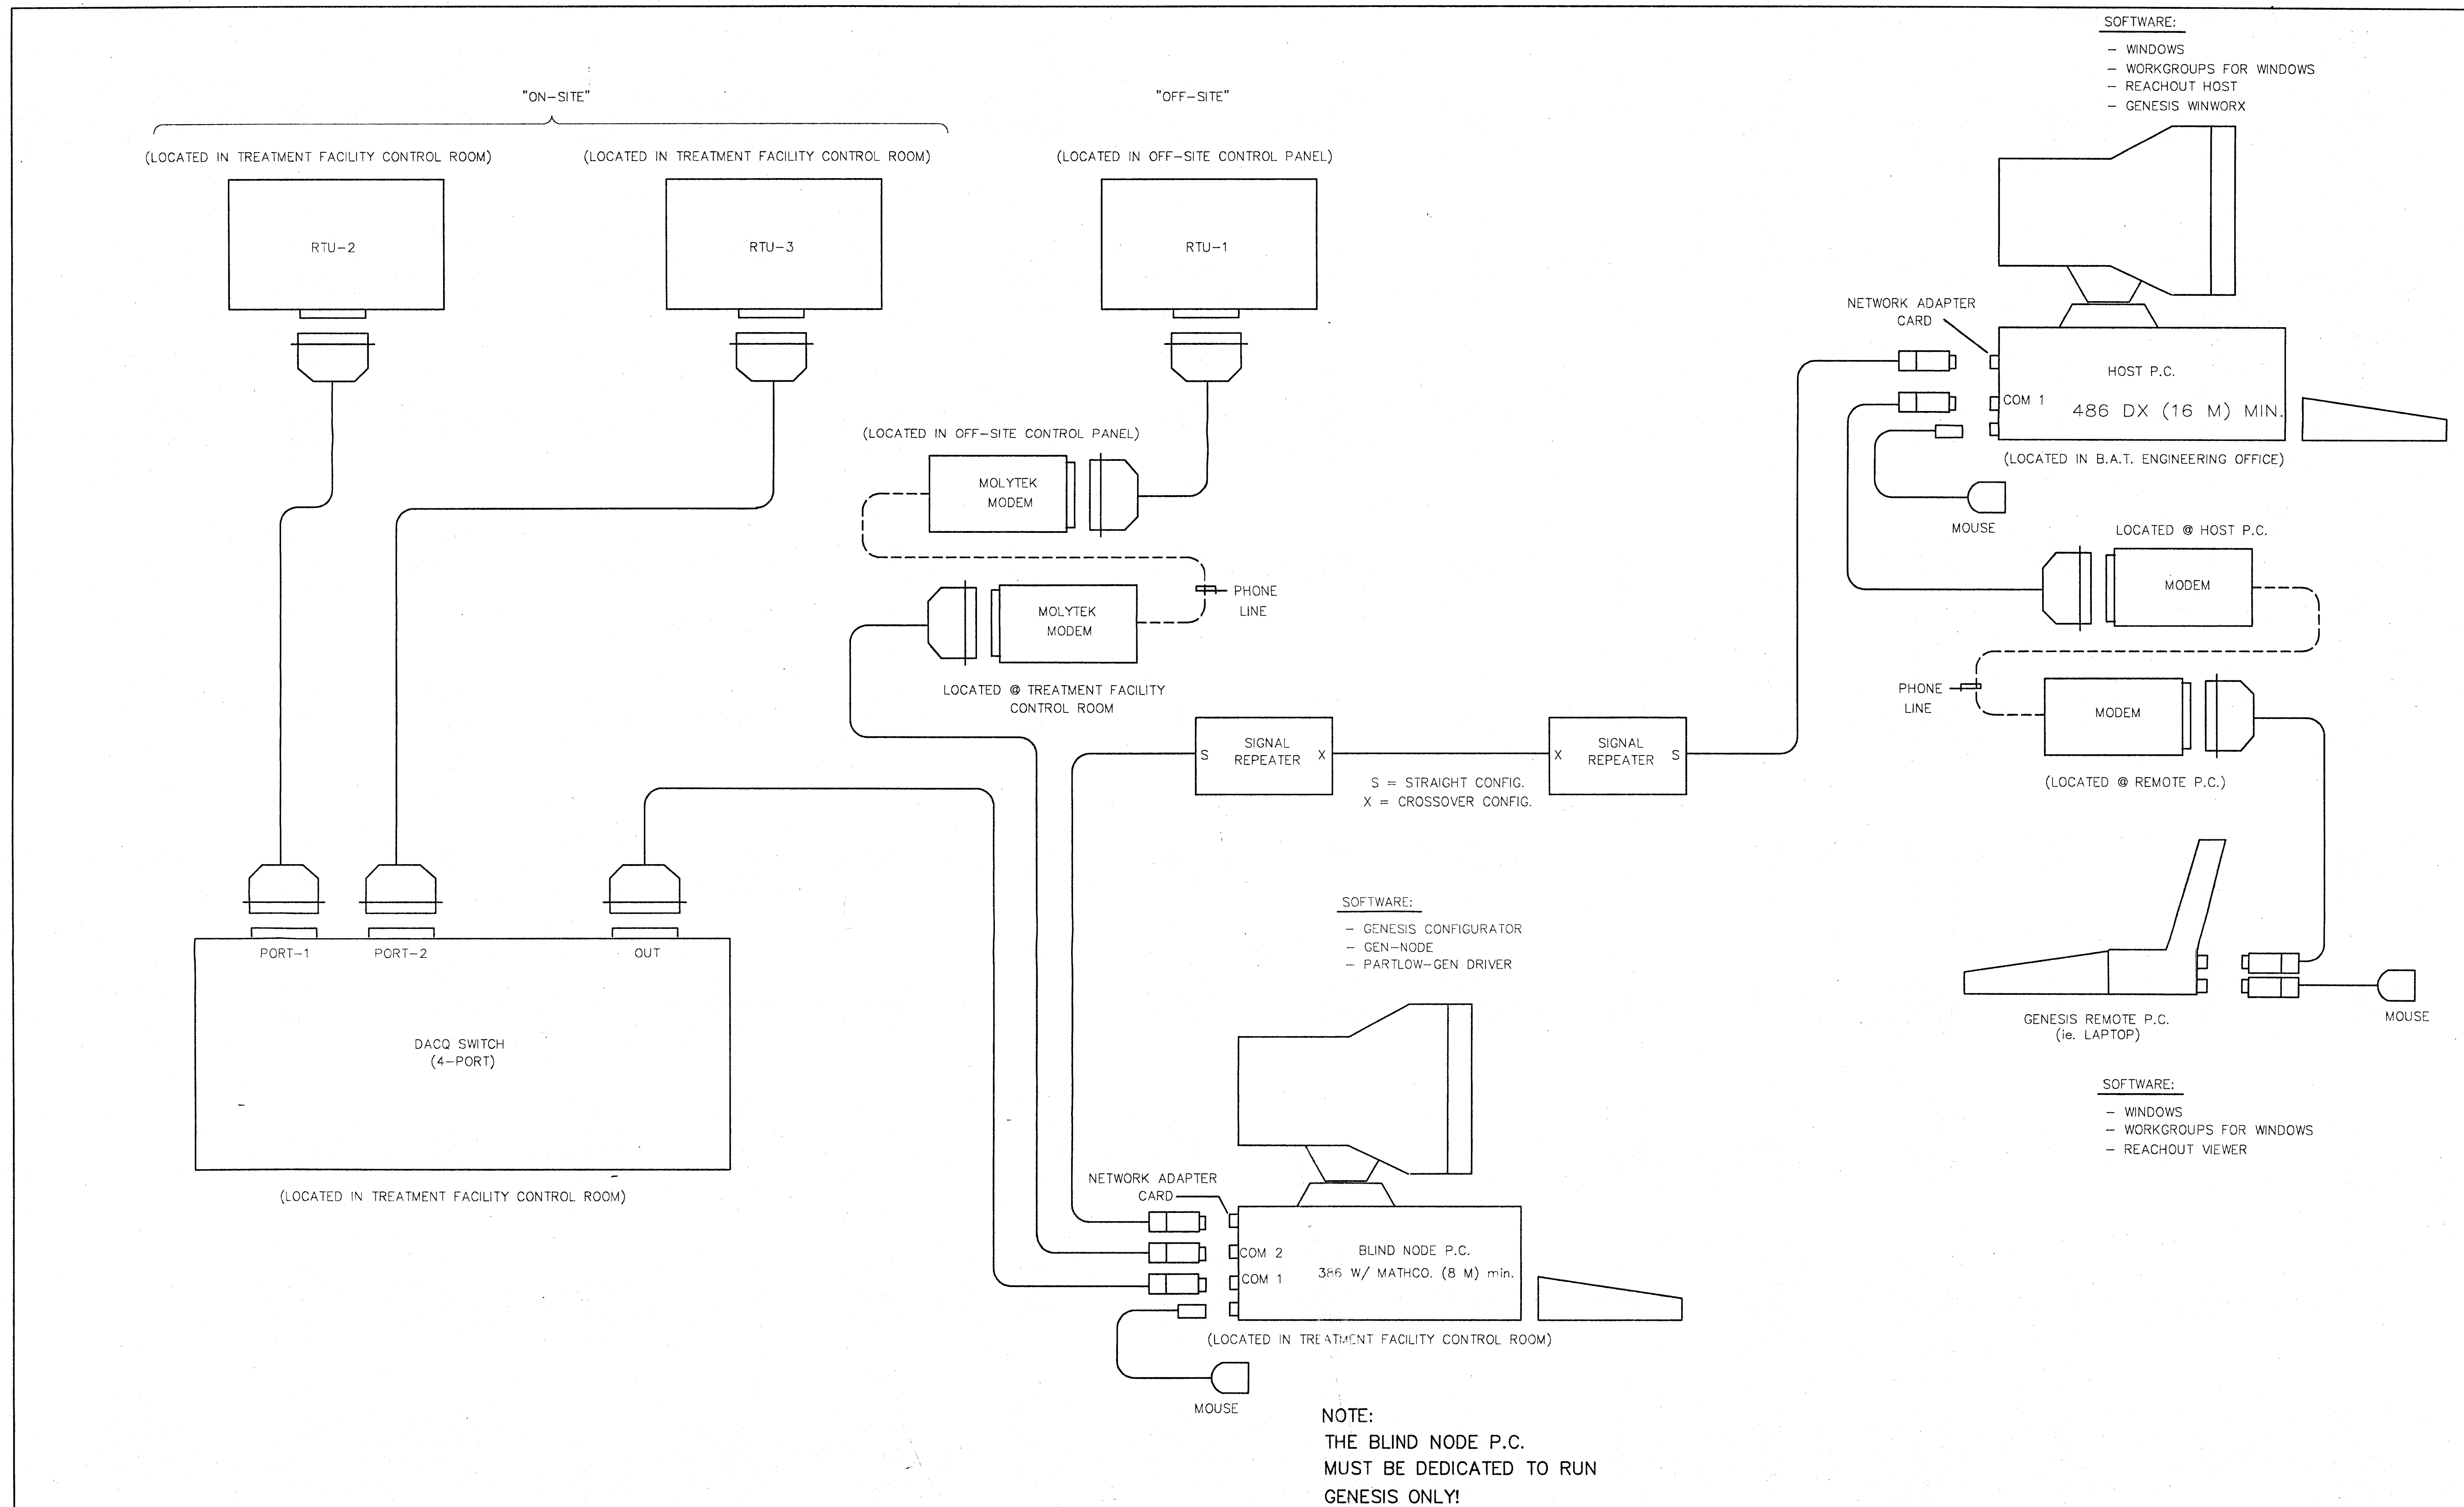

										FILE NAME: 0273E025									
										APPROVAL SO'D.LDR ENGR. DATE									
										STRAND CIVIL MECHANICAL ELECT. & INST. PROJECT									
										11-16-94 7-26-94 1-10-94 1-7-94									
										1-7-94 1-7-94									
										DRAWN BY B.A. BEEBE DATE 1/7/94									
										CHECKED BY B.A. BEEBE DATE 1-7-94									
										SCALE DWG. E-0273 SHT. 25									
										REVISIONS NO. DATE DESCRIPTION BY									
										4 AS BUILT BAB 11-16-94									
										3 REVISED FOR CONTROL SYSTEM UPGRADE JMF 7-26-94									
										2 CERTIFIED FOR CONSTRUCTION BAB 1-10-94									
										1 SUBMITTAL REVIEW REVISION BAB 1-7-94									
										REVISIONS NO. DATE DESCRIPTION BY									

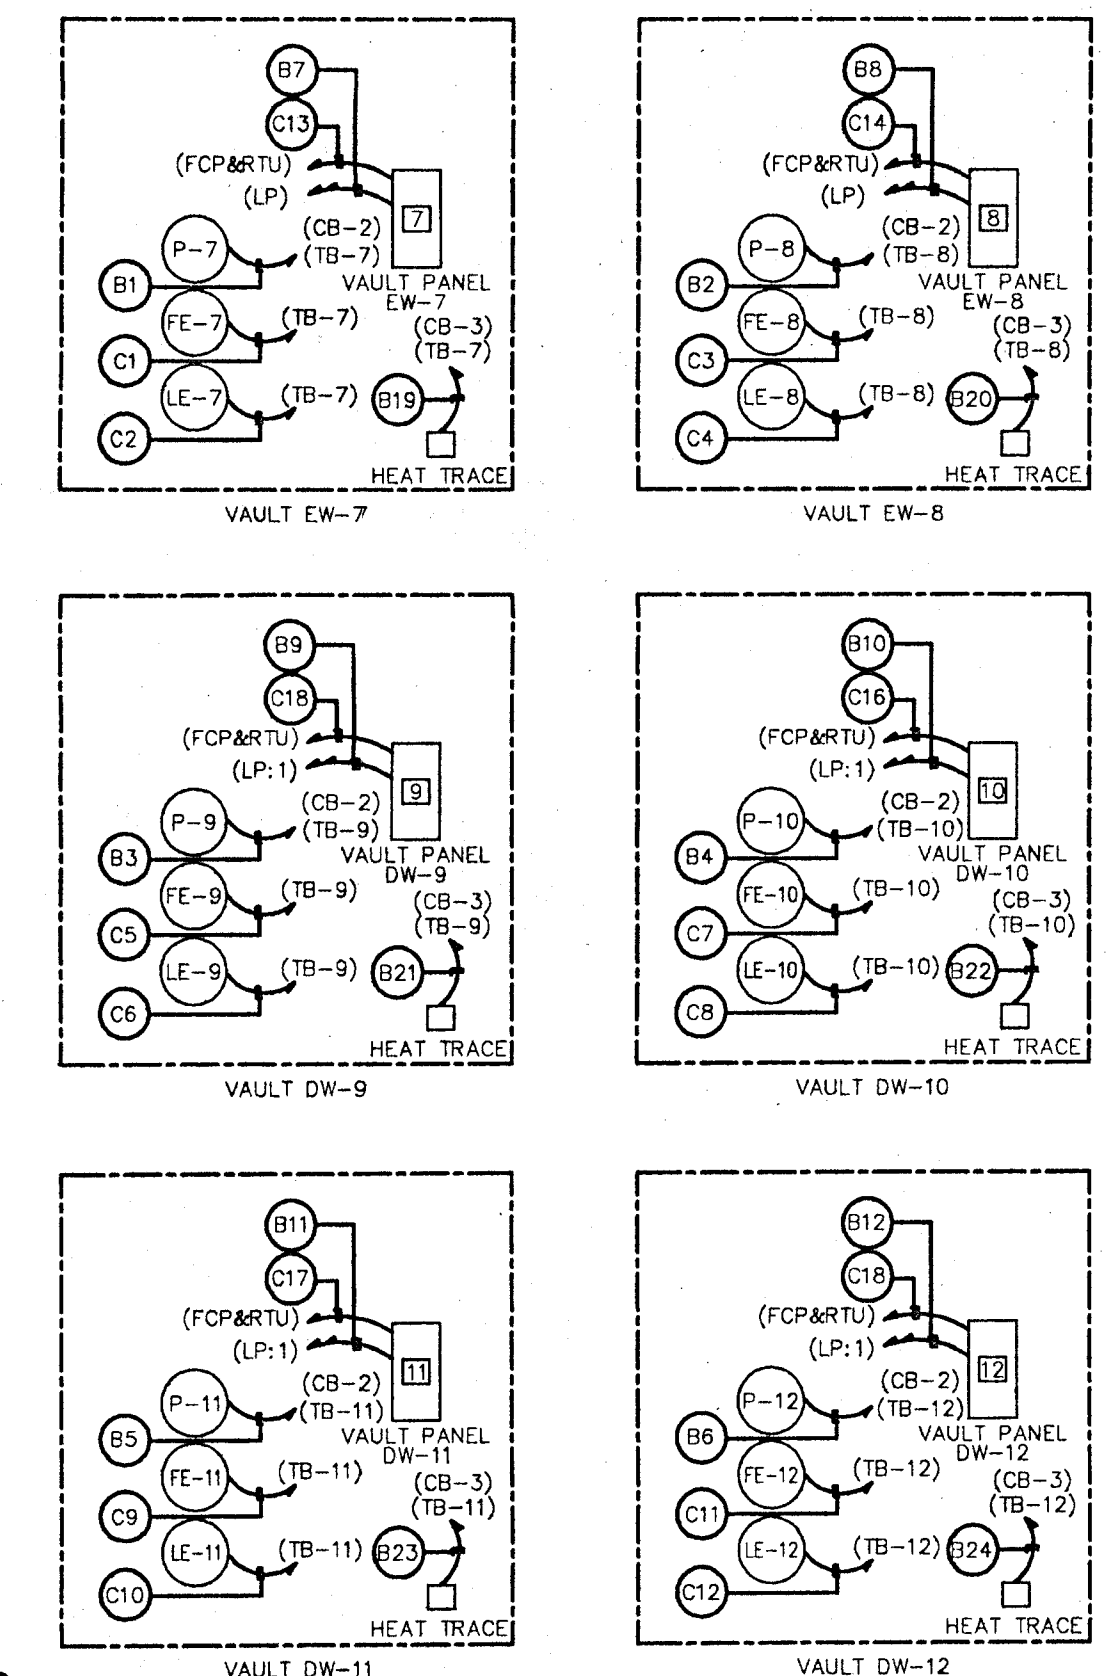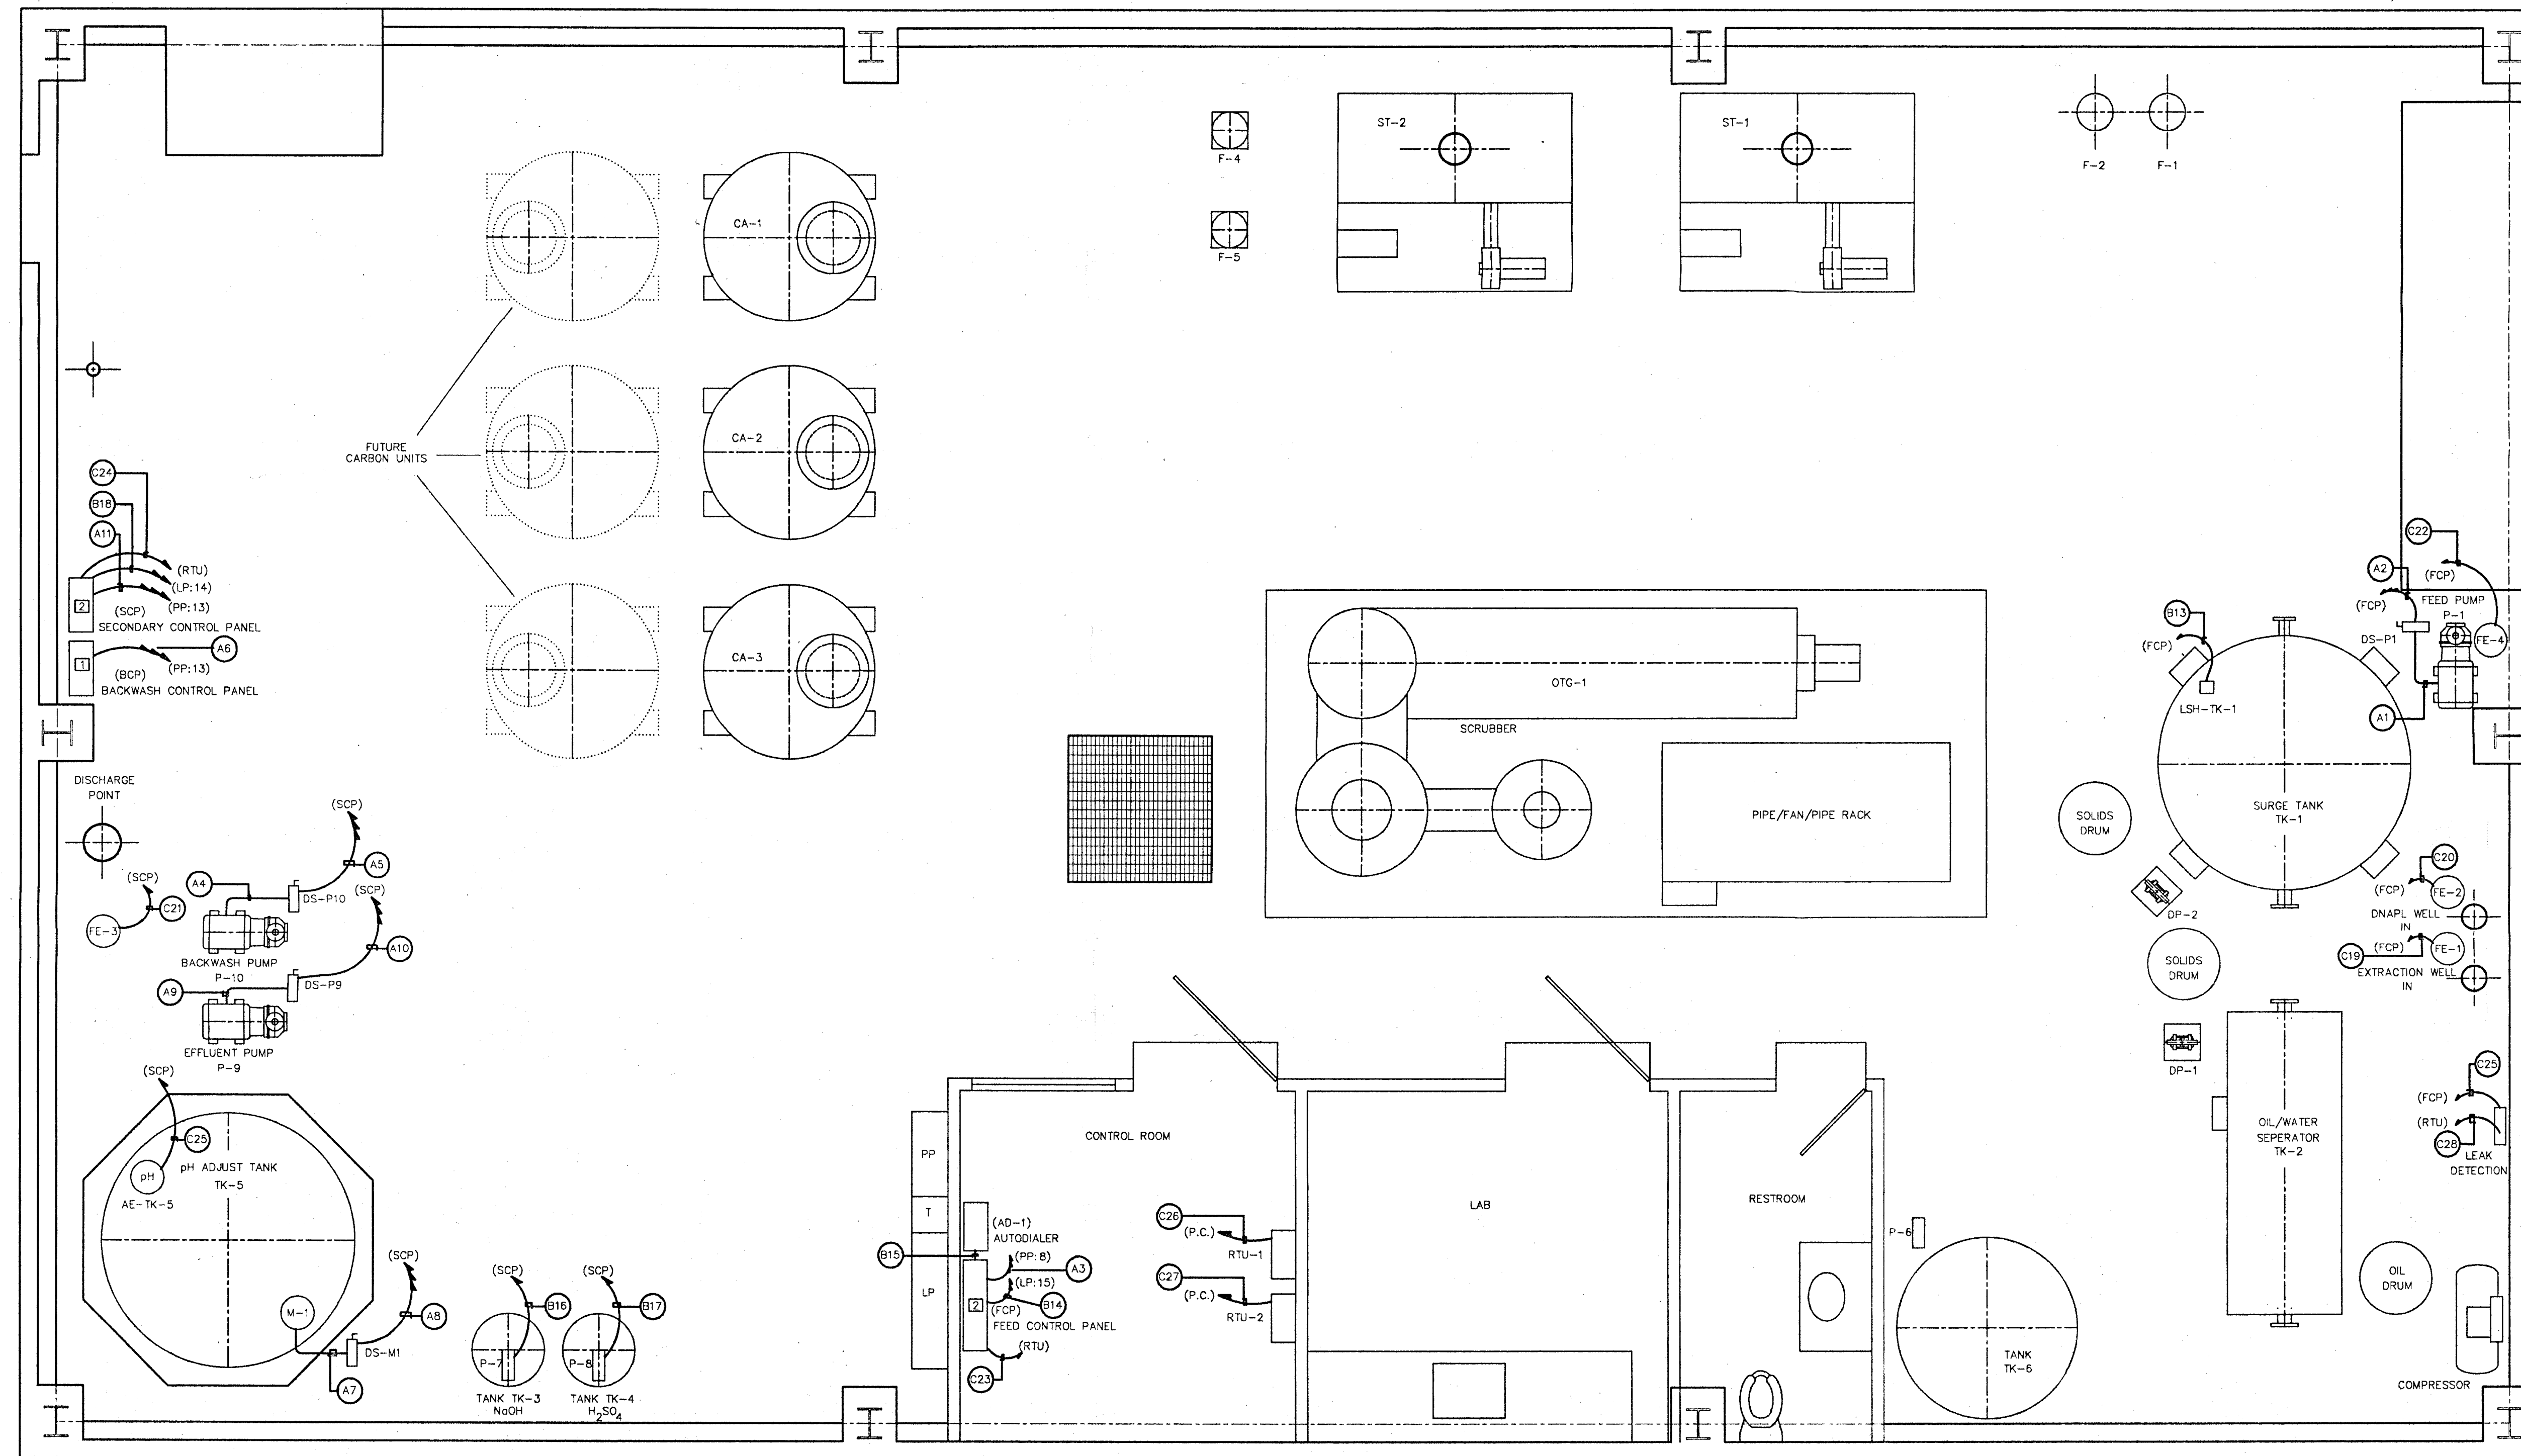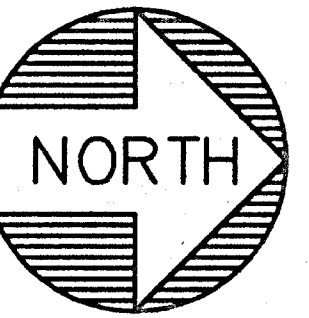

NOTE: WELL VAULTS ARE SHOWN FOR REFERENCE ONLY.
ACTUAL LOCATIONS ARE NOT TO SCALE

- KEY:
- AX - 208/240V CONDUIT
 - BX - 120/208V CONDUIT
 - CX - SIGNAL CONDUIT
 - X - TERMINAL BOX
 - HOMERUN INDICATION
 - (XXX) - HOMERUN DESTINATION

REVISIONS										REVISIONS									
NO.	DATE	APP.	CHKD.	DRAWN	NO.	DATE	APP.	CHKD.	DRAWN	NO.	DATE	APP.	CHKD.	DRAWN	NO.	DATE	APP.	CHKD.	DRAWN
3	11-16-94				3	11-16-94				3	11-16-94				3	11-16-94			
2	4-5-94				2	4-5-94				2	4-5-94				2	4-5-94			
1	1-10-94				1	1-10-94				1	1-10-94				1	1-10-94			

APPROVAL	MANAGER	ENGR.	DATE
STR. AND CIVIL	JMF	JMF	1-7-94
MECHANICAL	JMF	JMF	1-7-94
ELECT. & INST.	JMF	JMF	1-7-94
PROCESS	JMF	JMF	1-7-94
PROJECT	JMF	JMF	1-7-94
DRAWN BY B.A. BEEBE	DATE 1-7-94		
DSGN. CAL BY J. FLEISCHMAN	DATE 1-7-94		
CHECKED BY B.A. BEEBE	DATE 1-7-94		

FILE NAME:	0273E026	0273
Treatek - CRA TM COMPANY		
BELL AREOSPACE TEXTRON WASTEWATER TREATMENT PLANT - ELECTRICAL INTERCONNECTING LAYOUT		
SCALE	3/8" = 1'-0"	DWG. D-0273 SHT. 26

THIS DRAWING INCLUDING THE INFORMATION, DATA AND DESIGN IS THE PROPERTY OF TREATEK - CRA. IT IS NOT TO BE COPIED, REPRODUCED OR ITS CONTENTS DIVULGED WITHOUT THE WRITTEN PERMISSION OF TREATEK - CRA.

CONDUIT AND CABLE SCHEDULE


CONDUIT			FROM	TO	PURPOSE	CABLE					WIRE NUMBERS																												REMARKS																																																																																																																																																																																																																																																																																																																																																																																																																																																																																																																																																																																																																																																																																																																																																																																																																																																																																																																																																																																																																																																																																																																																																																																																																																																																																																																																				
NO.	SIZE	LENGTH	DESCRIPTION	DESCRIPTION		NO. COND.	SIZE	TYPE	VOLTS	LENGTH																																																																																																																																																																																																																																																																																																																																																																																																																																																																																																																																																																																																																																																																																																																																																																																																																																																																																																																																																																																																																																																																																																																																																																																																																																																																																																																																																																	
A1			FEED PUMP P1	DS-P1	POWER	4	# 12	THWN	208/240		1T1	1T2	1T3	GND																																																																																																																																																																																																																																																																																																																																																																																																																																																																																																																																																																																																																																																																																																																																																																																																																																																																																																																																																																																																																																																																																																																																																																																																																																																																																																																																																													


[illegible]


THIS DRAWING INCLUDING THE INFORMATION, DATA AND DESIGN IS THE PROPERTY OF TREATEK - CRA. IT IS NOT TO BE COPIED, REPRODUCED OR ITS CONTENTS DIVULGED WITHOUT THE WRITTEN PERMISSION OF TREATEK - CRA.

CONDUIT AND CABLE SCHEDULE

CONDUIT			FROM	TO	PURPOSE	CABLE				WIRE NUMBERS																												REMARKS																																																																																																																																																																																																																																																																																																																																																																																																																																																																																																																																																																																																																																																																																																																																																																																																																																																																																																																																																																																																																																																																																																																																																																																																																																																																																																																												
NO.	SIZE	LENGTH	DESCRIPTION	DESCRIPTION		NO. COND.	SIZE	TYPE	VOLTS	LENGTH																																																																																																																																																																																																																																																																																																																																																																																																																																																																																																																																																																																																																																																																																																																																																																																																																																																																																																																																																																																																																																																																																																																																																																																																																																																																																																																																																								
C1			FE-7	VAULT PNL. (TB-7) (FQI-7)	SIGNAL	CABLE SUPPLIED WITH DEVICE				FE-7 BK LE-7 +	FE-7 RD LE-7 -	SHLD																																																																																																																																																																																																																																																																																																																																																																																																																																																																																																																																																																																																																																																																																																																																																																																																																																																																																																																																																																																																																																																																																																																																																																																																																																																																																																																																																						

 																				FILE NAME: 0273E028 0273									
																													
																				BELL AEROSPACE TETRON GROUNDWATER TREATMENT PLANT - ELECTRICAL INTERCONNECTING SCHEDULE									
																				SCALE NONE DWG. D-0273 SHT. 28									
																				THIS DRAWING INCLUDING THE INFORMATION, DATA AND DESIGN IS THE PROPERTY OF TREATEK - CRA. IT IS NOT TO BE COPIED, REPRODUCED OR ITS CONTENTS DIVULGED WITHOUT THE WRITTEN PERMISSION OF TREATEK - CRA.									

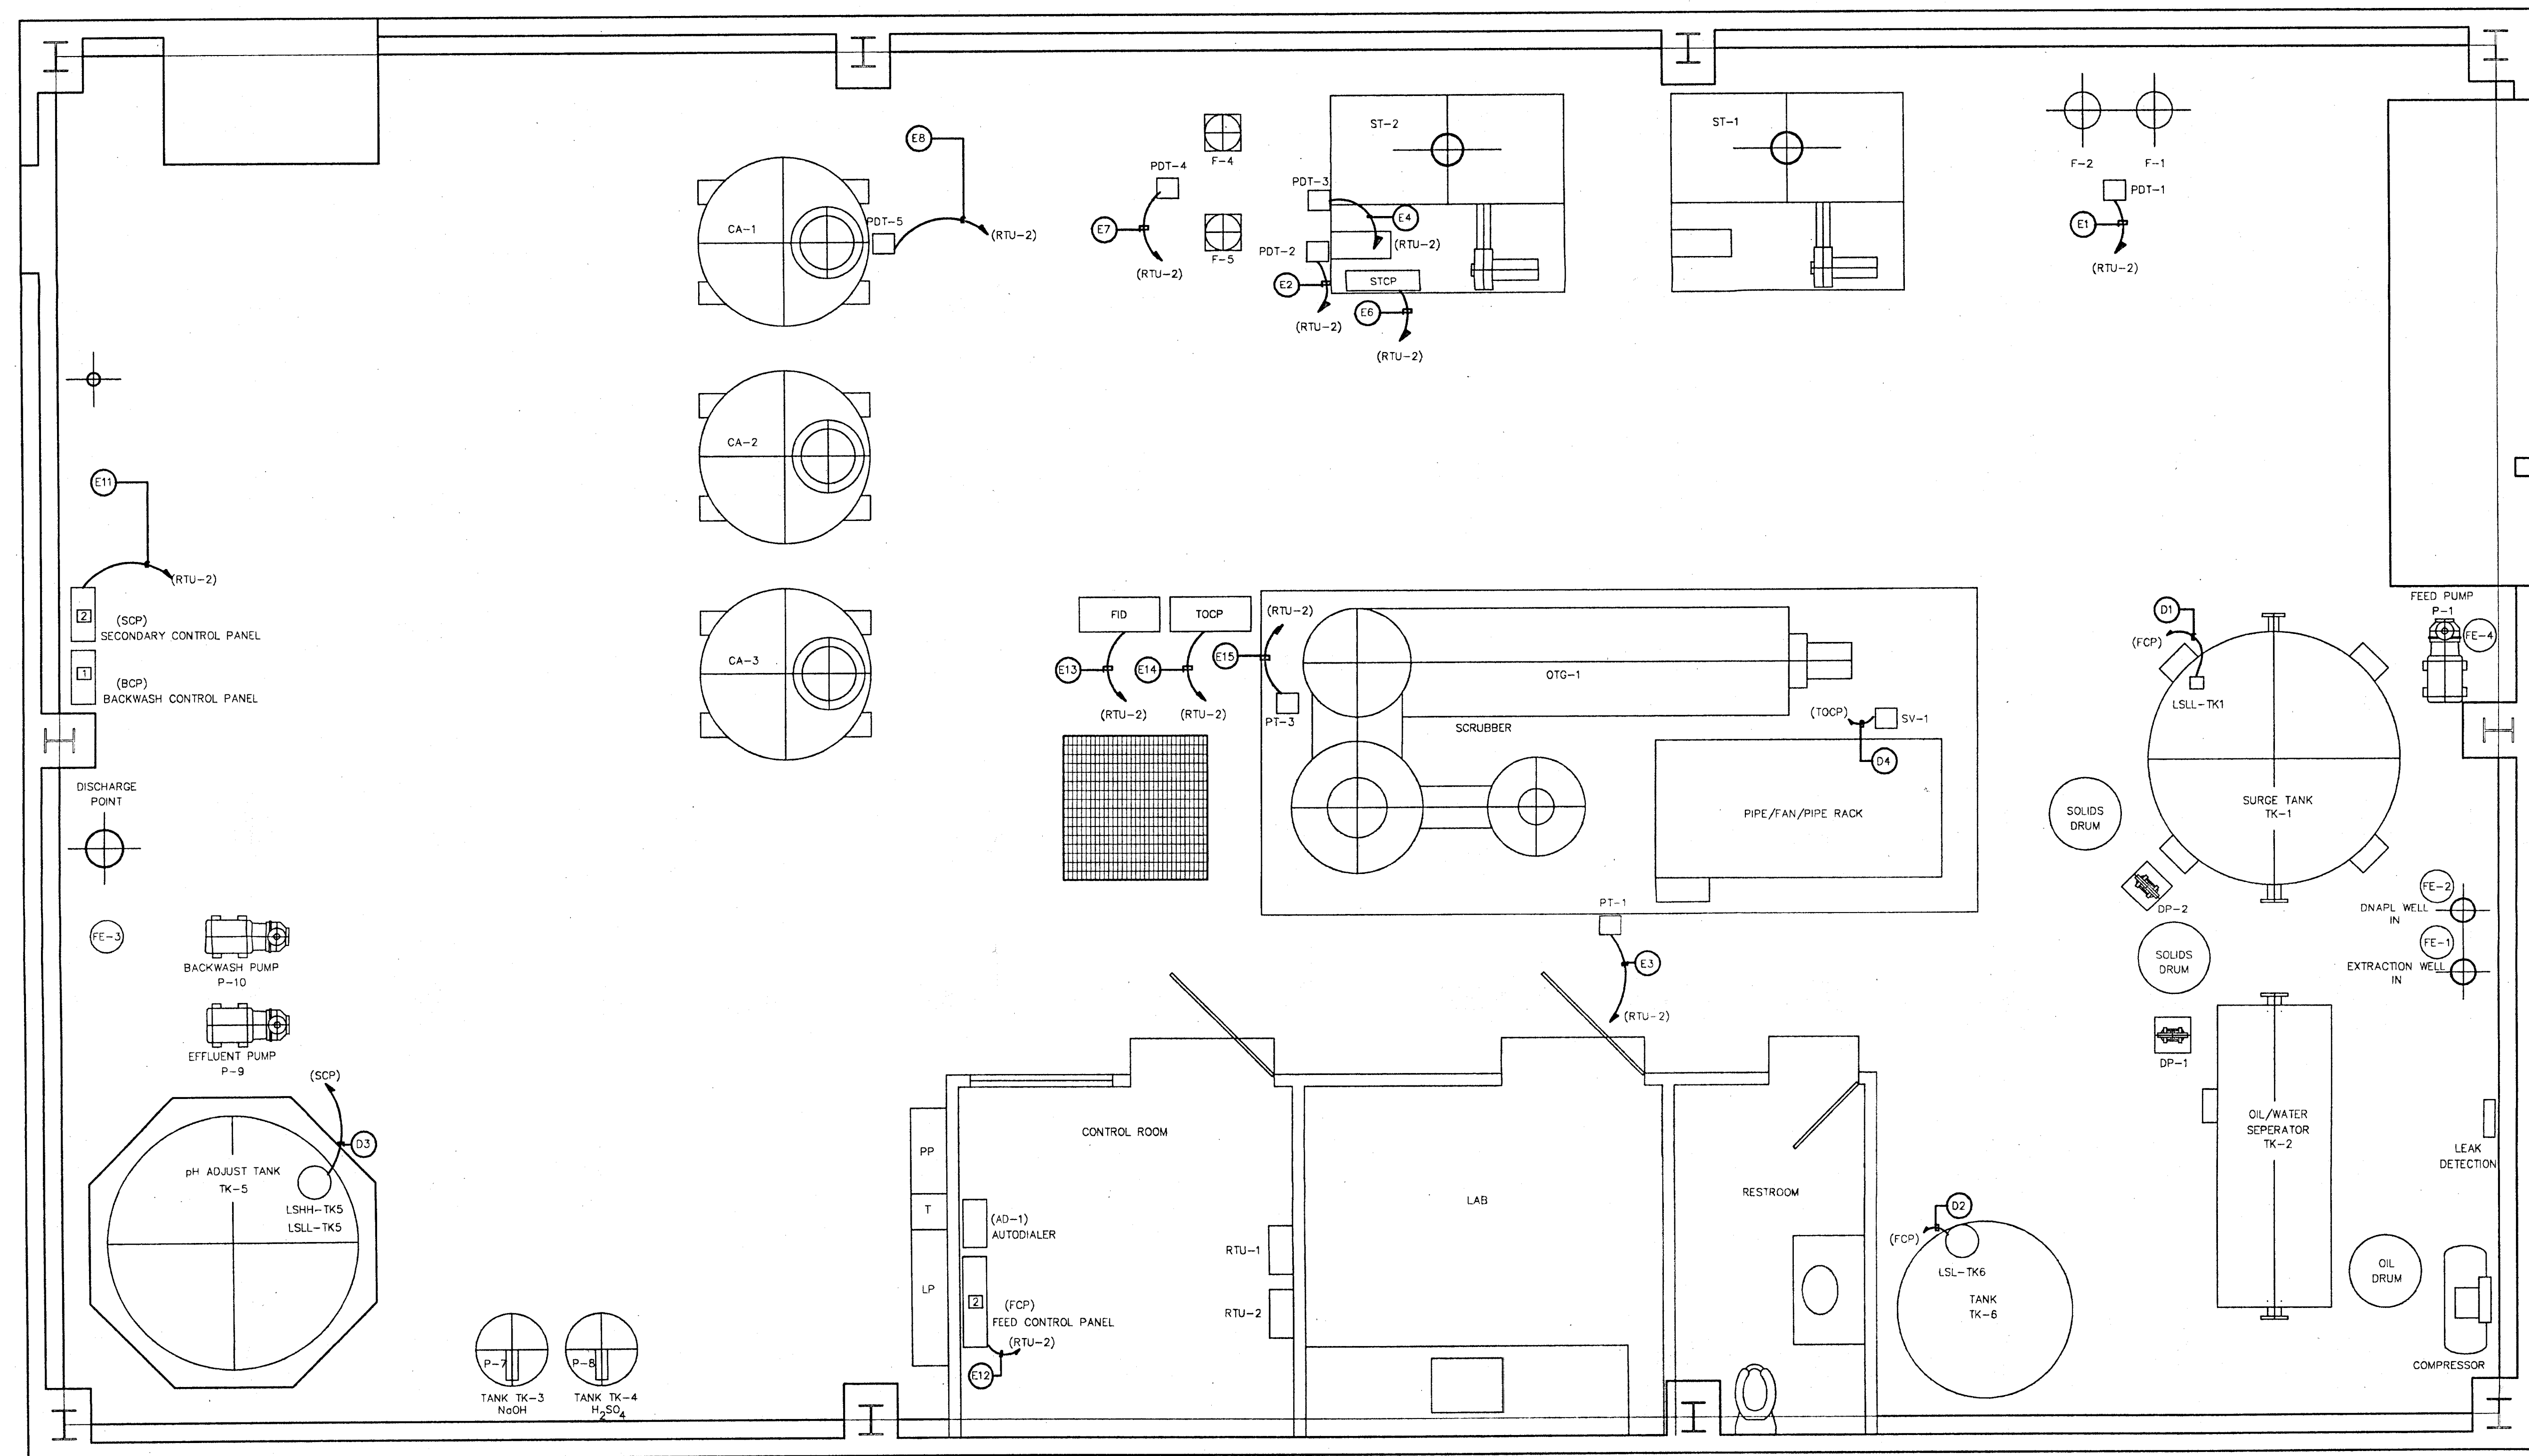
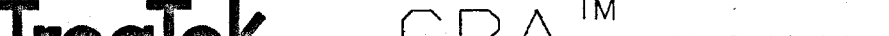
<table border="1"> <tr> <td>APPROVAL</td> <td>MANAGER</td> <td>ENGR.</td> <td>DATE</td> </tr> <tr> <td>STR. AND CIVIL</td> <td></td> <td></td> <td></td> </tr> <tr> <td>MECHANICAL</td> <td></td> <td></td> <td></td> </tr> <tr> <td>ELECT. & INST.</td> <td>JMF</td> <td>JMF</td> <td>7-19-94</td> </tr> <tr> <td>PROCESS</td> <td></td> <td></td> <td></td> </tr> <tr> <td>PROJECT</td> <td>ACY</td> <td></td> <td>7-19-94</td> </tr> <tr> <td>DRAWN BY</td> <td>JMF</td> <td>DATE</td> <td>7-19-94</td> </tr> <tr> <td>DSGN. CAL. BY</td> <td>JMF</td> <td>DATE</td> <td>7-19-94</td> </tr> <tr> <td>CHECKED BY</td> <td>JMF</td> <td>DATE</td> <td>7-19-94</td> </tr> </table>				APPROVAL	MANAGER	ENGR.	DATE	STR. AND CIVIL				MECHANICAL				ELECT. & INST.	JMF	JMF	7-19-94	PROCESS				PROJECT	ACY		7-19-94	DRAWN BY	JMF	DATE	7-19-94	DSGN. CAL. BY	JMF	DATE	7-19-94	CHECKED BY	JMF	DATE	7-19-94	FILE NAME: 0273E029		0273	
APPROVAL	MANAGER	ENGR.	DATE																																								
STR. AND CIVIL																																											
MECHANICAL																																											
ELECT. & INST.	JMF	JMF	7-19-94																																								
PROCESS																																											
PROJECT	ACY		7-19-94																																								
DRAWN BY	JMF	DATE	7-19-94																																								
DSGN. CAL. BY	JMF	DATE	7-19-94																																								
CHECKED BY	JMF	DATE	7-19-94																																								
																																											
BELL AREOSPACE TEXTRON WASTEWATER TREATMENT PLANT (UPGRADE) - ELECTRICAL INTERCONNECTING LAYOUT																																											
SCALE 3/8" = 1'-0"				DWG. D-0273		SHT. 29																																					
THIS DRAWING INCLUDING THE INFORMATION, DATA AND DESIGN IS THE PROPERTY OF TREATEK - CRA. IT IS NOT TO BE COPIED, REPRODUCED OR ITS CONTENTS DISCLOSED WITHOUT THE WRITTEN PERMISSION OF TREATEK - CRA.																																											

CONDUIT AND CABLE SCHEDULE

[illegible]

													APPROVAL				SQ'D.LDR.	ENGR.	DATE	FILE NAME: 0273E030			0273												
													STR. AND CIVIL																						
													MECHANICAL																						
													ELECT. & INST.				JMF	JMF	7-19-94																
													PROCESS																						
													PROJECT				ACY		7-19-94	BELL AEROSPACE TEXTRON GROUNDWATER TREATMENT															
													DRAWN BY				JMF		DATE	7-19-94	PLANT (UPGRADE) - ELECTRICAL INTERCONNECTING SCHEDULE														
													DSGN.CAL.BY				JMF		DATE	7-19-94	SCALE			NONE	DWG. D-0273			SHT. 30							
													CHECKED BY				JMF		DATE	7-19-94															
													1 AS BUILT				BAB				11-16-94														
NO.	REVISIONS					DRAWN	CHKD.	APP.	DATE	NO.	REVISIONS					DRAWN	CHKD.	APP.	DATE	NO.	REVISIONS					DRAWN	CHKD.	APP.	DATE						

THIS DRAWING INCLUDING THE INFORMATION, DATA AND DESIGN IS THE PROPERTY OF TREATEK - CRA. IT IS NOT TO BE COPIED, REPRODUCED OR ITS CONTENTS DIVULGED WITHOUT THE WRITTEN PERMISSION OF TREATEK - CRA.

RTU-2

(LOCATED IN TREATMENT PLANT CONTROL ROOM)

FCP


(FEED CONTROL PANEL)

RTU-2

(LOCATED IN TREATMENT PLANT CONTROL ROOM)



STCP

(STRIPPER CONTROL PANEL)

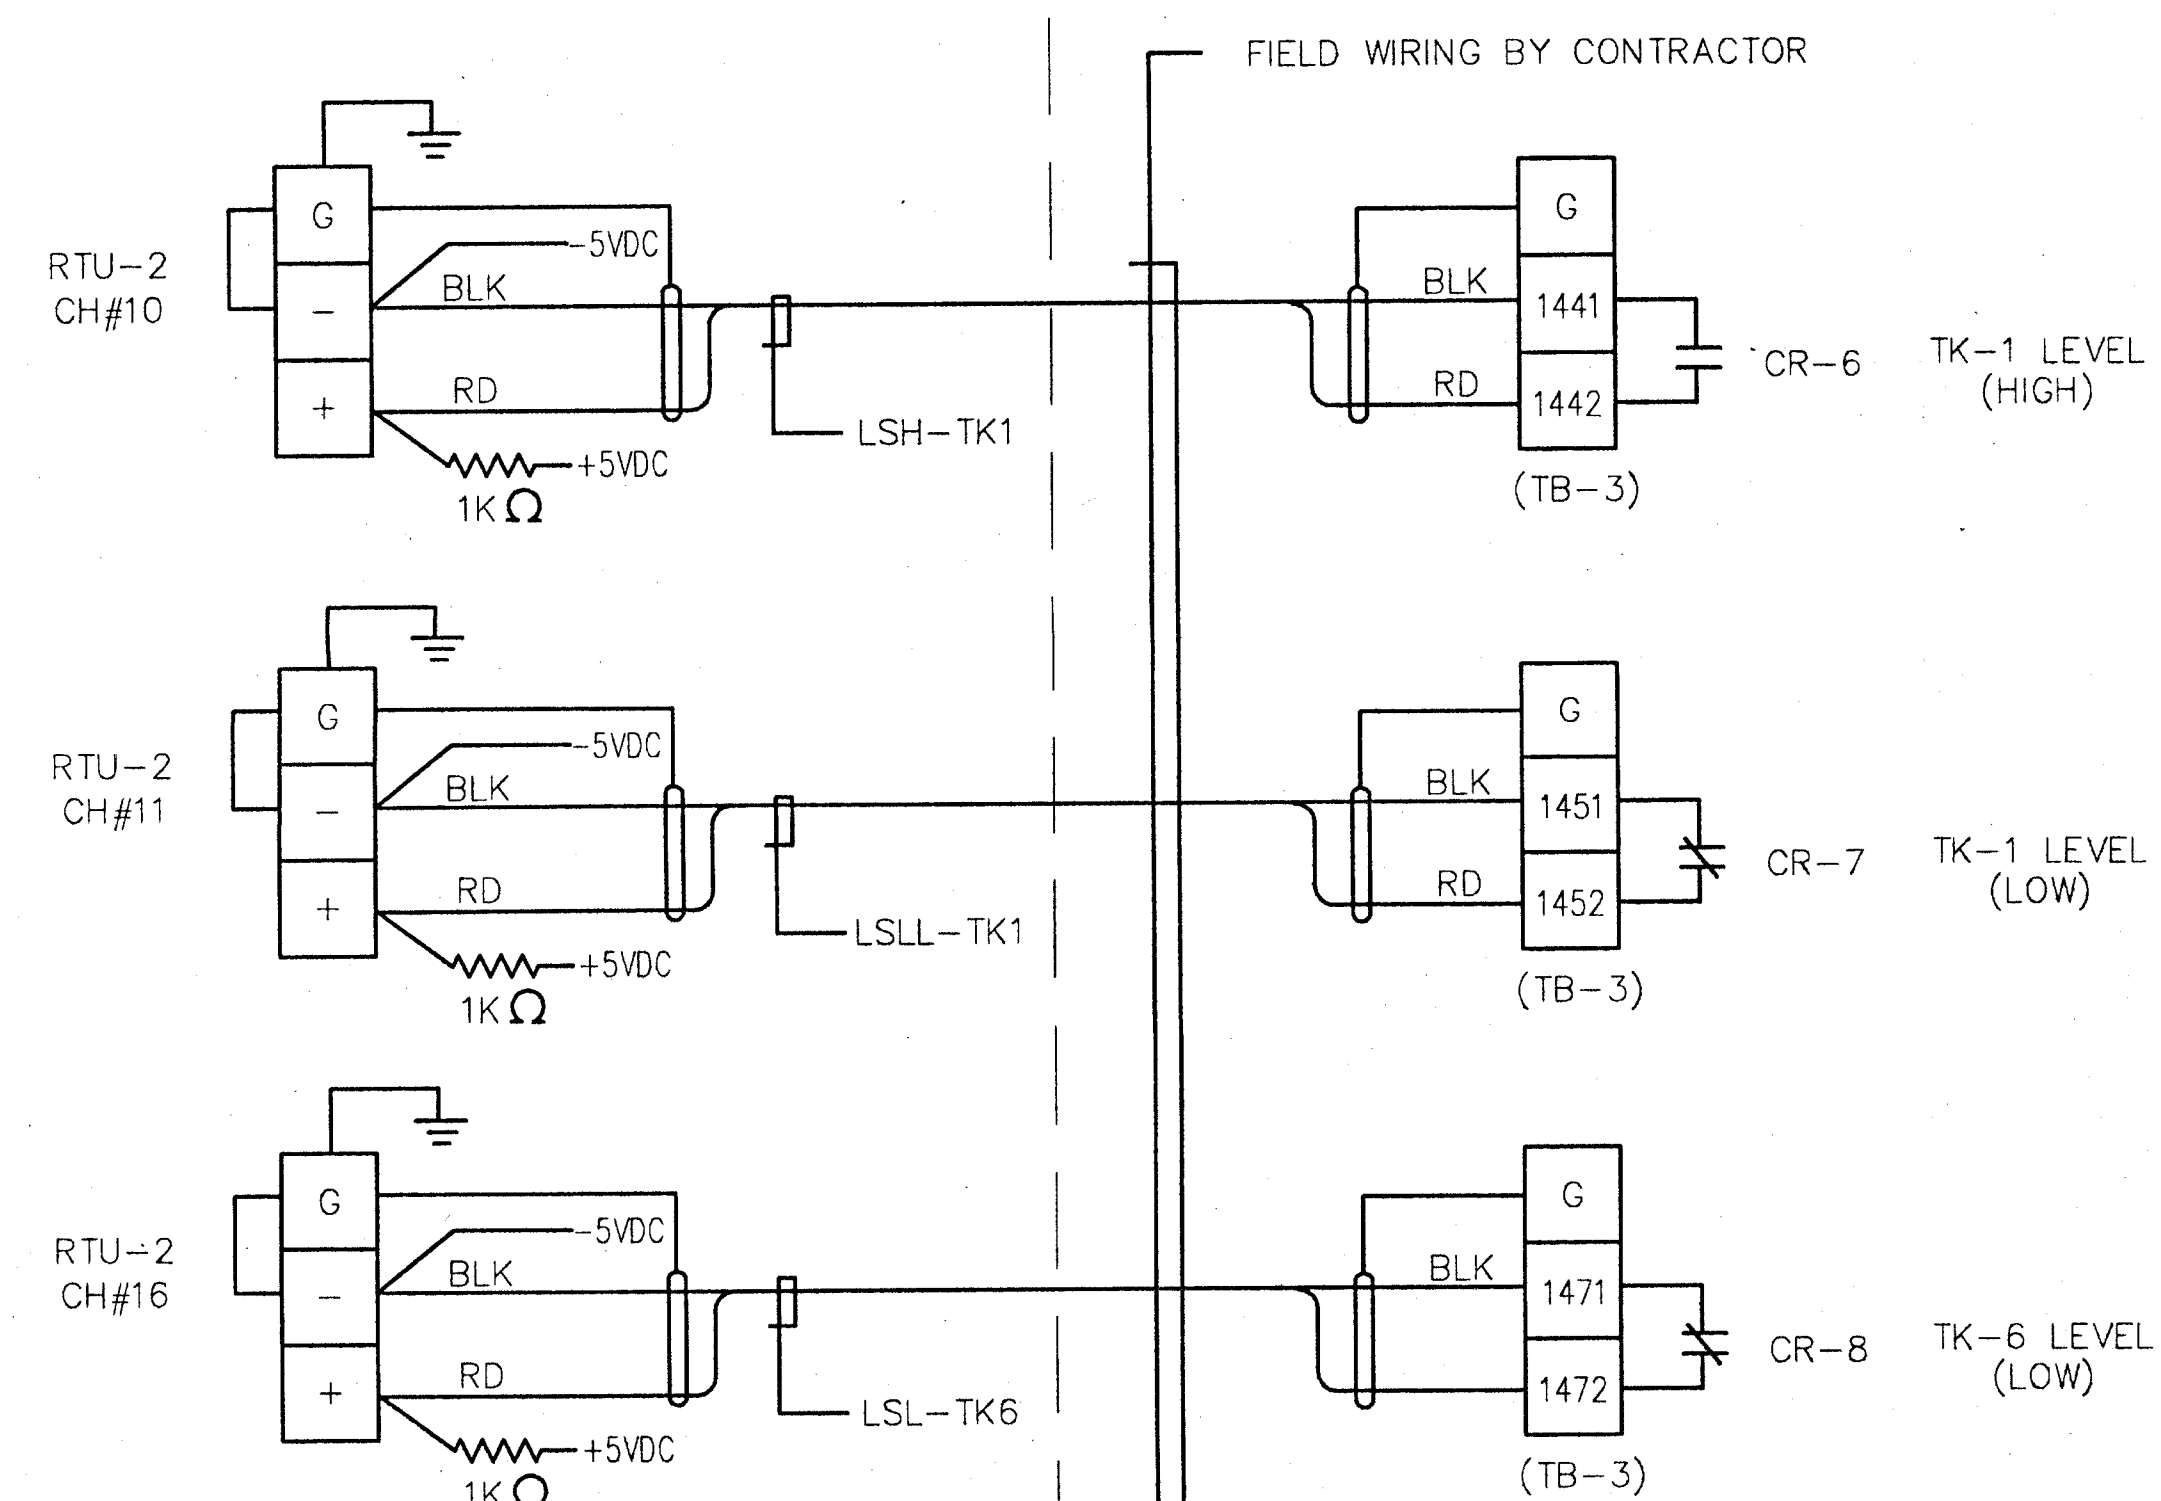



SCP

(SECONDARY CONTROL PANEL)

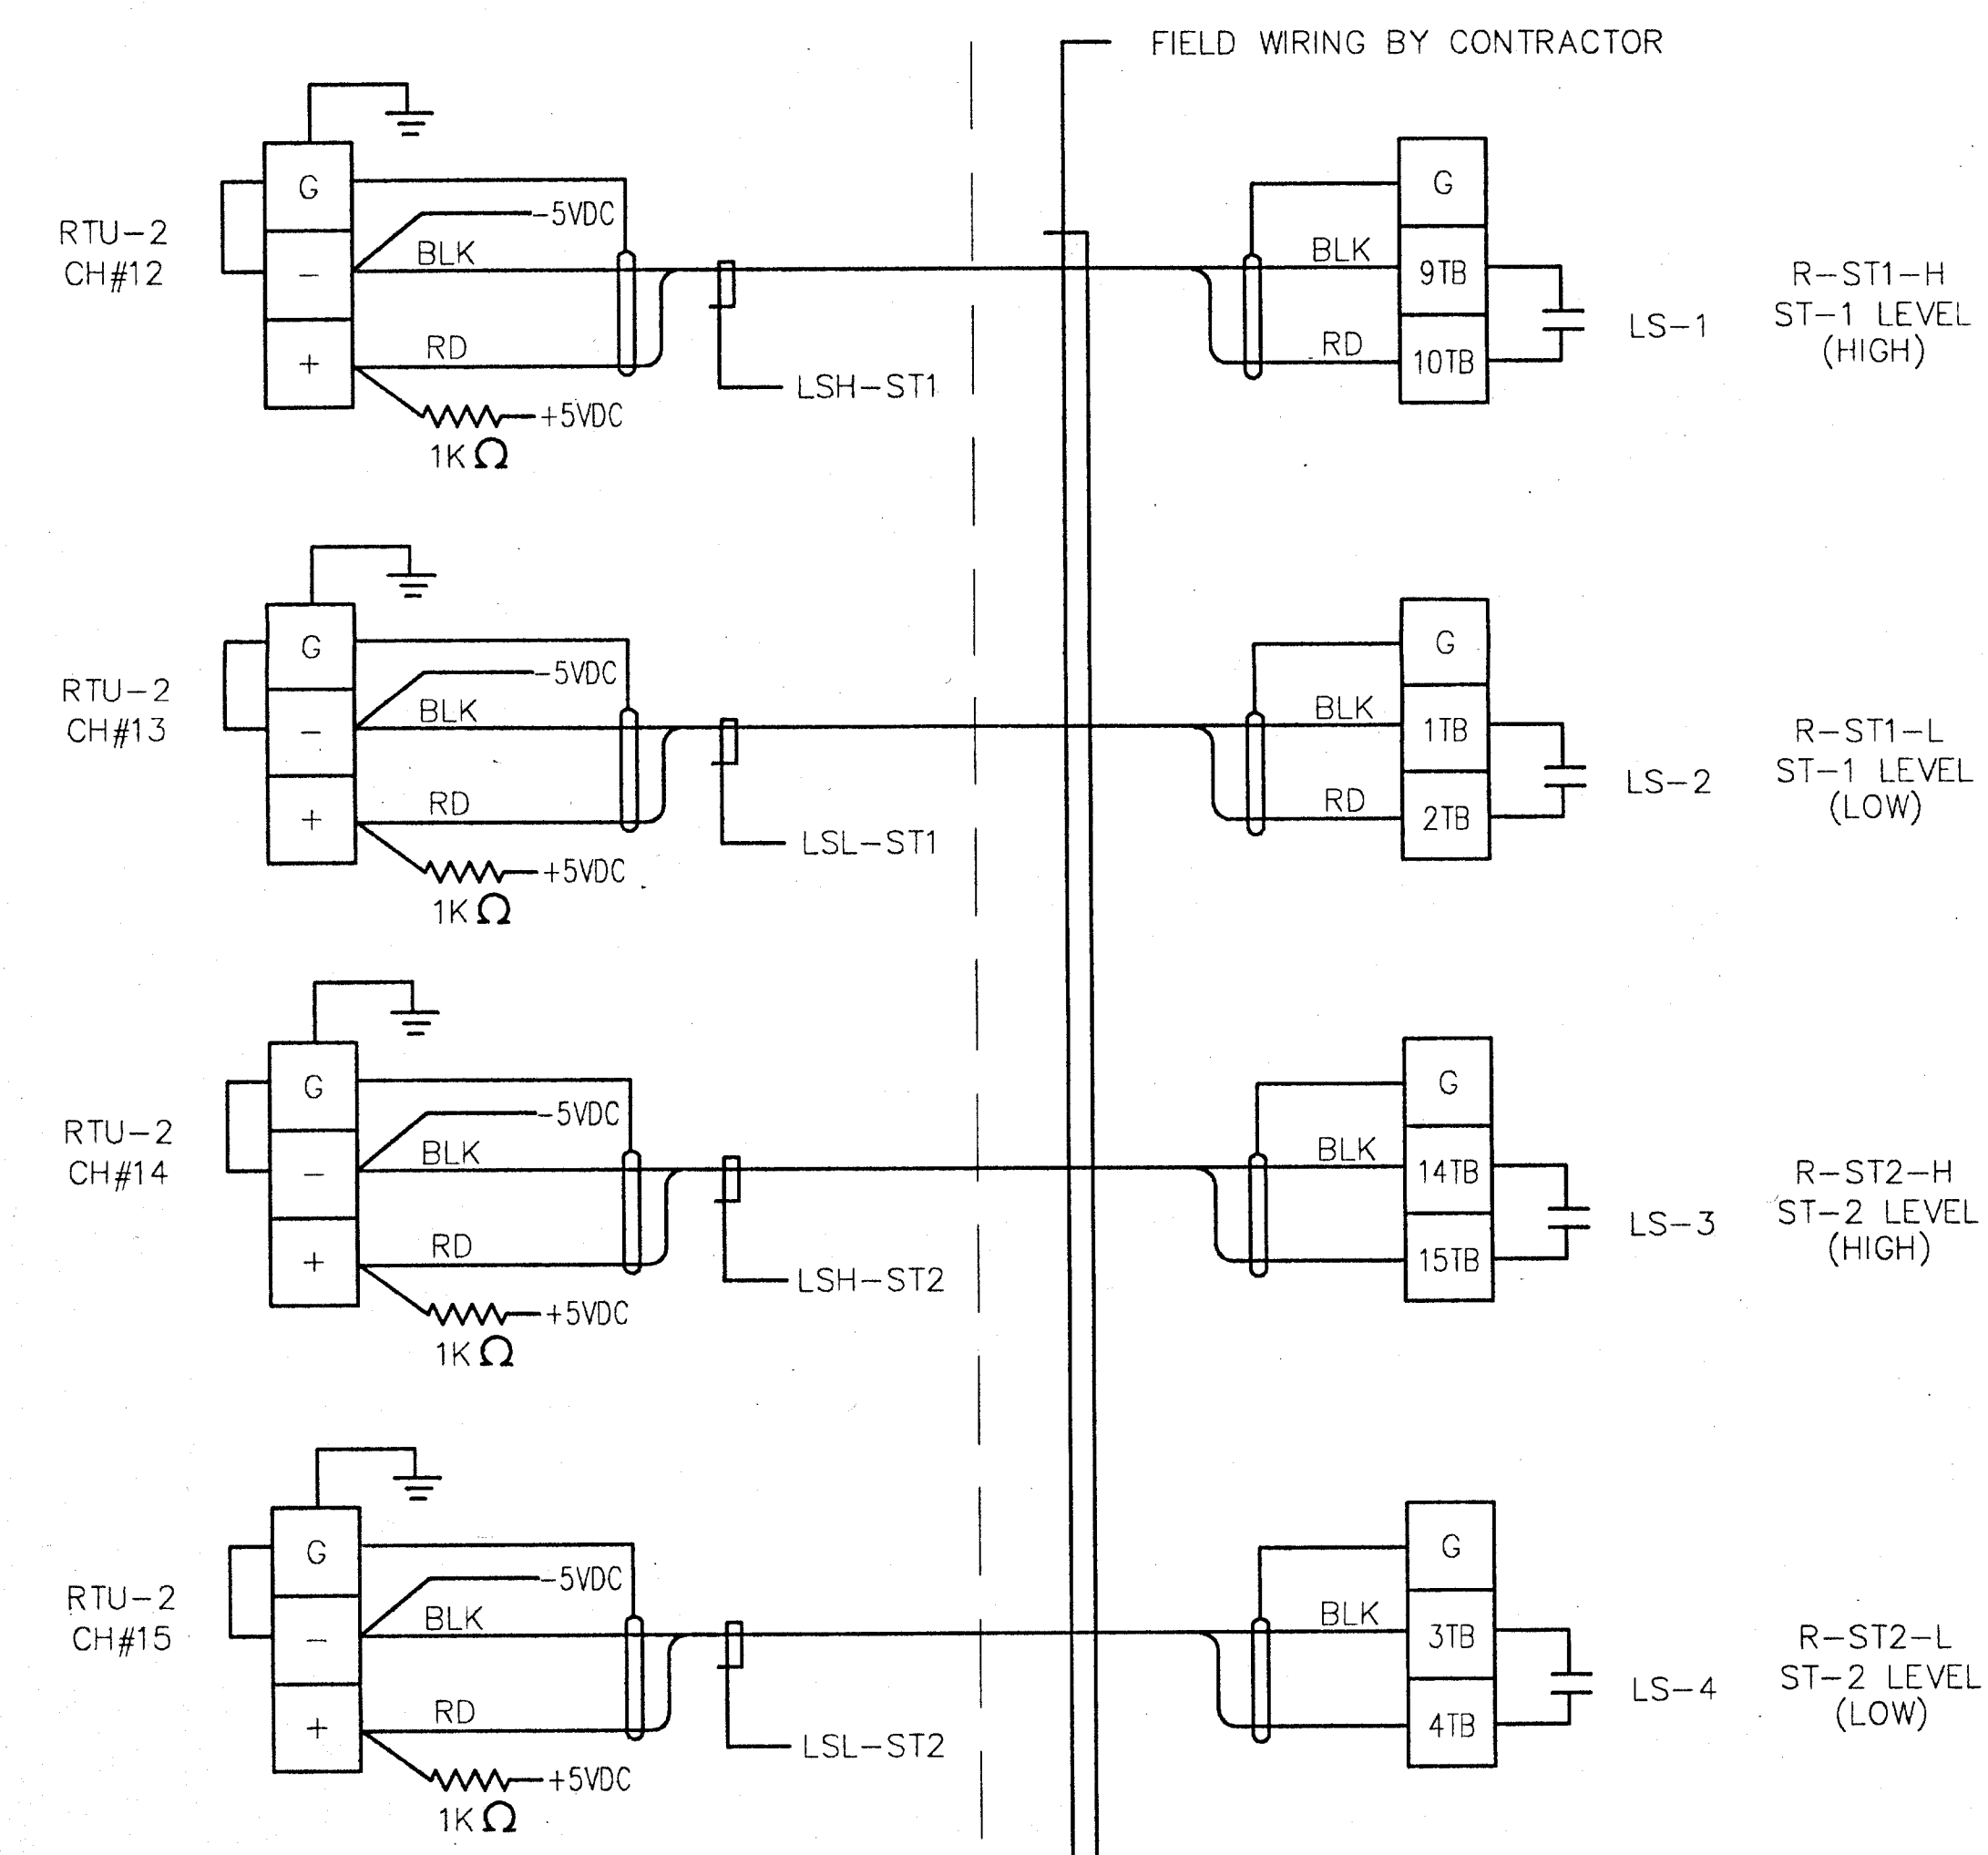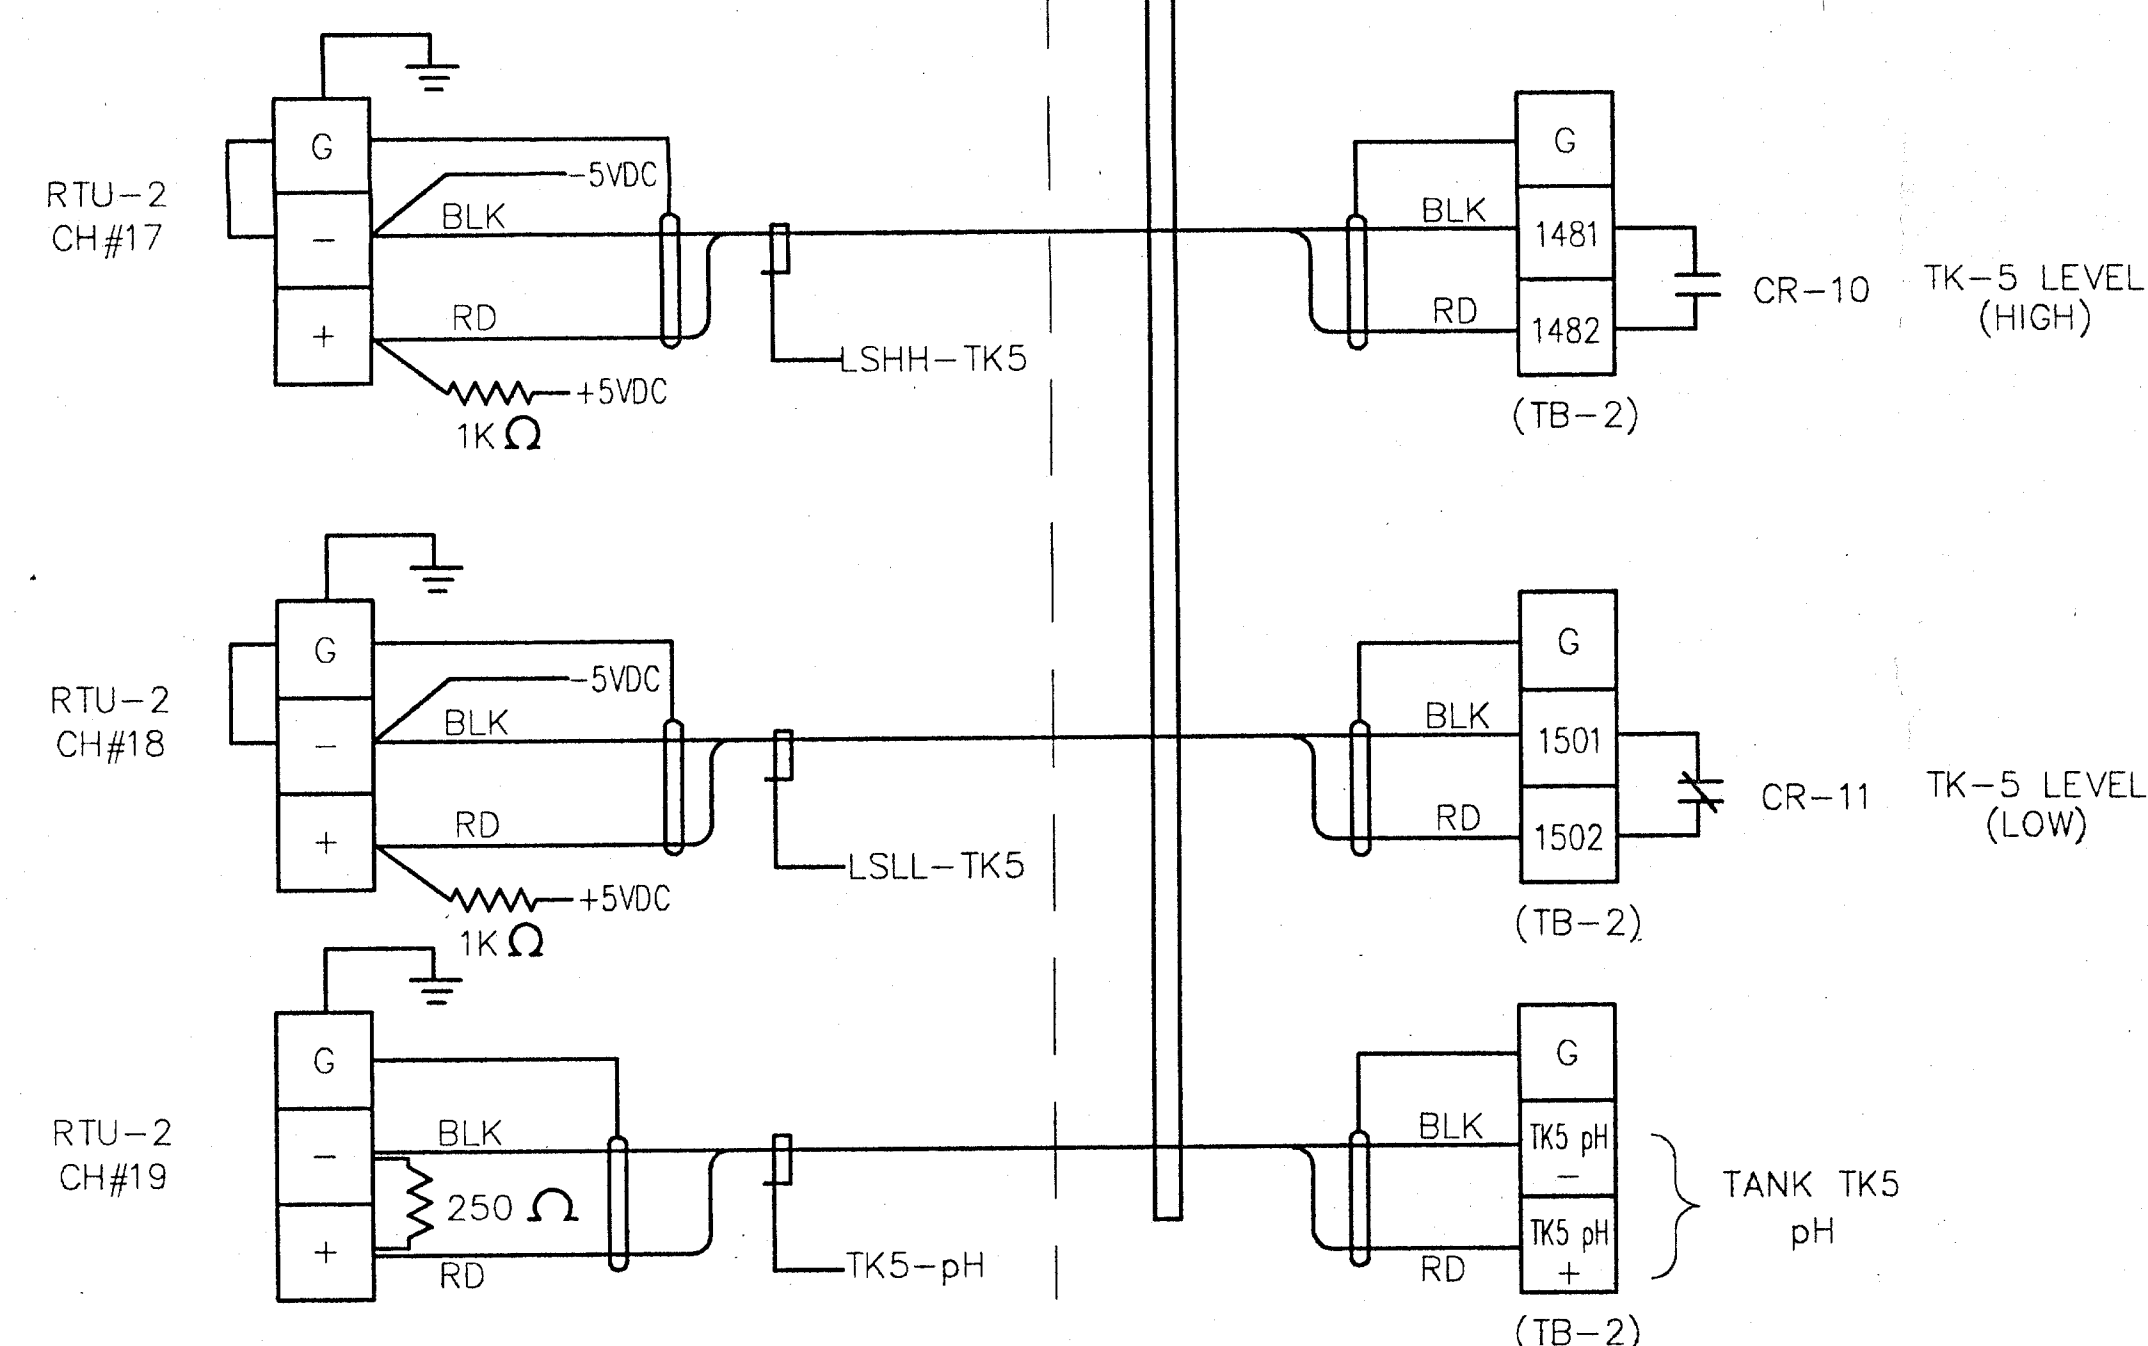

																														FILE NAME: 027380031 0273									
																														APPROVAL MANAGER ENGR. DATE TreatTek - CRATM COMPANY									
																														BELL AEROSPACE TEXTRON GROUNDWATER TREATMENT PLANT									
																														RTU WIRING (FCP, SCP, STCP)									
																														SCALE									
																														DWG. D-0273									
																														SHT. 31									
</																																							

(LOCATED IN TREATMENT PLANT CONTROL ROOM)

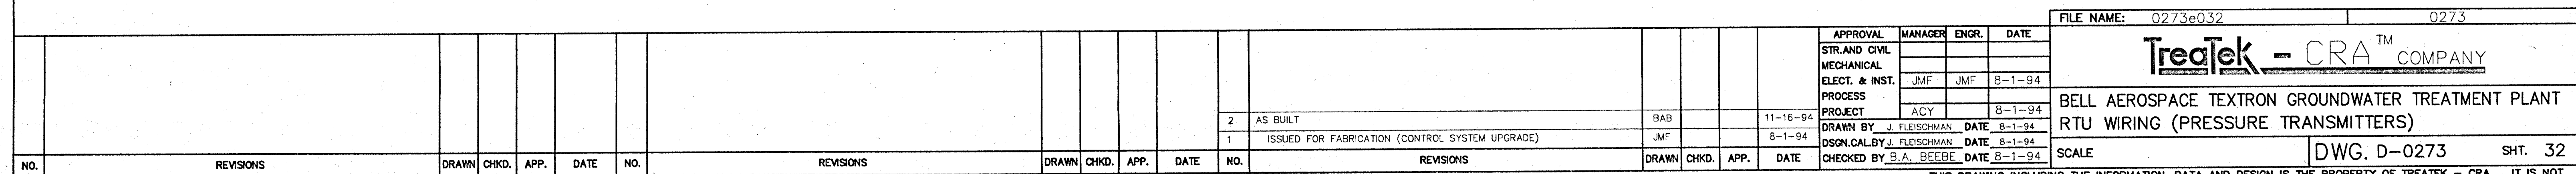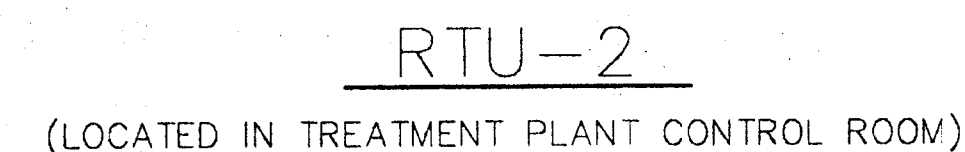

THIS DRAWING INCLUDING THE INFORMATION, DATA AND DESIGN IS THE PROPERTY OF TREATEK - CRA. IT IS NOT TO BE COPIED, REPRODUCED OR ITS CONTENTS DIVULGED WITHOUT THE WRITTEN PERMISSION OF TREATEK - CRA.