



**APPENDIX R
AS-BUILT DRAWING**

ENGLISH KILLS

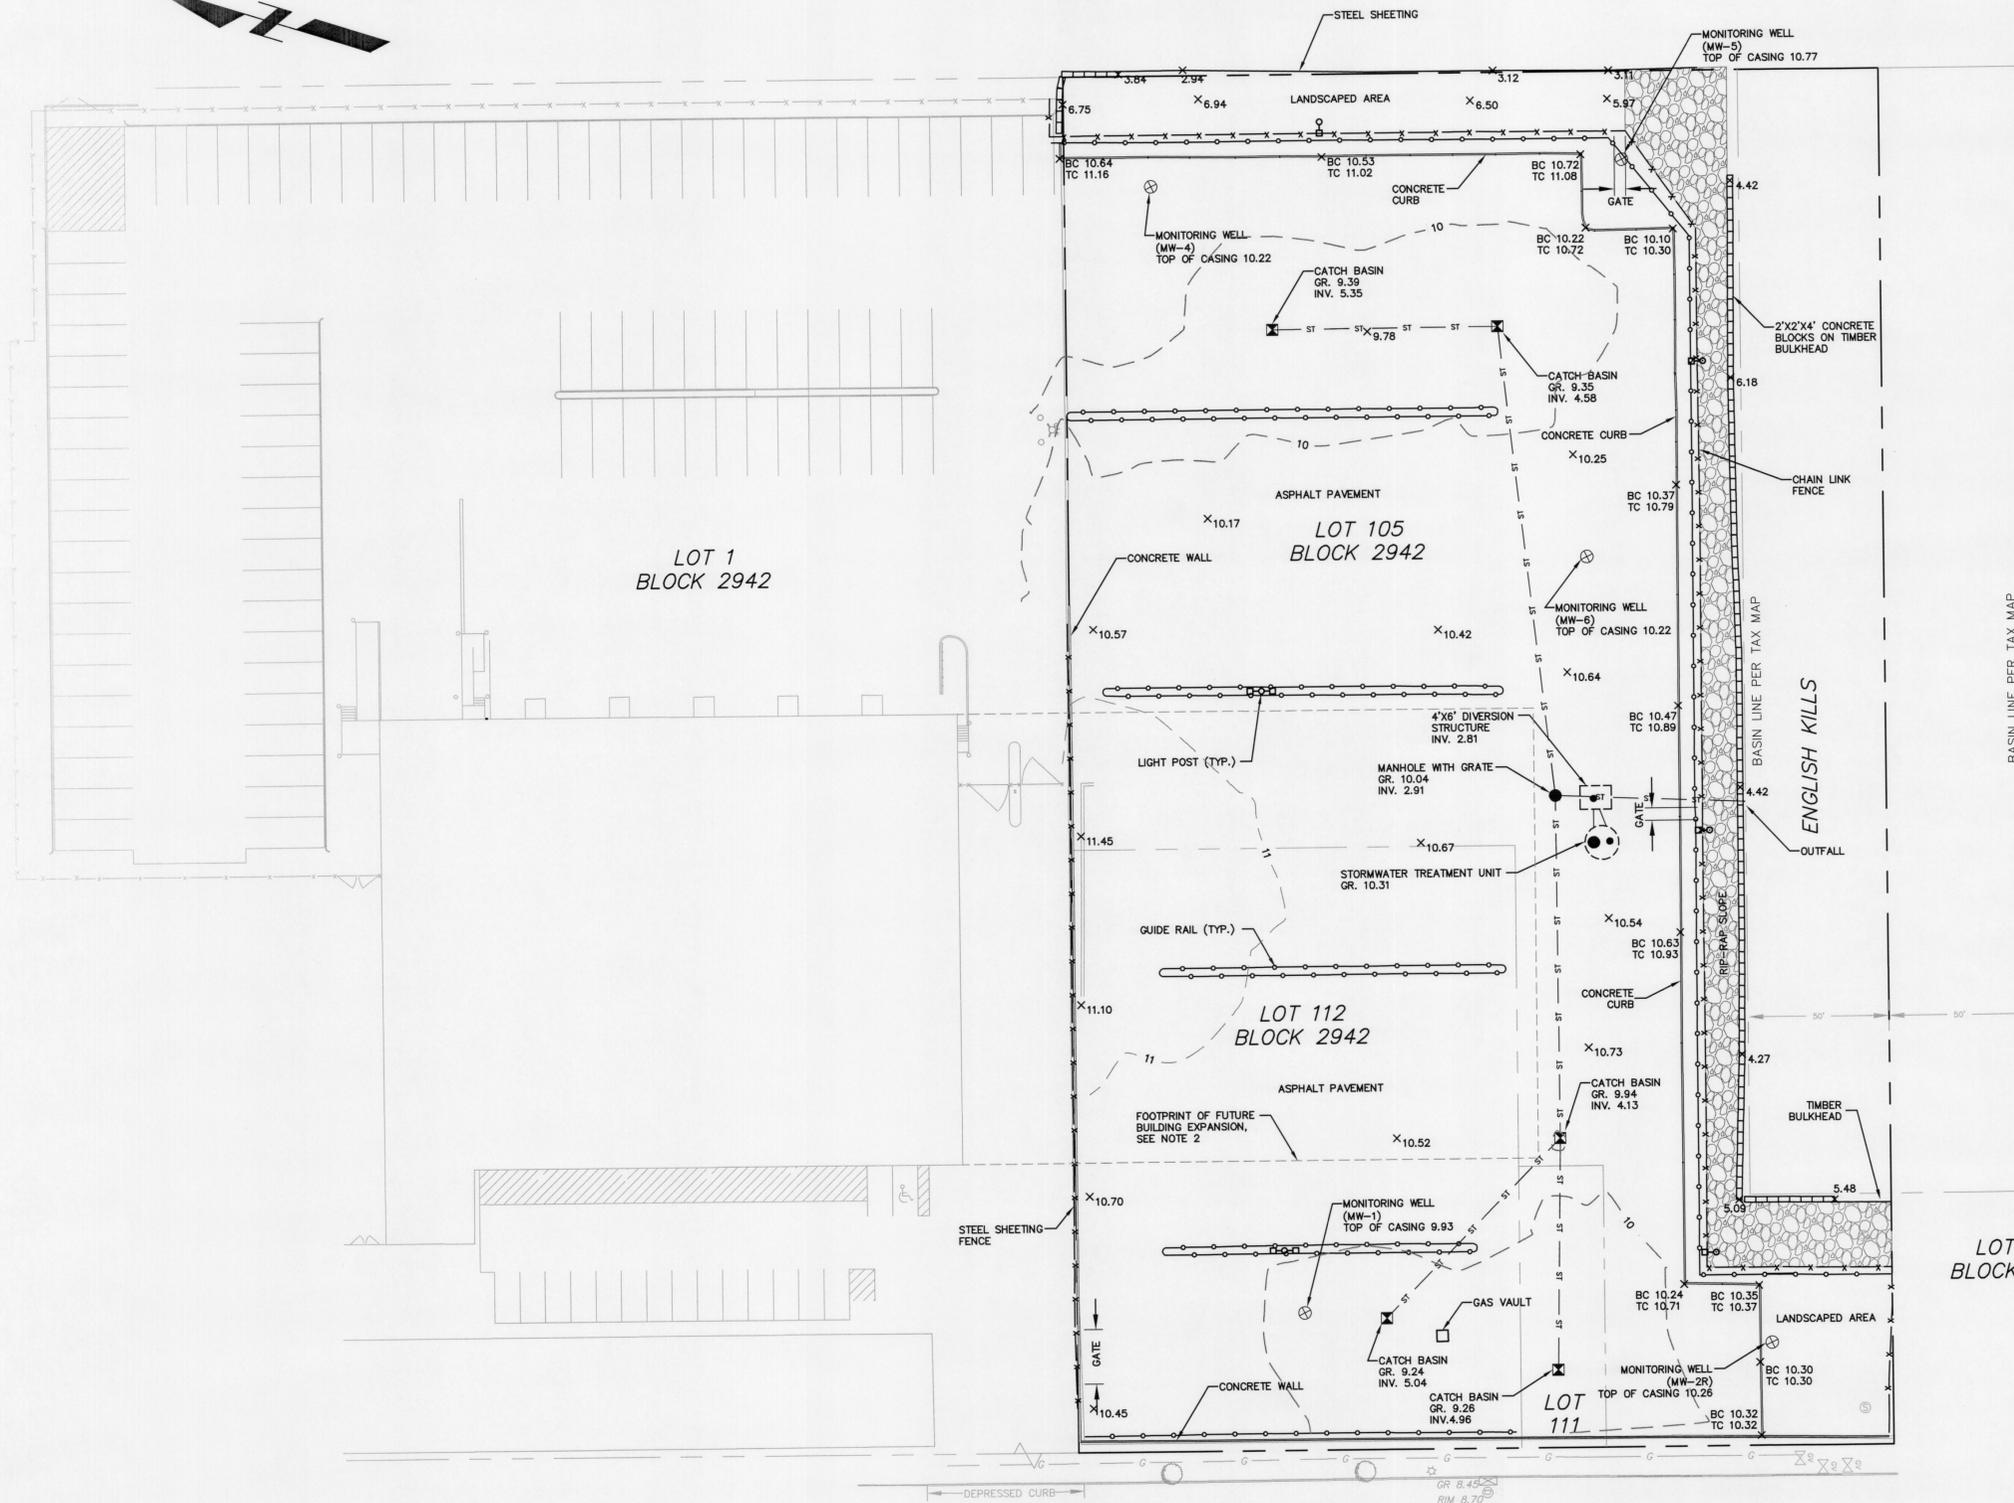

NOTES:

- AS-BUILT INFORMATION SHOWN REFERENCES A DRAWING TITLED "FRITO LAY DISTRIBUTION CENTER ADDITIONAL PARKING AS-BUILT" PREPARED BY "DIMENSION DEVELOPMENT CORP.", DATED 07/08/2013.
- BASED ON THE "SITE MANAGEMENT PLAN" PREPARED BY GANNETT FLEMING ENGINEERS, P.C., SOIL WITHIN THE FUTURE BUILDING FOOTPRINT AREA WAS REMEDIATED TO BELOW 10 PPM FOR PCB'S.

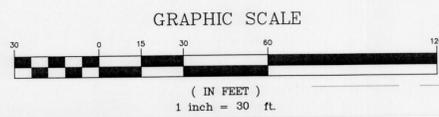

MORGAN AVENUE (60 FEET WIDE)

MEADOW STREET

REVISIONS/ISSUES					
NO.	DATE	BY	CHK	DESCRIPTION	

APPLICANT

ALL DIMENSIONS MUST BE VERIFIED BY THE CONTRACTOR. NOTIFY PAULUS, SOKOLOWSKI AND SARTOR OF ANY CONTRACT, ERROR, AMBIGUITIES OR DISCREPANCIES IN THE CONTRACT DRAWINGS OR SPECIFICATIONS BEFORE PROCEEDING WITH CONSTRUCTION.
 THESE CONTRACT DRAWINGS CONTAIN DATA INTENDED SPECIFICALLY FOR THE NOTED PROJECT AND CLIENT. THEY ARE NOT INTENDED FOR USE OR EXTENSION OF THIS PROJECT OR FOR REUSE ON ANY OTHER PROJECT.
 THE COPYING AND/OR MODIFICATION OF THIS DOCUMENT OR ANY PORTION THEREOF WITHOUT THE WRITTEN PERMISSION OF PAULUS, SOKOLOWSKI AND SARTOR IS PROHIBITED.
 COPYRIGHT 2013 PAULUS, SOKOLOWSKI AND SARTOR - ALL RIGHTS RESERVED.

ANDREW L. GRUNDY, P.E.
 PROFESSIONAL ENGINEER
 N.Y. LICENSE 074140

 SIGNATURE DATE 9-18-13

55 MAIN STREET, 3RD FLOOR
 YONKERS, NEW YORK 10701
 PHONE: (914) 939-8600 FAX: (914) 937-1679

PROJECT TITLE
FRITO LAY DISTRIBUTION CENTER ADDITIONAL PARKING

SHEET TITLE
AS-BUILT PLAN

DATE	8/21/2013	JOB NO.	03953.001
SCALE	1"=30'	B/O	
DRAWN	RP	SHEET NO.	1 of 1
CHKD.	ALG		

BOROUGH OF BROOKLYN, KINGS COUNTY, NY 11237