


Site Boundary




**ENVIRONMENT & INFRASTRUCTURE** 200 AMERICAN METRO BLVD, SUITE 113 HAMILTON, NEW JERSEY 08619


Rad I and Rad II Long Island City, Queens, New York

PROJ. NO.	34801203	03/06/2014			
DWN.	WSL	CHKD	NS		

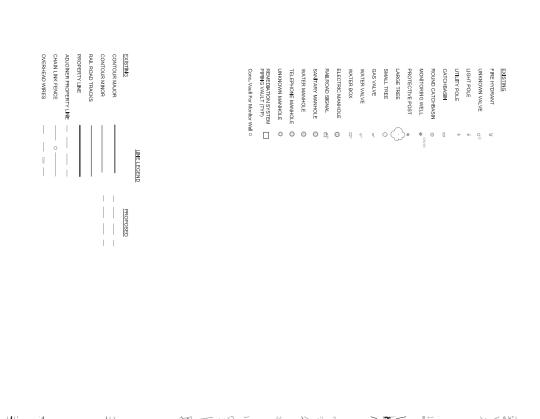

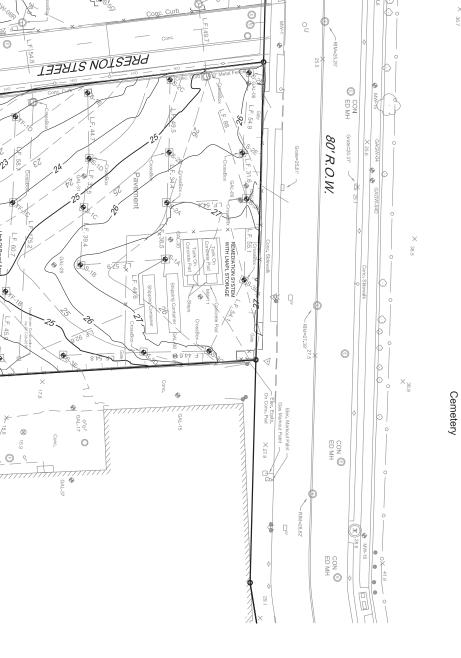

Key Map Not To Scale

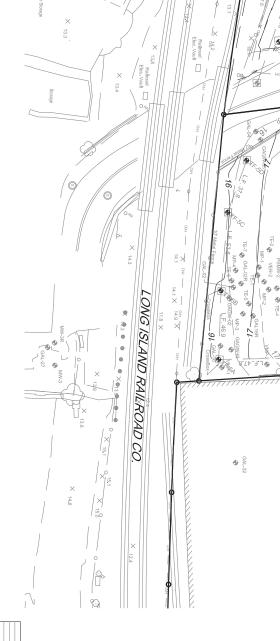

- 2. ANTTHING SHOWN OUTSIET THE DEFINED BOUNDARY OF THE MAP IS FOR DESCRIPTINE PURPOSES ONLY.

  2. HENDOR A MUNICIPAL COPY OF THE DOCUMENT UNLIES IT BENEVER THE OPIQINAL SEAN THERE AND THE PAYSED, EMBOSSED SEAL OF THE SURVEYOR NOTED HEREON. HORIZONTAL DATUM IS NORTH AMERICAN DATUM OF 1983 (NAD83 NEW YORK STATE PLANE COORDINATES, LONG ISLAND ZONE 3104). VERTICAL DATUM NORTH AMERICAN VERTICAL DATUM OF 1988; NAVD88.
- THIS SURPLY IS SUBJECT TO MAY EXCELLENTS, RESTRICTIONS, OR CONDEMNITS THAT MAY EXET. THE PROPERTY MAY ALSO DES BUBBECT TO MAPOUS SURPLY EXCELLENT EXCELLENTS HE POWER TELEPHONE SAMMAY & REFERENCE DED SESSIONAL PRESENCE FACES OF THE REPORT OF THE REPORT OF THE PROPERTY MAY UTILITIES SENOM HEREON MAY EXCELLENT ON THE REPORT OF THE PROPERTY MAY UTILITIES SENOM HEREON OF THE PROPERTY MAY UTILITIES TO SET OF THE PROPERTY
- . SURVEY IS BASED UPON GPS. RAPID STATIC APPLICATIONS, ALONG WITH CONVEXITIONAL SURVEY METHODS. ALL SURVEYING WAS PERFORMED BETWEEN APRL. AND JULY 2011, DECEMBER 2014 AND UPDATED JULY MOD JAIGUST 2015. AWARDON SHARING WITH THE WORLD CHARLES WERE SAWN SYCLOSIS HOUGH STATE OF THE WORLD SHARING STATES AND SHARING SHARING
- 7. MONITORING WELLS SHOWN ARE FROM PLANS, CURRENT FIELD MEASUREMENTS AND OR HISTORICAL FIELD MEASUREMENTS. UNAUTHORIZED ALTERATION OR ADDITION TO A SURVEY MAP BEARING A LICENSED LAND SURVEYOR'S SEAL IS A VIOLATION OF SECTION 7208, SUB-DIVISION 2, OF THE NEW YORK STATE EDUCATION LAW.
- ALL DISTANCES SHOWN ARE IN U.S. SURVEY FEET.



Revisions	Devisions	Doodala								
		I ong Island City Queens NY 11101	37-80 Review Avenue	Block 312 Lot 69		Final Grading As-Built	24 Kanouse Rd., Newfoundland, N.J. 07435 - (973) 697-2122 FAX: (973) 639-6433 Checked	PHOTOGRAMMETRIC SCIENCES - SURVEY TECHNOLOGIES CORPORATE OFFICE:	GEUU CORPORATION	
ago.	Dane.		Proj No.		Date	Scale:	Checked:		Drawn By S.B.M.	
9	of 1		3523		10/12/15	1" = 30'	R		SBM	
The annual point of the state o	1 of 1 N.Y. Professional Land Surveyor Lie. No 50203	PAUL J EMILIUS Jr								

