

APPENDIX L

As-Built Drawings



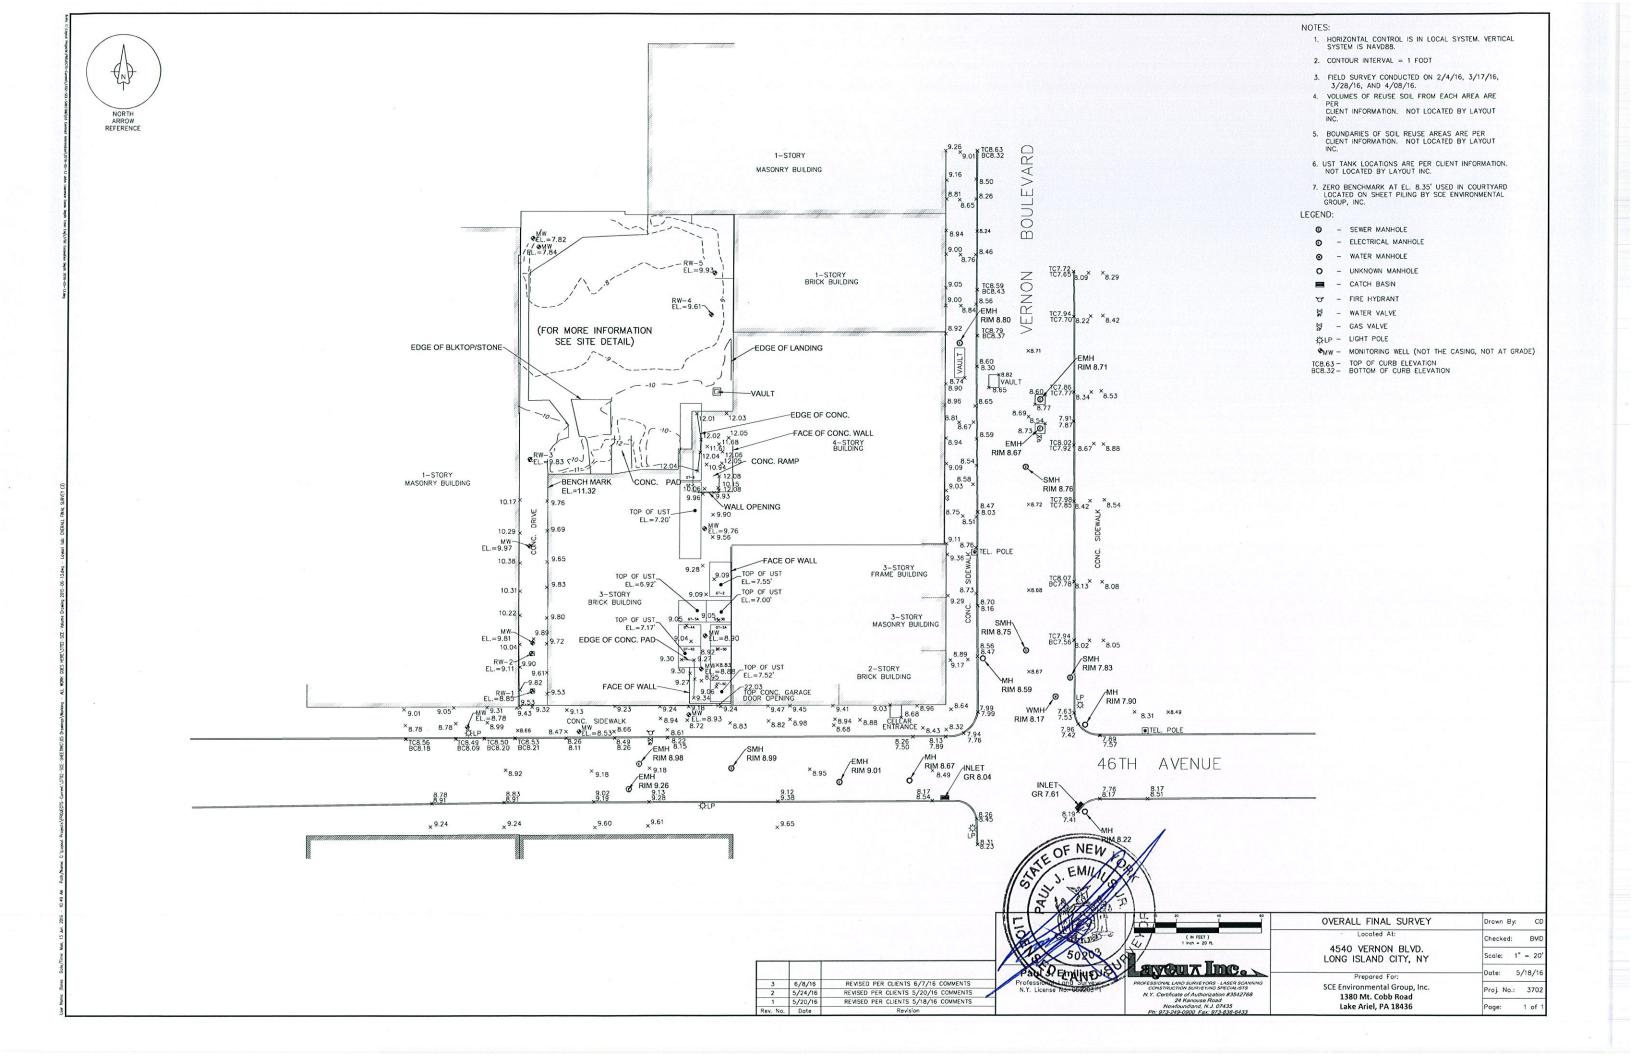

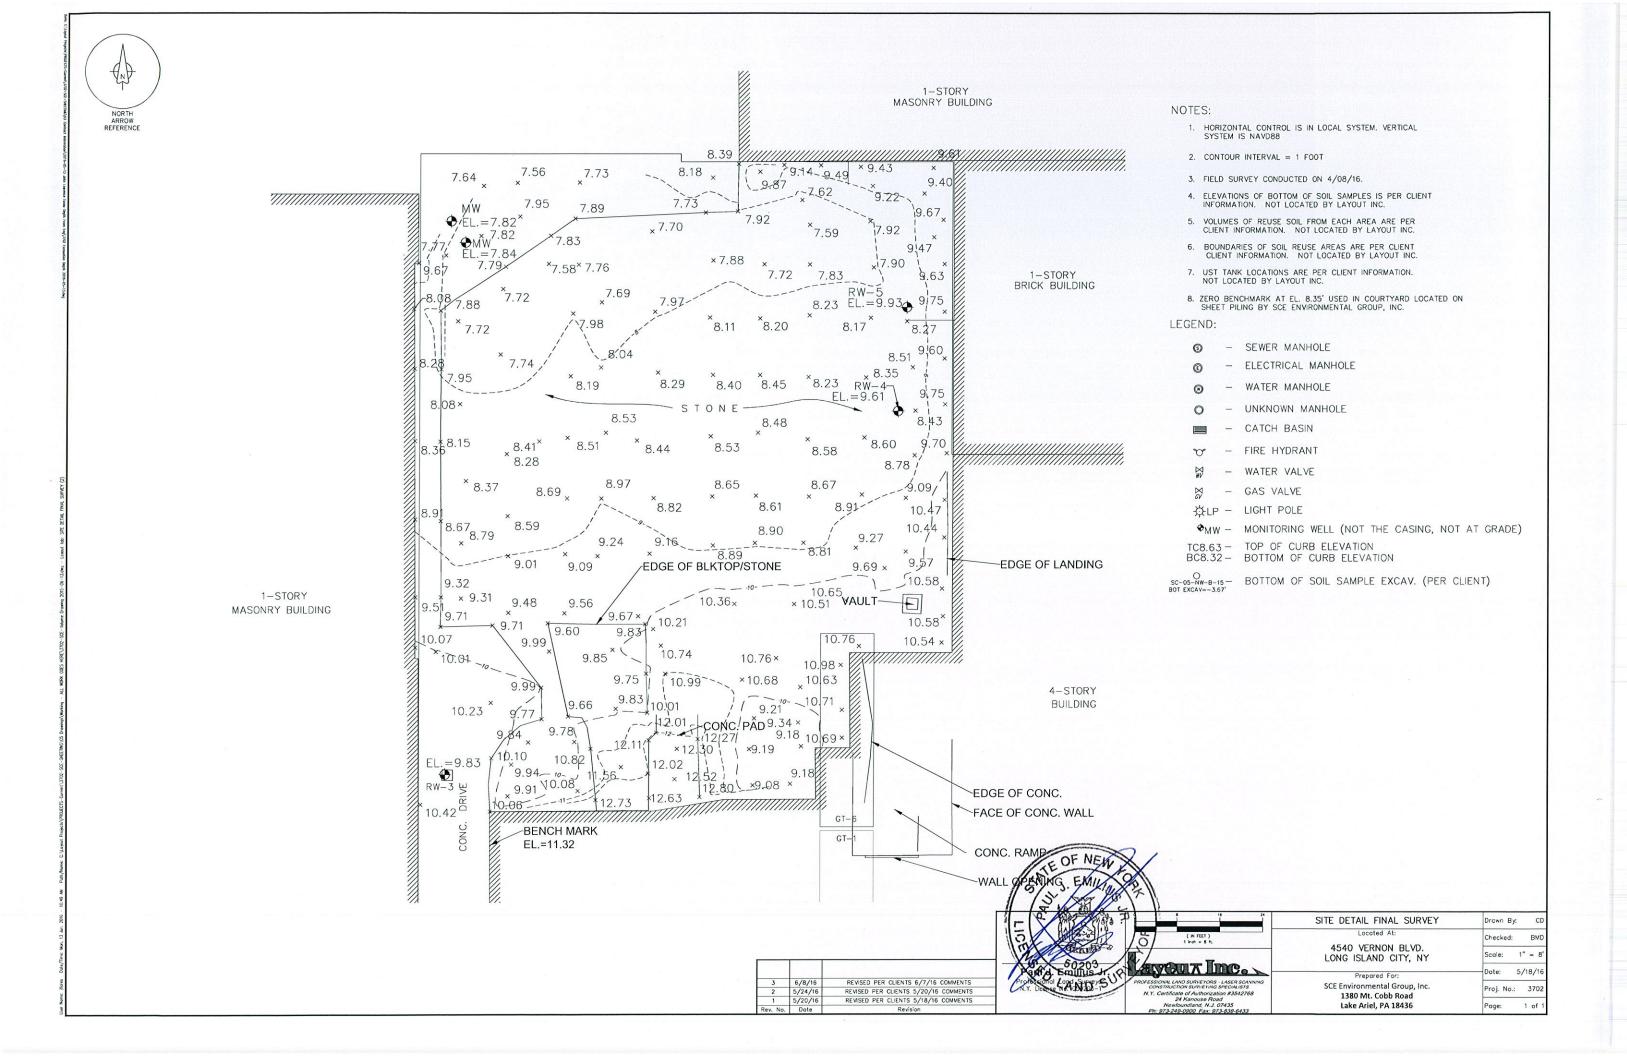

1-STORY MASONRY BUILDING

NOTES:

- 1. HORIZONTAL CONTROL IS IN LOCAL SYSTEM. VERTICAL SYSTEM IS NAVD88
- 2. CONTOUR INTERVAL = 1 FOOT
- 3. FIELD SURVEY CONDUCTED ON 11/20/15.
- 4. UST TANK LOCATIONS ARE PER CLIENT INFORMATION. NOT LOCATED BY LAYOUT INC.
- 5. ZERO BENCHMARK AT EL. 8.35' USED IN COURTYARD LOCATED ON SHEET PILING BY SCE ENVIRONMENTAL GROUP, INC.

7.63 ×7.93 ×7.96 ×7.83 ×7.80 ×7.87 8.30 ×9.03 ×7.55 ×7.85 8.25 7.97~ 9.10 ×7.19 ×6.69 7.97-6.76 ×7.29 ×6.61 9.097 1-STORY BRICK BUILDING 8.08 4 9.7, ×6.82 ×7.45 ×6.69 ×7.22 ×6.85 7.04-×7.49 ×7.28 ×7.12 ×7.32 ×7.21 ×7.88 × <= √7.21 7.97 7.11^x ×7.34 ×7.45 ×7.27 ¹/_{7.36} ¹/_{7.49} ×7/92 ×8.17 ×7.42 7.68 8.56-9.20-_{7.68} ×7.58 ×7.41 8.22^{-X} ×8.36 7.98* ×8.09 ×8.18 _×Z.96 ×8.18 ×8.03 ×8.21 ×8.21 8.25 ₆8.13 €8.19 ×8.32 x -=£^{7.98} 8.39-×9.31 ×8.95 4-STORY BUILDING 12.22 ×9,07 12.16 79.62 ×12.69 12.32-12.24 12.42 -8.82 GT-6 BENCH MARK GT-1 EL.=11.32

3 6/8/16 2 5/24/16 1 5/20/16

REVISED PER CLIENTS 6/7/16 COMMENTS

REVISED PER CLIENTS 5/20/16 COMMENTS

REVISED PER CLIENTS 5/18/16 COMMENTS

1-STORY MASONRY BUILDING

MAUX Inc.

ion \$ 02000

LAND S

PRE-EXCAVATION SURVEY Drawn By: Checked: BME 4540 VERNON BLVD. LONG ISLAND CITY, NY Scale: 5/18/16 Prepared For: SCE Environmental Group, Inc. Proj. No.: 3702 1380 Mt. Cobb Road Lake Ariel, PA 18436 Page:

