



## VIA ELECTRONIC MAIL

November 6, 2020

Mr. Christopher Mannes III, P.E.  
Environmental Engineer II  
New York State Department of Environmental Conservation  
615 Erie Boulevard West  
Syracuse, NY 13204-2400

**Subject: Third Quarter 2020 Progress Report  
Former Rollway Bearing Corporation Facility, Liverpool, New York  
Agreement Index Number: V7-1007-96-10**

Dear Mr. Mannes:

On behalf of Emerson Electric Co., WSP USA Inc. is submitting this Third Quarter 2020 Progress Report for the former Rollway Bearing Corporation facility in Liverpool, New York. This quarterly progress report summarizes all work completed at the former Rollway Bearing facility from July through September 2020 and work planned for October through December 2020. The report was prepared in accordance with the requirements of the Site Management Plan, dated March 6, 2018, and includes the following information:

- a summary of all work completed and the results of sampling and testing performed during the reporting period
- a summary of reports and deliverables that were completed and submitted during the reporting period
- an estimate of the percentage of completion of the approved work plan activities, problems encountered during the quarter and actions taken to alleviate those problems, and modifications to work plans approved by the New York State Department of Environmental Conservation (NYSDEC)
- a description of activities anticipated to be completed during the next quarter

## WORK COMPLETED

The following activities were completed during July through September 2020:

- WSP conducted operation, maintenance, and monitoring (OM&M) visits on July 30 and September 24, 2020, to ensure proper operation of the light non-aqueous phase liquid (LNAPL) recovery system. The OM&M logs are included in Enclosure A. The LNAPL recovery system was operational during the quarter. As part of the routine maintenance on the LNAPL recovery system, the dilution and inline air filters were replaced during the quarter.
- During the July site visit, LNAPL thickness measurements were collected from 15 observation or recovery wells (Figure 1). After the LNAPL measurements were collected, new absorbents were installed in all the wells except for wells RW-2, OW-4, OW-8, SB-7, and SB-10 because no product was observed in these wells during the site visit, or during the last 4 years of monitoring.
- During the September site visit, absorbent socks were removed from wells RW-1, OW-1, OW-2, OW-3, OW-5, SB-8, OW-10/FB-1, and OW-11/FB-4, weighed, and placed in a U.S. Department of Transportation (DOT)-compliant 55-gallon steel drum for subsequent characterization and offsite disposal (Enclosure B). New absorbent socks were installed in these wells. The weights of the new and spent absorbent socks were used to determine the mass of LNAPL removed, which was then converted to

WSP USA  
7000 East Genesee Street  
Building D, 2nd Floor  
Fayetteville, NY 13066

Tel.: +1 315 655-3900  
wsp.com



volume using an assumed density for the LNAPL. The existing absorbents in wells SB-5 and OW-9/FB-2 were not removed and replaced because no staining was observed on these absorbents. During the September site visit, LNAPL thickness measurements were collected from wells RW-2, OW-4, OW-8, SB-7, and SB-10, which are wells that had no measurable product during the July site visit. Measurable product was observed in wells RW-2 and OW-4 and, therefore, absorbents were installed in these wells (Figure 1). No absorbents were installed in wells OW-8, SB-7, and SB-10 because no product was observed in these wells during the site visit.

- WSP installed a sub-slab depressurization system (SSDS) in the eastern portion of the former Rollway Bearing facility from August 10 to September 18, 2020, in accordance with the approved work plan. System start-up was completed on September 17, and the system is operational. A copy of the record drawings for the SSDS are provided in Enclosure C. WSP anticipates submitting a construction completion report for the SSDS during the fourth quarter of 2020.

## RESULTS OF SAMPLING AND TESTING

- During the July site visit, measurable LNAPL was present in the following wells above the remedial action objective: RW-1, OW-1, OW-2, OW-3, OW-5, SB-5, SB-8, OW-10/FB-1, and OW-11/FB-4 (Figure 1). No product was observed in wells RW-2, OW-4, OW-8, SB-7, SB-10, and well OW-9/FB-2 was dry.
- The five wells that did not exhibit measurable LNAPL in July and well OW-9/FB-2 (which was dry) were inspected for LNAPL again in September. Two of the wells (RW-2 and OW-4) contained measurable product during the September site visit. Wells OW-8, SB-7, and SB-10 had no measurable product, and OW-9/FB-2 was dry (Figure 1).
- Approximately 1.1 gallons of LNAPL were removed from the wells with absorbents during the reporting period.

## REPORTS AND DELIVERABLES

- WSP submitted the Second Quarter 2020 Progress Report to the NYSDEC on July 14, 2020, which summarized activities conducted from April through June 2020.
- On July 20, 2020, WSP submitted the Periodic Review Report for the site, which covered the reporting period from June 21, 2019, through June 21, 2020.

## PERCENTAGE OF COMPLETION

WSP estimates that the project is 90 percent complete.

## DIFFICULTIES/MODIFICATIONS TO WORK PLAN

- During the July 30, 2020, site visit, vacuum readings on the LNAPL recovery wells could not be taken because the portable vacuum gauge was inoperable.
- During the September 24, 2020, site visit, it was observed that the vacuum reading on OW-2 was low compared to typical operating readings; the cause for this decrease in vacuum in OW-2 will be evaluated during the fourth quarter of 2020 and corrected, as necessary.

## WORK PLANNED

The following work has been completed, or is anticipated to be undertaken, from October through December 2020:

- WSP will submit the Third Quarter 2020 Progress Report to the NYSDEC, which summarizes activities conducted from July through October 2020.
- WSP will conduct an OM&M visit in November 2020 to ensure proper operation of the LNAPL recovery system. During the site visit, absorbent socks will be removed from wells RW-1, RW-2, OW-1, OW-2, OW-3, OW-4, OW-5, SB-5, SB-8, OW-9/FB-2, OW-10/FB-1, and OW-11/FB-4, weighed, and placed in a DOT-compliant 55-gallon steel drum for subsequent characterization and offsite disposal. New absorbents will be placed in all wells except wells OW-8, SB-7, and SB-10, which had no measurable product during the September 24, 2020, site visit.



Please contact us at (315) 655-3900 with any questions regarding this Third Quarter 2020 Progress Report, or other aspects of the project.

Sincerely yours,

A handwritten signature in black ink that reads "Brian E. Silfer". The signature is written in a cursive, flowing style.

Brian E. Silfer, P.G.  
Practice Leader

BES:rl0

\\uscaz1ser01\es\clients\emerson\liperollway\reports\quarterly reports\2020\3rd q 2020

Enclosures

cc/encl.: Mr. Johnathan Robinson, New York State Department of Health  
Mr. Stephen L. Clarke, Emerson  
Ms. Sheila M. Harvey, Esquire, Pillsbury Winthrop Shaw Pittman

FIGURE



ENCLOSURE A – OM&M LOG SHEETS

Table 1

**Checklist**  
**LNAPL Recovery System**  
**Former Rollway Bearing Facility**  
**Liverpool, NY**

Date: 7/30/20Inspector (print): Nate WinstonArrival Time: 0940Inspector (sign): Departure Time: 1230Weather Conditions: 77°F, sunnyReason for Visit: OM&M

**LNAPL Recovery System Skid**

Gauge	O&M Reading		Typical Operation Reading	
	Reading	Units	Reading	Units
Inlet Vacuum: Before Vapor-Liquid Separator	<b>-70</b>	in H <sub>2</sub> O	-58 to -62	in H <sub>2</sub> O
Vacuum Before Air Filter	<b>-78</b>	in H <sub>2</sub> O	-66 to -68	in H <sub>2</sub> O
Vacuum After Air Filter/Before Blower Inlet	<b>-90</b>	in H <sub>2</sub> O	-86	in H <sub>2</sub> O
Discharge Stack Pressure	<b>2</b>	in H <sub>2</sub> O	2	in H <sub>2</sub> O
Discharge Stack Temperature	<b>145</b>	° F	120 to 138	° F
Kilowatt Hour Meter	-	kWh	-	kWh

**LNAPL Recovery Wells**

Well ID	O&M Reading		Typical Operation Reading	
	Vacuum (in H <sub>2</sub> O)	Flow (SCFM)	Vacuum (in H <sub>2</sub> O)	Flow (SCFM)
OW-2	-	<b>5.5</b>	-40 to -54	3 to 7
RW-1	-	<b>6</b>	-5 to -11	5.5 to 7
OW-3	-	<b>3.5</b>	-6 to -11	2 to 3
OW-8	-	<b>7</b>	-8 to -10	4 to 11

**Notable Observations:**

Vacuum readings on the LNAPL recovery wells could not be taken because portable gauge was broken.  
The kilowatt hours for the LNAPL recovery system skid were inadvertently not recorded.

**System Maintenance:**

Description of Maintenance Needed: \_\_\_\_\_

Date of Maintenance Completion: \_\_\_\_\_

Table 1

**Checklist**  
**LNAPL Recovery System**  
**Former Rollway Bearing Facility**  
**Liverpool, NY**

Date: 9/24/20Inspector (print): Nate WinstonArrival Time: 0900Inspector (sign): Nate WinstonDeparture Time: 1415Weather Conditions: 55°F, sunnyReason for Visit: OMM

**LNAPL Recovery System Skid**

Gauge	O&M Reading		Typical Operation Reading	
	Reading	Units	Reading	Units
Inlet Vacuum: Before Vapor-Liquid Separator	-38	in H <sub>2</sub> O	-58 to -62	in H <sub>2</sub> O
Vacuum Before Air Filter	-47	in H <sub>2</sub> O	-66 to -68	in H <sub>2</sub> O
Vacuum After Air Filter/Before Blower Inlet	-74	in H <sub>2</sub> O	-86	in H <sub>2</sub> O
Discharge Stack Pressure	3.5	in H <sub>2</sub> O	2	in H <sub>2</sub> O
Discharge Stack Temperature	110	° F	120 to 138	° F
Kilowatt Hour Meter	159,327	kWh	-	kWh

**LNAPL Recovery Wells**

Well ID	O&M Reading		Typical Operation Reading	
	Vacuum (in H <sub>2</sub> O)	Flow (SCFM)	Vacuum (in H <sub>2</sub> O)	Flow (SCFM)
OW-2	-11	8	-40 to -54	3 to 7
RW-1	-6.5	10	-5 to -11	5.5 to 7
OW-3	-15.5	7	-6 to -11	2 to 3
OW-8	-7.5	5	-8 to -10	4 to 11

**Notable Observations:**

*The vacuum readings on the LNAPL recovery system skid were low compared to typical operation readings, which was most likely the result of replacing the inline and dilution filters on the system.*

*The vacuum reading on OW-2 was low (-11) compared to typical operation vacuum reading (-40 to -54).*

**System Maintenance:**

Description of Maintenance Needed: *Evaluate cause of decrease in vacuum for OW-2 and perform required maintenance as needed.*

Date of Maintenance Completion:



## ENCLOSURE B – ABSORBENT INSPECTION/REPLACEMENT FORMS

**Field Form for Absorbent Inspection/Replacement**  
**Former Rollway Bearing Facility**  
**Liverpool, New York**

Date: September 24, 2020

Arrival Time: 09:00

Departure Time: 14:15

Inspector (print): Nathaniel Winston

Inspector (sign): 

Weather Conditions: 55 F, sunny

Well ID	Staining (Y/N)	Absorbent Replaced (Y/N)	Spent Absorbent Weight (g)
RW-1	Y	Y	1790.0
RW-2	**	Y	-
OW-1	Y	Y	743.5
OW-2	Y	Y	304.0
OW-3	Y	Y	404
OW-4	**	Y	-
OW-5	Y	Y	459.0
OW-8	*	N*	-
SB-5	N – Absorbent not installed correctly	N ***	-
SB-7	*	N*	-
SB-8	Y	Y	40.0
SB-10	*	N*	-
OW-10/FB-1	Y	Y	664
OW-9/FB-2	N - Dry	N****	-
OW-11/FB-4	Y	Y	1629

\* = no absorbent in well and no measurable product observed

\*\* = no absorbent in well and measurable product observed during September 24, 2020, site visit

\*\*\* = same absorbent left in well and not replaced.

**Notable Observations:**

OW-9/FB-2 appeared dry; absorbent in well SB-5 was not installed correctly in July

**Well Maintenance:**

Description of Maintenance Needed:

NA

Date of Maintenance Completion:

ENCLOSURE C – SUB-SLAB DEPRESSURIZATION SYSTEM RECORD DRAWINGS

\\slouis\GIS\GIS\Drawings\CLIENT\EMERSON\NY\Liverpool\_Frm Rollway\CD\314P1545.018-D14.dwg 10/2/2020 2:24 PM 10/2/2016

D

INDEX OF DRAWINGS		
DRAWING NUMBER	SHEET NUMBER	DESCRIPTION
314P1545.018-D14	1	TITLE SHEET
314P1545.018-D15	2	SSD SYSTEM LAYOUT
314P1545.018-D16	3	SSD SYSTEM CONSTRUCTION DETAILS

TITLE SHEET

SUB-SLAB DEPRESSURIZATION SYSTEM  
RECORD DRAWINGS

FORMER ROLLWAY BEARING FACILITY  
LIVERPOOL, NEW YORK


PREPARED FOR

EMERSON

ST. LOUIS, MISSOURI

DRAWN BY RA 02/10/20		CHECKED DC 02/10/20		APPROVED	
PROPERTY OF WSP USA INC. THIS DRAWING IS THE PROPERTY OF WSP USA INC. AND IS NOT TO BE REPRODUCED OR TRANSMITTED IN ANY FORM OR BY ANY MEANS, ELECTRONIC OR MECHANICAL, INCLUDING PHOTOCOPYING, RECORDING, OR BY ANY INFORMATION STORAGE AND RETRIEVAL SYSTEM, WITHOUT THE WRITTEN CONSENT OF WSP USA INC.		NOTICE: THIS DRAWING HAS BEEN PREPARED UNDER THE ASSURANCE AND LIABILITY OF WSP USA INC. AND IS NOT TO BE USED FOR ANY OTHER PROJECT OR FOR ANY OTHER PURPOSE WITHOUT THE WRITTEN CONSENT OF WSP USA INC.		NOTICE: THIS DRAWING HAS BEEN PREPARED UNDER THE ASSURANCE AND LIABILITY OF WSP USA INC. AND IS NOT TO BE USED FOR ANY OTHER PROJECT OR FOR ANY OTHER PURPOSE WITHOUT THE WRITTEN CONSENT OF WSP USA INC.	
TITLE SHEET					
FORMER ROLLWAY BEARING FACILITY LIVERPOOL, NEW YORK					
PREPARED FOR EMERSON ST. LOUIS, MISSOURI					
WSP USA Inc. 7000 E. GENESEE ST. BLDG D, 2ND FLOOR FAYETTEVILLE, NY 13066 TEL: +1 315.655.3900					
SHEET 1					
Drawing Number 314P1545.018-D14					
REVISIONS					
REV	DESCRIPTION				
1	Change: _____				
2	Change: _____				
499	Change:				




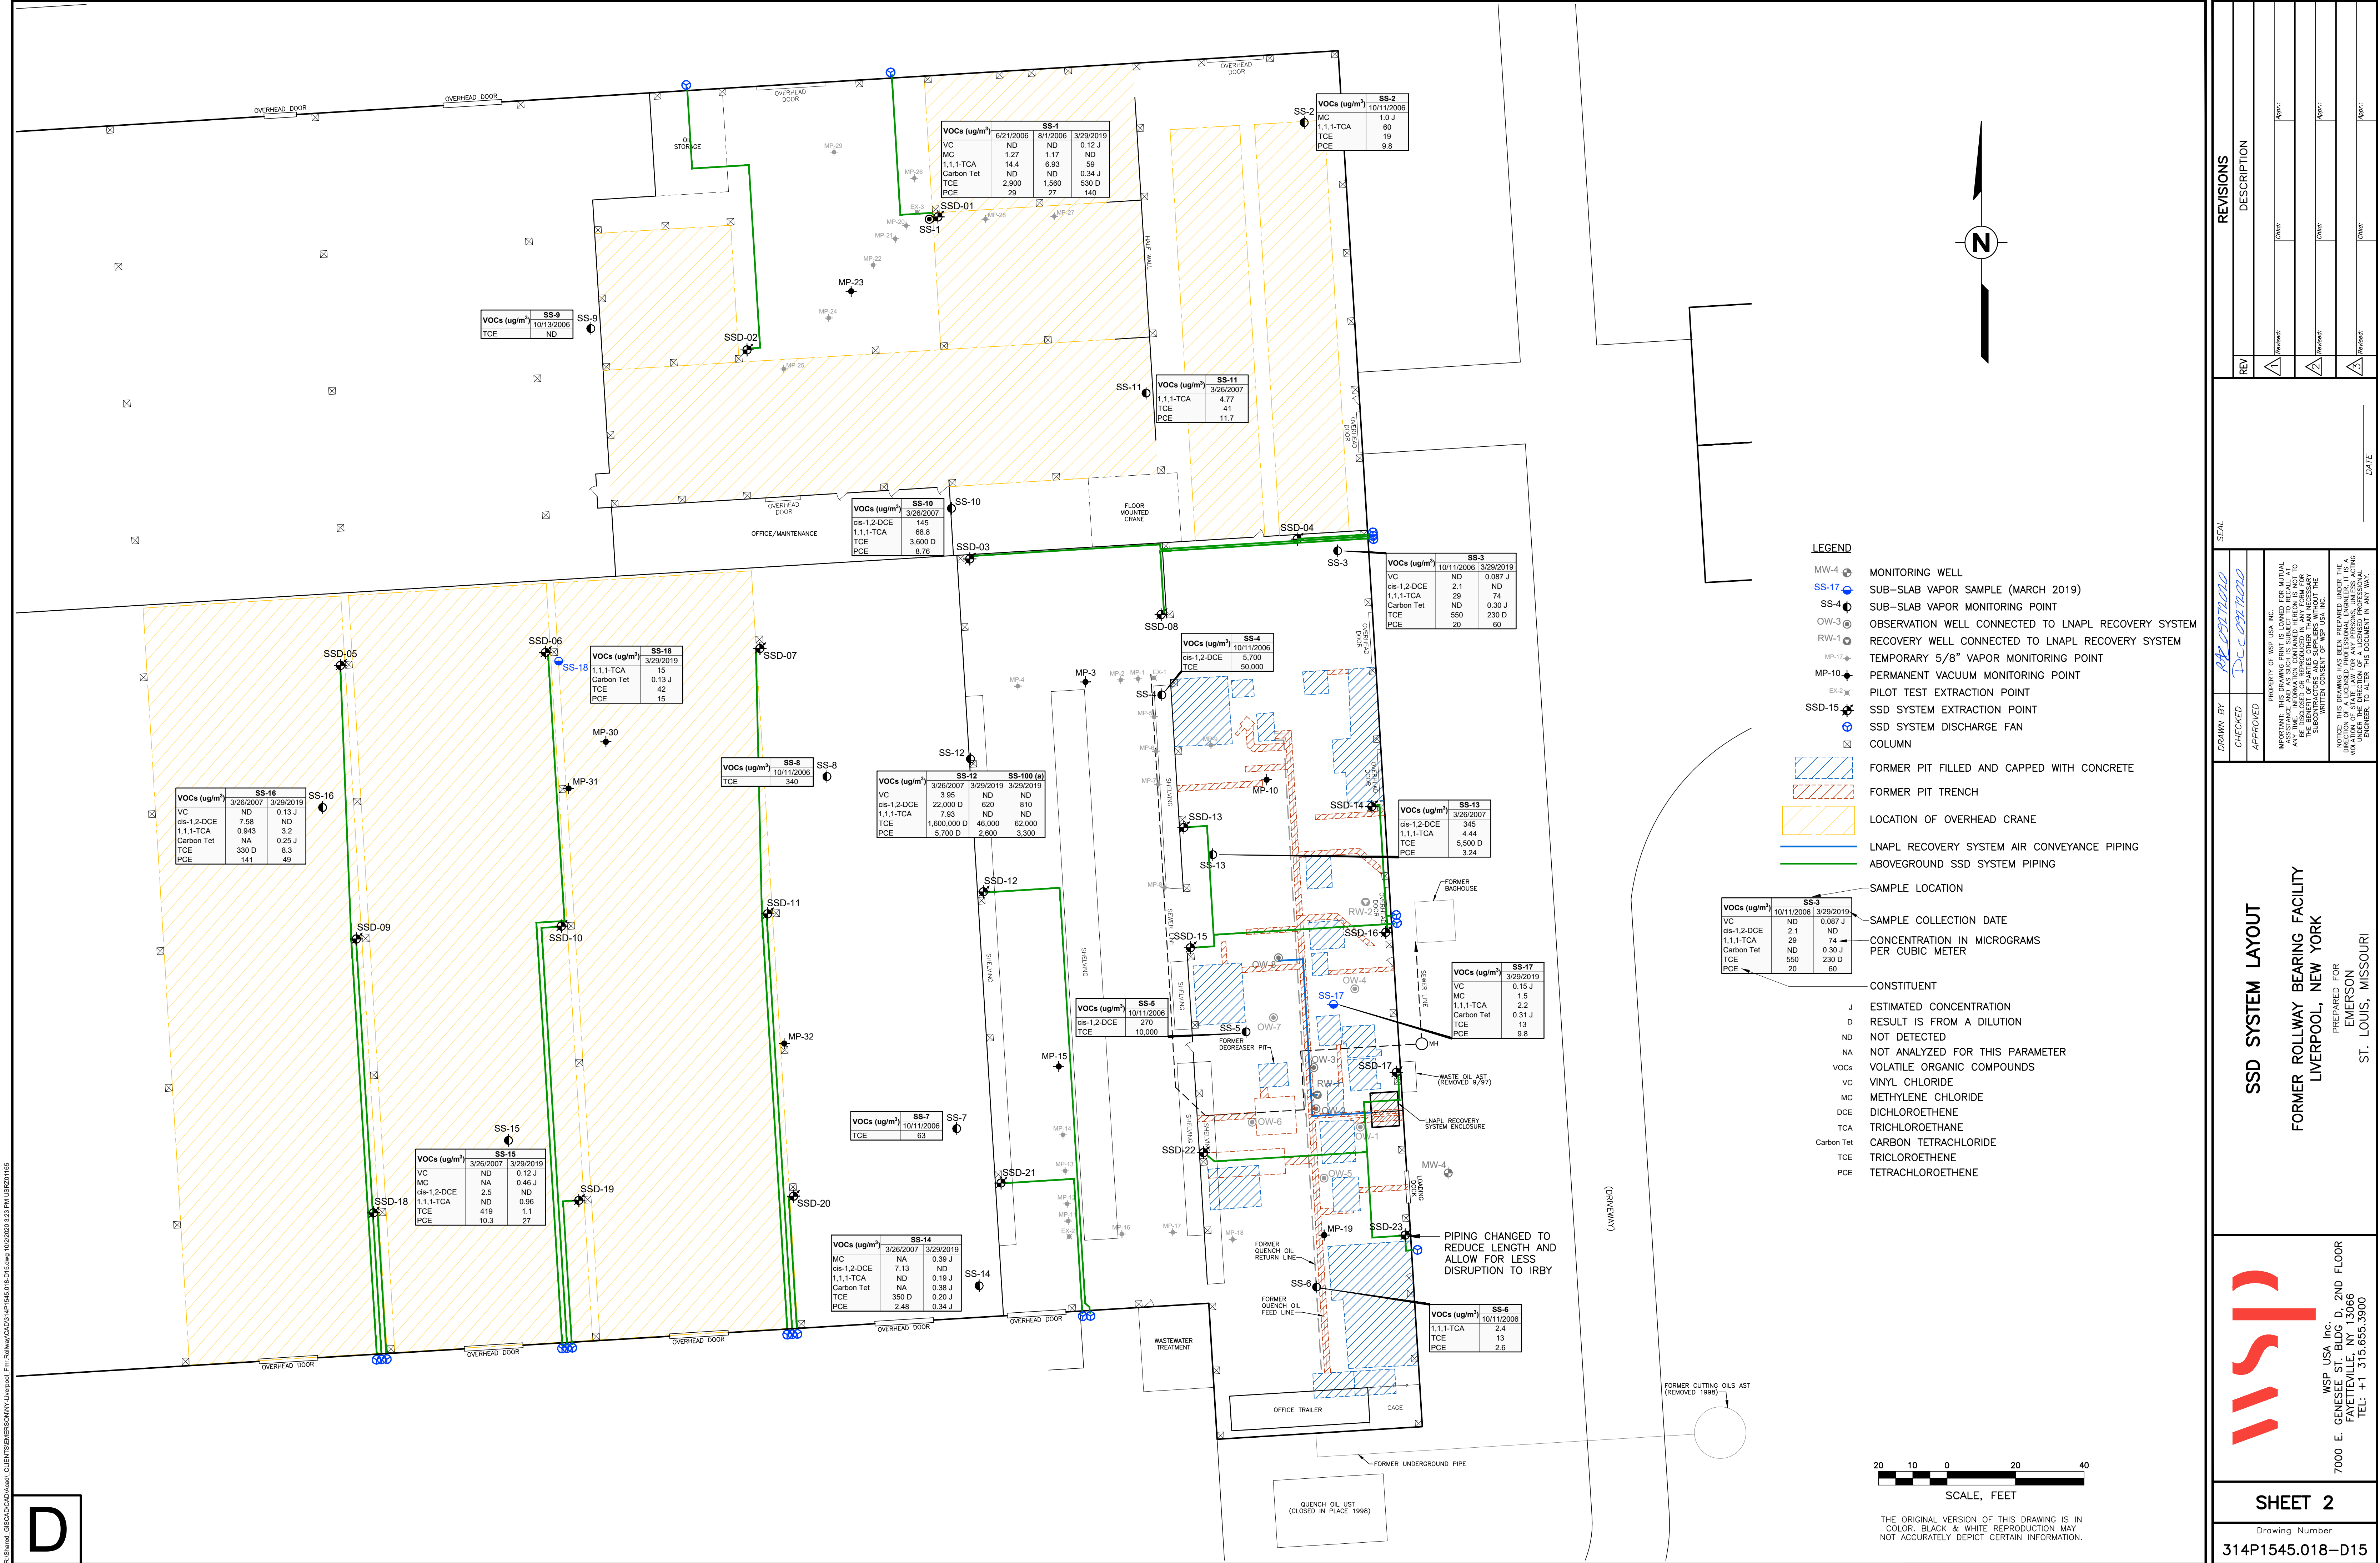




RSBhardi\_GBCACAD\dwg\CLINTS\EMERSON\NY\Liverpool\_Fm\_Railway\CAD\314P\314P-HS3000.dwg 10/12/2020 11:50 AM USR201165

D

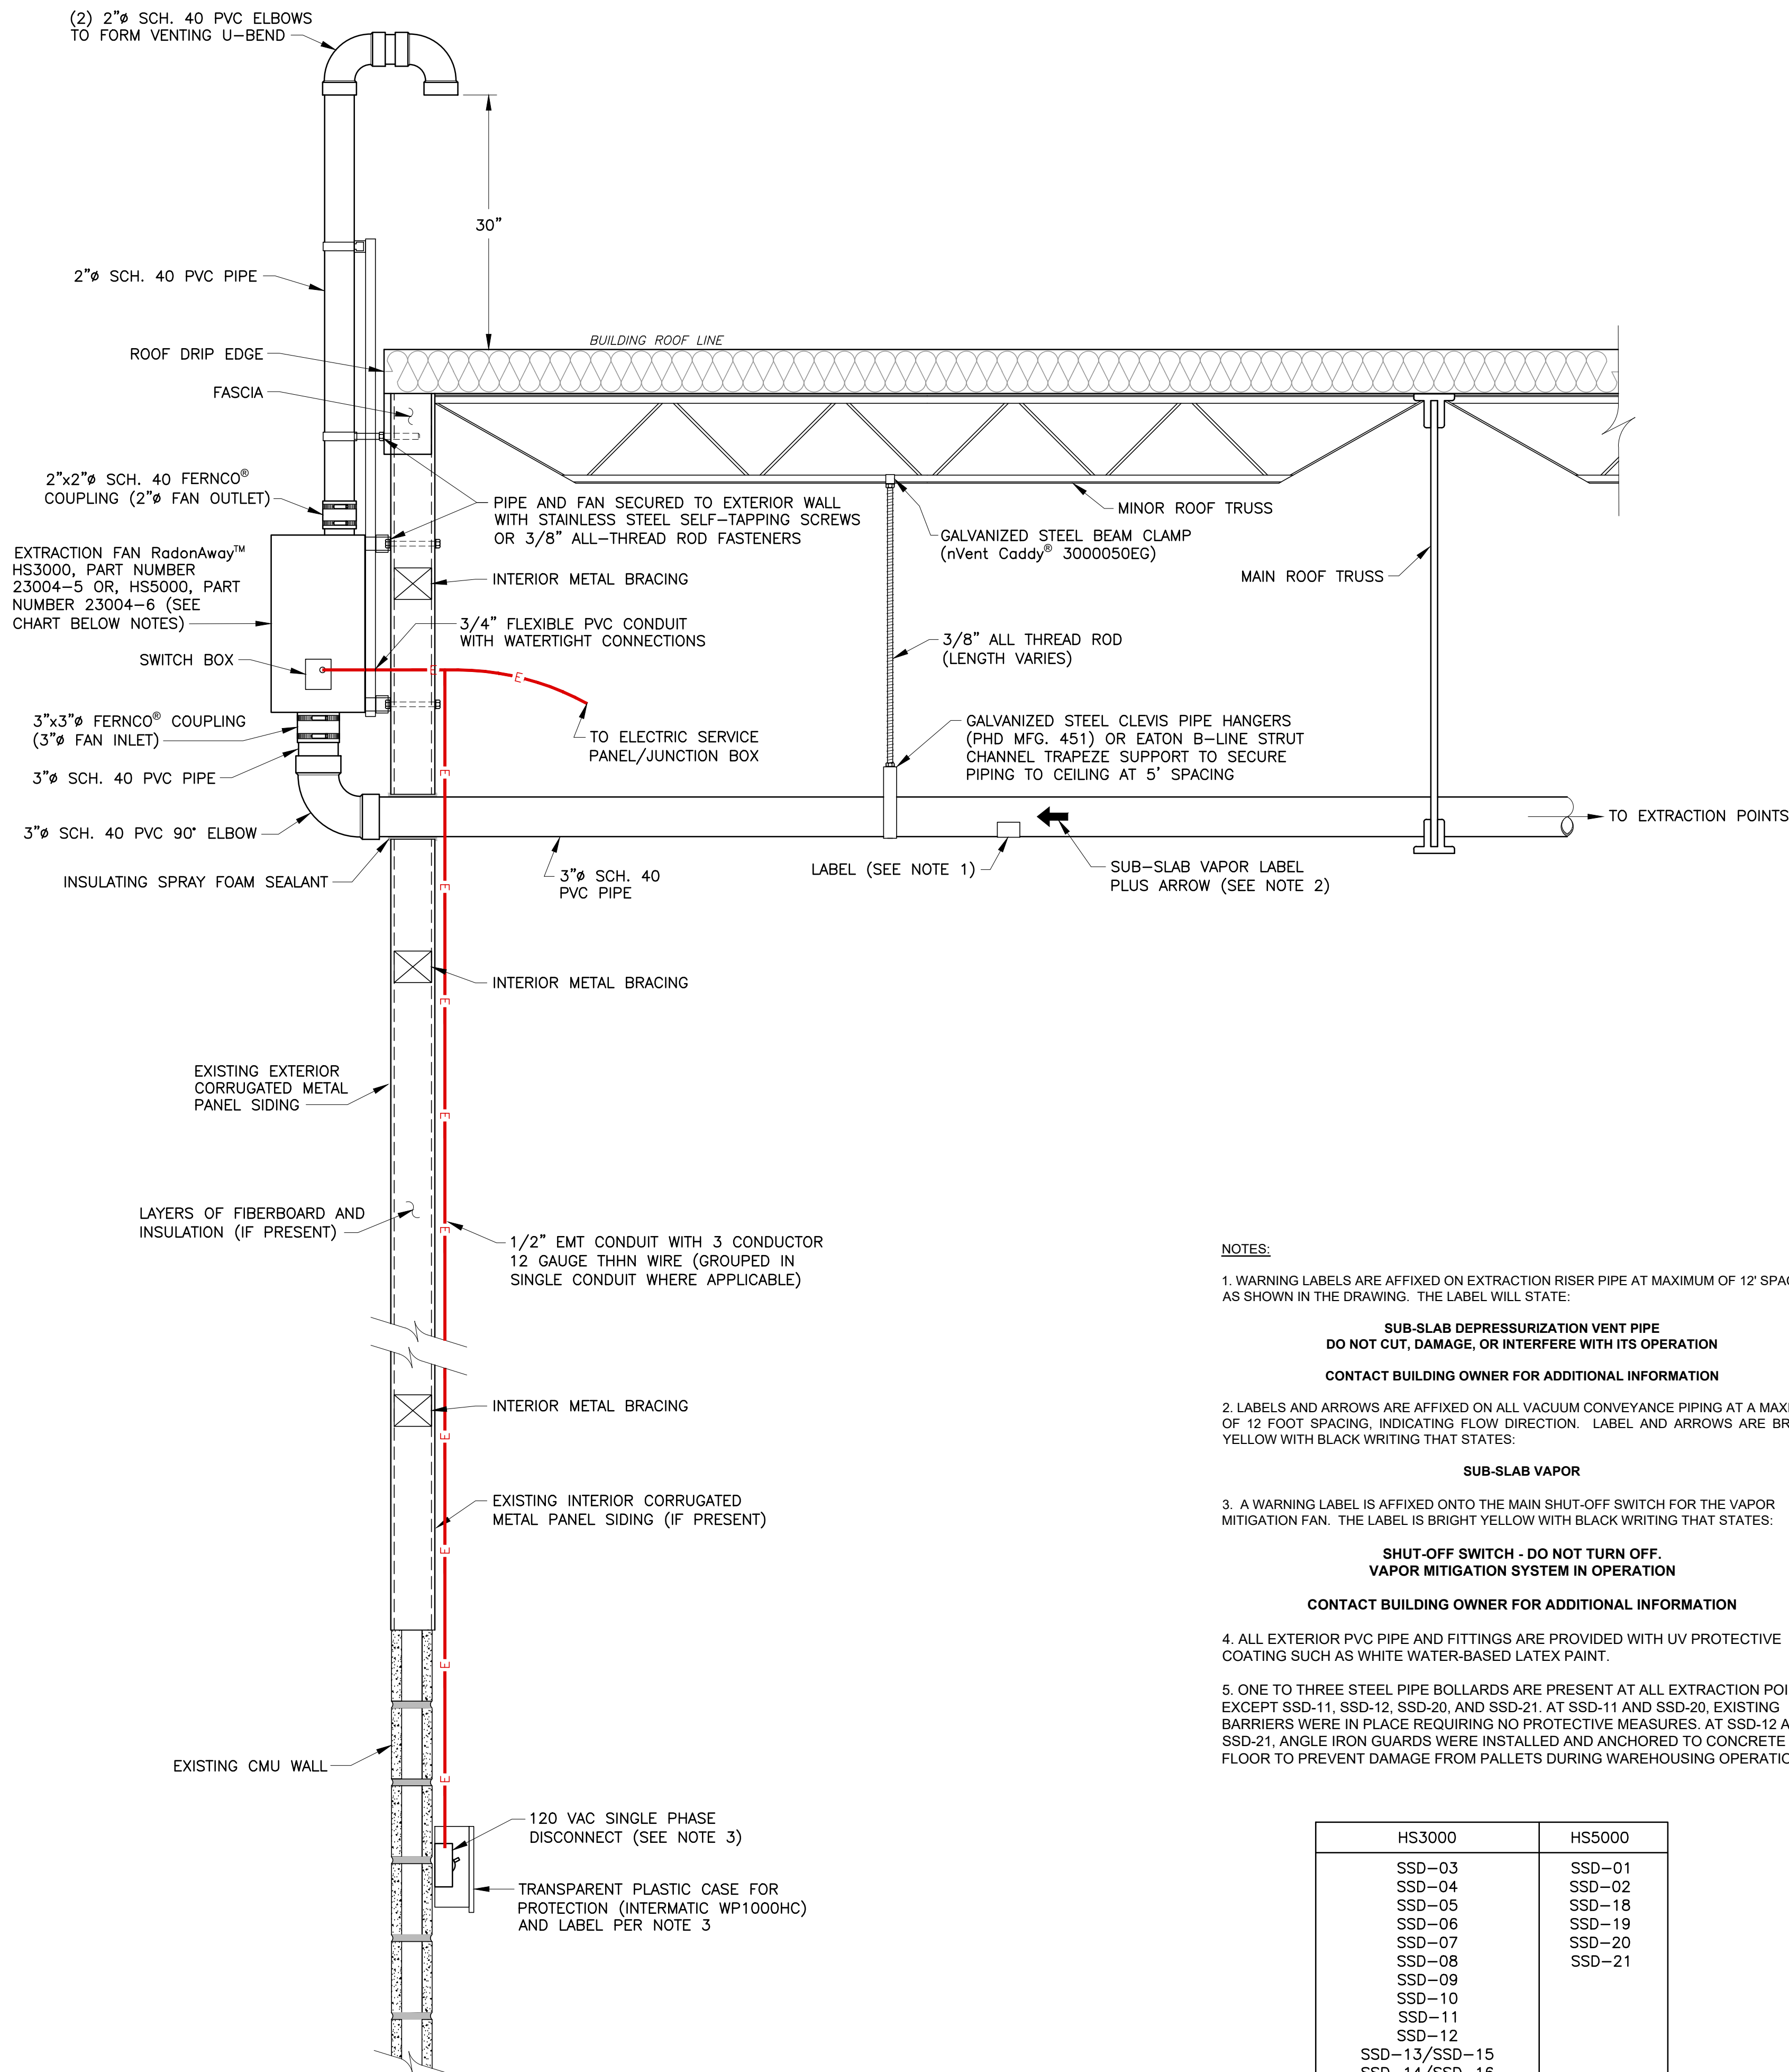

TYPICAL EXHAUST PIPING DETAIL

NOT TO SCALE

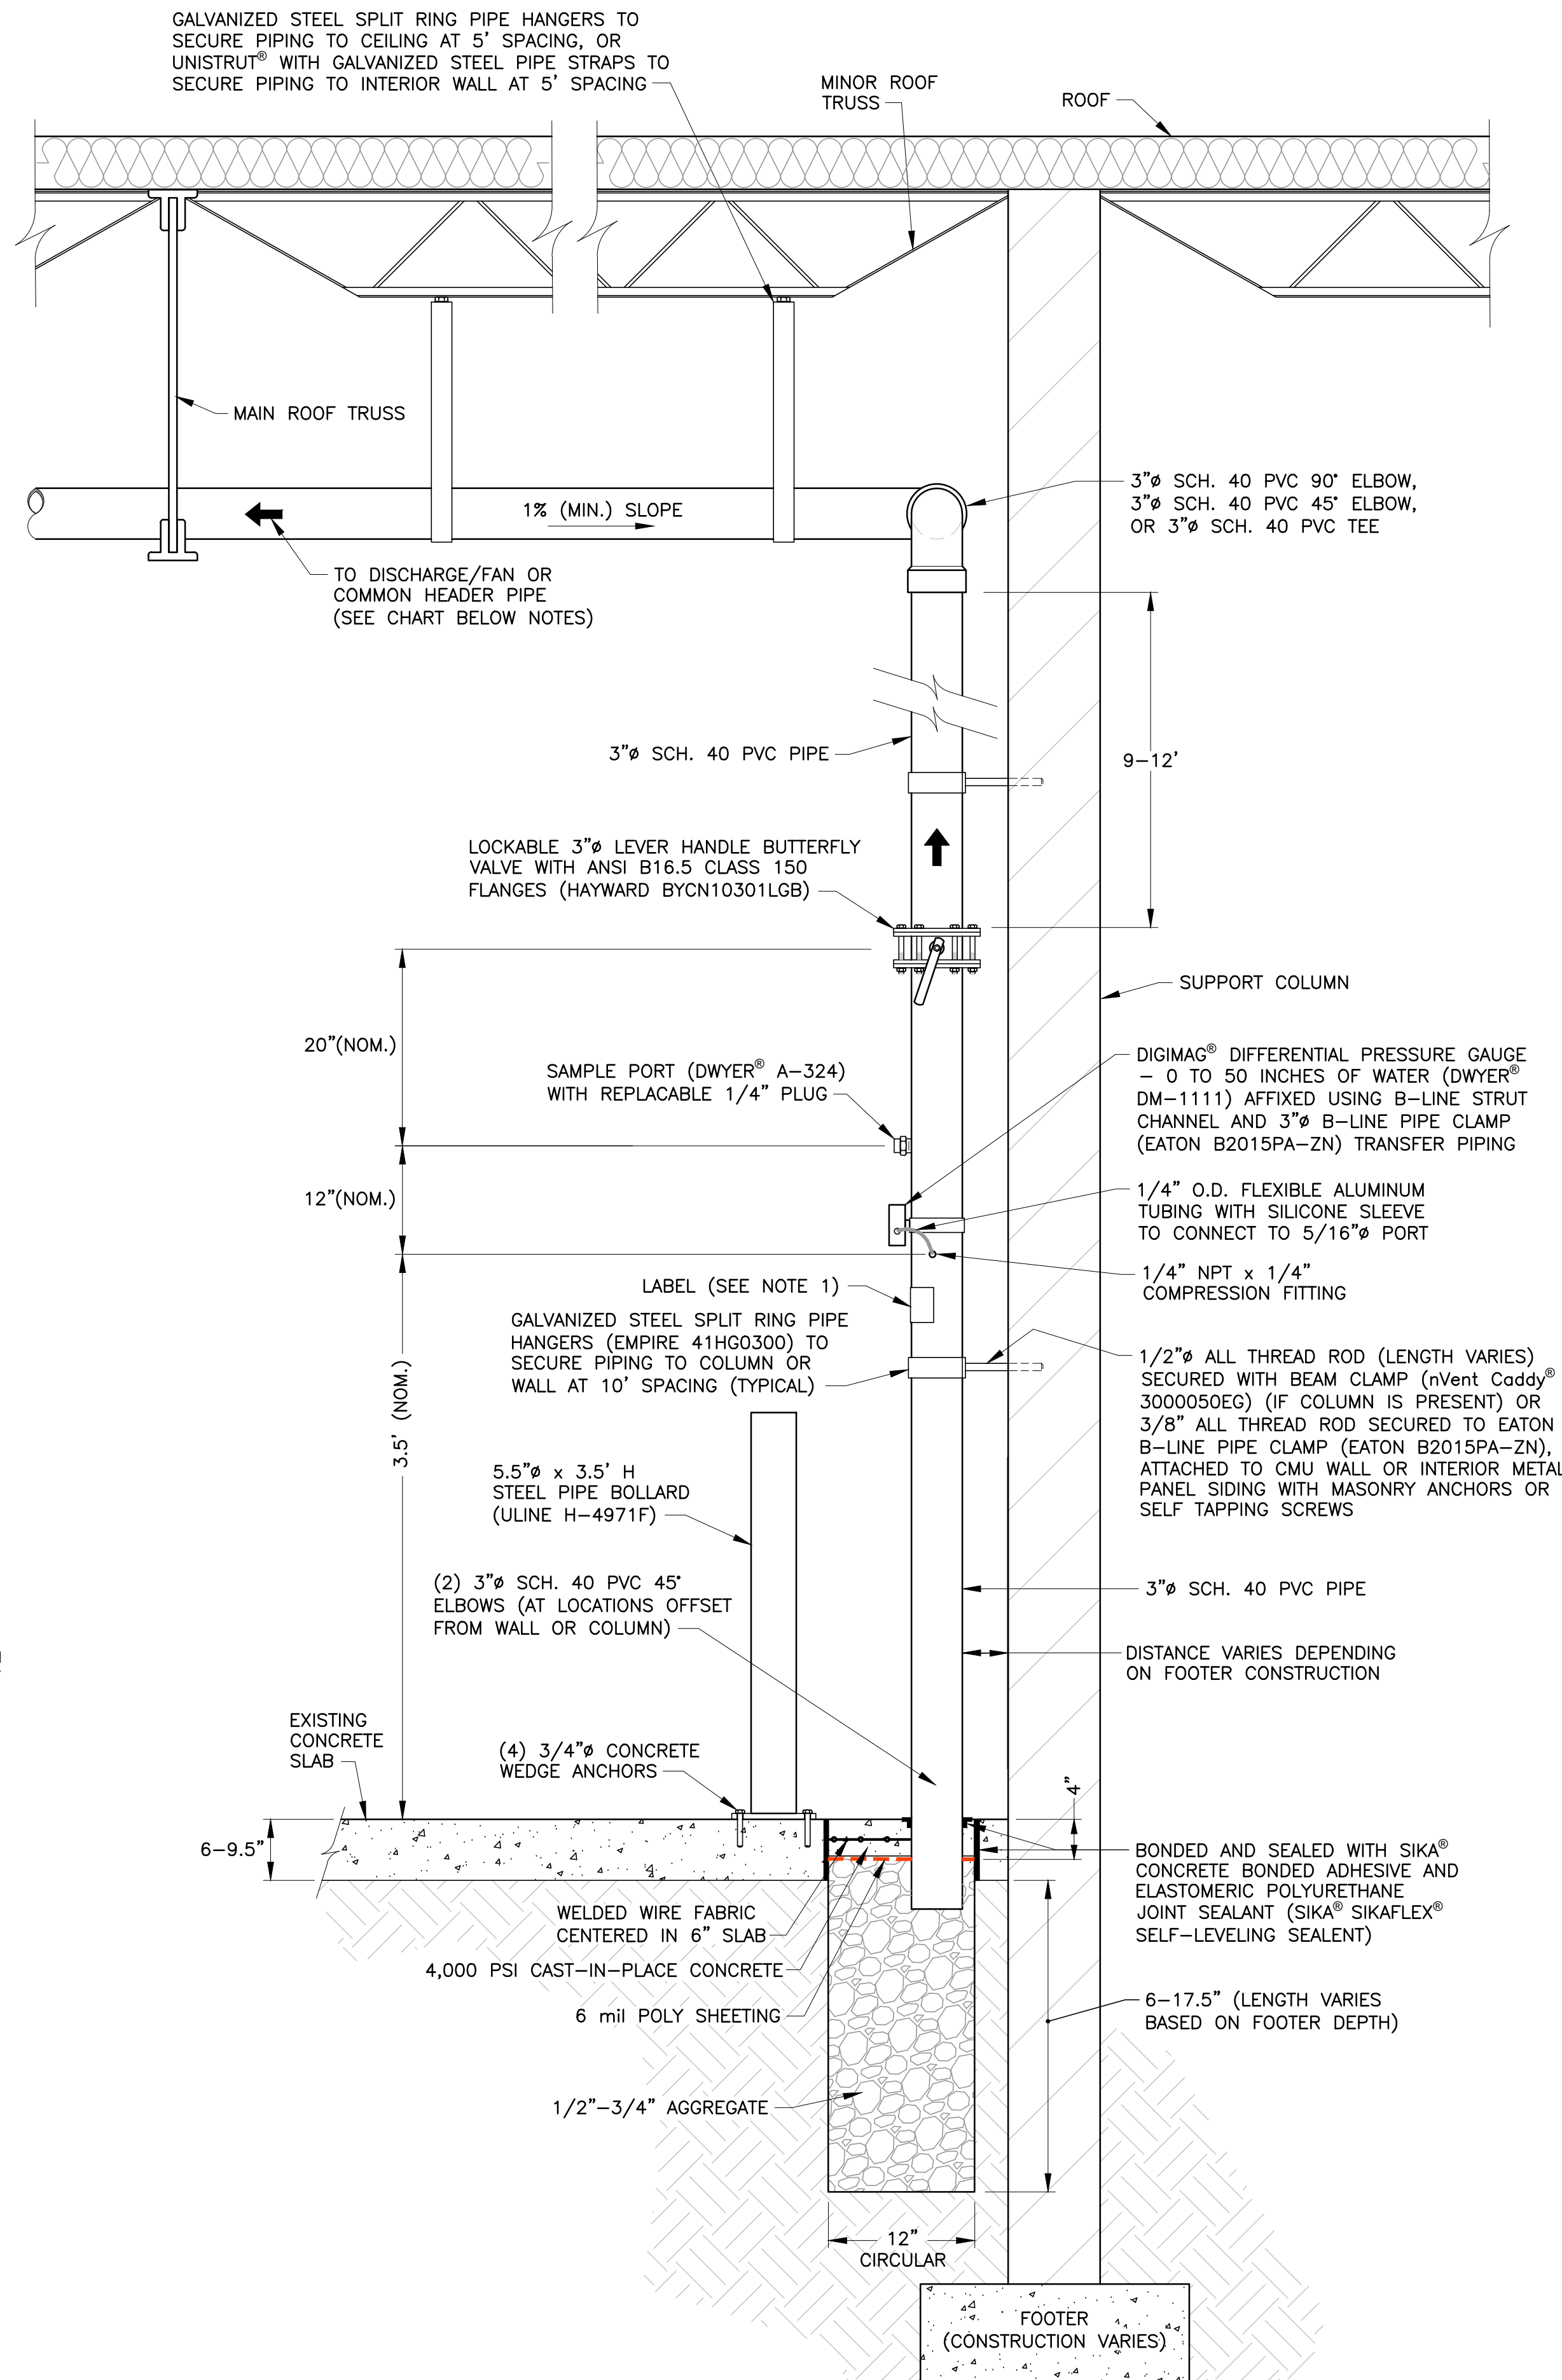

TYPICAL EXTRACTION POINT AND EXHAUST RISER INSTALLATION DETAIL

NOT TO SCALE

REVISIONS	
REV	DESCRIPTION

DATE	

SEAL	

DRAWN BY	CHECKED	APPROVED

PROPERTY OF WSP USA INC. IMPORTANT: THIS DOCUMENT IS THE PROPERTY OF WSP USA INC. AND IS NOT TO BE REPRODUCED OR TRANSMITTED IN ANY FORM OR BY ANY MEANS, WITHOUT THE WRITTEN CONSENT OF WSP USA INC.

NOTES: THIS DRAWING HAS BEEN PREPARED UNDER THE CLOSE PERSONAL SUPERVISION AND DIRECTING OF AN ENGINEER, TO ALTER THIS DOCUMENT IN ANY WAY, WITHOUT THE WRITTEN CONSENT OF WSP USA INC.

**SSD SYSTEM CONSTRUCTION DETAILS**

**FORMER ROLLWAY BEARING FACILITY LIVERPOOL, NEW YORK**

PREPARED FOR  
**EMERSON**  
ST. LOUIS, MISSOURI

**WSP**

WSP USA Inc.  
7000 E. GENESEE ST. BLDG D, 2ND FLOOR  
FAYETTEVILLE, NY 13066  
TEL: +1 315.655.3900

**SHEET 3**

Drawing Number  
**314P1545.018-D16**