

Abridged version, please refer to the complete document found in the Document Repository or at the NYSDEC R9 office.


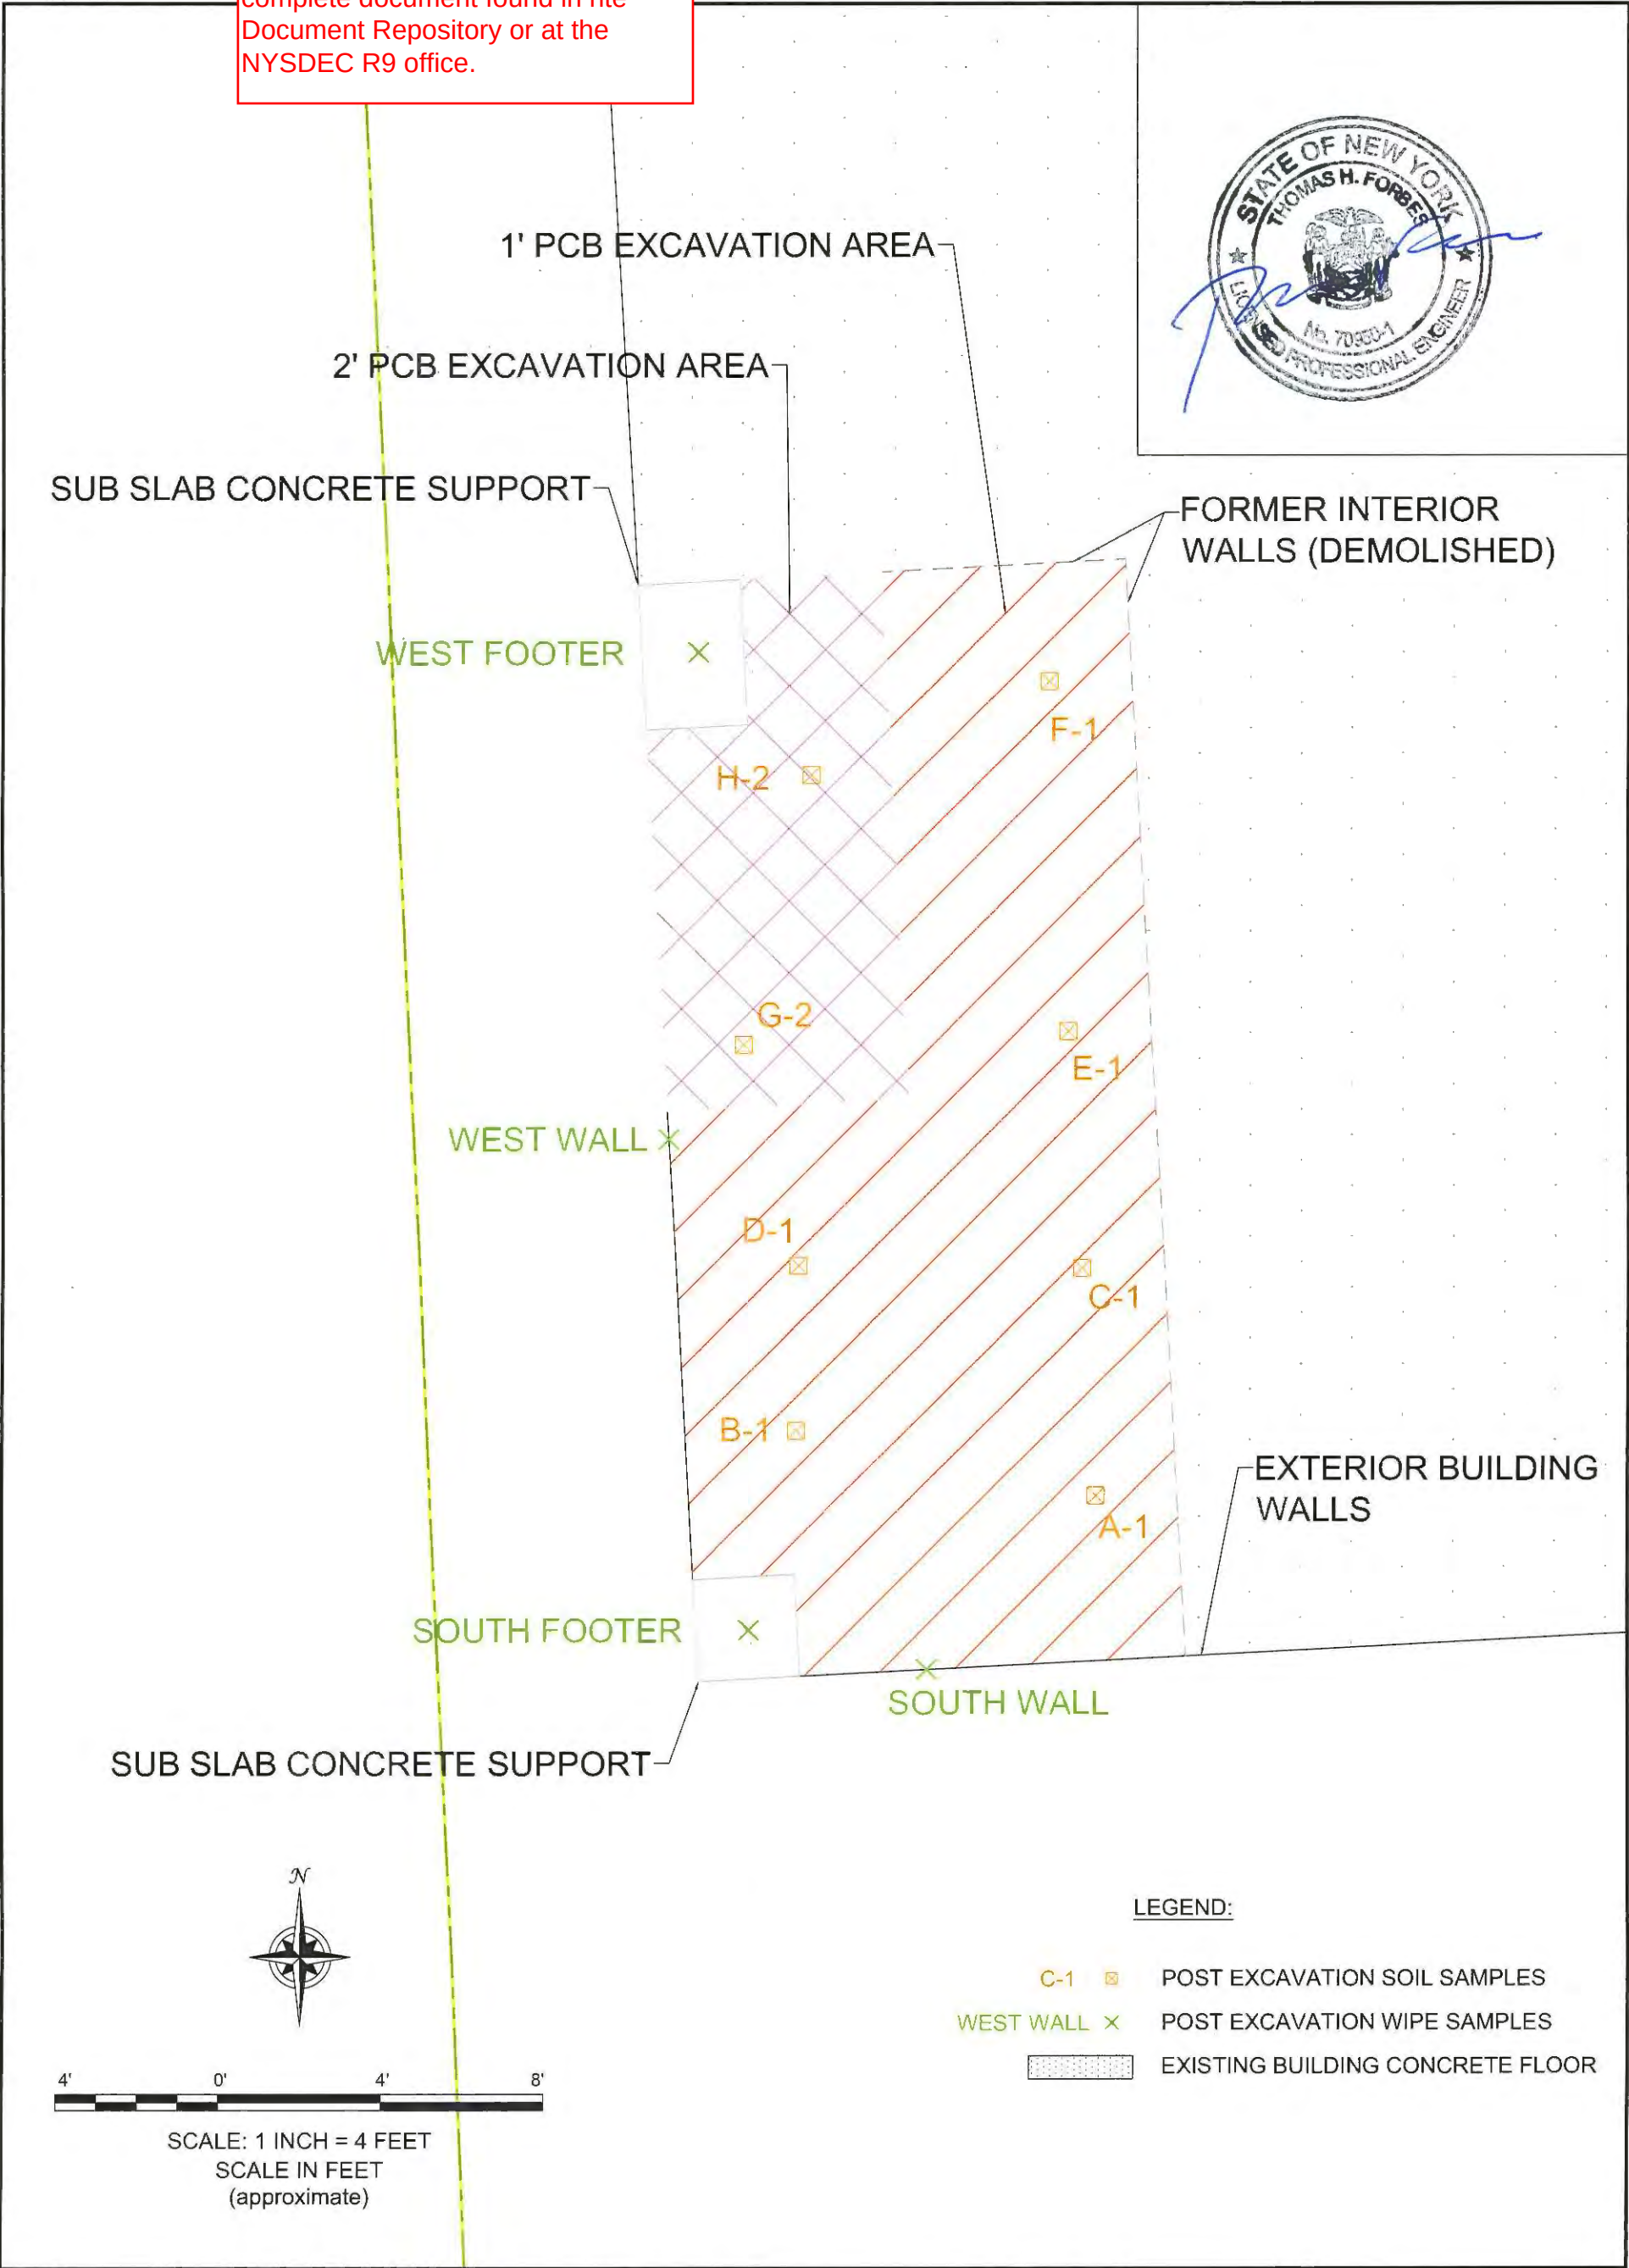


FIGURE 6	TRANSFORMER ROOM IRM ACTIVITIES (RECORD DRAWING) FINAL ENGINEERING REPORT 402 & 430 BUFFALO AVENUE SITE BCP SITE No. C932164 NIAGARA FALLS, NEW YORK PREPARED FOR MERANI HOSPITALITY, INC.	BENCHMARK ENVIRONMENTAL ENGINEERING & SCIENCE, PLLC 2558 HAMBURG TURNPIKE SUITE 300 BUFFALO, NY 14218 (716) 856-0599 JOB NO.: 0294-013-001
	DISCLAIMER: PROPERTY OF BENCHMARK ENVIRONMENTAL ENGINEERING & SCIENCE, PLLC. IMPORTANT: THIS DRAWING PRINT IS LOANED FOR MUTUAL ASSISTANCE AND AS SUCH IS SUBJECT TO RECALL AT ANY TIME. INFORMATION CONTAINED HEREON IS NOT TO BE DISCLOSED OR REPRODUCED IN ANY FORM FOR THE BENEFIT OF PARTIES OTHER THAN NECESSARY SUBCONTRACTORS & SUPPLIERS WITHOUT THE WRITTEN CONSENT OF BENCHMARK ENVIRONMENTAL ENGINEERING & SCIENCE, PLLC.	

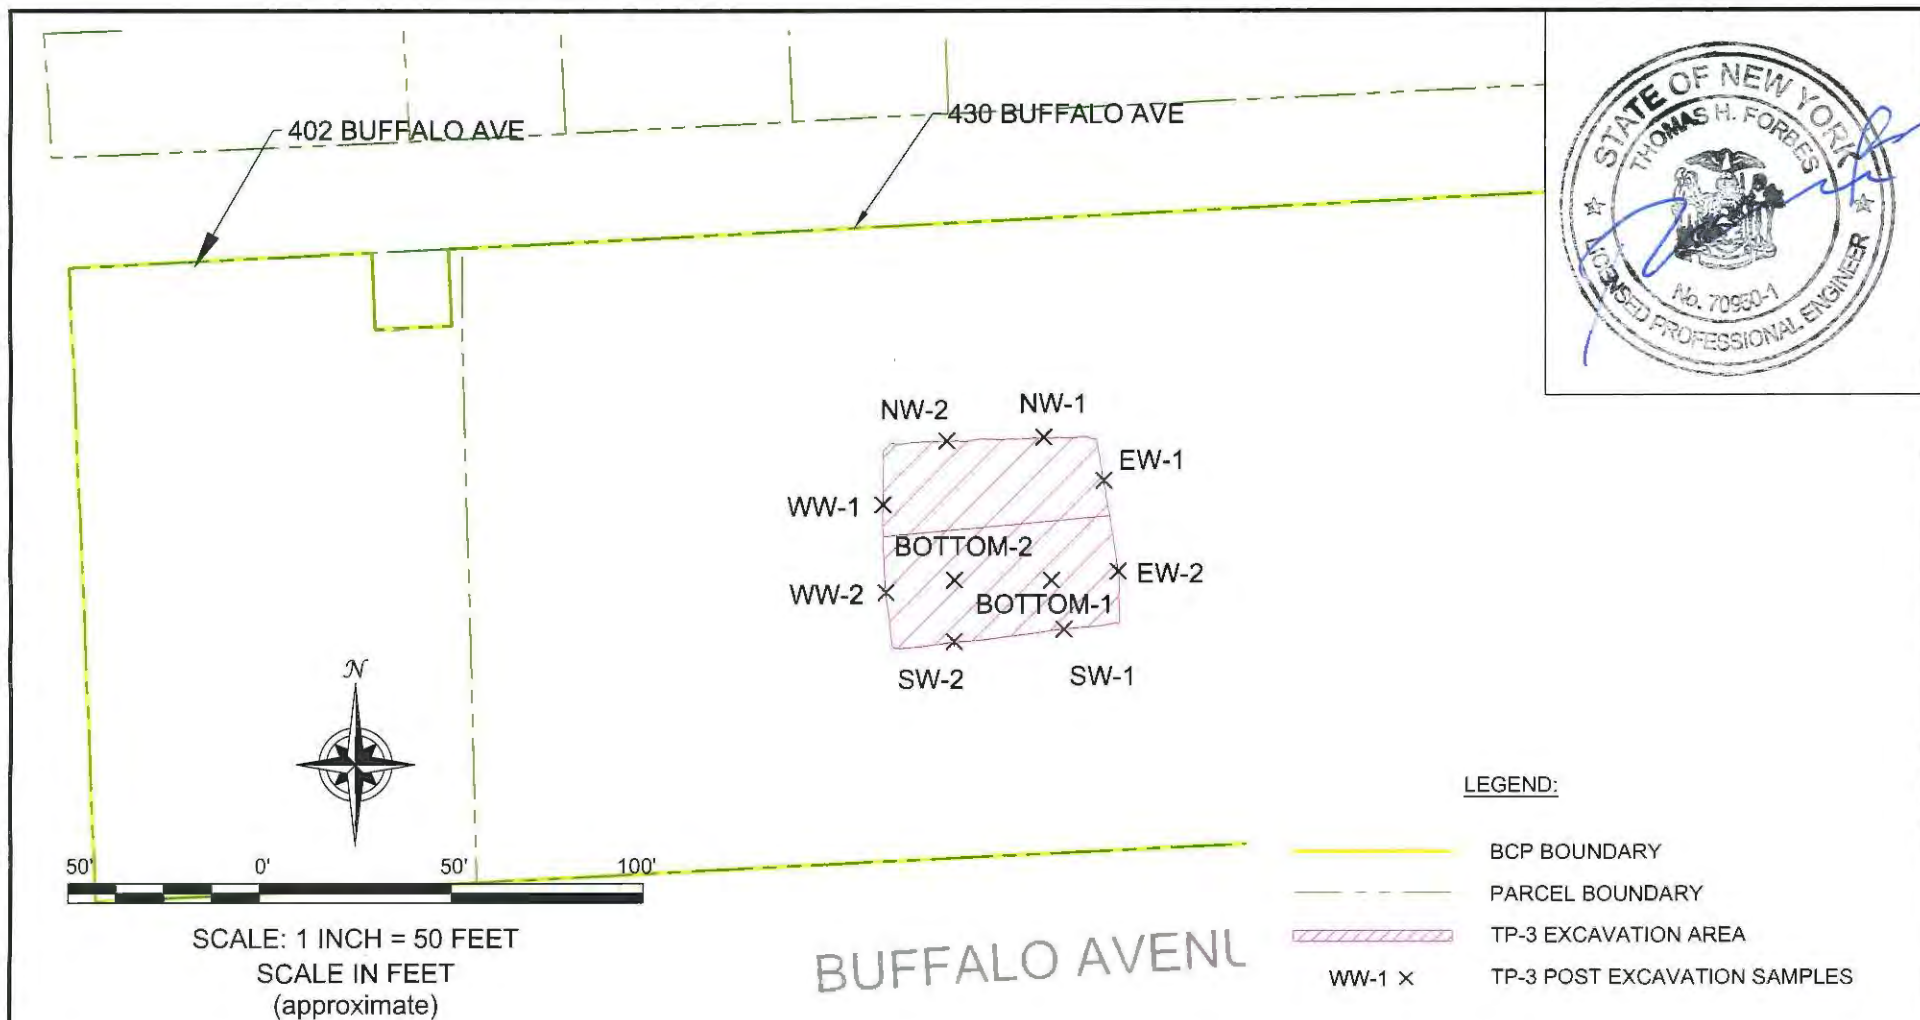

2558 HAMBURG TURNPIKE
SUITE 300
BUFFALO, NY 14218
(716) 858-0599

PROJECT NO.: 0294-013-001

DATE: rev NOVEMBER 2015

DRAFTED BY: KRR/NTM

430 BUFFALO AVENUE - TP-3 IRM ACTIVITIES (RECORD DRAWING)

FINAL ENGINEERING REPORT

402 & 430 BUFFALO AVENUE SITE

BCP SITE NO. C932164

NIAGARA FALLS, NEW YORK

PREPARED FOR


MERANI HOSPITALITY, INC.

FIGURE 7

DISCLAIMER:

PROPERTY OF BENCHMARK ENVIRONMENTAL ENGINEERING & SCIENCE, PLLC. IMPORTANT: THIS DRAWING PRINT IS LOANED FOR MUTUAL ASSISTANCE AND AS SUCH IS SUBJECT TO RECALL AT ANY TIME. INFORMATION CONTAINED HEREON IS NOT TO BE DISCLOSED OR REPRODUCED IN ANY FORM FOR THE BENEFIT OF PARTIES OTHER THAN NECESSARY SUBCONTRACTORS & SUPPLIERS WITHOUT THE WRITTEN CONSENT OF BENCHMARK ENVIRONMENTAL ENGINEERING & SCIENCE, PLLC.

F:\CAD\TurnKey\Merani Hospitality\401, 402, and 430 Buffalo Ave\FER\Figure 8, Post Excavation Radiologic Readings.dwg

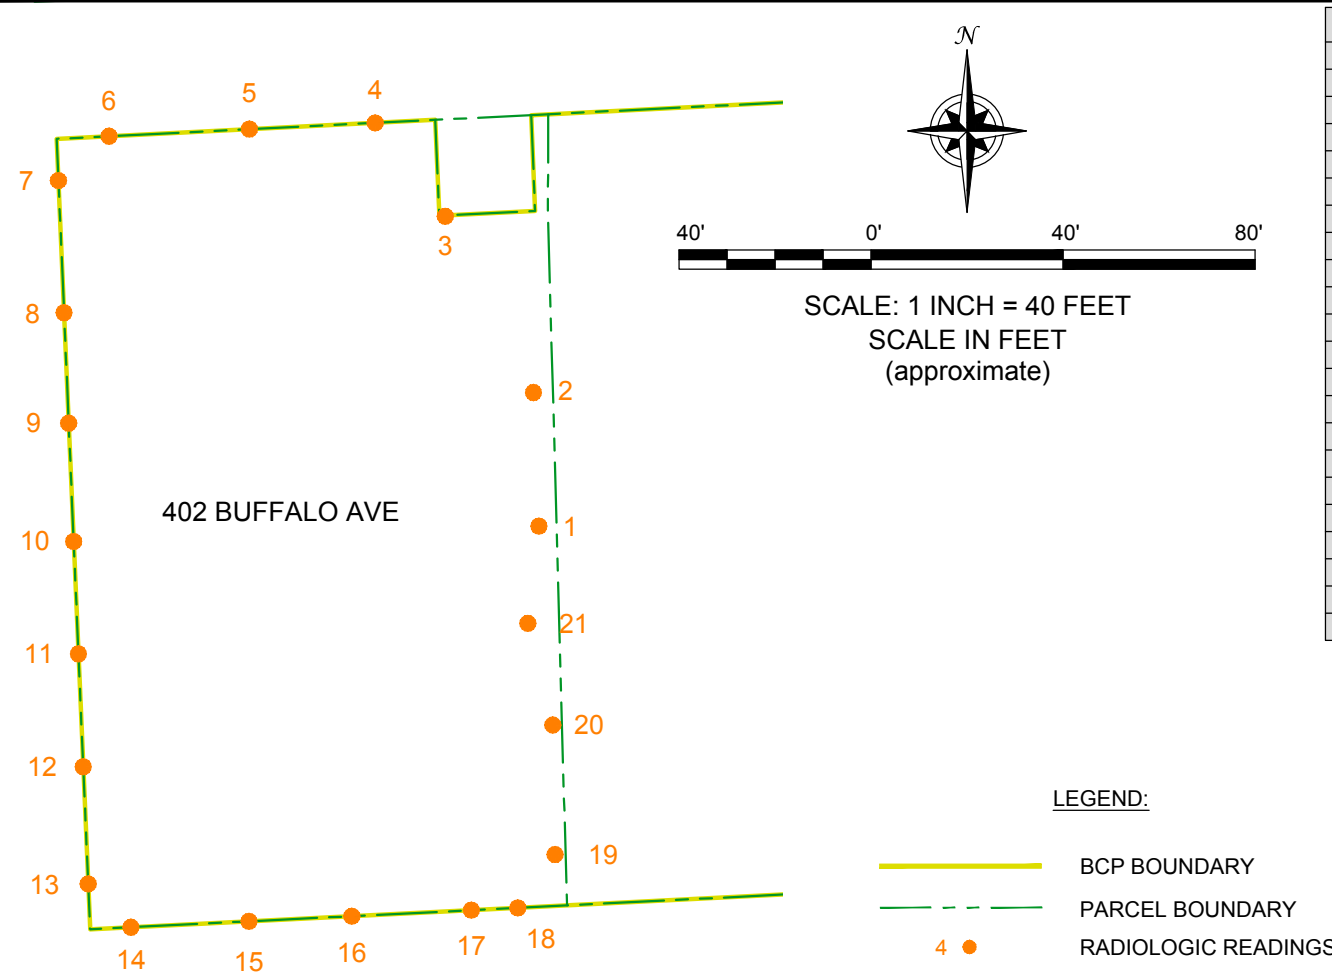

RADIOLOGICAL READINGS	
LOCATIONS	CPM
1	5393
2	5223
3	20059
4	20537
5	21565
6	14685
7	10490
8	8487
9	11732
10	28787
11	7976
12	11552
13	37155
14	27426
15	10201
16	8106
17	44441
18	32744
19	3917
20	4995
21	2410

READINGS IN COUNTS PER MINUTE



2558 HAMBURG TURNPIKE, SUITE 300, BUFFALO, NY 14218, (716) 856-0599



PROJECT NO.: 0294-013-001
DATE: NOVEMBER 2015
DRAFTED BY: KRR


402 BUFFALO AVENUE - IRM ACTIVITIES POST-REMOVAL SCREENING RESULTS

FINAL ENGINEERING REPORT

402 & 430 BUFFALO AVENUE SITE
BCP SITE No. C932164
NIAGARA FALLS, NEW YORK
PREPARED FOR
MERANI HOSPITALITY, INC.

FIGURE 8

DISCLAIMER: PROPERTY OF BENCHMARK ENVIRONMENTAL ENGINEERING & SCIENCE, PLLC. & TURNKEY ENVIRONMENTAL RESTORATION, LLC IMPORTANT: THIS DRAWING PRINT IS LOANED FOR MUTUAL ASSISTANCE AND AS SUCH IS SUBJECT TO RECALL AT ANY TIME. INFORMATION CONTAINED HEREON IS NOT TO BE DISCLOSED OR REPRODUCED IN ANY FORM FOR THE BENEFIT OF PARTIES OTHER THAN NECESSARY SUBCONTRACTORS & SUPPLIERS WITHOUT THE WRITTEN CONSENT OF BENCHMARK ENVIRONMENTAL ENGINEERING & SCIENCE, PLLC & TURNKEY ENVIRONMENTAL RESTORATION, LLC.

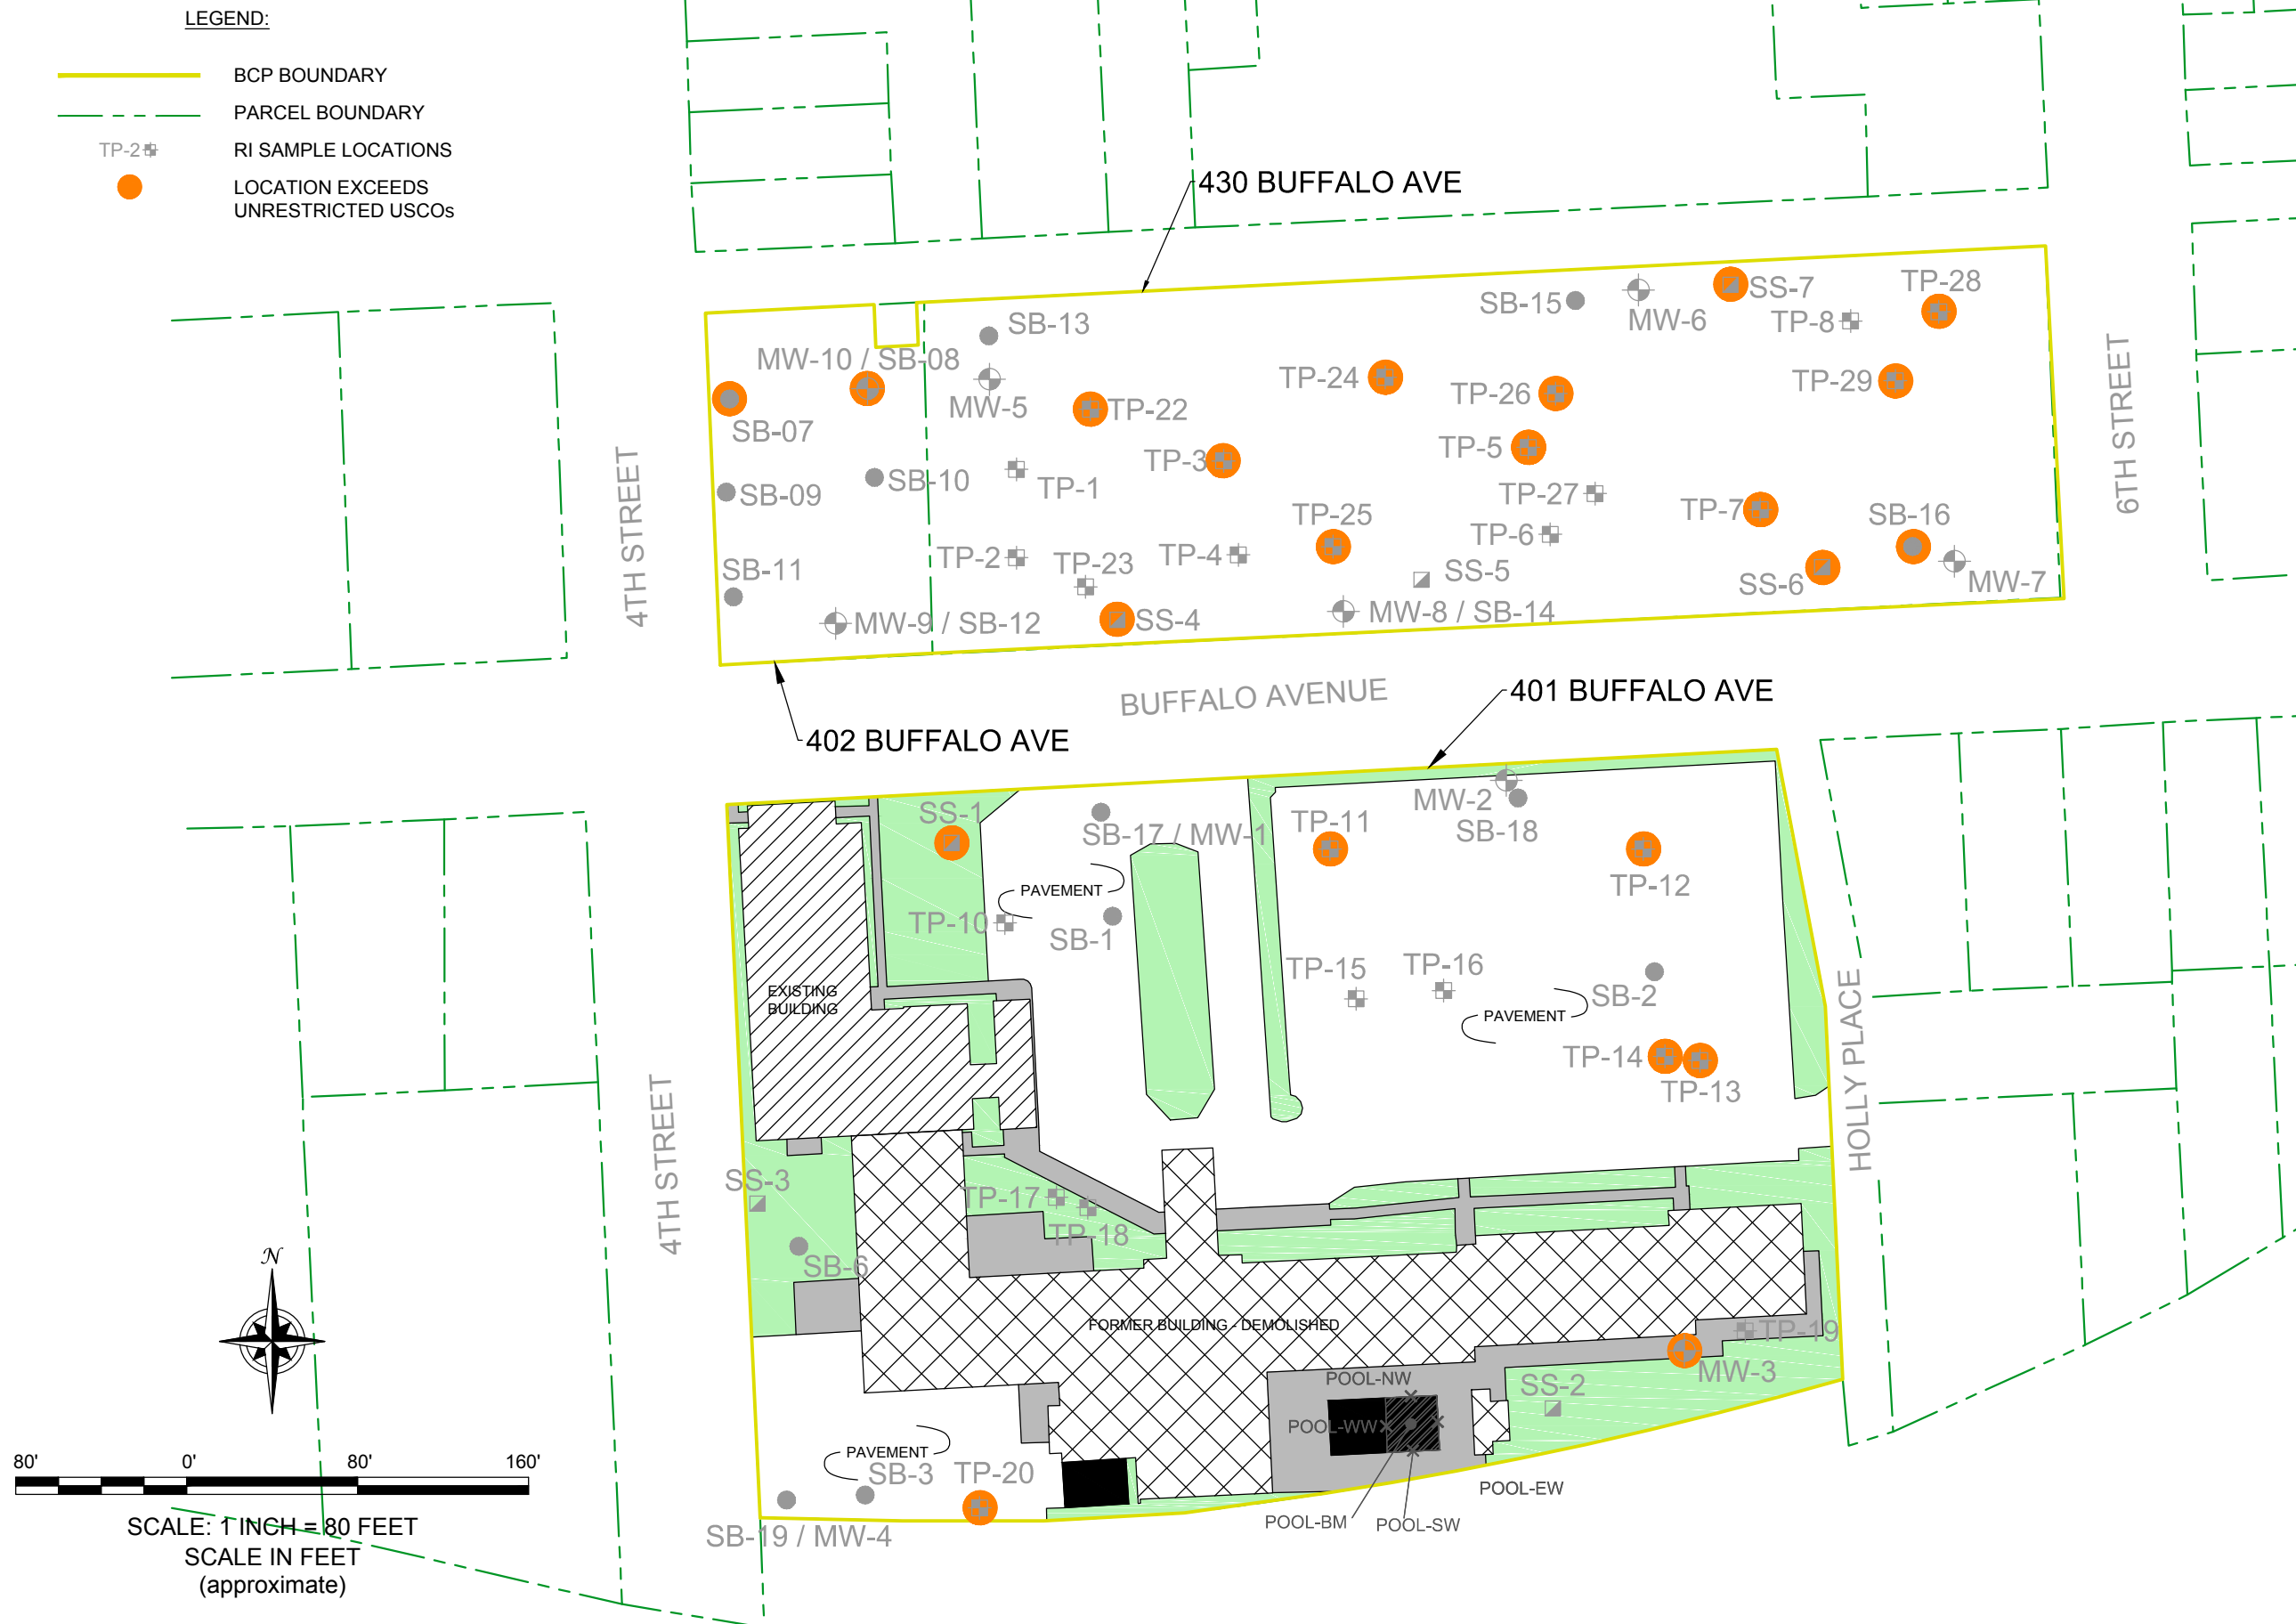

REMAINING SAMPLE LOCATIONS EXCEEDING USCOS

FINAL ENGINEERING REPORT
402 & 430 BUFFALO AVENUE SITE
BCP SITE No. C932164
NIAGARA FALLS, NEW YORK
PREPARED FOR
MERANI HOSPITALITY, INC.

PREPARED FOR


PREPARED FOR
MERANI HOSPITALITY, INC.


JOB NO.: 0294-013-001



2558 HAMBURG TURNPIKE, SUITE 300, BUFFALO, NY 14218. (716) 856-0599

DISCLAIMER: PROPERTY OF BENCHMARK ENVIRONMENTAL ENGINEERING & SCIENCE, PLLC. & TURNKEY ENVIRONMENTAL RESTORATION, LLC. IMPORTANT: THIS DRAWING PRINT IS LOANED FOR MUTUAL ASSISTANCE AND AS SUCH IS SUBJECT TO RECALL AT ANY TIME. INFORMATION CONTAINED HEREON IS NOT TO BE DISCLOSED OR REPRODUCED IN ANY FORM FOR THE BENEFIT OF PARTIES OTHER THAN NECESSARY SUBCONTRACTORS & SUPPLIERS WITHOUT THE WRITTEN CONSENT OF BENCHMARK ENVIRONMENTAL ENGINEERING & SCIENCE, PLLC & TURNKEY ENVIRONMENTAL RESTORATION, LLC.

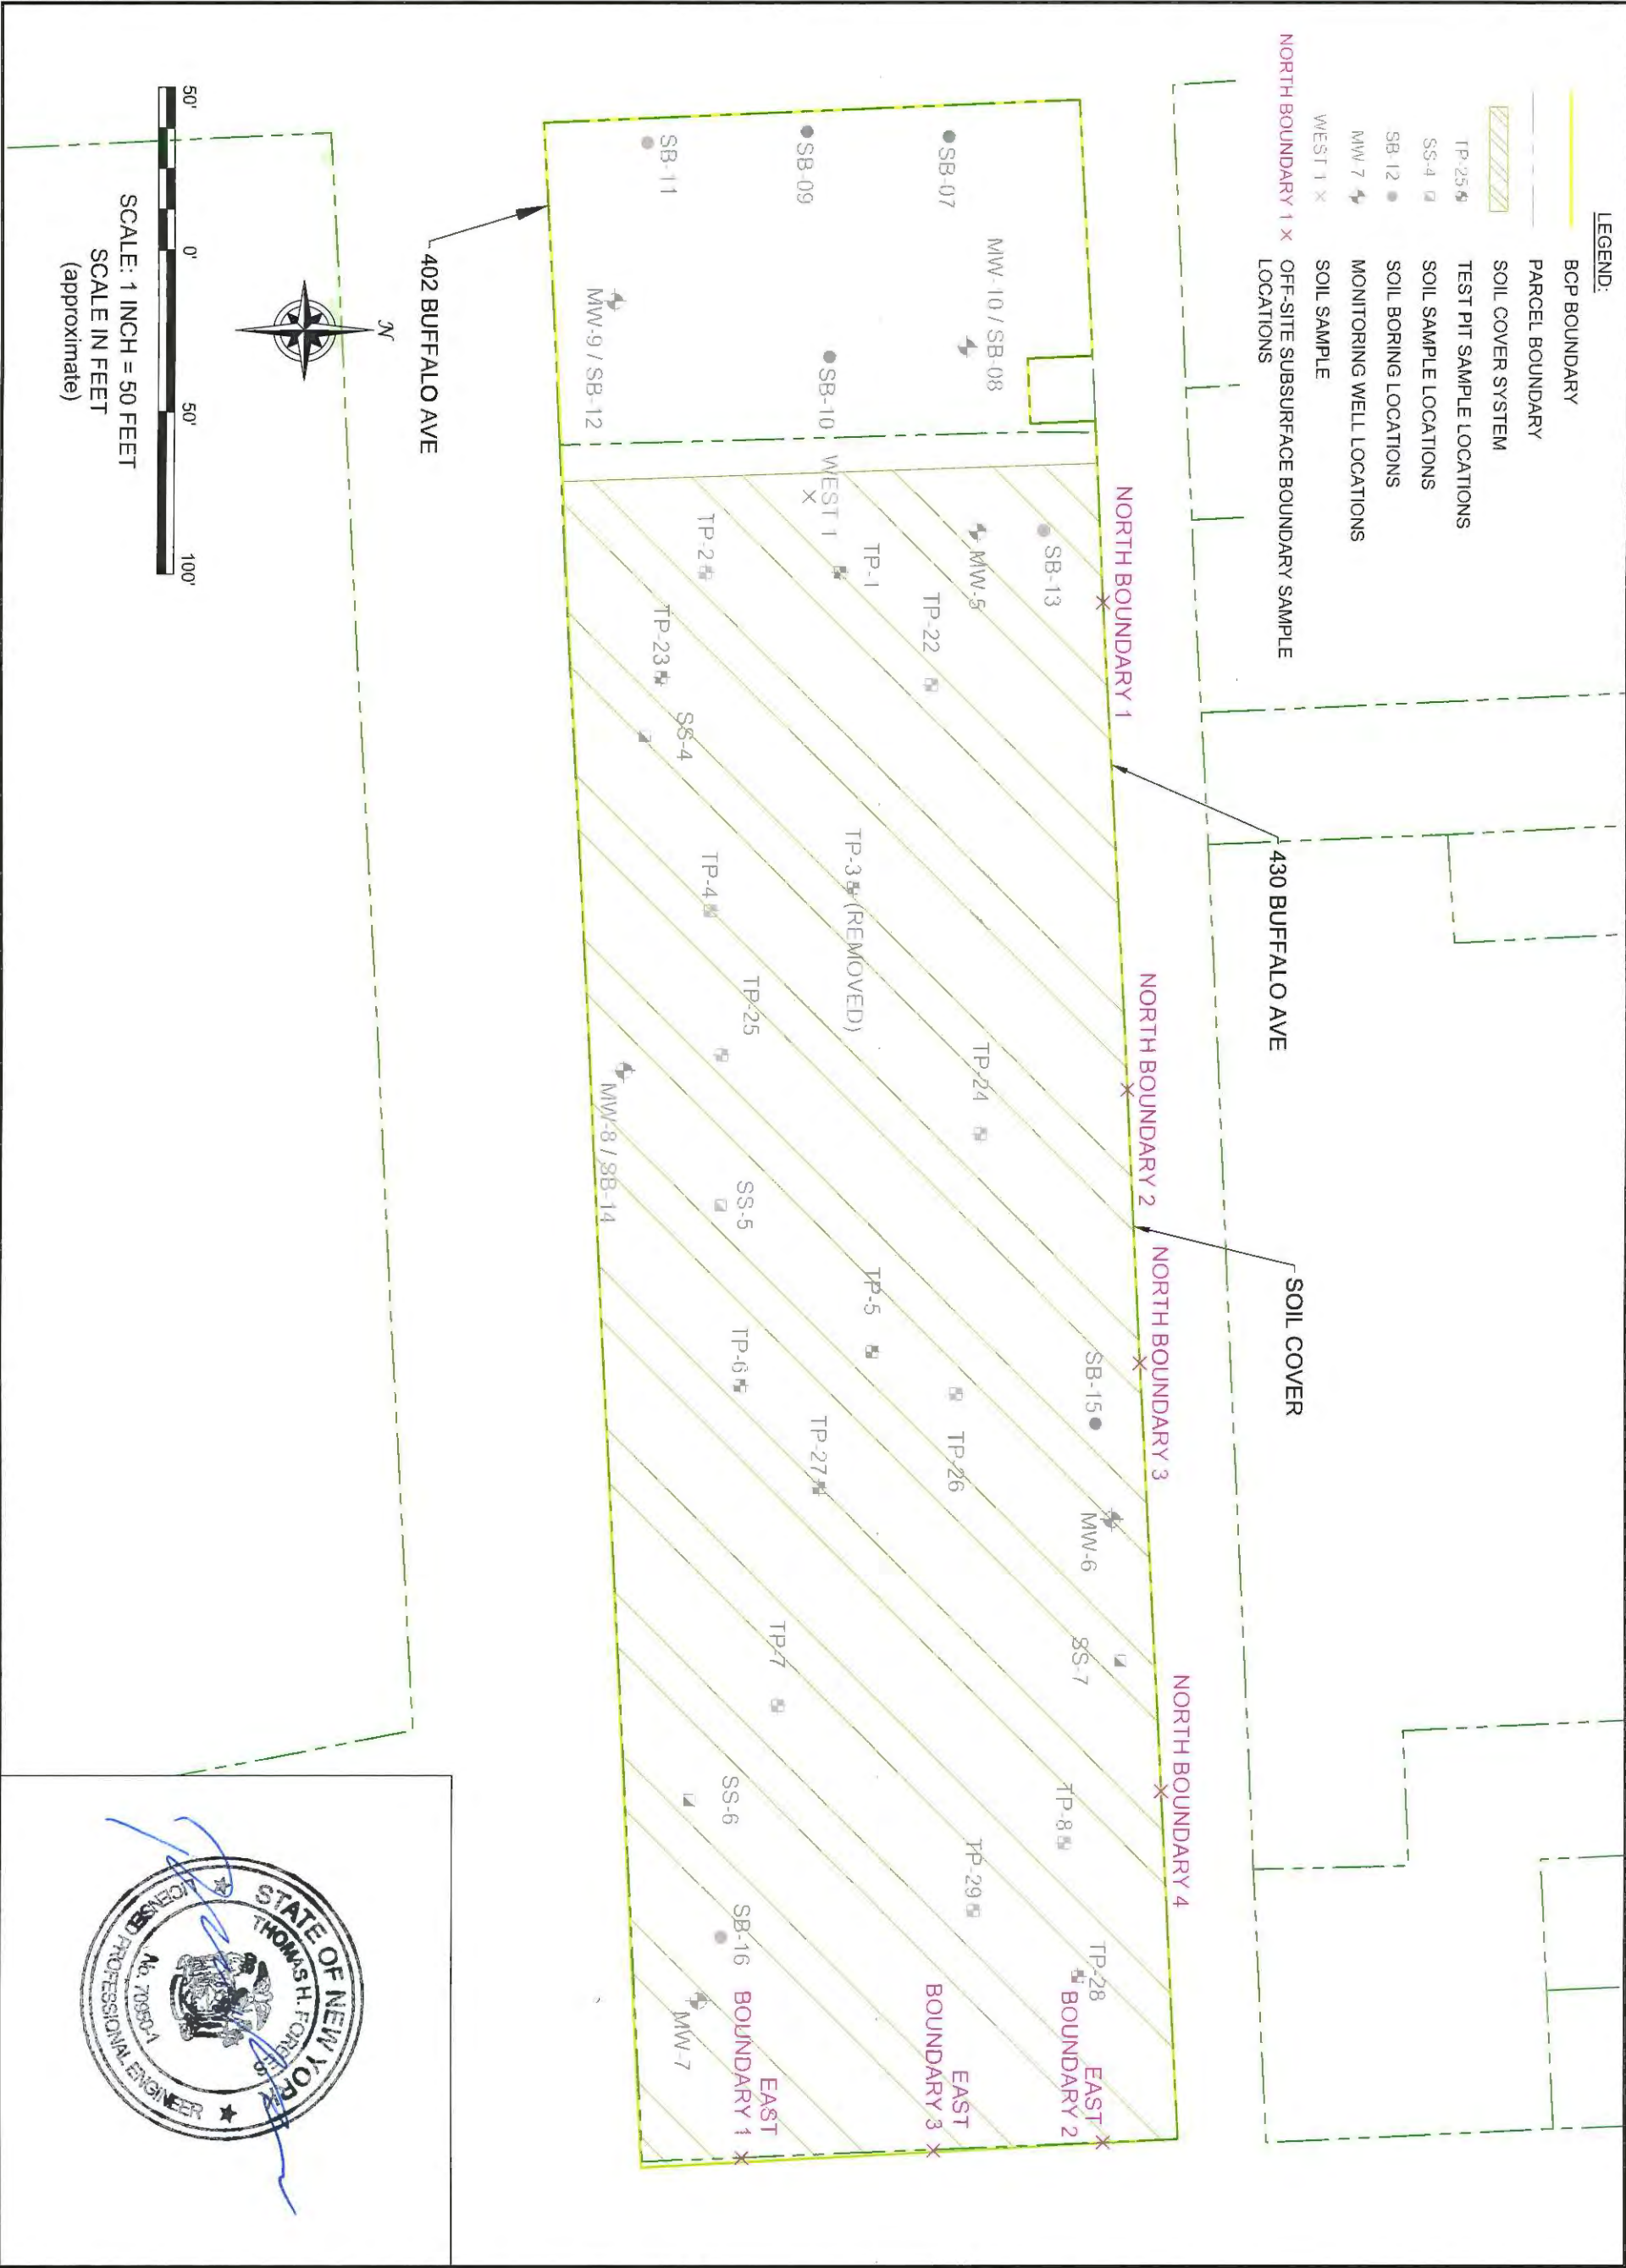

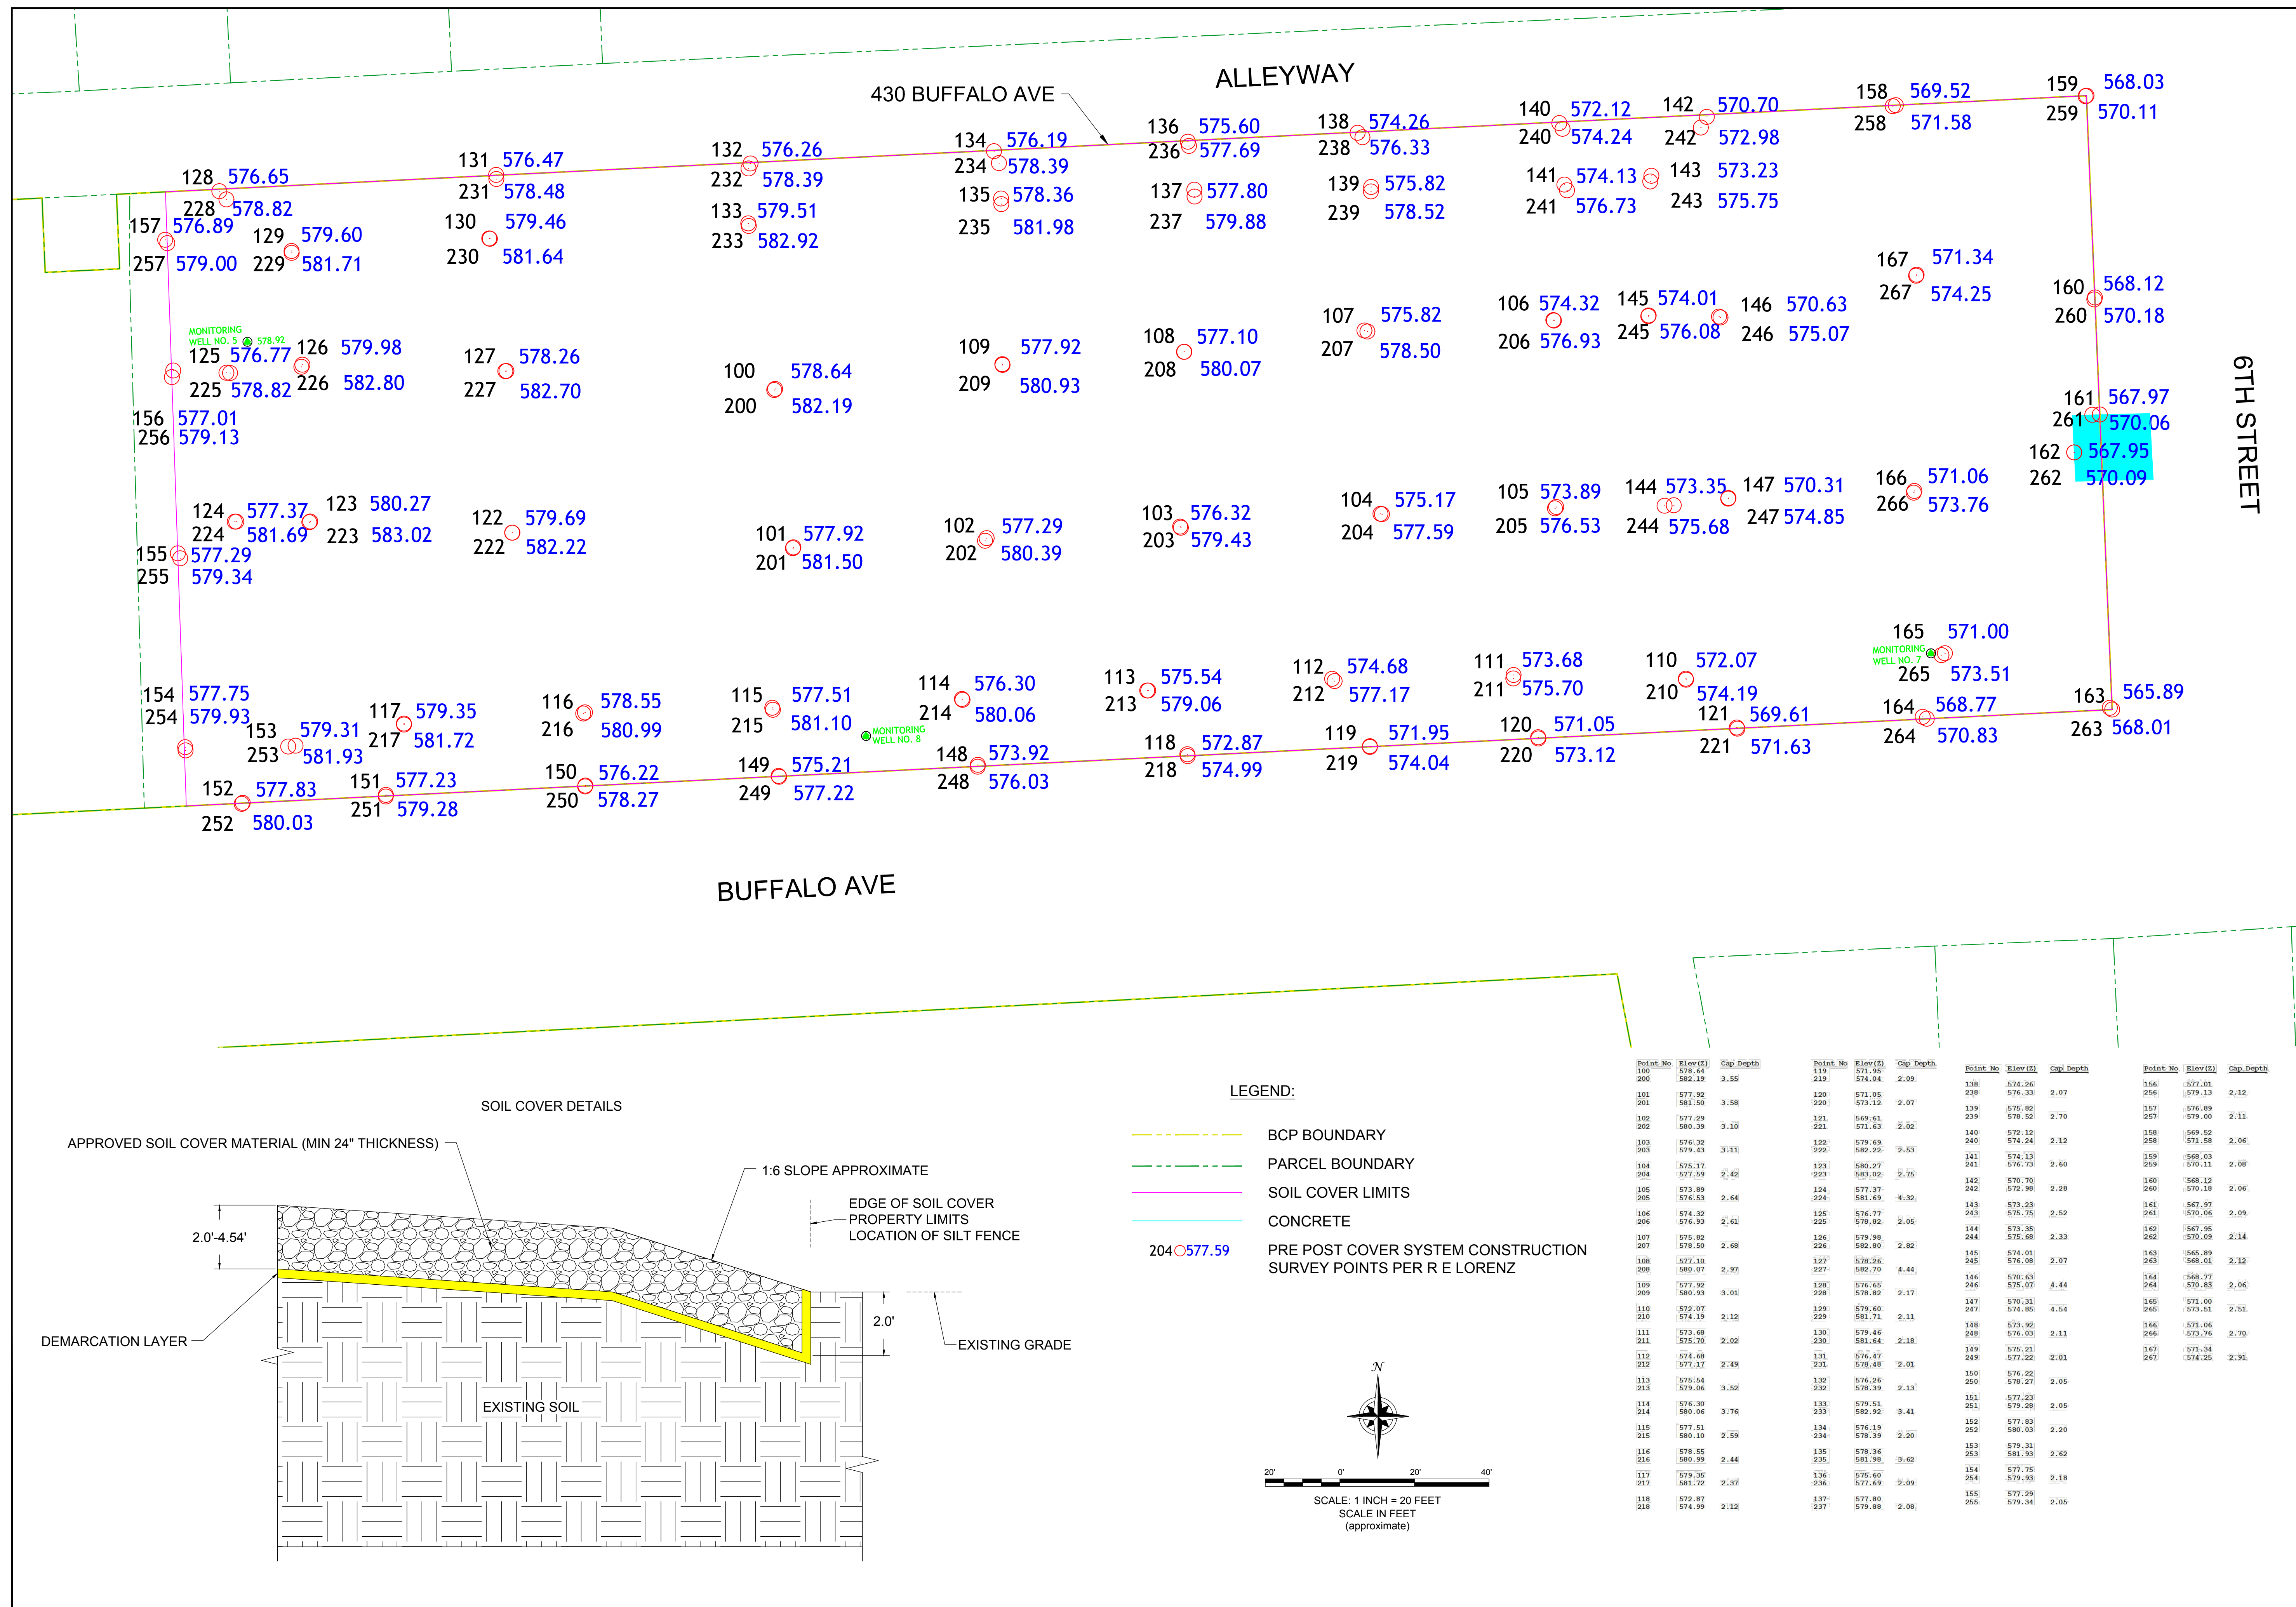[illegible]

SEAL

DRAWN BY:	KRR
DATE:	REV DECEMBER 2015
CHECKED BY:	NTM
APPROVED BY:	THF

**COVER SYSTEM
RECORD DRAWING)**
FINAL ENGINEERING REPORT
402 & 430 BUFFALO AVENUE SITE
BCP SITE NO. C932164
NIAGARA FALLS, NEW YORK
PREPARED FOR
MERANI HOSPITALITY, INC.

FIGURE 11