


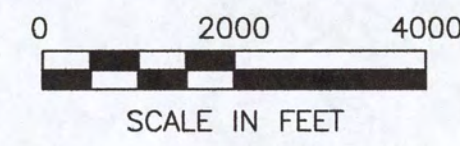

NWIRP BETHPAGE VICINITY MAP  
NAVAL WEAPONS INDUSTRIAL RESERVE PLANT  
BETHPAGE, NEW YORK



# APPENDIX G GROUNDWATER TREATMENT PLANT ADVANCED OXIDATION PROCESS ADDITION



JUNE 2019

GM-38 AREA - GROUNDWATER TREATMENT FACILITY  
NAVAL WEAPONS INDUSTRIAL RESERVE PLANT  
BETHPAGE, NEW YORK

COMPREHENSIVE LONG TERM  
ENVIRONMENTAL ACTION NAVY (CLEAN) CONTRACT  
CONTRACT NUMBER N6247216D9008  
CONTRACT TASK ORDER WE24

Submitted to:  
Department of the Navy  
Naval Facilities Engineering Command Mid-Atlantic  
9324 Maryland Avenue  
Norfolk, VA 23511-3085

Submitted by:  
Tetra Tech  
5700 Lake Wright Drive, Suite 102  
Norfolk, VA, 23502

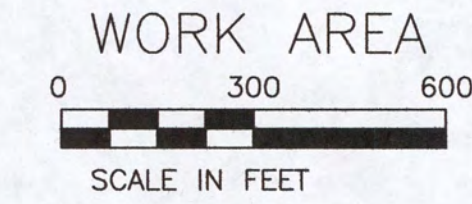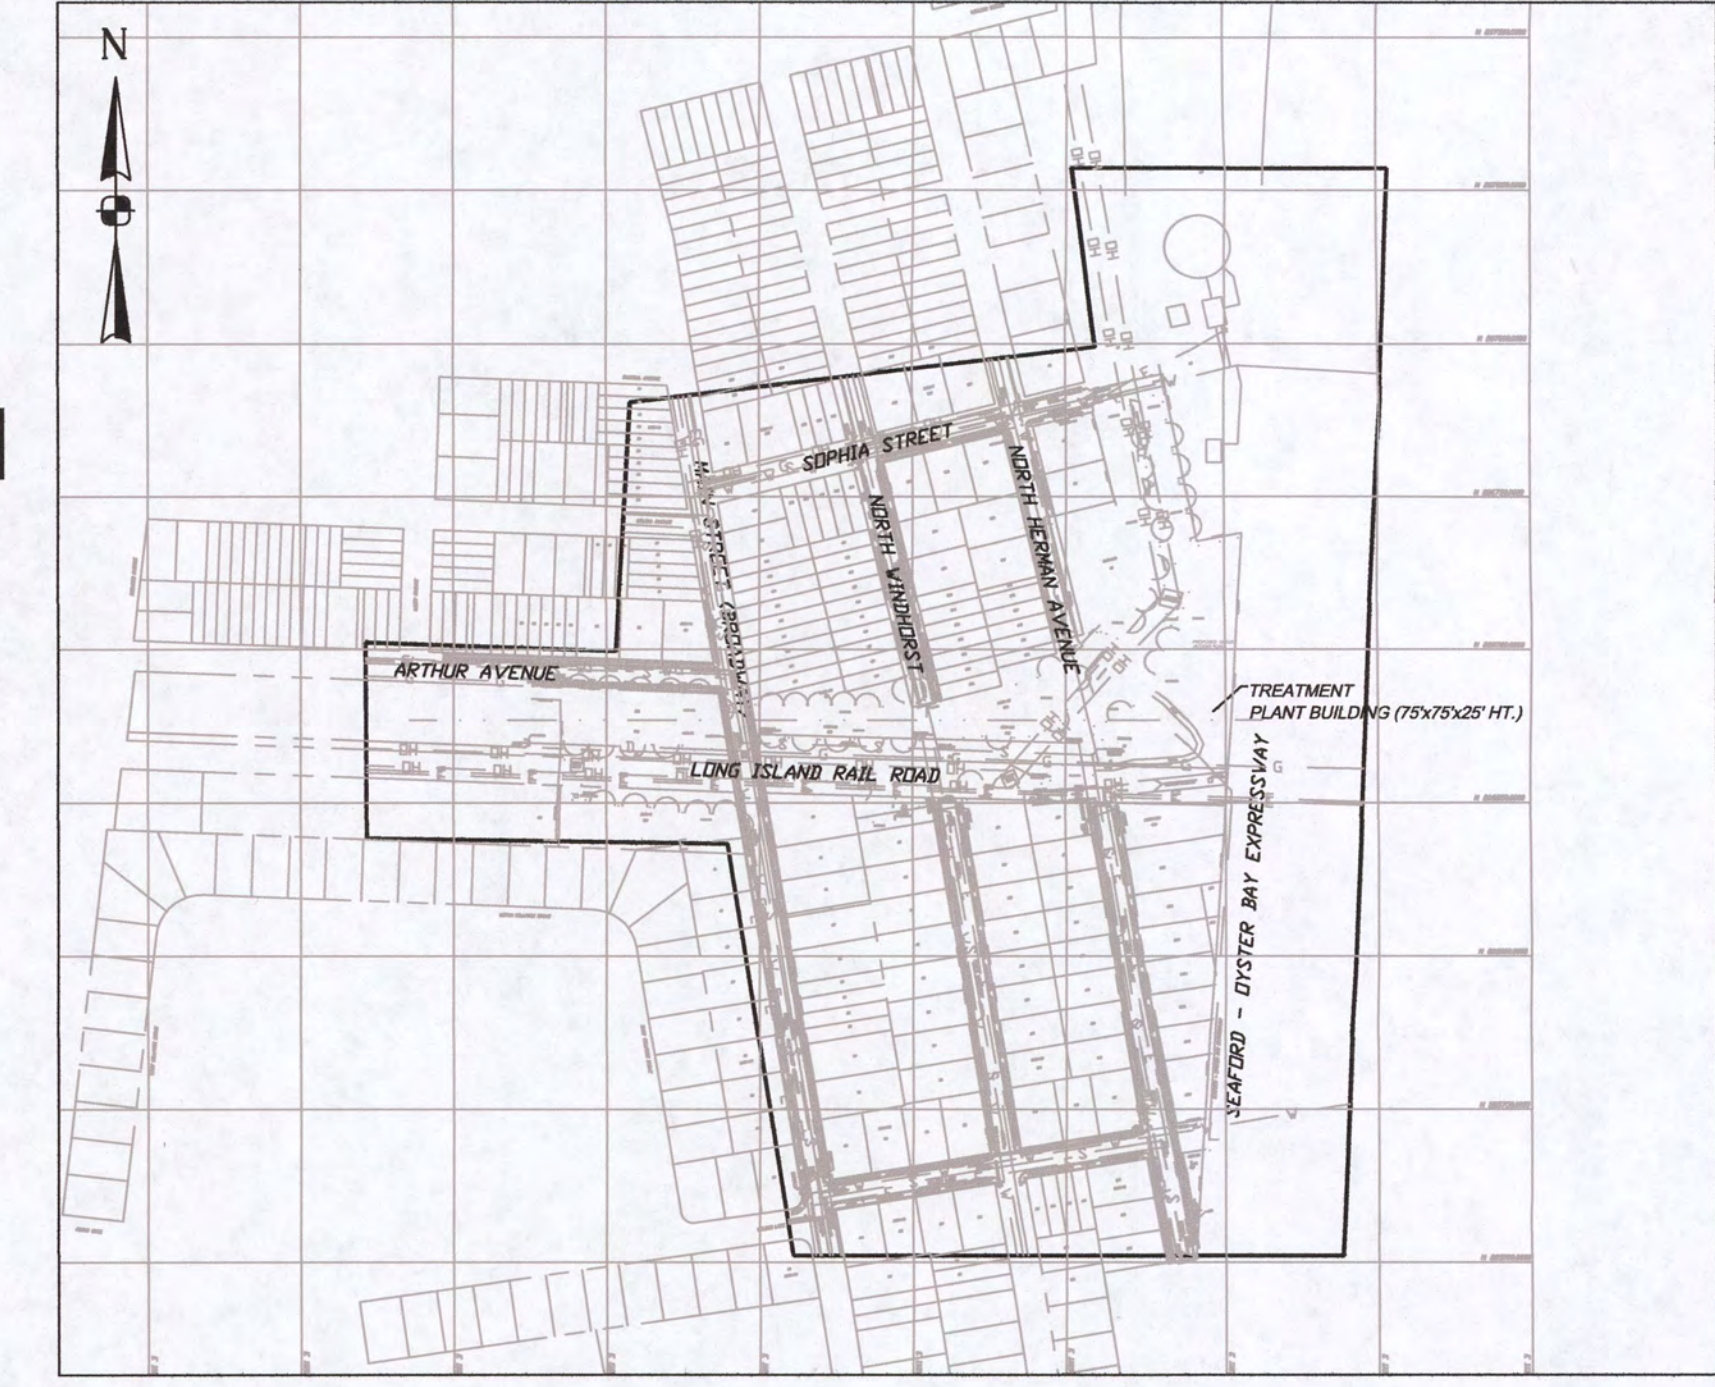


WORK AREA  
SCALE IN FEET

| Sheet # | Title  |
|---------|--|
| G-100   | TITLE INDEX                                      |
| C-100   | EXISTING CONDITIONS & DEMOLITION PLAN            |
| C-200   | LAYOUT PLAN                                      |
| C-300   | GRADING PLAN                                     |
| AS-001  | STRUCTURAL GENERAL NOTES I                       |
| AS-002  | STRUCTURAL GENERAL NOTES II                      |
| AS-101  | STRUCTURAL FDN AND ROOF PLAN                     |
| AS-301  | STRUCTURAL FDN & ROOF SECTIONS                   |
| AS-501  | STRUCTURAL TYPICAL DETAILS                       |
| MD-101  | PLUMBING FLOOR PLAN - REMOVAL WORK               |
| M-101   | PLUMBING FLOOR PLAN - NEW WORK                   |
| PFD-100 | PROCESS FLOW DIAGRAM                             |
| P-4     | PIPING AND INSTRUMENTATION DIAGRAM (2 of 5)      |
| P-5     | PIPING AND INSTRUMENTATION DIAGRAM (3 of 5)      |
| P-6     | PIPING AND INSTRUMENTATION DIAGRAM (4 of 5)      |
| P-6A    | AOP PIPING AND INSTRUMENTATION DIAGRAM           |
| P-12    | AOP PROPOSED OVERALL PIPING LAYOUT (1 of 2)      |
| P-13    | AOP PROPOSED OVERALL PIPING LAYOUT (2 of 2)      |
| P-14    | AOP PROPOSED PIPING - ISOMETRIC VIEW             |
| P-15    | DETAILS  |
| E-001   | ELECTRICAL GENERAL NOTES, LEGEND & ABBREVIATIONS |
| E-100   | ELECTRICAL SITE PLAN - REMOVAL & NEW WORK        |
| E-101   | ELECTRICAL FLOOR PLAN - NEW WORK                 |
| E-501   | DETAILS  |
| E-601   | ELECTRICAL SINGLE LINE DIAGRAM - REMOVAL WORK    |
| E-602   | ELECTRICAL SINGLE LINE DIAGRAM - NEW WORK        |
| E-603   | ELECTRICAL SCHEDULES                             |

ISSUED FOR BID - 06/21/2019

CAUTION: IF SHEET IS LESS THAN 34"x22" USE GRAPHIC SCALE


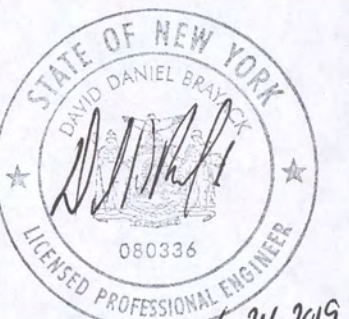


|                |     |    |     |
|----------------|-----|----|-----|
| DES            | HKM | DR | SNL |
| REVIEWED BY    | HKM |    |     |
| PM/DM          | HKM |    |     |
| CHIEF ENG/ARCH | HKM |    |     |

DEPARTMENT OF THE NAVY  
NAVAL FACILITIES ENGINEERING COMMAND  
NAVAL WEAPONS INDUSTRIAL RESERVE PLANT  
GM-38 AREA  
GROUNDWATER TREATMENT PLANT  
AOP SYSTEM ADDITION

|                    |                  |      |       |
|--------------------|------------------|------|-------|
| CODE ID. NO.       | 80091            | SIZE | D     |
| SCALE              |                  |      | NTS   |
| MANUM. NO.         | N62470-08-D-1001 |      |       |
| JOB ORDER NO.      | WE-24            |      |       |
| SPEC. NO.          |                  |      |       |
| CONSTR. CONTR. NO. | N62472-08-D-0032 |      |       |
| NAVAC DRAWING NO.  | 112G08005        |      |       |
| SHEET              | OF               |      |       |
|                    |                  |      | G-100 |

THIS DRAWING PRODUCED ON AUTOCAD  
DO NOT REUSE MANUALLY  
THIS DOCUMENT IS THE PROPERTY OF  
NAVAL FACILITIES ENGINEERING COMMAND,  
PREPARED BY TETRA TECH ENGINEERING  
CORPORATION PC, AND IS PROVIDED UPON  
CONDITION THAT IT WILL NOT BE REPRODUCED,  
COPIED, OR ISSUED TO A THIRD PARTY, AND WILL  
BE USED SOLELY FOR THE ORIGINAL INTENDED  
PURPOSE AND SOLELY FOR THE EXECUTION  
OR REVIEW OF THE ENGINEERING CONSTRUCTION  
OF THE PROJECT.  
IT IS A VIOLATION OF THE NEW YORK STATE  
EDUCATION LAW, ARTICLE 145, FOR ANY PERSON,  
UNLESS UNDER THE DIRECTION OF A NEW YORK  
STATE LICENSED PROFESSIONAL ENGINEER, TO  
ALTER AN ITEM ON THIS DOCUMENT IN ANY WAY.

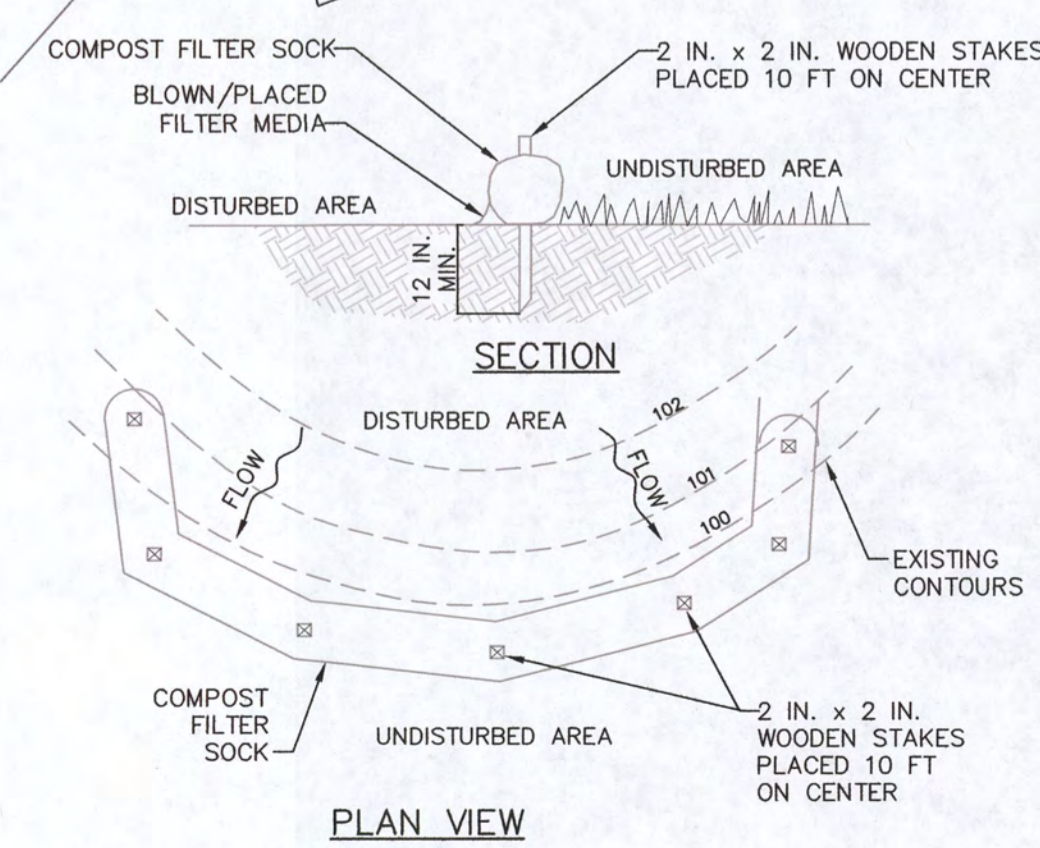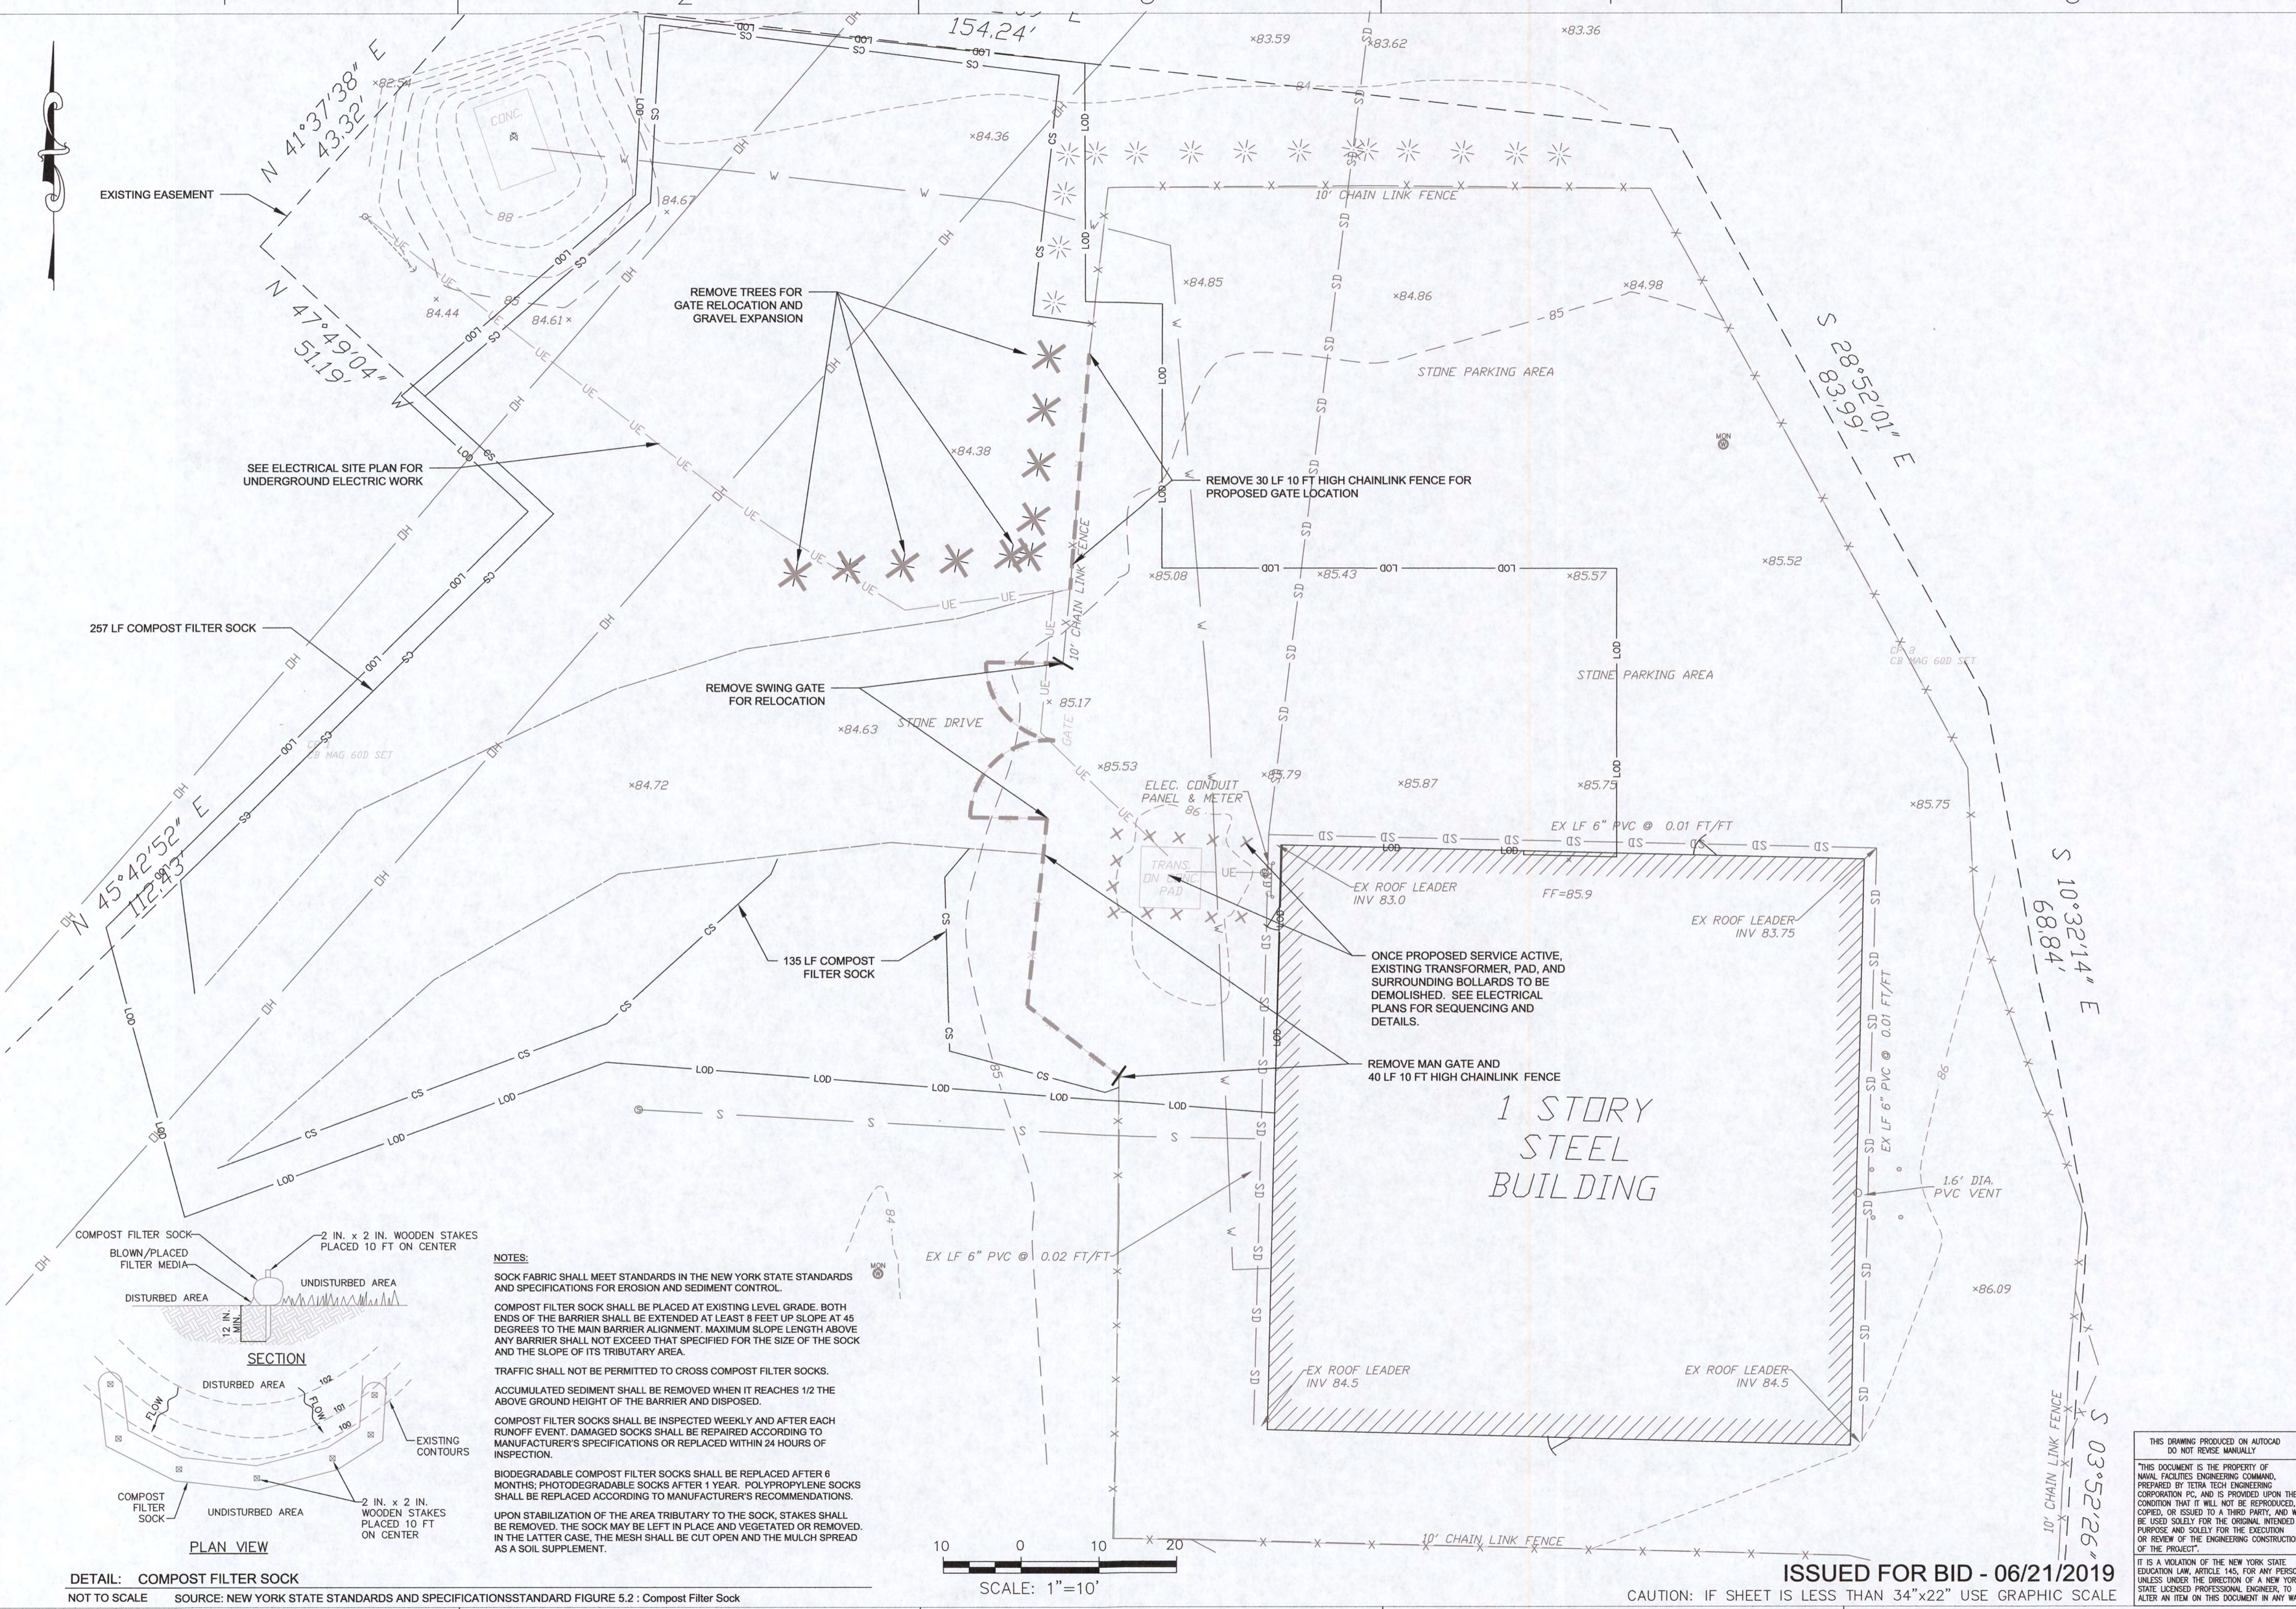

**NOTES:**

SOCK FABRIC SHALL MEET STANDARDS IN THE NEW YORK STATE STANDARDS AND SPECIFICATIONS FOR EROSION AND SEDIMENT CONTROL.

COMPOST FILTER SOCK SHALL BE PLACED AT EXISTING LEVEL GRADE. BOTH ENDS OF THE BARRIER SHALL BE EXTENDED AT LEAST 8 FEET UP SLOPE AT 45 DEGREES TO THE MAIN BARRIER ALIGNMENT. MAXIMUM SLOPE LENGTH ABOVE ANY BARRIER SHALL NOT EXCEED THAT SPECIFIED FOR THE SIZE OF THE SOCK AND THE SLOPE OF ITS TRIBUTARY AREA.


TRAFFIC SHALL NOT BE PERMITTED TO CROSS COMPOST FILTER SOCKS.

ACCUMULATED SEDIMENT SHALL BE REMOVED WHEN IT REACHES 1/2 THE ABOVE GROUND HEIGHT OF THE BARRIER AND DISPOSED.

COMPOST FILTER SOCKS SHALL BE INSPECTED WEEKLY AND AFTER EACH RUNOFF EVENT. DAMAGED SOCKS SHALL BE REPAIRED ACCORDING TO MANUFACTURER'S SPECIFICATIONS OR REPLACED WITHIN 24 HOURS OF INSPECTION.

BIODEGRADABLE COMPOST FILTER SOCKS SHALL BE REPLACED AFTER 6 MONTHS; PHOTODEGRADABLE SOCKS AFTER 1 YEAR. POLYPROPYLENE SOCKS SHALL BE REPLACED ACCORDING TO MANUFACTURER'S RECOMMENDATIONS.

UPON STABILIZATION OF THE AREA TRIBUTARY TO THE SOCK, STAKES SHALL BE REMOVED. THE SOCK MAY BE LEFT IN PLACE AND VEGETATED OR REMOVED. IN THE LATTER CASE, THE MESH SHALL BE CUT OPEN AND THE MULCH SPREAD AS A SOIL SUPPLEMENT.




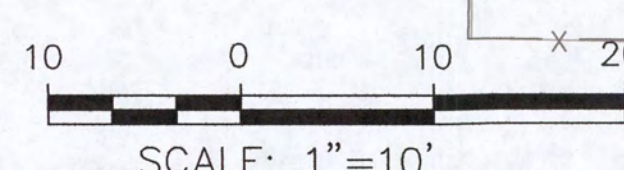


DETAIL: COMPOST FILTER SOCK  
 NOT TO SCALE SOURCE: NEW YORK STATE STANDARDS AND SPECIFICATIONS STANDARD FIGURE 5.2 : Compost Filter Sock



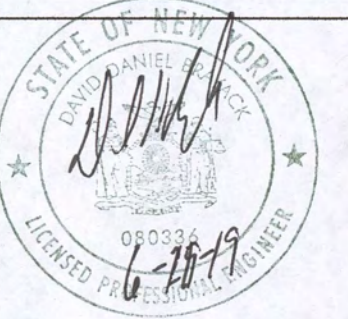
1 STORY  
 STEEL  
 BUILDING



ISSUED FOR BID - 06/21/2019  
 CAUTION: IF SHEET IS LESS THAN 34"x22" USE GRAPHIC SCALE

|  |  |
|--|--|
| DATE   | APP'D  |
| DESCRIPTION  | SYM  |
|  |  |
|  |  |
|  |  |
| SEAL AREA  | DR   |
| DES  | DR   |
| REVIEWED BY  |  |
| PM/DM  |  |
| CHIEF ENGR/ARCH  |  |
| NAVAL FACILITIES ENGINEERING COMMAND<br>NAVAL FACILITIES ENGINEERING COMMAND ~ MID-ATLANTIC<br>NAVAL INDUSTRIAL RESERVE ORDNANCE PLANT<br>BETHPAGE, NEW YORK   | GM-38 AREA<br>GROUNDWATER TREATMENT PLANT<br>AOP SYSTEM ADDITION |
| DEPARTMENT OF THE NAVY<br>NAVAL FACILITIES ENGINEERING COMMAND<br>NAVAL FACILITIES ENGINEERING COMMAND ~ MID-ATLANTIC<br>NAVAL INDUSTRIAL RESERVE ORDNANCE PLANT<br>BETHPAGE, NEW YORK                           | EXISTING CONDITIONS & DEMOLITION PLAN                            |
| CODE NO. NO. 80091<br>SCALE:<br>MAXIMO NO. N62470-08-D-1001<br>JOB ORDER NO. WE-24<br>SPEC. NO.<br>CONSTR. CONTR. NO. N62472-99-D-0002<br>112G08005<br>NAVFAC DRAWING NO.  | SIZE: D<br>SHEET OF  |
| IT IS A VIOLATION OF THE NEW YORK STATE EDUCATION LAW, ARTICLE 145, FOR ANY PERSON, UNLESS UNDER THE DIRECTION OF A NEW YORK STATE LICENSED PROFESSIONAL ENGINEER, TO ALTER AN ITEM ON THIS DOCUMENT IN ANY WAY. |  |
| <b>C-100</b>   |  |

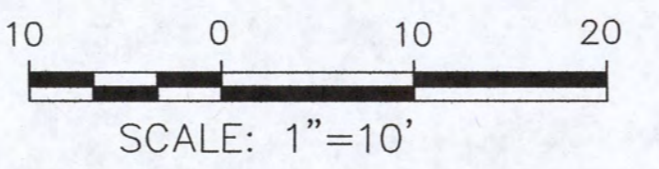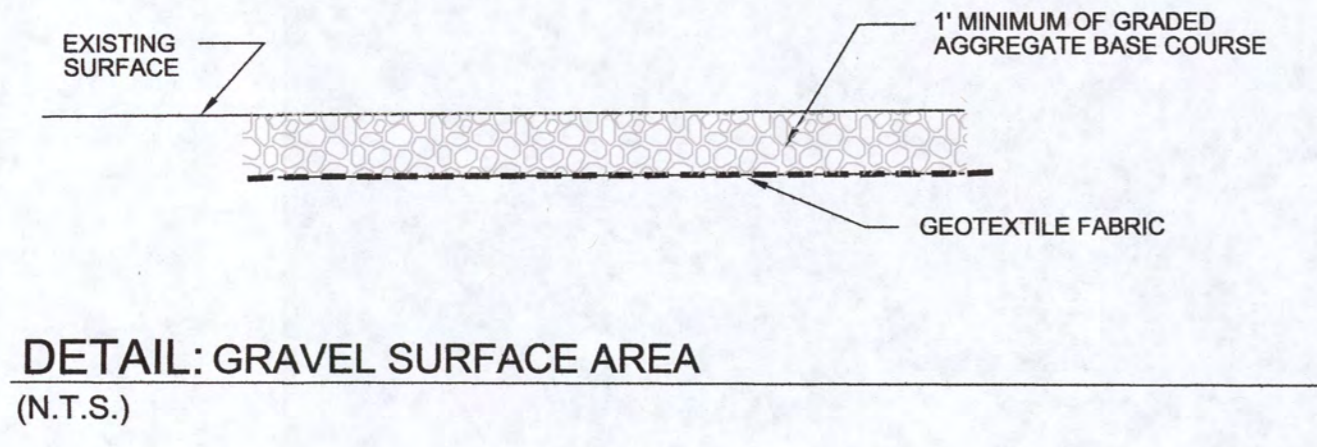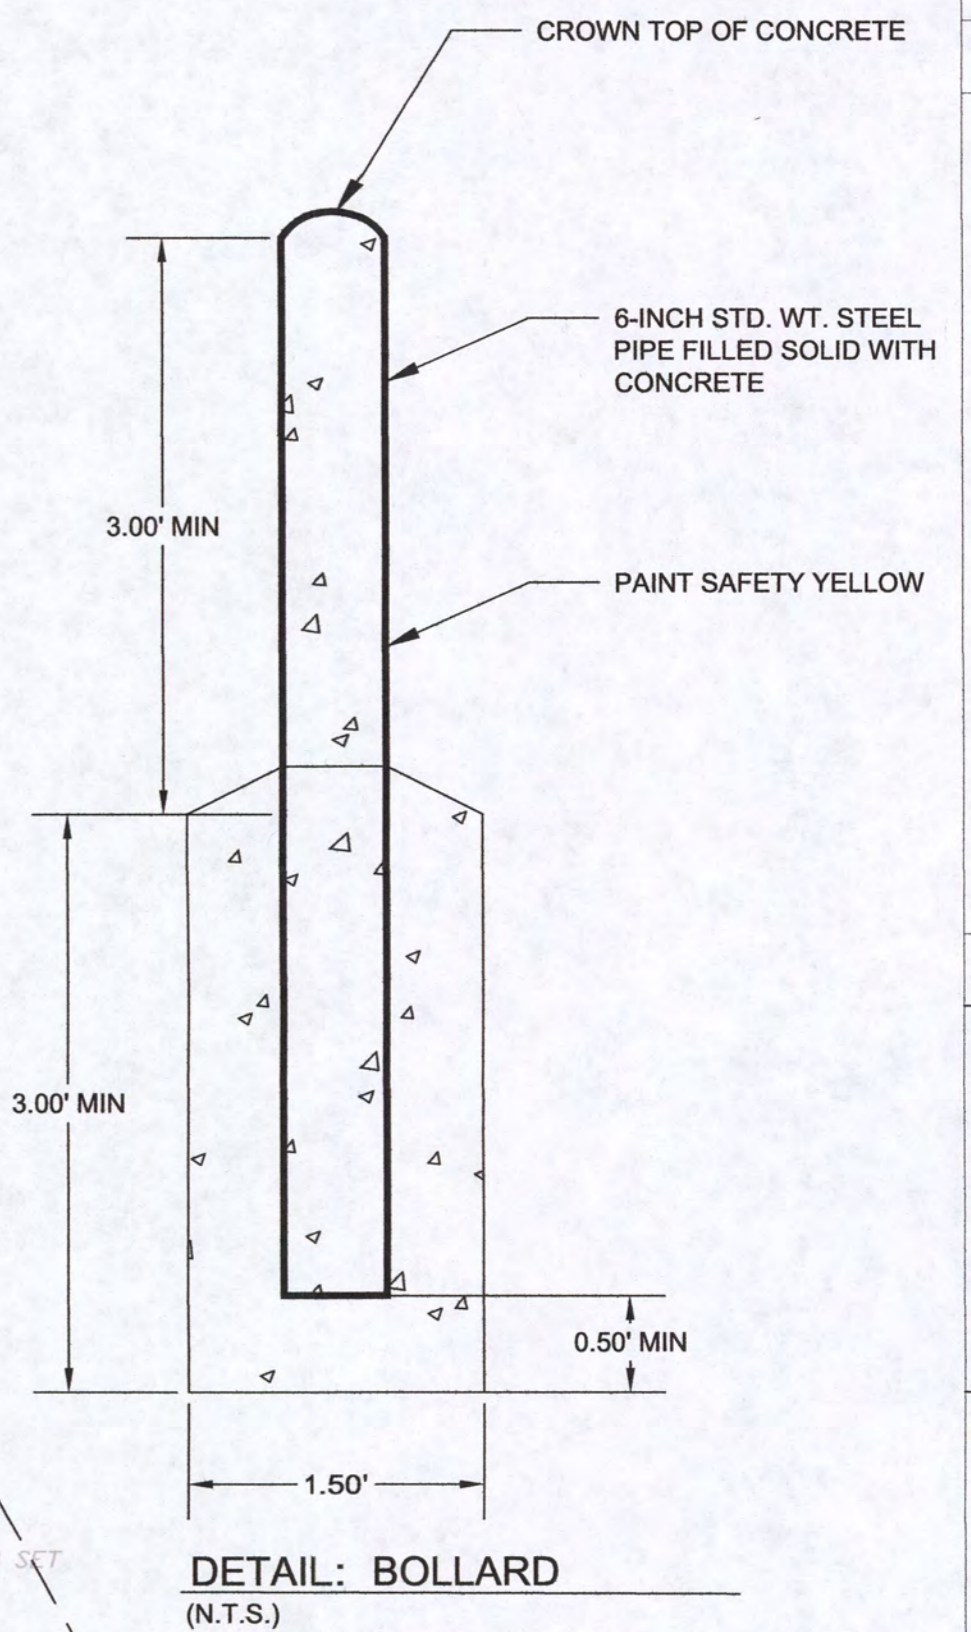
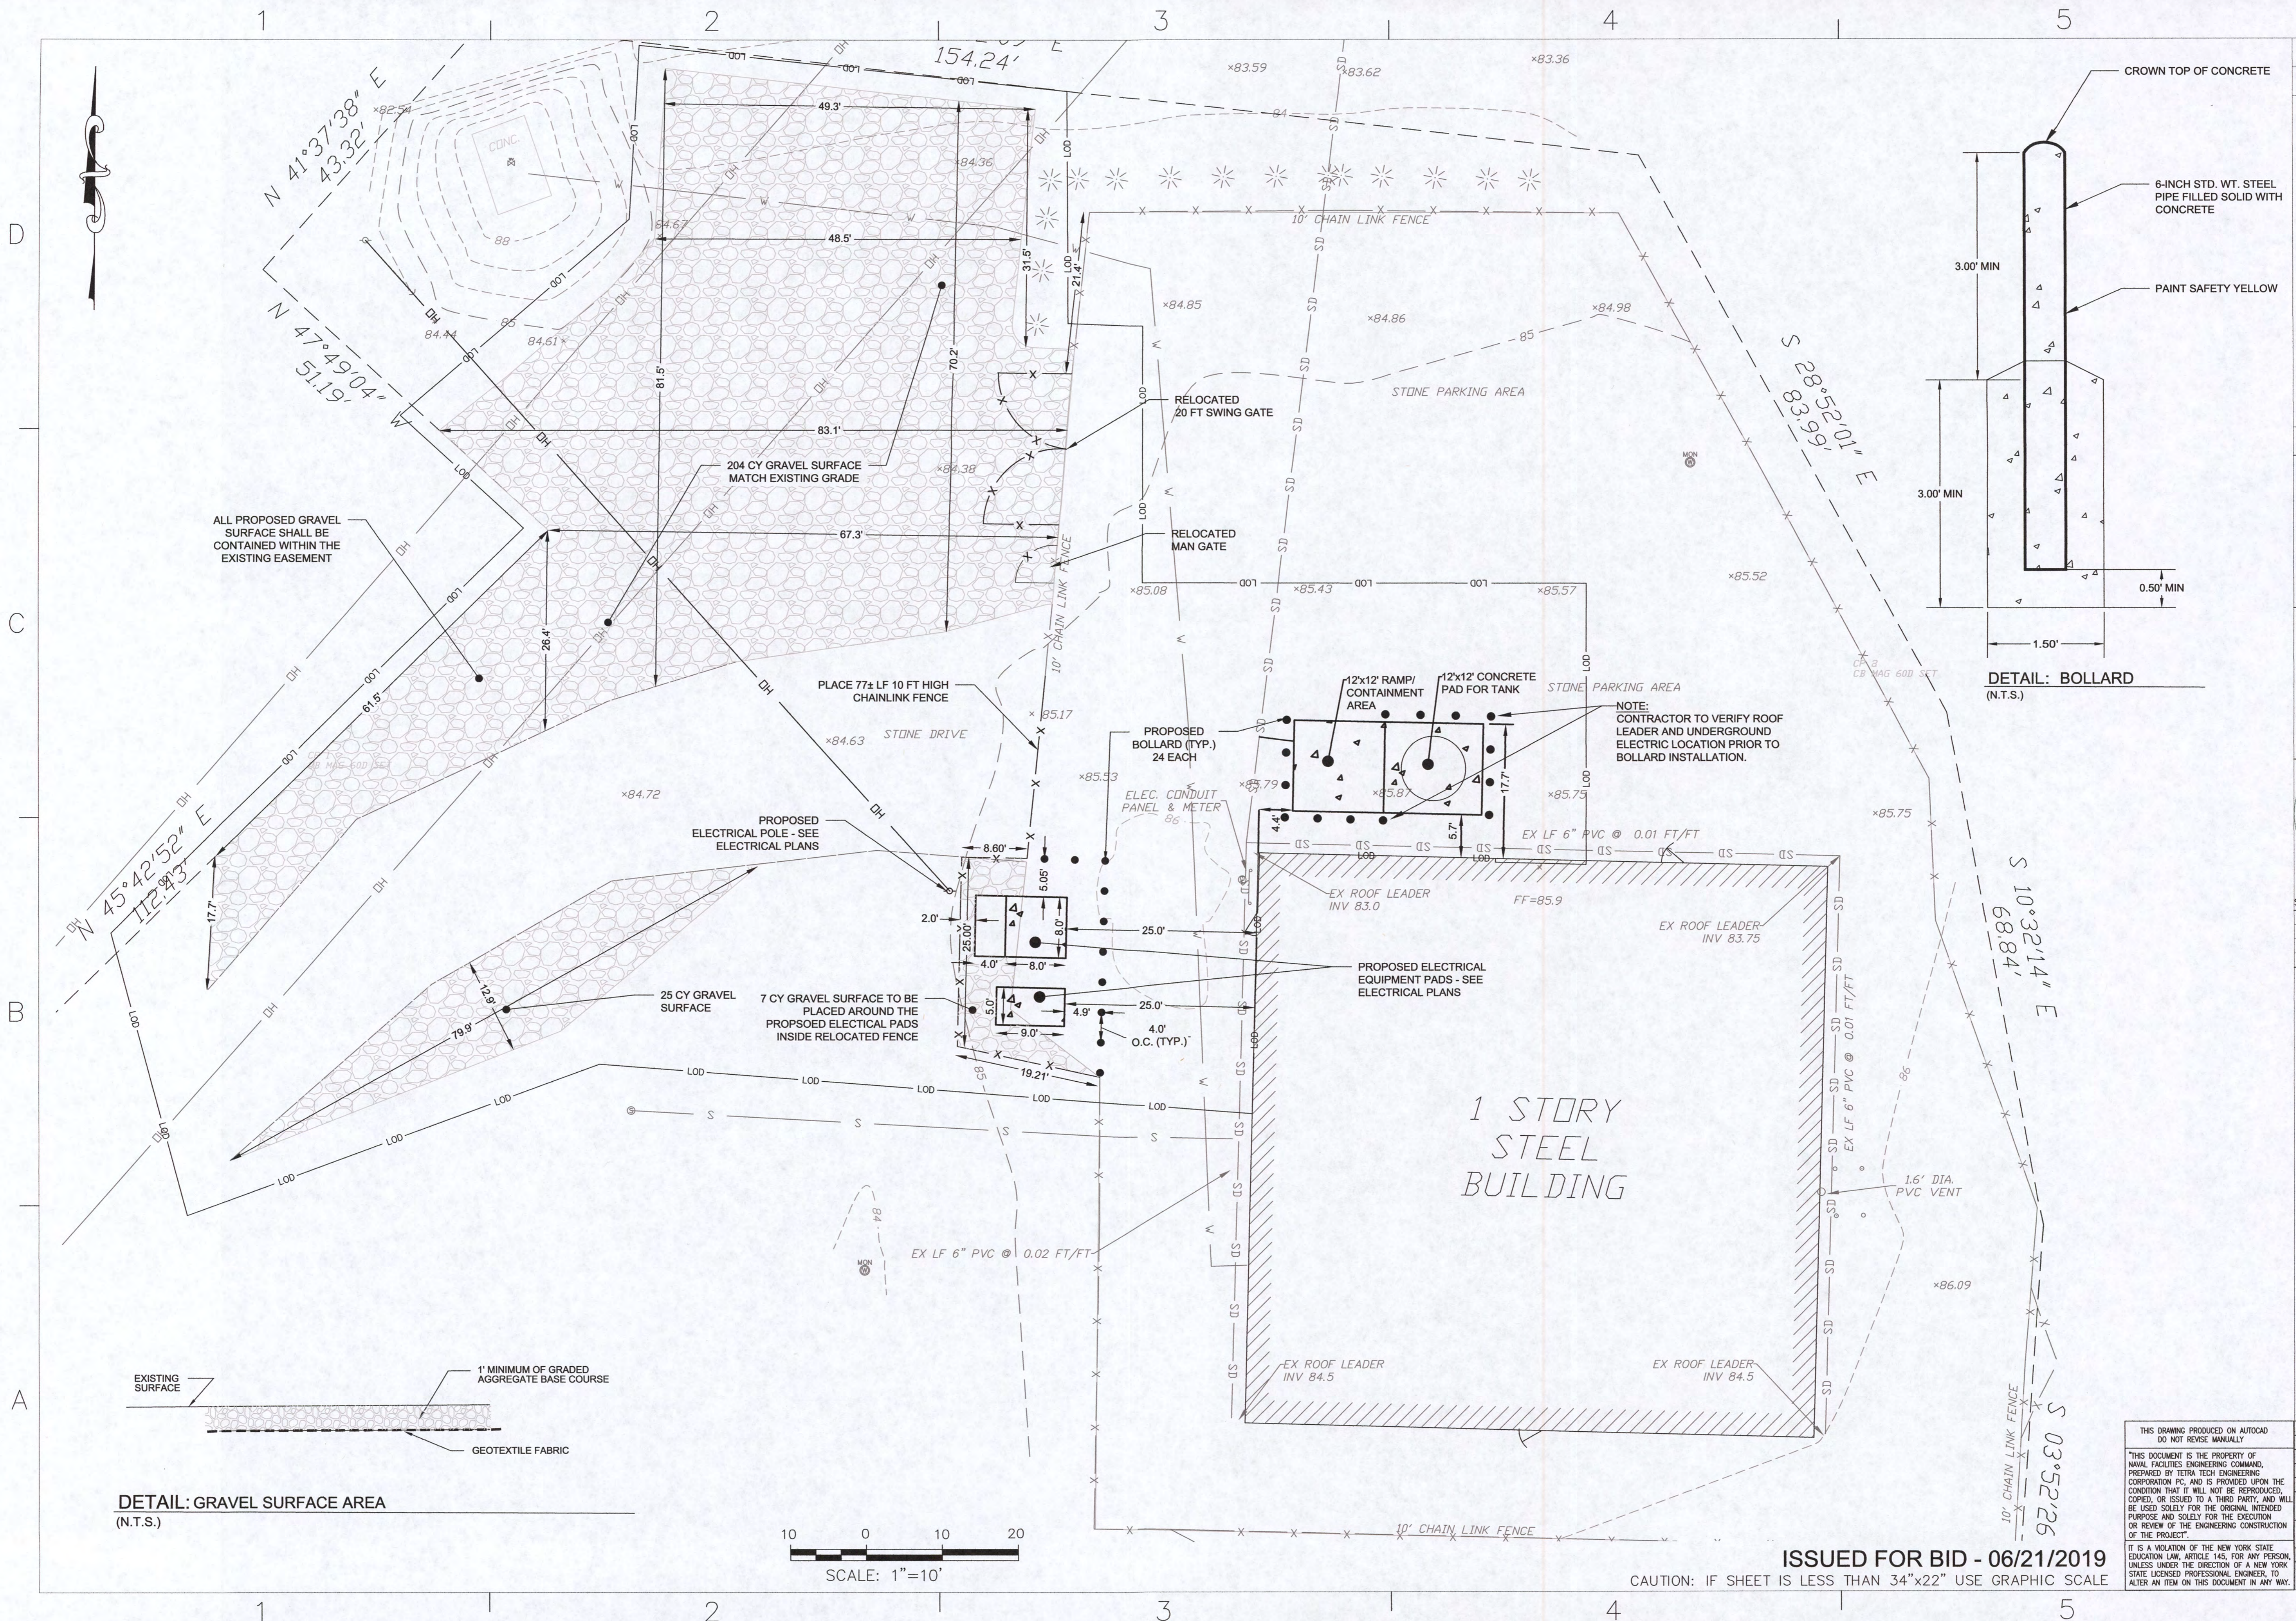


ISSUED FOR BID - 06/21/2019  
 CAUTION: IF SHEET IS LESS THAN 34"x22" USE GRAPHIC SCALE
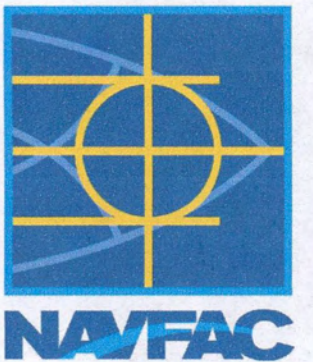
|   |                                     |
|---|-------------------------------------|
| DATE  | APPRO                               |
| DESCRIPTION   |                                     |
| SYN   |                                     |
| <br>  |                                     |
|   |                                     |
| SEAL AREA   | DR                                  |
| DES   | DR                                  |
| REVIEWED BY   |                                     |
| FM/DM   |                                     |
| CHIEF ENG/ARCH  |                                     |
| NAVAL FACILITIES ENGINEERING COMMAND<br>NAVAL FACILITIES ENGINEERING COMMAND ~ MID-ATLANTIC<br>NAVAL INDUSTRIAL RESERVE ORDANCE PLANT<br>GM-38 AREA<br>NAVAL WEAPONS INDUSTRIAL RESERVE PLANT<br>BETHPAGE, NEW YORK |                                     |
| <b>GROUNDWATER TREATMENT PLANT<br/>         AOP SYSTEM ADDITION<br/>         LAYOUT PLAN</b>  |                                     |
| DEPARTMENT OF THE NAVY  | CODE NO. 80091                      |
| NAVAL FACILITIES ENGINEERING COMMAND  | SIZE D                              |
| NAVAL FACILITIES ENGINEERING COMMAND ~ MID-ATLANTIC   | SCALE:                              |
| NAVAL INDUSTRIAL RESERVE ORDANCE PLANT  | MAXIMO NO. NS2470-08-D-1001         |
| GM-38   | JOB ORDER NO. WE-24                 |
| NAVAL WEAPONS INDUSTRIAL RESERVE PLANT  | SPEC. NO.                           |
| BETHPAGE, NEW YORK  | CONSTR. CONTR. NO. NS2470-99-D-0032 |
|   | 112G08005                           |
|   | NAVFAC DRAWING NO.                  |
|   | SHEET OF                            |
|   | <b>C-200</b>                        |

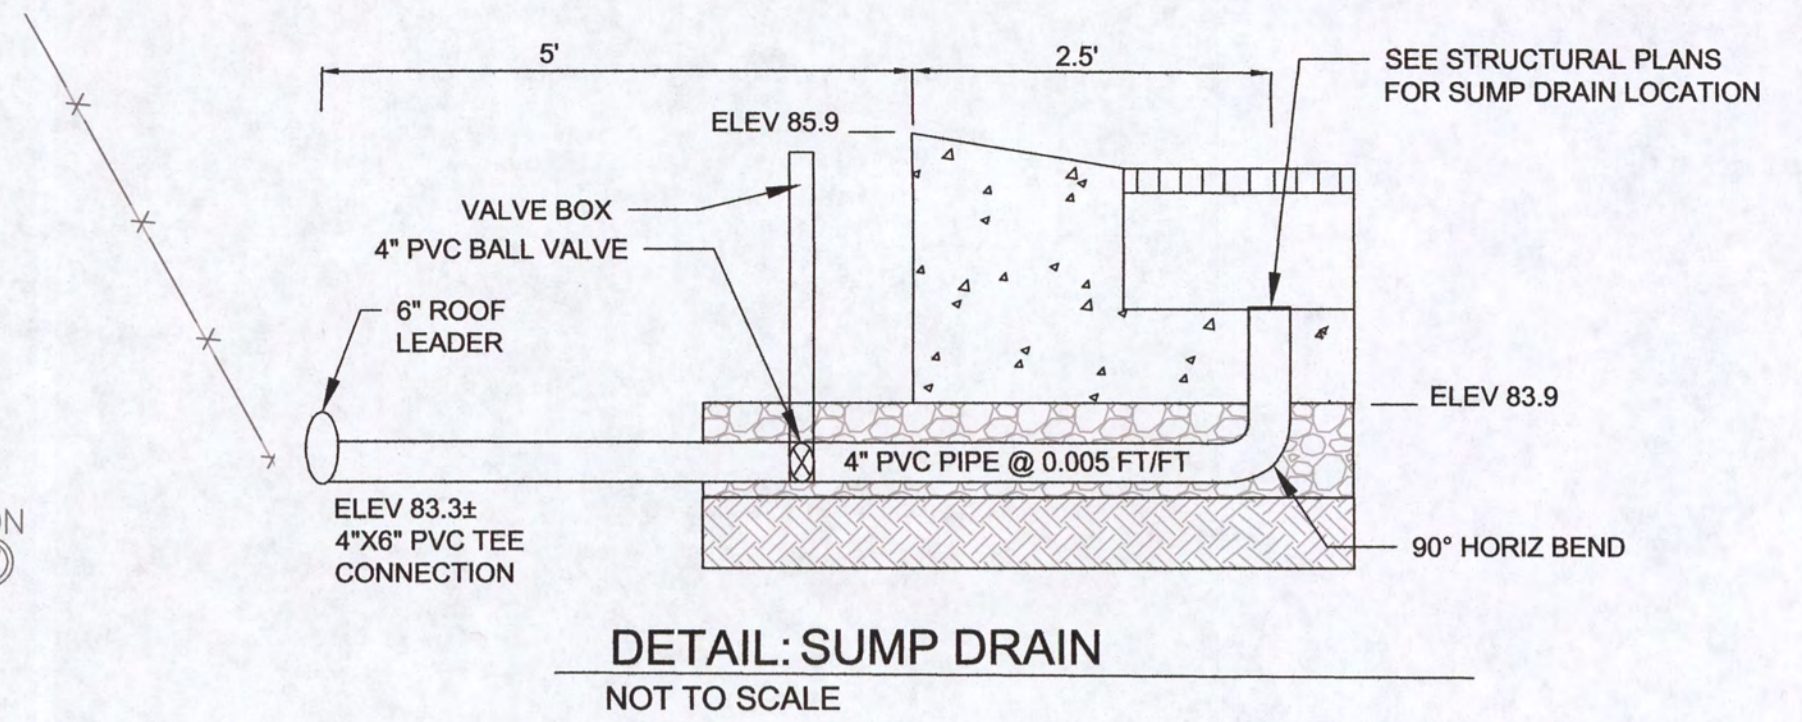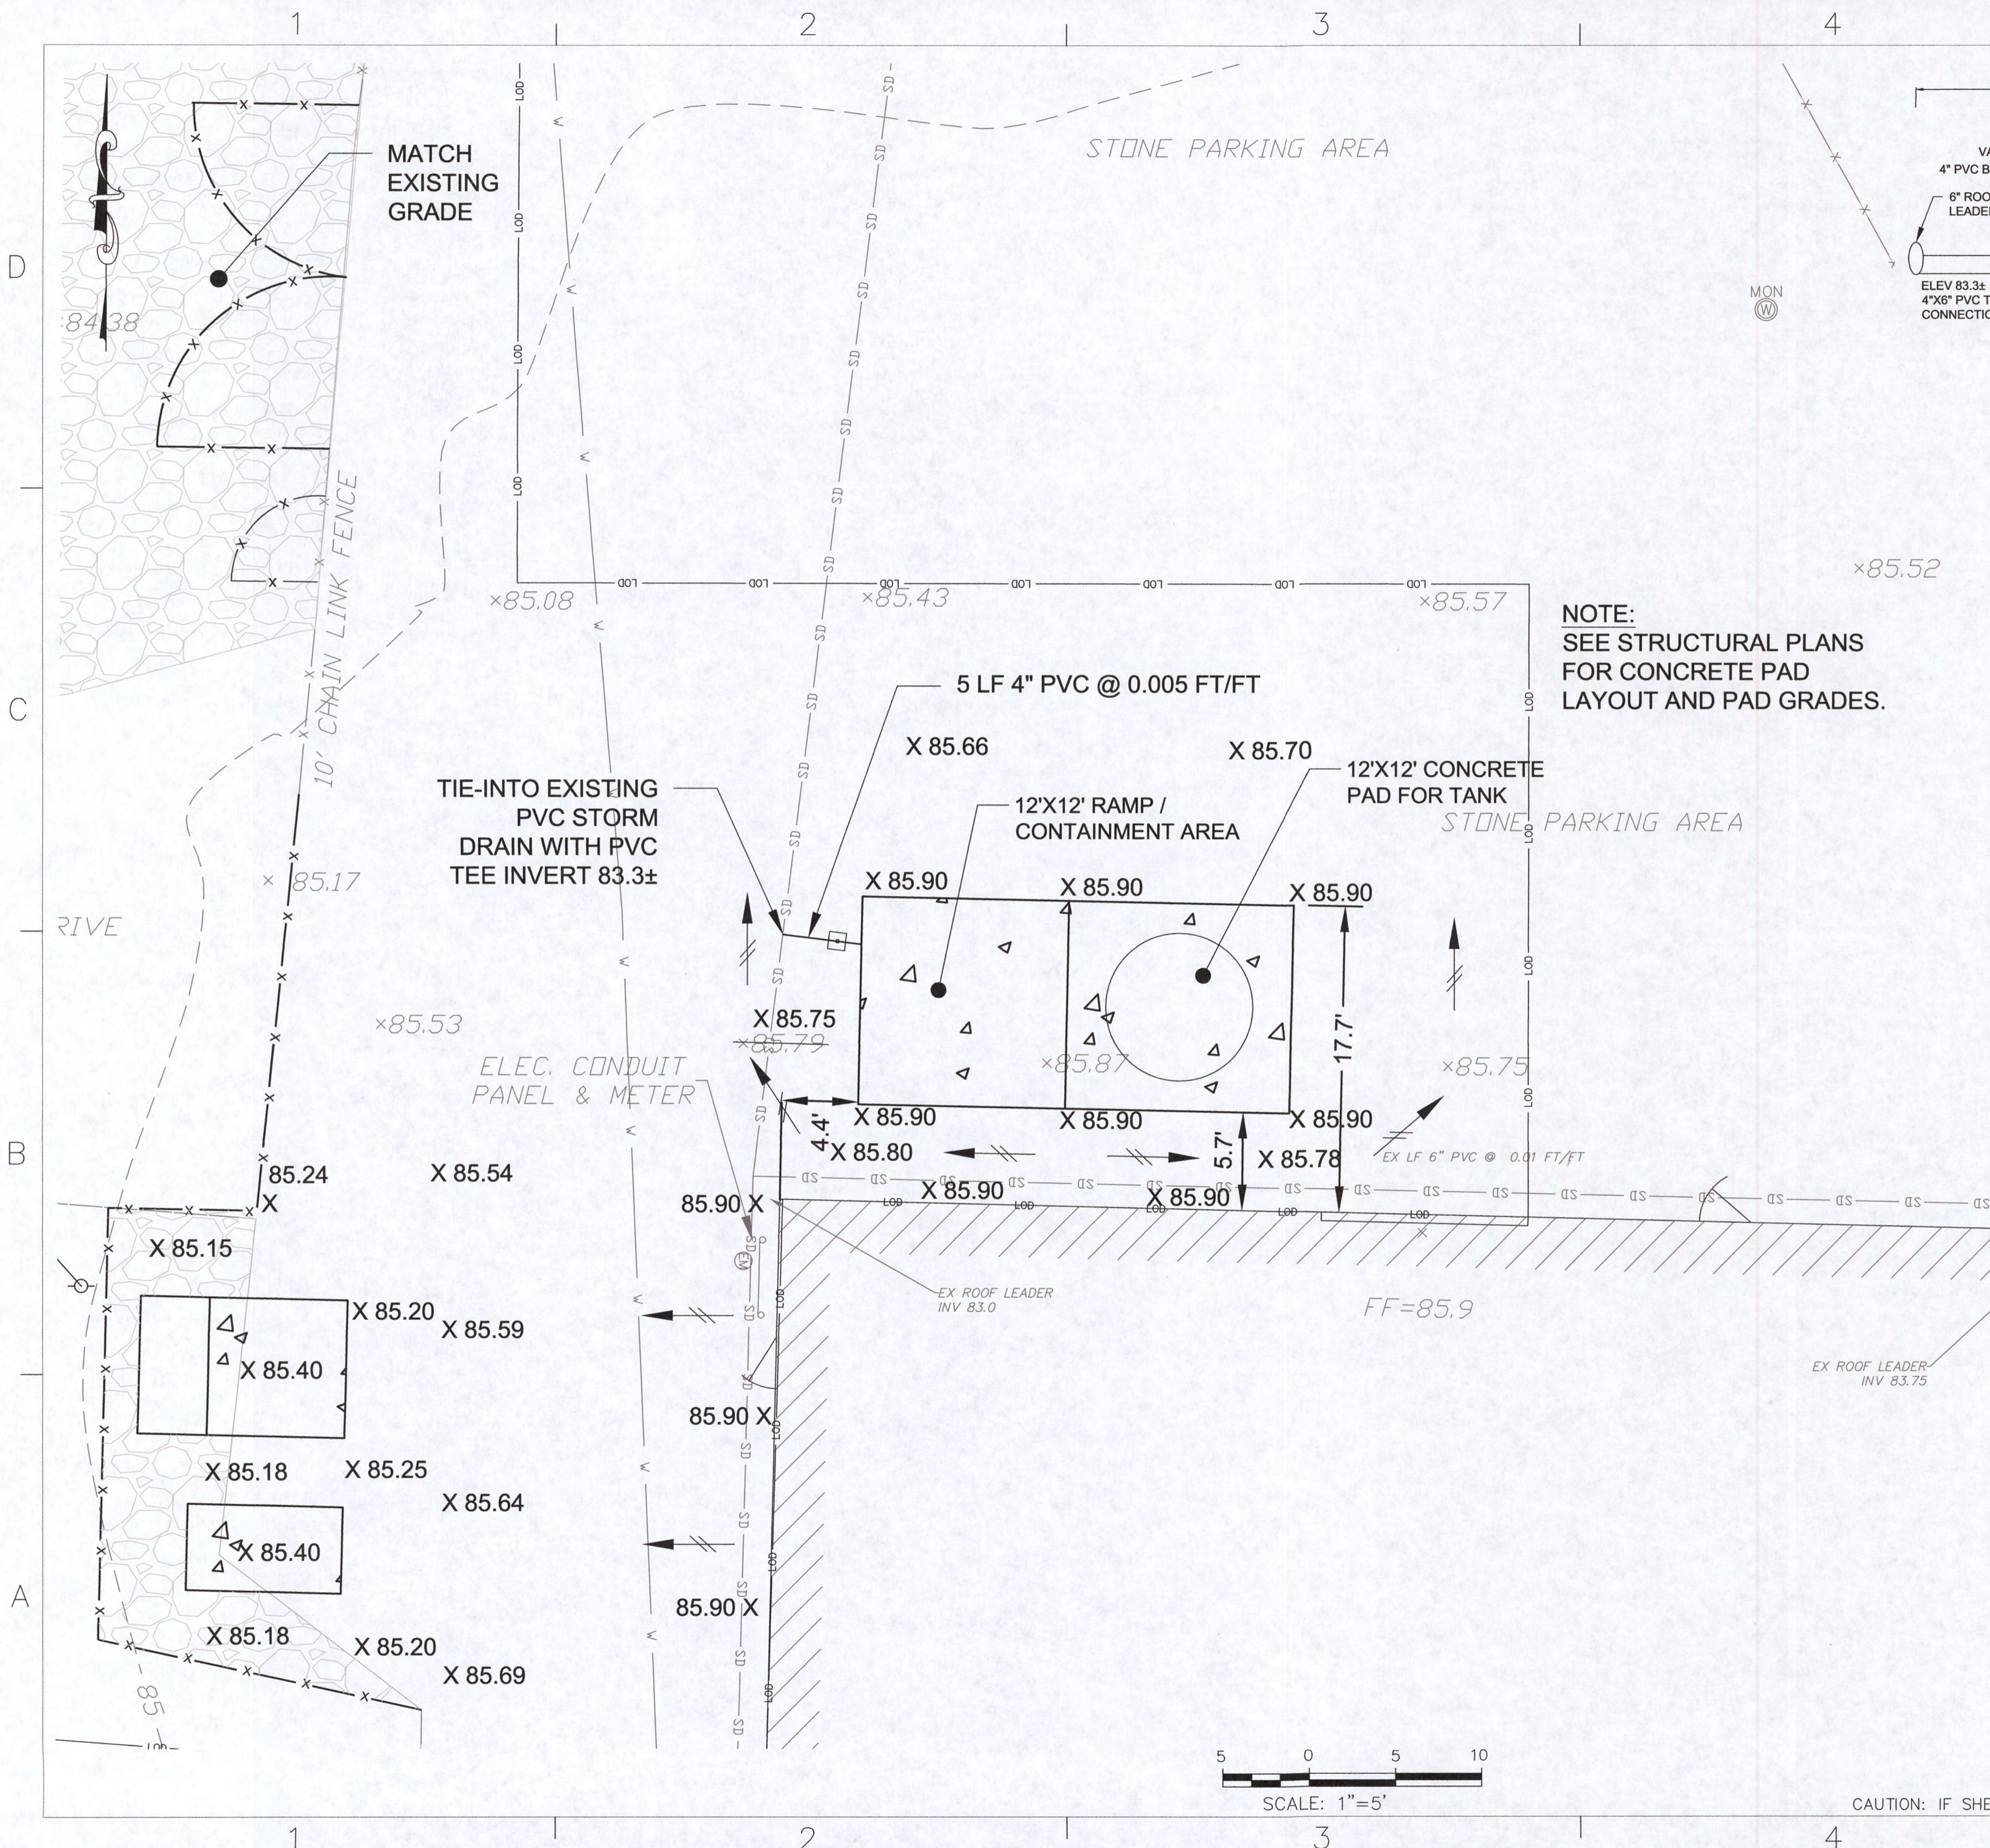

NOTE:  
SEE STRUCTURAL PLANS FOR CONCRETE PAD LAYOUT AND PAD GRADES.

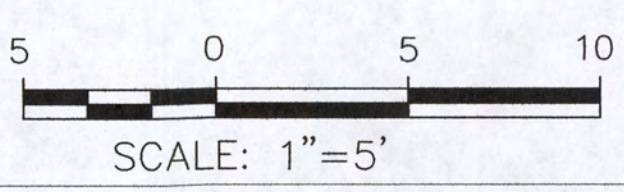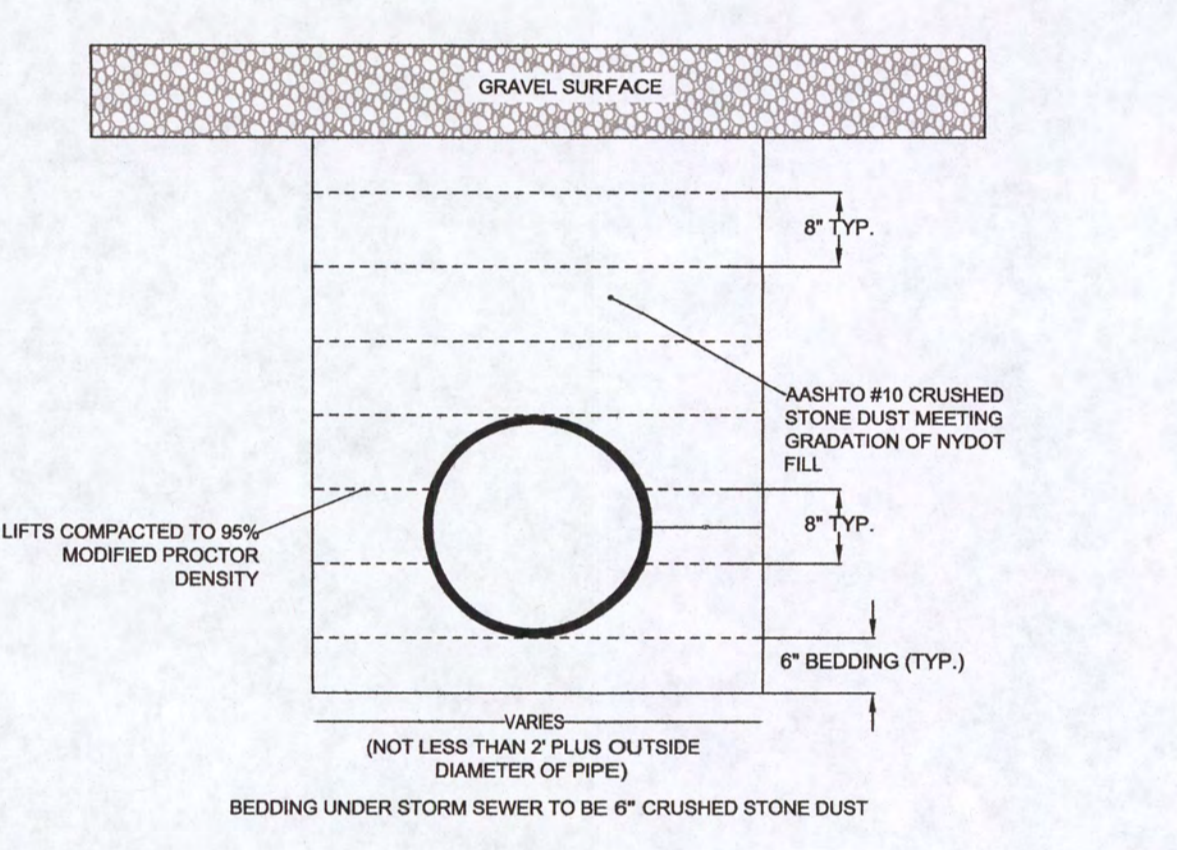

ISSUED FOR BID - 06/21/2019  
CAUTION: IF SHEET IS LESS THAN 34"x22" USE GRAPHIC SCALE

|  |         |
|--|---------|
| DATE   | APPR    |
| DESCRIPTION  | SYN     |
|  |         |
|  |         |
|  |         |
| SEAL AREA  |         |
| DES  | DR      |
| REVIEWED BY  |         |
| PM/DM  |         |
| CHIEF ENG/ARCH   |         |
| DEPARTMENT OF THE NAVY<br>NAVAL FACILITIES ENGINEERING COMMAND<br>NAVAL FACILITIES ENGINEERING COMMAND ~ MID-ATLANTIC<br>NAVAL WEAPONS INDUSTRIAL RESERVE PLANT GM-38 AREA<br>NAVAL INDUSTRIAL RESERVE ORDNANCE PLANT BETHPAGE, NEW YORK<br>GROUNDWATER TREATMENT PLANT<br>AOP SYSTEM ADDITION<br>GRADING PLAN |         |
| CODE NO. NO 80091  | SIZE: D |
| SCALE:   |         |
| MAXIMO NO. H62470-08-D-1001  |         |
| JOB ORDER NO. WE-24  |         |
| SPEC. NO.  |         |
| CONSTR. CONTR. NO. H62472-99-D-0032  |         |
| 112G08005  |         |
| NAVIFAC DRAWING NO.  |         |
| SHEET  | OF      |
| C-300  |         |

STRUCTURAL GENERAL NOTES

- A. THESE GENERAL NOTES PRESENT AND/OR SUMMARIZE KEY PROJECT INFORMATION FOR THE DRAWING READER'S CONVENIENCE. SEE ALSO INDIVIDUAL DRAWING NOTES AND PROJECT SPECIFICATIONS FOR FURTHER DETAILS AND REQUIREMENTS.
B. ALL REFERENCES TO REFERENCE STANDARDS HEREIN ARE TO MOST RECENT ISSUE IN EFFECT AS OF THE DATE OF THESE DOCUMENTS, UNLESS NOTED OTHERWISE IN PROJECT SPECIFICATIONS OR ON THE DRAWING
C. ALL ELEVATIONS ARE REFERENCED TO FINISH FLOOR EL. 0'-0" = 85.9' (VIF) ELEVATIONS SHOWN ON DRAWINGS ARE REFERENCED TO THIS DATUM UNLESS NOTED.
D. SUBMIT SHOP DRAWINGS, PROJECT DATA AND SAMPLES AS SPECIFIED IN PROJECT SPECIFICATIONS.
E. ABBREVIATIONS
A.B. ANCHOR BOLT
ADD'L ADDITIONAL
AISC AMERICAN INSTITUTE OF STEEL CONSTRUCTION
ALT. ALTERNATE
ALUM. ALUMINUM
APPROX. APPROXIMATE
ARCH. ARCHITECT(URAL)
B.M. BEAM
B.O. BOTTOM OF
B.O.F. BOTTOM OF FOOTING
B.O.S. BOTTOM OF STEEL
BLDG. BUILDING
BOT. BOTTOM
BRG. BEARING
BTWN BETWEEN
C/C CENTER TO CENTER
CCJ CRACK CONTROL JOINT
CFS COLD FORMED STEEL
CJ CONSTRUCTION JOINT
CL CENTER LINE
CLG CEILING
CLR CLEAR
CMU CONCRETE MASONRY UNIT
COL COLUMN
CONC CONCRETE
CONST CONSTRUCTION
CONT CONTINUOUS
COORD COORDINATE
CTR CENTER
DBA DEFORMED BAR ANCHOR
DEMO DEMOLISH
DIA DIAMETER
DIM DIMENSION
DIST DISTANCE
DN DOWN
DTL DETAIL
DWG(S) DRAWING(S)
DWL DWEL
E EXISTING
EA EACH
EF EACH FACE
EJ EXPANSION JOINT
EL / ELEV. ELEVATION
ELEC ELECTRIC(AL)
ENGR ENGINEER
EQ EQUAL
EQUIP EQUIPMENT
EW EACH WAY
EXIST EXISTING
EXP EXPANSION
EXTG EXISTING
F.S. FAR SIDE
F.V. FIELD VERIFY
FD FLOOR DRAIN
FF FINISH FLOOR
FFE FINISH FLOOR ELEVATION
FIN FINISH (ED)
FLG FLANGE
FLR FLOOR
FND. FOUNDATION
FRMG FRAMING
FT FOOT
FTG FOOTING
GA GAGE, GAUGE
GALV GALVANIZED
GR. GRADE
GRGT GRATING
H.P. HIGH POINT
H.R. HAND RAIL
HK HOOK
HORIZ HORIZONTAL
HT HEIGHT
HVAC HEATING VENTILATION AND AIR CONDITIONING
I.D. INSIDE DIAMETER
I.F. INSIDE FACE
I.J. ISOLATION JOINT
IN. INCH
INSUL INSULATION
L ANGLE
L.P. LOW POINT
LBS POUNDS
LF LINEAR FOOT (FEET)
LLH LONG LEG HORIZONTAL
LLV LONG LEG VERTICAL
LOC LOCATION
MATL MATERIAL
MAX MAXIMUM
MECH MECHANICAL
MFR MANUFACTURER
MID MIDDLE / MIDPOINT
MIN MINIMUM, MINUTE
MISC. MISCELLANEOUS
MTL METAL
N NEW
N.S. NEAR SIDE
N.T.S. NOT TO SCALE
NA NOT APPLICABLE
NO NUMBER
NOM NOMINAL
O.C. ON CENTER
O.D. OUTSIDE DIAMETER
OPH OPPOSITE HAND
OPNG OPENING
OPP OPPOSITE
ORIG ORIGINAL
PEMB PRE-ENGINEERED METAL BUILDING
PERF PERFORATED
PERP PERPENDICULAR
PL PLATE
PLF POUNDS PER LINEAR FOOT
PRCST PRECAST
PRFAB PREFABRICATED
PSF POUNDS PER SQUARE FOOT
PSI POUNDS PER SQUARE INCH
PT PRESSURE TREATED
QTY QUANTITY
R RISER
RAD. RADIUS
RD ROOF DRAIN
REF REFERENCE
REINF. REINFORCEMENT
REQ REQUIRE
REQD REQUIRED
REV REVISION
RO ROUGH OPENING
SCHED SCHEDULE
SF SQUARE FOOT
SHT. SHEET
SIM. SIMILAR
SLF SIDE LAP FASTENER
SPA. SPACE
SPEC SPECIFICATIONS
SQ SQUARE
SS STAINLESS STEEL
STAG. STAGGER
STD STANDARD
STL STEEL
STL JST STEEL JOIST
STRUCT STRUCTURE(AL)
SYM SYMMETRICAL
T TREAD
T.O.C. TOP OF CONCRETE
T/ TOP OF
TEMP TEMPORARY
THK THCKNESS
TOF TOP OF FOOTING
TOS TOP OF SLAB
TRANSV. TRANSVERSE
TYP TYPICAL
UNO UNLESS NOTED OTHERWISE
V.I.F. VERIFY IN FIELD
VERT VERTICAL
W.P. WORK POINT
W/ WITH
W/O WITHOUT
WS WATER STOP.
WWF WELDED WIRE FABRIC

FOUNDATIONS

- A. SEE GEOTECHNICAL/SUBSURFACE INVESTIGATION REPORT BY TETRA TECH, DATED 4/23/2019. IT SHALL BE THE CONTRACTOR'S RESPONSIBILITY TO DETERMINE WHETHER OR NOT ADDITIONAL GEOTECHNICAL INFORMATION IS REQUIRED AND TO PROVIDE SUCH INFORMATION AS THE CONTRACTOR DEEMS NECESSARY.
B. ALLOWABLE BEARING PRESSURES AS FOLLOWS:
SLAB ON GRADE = 3000 PSF
C. GEOTECHNICAL ENGINEER SHALL BE RETAINED BY OWNER TO PROVIDE OBSERVATION AND TESTING SERVICES DURING THE GRADING AND FOUNDATION PHASE OF CONSTRUCTION. INSPECTION AND TESTING REPORTS SHALL BE SUBMITTED TO THE STRUCTURAL ENGINEER.
D. PRIOR TO PLACING ENGINEERED FILL, THE SITE SHALL BE STRIPPED AND PROOF ROLLED. ANY SOFT SPOTS ENCOUNTERED SHALL BE REMOVED AND REPLACED WITH ENGINEERED FILL. REFER TO GEOTECHNICAL REPORT FOR ADDITIONAL INFORMATION.
E. SITE PREPARATION ACTIVITIES WILL BE REQUIRED PRIOR TO CONSTRUCTION OF THE TANK MAT FOUNDATION AND CONTAINMENT SLAB DUE TO THE PRESENCE OF THE STRATUM "A" HISTORICALLY FILL SOILS. THE STRATUM "A" FILL SOILS (INCLUDING THE ORGANIC SOILS) ARE CONSIDERED UNSUITABLE FOR DIRECT SUPPORT OF THE MAT FOUNDATION BECAUSE EXCESSIVE AND DETRIMENTAL DIFFERENTIAL SETTLEMENT OF THE MAT FOUNDATION COULD RESULT. THEREFORE, CONTRACTOR TO REMOVE ALL STRATUM "A" FILL SOILS FROM THE SLAB FOUNDATIONS AREAS TO A MINIMUM DEPTH OF FIVE (5) FEET BELOW GRADE SURFACE. REMOVAL OF THESE MATERIALS IS TO EXTEND A MINIMUM OF FIVE (5) FEET BEYOND THE FOOTPRINT OF THE SLABS. FOLLOWING REMOVAL OF THE STRATUM "A" FILL MATERIAL AND PROPER SUBGRADE PREPARATION, APPROVED ENGINEERED FILL MAY BE USED TO BRING THESE AREAS TO DESIGN SUBGRADE ELEVATIONS. SEE GEOTECHNICAL REPORT FOR ADDITIONAL INFORMATION.

DESIGN CRITERIA

- A. REFERENCES:
1. ICC INTERNATIONAL BUILDING CODE, 2015 EDITION
RISK CATEGORY III IN ACCORDANCE WITH TABLE 1604.5
2. STATE BUILDING CODE: NYC CONSTRUCTION CODE 2014
3. ASCE/SEI 7-10 - MINIMUM DESIGN LOADS FOR BUILDINGS AND OTHER STRUCTURES
B. DEAD LOADS:
ROOF DEAD LOAD = (SELF WEIGHT) OR 5 PSF
ROOF COLLATERAL\* LOAD = 10 PSF
AVAILABLE TO RESIST UPLIFT = SELF WEIGHT OF STRUCTURAL FRAMING ONLY
\* COLLATERAL LOAD INCLUDES PROVISION FOR HANGING LOADS INCLUDING PROCESS, PLUMBING AND OTHER COMPONENTS. REFER TO DRAWINGS FOR CONCENTRATED LOADING.
C. LIVE LOADS (U.N.O.):
TYPICAL GROUND FLOORS = WEIGHT OF TANK 30,000 LBS (FULL) 2,300 LBS (EMPTY) TO BE CONFIRMED BY CONTRACTOR UPON FINAL EQUIPMENT SELECTION
TRUCK LOADING SLAB = H-20 LOADING
CANOPY ROOF = 20 PSF
PROCESS FLOOR = 200 PSF
D. FROST DEPTH = 48 INCHES
E. ROOF SNOW LOAD:
GROUND SNOW LOAD, Pg = 30.0 PSF
FLAT ROOF SNOW LOAD, Pf = 27.7 PSF
SNOW EXPOSURE FACTOR, Ce = 1.0
SNOW LOAD IMPORTANCE FACTOR, I = 1.10
THERMAL FACTOR, Ct = 1.20
F. WIND LOAD:
ULTIMATE DESIGN WIND SPEED, VuIt = 138 MPH
NOMINAL DESIGN WIND SPEED, Vasd = 106 (VuIt\*0.6) MPH
RISK CATEGORY = III
WIND EXPOSURE CATEGORY = B
DIRECTIONALITY FACTOR, Kd = 0.85
TOPOGRAPHY = 1.0
INTERNAL PRESSURE COEFFICIENT, GCpi = 0.00
BUILDING ENCLOSURE CLASSIFICATION = OPEN BUILDING
FOR COMPONENTS & CLADDING PRESSURES, REFER TO CHART ON SHEET S-002
G. SEISMIC DESIGN DATA:
RISK CATEGORY = III
SEISMIC IMPORTANCE FACTOR, Ie = 1.25
SDS = 0.250
SD1 = 0.106
SS = 0.234
S1 = 0.066
SITE CLASS = 'D'
SEISMIC DESIGN CATEGORY = 'B'
RESPONSE MODIFICATION FACTOR, R = 3
BASIC SEISMIC FORCE RESISTING SYSTEM = (STRUCTURAL STEEL SYSTEM NOT SPECIFICALLY DETAILED FOR SEISMIC RESISTANCE)
SEISMIC RESPONSE COEFFICIENT, Cs = 0.104
DESIGN BASE SHEAR = 0.5 KIPS
ANALYSIS PROCEDURE: = EQUIVALENT LATERAL FORCE

STRUCTURAL CONCRETE

- A. REFERENCES:
1. ACI 318-14 BUILDING CODE REQUIREMENTS FOR STRUCTURAL CONCRETE
2. ACI 350-06 CODE REQUIREMENTS FOR ENVIRONMENTAL ENGINEERING CONCRETE STRUCTURES
3. ACI SP-66 ACI DETAILING MANUAL
4. ACI 301-16 SPECIFICATION FOR STRUCTURAL CONCRETE
5. ACI 117-10 SPECIFICATION FOR TOLERANCES FOR CONCRETE CONSTRUCTION AND MATERIALS
6. CRSI MSP-2-01 MANUAL OF STANDARD PRACTICE
7. CRSI REINFORCING BAR DETAILING
8. CRSI PLACING REINFORCING BARS
B. MATERIALS
1. STRUCTURAL CONCRETE
a) MINIMUM COMPRESSIVE STRENGTH AT 28 DAYS (fc).....4500 PSI
b) ALL CONCRETE EXPOSED TO THE ELEMENTS SHALL BE AIR-ENTRAINED IN ACCORDANCE WITH ASTM C260. SEE SPECIFICATIONS.
c) ALL CONCRETE AGGREGATE SHALL COMPLY WITH ASTM C33 (NORMAL WEIGHT).
2. REINFORCEMENT
a) REINFORCING BARS: ASTM A615, GRADE 60
3. ANCHOR RODS
a) SHALL BE GALVANIZED, FURNISHED WITH CHAMFERED ENDS, AND SHALL MEET STRENGTH AND DUCTILITY REQUIREMENTS EQUIVALENT ASTM F1554, GR 55 WELDABLE MATERIAL.
4. MECHANICAL (TORQUE-CONTROLLED) ANCHORS
a) APPROVED SYSTEMS INCLUDE HILTI KWIK BOLT TZ (ICC ESR 1917) OR HILTI KWIK HUS-EZ (ICC ESR 3027) OR EQUAL CONSIDERING LOAD RESISTANCE. MECHANICAL ANCHORS SHALL BE APPROVED FOR USE WITH CRACKED CONCRETE PER AC 193. CURRENT ICC-ESR SHALL BE SUBMITTED. ALL PERSONNEL INSTALLING ANCHORS SHALL BE TRAINED BY THE MANUFACTURER ON PROPER INSTALLATION TECHNIQUE. TRAINING DOCUMENTATION FROM THE MANUFACTURER SHALL BE AVAILABLE ON REQUEST
5. ADHESIVE ANCHORS
a) APPROVED SYSTEMS INCLUDE HILTI HIT-RE 500 V3 (ICC ESR 3814) OR HILTI HIT-HY 200 HAS WITH SAFESET TECHNOLOGY (ICC ESR 3187) OR EQUAL CONSIDERING LOAD RESISTANCE, IN-SERVICE AND INSTALLATION TEMPERATURE, AVAILABILITY OR COMPREHENSIVE INSTALLATION INSTRUCTIONS, AND CREEP. ADHESIVE ANCHORS SHALL BE APPROVED FOR USE WITH CRACKED CONCRETE PER AC 308. CURRENT ICC-ESR SHALL BE SUBMITTED
b) ALL PERSONNEL INSTALLING ANCHORS SHALL BE TRAINED BY THE MANUFACTURER ON PROPER INSTALLATION TECHNIQUE. TRAINING DOCUMENTATION FROM THE MANUFACTURER SHALL BE AVAILABLE ON REQUEST.
c) HOLE SIZES AND INSTALLATION SHALL BE IN ACCORDANCE WITH MANUFACTURER'S PRINTED INSTALLATION INSTRUCTIONS (MPI)

STRUCTURAL CONCRETE(CONTINUED)

- d) ADHESIVE FOR REBAR AND ANCHORS SHALL HAVE BEEN TESTED IN ACCORDANCE WITH ACI 355.4 AND ICC-ES AC308 FOR CRACKED CONCRETE AND SEISMIC APPLICATIONS. DESIGN ADHESIVE BOND STRENGTH HAS BEEN BASED ON ACI 355.4 TEMPERATURE CATEGORY A WITH INSTALLATIONS INTO DRY OR WATER SATURATED HOLES DRILLED USING A CARBIDE DRILL BIT INTO CONCRETE THAT HAS BEEN CURED FOR AT LEAST 21 DAYS.
e) ANY ADHESIVE ANCHOR INSTALLED HORIZONTALLY OR IN A VERTICALLY INCLINED PLANE SHALL BE INSTALLED BY CERTIFIED ADHESIVE ANCHOR INSTALLER, PER ACI 318-14 17.8.2.2, AND SHALL BE INSPECTED PER ACI 318-14 17.8.2.4.
f) FILL IN ALL ABANDONED HOLES WITHIN 2" OF NEW ANCHOR LOCATIONS.
6. GROUT: HIGH STRENGTH, NON-SHRINK STRUCTURAL GROUT. SEE SPECIFICATIONS.
C. REINFORCEMENT DETAILING
1. ALL REINFORCING STEEL DETAILS SHALL BE IN ACCORDANCE WITH THE ACI CODE REQUIREMENTS ( ACI 350 - CURRENT EDITION).
2. REINFORCING STEEL PLACING DRAWINGS AND BAR LISTS SHALL CONFORM TO THE ACI OR CRSI DETAILING MANUALS. ALL BAR AND MESH SUPPORTS MUST BE CLEARLY DETAILED
3. CONCRETE COVER FOR REINFORCING SHALL BE INDICATED ON THE APPLICABLE REINFORCING STEEL SHOP DRAWINGS. HOWEVER, NO REINFORCING IN AREAS EXPOSED TO EARTH, WEATHER OR WATER SHALL HAVE COVER LESS THAN TWO INCHES.
4. SPECIFIED COVER FOR REINFORCING PER ACI 350 (BUILDING STRUCTURES):
CURB (EXTERIOR).....2.0"
SLAB-ON-GRADE.....3.0" BOTTOM (U.N.O)
5. PROVIDE CORNER BARS AT ALL TURNDOWN FOUNDATION CORNERS LAPPED WITH THE HORIZONTAL BARS. CORNER BARS ARE TO MATCH THE HORIZONTAL BARS IN SIZE, GRADE AND SPACING UNLESS OTHERWISE SHOWN.
6. HOOKS AND BENDS SHALL MEET ACI STANDARD UNLESS OTHERWISE INDICATED.
7. SPLICES: CONTINUOUS REINFORCING BARS SHALL BE FURNISHED WITH CLASS 'B' TENSION LAPS SPLICES INCLUDING CORNER BARS, UNLESS NOTED OTHERWISE.
8. MECHANICAL SPLICES SHALL NOT BE PERMITTED UNLESS SHOWN ON THE DRAWINGS OR APPROVED BY THE ENGINEER
9. REINFORCING STEEL FABRICATION AND PLACEMENT SHALL BE IN ACCORDANCE WITH CRSI MANUAL OF STANDARD PRACTICE AND CRSI PLACING REINFORCING BARS (LATEST EDITIONS).
10. SPREAD BARS AROUND SMALL OPENINGS AND SLEEVES IN SLABS AND WALLS WHERE POSSIBLE AND WHERE BAR SPACING WILL NOT EXCEED 1.5 TIMES THE NORMAL SPACING. DISCONTINUE BARS AT LARGE OPENINGS WHERE NECESSARY AND PROVIDE AN AREA OF REINFORCEMENT EQUAL TO THE INTERRUPTED REINFORCEMENT DISTRIBUTING ONE-HALF OF THIS REINFORCEMENT EACH SIDE OF THE OPENING (TENSION LAP SPLICED). HOLES LARGER THAN 12 INCHES IN ANY DIRECTION SHALL HAVE (2) #6 X 4'-0" DIAGONAL BARS IN BOTH FACES AT EACH CORNER
11. ALL REINFORCING SHALL BE HELD SECURELY IN POSITION WITH STANDARD ACCESSORIES IN CONCRETE
12. NO REINFORCING STEEL SHALL BE FIELD BENT WITHOUT THE APPROVAL OF THE STRUCTURAL ENGINEER. FIELD BENDING OF PLAIN REINFORCEMENT, IF PERMITTED, SHALL BE PERFORMED USING AN APPROVED AND APPROPRIATE SIZED PORTABLE HYDRAULIC DEVICE THAT MAKES ACI STANDARD RADIUS BENDS. NO OTHER FIELD BENDING METHOD SHALL BE PERMITTED.
13. WELDING, INCLUDING TACK WELDING, FOR REINFORCING STEEL IS PROHIBITED. WELDING OF REINFORCING STEEL AND HIGH STRENGTH BOLTS, IE. A36, F1554, WILL BE PERMITTED ONLY BY WRITTEN APPROVAL OF THE ENGINEER.
14. ALL OPENINGS THROUGH WALLS, SLABS OR OTHER STRUCTURAL ELEMENTS NOT DETAILED ON THE STRUCTURAL DRAWINGS MUST BE LOCATED BY THE CONTRACTOR AND SHOWN ON THE APPLICABLE REINFORCING STEEL SHOP DRAWINGS. THE FINAL LOCATION OF ALL OPENINGS MUST BE REVIEWED BY THE ENGINEER BEFORE THE CONCRETE IS POURED.
D. FORMWORK
1. SEE SPECIFICATIONS
2. CAMBER: PROVIDE CAMBER TO COMPENSATE FOR DISPLACEMENT OF FORMS (SEE SPECS.) AND TO PROVIDE AS-CAST MEMBER CAMBER AS NOTED ON DRAWINGS.
3. RUSTICATION STRIPS, CHAMFERS, DRIPS, MISC. EMBEDS, ETC. SEE DRAWINGS AND/OR ARCHITECTURAL DRAWINGS.
4. PROVIDE 3/4" CHAMFER AT ALL EXPOSED CORNERS OF SLAB ON GRADE AND CONCRETE CURBS ETC. UNLESS OTHERWISE NOTED.
5. OPENINGS FOR MEP TRADES ARE TO BE INCLUDED IN THE BID. ALL HOLES FOR OTHER TRADES WHICH MUST BE CUT OR FORMED AND WHICH ARE NOT SHOWN ON THE STRUCTURAL DESIGN(S) DRAWINGS SHALL BE SUBMITTED TO THE STRUCTURAL ENGINEER DESIGNER FOR REVIEW AND APPROVAL. ANY STRENGTHENING OR ADDITIONAL REINFORCEMENT REQUIRED SHALL BE FURNISHED BY THE CONTRACTOR WITHOUT ADDITIONAL COST TO THE OWNER.
F. CONCRETE FINISHES: SEE SPECIFICATIONS
1. FORMED SURFACES:
a) EXPOSED TO VIEW: SMOOTH FINISH
b) COVERED OR AS NOTED ON PLANS: AS-CAST
2. FLATWORK:
a) EXPOSED TO VIEW: LIGHT BROOM FINISH PARALLEL WITH DIRECTION OF SLAB SLOPE
G. CURING AND PROTECTION: SEE SPECIFICATIONS.
H. EMBEDDED PIPES OR CONDUIT. MAXIMUM DIAMETER ONE THIRD x SLAB OR WALL THICKNESS, SPACED MINIMUM OF 3 TIMES DIAMETER ON CENTER. ALL EMBEDDED PIPES OR CONDUIT SHALL BE APPROVED BY ENGINEER OF RECORD PRIOR TO INSTALLING.
J. ANY CONSTRUCTION JOINTS IN STRUCTURES WHERE WATERSTOPS ARE USED SHALL BE PROTECTED BY WATERSTOP UNLESS OTHERWISE NOTED. CONTRACTOR SHALL SUBMIT A CONSTRUCTION JOINT LAYOUT PLAN FOR APPROVAL BY THE ENGINEER OF RECORD PRIOR TO CONSTRUCTION.
K. SUBMITTALS
1. CONTRACTOR SHALL BE RESPONSIBLE FOR SUBMITTING THE FOLLOWING DOCUMENTS TO THE ENGINEER OF RECORD:
a) CONCRETE MIX DESIGN
b) CONCRETE REINFORCING DRAWINGS

ISSUED FOR BID - 06/21/2019

CAUTION: IF SHEET IS LESS THAN 34"x22" USE GRAPHIC SCALE

Vertical sidebar containing logos for NAVFAC and Tt, a professional engineer seal for Andrew Todd Cook, and project information including 'STRUCTURAL GENERAL NOTES 1', 'GROUNDWATER TREATMENT PLANT AOP SYSTEM ADDITION', and 'AS-001'.

**STRUCTURAL STEEL**

- A. REFERENCES:**
- AISC STEEL CONSTRUCTION MANUAL, 14TH EDITION
  - AWS D1.1 STRUCTURAL WELDING CODE - STEEL
- B. MATERIALS:**
- GRADE STEEL  
WIDE FLANGES.....ASTM A992, GRADE 50  
CHANNELS, ANGLES, AND PLATES.....ASTM A36  
SHEAR CONNECTOR PLATES.....ASTM A572, GRADE 50  
SQUARE HSS.....ASTM A500, GRADE C, Fy=46 KSI
  - ANCHOR BOLTS: ASTM F1554, GRADE 55, WELDABLE.
  - STRUCTURAL BOLTS: ASTM A325-N
  - WELDS: E70XX ELECTRODES
- C. CONNECTIONS**
- AISC MANUAL STANDARD CONNECTIONS UNLESS NOTED. HIGH-STRENGTH BOLTS: ASTM A325-N 5/8" UNLESS NOTED OTHERWISE. BEARING TYPE INSTALLED IN CONFORMANCE WITH "SPECIFICATIONS FOR STRUCTURAL JOINTS USING ASTM A325 OR A490 BOLTS", RESEARCH COUNCIL ON RIVETED AND BOLTED STRUCTURAL JOINTS, UNLESS NOTED OTHERWISE. STANDARD AISC "USUAL GAGE" DIMENSIONS SHALL BE USED FOR LOCATING HOLES FOR BOLTS, EXPANSION ANCHORS, ETC. IN ALL ANGLES, BEAM FLANGES, ETC.
  - THE ASSEMBLY SURFACE, INCLUDING THOSE ADJACENT TO THE WASHER, SHALL BE FREE OF MILL SCALE, OIL, PAINT OR OTHER COATINGS.
  - ALL HIGH STRENGTH BOLTS SHALL BE TIGHTENED TO A BOLT TENSION NOT LESS THAN THAT SPECIFICATION IN THE AISC MANUAL. FULL TENSIONING SHALL BE BY THE TURN OF NUT METHOD, BY A DIRECT TENSION INDICATOR, OR BY PROPERLY CALIBRATED WRENCHES. PROVIDE HARDENED WASHERS UNDER THE NUT OR BOLT HEAD, WHICHEVER IS THE ELEMENT TURNED IN TIGHTENING.
  - WELDING - PERFORM ALL WELDING IN ACCORDANCE WITH AWS D1.1 CODE, LATEST EDITION, WELDS SHALL BE MADE ONLY BY OPERATORS CERTIFIED BY AWS IN PERFORMING THE TYPE OF WORK INDICATED.
- D. TOLERANCES:** AISC CODE OF STANDARD PRACTICE (LATEST EDITION)
- E. CAMBER:** PROVIDE POSITIVE CAMBER AS NOTED ON DRAWINGS. WHERE NO CAMBER IS NOTED, RESIDUAL MILL CAMBER IS TO BE UPWARDS.
- F. SHOP DRAWINGS**
- SUBMIT ERECTION AND FABRICATION SHOP DRAWINGS. SEE SPECS.
- G. ALL STEEL MEMBERS AND CONNECTIONS ITEMS SHALL BE HOT DIPPED (G90) GALVANIZED**


**COMPONENTS & CLADDING WIND PRESSURES FOR CANOPY**

| FACTORED (ULTIMATE) COMPONENTS & CLADDING WIND PRESSURES (PSF) |                           |              |         |
|--|---------------------------|--------------|---------|
| OPEN BUILDING  |                           |              |         |
| ROOF ZONES   | EFFECTIVE TRIBUTARY AREA* |              |         |
|  | ≤ 9SF                     | 9SF, ≤ 36 SF | > 36 SF |
| NEGATIVE ZONE 1  | -27                       | -27          | -27     |
| NEGATIVE ZONE 2  | -42                       | -42          | -27     |
| NEGATIVE ZONE 3  | -81                       | -42          | -27     |
| POSITIVE ZONE 1  | 29                        | 29           | 29      |
| POSITIVE ZONE 2  | 43                        | 43           | 29      |
| POSITIVE ZONE 3  | 57                        | 43           | 29      |

**NOTES:**

- EDGE DISTANCE 'a' = 3'-0"
- \* EFFECTIVE TRIBUTARY AREA: SPAN LENGTH MULTIPLIED BY AN EFFECTIVE WIDTH THAT NEED NOT BE LESS THAN 1/3 THE SPAN LENGTH
- NEGATIVE VALUE DENOTES PRESSURE ACTING AWAY FROM THE SURFACE
- UNFACTORED (NOMINAL) COMPONENTS AND CLADDING PRESSURES MAY BE OBTAINED BY MULTIPLYING THE VALUES IN THE TABLE BY 0.60


**LOCATION OF WIND PRESSURE ZONES**

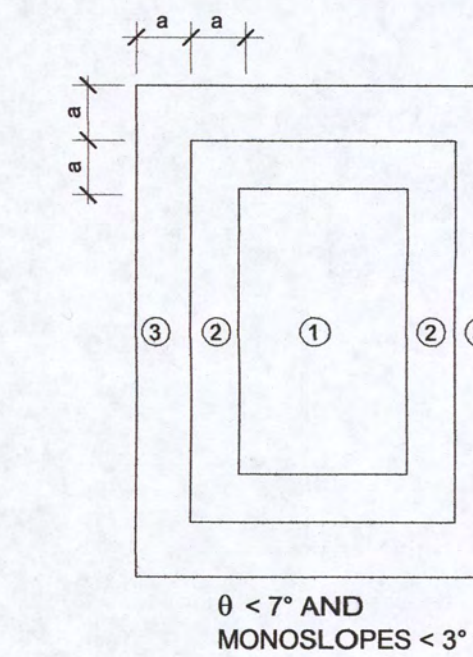

θ < 7° AND MONOSLOPES < 3°

**TENSION DEVELOPMENT / LAP SPLICE SCHEDULE (UNCOATED BARS)**

| BAR SIZE | DEVELOPMENT / LAP SPLICE LENGTH IN CONCRETE (f'c = 4500 PSI) |            |                                  |            |                       |            |           |
|----------|--|------------|----------------------------------|------------|-----------------------|------------|-----------|
|          | DEVELOPMENT LENGTH (IN)                                      |            | CLASS 'B' LAP SPLICE LENGTH (IN) |            | STD 90 DEG. HOOK (IN) |            |           |
|          | BAR TYPE 1   | BAR TYPE 2 | BAR TYPE 1                       | BAR TYPE 2 | EMBED                 | LEG LENGTH | BEND DIA. |
| 4        | 18   | 27         | 24                               | 35         | 7                     | 8          | 3         |
| 5        | 23   | 34         | 30                               | 44         | 9                     | 10         | 3 3/4     |
| 6        | 27   | 41         | 35                               | 53         | 10                    | 12         | 4 1/2     |
| 7        | 40   | 59         | 51                               | 77         | 12                    | 14         | 5 1/4     |
| 8        | 45   | 67         | 59                               | 88         | 14                    | 16         | 6         |
| 9        | 51   | 76         | 66                               | 99         | 15                    | 19         | 9 1/2     |
| 10       | 57   | 86         | 74                               | 111        | 17                    | 22         | 10 3/4    |

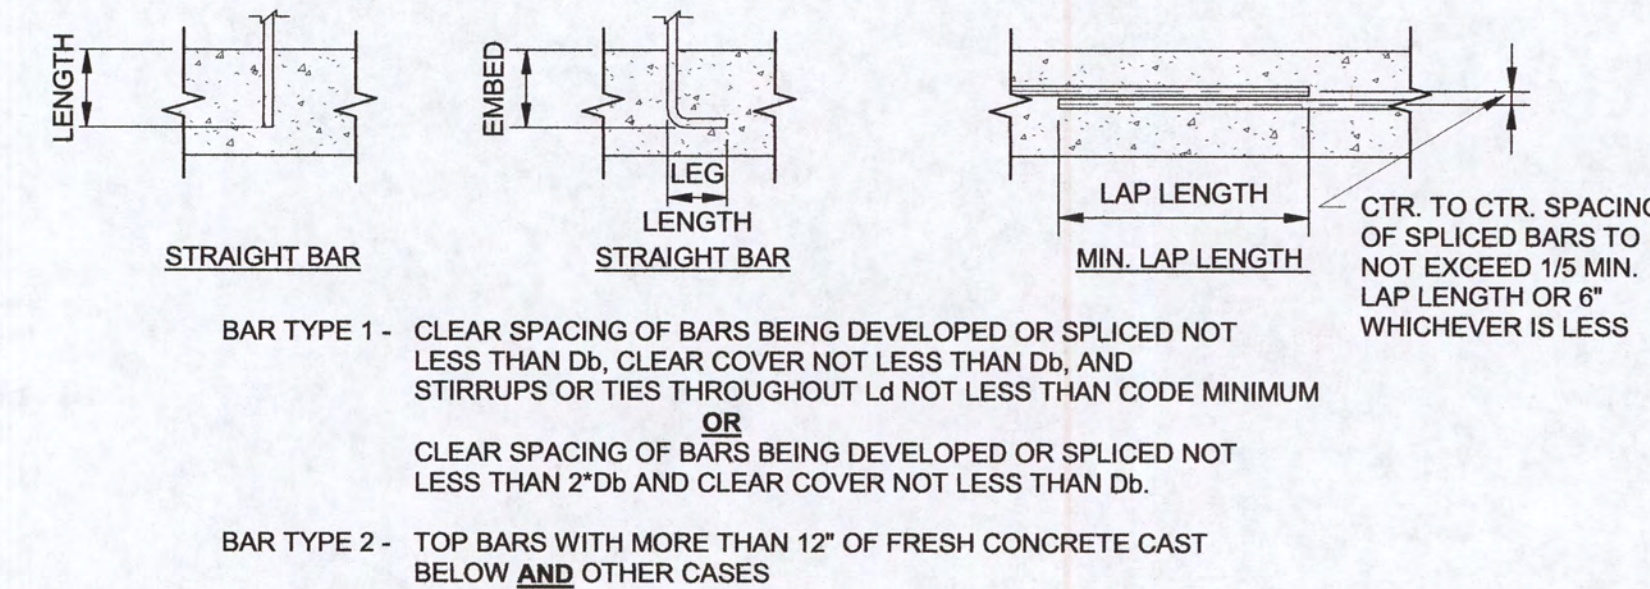

**STEEL DECK**


- A. REFERENCES:**
- SDI DESIGN MANUAL FOR COMPOSITE DECKS, FORM DECKS, AND ROOF DECKS
  - SDI DIAPHRAGM DESIGN MANUAL
- B. MATERIAL:** A653 GRADE A (33,000 PSI MIN.), GALVANIZED (G90).
- C. INSTALLATION:**
- DECK ATTACHMENTS SHALL BE IN ACCORDANCE WITH SDI SPECS AND PLAN NOTES UNLESS NOTED OTHERWISE AND SHALL BE ADEQUATELY SHOWN ON SHOP DRAWING SUBMITTAL.

DATE: APRR  
DESCRIPTION: SW  
SEAL AREA: DES SPS DR SPS  
REVIEWED BY: ATC  
PM/DM: HKM  
CHIEF ENG/ARCH: ATC

DEPARTMENT OF THE NAVY  
NAVAL FACILITIES ENGINEERING COMMAND  
NAVAL FACILITIES ENGINEERING COMMAND ~ MID-ATLANTIC  
NAVAL INDUSTRIAL RESERVE ORDNANCE PLANT  
GM 38  
NAVAL WEAPONS INDUSTRIAL RESERVE PLANT GM-38 AREA BETHPAGE, NEW YORK  
GROUNDWATER TREATMENT PLANT  
AOP SYSTEM ADDITION  
STRUCTURAL GENERAL NOTES II

THIS DRAWING PRODUCED ON AUTOCAD DO NOT REVISE MANUALLY  
SCALE: AS NOTED  
MAXIMO NO. N62470-08-D-1001  
JOB ORDER NO. WE-24  
SPEC. NO. ...  
CONSTR. CONTR. NO. N62472-99-D-0032  
112G08005  
NAVFAC DRAWING NO. ....  
SHEET ..... OF ...  
AS-002


IT IS A VIOLATION OF THE NEW YORK STATE EDUCATION LAW, ARTICLE 145, FOR ANY PERSON, UNLESS UNDER THE DIRECTION OF A NEW YORK STATE LICENSED PROFESSIONAL ENGINEER, TO ALTER AN ITEM ON THIS DOCUMENT IN ANY WAY.

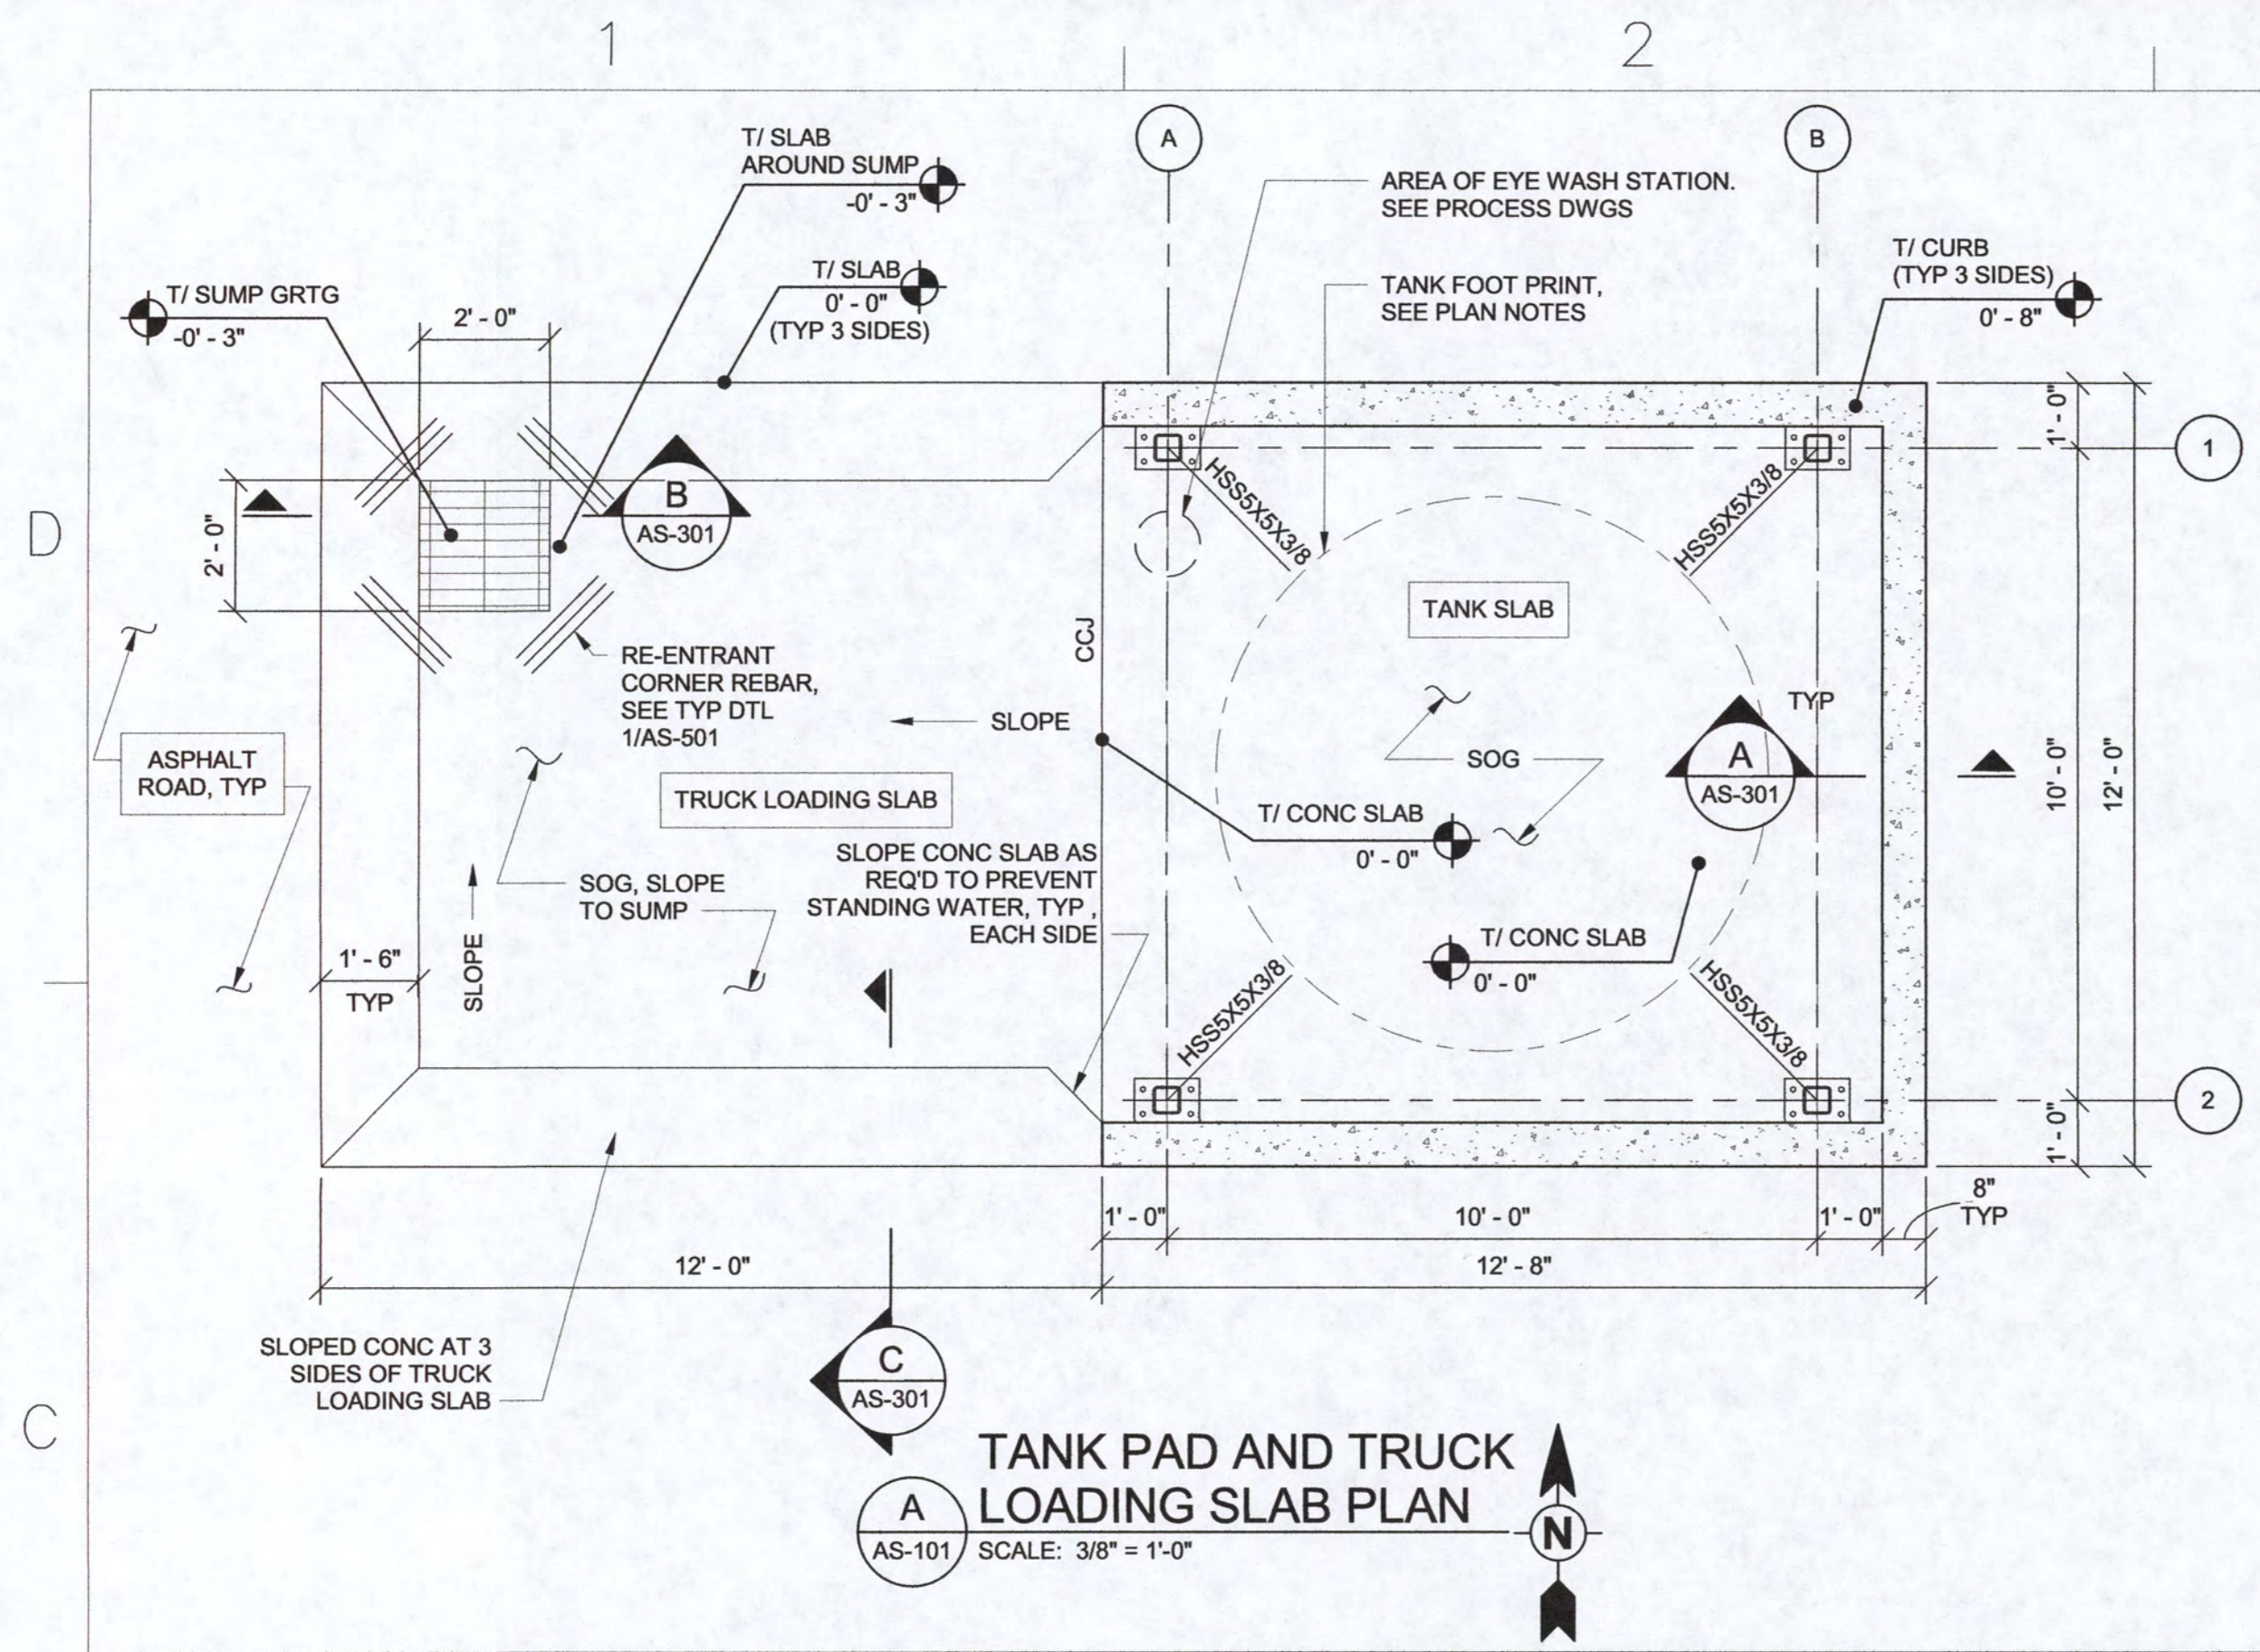

**A TANK PAD AND TRUCK LOADING SLAB PLAN**  
AS-101 SCALE: 3/8" = 1'-0"


- PLAN NOTES:**
- SEE AS-001 AND AS-002 FOR DESIGN CRITERIA AND GENERAL NOTES.
  - SEE AS-501 FOR TYPICAL DETAILS NOT CUT IN PLAN.
  - CONTRACTOR TO COORDINATE SIZE OF PAD AND CANOPY WITH FINAL TANK SELECTION SIZE BEFORE CONSTRUCTION AND FABRICATION OF TANK SLAB AND CANOPY.
  - APPLY CHEMICAL-RESISTANT EPOXY COATING TO ALL EXTERIOR EXPOSED CONCRETE SURFACES. PRODUCT TO BE SPECIFICALLY DESIGNED FOR EXPOSURE TO A 30% HYDROGEN PEROXIDE SOLUTION. CLEAN, PREPARE SURFACE AND INSTALL COATING PER WRITTEN MANUFACTURER'S INSTRUCTIONS.
  - ALL STEEL TO BE (G90) HOT DIPPED GALVANIZED.
  - FRP GRATING TO BE DESIGNED FOR H-20 LOADING.
  - 8.5' DIA BY 9' HIGH TANK. SEE PROCESS DWGS FOR TANK INFO. CONTRACTOR TO INFORM EOR IF FINAL TANK DIAMETER/ HEIGHT VARIES FROM ASSUMED VALUES.

- LEGEND:**
- SOG - DENOTES 8" SLAB ON GRADE REINF W/ #5 @ 12" O.C., E.W., MID-DEPTH.
  - [Grid Symbol] - DENOTES 2" FRP GRATING.
  - CCJ - DENOTES CRACK CONTROL JOINT, SEE TYPICAL DETAILS

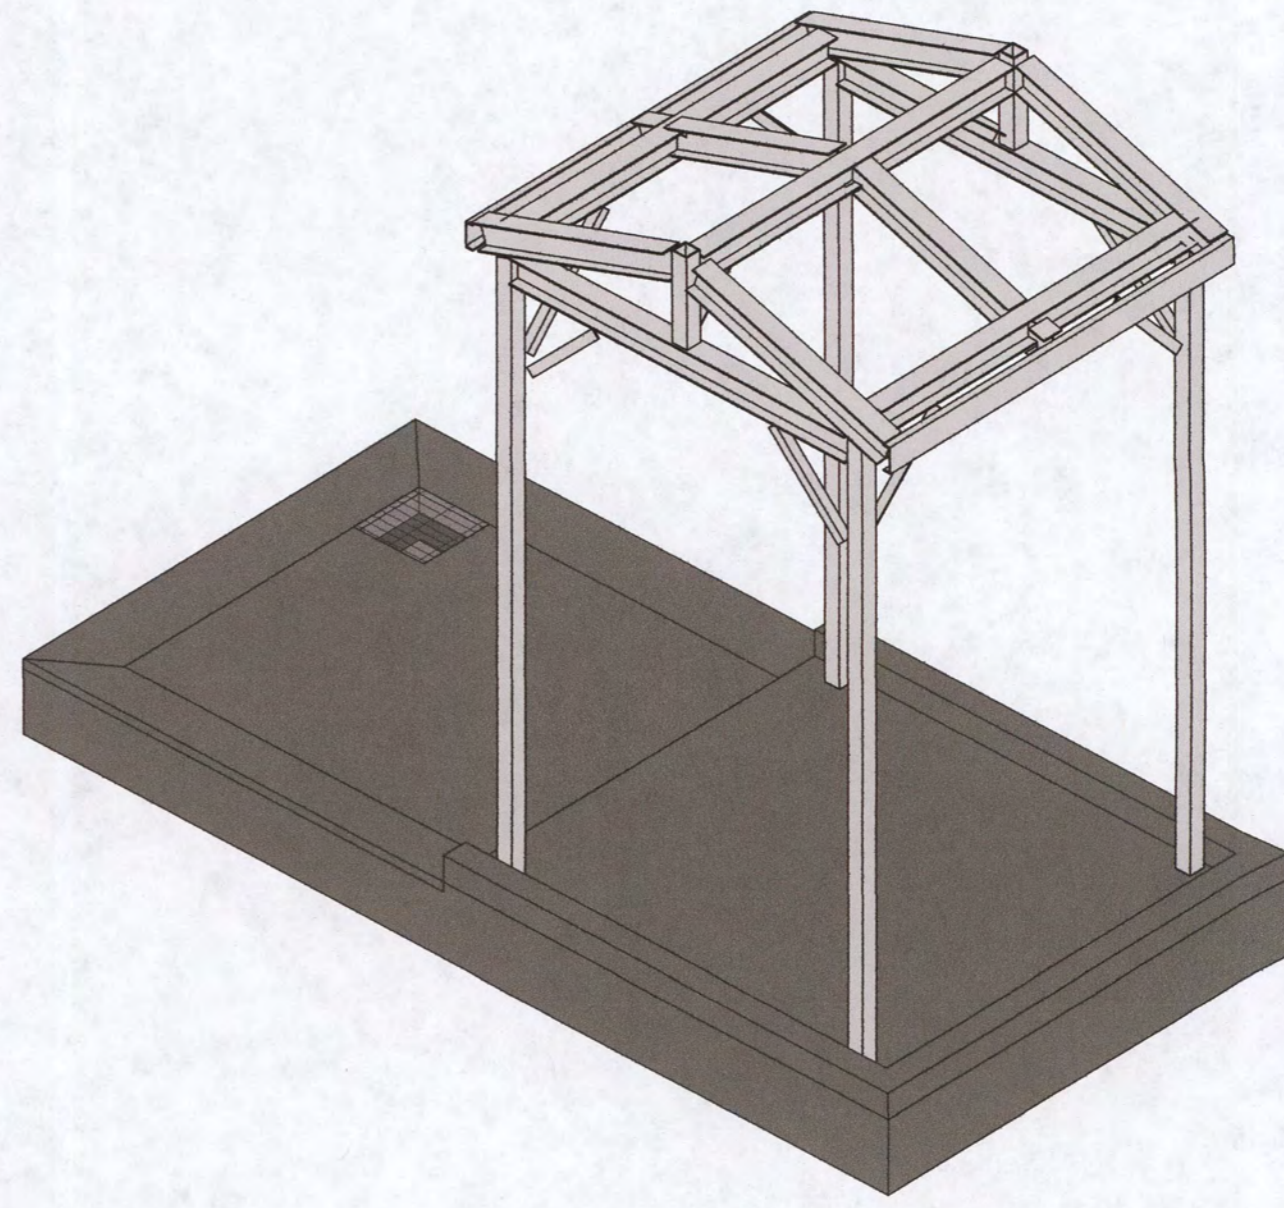


**B OVERALL 3-D VIEW**  
AS-101 SCALE: N/A

- PLAN NOTES:**
- SEE AS-001 AND AS-002 FOR DESIGN CRITERIA AND GENERAL NOTES.
  - SEE AS-501 FOR TYPICAL DETAILS NOT CUT IN PLAN.
  - CONTRACTOR TO COORDINATE SIZE OF CANOPY WITH FINAL TANK SELECTION SIZE BEFORE CONSTRUCTION AND FABRICATION.
  - ALL STEEL TO BE (G90) HOT DIPPED GALVANIZED.
- LEGEND:**
- D-1 - DENOTES SPAN OF 1 1/2" TYPE B 20 GAUGE GALV ROOF DECK SECURED HILTI X-HSN24 POWDER ACTUATED FASTNER AT 36" PATTERN AND 6" O.C AROUND THE PERIMETER. S-SLC 01 M HWH SIDELAP CONNECTORS AT 9" O.C.

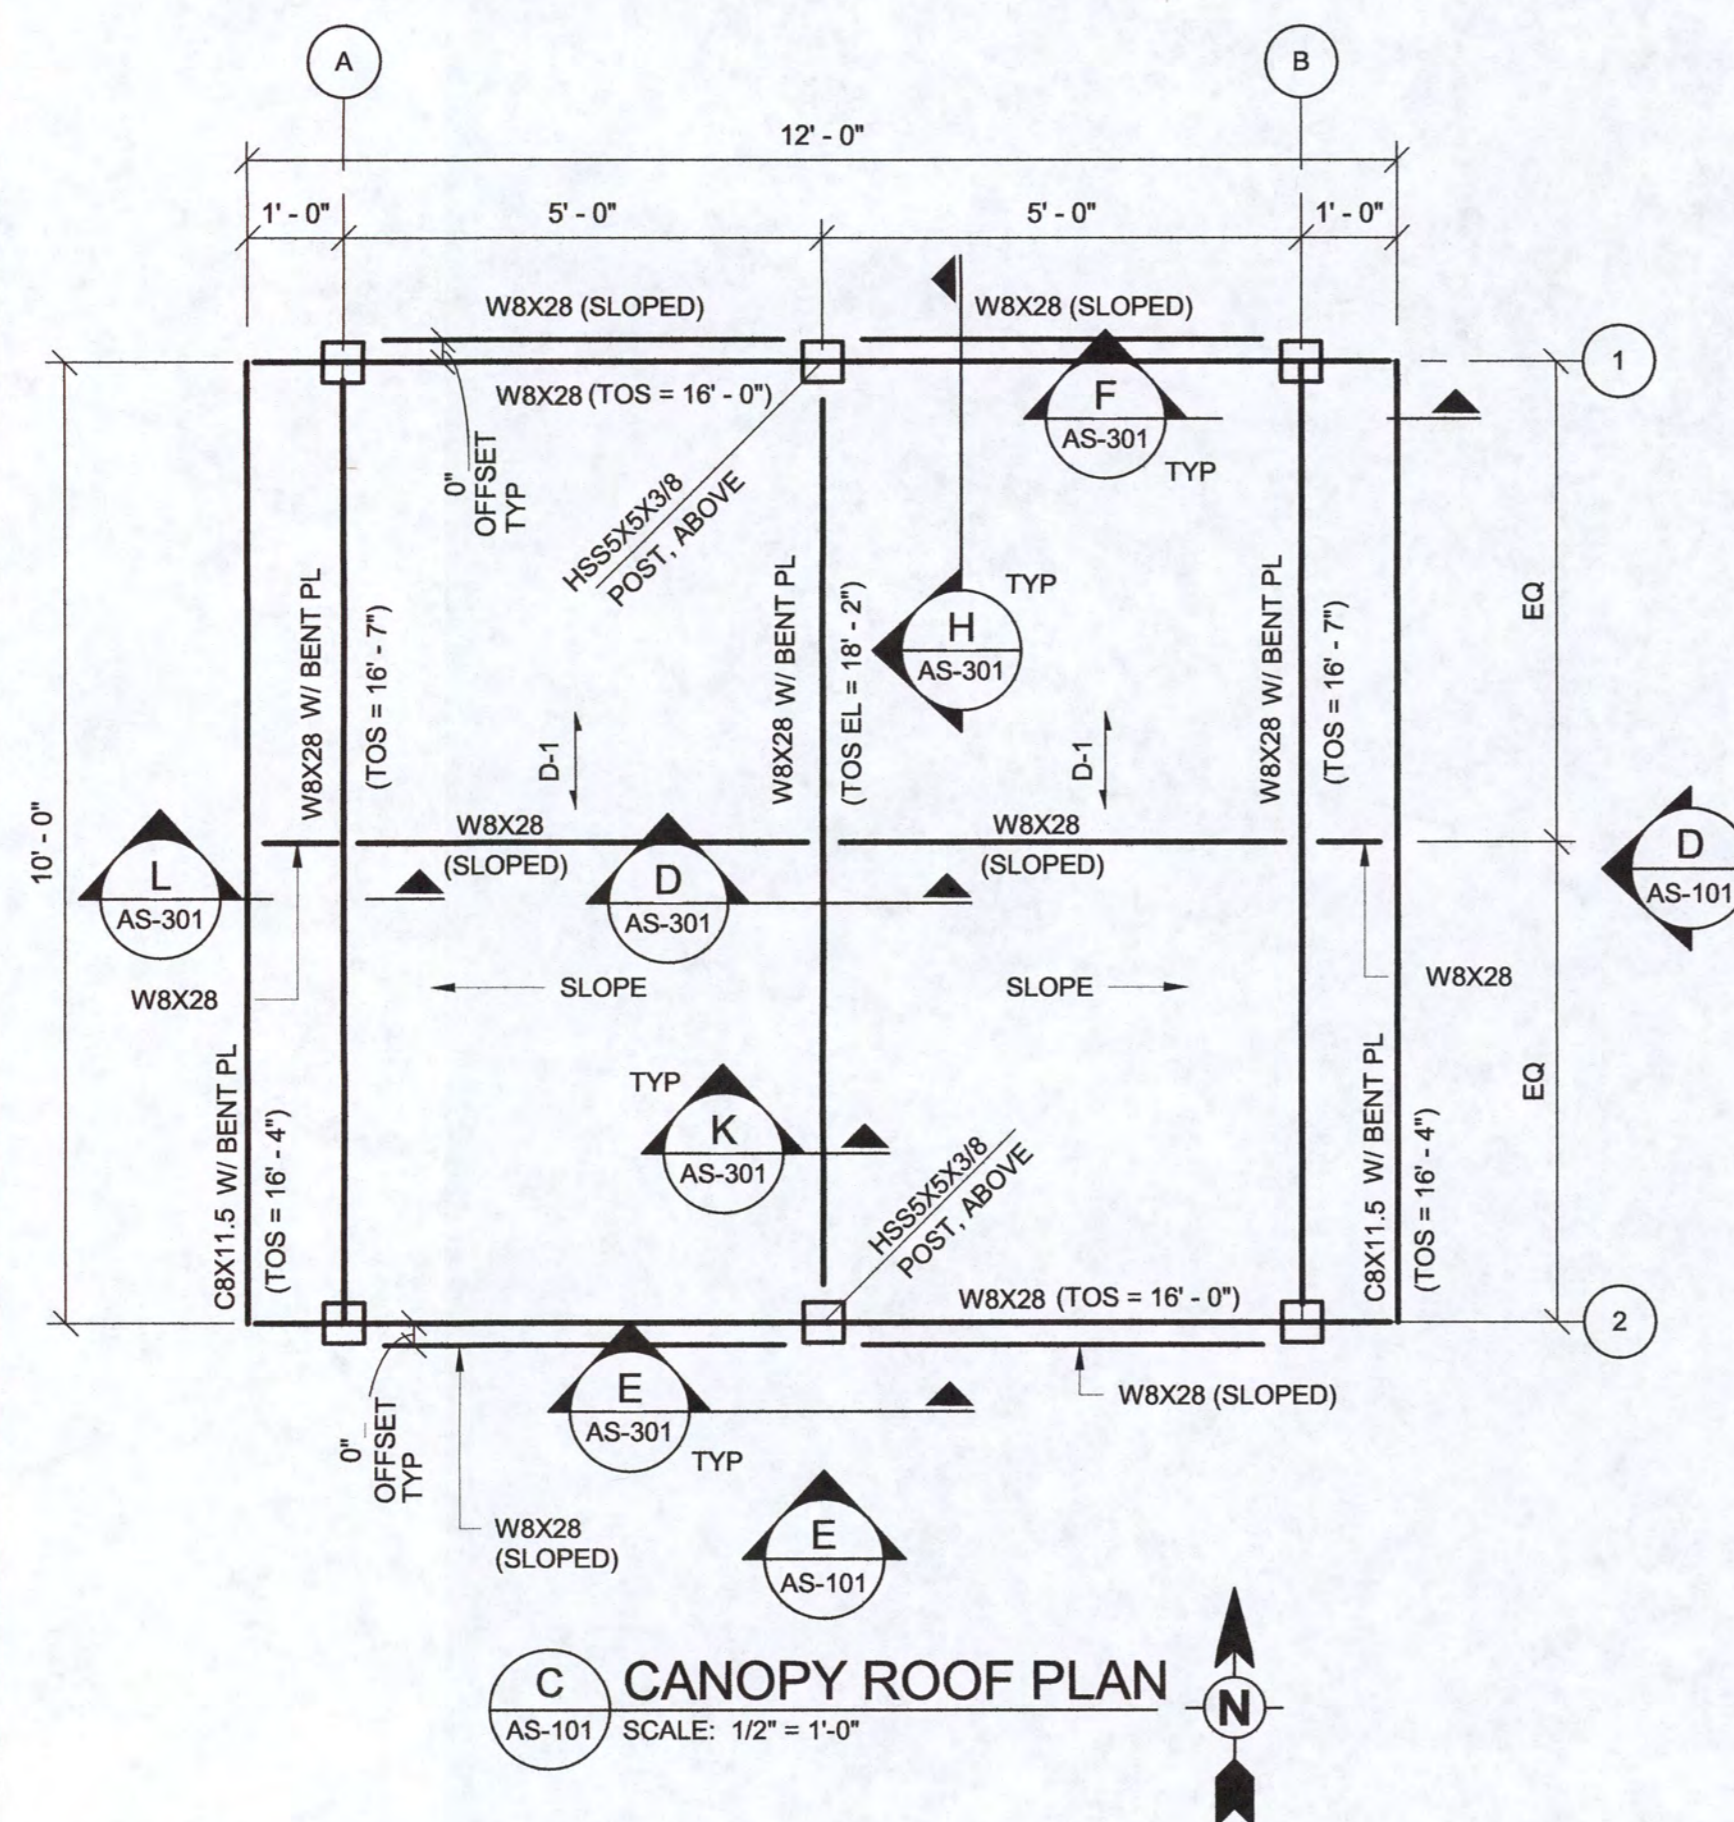


**C CANOPY ROOF PLAN**  
AS-101 SCALE: 1/2" = 1'-0"

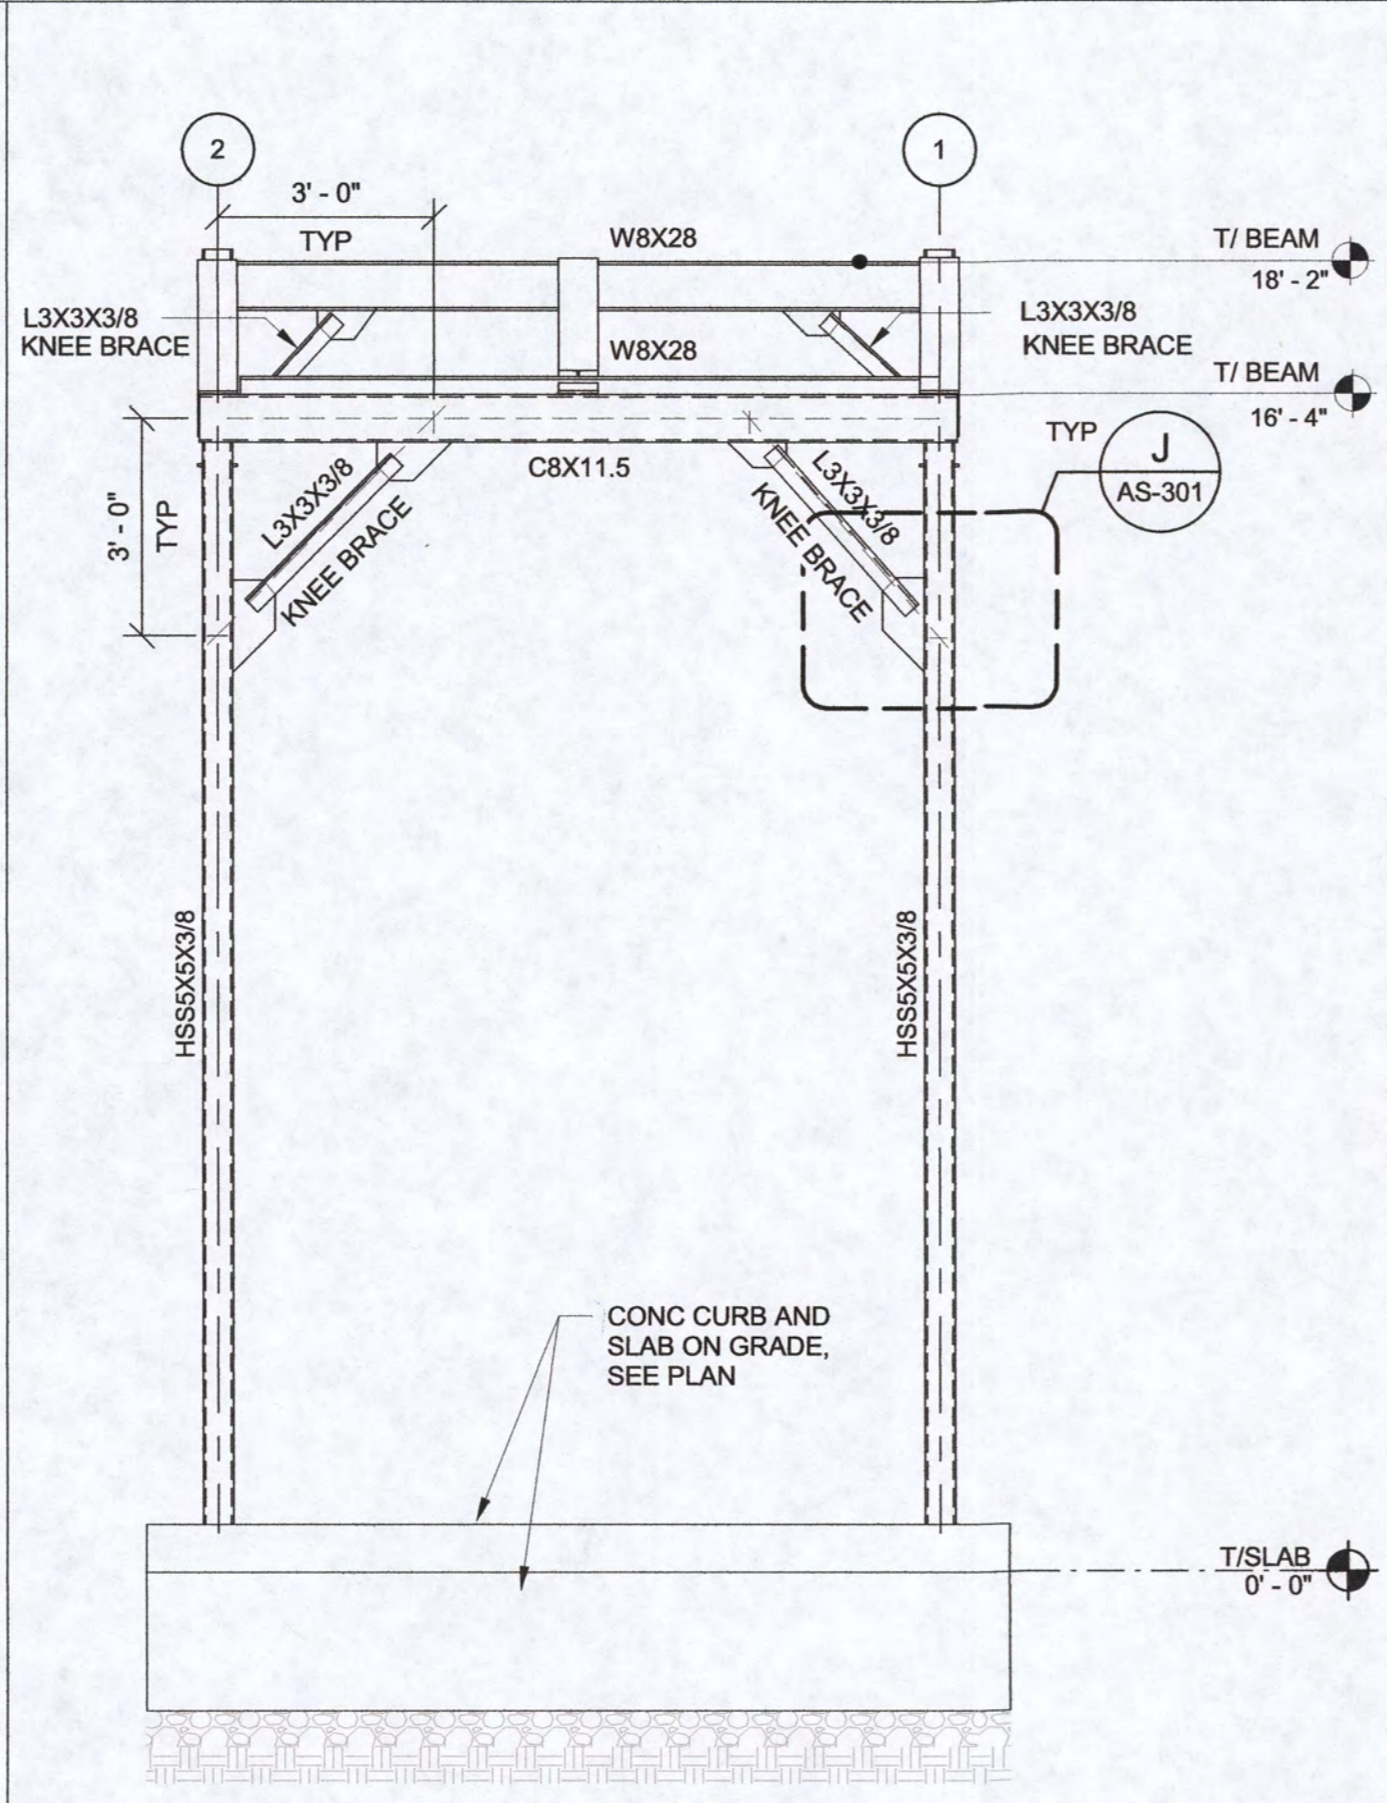


**D ELEVATION**  
AS-101 SCALE: 3/8" = 1'-0"

- NOTES:**
- ROOF DECK NOT SHOWN FOR CLARITY

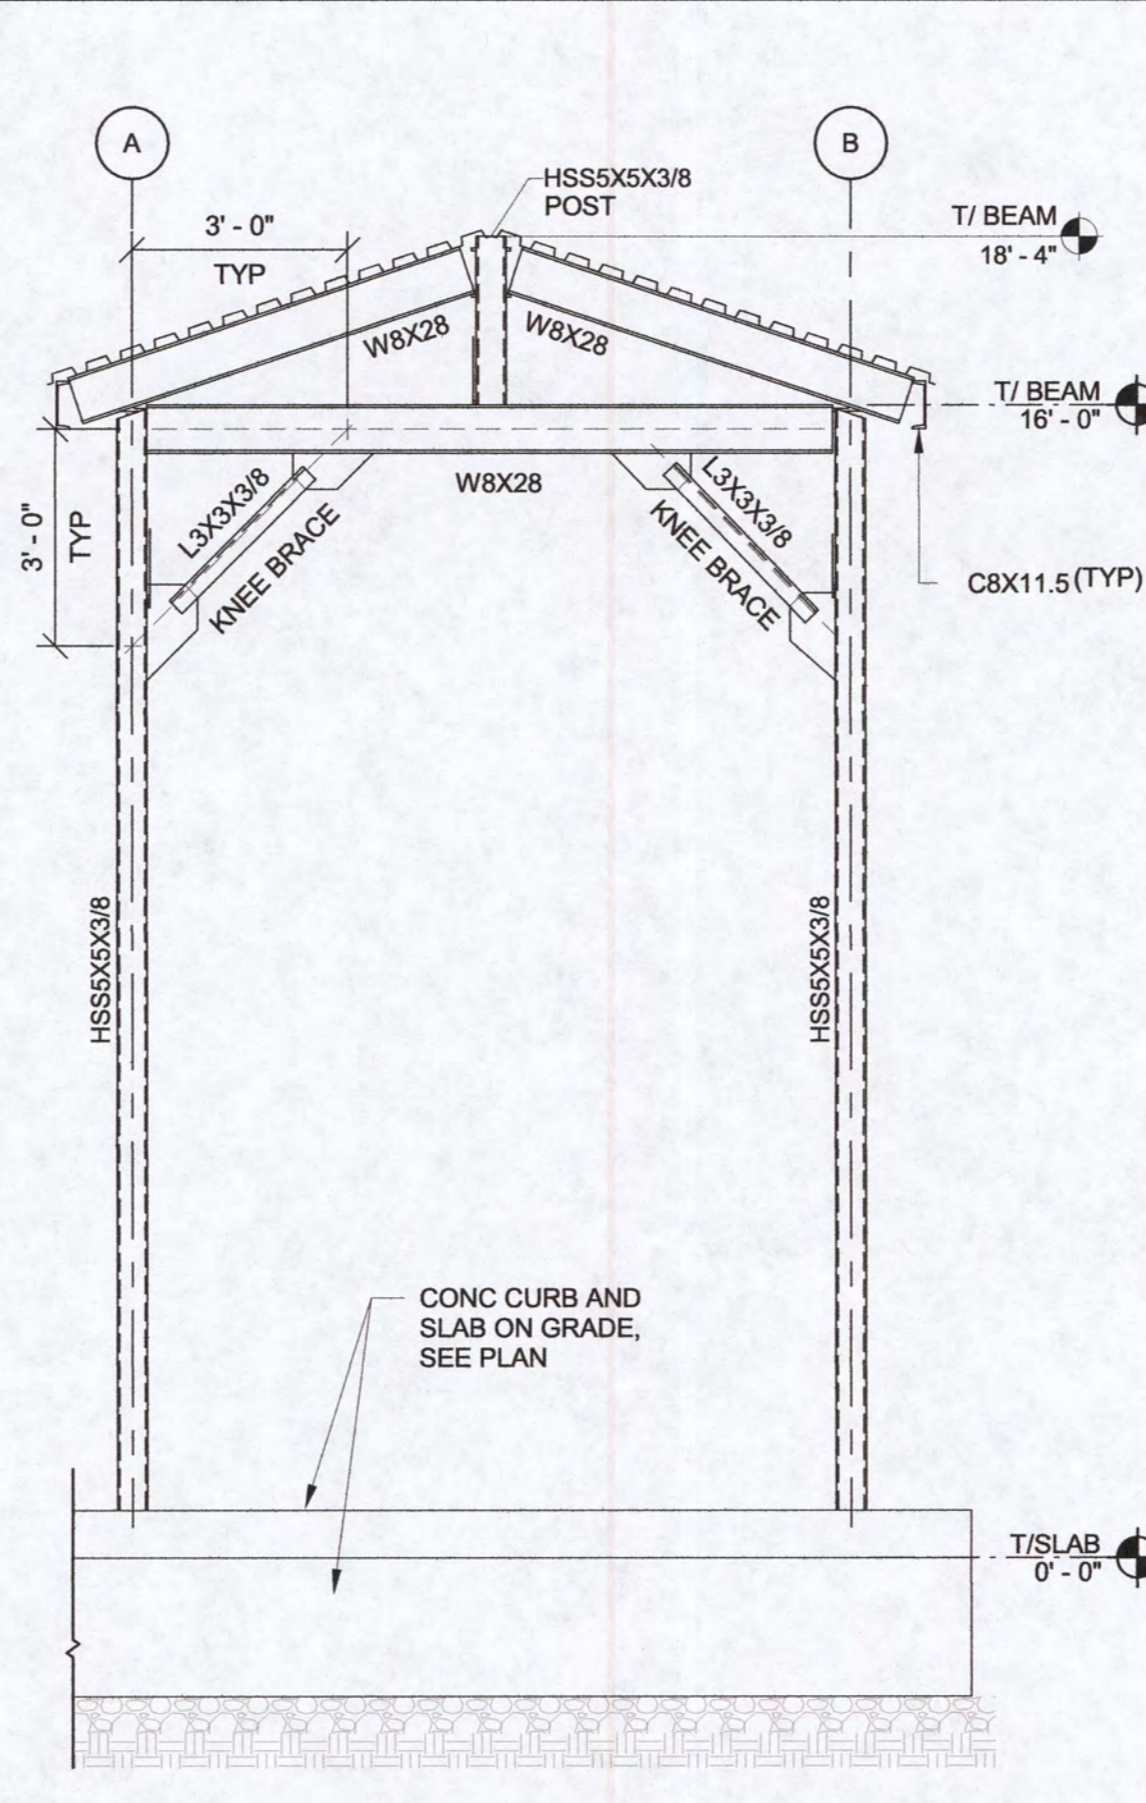

**E ELEVATION**  
AS-101 SCALE: 3/8" = 1'-0"

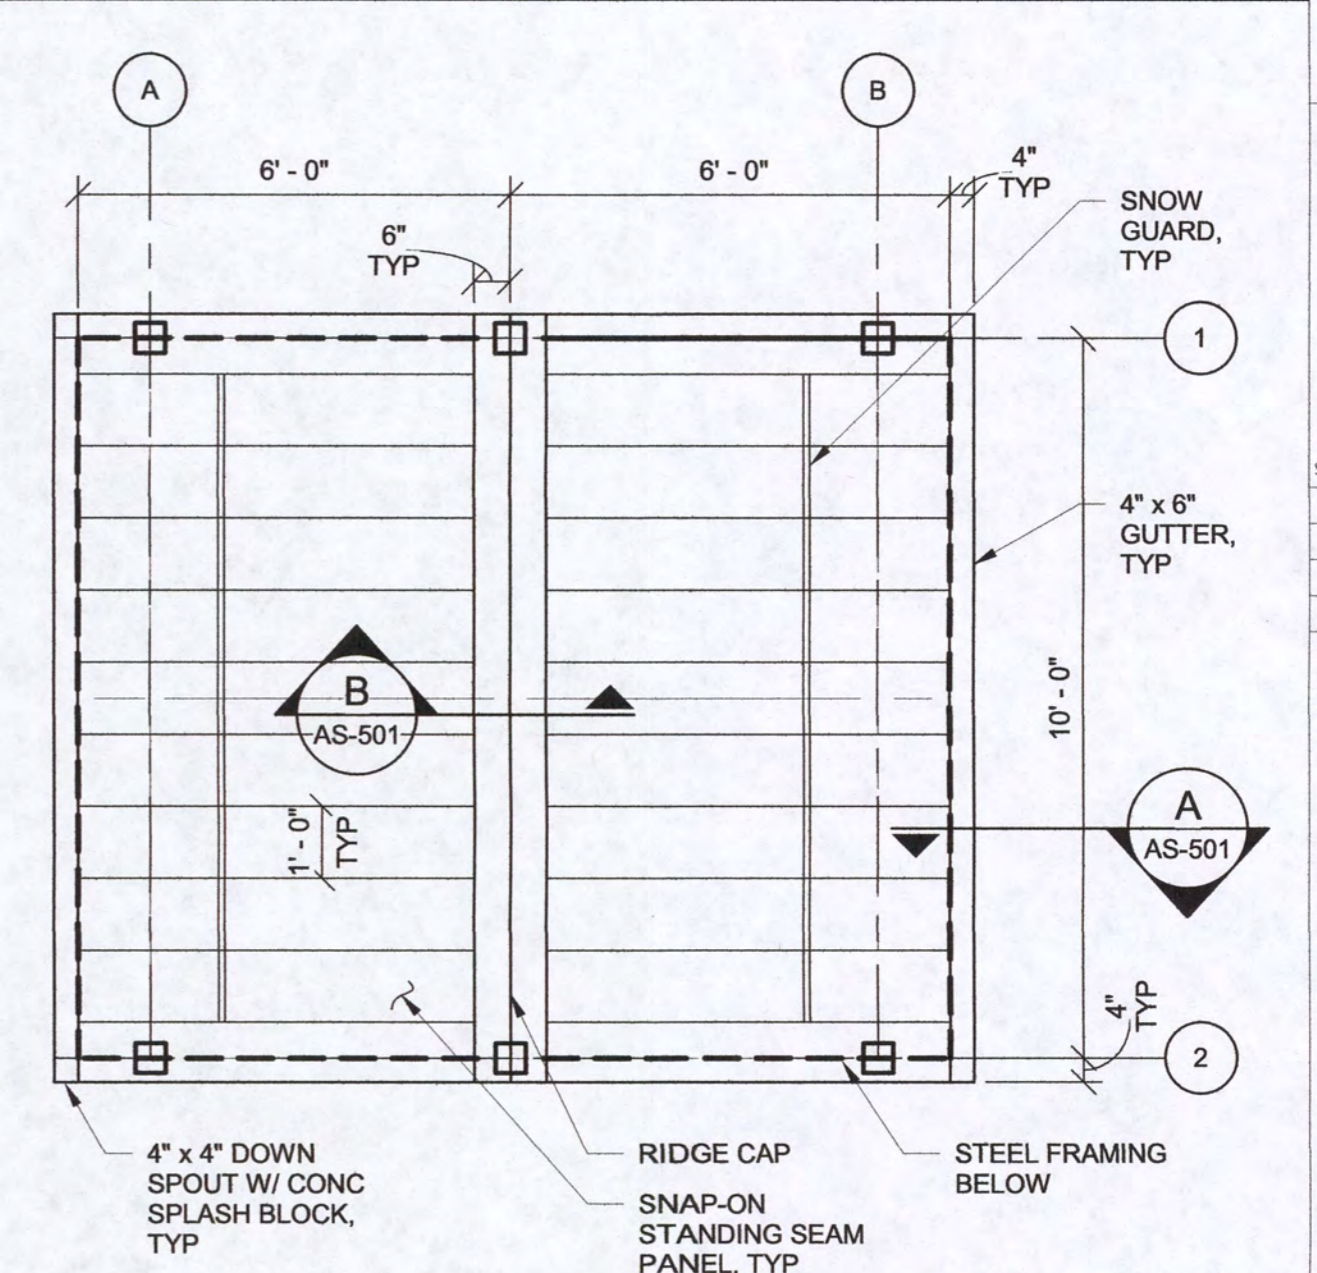













**F ARCH ROOF PLAN**  
AS-101 SCALE: 3/8" = 1'-0"

**KEY PLAN**

THIS DRAWING PRODUCED ON AUTOCAD DO NOT REUSE MANUALLY

SCALE: 1/2" = 1'-0"  
SCALE: 3/8" = 1'-0"

|  |                |
|--|----------------|
| DATE   | APPR           |
| DESCRIPTION  | STM            |
|  |                |
|  |                |
|  |                |
| SEAL AREA  | DES SPS DR SPS |
| REVIEWED BY  | ATC            |
| PM/DM  | HKM            |
| CHIEF ENG/ARCH   | ATC            |
| NAVAL FACILITIES ENGINEERING COMMAND<br>NAVAL FACILITIES ENGINEERING COMMAND - MID-ATLANTIC<br>NAVAL INDUSTRIAL RESERVE ORDNANCE PLANT<br>GROUNDWATER TREATMENT PLANT<br>AOP SYSTEM ADDITION<br>BETHPAGE, NEW YORK<br>GM-38 AREA |                |
| STRUCTURAL FDN AND ROOF PLAN   |                |
| CODE NO. 80091   | SIZE 0         |
| SCALE:   | AS NOTED       |
| MAXIMO NO. N62470-08-D-1001  |                |
| JOB ORDER NO. WE-24  |                |
| SPEC. NO.  |                |
| CONSTR. CONTR. NO. N62470-99-D-0032  |                |
| NAVFAC DRAWING NO.   | 112G08005      |
| SHEET  | OF             |
| ISSUED FOR BID - 06/21/2019<br>CAUTION: IF SHEET IS LESS THAN 34"x22" USE GRAPHIC SCALE  |                |
| IT IS A VIOLATION OF THE NEW YORK STATE EDUCATION LAW, ARTICLE 145, FOR ANY PERSON, UNLESS UNDER THE DIRECTION OF A NEW YORK STATE LICENSED PROFESSIONAL ENGINEER, TO ALTER AN ITEM ON THIS DOCUMENT IN ANY WAY.                 |                |
| AS-101   |                |

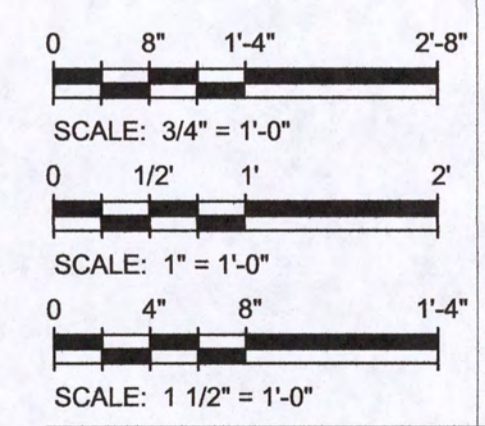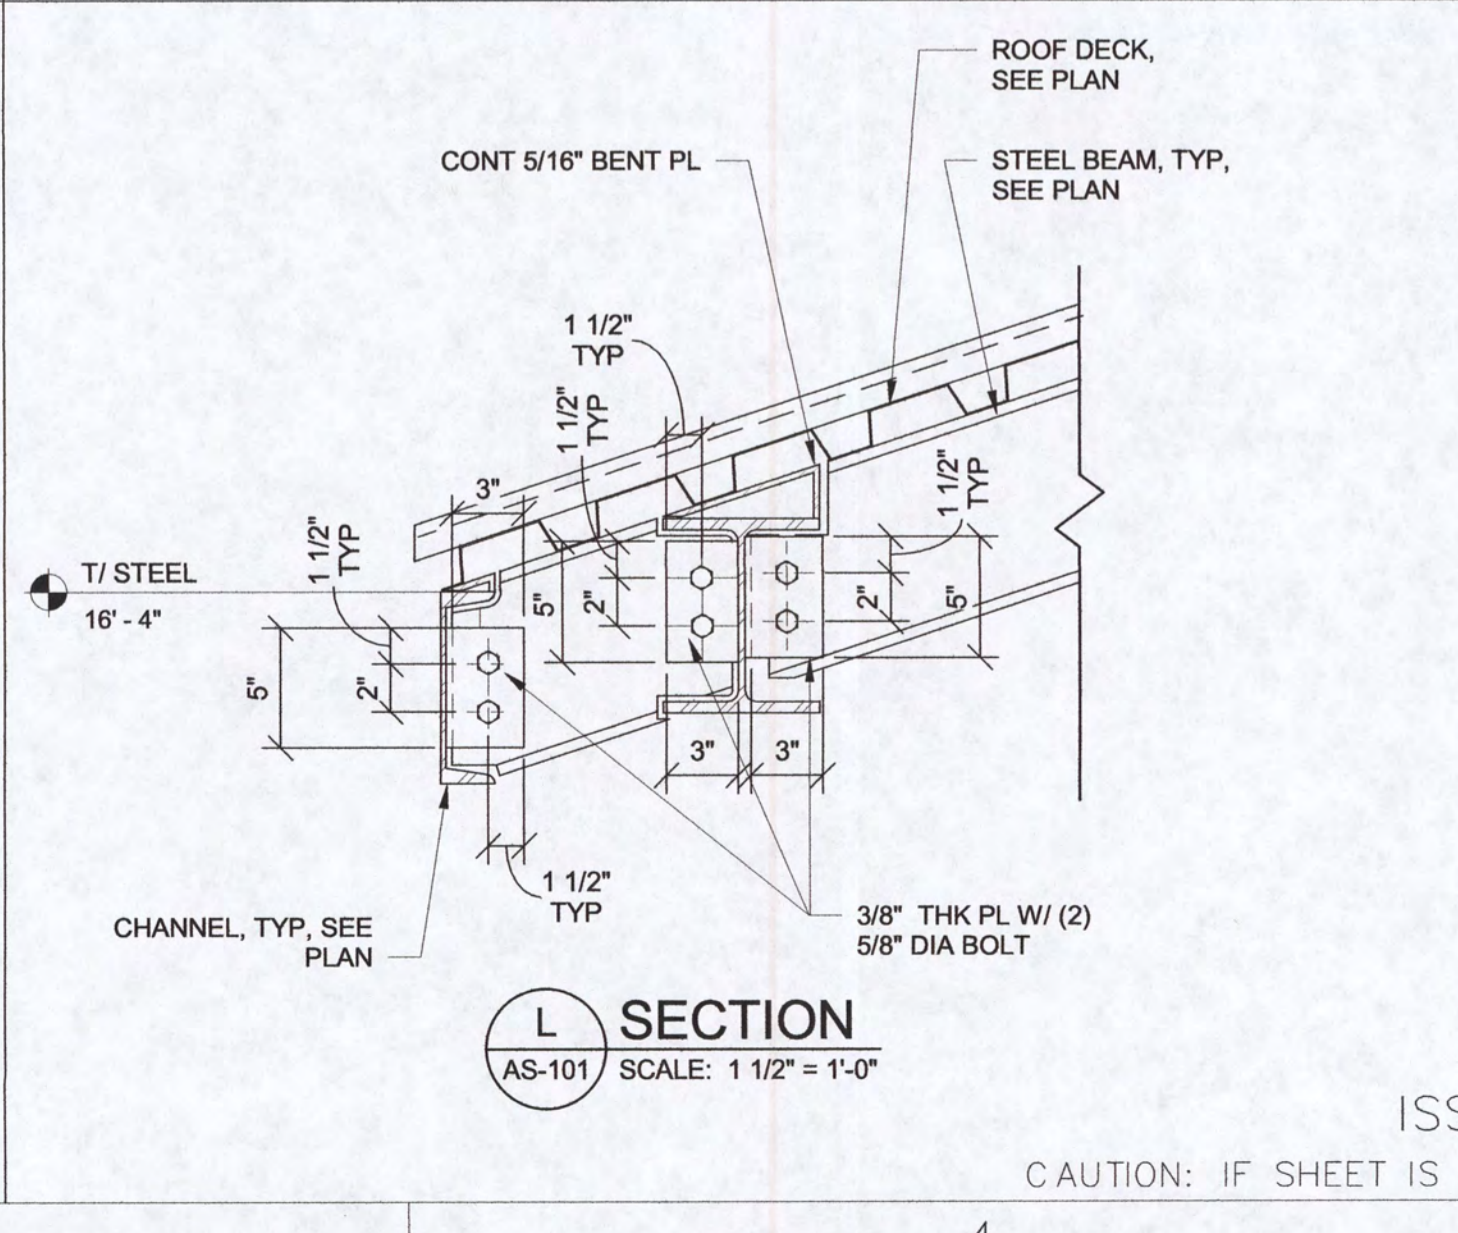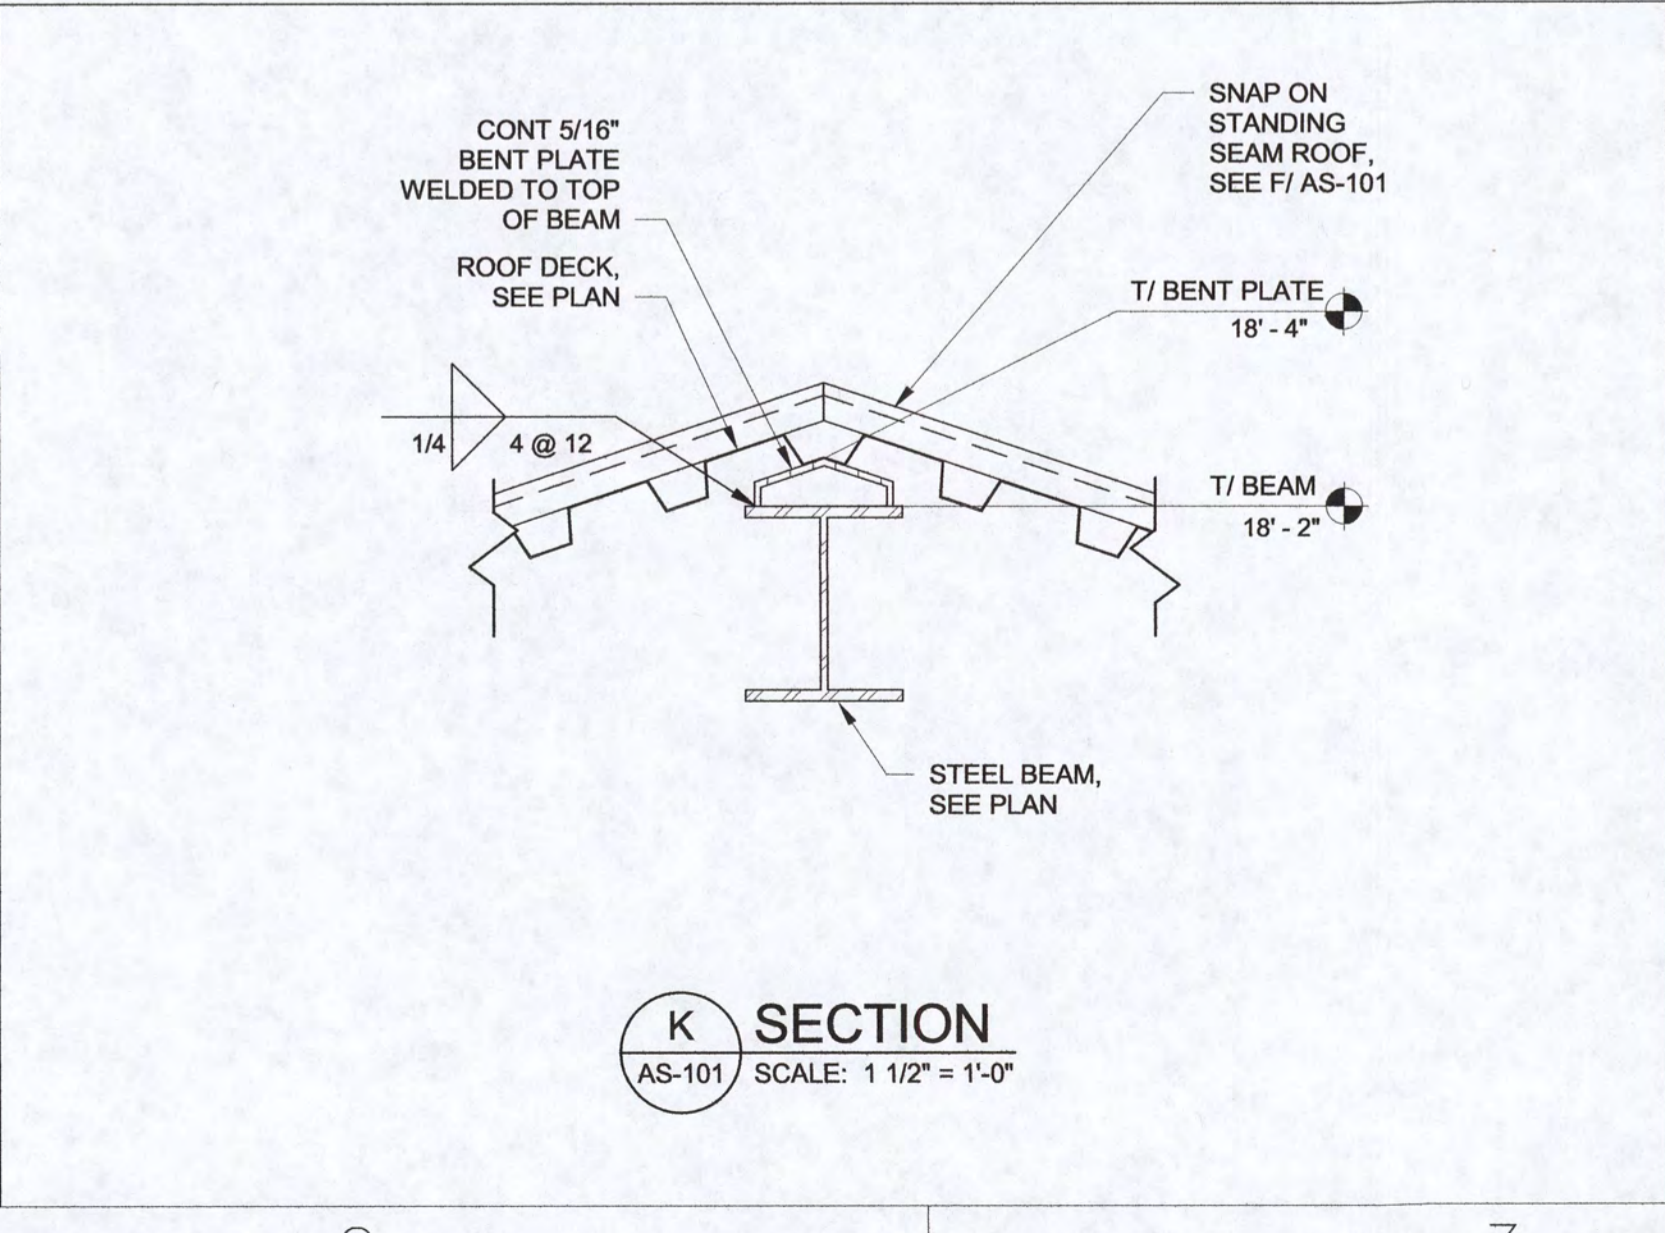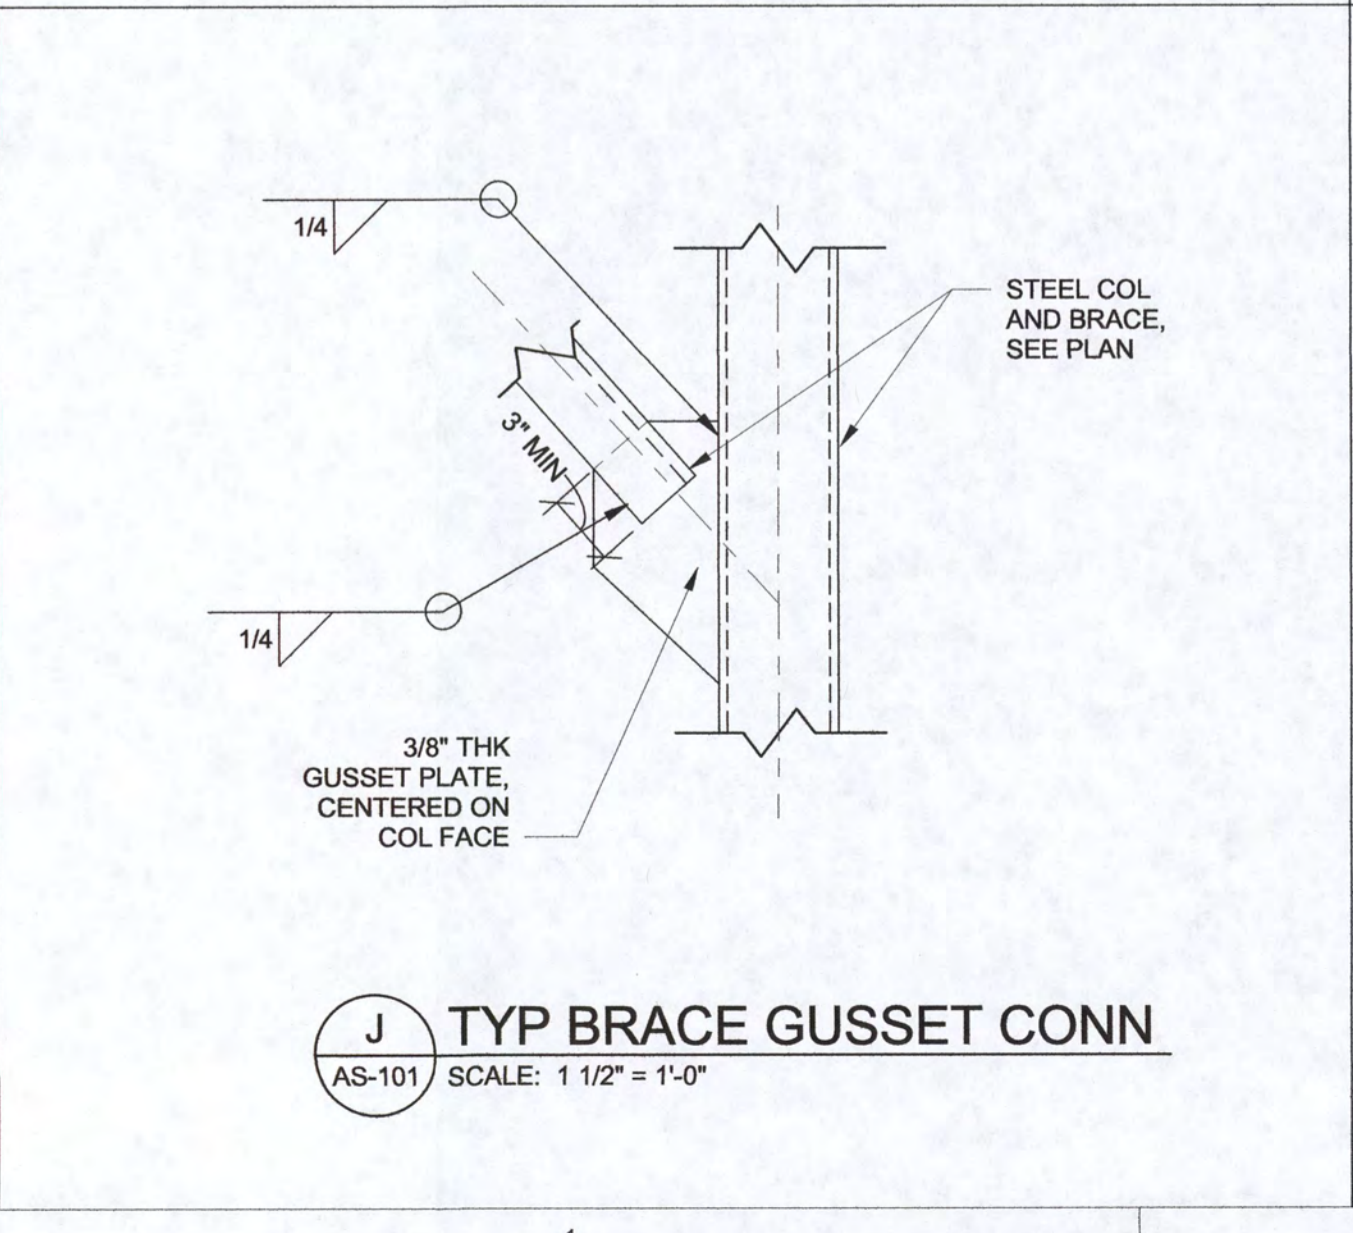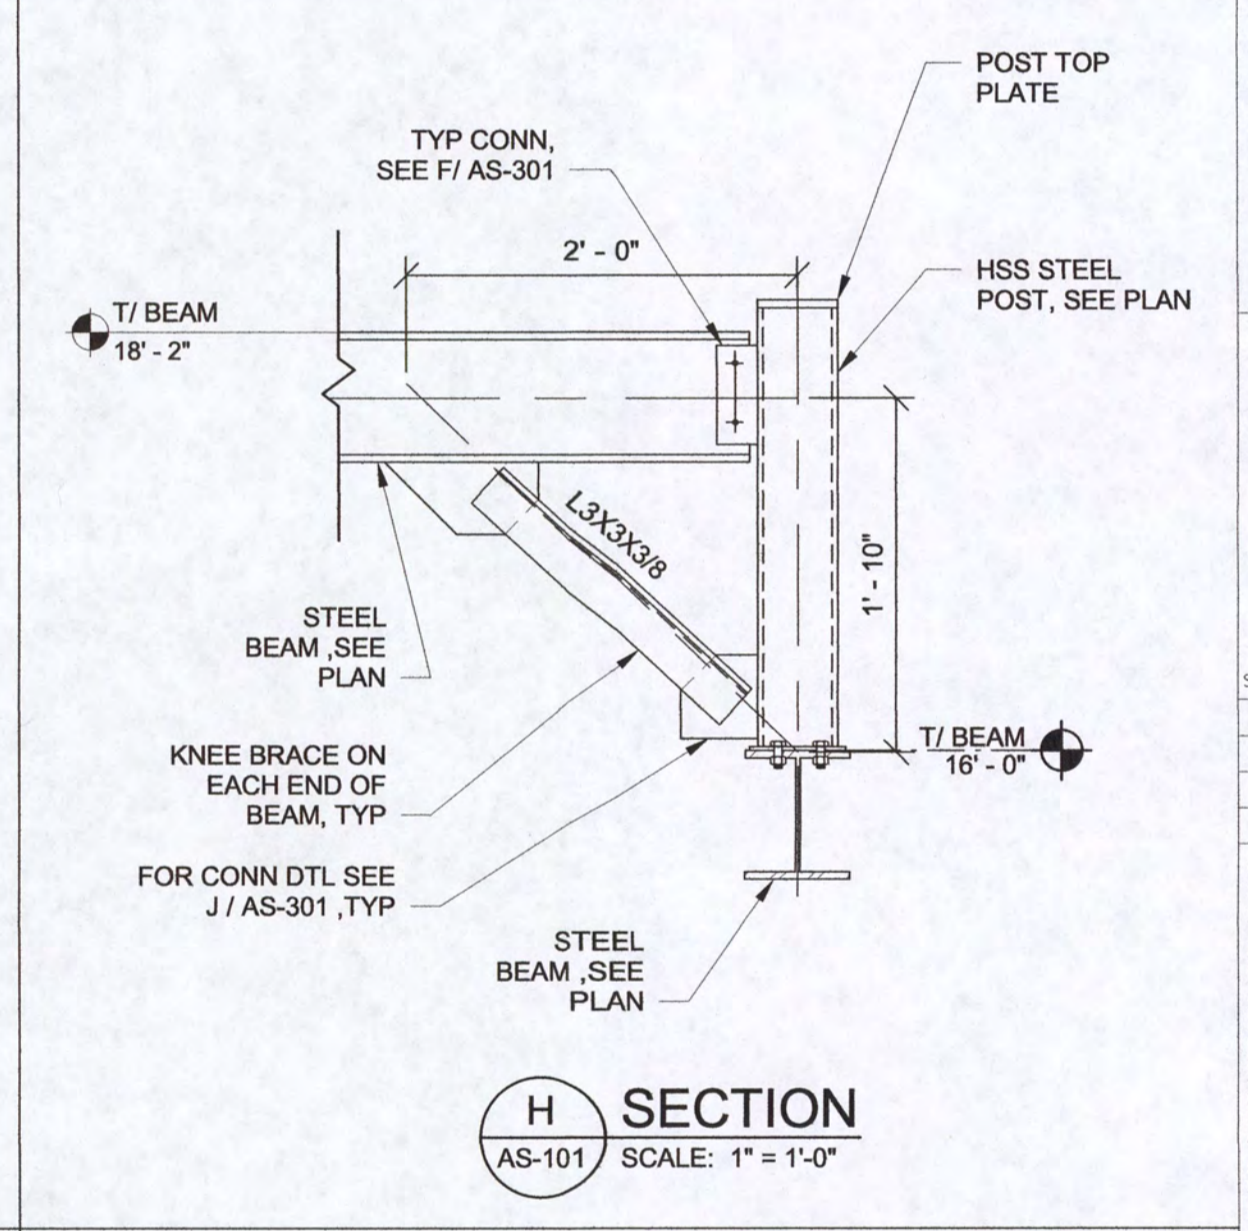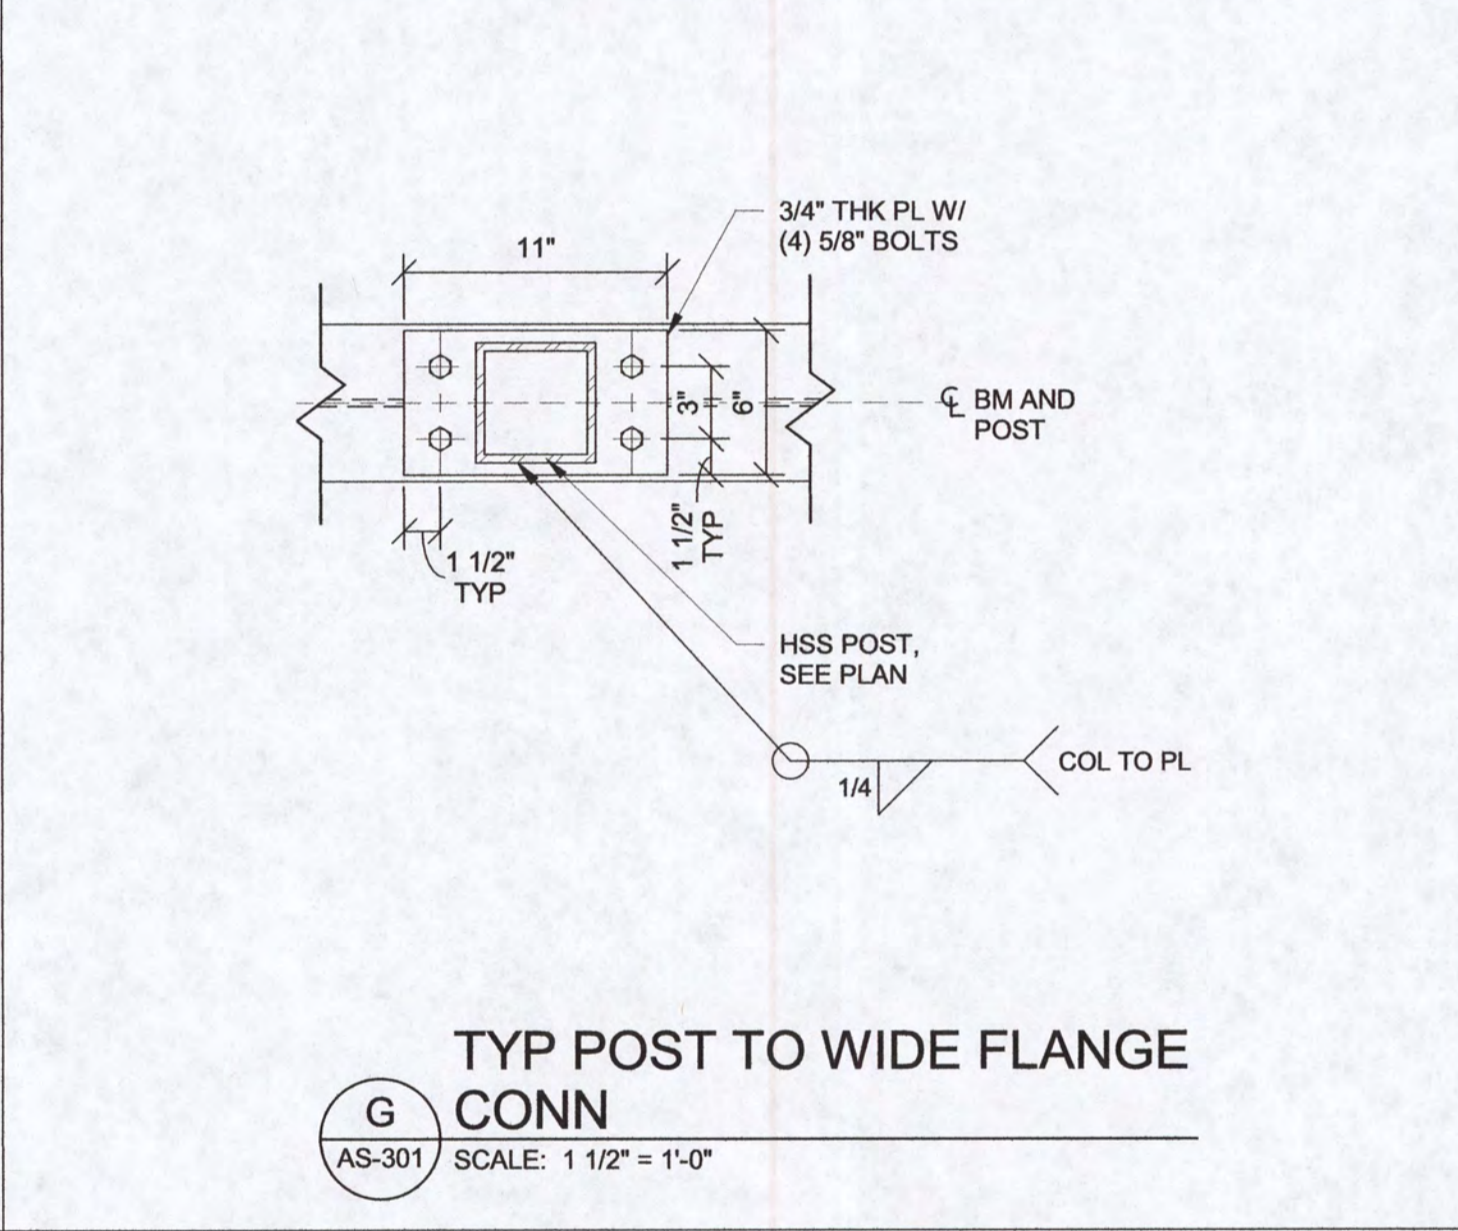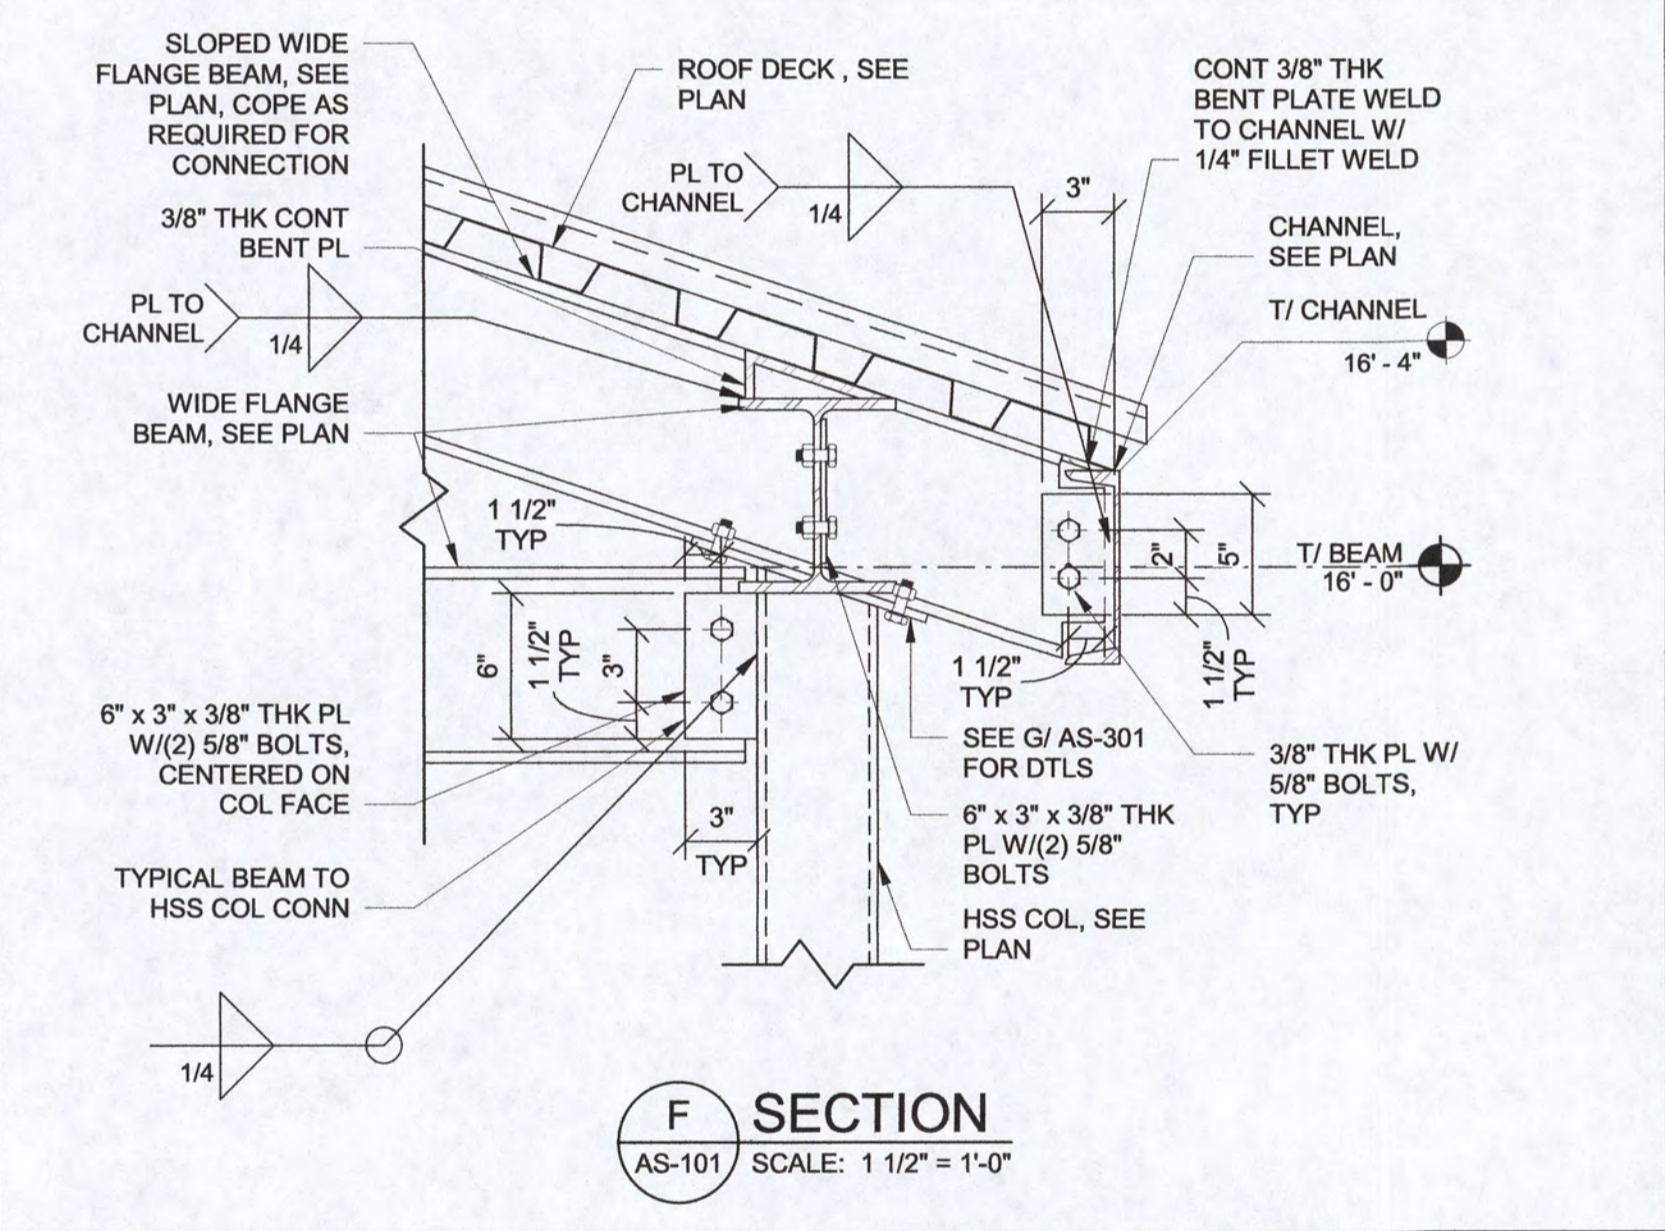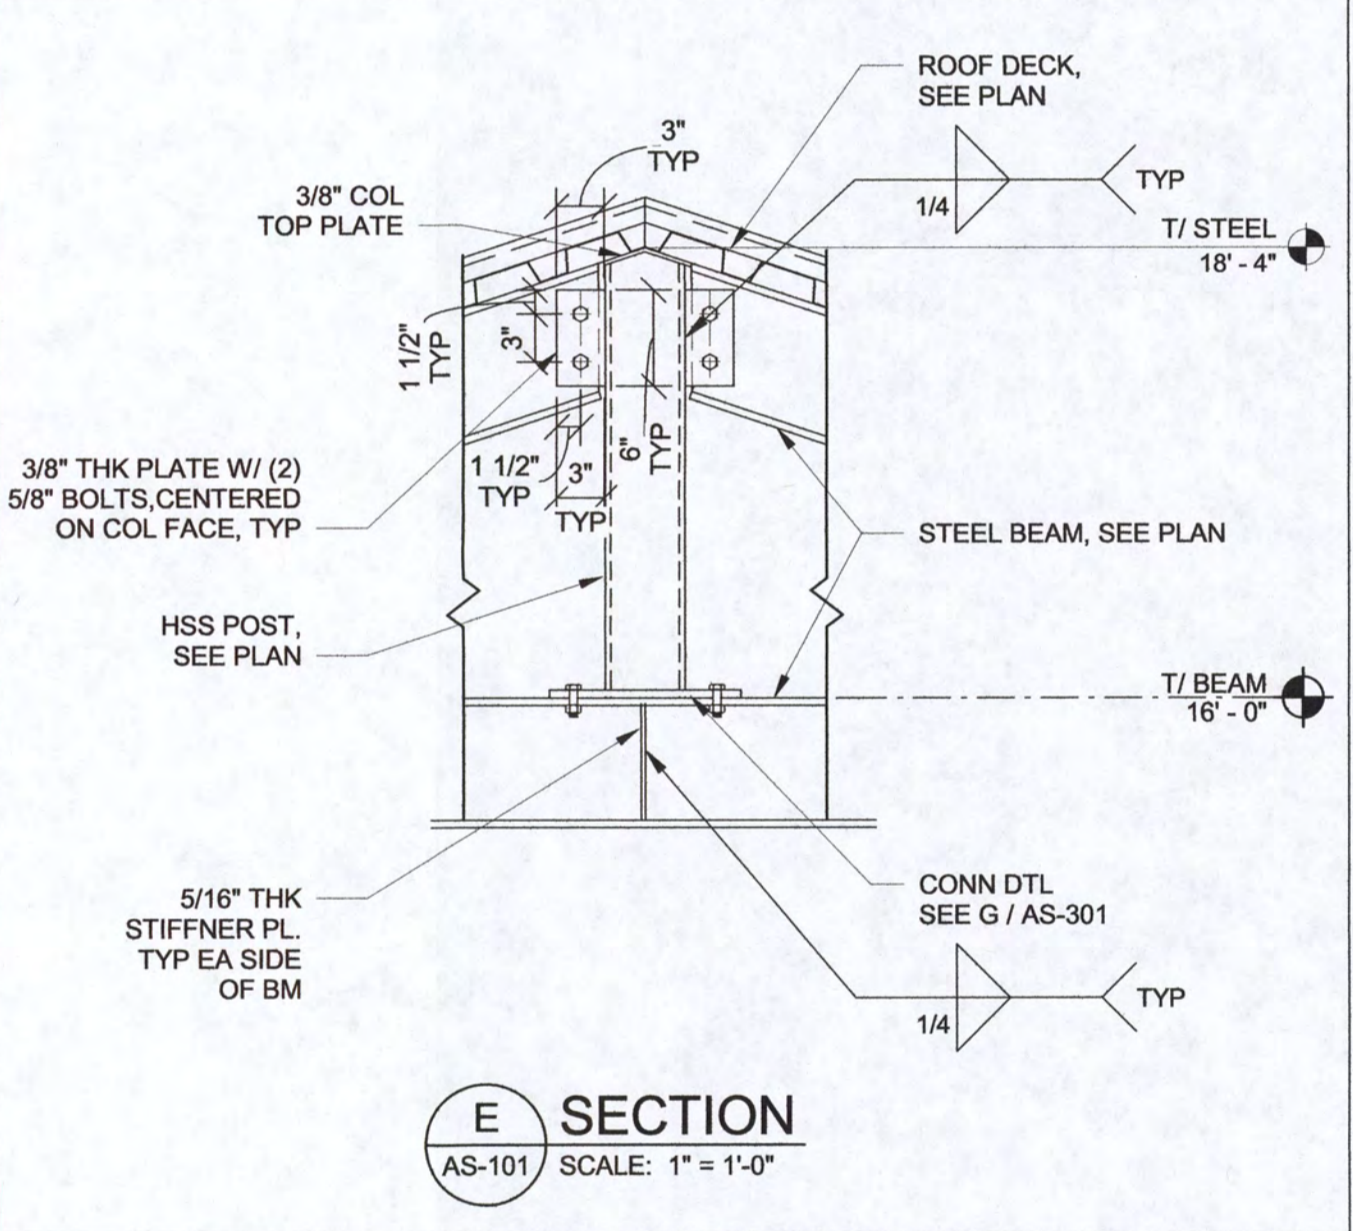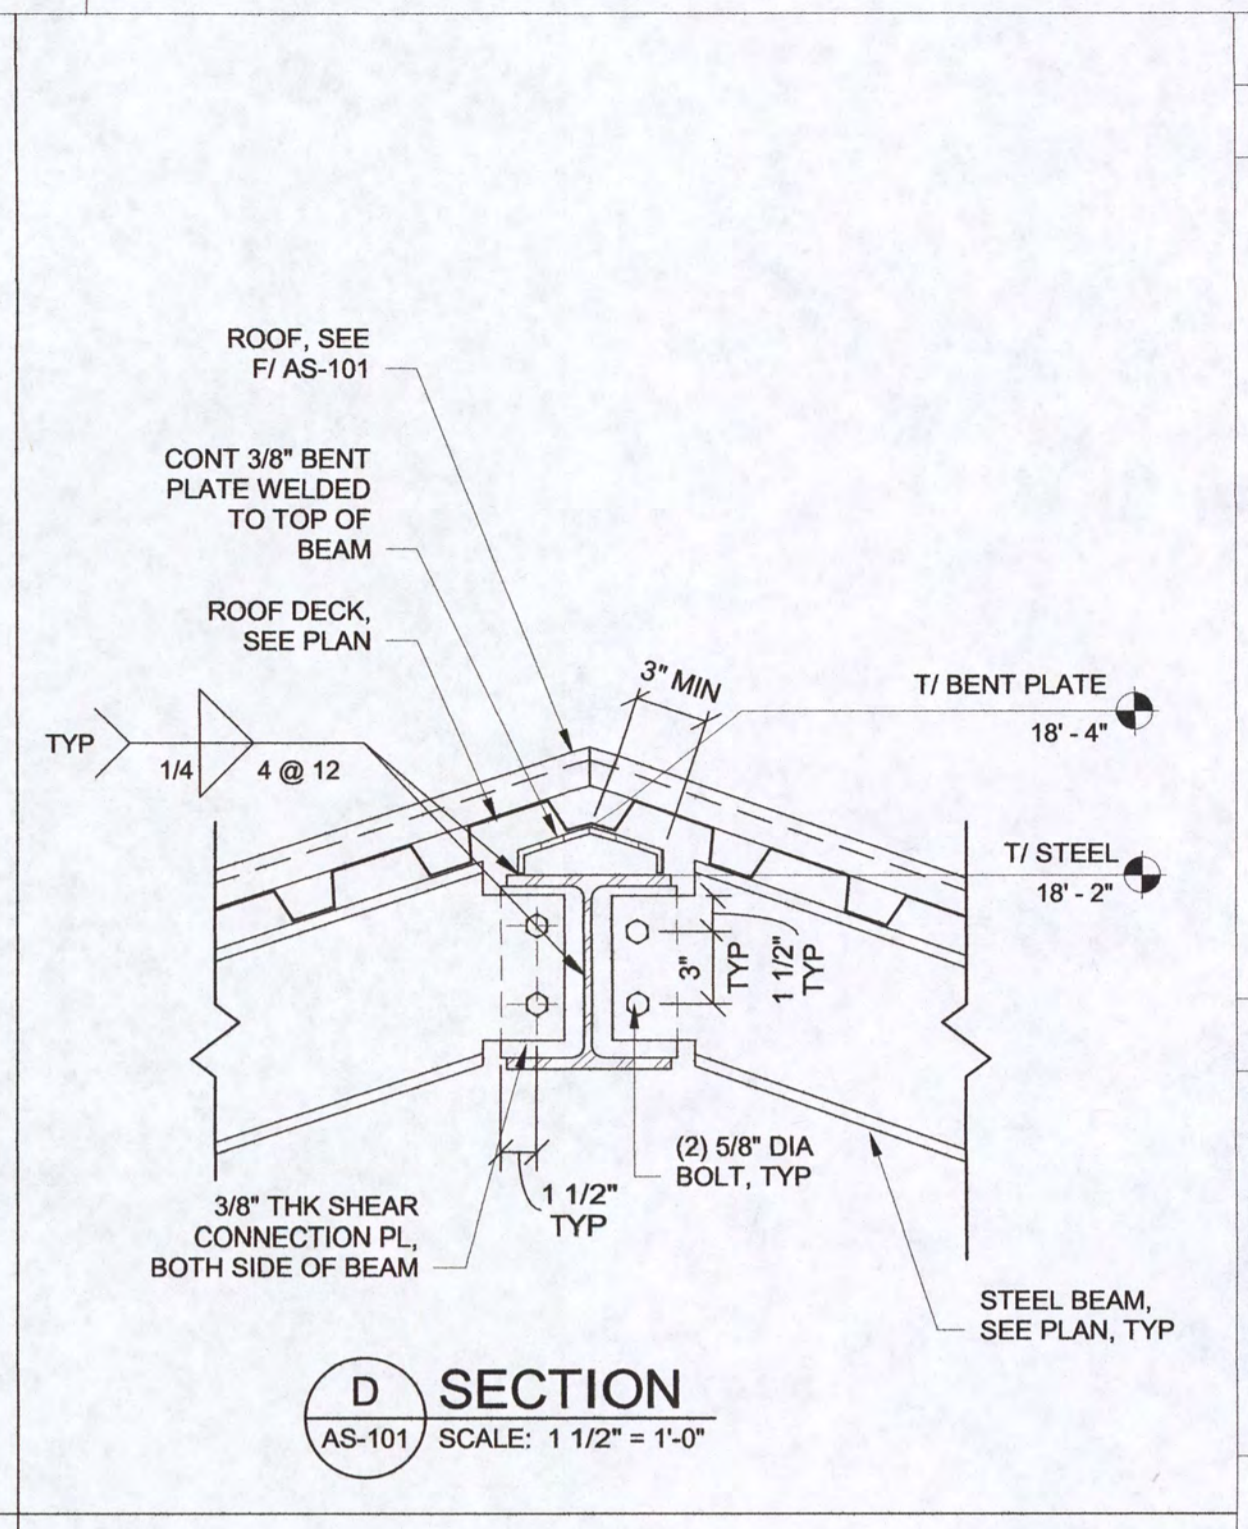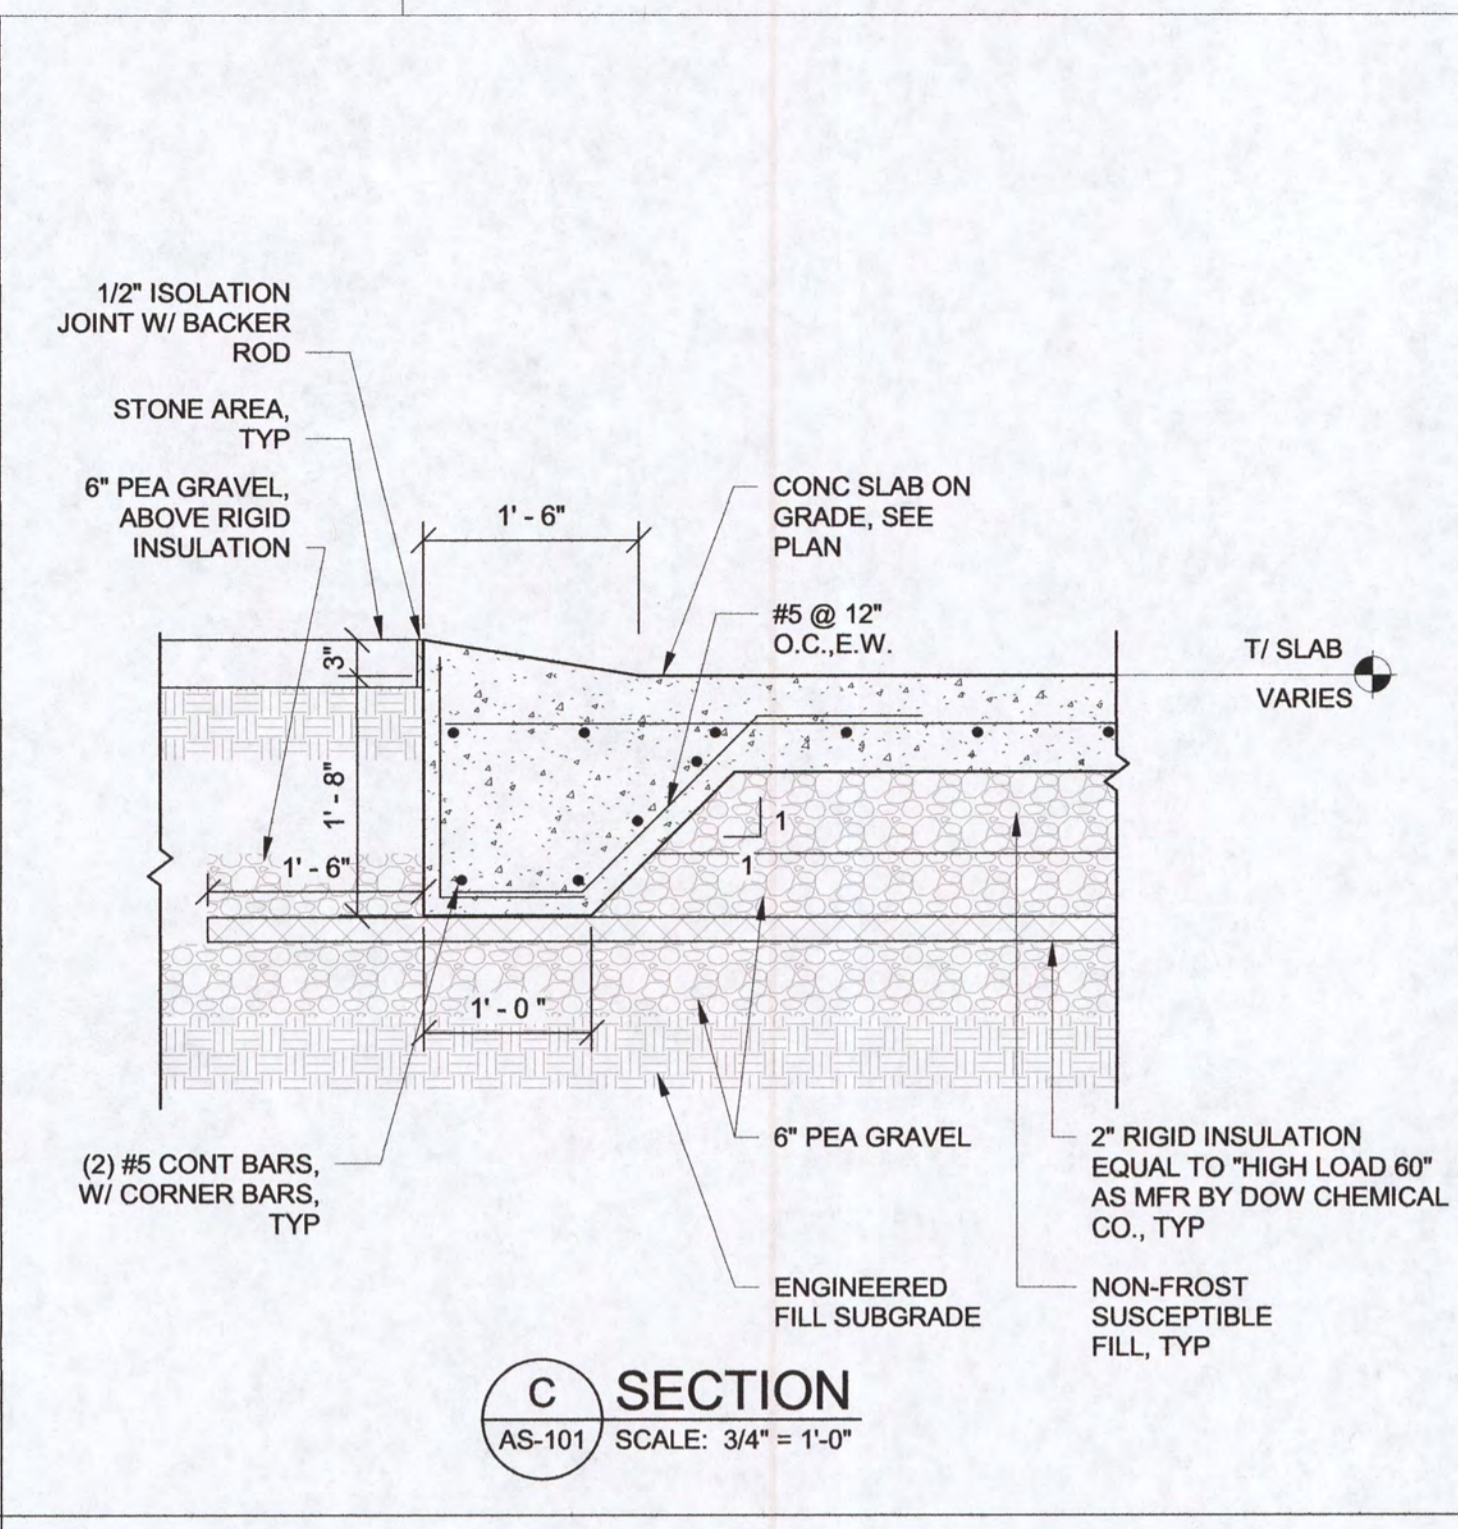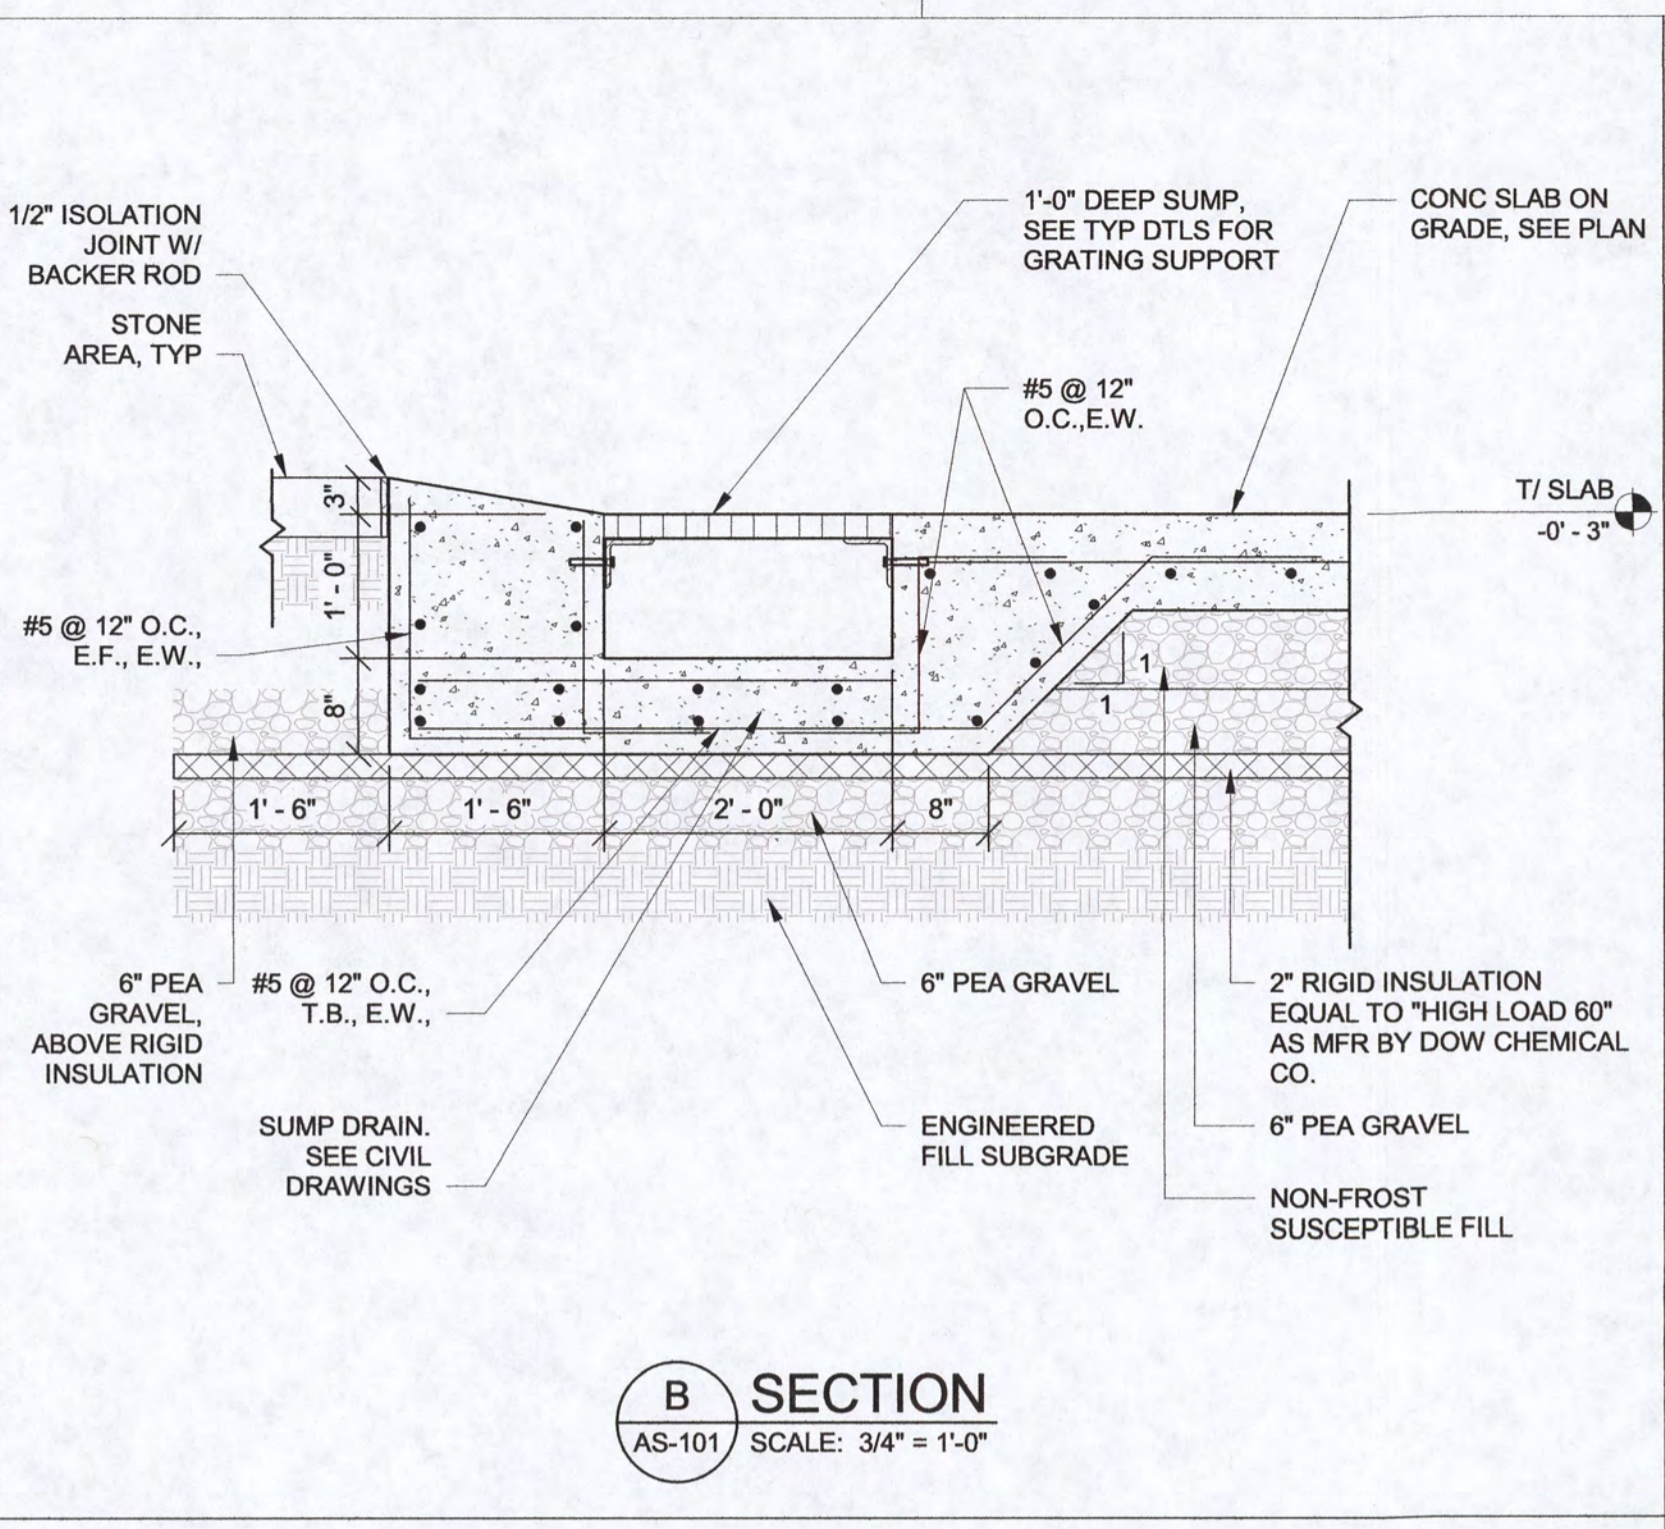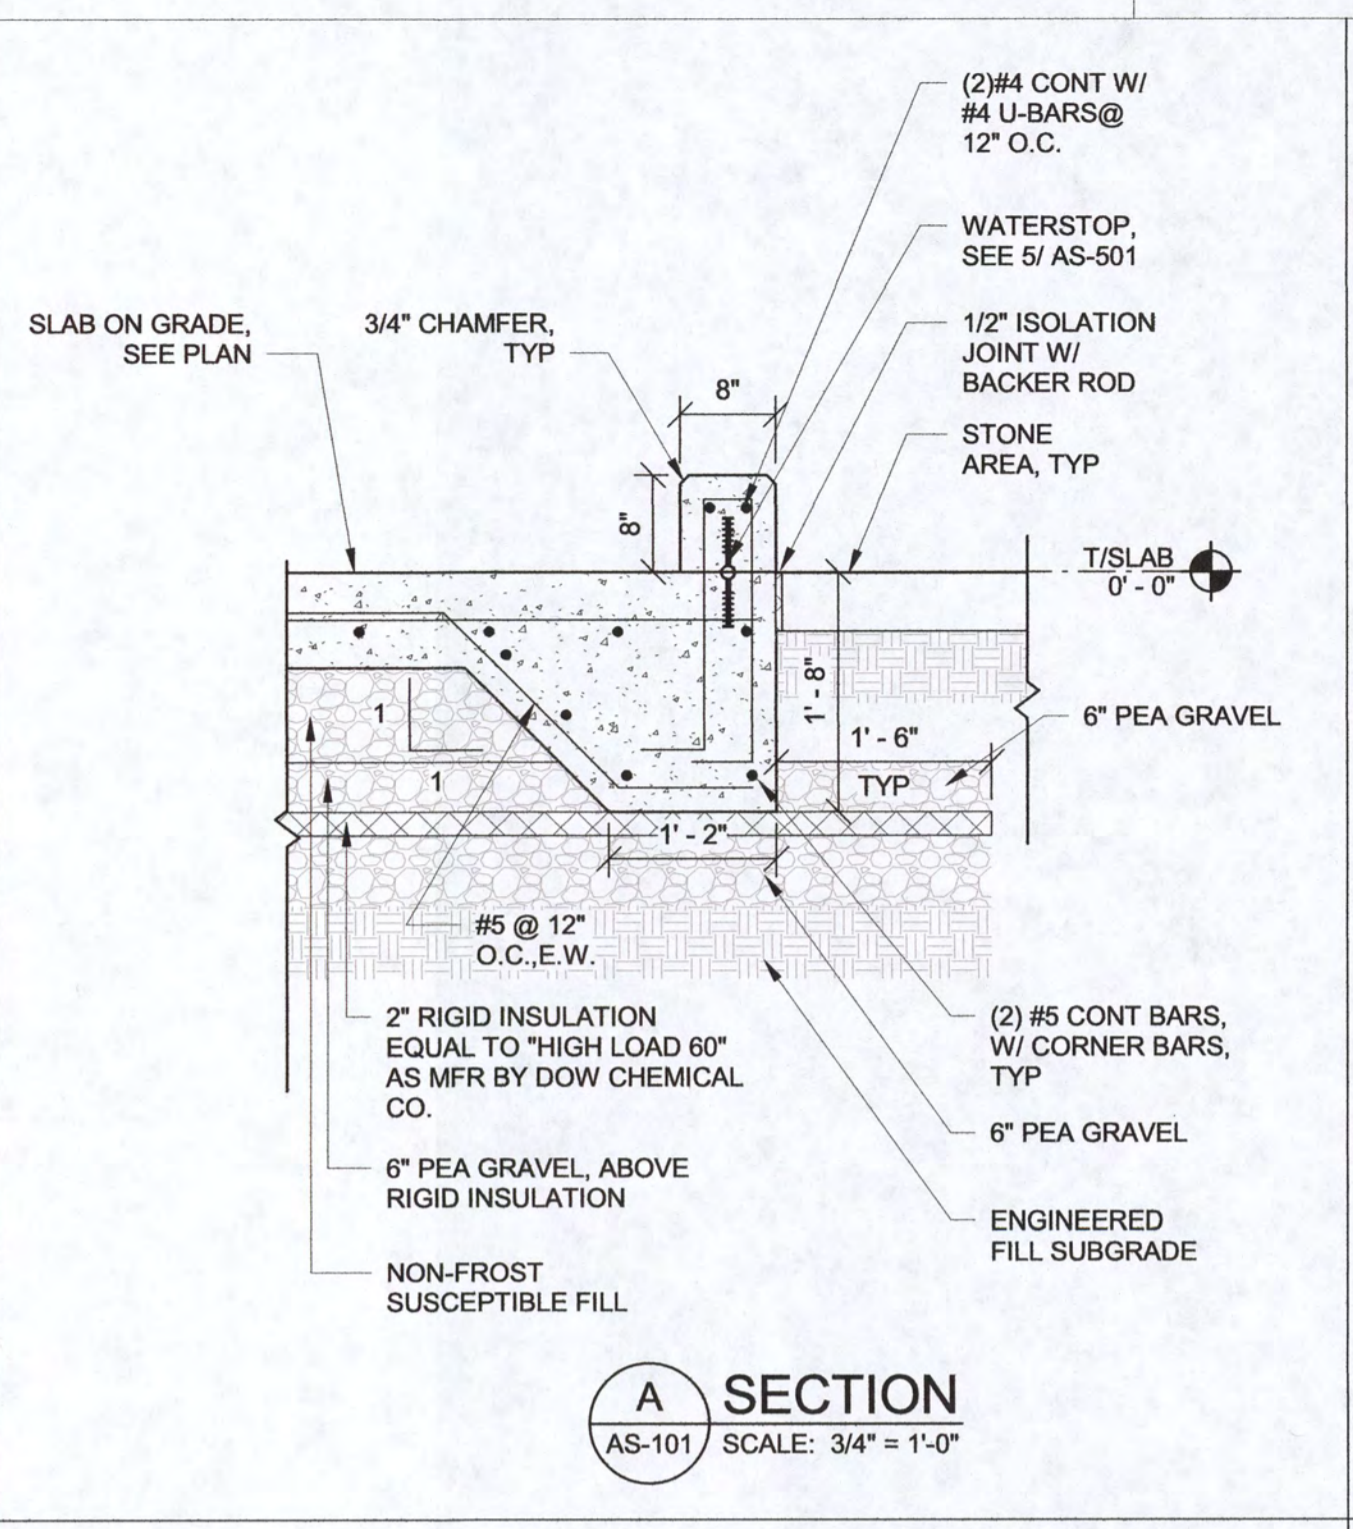

THIS DRAWING PRODUCED ON AUTOCAD  
DO NOT REVISE MANUALLY

THIS DOCUMENT IS THE PROPERTY OF NAVAL FACILITIES ENGINEERING COMMAND, PREPARED BY TETRA TECH ENGINEERING CORPORATION, INC. AND IS PROVIDED UPON THE CONDITION THAT IT WILL NOT BE REPRODUCED, COPIED, OR ISSUED TO A THIRD PARTY, AND WILL BE USED SOLELY FOR THE ORIGINAL INTENDED PURPOSE AND SOLELY FOR THE EXECUTION OR REVIEW OF THE ENGINEERING CONSTRUCTION OF THE PROJECT.

IT IS A VIOLATION OF THE NEW YORK STATE EDUCATION LAW, ARTICLE 145, FOR ANY PERSON, UNLESS UNDER THE DIRECTION OF A NEW YORK STATE LICENSED PROFESSIONAL ENGINEER, TO ALTER AN ITEM ON THIS DOCUMENT IN ANY WAY.

CODE ID. NO. 80091 SIZE D  
SCALE: AS NOTED  
MAXIMO NO. N62470-DB-D-1001  
JOB ORDER NO. WE-24  
SPEC. NO.  
CONSTR. CONTR. NO. N62475-99-D-0002  
112G08005  
NAVFAC DRAWING NO.  
SHEET OF

ISSUED FOR BID - 06/21/2019  
CAUTION: IF SHEET IS LESS THAN 34"x22" USE GRAPHIC SCALE

DATE APPR  
DESCRIPTION  
SYM

SEAL AREA  
DES SPS DR SPS  
REVIEWED BY ATC  
PM/DM HKM  
CHIEF ENG/ARCH ATC


NAVAL FACILITIES ENGINEERING COMMAND  
NAVAL FACILITIES ENGINEERING COMMAND - MID-ATLANTIC  
NAVAL INDUSTRIAL RESERVE ORDNANCE PLANT  
BETHPAGE, NEW YORK

GM-38 AREA  
GROUNDWATER TREATMENT PLANT  
AOP SYSTEM ADDITION


STRUCTURAL FDN & ROOF SECTIONS

AS-301




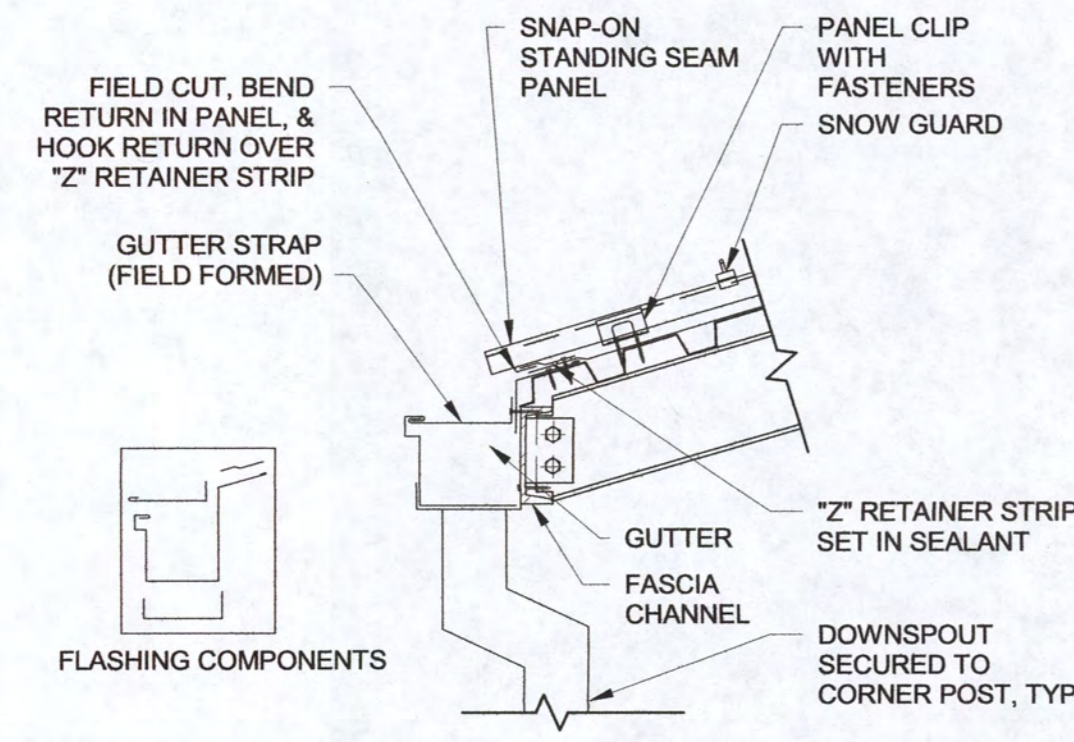


**A ARCH GUTTER DETAIL**  
AS-101 SCALE: 1" = 1'-0"

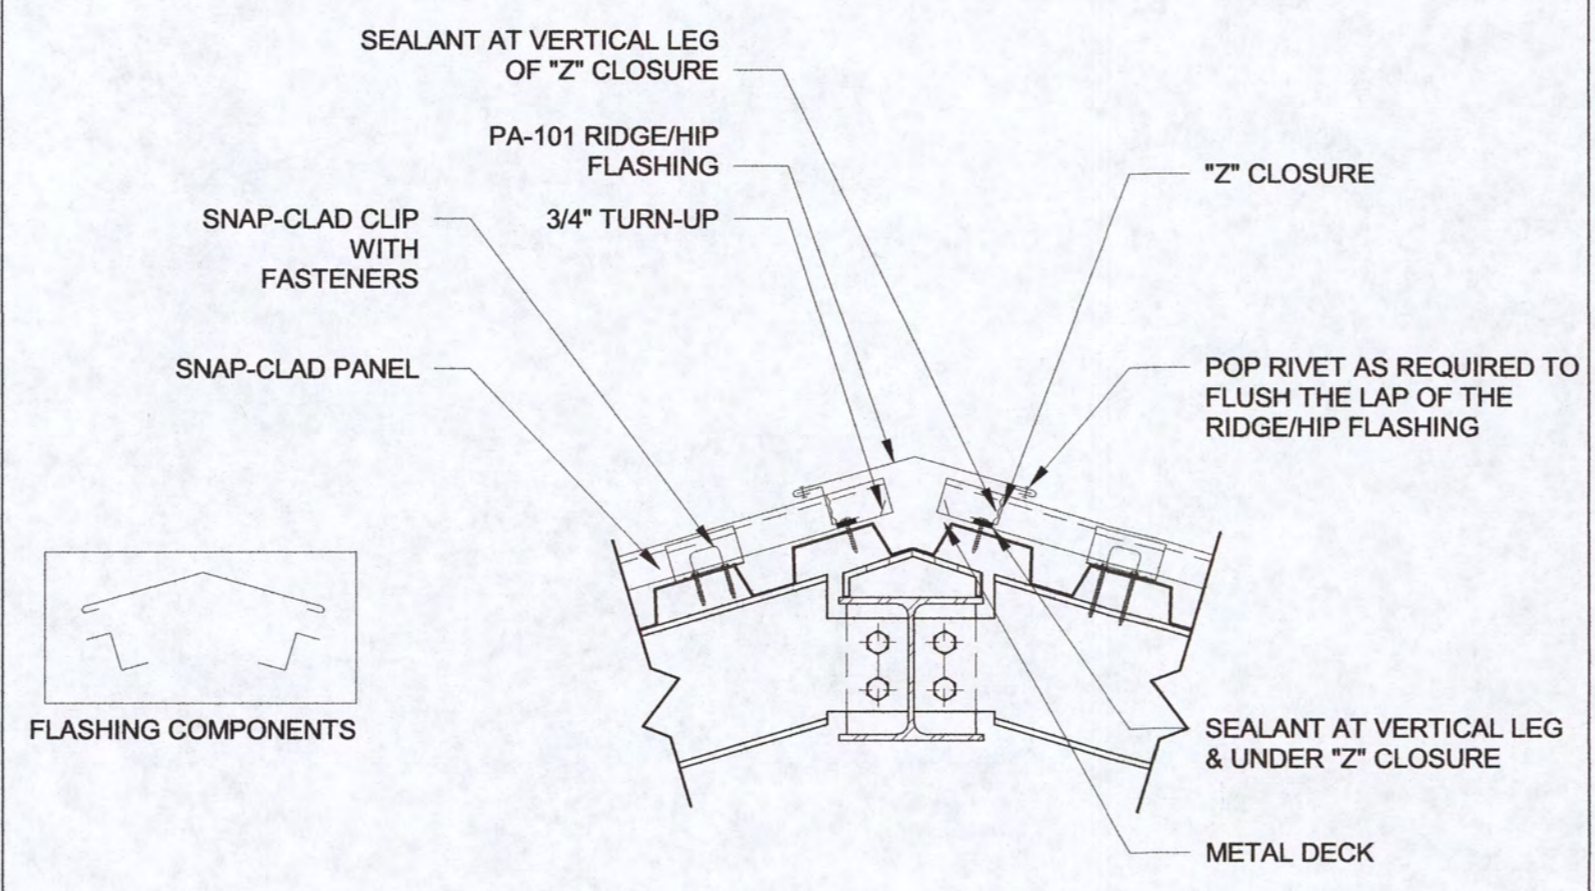


**B ARCH RIDGE DETAIL**  
AS-101 SCALE: 1 1/2" = 1'-0"

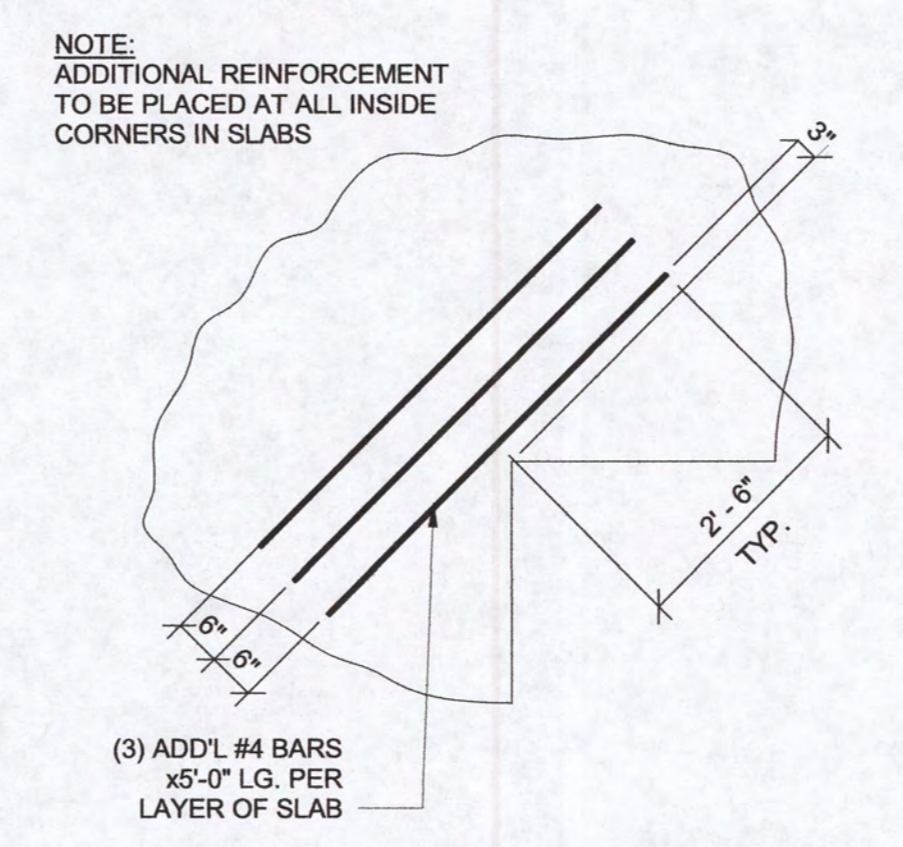

**1 REIN. SLAB RE-ENTRANT CORNER**  
AS-501 SCALE: 1/2" = 1'-0"

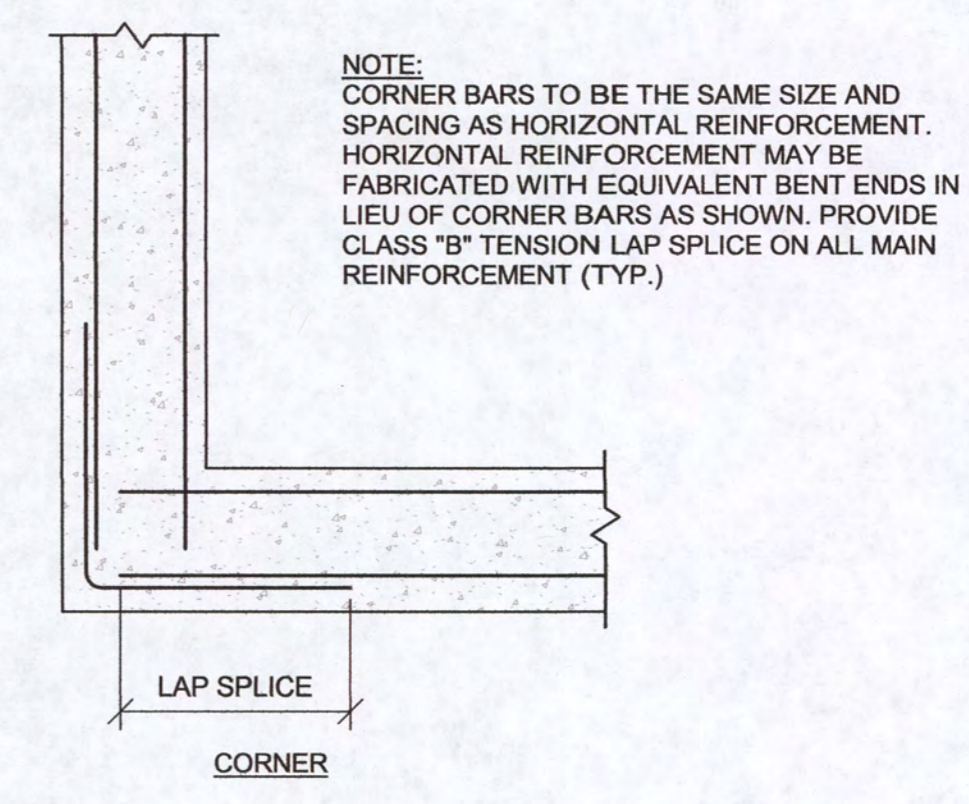


**2 WALL CORNERS AT BLDG WALLS**  
AS-501 SCALE: 3/4" = 1'-0"

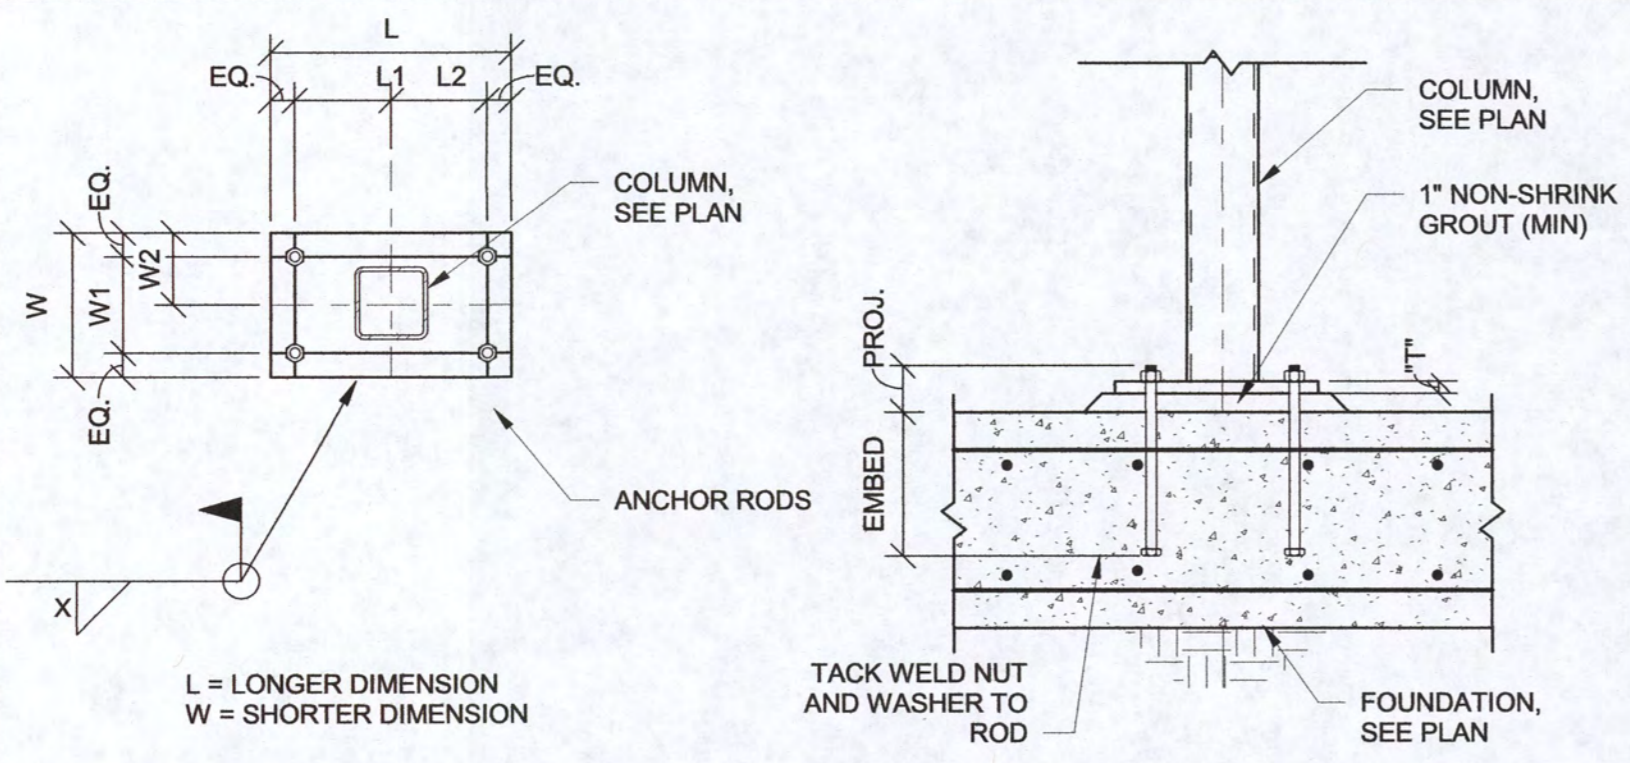

| BASEPLATE |       |       |       |       |       |      | ANCHOR ROD |      |        |       |
|-----------|-------|-------|-------|-------|-------|------|------------|------|--------|-------|
| L         | L1    | L2    | W     | W1    | W2    | "T"  | X          | SIZE | EMBED. | PROJ. |
| 1'-0"     | 0'-9" | 0'-6" | 0'-8" | 0'-5" | 0'-4" | 3/4" | 1/4"       | 3/4" | 6"     | 6"    |


- NOTES:
- ANCHOR RODS SHALL CONFORM TO ASTM F1554, GRADE 55, WELDABLE
  - ALL ANCHOR RODS SHALL BE STRAIGHT BOLTS W/ NUTS & STANDARD WASHER TACK WELD
  - HOLE SIZES FOR ANCHOR RODS ARE NORMALLY MADE OVERSIZE TO FACILITATE ERECTION. BOLTS 3/4" TO 1" DIA. = 5/16" OVERSIZE

**3 BASEPLATE DETAIL W/ SCHEDULE**  
AS-501 SCALE: 3/4" = 1'-0"

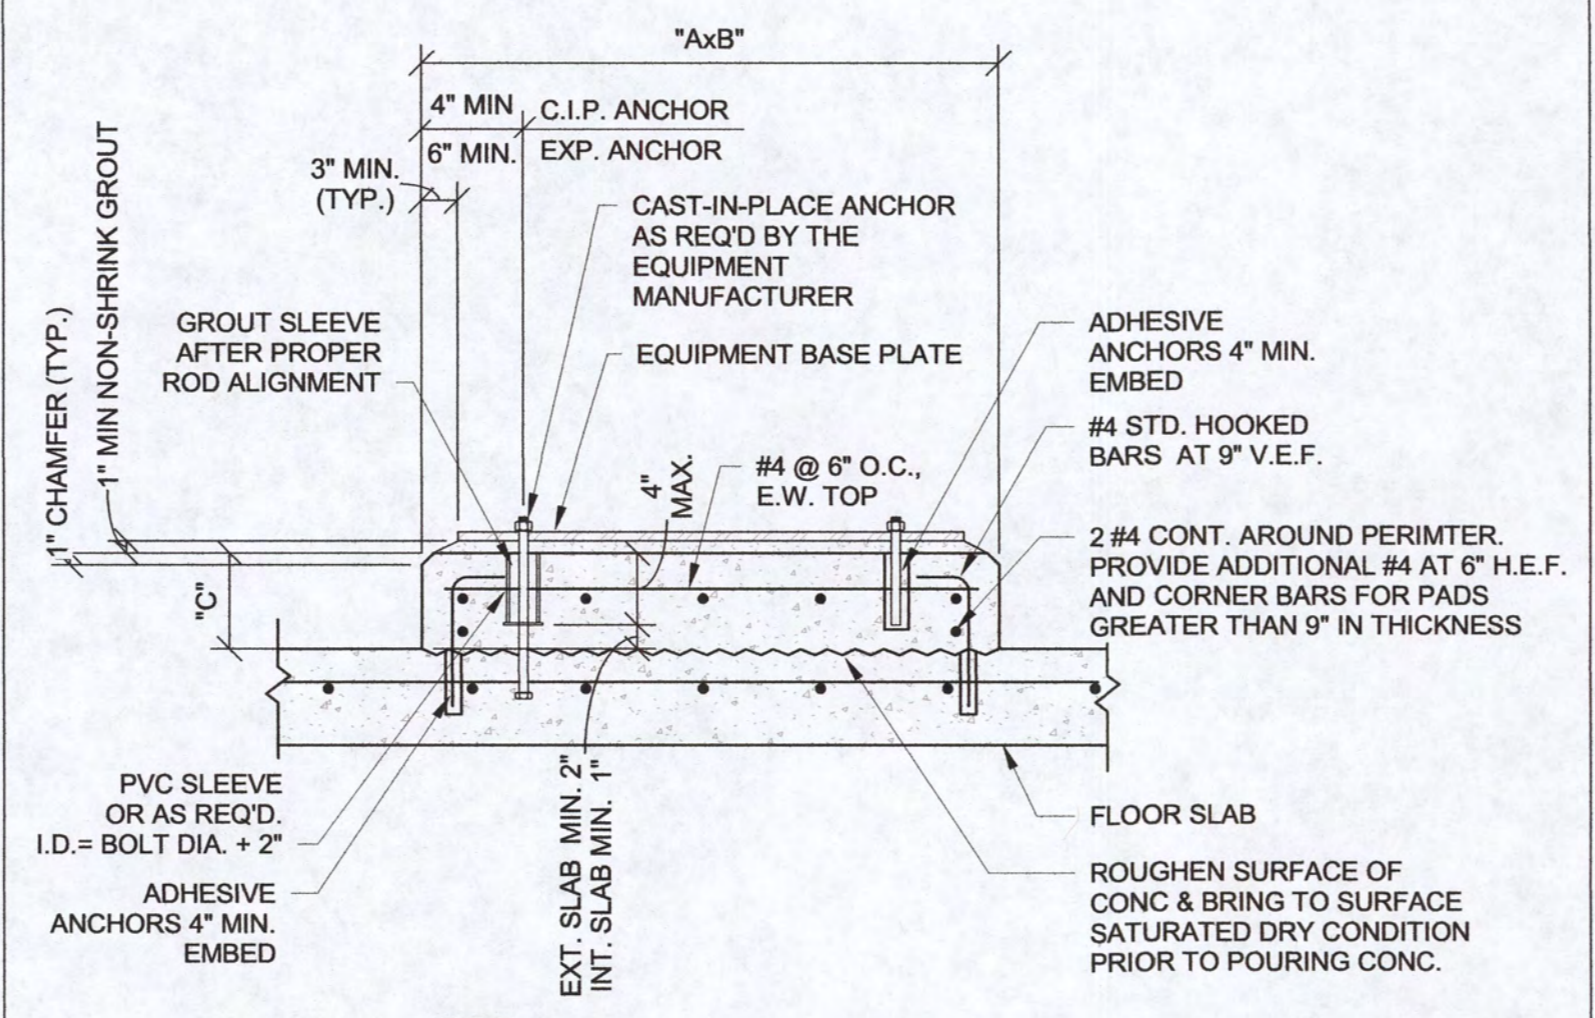


- NOTES:
- "A", "B" & "C" DIMS. AS REQ'D TO SUIT EQUIPMENT, ("C" = 8" TYP. U.N.O.)


**4 TYP. EQUIPMENT PAD**  
AS-501 SCALE: 3/4" = 1'-0"

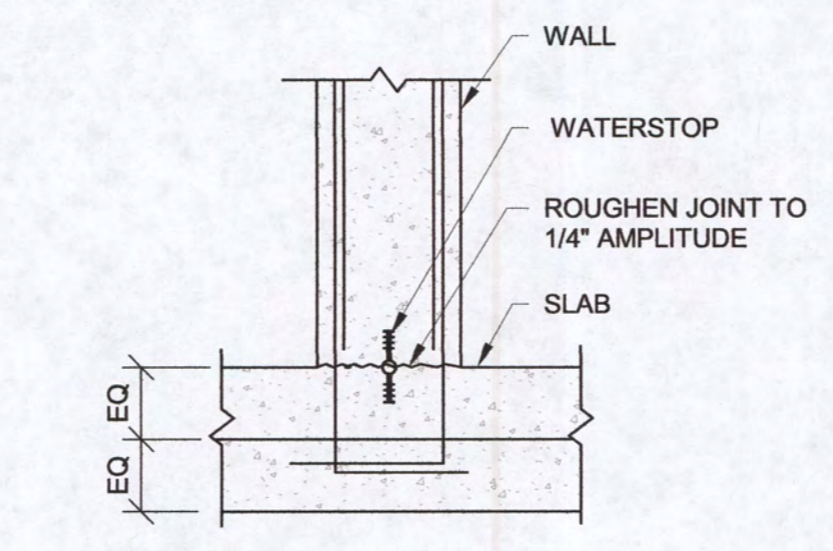


**5 WATERSTOP CONSTRUCTION JOINTS**  
AS-501 SCALE: 3/4" = 1'-0"

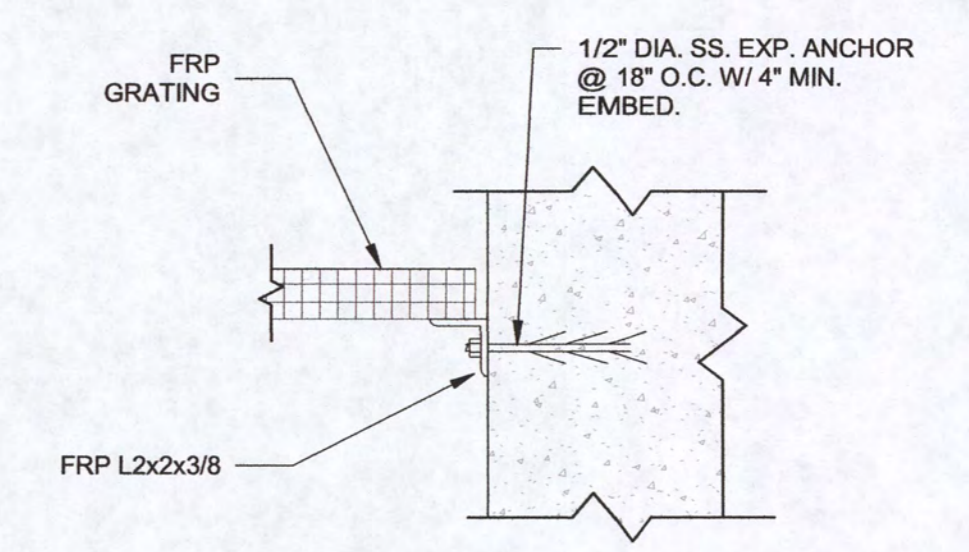

**6 GRATING DETAIL**  
AS-501 SCALE: 1 1/2" = 1'-0"

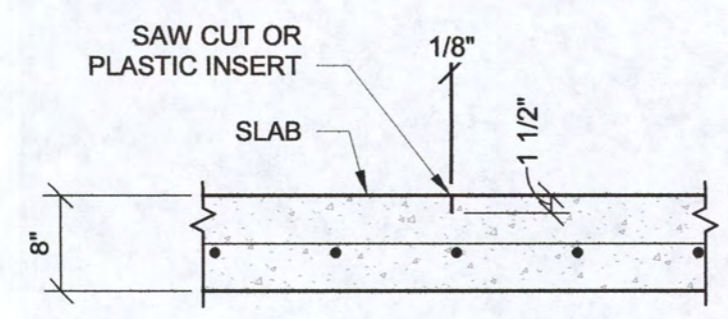

**7 CRACK CONTROL JOINT DETAIL**  
AS-501 SCALE: 3/4" = 1'-0"

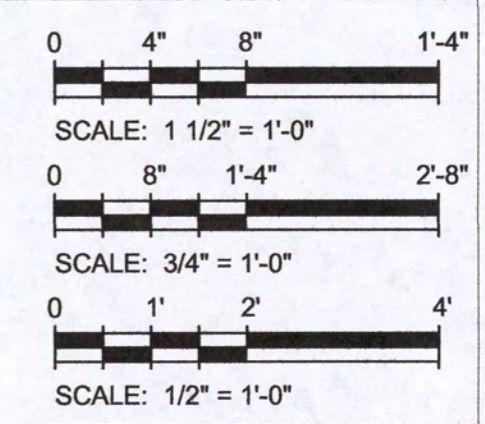

ISSUED FOR BID - 06/21/2019  
CAUTION: IF SHEET IS LESS THAN 34"x22" USE GRAPHIC SCALE

DATE: APRR  
DESCRIPTION: STRUCTURAL TYPICAL DETAILS  
SYN

6-20-19

|                |     |    |     |
|----------------|-----|----|-----|
| DES            | SPS | DR | SPS |
| REVIEWED BY    | ATC |    |     |
| PM/DM          | HKM |    |     |
| CHIEF ENG/ARCH | ATC |    |     |

SEAL AREA

DEPARTMENT OF THE NAVY  
NAVAL FACILITIES ENGINEERING COMMAND  
NAVAL FACILITIES ENGINEERING COMMAND ~ MID-ATLANTIC  
NAVAL INDUSTRIAL RESERVE ORDNANCE PLANT  
BETHPAGE, NEW YORK

GROUNDWATER TREATMENT PLANT  
AOP SYSTEM ADDITION

CONSTR. CONTR. NO. 112G08005  
NAVFAC DRAWING NO. 112G08005


THIS DRAWING PRODUCED ON AUTOCAD  
DO NOT REVISE MANUALLY

THIS DOCUMENT IS THE PROPERTY OF  
NAVAL FACILITIES ENGINEERING COMMAND,  
PREPARED BY TETRA TECH ENGINEERING  
CORPORATION, P.C., AND IS PROVIDED UPON  
THE CONDITION THAT IT WILL NOT BE REPRODUCED,  
COPIED, OR ISSUED TO A THIRD PARTY, AND WILL  
BE USED SOLELY FOR THE ORIGINAL INTENDED  
PURPOSE AND SOLELY FOR THE EXECUTION  
OR REVIEW OF THE ENGINEERING CONSTRUCTION  
OF THE PROJECT.

IT IS A VIOLATION OF THE NEW YORK STATE  
EDUCATION LAW, ARTICLE 145, FOR ANY PERSON,  
UNLESS UNDER THE DIRECTION OF A NEW YORK  
STATE LICENSED PROFESSIONAL ENGINEER, TO  
ALTER AN ITEM ON THIS DOCUMENT IN ANY WAY.

CODE ID. NO. 80091 SIZE D  
SCALE: AS NOTED  
MAXIMO NO. N62470-DB-D-1001  
JOB ORDER NO. WE-24  
SPEC. NO.  
CONSTR. CONTR. NO. 112G08005  
NAVFAC DRAWING NO. 112G08005  
SHEET ..... OF ...



AS-501

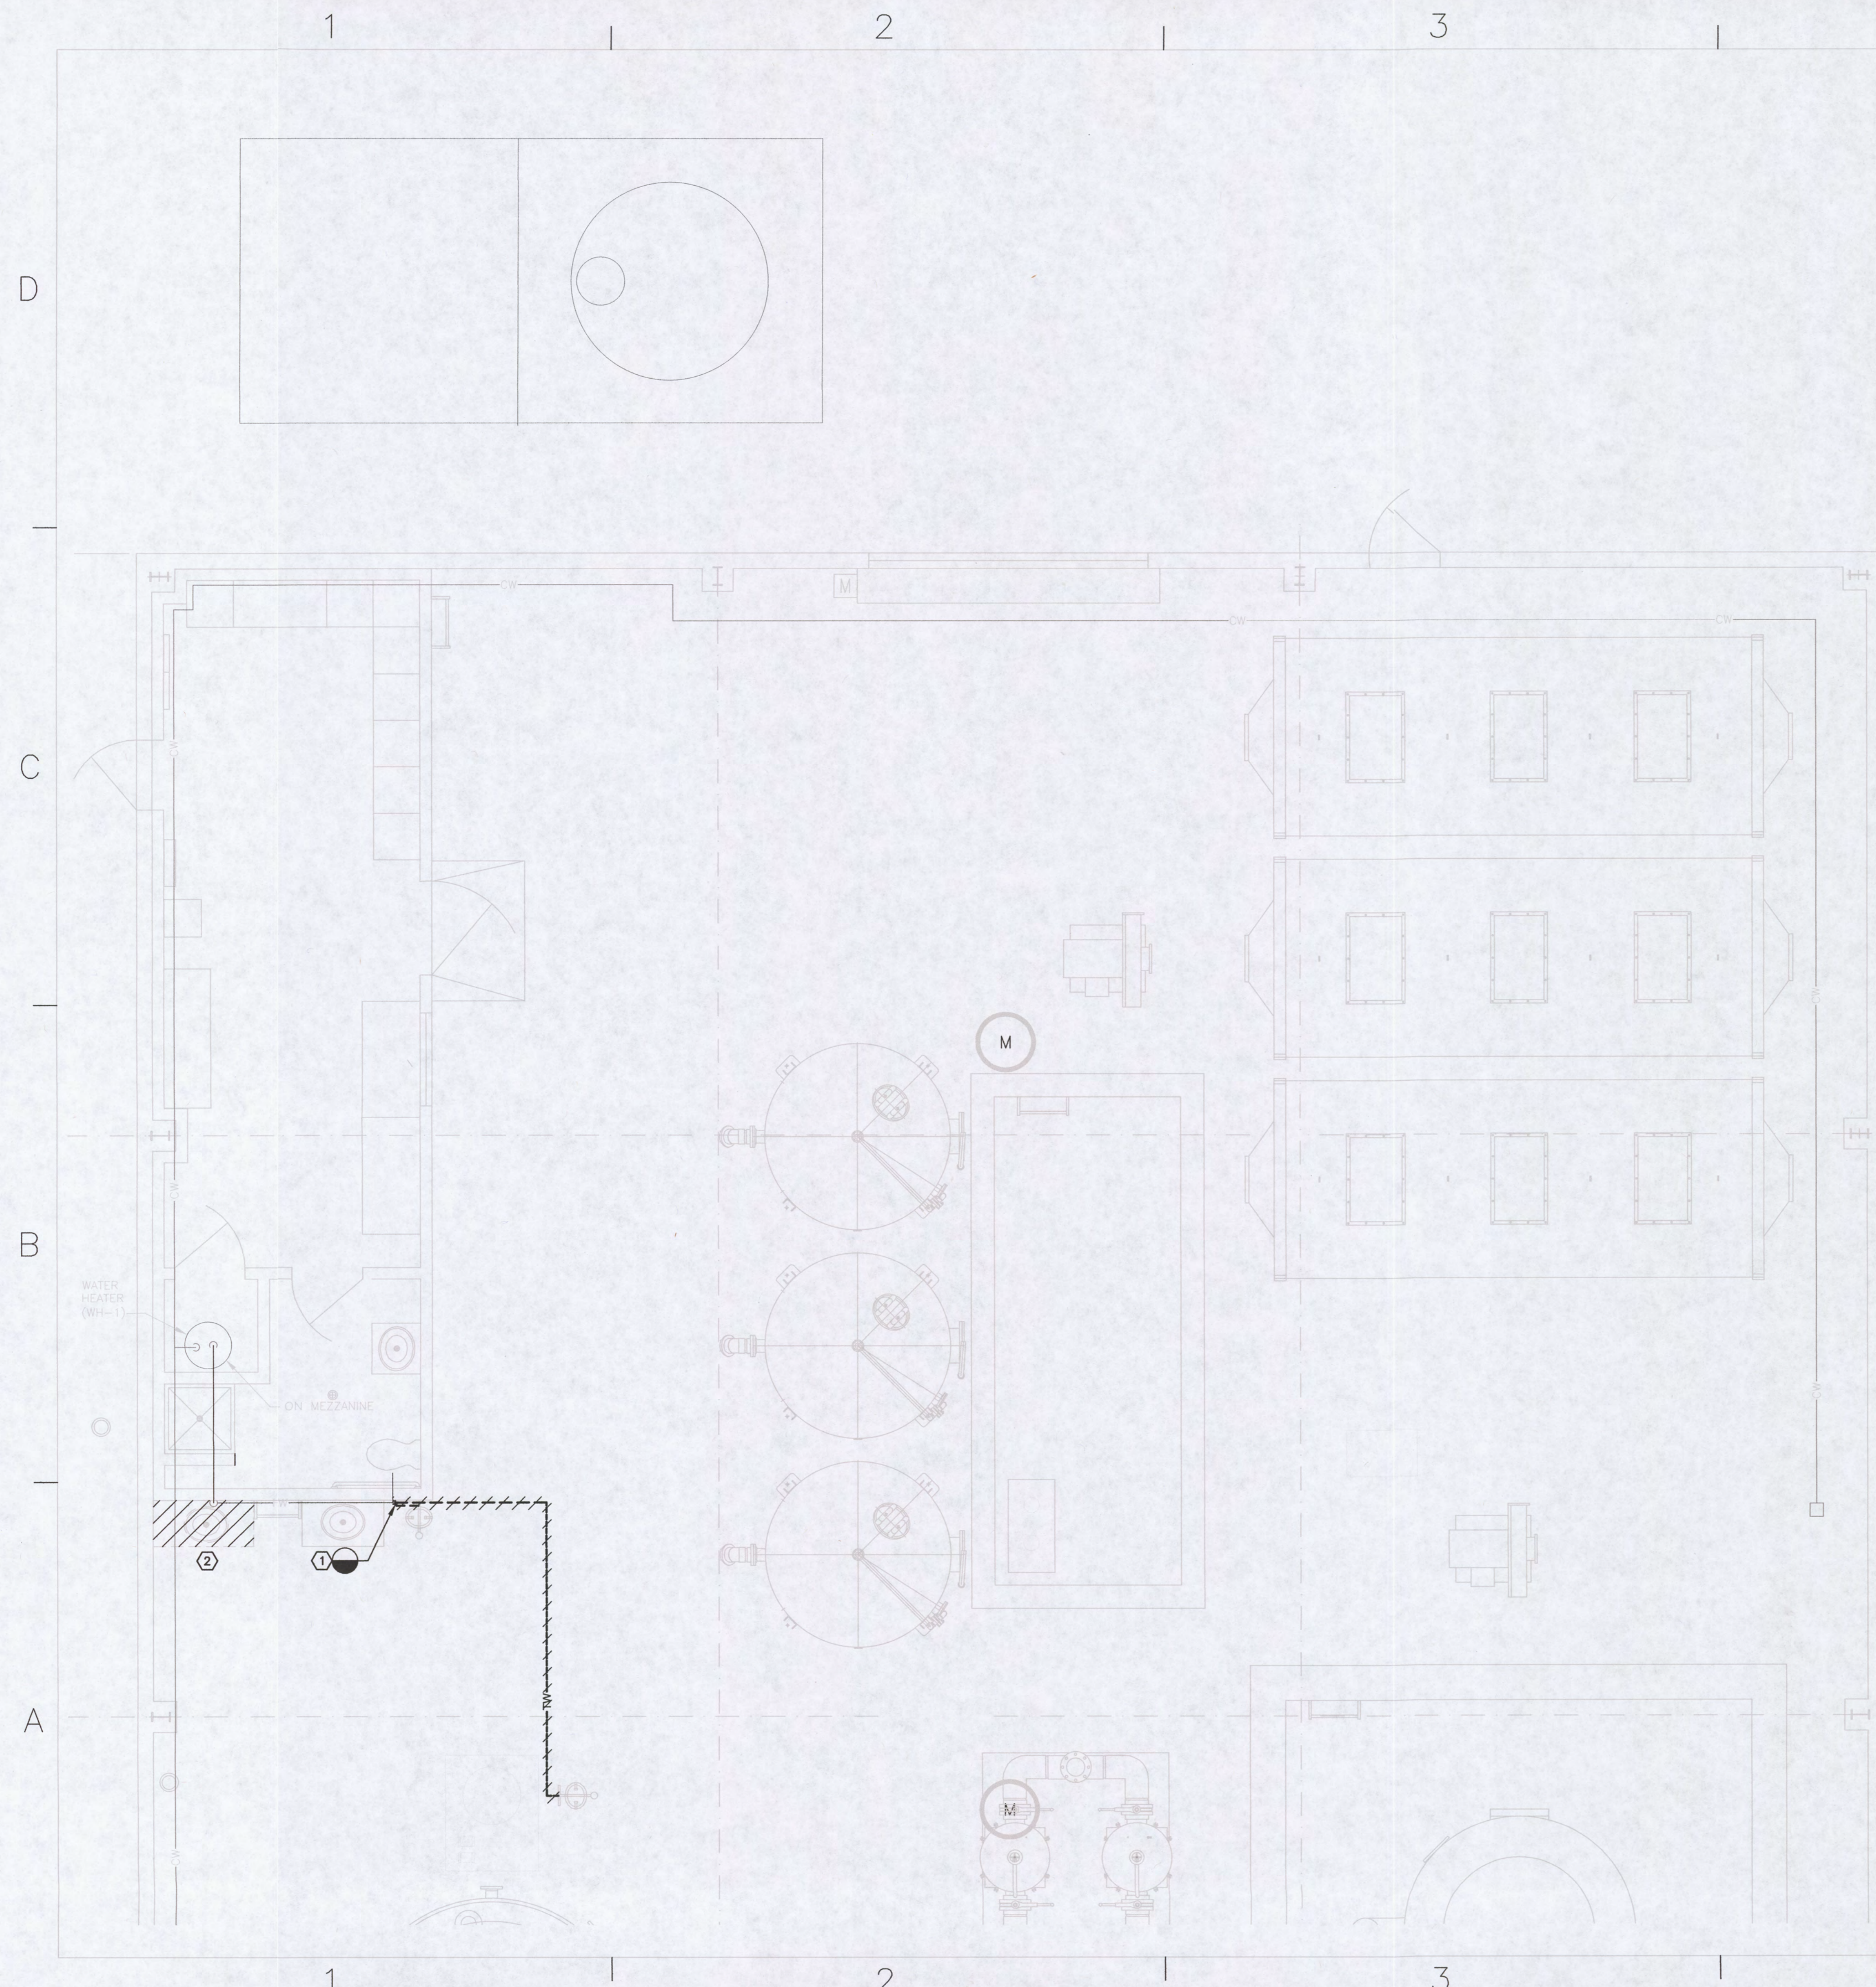

**PLUMBING REMOVAL WORK NOTES:**

- ① DISCONNECT AND REMOVE EXISTING HOT WATER PIPING, INSULATION, HANGERS AND ACCESSORIES FROM EMERGENCY SHOWER EYE WASH STATION TO POINT INDICATED.
- ② DISCONNECT AND REMOVE EXISTING SINK, INCLUDING DOMESTIC WATER PIPING AND SANITARY PIPING TO WALL. CAP PIPING AT WALL.

| SYN | DESCRIPTION | DATE | APPR. |
|-----|-------------|------|-------|
|     |             |      |       |

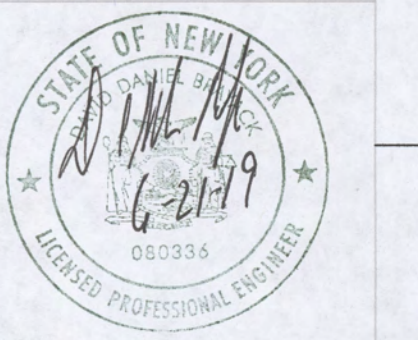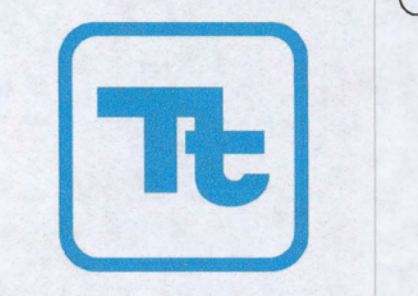

|   |     |    |     |
|---|-----|----|-----|
| SEAL AREA   |     |    |     |
| DES   | APS | DR | APS |
|   |     |    |     |
| REVIEWED BY   |     |    |     |
| PM/CM   | HKM |    |     |
| CHIEF ENG/ARCH  |     |    |     |
|   | HKM |    |     |
| NAVAL FACILITIES ENGINEERING COMMAND<br>NAVAL FACILITIES ENGINEERING COMMAND - MID-ATLANTIC<br>NAVAL INDUSTRIAL RESERVE ORDNANCE PLANT<br>BETHPAGE, NEW YORK<br>GM-38 AREA<br>GROUNDWATER TREATMENT PLANT<br>AOP SYSTEM ADDITION<br><b>PLUMBING FLOOR PLAN - REMOVAL WORK</b> |     |    |     |

THIS DRAWING PRODUCED ON AUTOCAD DO NOT REVISE MANUALLY

THIS DOCUMENT IS THE PROPERTY OF NAVAL FACILITIES ENGINEERING COMMAND, PREPARED BY TETRA TECH ENGINEERING CORPORATION PC, AND IS PROVIDED UPON THE CONDITION THAT IT WILL NOT BE REPRODUCED, COPIED, OR ISSUED TO A THIRD PARTY, AND WILL BE USED SOLELY FOR THE ORIGINAL INTENDED PURPOSE AND SOLELY FOR THE EXECUTION OR REVIEW OF THE ENGINEERING CONSTRUCTION OF THE PROJECT.

IT IS A VIOLATION OF THE NEW YORK STATE EDUCATION LAW, ARTICLE 145, FOR ANY PERSON, UNLESS UNDER THE DIRECTION OF A NEW YORK STATE LICENSED PROFESSIONAL ENGINEER, TO ALTER AN ITEM ON THIS DOCUMENT IN ANY WAY.

|                                     |              |   |
|-------------------------------------|--------------|---|
| CODE NO. 80091                      | SIZE         | D |
| SCALE:                              | 1/4" = 1'-0" |   |
| MAXIMO NO. N62470-08-D-1001         |              |   |
| JOB ORDER NO. WE-24                 |              |   |
| SPEC. NO.                           |              |   |
| CONSTR. CONTR. NO. N62472-99-D-0032 |              |   |
| 112G08005                           |              |   |
| NAVFAC DRAWING NO.                  |              |   |
|                                     |              |   |
| SHEET                               | OF           |   |
|                                     |              |   |
| MD101                               |              |   |

ISSUED FOR BID - 06/21/2019

CAUTION: IF SHEET IS LESS THAN 34"x22" USE GRAPHIC SCALE

**PLUMBING FIXTURE SCHEDULE**

| ID NO. | ITEM                         | MANUFACTURER | MODEL   | NUMBER  | FLOW RATE |
|--------|------------------------------|--------------|---|---------|-----------|
| P-1    | EMERGENCY FIXTURE            | GUARDIAN     | COMBINATION EYE/FACE WASH AND SHOWER SAFETY STATION WITH ABS PLASTIC SHOWER HEAD. INTERNAL 20 GPM FLOW CONTROL, ABS PLASTIC EYE/FACE WASH BOWL, POWDER-COATED CAST ALUMINUM FLAG HANDLE AND FLOOR FLANGE, 1/2" IPS SCHEDULE 40 GALVANIZED PIPE AND FITTINGS, 1" IPS AND 1/2" IPS U.S. MADE CHROME-PLATED BRASS STAY-OPEN BALL VALVES, AND POLISHED STAINLESS STEEL PULL ROD. UNIT SHALL HAVE (2) POLYPROPYLENE FS-PLUS™ SPRAY HEADS WITH INTEGRAL "FLIP-TOP" DUST COVERS, FILTERS, AND 3.2 GPM FLOW CONTROL ORIFICES MOUNTED ON A CHROME-PLATED BRASS EYEWASH ASSEMBLY. UNIT SHALL INCLUDE ANSI COMPLIANT SIGN.   | G1950P  | 20 GPM    |
| P-2    | EMERGENCY FIXTURE            | GUARDIAN     | OUTSIDE, FLOOR MOUNTED ELECTRICALLY HEAT TRACED EMERGENCY EYEWASH AND SHOWER SAFETY STATION WITH BOTTOM INLET, ABS PLASTIC SHOWER HEAD WITH INTERNAL 20 GPM FLOW CONTROL, 1" IPS U.S. MADE BRASS STAY-OPEN BALL VALVE WITH STAINLESS STEEL ACTUATING ARM, 1/2" IPS U.S. MADE BRASS 3-WAY SELF DRAINING STAY-OPEN BALL VALVE, 1/2" IPS SCHEDULE 40 HOT DIPPED GALVANIZED PIPE AND FITTINGS, POLISHED STAINLESS STEEL PULL ROD, STAINLESS STEEL FLAG HANDLE AND POWDER-COATED CAST ALUMINUM FLOOR FLANGE, SELF REGULATING ELECTRIC HEAT-TRACED CABLE, UV-RESISTANT ABS PLASTIC JACKET WITH FOAM INSULATED CORE AND WEATHER SEALED WITH ELASTOMERIC MATERIAL, 120VAC, 60 HZ SINGLE PHASE POWER SUPPLY, AND PIPE SENSING THERMOSTAT (OPTIONAL FREEZE PROTECTION VALVE, "FP"). UNIT SHALL HAVE FREEZE-RESISTANT SPRAY HEADS WITH DUST COVERS. SPRAY HEADS SHALL BE MOUNTED ON A CHROME-PLATED BRASS EYEWASH ASSEMBLY. UNIT SHALL INCLUDE ANSI COMPLIANT SIGNS. | GFR3110 | 20 GPM    |
| P-3    | EMERGENCY TEPID WATER HEATER | STINGRAY     | TEPID EMERGENCY HEATER, 118 GALLON STORAGE TANK AT 180°F WATER, 1" COLD SUPPLY, DUAL THERMOSTAT MIXING VALVES WITH POSITIVE HOT WATER SHUT-OFF AND INTEGRAL COLD WATER BYPASS, INTEGRAL HEAT TRAP, ACCUMULATOR FOR TEMPERATURE SPIKES, NEMA 4 HEATING ELEMENT LISTED UL TANK. 120VAC/20A ELECTRICAL POWER, COLD WATER FILTER, BARRIER FREE ACCESSIBLE COMBINATION SYSTEM, ELEMENT FILTER. ABS BOWL/ABS SHOWERHEAD MATERIALS 1/2" THK X 8" DIA. BASE PLATE.  | S9300   | 2-22 GPM  |

**PLUMBING LEGEND AND ABBREVIATIONS**


- EXISTING WORK
- NEW WORK
- EXTENT OF REMOVAL
- ⊗ CONNECT NEW TO EXISTING
- ◇ NEW WORK NOTES
- ⊘ (P/X) FIXTURE REFERENCE ITEM
- CW → COLD WATER SUPPLY
- HW → HOT WATER SUPPLY
- TW → TEPID WATER SUPPLY
- S → SANITARY
- ⊘ BALL VALVE
- DN DOWN
- CO FLOOR CLEANOUT
- FD FLOOR DRAIN
- S/SAN SANITARY SEWER

**PLUMBING GENERAL WORK NOTES:**

- INSTALLER SHALL VERIFY ALL DIMENSIONS IN THE FIELD PRIOR TO THE START OF CONSTRUCTION OR FABRICATION OF PIPING.
- FINAL LOCATIONS OF PIPING AND FIXTURE CONNECTIONS SHALL BE COORDINATED WITH THE SHOP DRAWINGS AND GENERAL INSTALLER. THE PLUMBING INSTALLER SHALL BE RESPONSIBLE FOR CONDUCTING THIS COORDINATION OF THEIR PLUMBING ROUGH-IN AND FINAL CONNECTION WORK.
- PROVIDE SLEEVES AND SEALS FOR ALL PIPING THROUGH FLOOR SLAB.
- UPON COMPLETION OF ALL NEW PIPING, FIXTURE INSTALLATION AND ACTIVATION, PATCH ALL WALL AND FLOOR OPENINGS MADE BY NEW WORK. CLEAN UP AND RESTORE ALL WORK AREAS.
- INSTALLER TO LOCATE CONNECTION POINTS IN FIELD, AS NOTED ON THE DRAWINGS, BEFORE STARTING WORK.

**PLUMBING NEW WORK NOTES:**

- RUN 1-1/4" TEPID WATER LINE UNDERGROUND BELOW FROST LINE (MIN. 48"). PROVIDE PIPE HEAT TRACE CABLE WITH NICKEL-COPPER MIN. 6 WATTS/FT., 120V, SINGLE PHASE, 60 HZ. (PROVIDE POWER CIRCUIT AS REQUIRED) SELF REGULATING AND CONDUCTIVE CORE, INSULATING BRAID FOR FREEZE PROTECTION OF WATER PIPE SHOWN/INDICATED. PROVIDE SHOP DRAWING WITH ALL NECESSARY DEVICES, HARDWARE ELECTRICAL CONDUIT (AS DETERMINED FROM PANEL SCHEDULE IN COORDINATION WITH ELECTRICAL CONTRACTOR) FOR COMPLETE OPERATION/FUNCTIONAL SYSTEM FOR APPROVAL FROM ENGINEER. PROVIDE 2" INSULATION.
- CONNECT NEW TEPID WATER LINE SERVING THE TEPID EMERGENCY HEATER TO EXISTING COLD WATER MAIN.

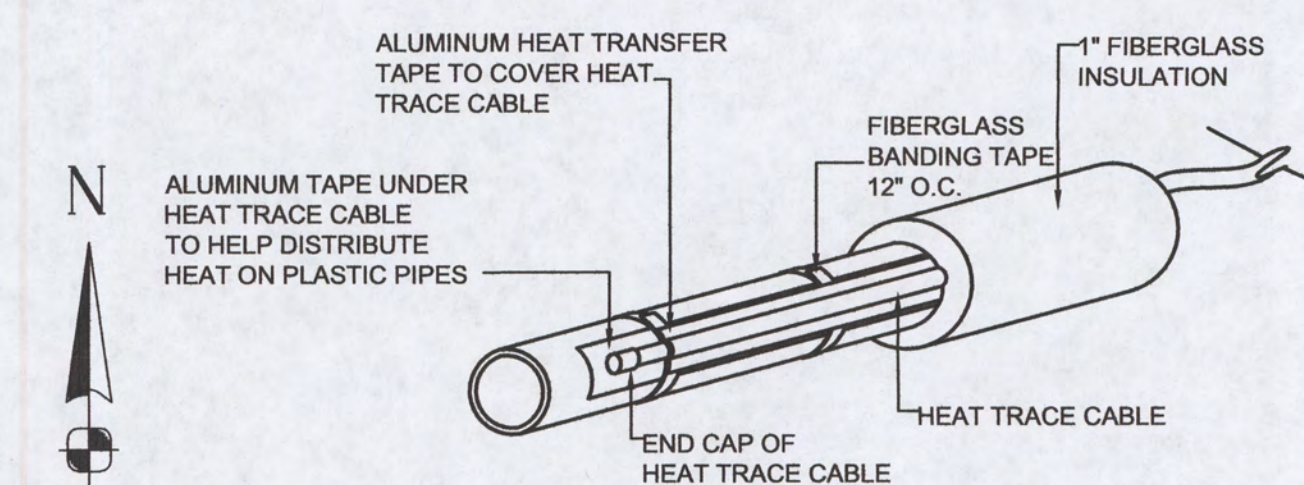

**TYPICAL HEAT TRACE DETAIL**  
N.T.S

ISSUED FOR BID - 06/21/2019


CAUTION: IF SHEET IS LESS THAN 34"x22" USE GRAPHIC SCALE


THIS DRAWING PRODUCED ON AUTOCAD DO NOT REVISE MANUALLY  
 THIS DOCUMENT IS THE PROPERTY OF NAVAL FACILITIES ENGINEERING COMMAND, PREPARED BY TETRA TECH ENGINEERING CORPORATION PC, AND IS PROVIDED UNDER THE CONDITION THAT IT WILL NOT BE REPRODUCED, COPIED, OR ISSUED TO A THIRD PARTY, AND WILL BE USED SOLELY FOR THE ORIGINAL INTENDED PURPOSE AND SOLELY FOR THE EXECUTION OR REVIEW OF THE ENGINEERING CONSTRUCTION OF THE PROJECT.  
 IT IS A VIOLATION OF THE NEW YORK STATE EDUCATION LAW, ARTICLE 145, FOR ANY PERSON, UNLESS UNDER THE DIRECTION OF A NEW YORK STATE LICENSED PROFESSIONAL ENGINEER, TO ALTER AN ITEM ON THIS DOCUMENT IN ANY WAY.

DEPARTMENT OF THE NAVY  
 NAVAL FACILITIES ENGINEERING COMMAND  
 NAVAL FACILITIES ENGINEERING COMMAND - MID-ATLANTIC  
 NAVAL INDUSTRIAL RESERVE ORDNANCE PLANT  
 NAVAL WEAPONS INDUSTRIAL RESERVE PLANT GM-38 AREA  
 GROUNDWATER TREATMENT PLANT  
 AOP SYSTEM ADDITION  
 PLUMBING FLOOR PLAN - NEW WORK

REVIEWED BY: [Signature]  
 DES: APS  
 PM/DM: HKH  
 CHIEF ENG/ARCH: HKH

CODE NO. 80091  
 SCALE: 1/4" = 1'-0"  
 MAXIMO NO. N62470-08-D-1001  
 JOB ORDER NO. WE-24  
 SPEC. NO.  
 CONSTR. CONTR. NO. N62472-99-D-0032  
 NAVFAC DRAWING NO. 112G08005  
 SHEET OF  
 M-101

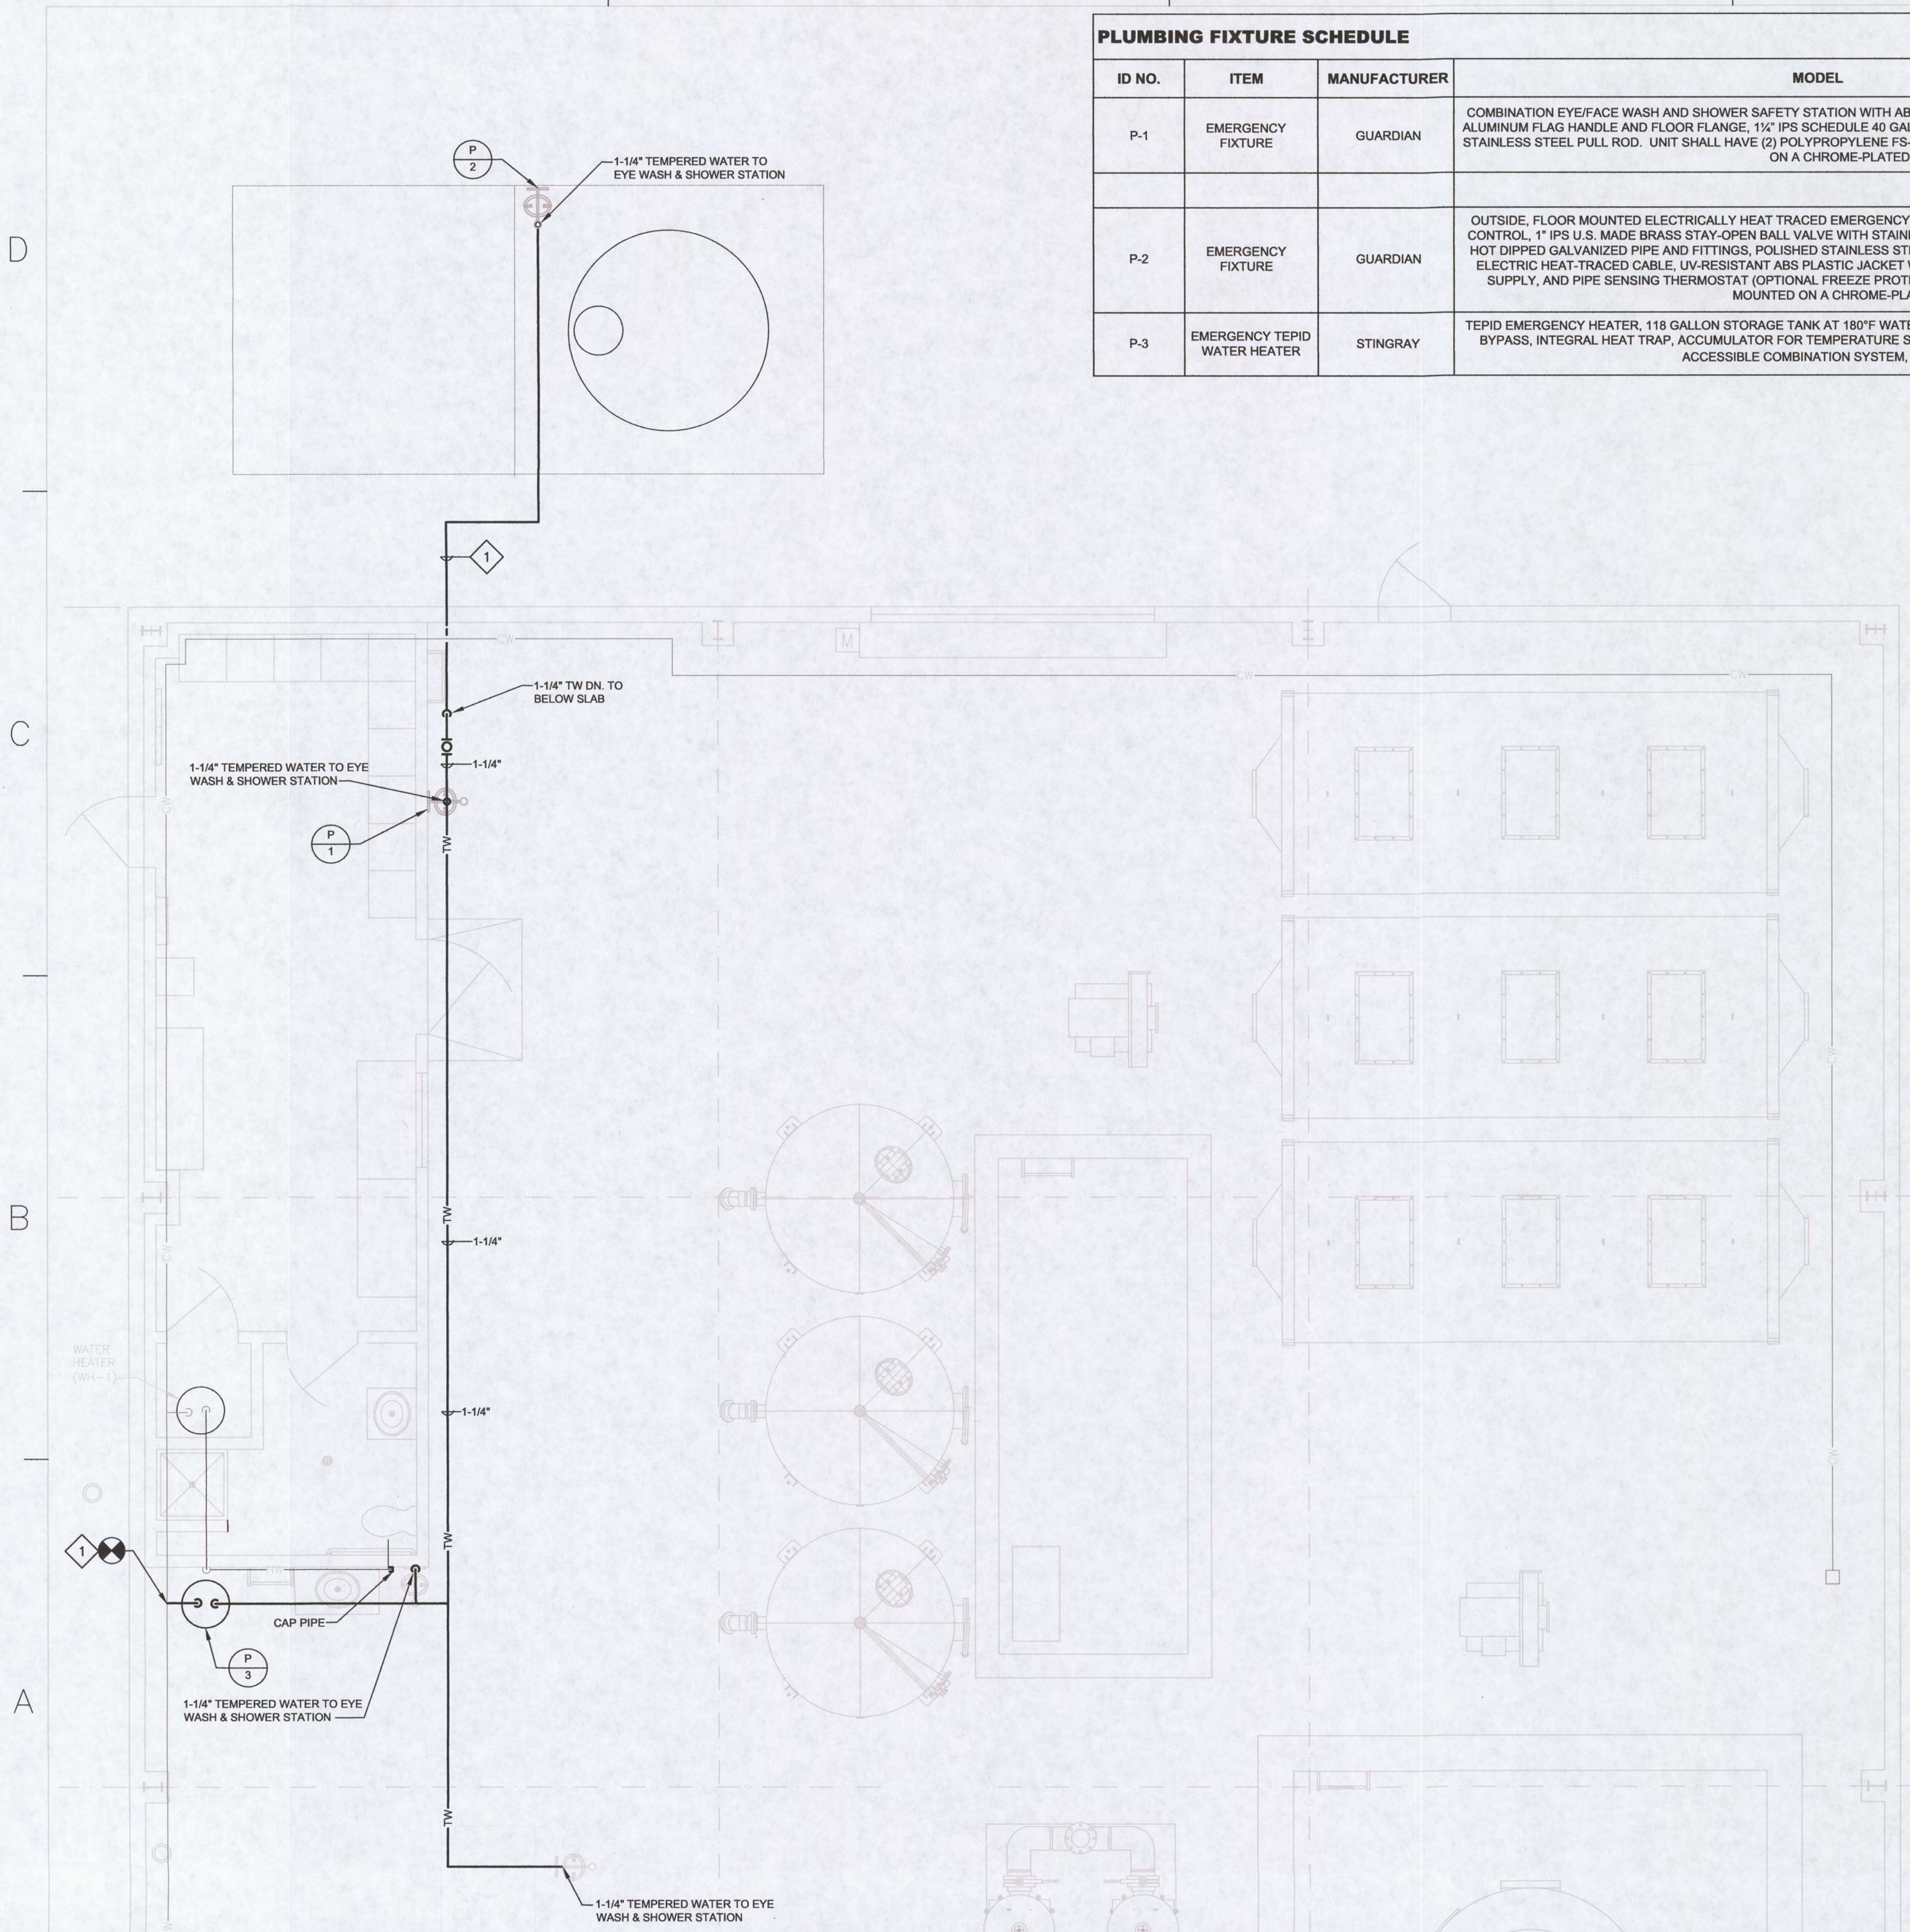

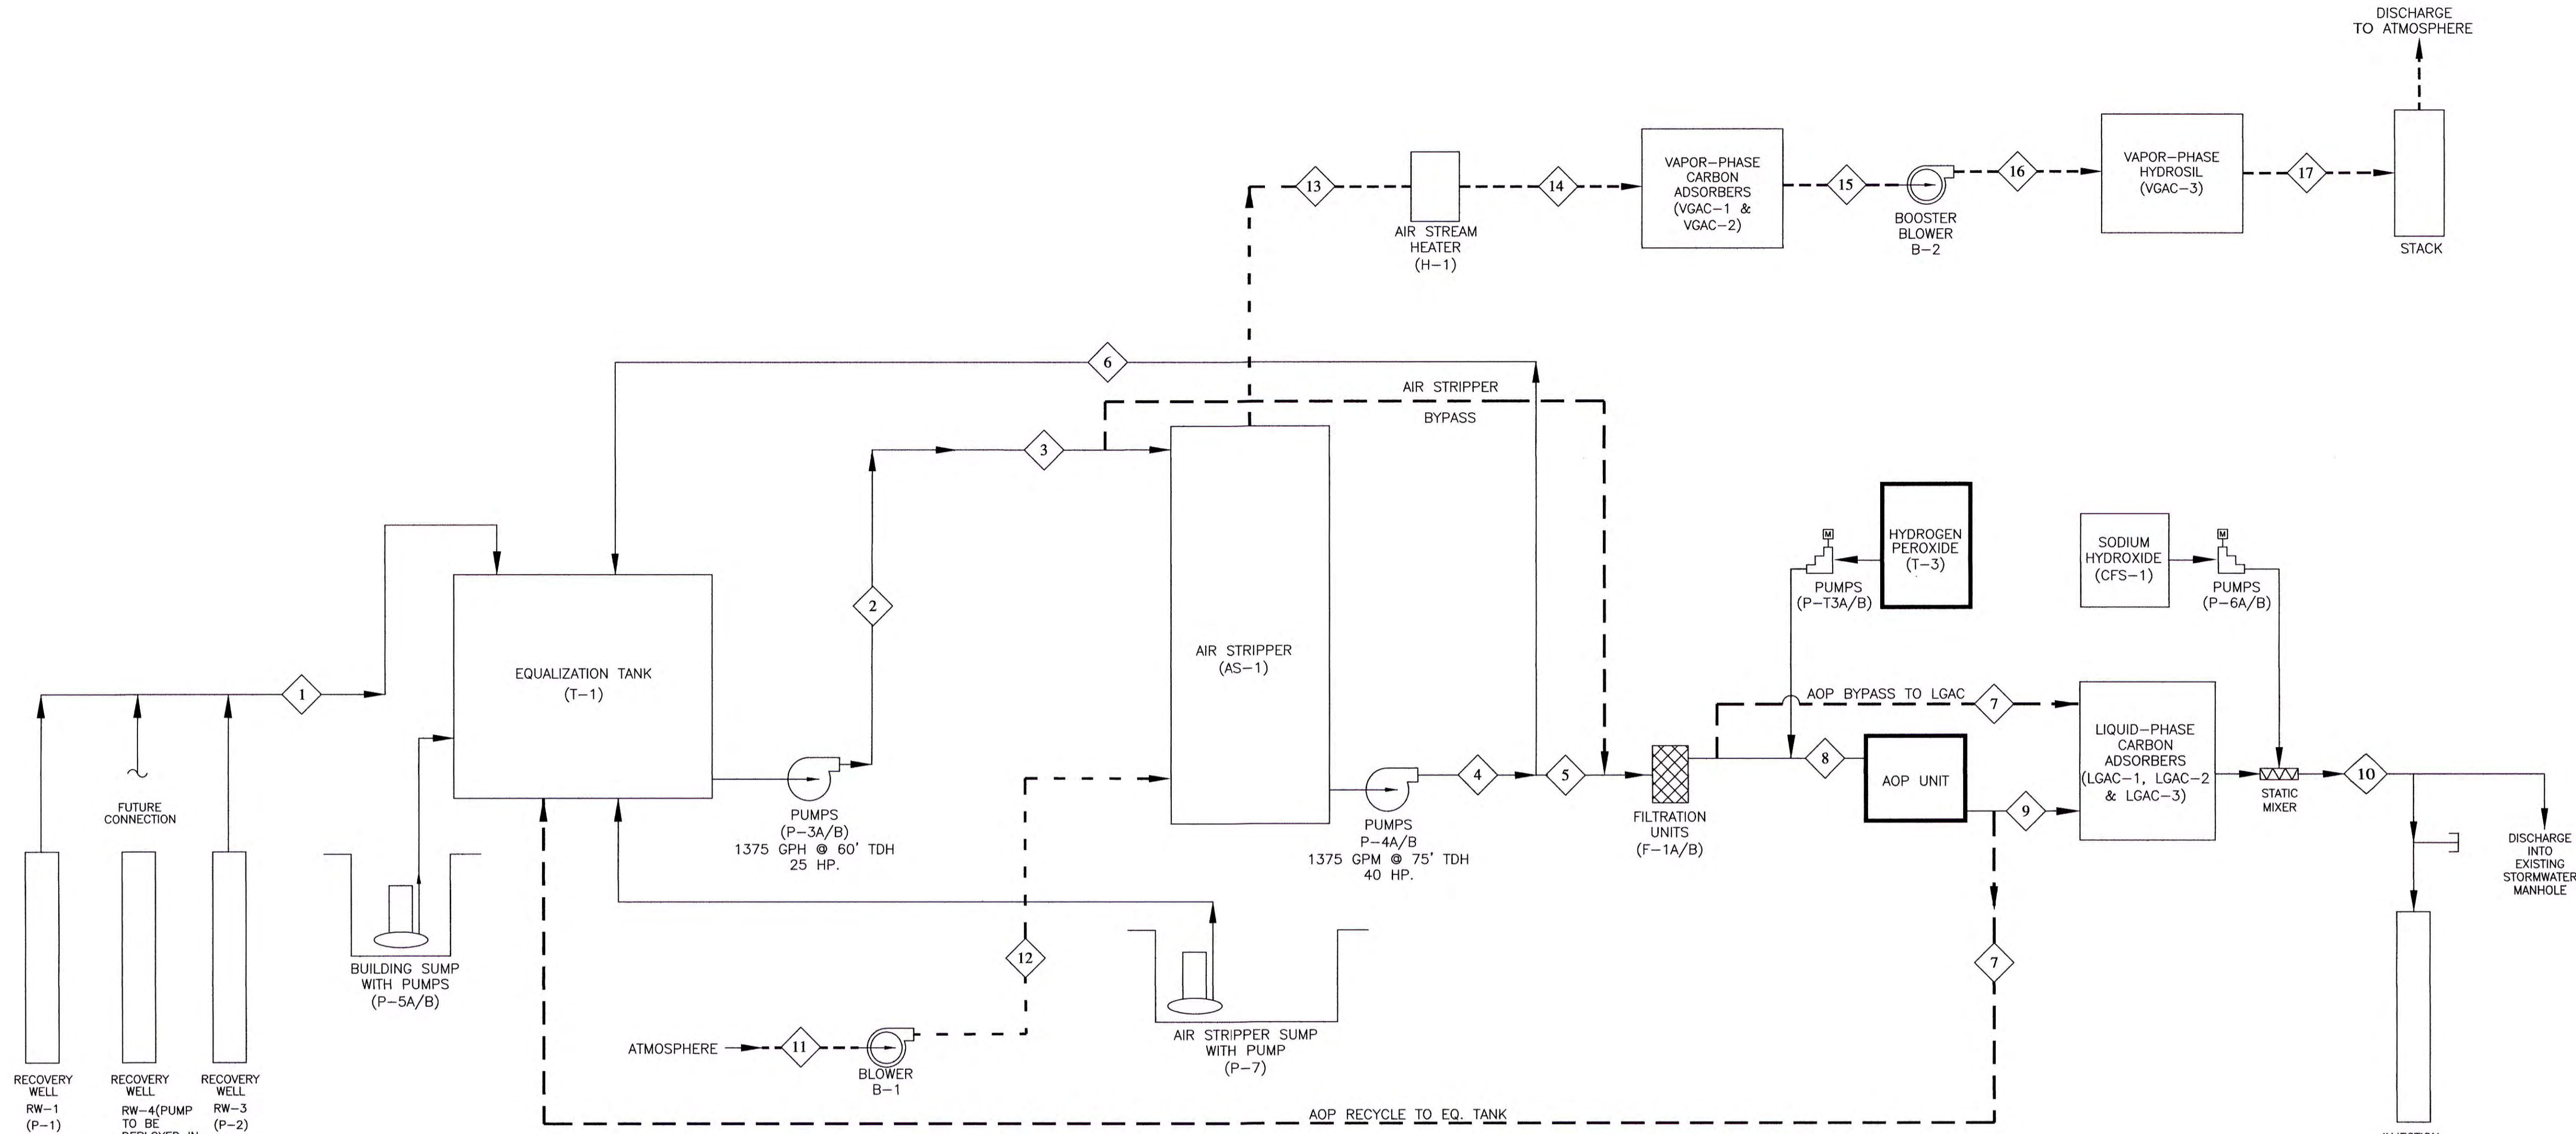

**PROCESS FLOW DIAGRAM**

| STREAM NO. | 1 | 2 | 3 | 4 | 5 | 6 | 7 | 8 | 9 | 10 | 11 | 12 | 13 | 14 | 15 | 16 | 17 |
|------------|---|---|---|---|---|---|---|---|---|----|----|----|----|----|----|----|----|
|------------|---|---|---|---|---|---|---|---|---|----|----|----|----|----|----|----|----|

| COMPOSITION (UG/L, UNLESS OTHERWISE NOTED) | 1       | 2       | 3       | 4       | 5       | 6    | 7    | 8       | 9       | 10      | 11     | 12     | 13     | 14     | 15     | 16     | 17     |
|--|---------|---------|---------|---------|---------|------|------|---------|---------|---------|--------|--------|--------|--------|--------|--------|--------|
| TETRACHLOROETHENE                          | 15.7    | 15.7    | 15.7    | <0.5    | <0.5    | <0.5 | <0.5 | <0.5    | <0.5    | <0.5    |        |        |        |        |        |        |        |
| TRICHLOROETHENE                            | 1,293   | 1,293   | 1,293   | 19.4    | 19.4    | 19.4 | 19.4 | 19.4    | <0.5    | <0.5    |        |        |        |        |        |        |        |
| CIS-1,2-DICHLOROETHENE                     | 7.2     | 7.2     | 7.2     | <0.5    | <0.5    | <0.5 | <0.5 | <0.5    | <0.5    | <0.5    |        |        |        |        |        |        |        |
| TRANS-1,2-DICHLOROETHENE                   | 1       | 1       | 1       | <0.5    | <0.5    | <0.5 | <0.5 | <0.5    | <0.5    | <0.5    |        |        |        |        |        |        |        |
| 1,1-DICHLOROETHENE                         | 3.5     | 3.5     | 3.5     | <0.5    | <0.5    | <0.5 | <0.5 | <0.5    | <0.5    | <0.5    |        |        |        |        |        |        |        |
| VINYL CHLORIDE                             | 0.9     | 0.9     | 0.9     | <0.5    | <0.5    | <0.5 | <0.5 | <0.5    | <0.5    | <0.5    |        |        |        |        |        |        |        |
| 1,1,1-TRICHLOROETHANE                      | 1.1     | 1.1     | 1.1     | <0.5    | <0.5    | <0.5 | <0.5 | <0.5    | <0.5    | <0.5    |        |        |        |        |        |        |        |
| FREON 113                                  | 6.6     | 6.6     | 6.6     | <0.5    | <0.5    | <0.5 | <0.5 | <0.5    | <0.5    | <0.5    |        |        |        |        |        |        |        |
| 1,4-DIOXANE                                | 5       | 5       | 5       | 5       | 5       | 5    | 5    | 5       | 5       | <0.5    | <0.5   |        |        |        |        |        |        |
| 1,1-DICHLOROETHANE                         | 2.2     | 2.2     | 2.2     | <0.5    | <0.5    | <0.5 | <0.5 | <0.5    | <0.5    | <0.5    |        |        |        |        |        |        |        |
| 1,1,2-TRICHLOROETHANE                      | 1.7     | 1.7     | 1.7     | <0.5    | <0.5    | <0.5 | <0.5 | <0.5    | <0.5    | <0.5    |        |        |        |        |        |        |        |
| WATER FLOW RATE (GPM)                      | 1,000   | 1,000   | 1,000   | 1,000   | 1,000   | 0    | 0    | 1,000   | 1,000   | 1,000   |        |        |        |        |        |        |        |
| HYDROGEN PEROXIDE (mg/L)                   | -       | -       | -       | -       | -       | -    | -    | 12      | 10      | <1      |        |        |        |        |        |        |        |
| TEMPERATURE (°F)                           | 55      | 55      | 55      | 55      | 55      | 55   | 55   | 55      | 55      | 55      |        |        |        |        |        |        |        |
| PRESSURE (PSIG)                            |         |         |         |         |         |      |      |         |         |         | -0.27  | 1.5    | 1.36   | 1.18   | 0.53   | 0.53   | 0.53   |
| DENSITY (lb/ft³)                           |         |         |         |         |         |      |      |         |         |         | 0.077  | 0.085  | 0.084  | 0.082  | 0.079  | 0.079  | 0.079  |
| MASS FLOW RATE (lb/hr)                     | 550,500 | 600,545 | 600,545 | 600,545 | 550,500 | 0    | 0    | 550,500 | 550,500 | 550,500 | 36,960 | 40,800 | 40,320 | 39,360 | 37,920 | 37,920 | 37,920 |
| RELATIVE HUMIDITY (%)                      |         |         |         |         |         |      |      |         |         |         | 50     | 50     | 100    | 50     | 50     | 50     | 50     |
| STATIC PRESSURE (PSIA)                     |         |         |         |         |         |      |      |         |         |         | 0.214  | 0.214  | 0.214  | 0.275  | 0.275  | 0.275  | 0.275  |
| pH (S.U.)                                  | 5.5     | 5.5     | 5.5     | 6.5     | 6.5     | 6.5  | 6.5  | 6.5     | 6.5     | 6.5     |        |        |        |        |        |        |        |
| VAPOR FLOW RATE (CFM)                      |         |         |         |         |         |      |      |         |         |         | 8,000  | 8,000  | 8,000  | 8,000  | 8,000  | 8,000  | 8,000  |
| TOTAL VAPOR VOC (PPMV)                     |         |         |         |         |         |      |      |         |         |         |        |        |        |        | 25.5   | 25.5   | 1.2    |
| TOTAL VAPOR VOC (LBS/HR)                   |         |         |         |         |         |      |      |         |         |         |        |        |        |        | 3.18   | 3.18   | 0.15   |



|                |     |    |     |
|----------------|-----|----|-----|
| DES            | HKM | DR | SNL |
| REVIEWED BY    | HKM |    |     |
| PM/DM          | HKM |    |     |
| CHIEF ENG/ARCH | HKM |    |     |


DEPARTMENT OF THE NAVY  
 NAVAL FACILITIES ENGINEERING COMMAND  
 NAVAL FACILITIES ENGINEERING COMMAND ~ MID-ATLANTIC  
 NAVAL INDUSTRIAL RESERVE ORDNANCE PLANT  
 GM-38 AREA  
 GROUNDWATER TREATMENT PLANT  
 AOP SYSTEM ADDITION  
 PROCESS FLOW DIAGRAM

|  |                              |        |
|--|------------------------------|--------|
| THIS DRAWING PRODUCED ON AUTOCAD<br>DO NOT REVISE MANUALLY | CODE ID. NO. 80091           | SIZE D |
| SCALE: NTS   | MAXIMO NO. N62470-08-D-1001  |        |
|  | JOB ORDER NO. WE-24          |        |
|  | SPEC. NO.                    |        |
|  | CONSTR. CONTR. NO. 112G08005 |        |
|  | NAVFAC DRAWING NO.           |        |
|  | SHEET                        | OF     |
|  | <b>PFD-100</b>               |        |

ISSUED FOR BID - 06/21/2019  
 CAUTION: IF SHEET IS LESS THAN 34"x22" USE GRAPHIC SCALE

IT IS A VIOLATION OF THE NEW YORK STATE EDUCATION LAW, ARTICLE 145, FOR ANY PERSON, UNLESS UNDER THE DIRECTION OF A NEW YORK STATE LICENSED PROFESSIONAL ENGINEER, TO ALTER AN ITEM ON THIS DOCUMENT IN ANY WAY.

- NOTES:**
- LEVEL TRANSMITTER AND PH PROBE ARE LOCATED IN STILLING WELLS.
  - FLOWMETERS HAVE STRAIGHT PIPE RUN OF 5 PIPE DIAMETERS UPSTREAM AND 3 PIPE DIAMETERS DOWNSTREAM OF ANY FLOW DISTURBANCES.
  - ALL PVC PIPING IS SCHEDULE 80 UNLESS OTHERWISE NOTED.
  - PRESSURE INDICATORS FOR LIQUID SERVICE INCLUDE GAUGE GUARDS, SNUBBERS, GLYCERIN FILL AND READ IN PSI.
  - END TERMINATIONS WERE USED TO SEAL SECONDARY CONTAINMENT PIPING AT THE ENDS OF THE PIPING RUNS.

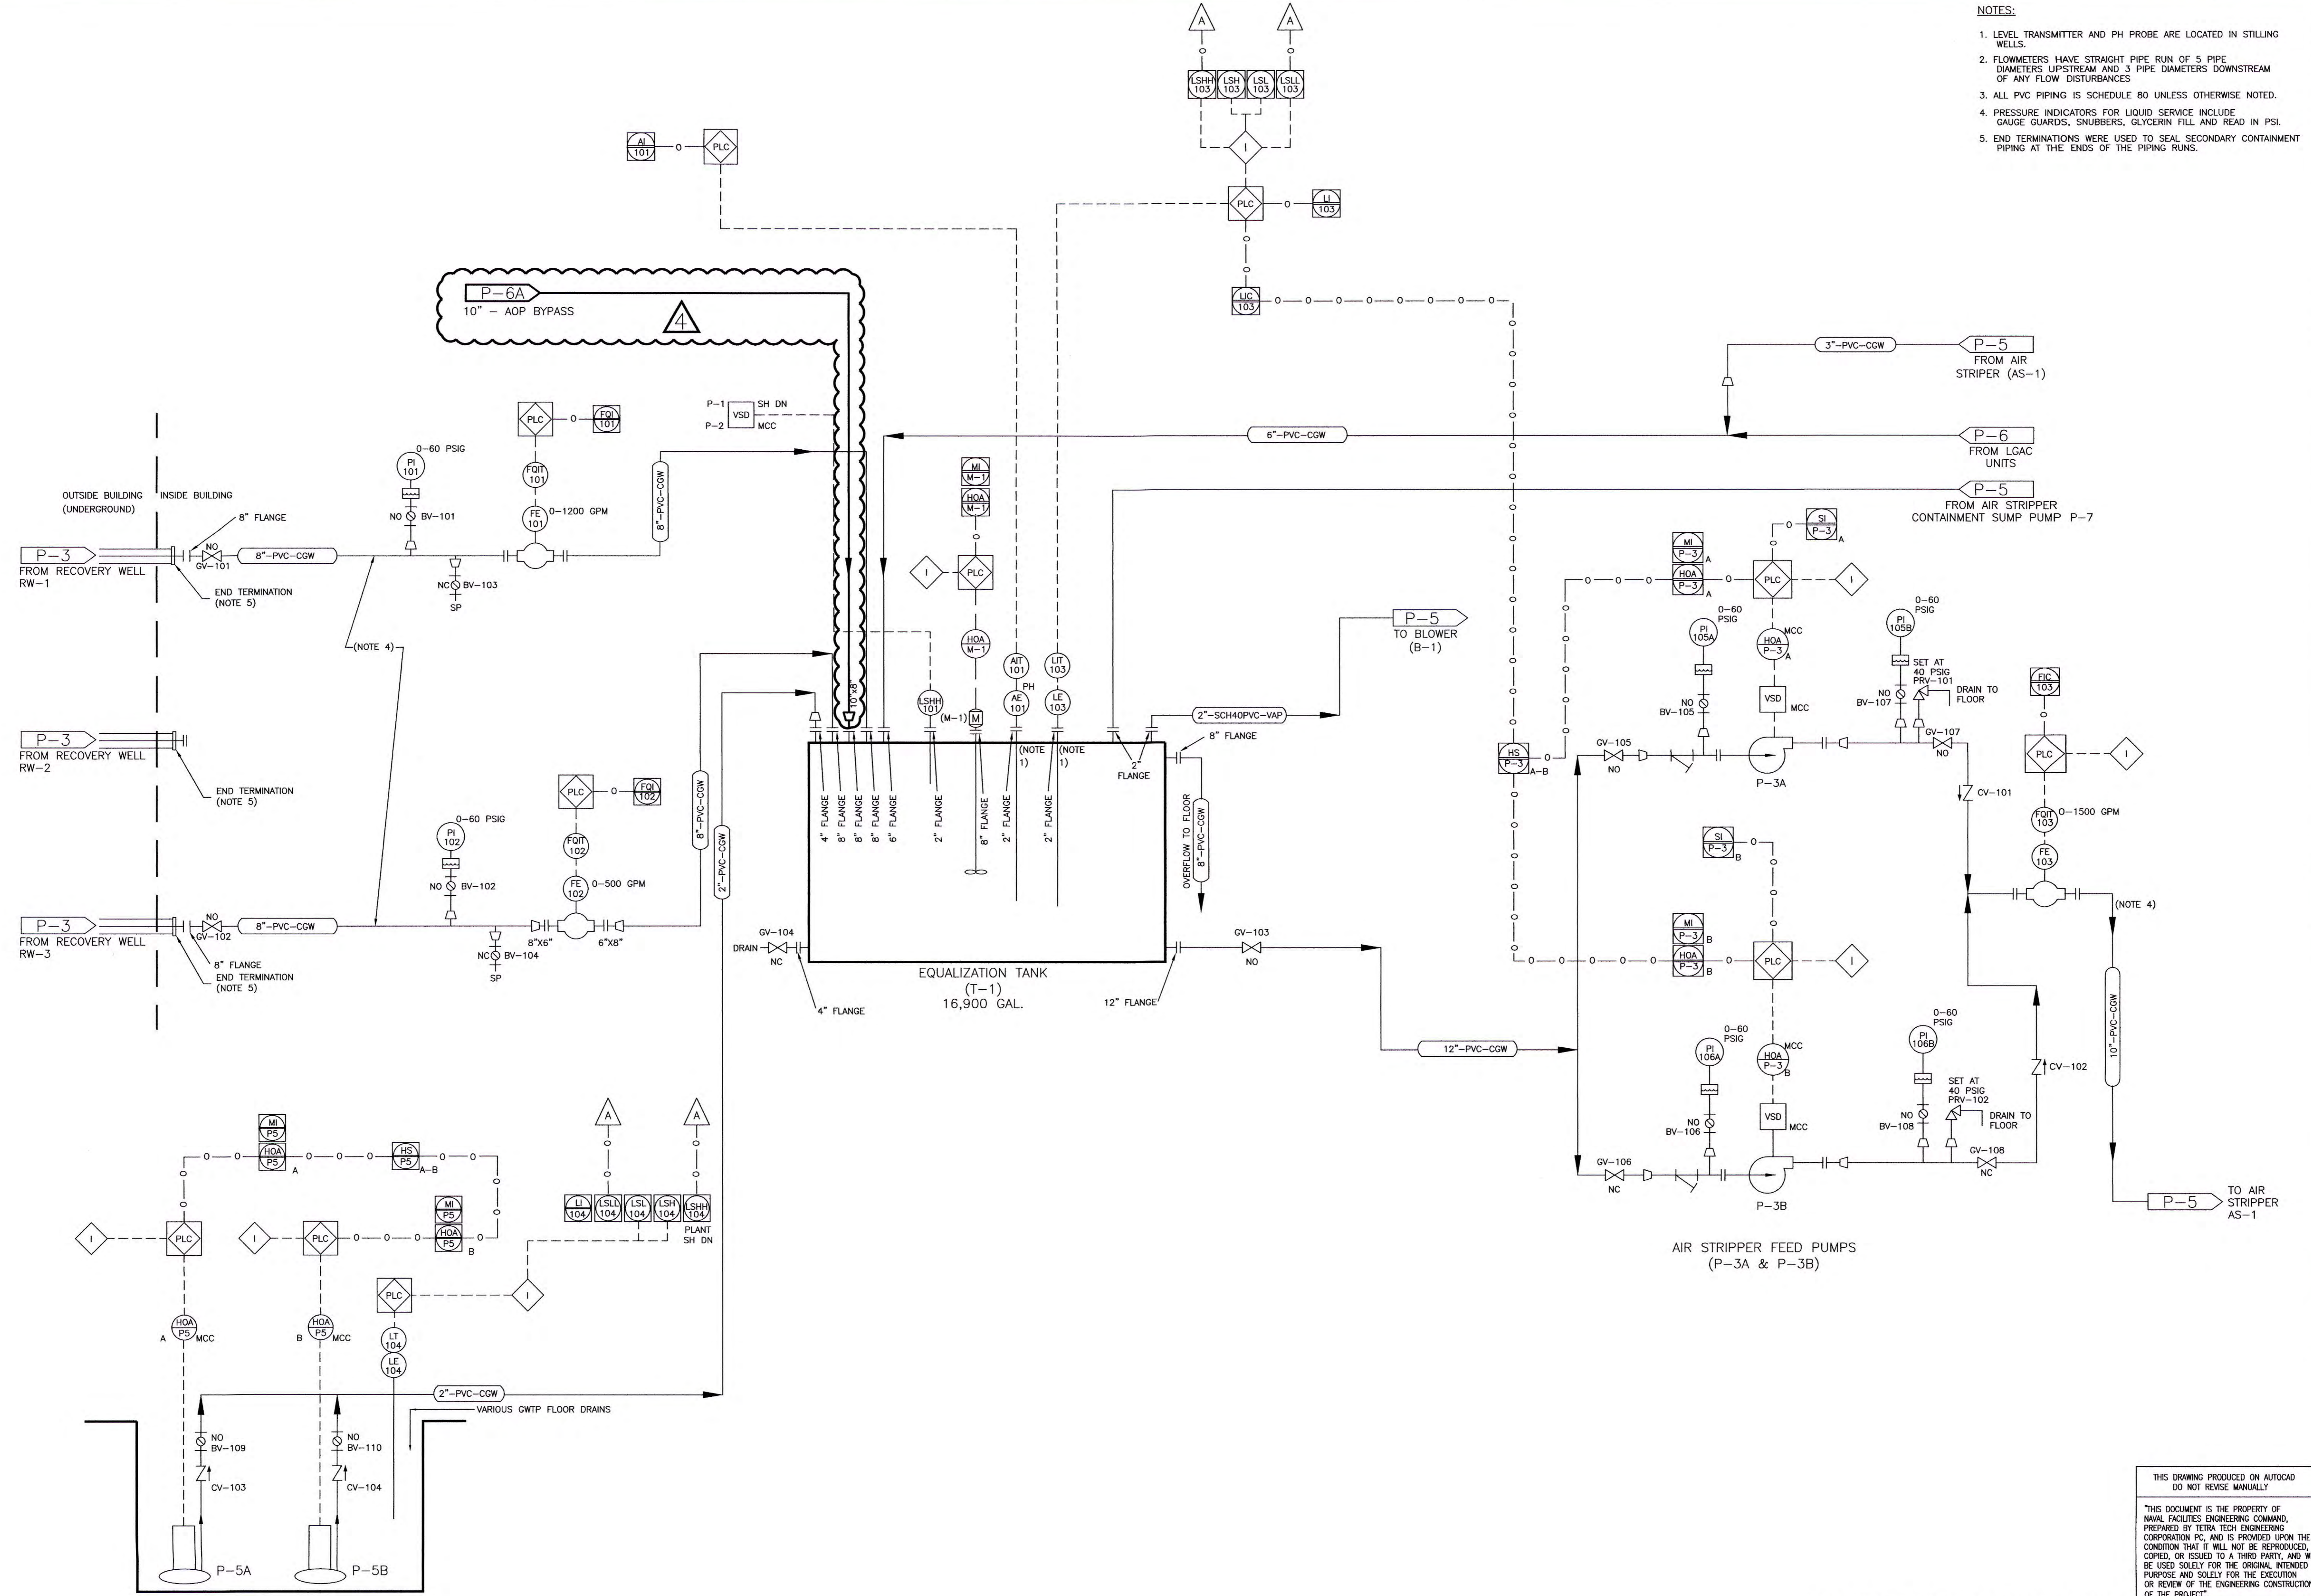


|  |   |   |   |
|--|---|---|---|
| <p>DEPARTMENT OF THE NAVY<br/> <b>NAVAL FACILITIES ENGINEERING COMMAND, MID-ATLANTIC</b><br/>         NAVAL WEAPONS INDUSTRIAL RESERVE PLANT<br/>         GM-38 AREA<br/>         GROUNDWATER TREATMENT PLANT<br/>         PIPING AND INSTRUMENTATION DIAGRAM (SHEET 2 OF 5)</p> |   | <p>APPROVED<br/> </p>   | <p>DATE<br/>         05/05/06</p>   |
| <p>FOR COMMANDER, NAVFAC MID-ATLANTIC</p>  | <p>DESCRIPTION<br/>         ADDED RECOVERY WELL RW-3 AND PIPING;<br/>         DELETED TERMINATION VALVE SUBSTITUTIONS;<br/>         DRAWING UPDATES FOR CONSTRUCTION.</p> | <p>REV<br/>         0<br/>         1<br/>         2<br/>         3<br/>         4</p>               | <p>DATE<br/>         05/05/06<br/>         03/31/08<br/>         02/24/09<br/>         04/16/10<br/>         06/21/19</p> |
| <p>NAVAL FACILITIES ENGINEERING CORPORATION PC</p>   | <p>PREP BY<br/>         DL<br/>         TAD<br/>         DIL<br/>         SNL</p>   | <p>APPROVD<br/>         BKB<br/>         BKB<br/>         BKB<br/>         SGP<br/>         HKM</p> | <p>DATE<br/>         05/05/06<br/>         03/31/08<br/>         02/24/09<br/>         04/16/10<br/>         06/21/19</p> |

THIS DRAWING PRODUCED ON AUTOCAD DO NOT REVISE MANUALLY

THIS DOCUMENT IS THE PROPERTY OF NAVAL FACILITIES ENGINEERING CORPORATION PC, AND IS PROVIDED UPON THE CONDITION THAT IT WILL NOT BE REPRODUCED, COPIED, OR ISSUED TO A THIRD PARTY, AND WILL BE USED SOLELY FOR THE ORIGINAL INTENDED PURPOSE AND SOLELY FOR THE EXECUTION OR REVIEW OF THE ENGINEERING CONSTRUCTION OF THE PROJECT.

IT IS A VIOLATION OF THE NEW YORK STATE EDUCATION LAW, ARTICLE 145, FOR ANY PERSON, UNLESS UNDER THE DIRECTION OF A NEW YORK STATE LICENSED PROFESSIONAL ENGINEER, TO ALTER AN ITEM ON THIS DOCUMENT IN ANY WAY.

ISSUED FOR BID - 06/21/2019

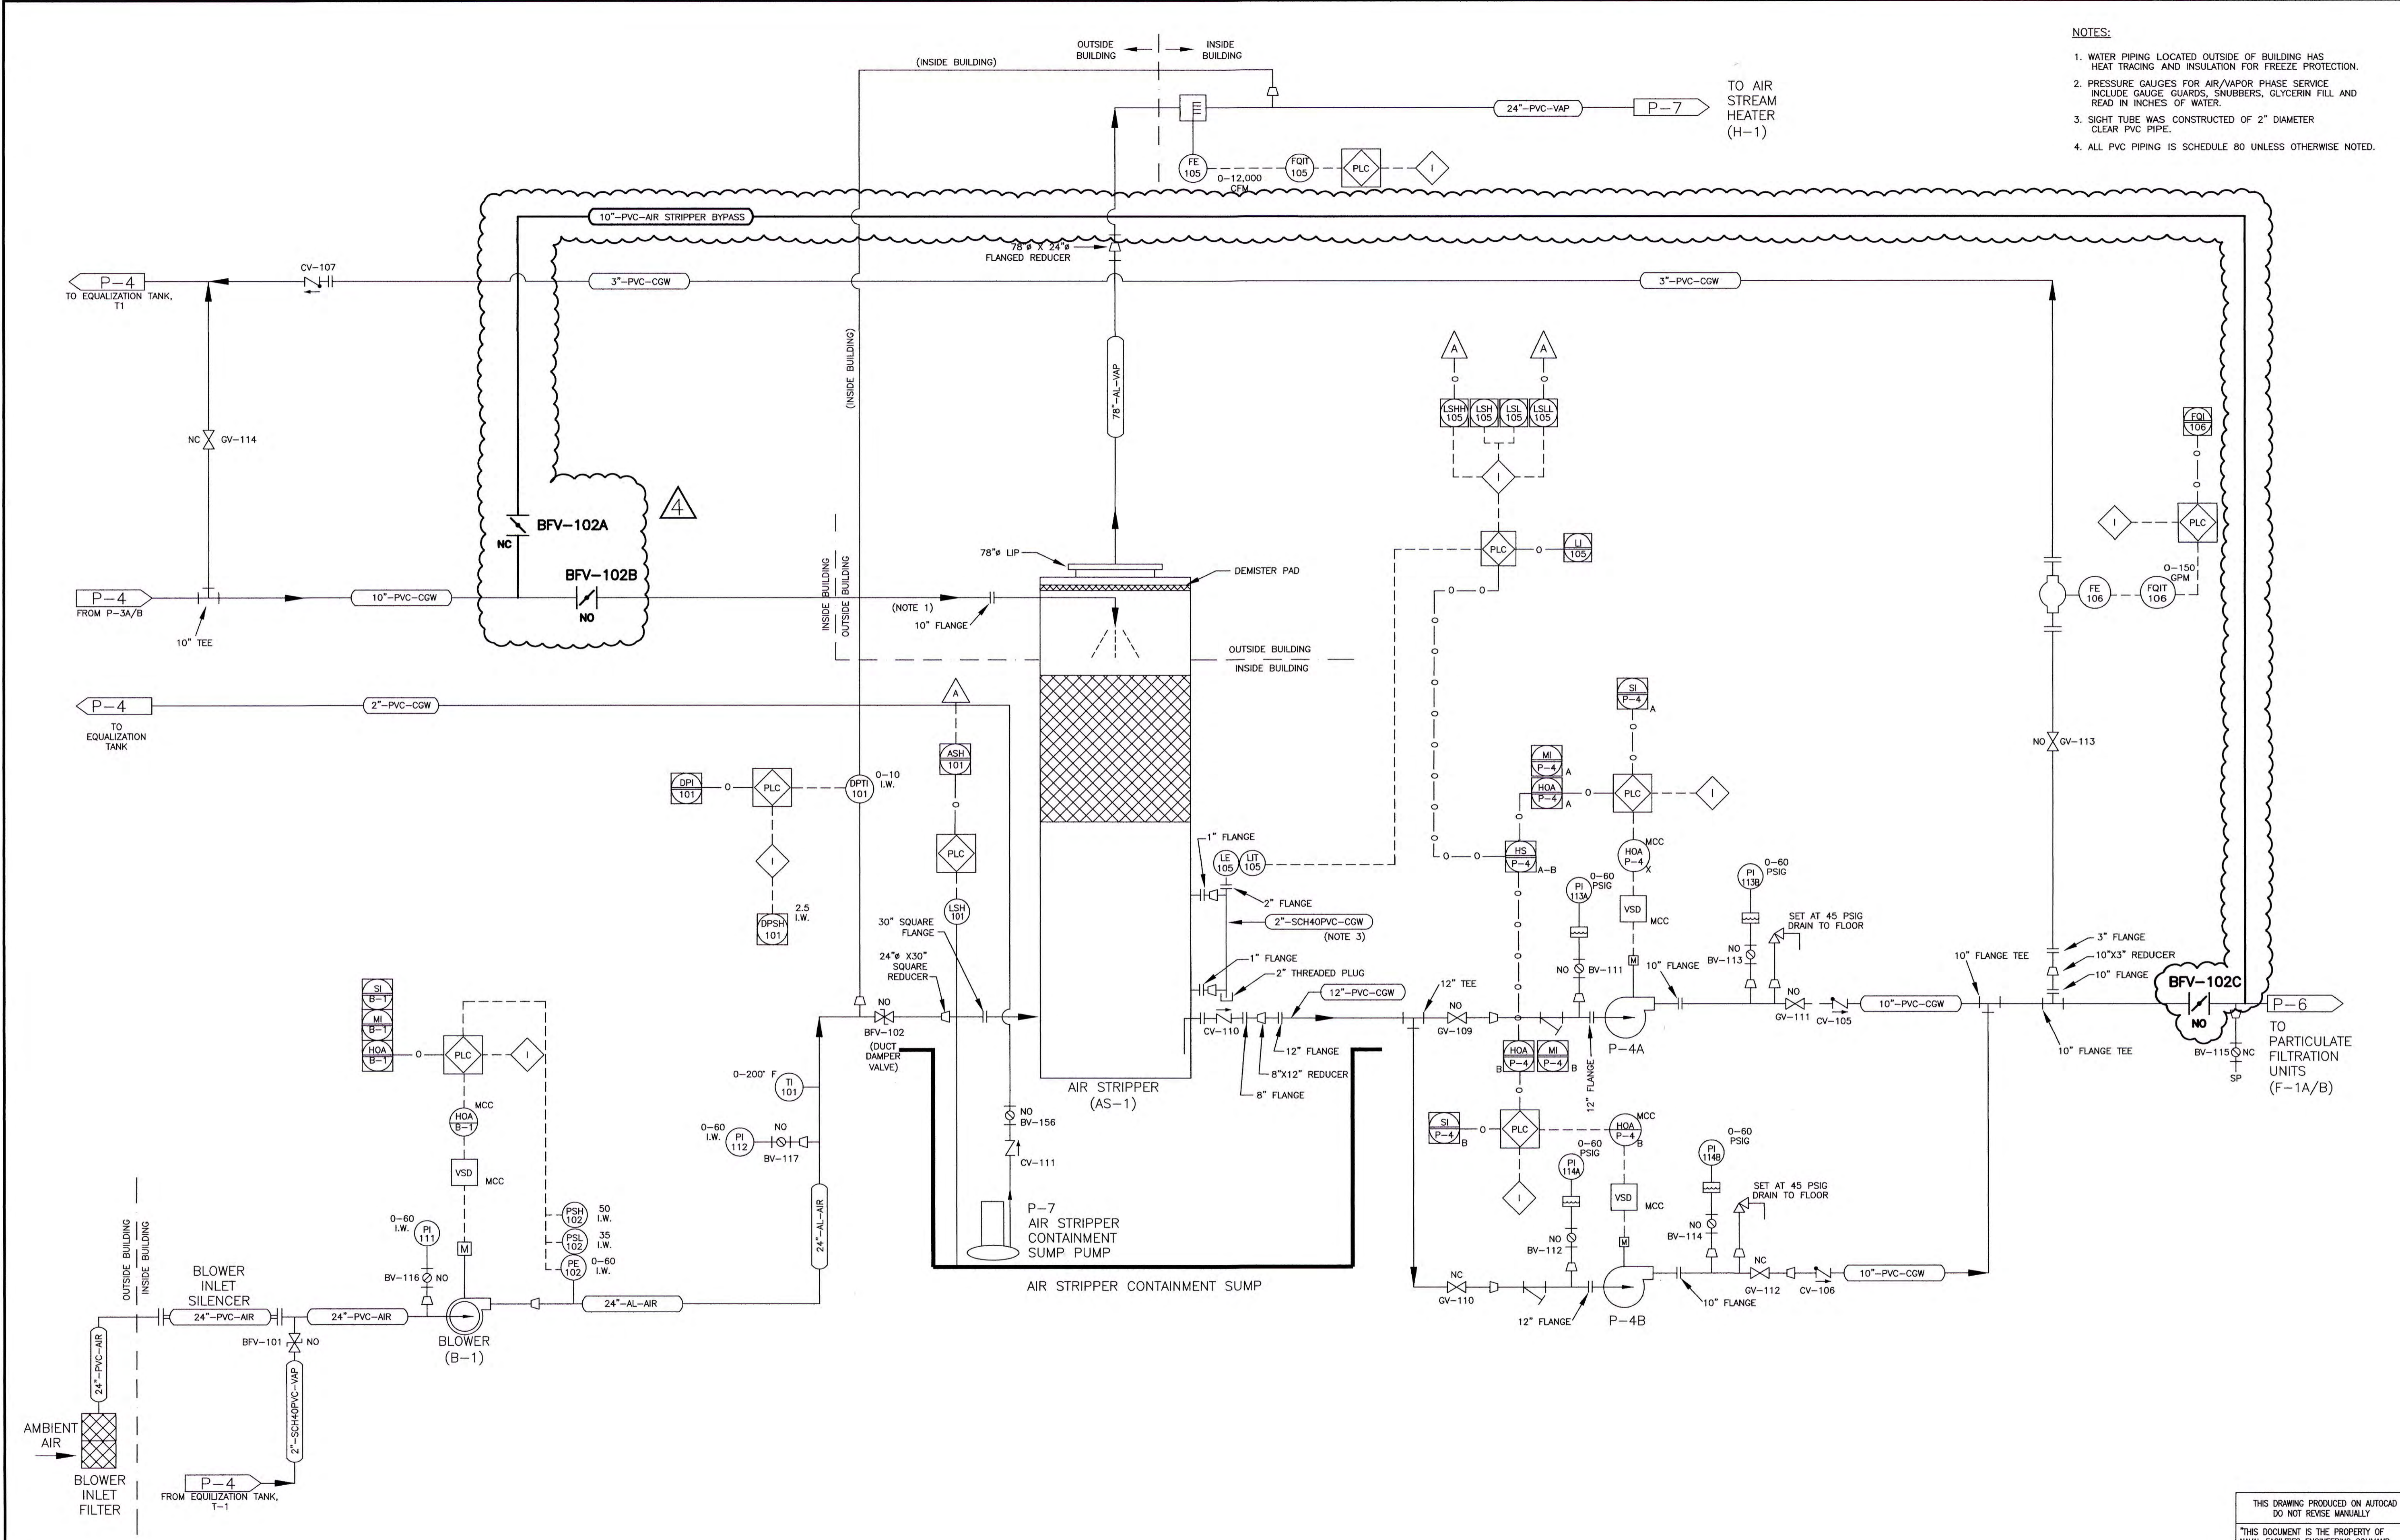

- NOTES:**
1. WATER PIPING LOCATED OUTSIDE OF BUILDING HAS HEAT TRACING AND INSULATION FOR FREEZE PROTECTION.
  2. PRESSURE GAUGES FOR AIR/VAPOR PHASE SERVICE INCLUDE GAUGE GUARDS, SNUBBERS, GLYCERIN FILL AND READ IN INCHES OF WATER.
  3. SIGHT TUBE WAS CONSTRUCTED OF 2" DIAMETER CLEAR PVC PIPE.
  4. ALL PVC PIPING IS SCHEDULE 80 UNLESS OTHERWISE NOTED.

|   |  |  |          |
|---|--|--|----------|
| DEPARTMENT OF THE NAVY<br><b>NAVAL FACILITIES ENGINEERING COMMAND, MID-ATLANTIC</b><br>NAVAL WEAPONS INDUSTRIAL RESERVE PLANT<br>GM-38 AREA<br>GROUNDWATER TREATMENT PLANT<br>PIPING AND INSTRUMENTATION DIAGRAM (SHEET 3 OF 5) |  | TETRA TECH ENGINEERING CORPORATION PC<br>APPROVED: [Signature]<br>DATE: 06/21/19 |          |
| REV   | DESCRIPTION  | DATE   | APPROVED |
| 0   | FINAL DESIGN   | 05/05/06   | BKB      |
| 1   | REVISED BASED ON VENDOR SUBMITTALS, DRAWING UPDATES FOR CONSTRUCTION | 02/25/09   | BKB      |
| 2   | FINAL RECORD DRAWING   | 04/16/10   | SGP      |
| 4   | ACP SYSTEM ADDITION  | 06/21/19   | HKM      |


THIS DRAWING PRODUCED ON AUTOCAD DO NOT REVISE MANUALLY

THIS DOCUMENT IS THE PROPERTY OF NAVAL FACILITIES ENGINEERING COMMAND, PREPARED BY TETRA TECH ENGINEERING CORPORATION PC, AND IS PROVIDED UPON THE CONDITION THAT IT WILL NOT BE REPRODUCED, COPIED, OR ISSUED TO A THIRD PARTY, AND WILL BE USED SOLELY FOR THE ORIGINAL INTENDED PURPOSE AND SOLELY FOR THE EXECUTION OR REVIEW OF THE ENGINEERING CONSTRUCTION OF THE PROJECT.

IT IS A VIOLATION OF THE NEW YORK STATE EDUCATION LAW, ARTICLE 145, FOR ANY PERSON, UNLESS UNDER THE DIRECTION OF A NEW YORK STATE LICENSED PROFESSIONAL ENGINEER, TO ALTER AN ITEM ON THIS DOCUMENT IN ANY WAY.

ISSUED FOR BID - 06/21/2019

|                    |                  |
|--------------------|------------------|
| SAT TO             | DATE             |
| CODE I.D. NO.      | 80091            |
| SCALE              | AS SHOWN         |
| SPEC. NO.          |                  |
| CONSTR. CONTR. NO. | N62472-99-D-0032 |
| NAVFAC DRAWING NO. |                  |
| SHEET              | OF               |
| D                  | P-5              |

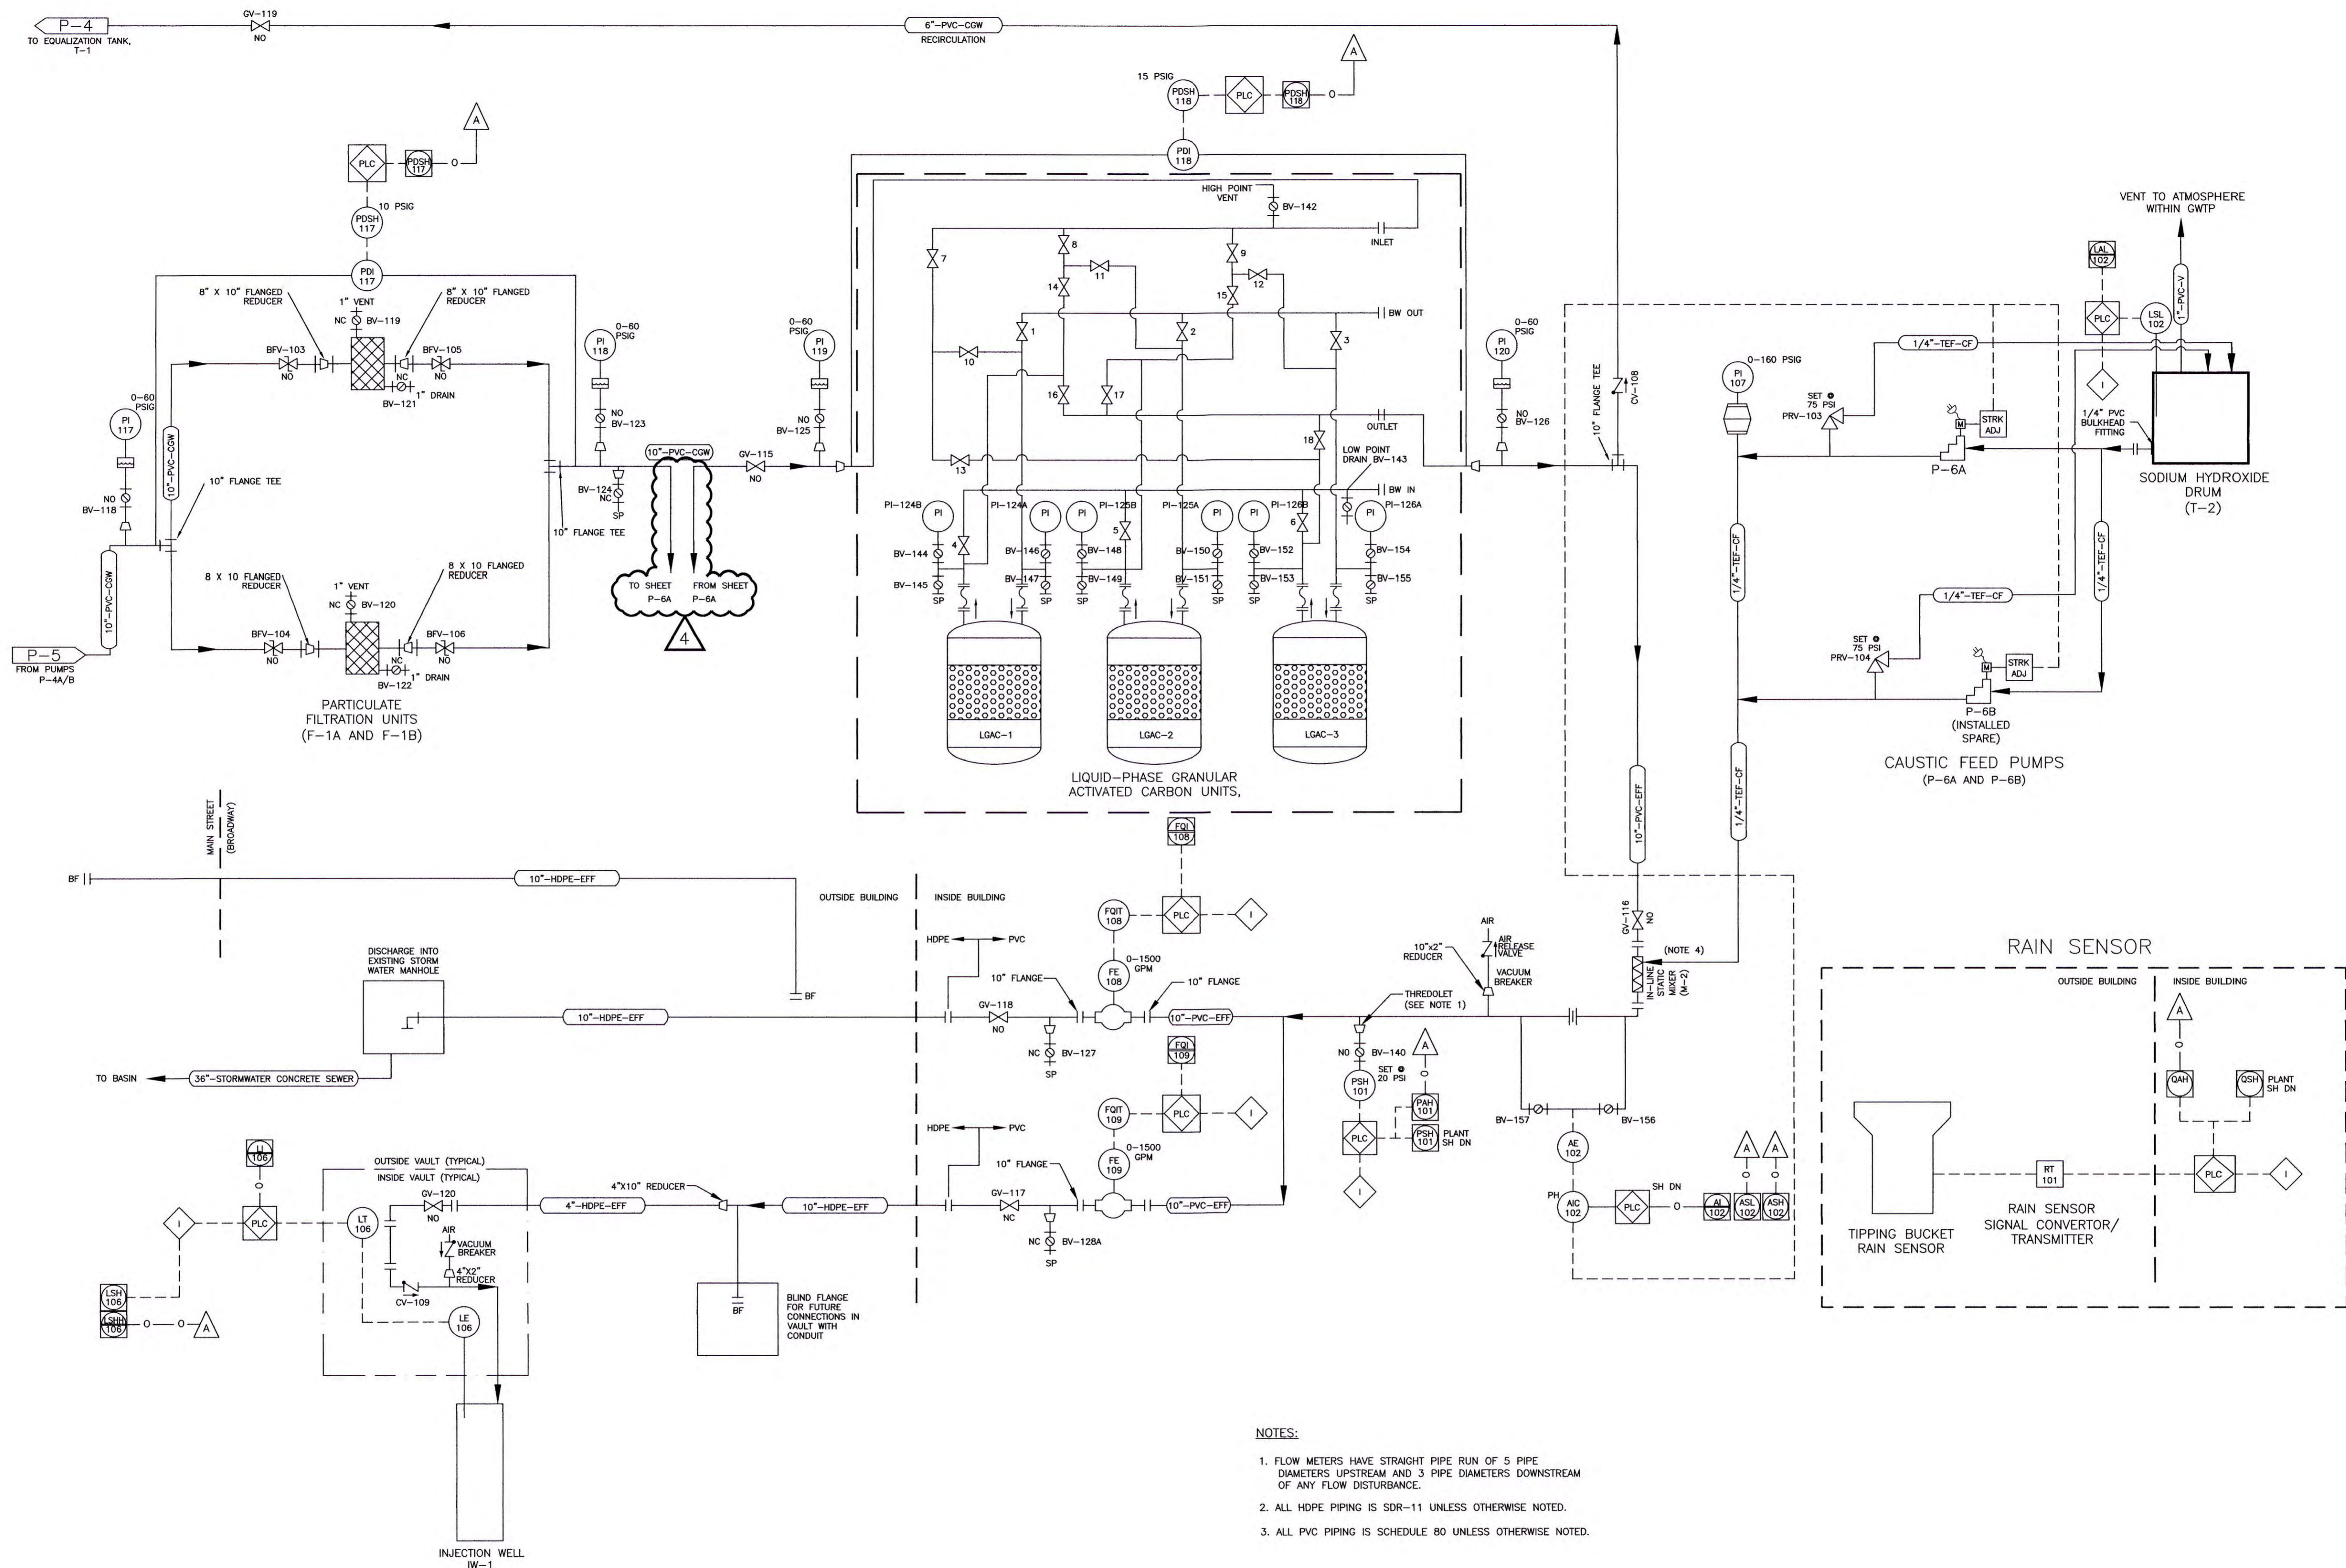

- NOTES:
1. FLOW METERS HAVE STRAIGHT PIPE RUN OF 5 PIPE DIAMETERS UPSTREAM AND 3 PIPE DIAMETERS DOWNSTREAM OF ANY FLOW DISTURBANCE.
  2. ALL HDPE PIPING IS SDR-11 UNLESS OTHERWISE NOTED.
  3. ALL PVC PIPING IS SCHEDULE 80 UNLESS OTHERWISE NOTED.

|                                       |   |          |          |          |     |
|---------------------------------------|---|----------|----------|----------|-----|
| TETRA TECH ENGINEERING CORPORATION PC |   | DATE     | 05/05/06 | APPROVED | DL  |
| DR                                    | CHK   | DATE     | 03/31/06 | APPROVED | DLB |
| DESIGNED BY                           | CHK   | DATE     | 02/12/09 | APPROVED | DLB |
| DRAWN BY                              | CHK   | DATE     | 04/16/10 | APPROVED | DLB |
| PROJECT NO.                           | CHK   | DATE     | 06/21/19 | APPROVED | SNL |
| OFFICE IN CHARGE                      | CHK   | DATE     |          | APPROVED | HKM |
| PROJECT NAME                          | CHK   | DATE     |          | APPROVED |     |
| DESCRIPTION                           | CHK   | DATE     |          | APPROVED |     |
| REV                                   | DESCRIPTION   | DATE     |          |          |     |
| 0                                     | FINAL DESIGN  | 05/05/06 |          |          |     |
| 1                                     | DELETED TERMINATION VALVE AND ASSOCIATED PIPING AND FITTINGS NOT TO BE CHANGED. | 03/31/06 |          |          |     |
| 2                                     | DRAWING UPDATES FOR CONSTRUCTION.   | 02/12/09 |          |          |     |
| 3                                     | FINAL RECORD DRAWING  | 04/16/10 |          |          |     |
| 4                                     | AOP SYSTEM ADDITION   | 06/21/19 |          |          |     |

NAVAL FACILITIES ENGINEERING COMMAND, MID-ATLANTIC  
 NAVAL WEAPONS INDUSTRIAL RESERVE PLANT  
 GM-38 AREA  
 GROUNDWATER TREATMENT PLANT  
 PIPING AND INSTRUMENTATION DIAGRAM (SHEET 4 OF 5)

FOR COMMANDER, NAVFAC MID-ATLANTIC

DATE

6-21-19

THIS DRAWING PRODUCED ON AUTOCAD DO NOT REVISE MANUALLY

THIS DOCUMENT IS THE PROPERTY OF NAVAL FACILITIES ENGINEERING COMMAND, PREPARED BY TETRA TECH ENGINEERING CORPORATION PC, AND IS PROVIDED UPON THE CONDITION THAT IT WILL NOT BE REPRODUCED, COPIED, OR ISSUED TO A THIRD PARTY, AND WILL BE USED SOLELY FOR THE ORIGINAL INTENDED PURPOSE AND SOLELY FOR THE EXECUTION OR REVIEW OF THE ENGINEERING CONSTRUCTION OF THE PROJECT.

IT IS A VIOLATION OF THE NEW YORK STATE EDUCATION LAW, ARTICLE 145, FOR ANY PERSON, UNLESS UNDER THE DIRECTION OF A NEW YORK STATE LICENSED PROFESSIONAL ENGINEER, TO ALTER AN ITEM ON THIS DOCUMENT IN ANY WAY.

SAT TO: DATE: 05/05/06

CODE ID. NO.: 80091

SCALE: AS SHOWN


SPEC. NO.:

CONSTR. CONTR. NO.: N62472-99-D-0032

NAVFAC DRAWING NO.:

SHEET OF: DIS. SH. NO. P-6

ISSUED FOR BID - 06/21/2019

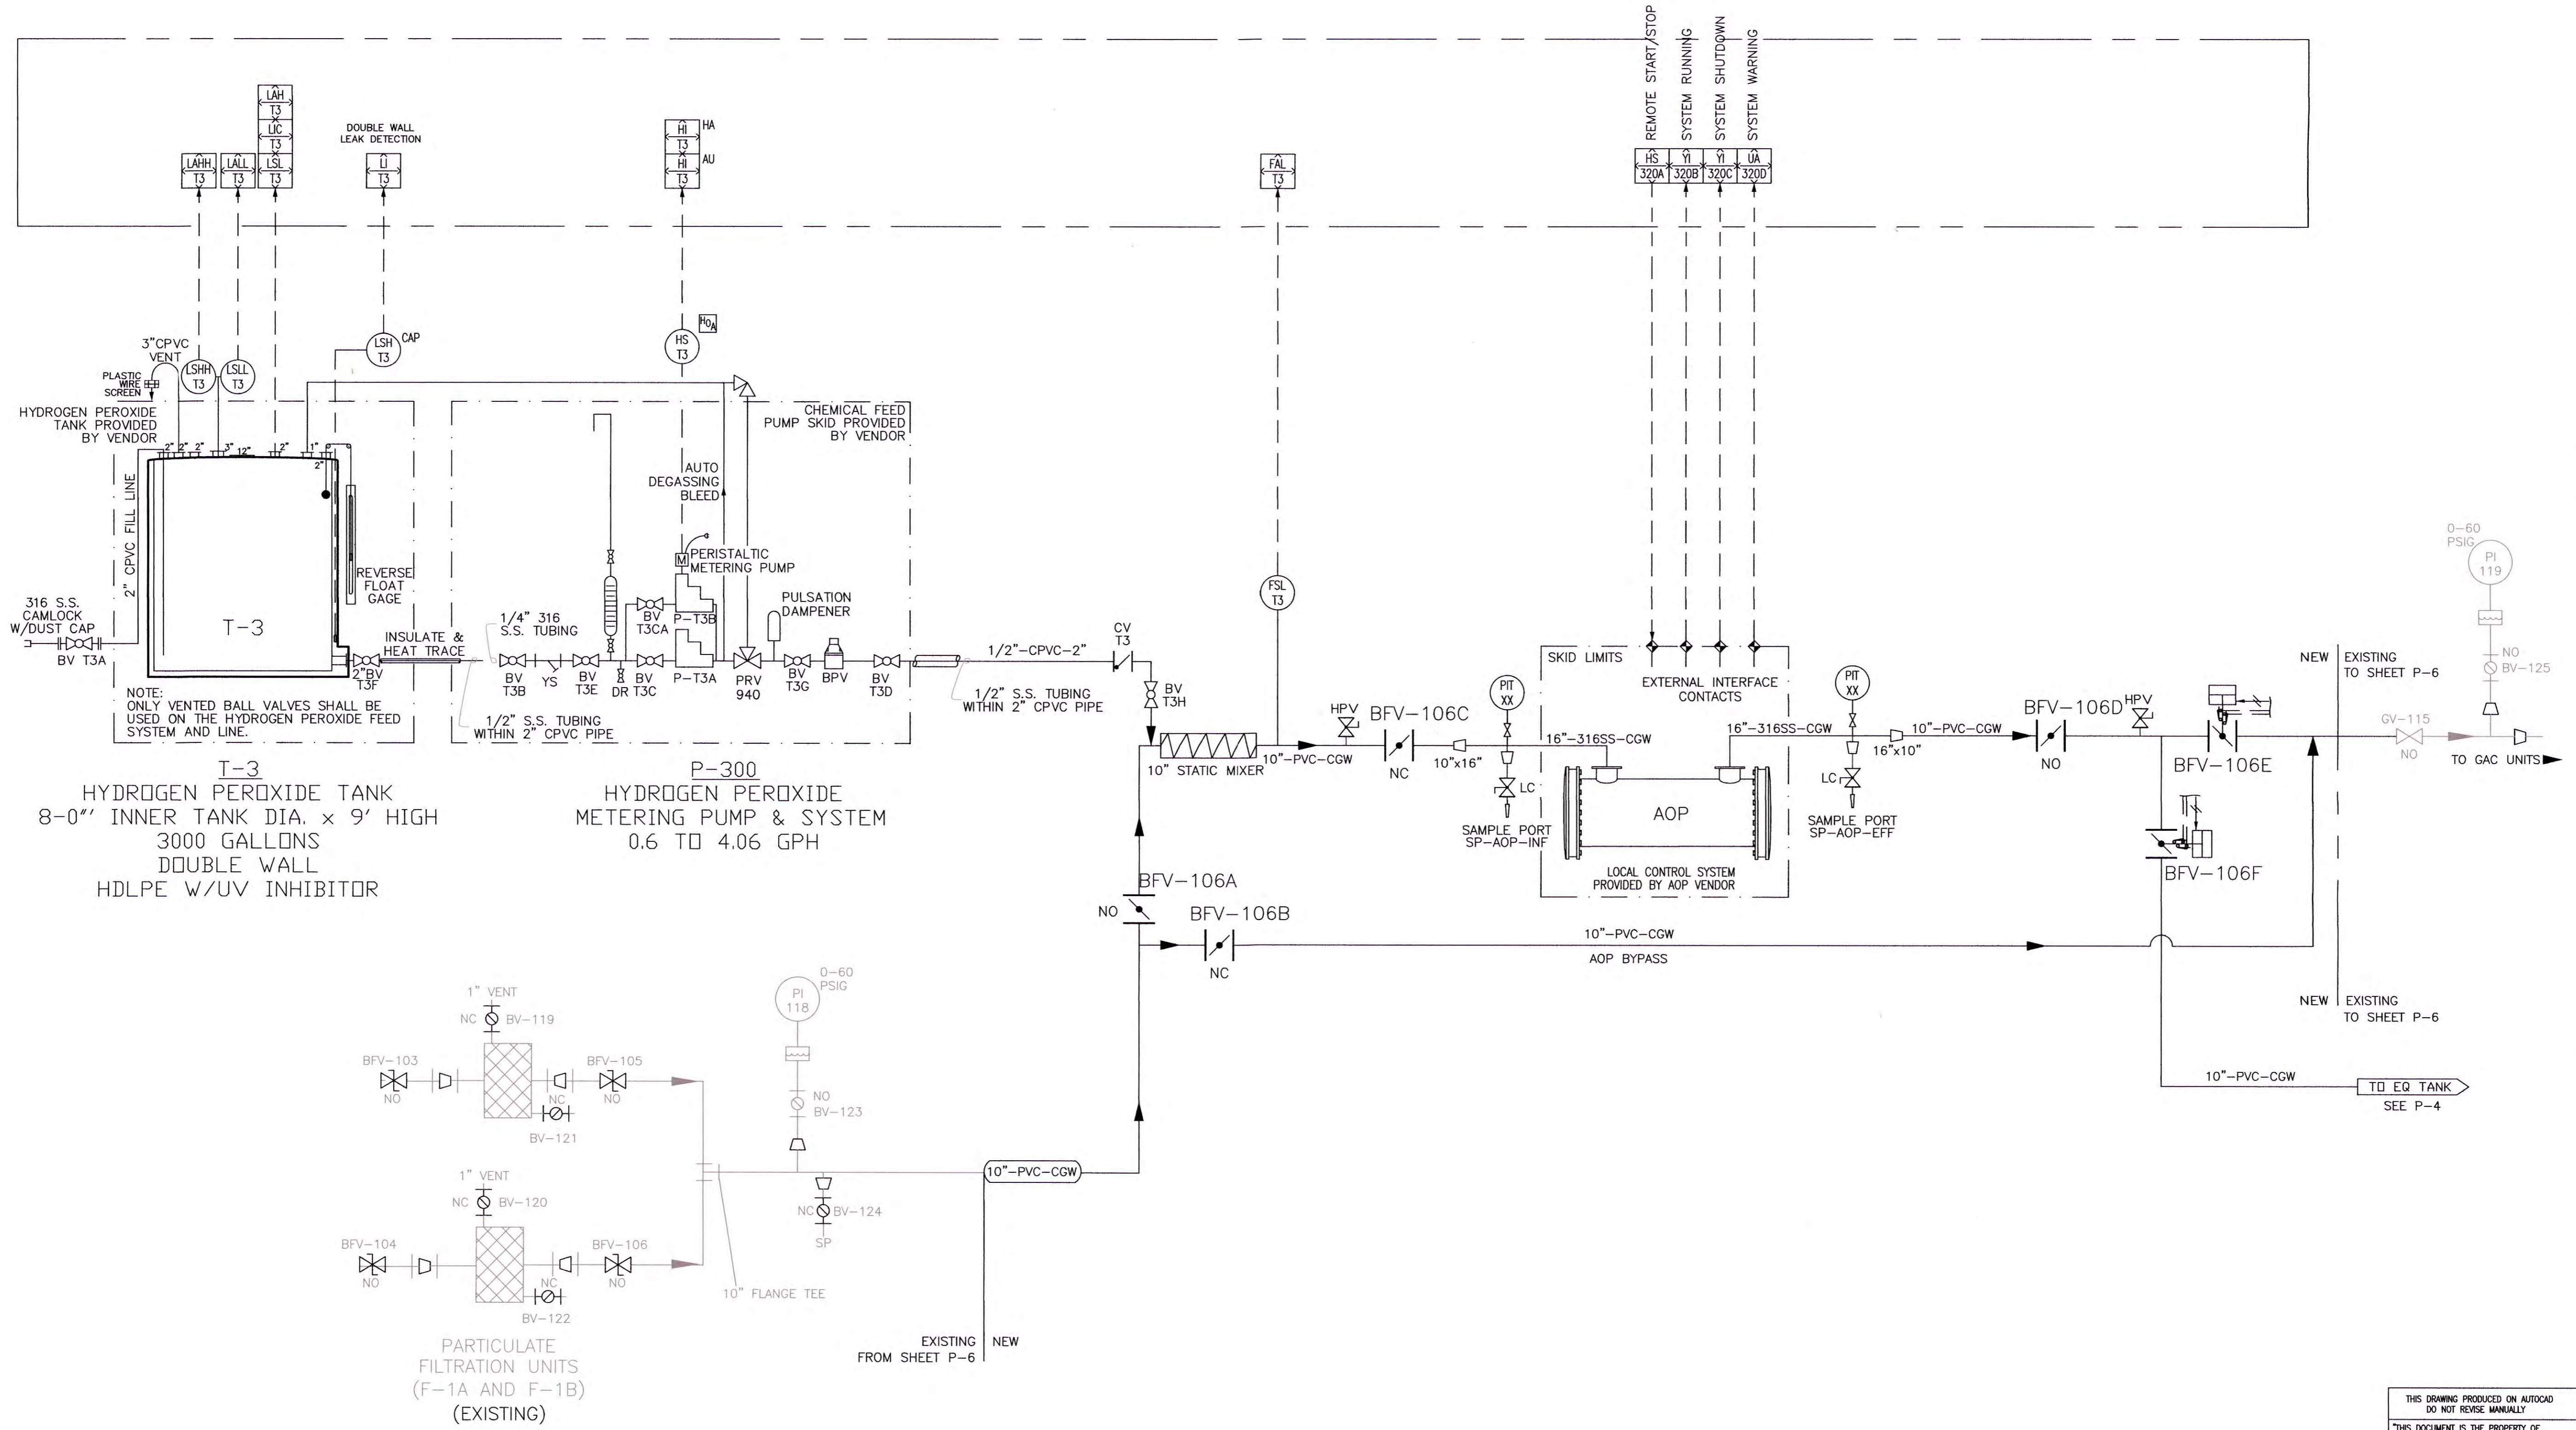


**T-3**  
HYDROGEN PEROXIDE TANK  
8-0" INNER TANK DIA. x 9' HIGH  
3000 GALLONS  
DOUBLE WALL  
HDLPE W/UV INHIBITOR

**P-300**  
HYDROGEN PEROXIDE  
METERING PUMP & SYSTEM  
0.6 TO 4.06 GPH

**PARTICULATE  
FILTRATION UNITS  
(F-1A AND F-1B)  
(EXISTING)**

| NO. | DATE | APPR. |
|-----|------|-------|
|     |      |       |
|     |      |       |
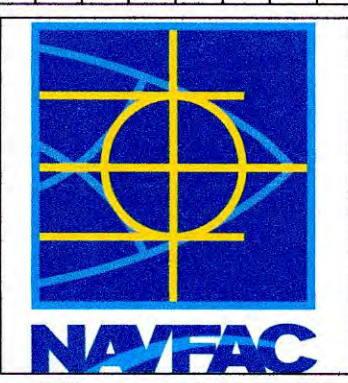

|                |     |    |     |
|----------------|-----|----|-----|
| DESIGN         | CHK | DR | SNL |
| REVIEWED BY    | CHK |    |     |
| PL/DM          | CHK |    |     |
| CHIEF ENG/ARCH | CHK |    |     |

NAVAL FACILITIES ENGINEERING COMMAND  
NAVAL FACILITIES ENGINEERING COMMAND ~ MID-ATLANTIC  
NAVAL INDUSTRIAL RESERVE ORDNANCE PLANT  
GM-38 AREA  
GROUNDWATER TREATMENT PLANT  
AOP SYSTEM ADDITION  
AOP PIPING AND INSTRUMENTATION DIAGRAM

|  |                              |                                     |   |
|--|------------------------------|-------------------------------------|---|
| THIS DRAWING PRODUCED ON AUTOCAD<br>DO NOT REVERSE MANUALLY  | CODE ID NO. 80091            | SIZE                                | D |
| SCALE: NTS   | MAXIMUM NO. 862470-09-D-1001 |                                     |   |
| THIS DOCUMENT IS THE PROPERTY OF<br>NAVAL FACILITIES ENGINEERING COMMAND,<br>PREPARED BY TETRA TECH ENGINEERING<br>CORPORATION PC, AND IS PROVIDED UPON THE<br>CONDITION THAT IT WILL NOT BE REPRODUCED,<br>COPIED, OR ISSUED TO A THIRD PARTY, AND WILL<br>BE USED SOLELY FOR THE ORIGINAL INTENDED<br>PURPOSE AND SOLELY FOR THE EXECUTION<br>OR REVIEW OF THE ENGINEERING CONSTRUCTION<br>OF THE PROJECT. | SPEC. NO. 112C08005          | CONSTR. CONTR. NO. 862472-99-D-0032 |   |
|  | NAVFAC DRAWING NO.           |                                     |   |
|  | SHEET                        | OF                                  |   |

ISSUED FOR BID - 06/21/2019  
CAUTION: IF SHEET IS LESS THAN 34"x22" USE GRAPHIC SCALE


IT IS A VIOLATION OF THE NEW YORK STATE  
EDUCATION LAW, ARTICLE 145, FOR ANY PERSON,  
UNLESS UNDER THE DIRECTION OF A NEW YORK  
STATE LICENSED PROFESSIONAL ENGINEER, TO  
ALTER AN ITEM ON THIS DOCUMENT IN ANY WAY.



1 2 3 4 5

D  
C  
B  
A

CONCRETE PAD AND SUMP DETAILS  
SEE STRUCTURAL DRAWINGS

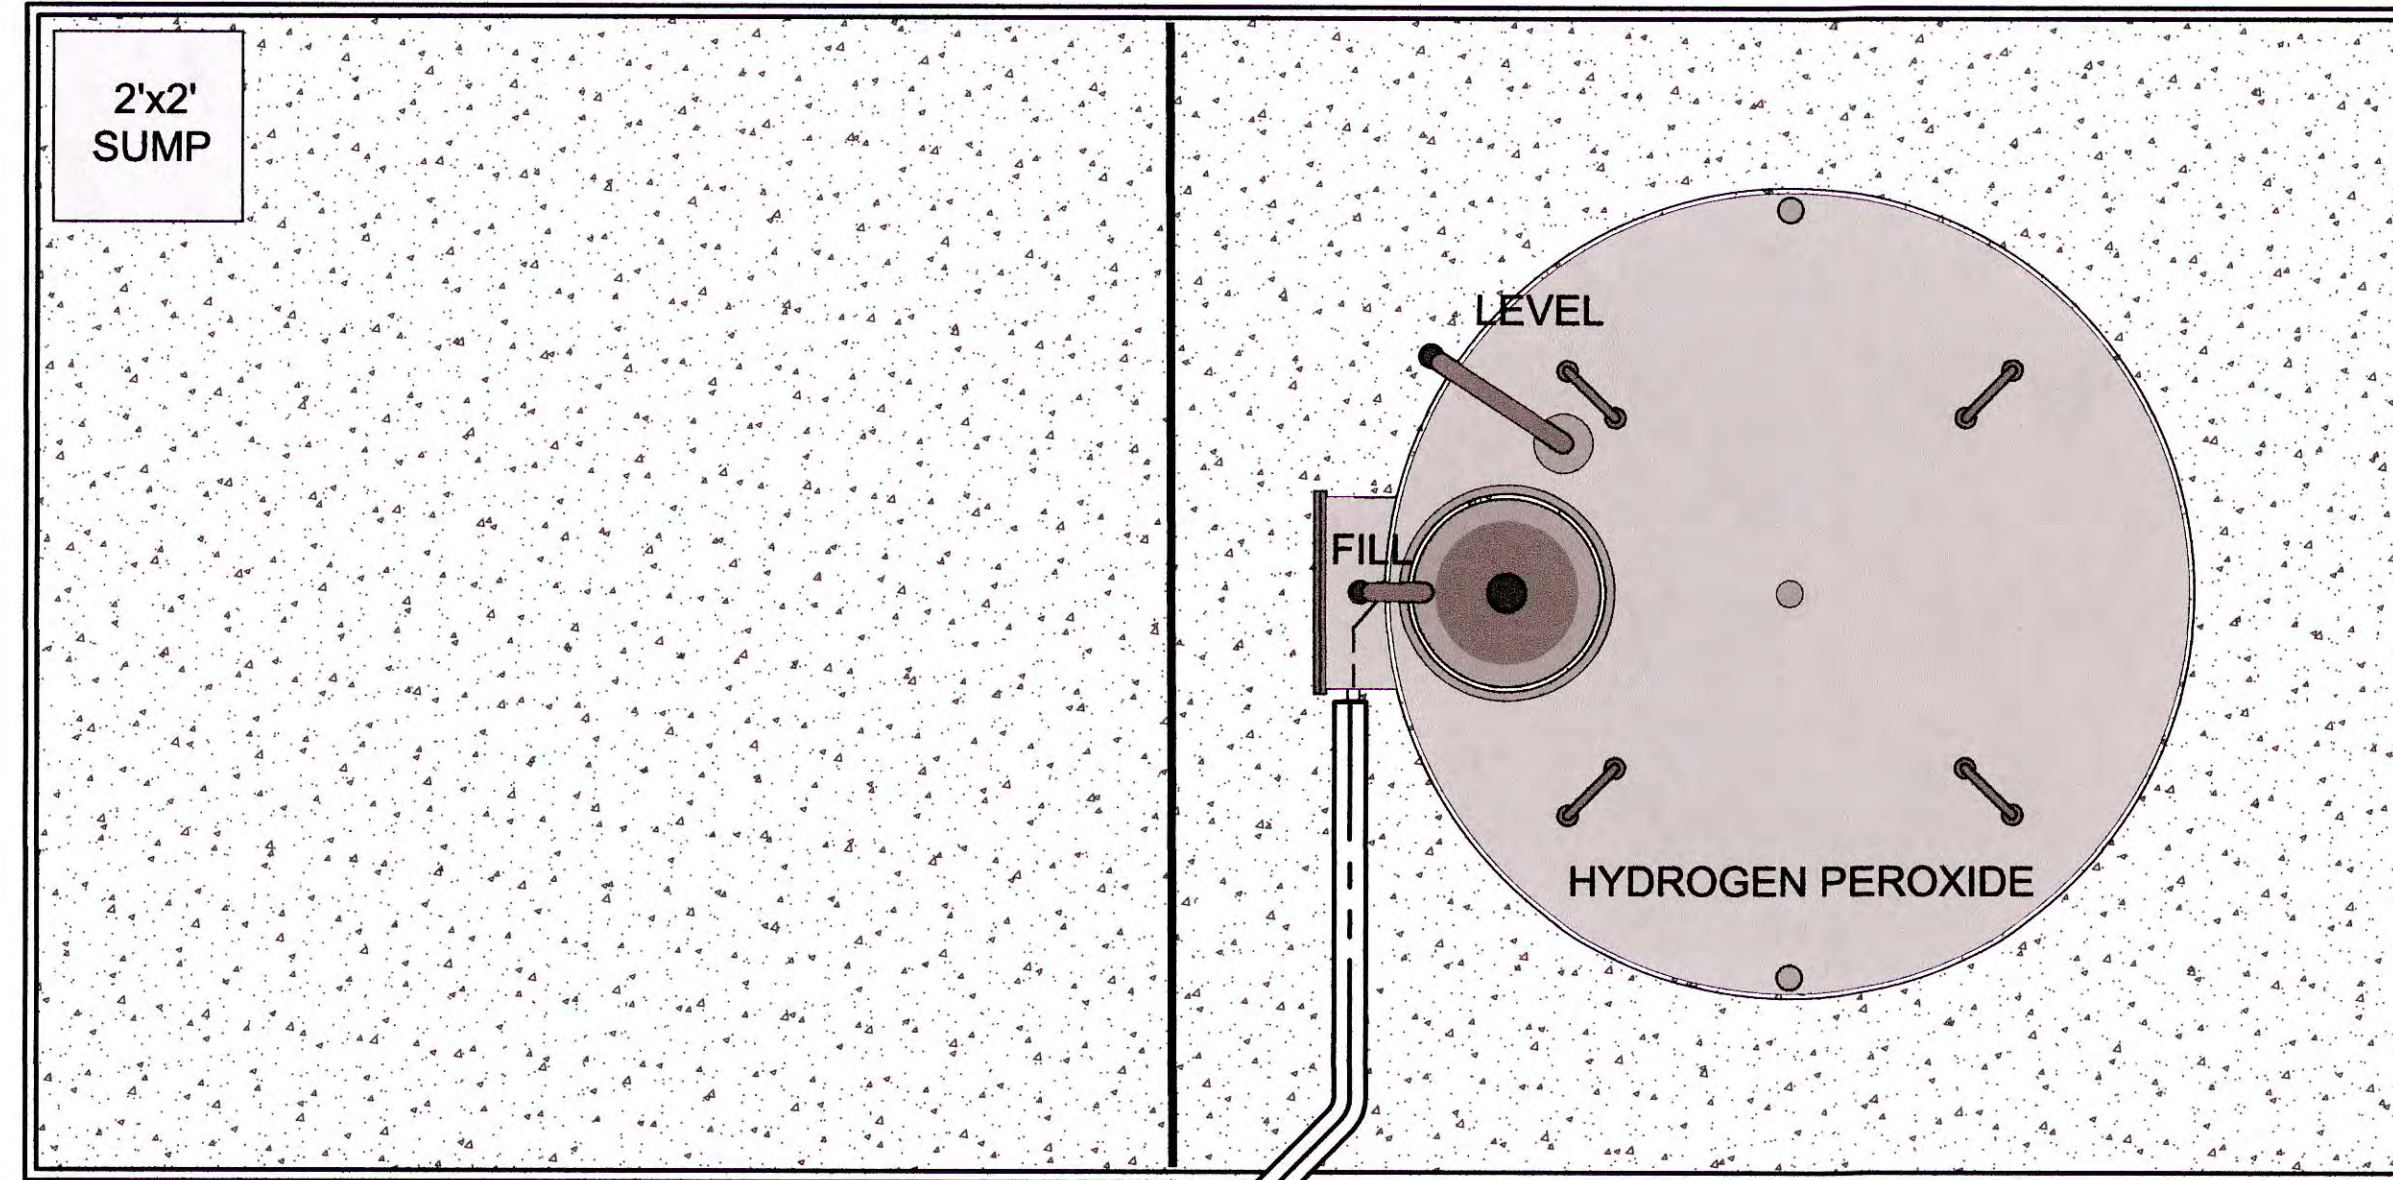


12'x12' RAMP/  
CONTAINMENT AREA PAD

SEE PLUMBING DRAWING  
FOR HEAT TRACE DETAIL


12'x12' CONCRETE  
PAD FOR TANK

1/2" SS TUBING IN  
2" CPVC


6" PIPE SLEEVE  
& LINK SEAL

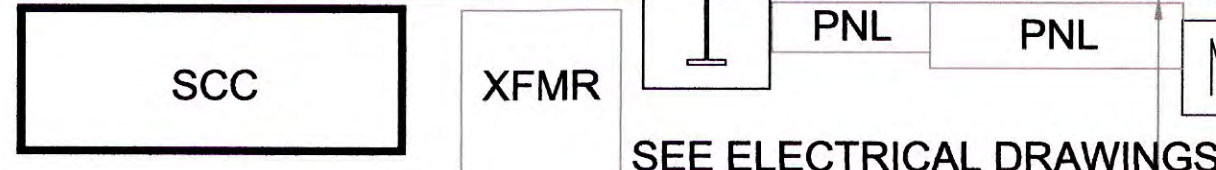

SEE ELECTRICAL DRAWINGS

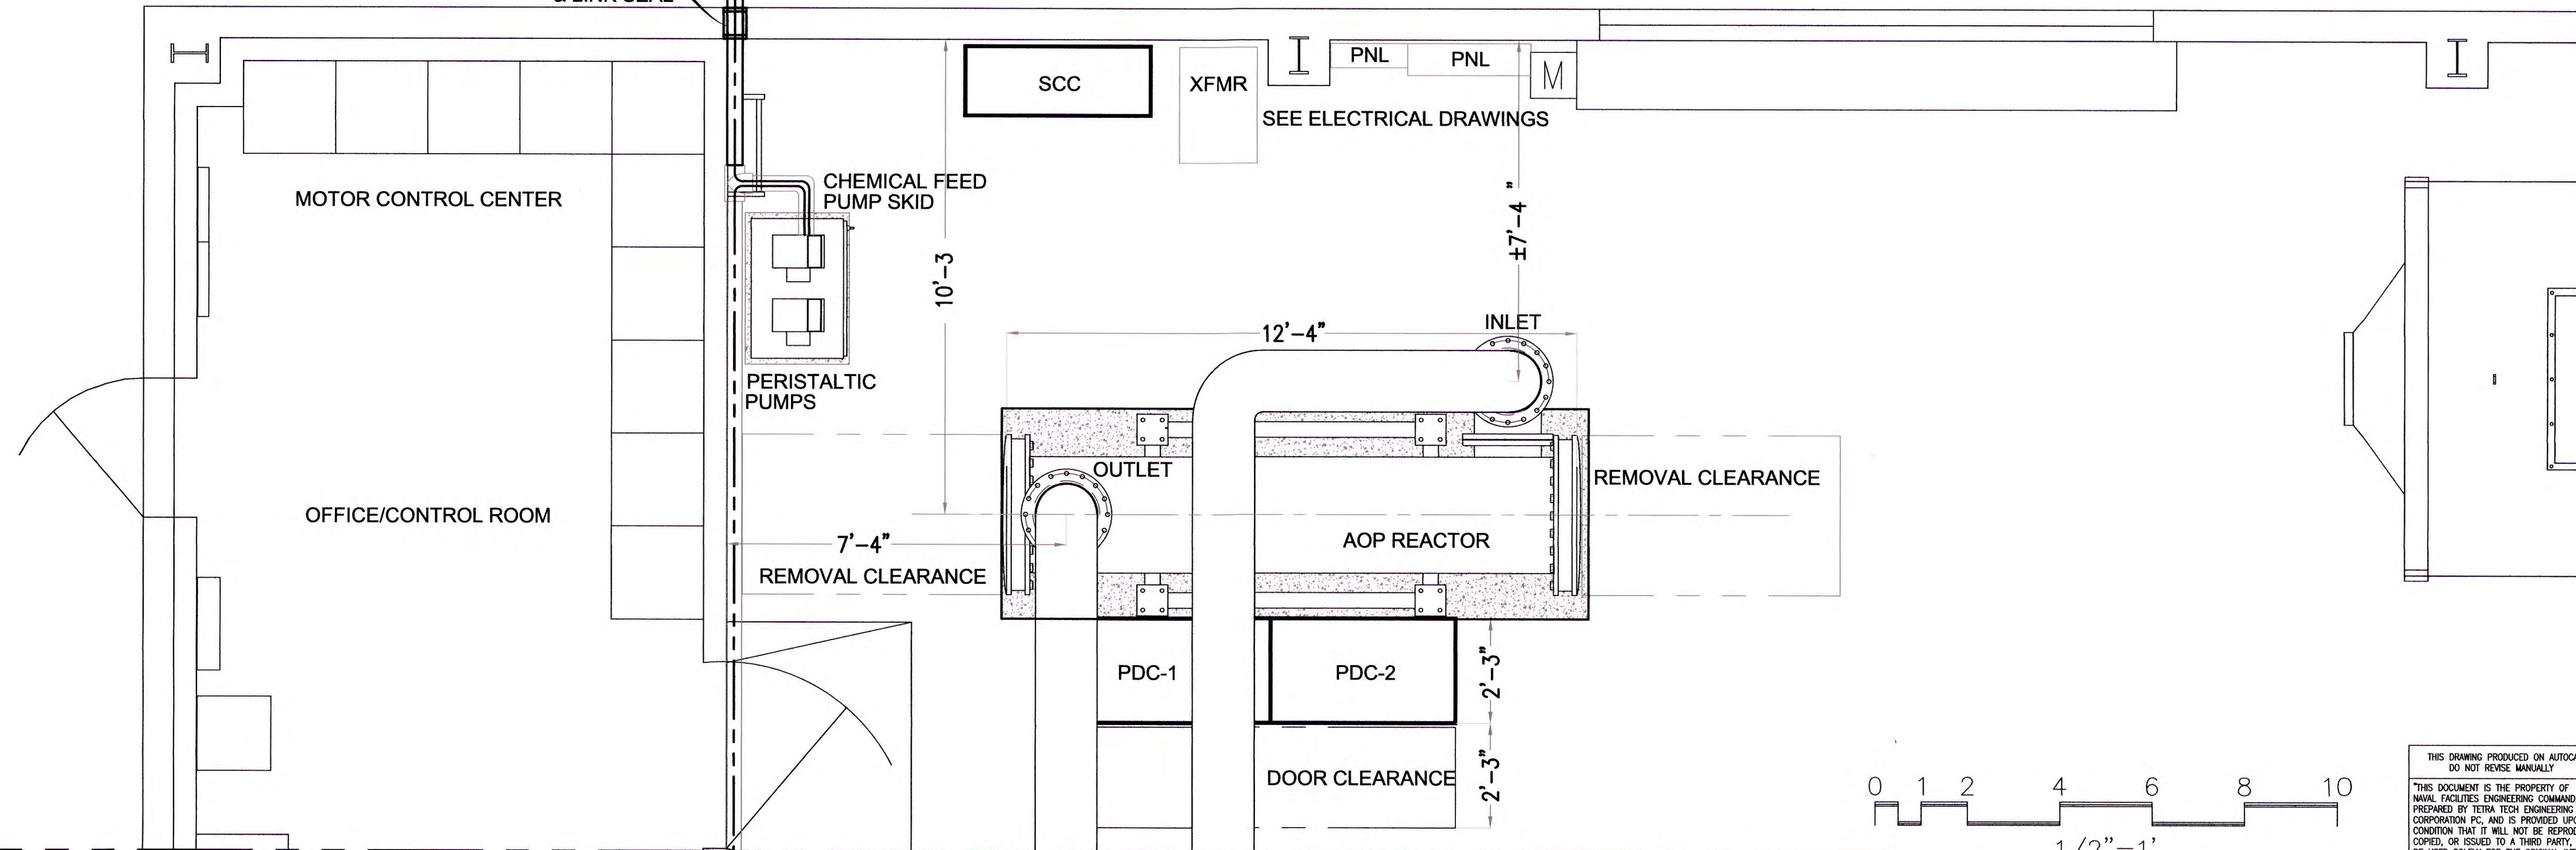

FOR CONTINUATION SEE DRAWING P-13

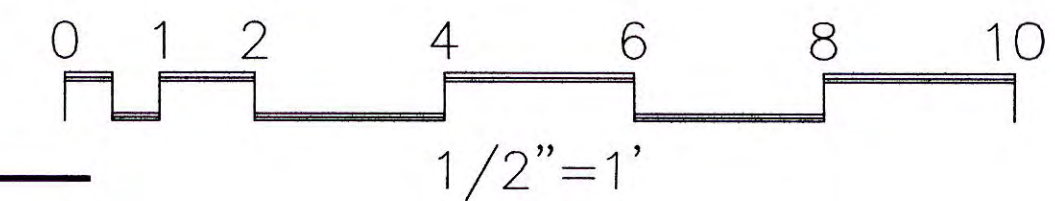

|   |  |                                     |        |
|---|--|-------------------------------------|--------|
| THIS DRAWING PRODUCED ON AUTOCAD<br>DO NOT REUSE MANUALLY   |  | CODE ID. NO. 80091                  | SIZE D |
| THIS DOCUMENT IS THE PROPERTY OF<br>NAVAL FACILITIES ENGINEERING COMMAND,<br>PREPARED BY TETRA TECH ENGINEERING<br>CORPORATION P.C. AND IS PROVIDED UPON THE<br>CONDITION THAT IT WILL NOT BE REPRODUCED,<br>COPIED, OR ISSUED TO A THIRD PARTY, AND WILL<br>BE USED SOLELY FOR THE ORIGINAL INTENDED<br>PURPOSE AND SOLELY FOR THE EXECUTION<br>OR REVIEW OF THE ENGINEERING CONSTRUCTION<br>OF THE PROJECT. |  | SCALE: 1/2"=1'                      | NTS    |
| DEPARTMENT OF THE NAVY<br>NAVAL FACILITIES ENGINEERING COMMAND ~ MID-ATLANTIC<br>NAVAL INDUSTRIAL RESERVE ORDNANCE PLANT<br>NAVAL RESPONSE INDUSTRIAL RESERVE PLANT GM-38 AREA<br>BERHAMP, NEW YORK   |  | DRAWING NO. N62470-99-D-1001        |        |

ISSUED FOR BID - 06/21/2019


CAUTION: IF SHEET IS LESS THAN 34"x22" USE GRAPHIC SCALE

1 2 3 4 5

DATE APPR

DESCRIPTION

SYM

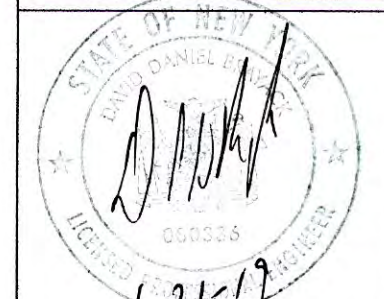

SEAL AREA

|                |     |    |     |
|----------------|-----|----|-----|
| DES            | CHK | DR | SRL |
| REVIEWED BY    | HKM |    |     |
| PA/DM          | HKM |    |     |
| CHIEF ENG/ARCH | HKM |    |     |

NAVAL FACILITIES ENGINEERING COMMAND  
NAVAL FACILITIES ENGINEERING COMMAND ~ MID-ATLANTIC  
NAVAL INDUSTRIAL RESERVE ORDNANCE PLANT  
NAVAL RESPONSE INDUSTRIAL RESERVE PLANT GM-38 AREA  
BERHAMP, NEW YORK

GROUNDWATER TREATMENT PLANT  
AOP SYSTEM ADDITION

AOP PROPOSED OVERALL PIPING LAYOUT (1 OF 2)

FOR CONTINUATION SEE DRAWING P-12

SUPPORT PIPE AND VALVES PROPERLY FROM FLOOR OR CEILING AS NECESSARY. VERIFY AND FIT IN FIELD.


AST BYPASS

10" FROM BAG FILTERS ←

(3) 10" AST BYPASS VALVES W/ CHAIN WHEEL

10" PVC TO AST →

← 10" FROM AST

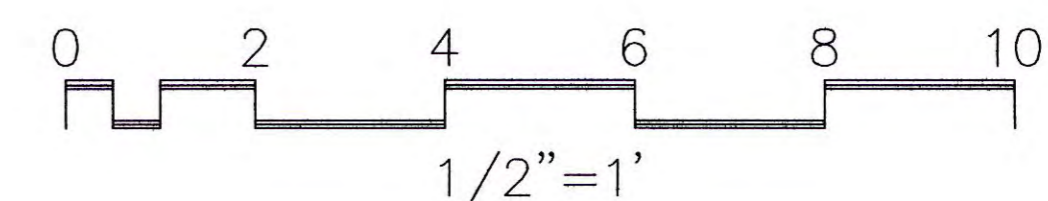


ISSUED FOR BID - 06/21/2019



CAUTION: IF SHEET IS LESS THAN 34"x22" USE GRAPHIC SCALE

THIS DRAWING PRODUCED ON AUTOCAD DO NOT REVISE MANUALLY.  
 THIS DOCUMENT IS THE PROPERTY OF NAVAL FACILITIES ENGINEERING COMMAND, PREPARED BY TETRA TECH ENGINEERING CORPORATION PC, AND IS PROVIDED UPON THE CONDITION THAT IT WILL NOT BE REPRODUCED, COPIED, OR ISSUED TO A THIRD PARTY, AND WILL BE USED SOLELY FOR THE ORIGINAL INTENDED PURPOSE AND SOLELY FOR THE EXECUTION OR REVIEW OF THE ENGINEERING CONSTRUCTION OF THE PROJECT.  
 IT IS A VIOLATION OF THE NEW YORK STATE EDUCATION LAW, ARTICLE 145, FOR ANY PERSON, UNLESS UNDER THE DIRECTION OF A NEW YORK STATE LICENSED PROFESSIONAL ENGINEER, TO ALTER AN ITEM ON THIS DOCUMENT IN ANY WAY.




|  |                                     |        |
|--|-------------------------------------|--------|
| DEPARTMENT OF THE NAVY<br>NAVAL FACILITIES ENGINEERING COMMAND ~ MID-ATLANTIC<br>NAVAL WEAPONS INDUSTRIAL RESERVE PLANT GM-38 AREA<br>BEHRAEGE, NEW YORK | CODE ID NO. 80091                   | SIZE D |
| SEAL AREA<br>DES HKH DR SNL  | SCALE: NTS                          |        |
| REVIEWED BY HKH  | MAXIMO NO. N62470-08-D-1001         |        |
| PM/DM HKH  | SJOB ORDER NO. WE-24                |        |
| CHIEF ENG/ARCH HKH   | SPEC. NO. 112G08005                 |        |
|  | CONSTR. CONTR. NO. N62472-98-D-0032 |        |
|  | NAVFAC DRAWING NO. ....             |        |
|  | SHEET OF                            |        |
|  |                                     | P-13   |

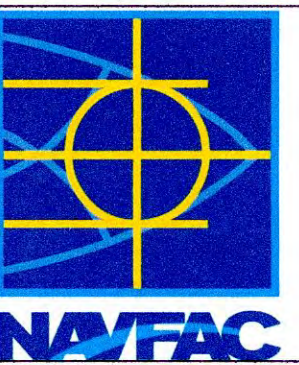


A  
B  
C  
D

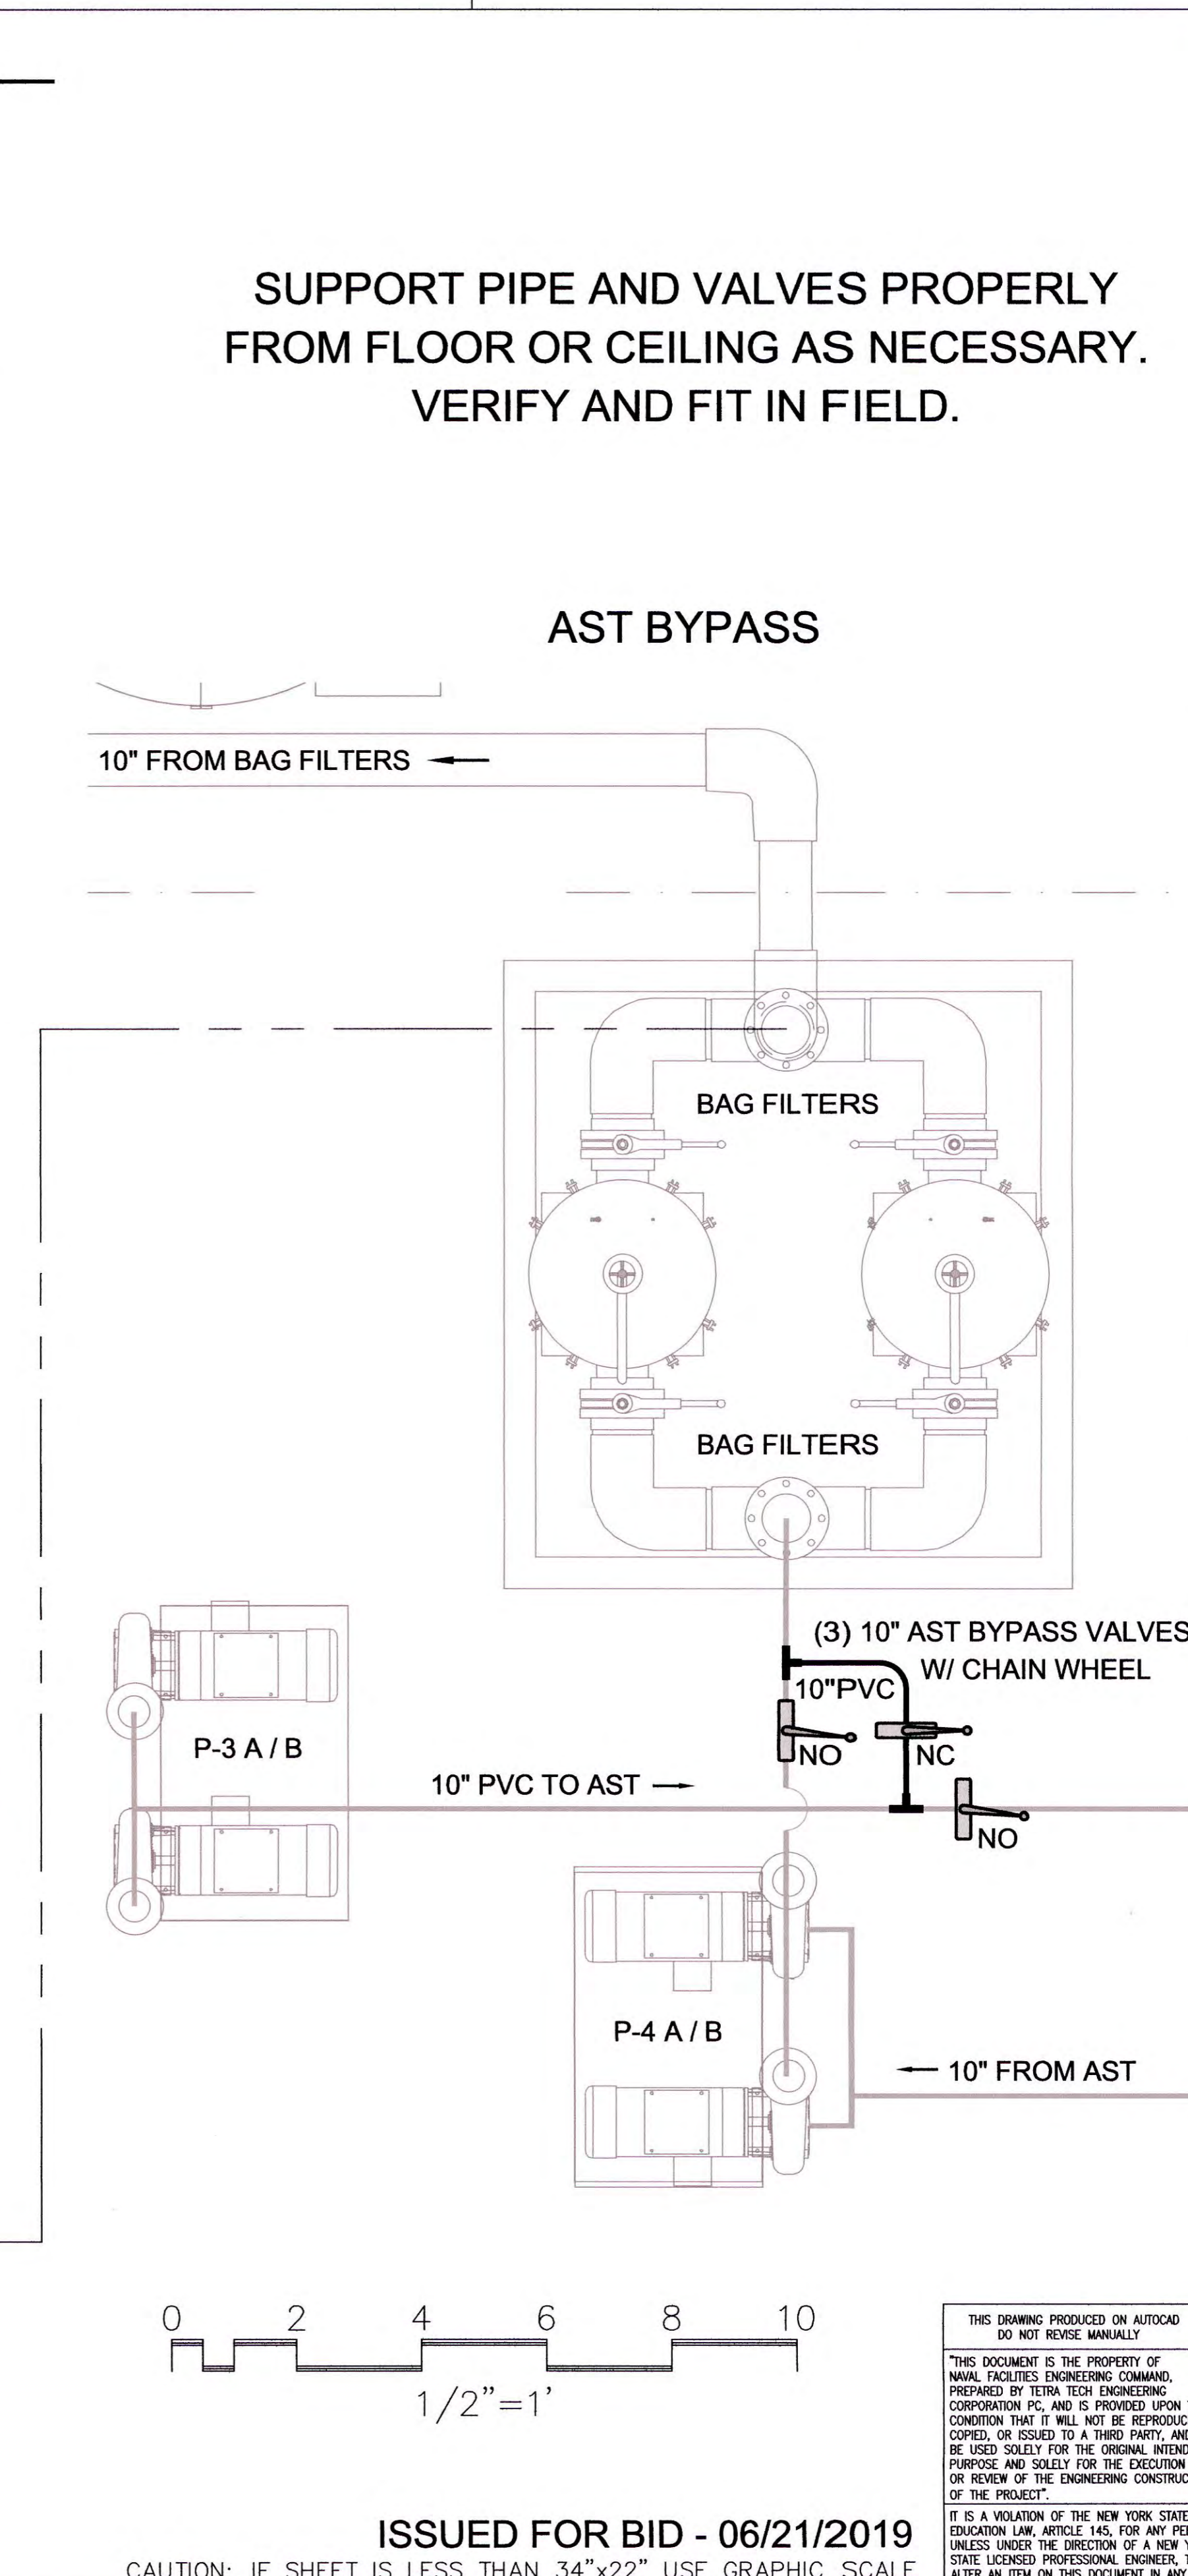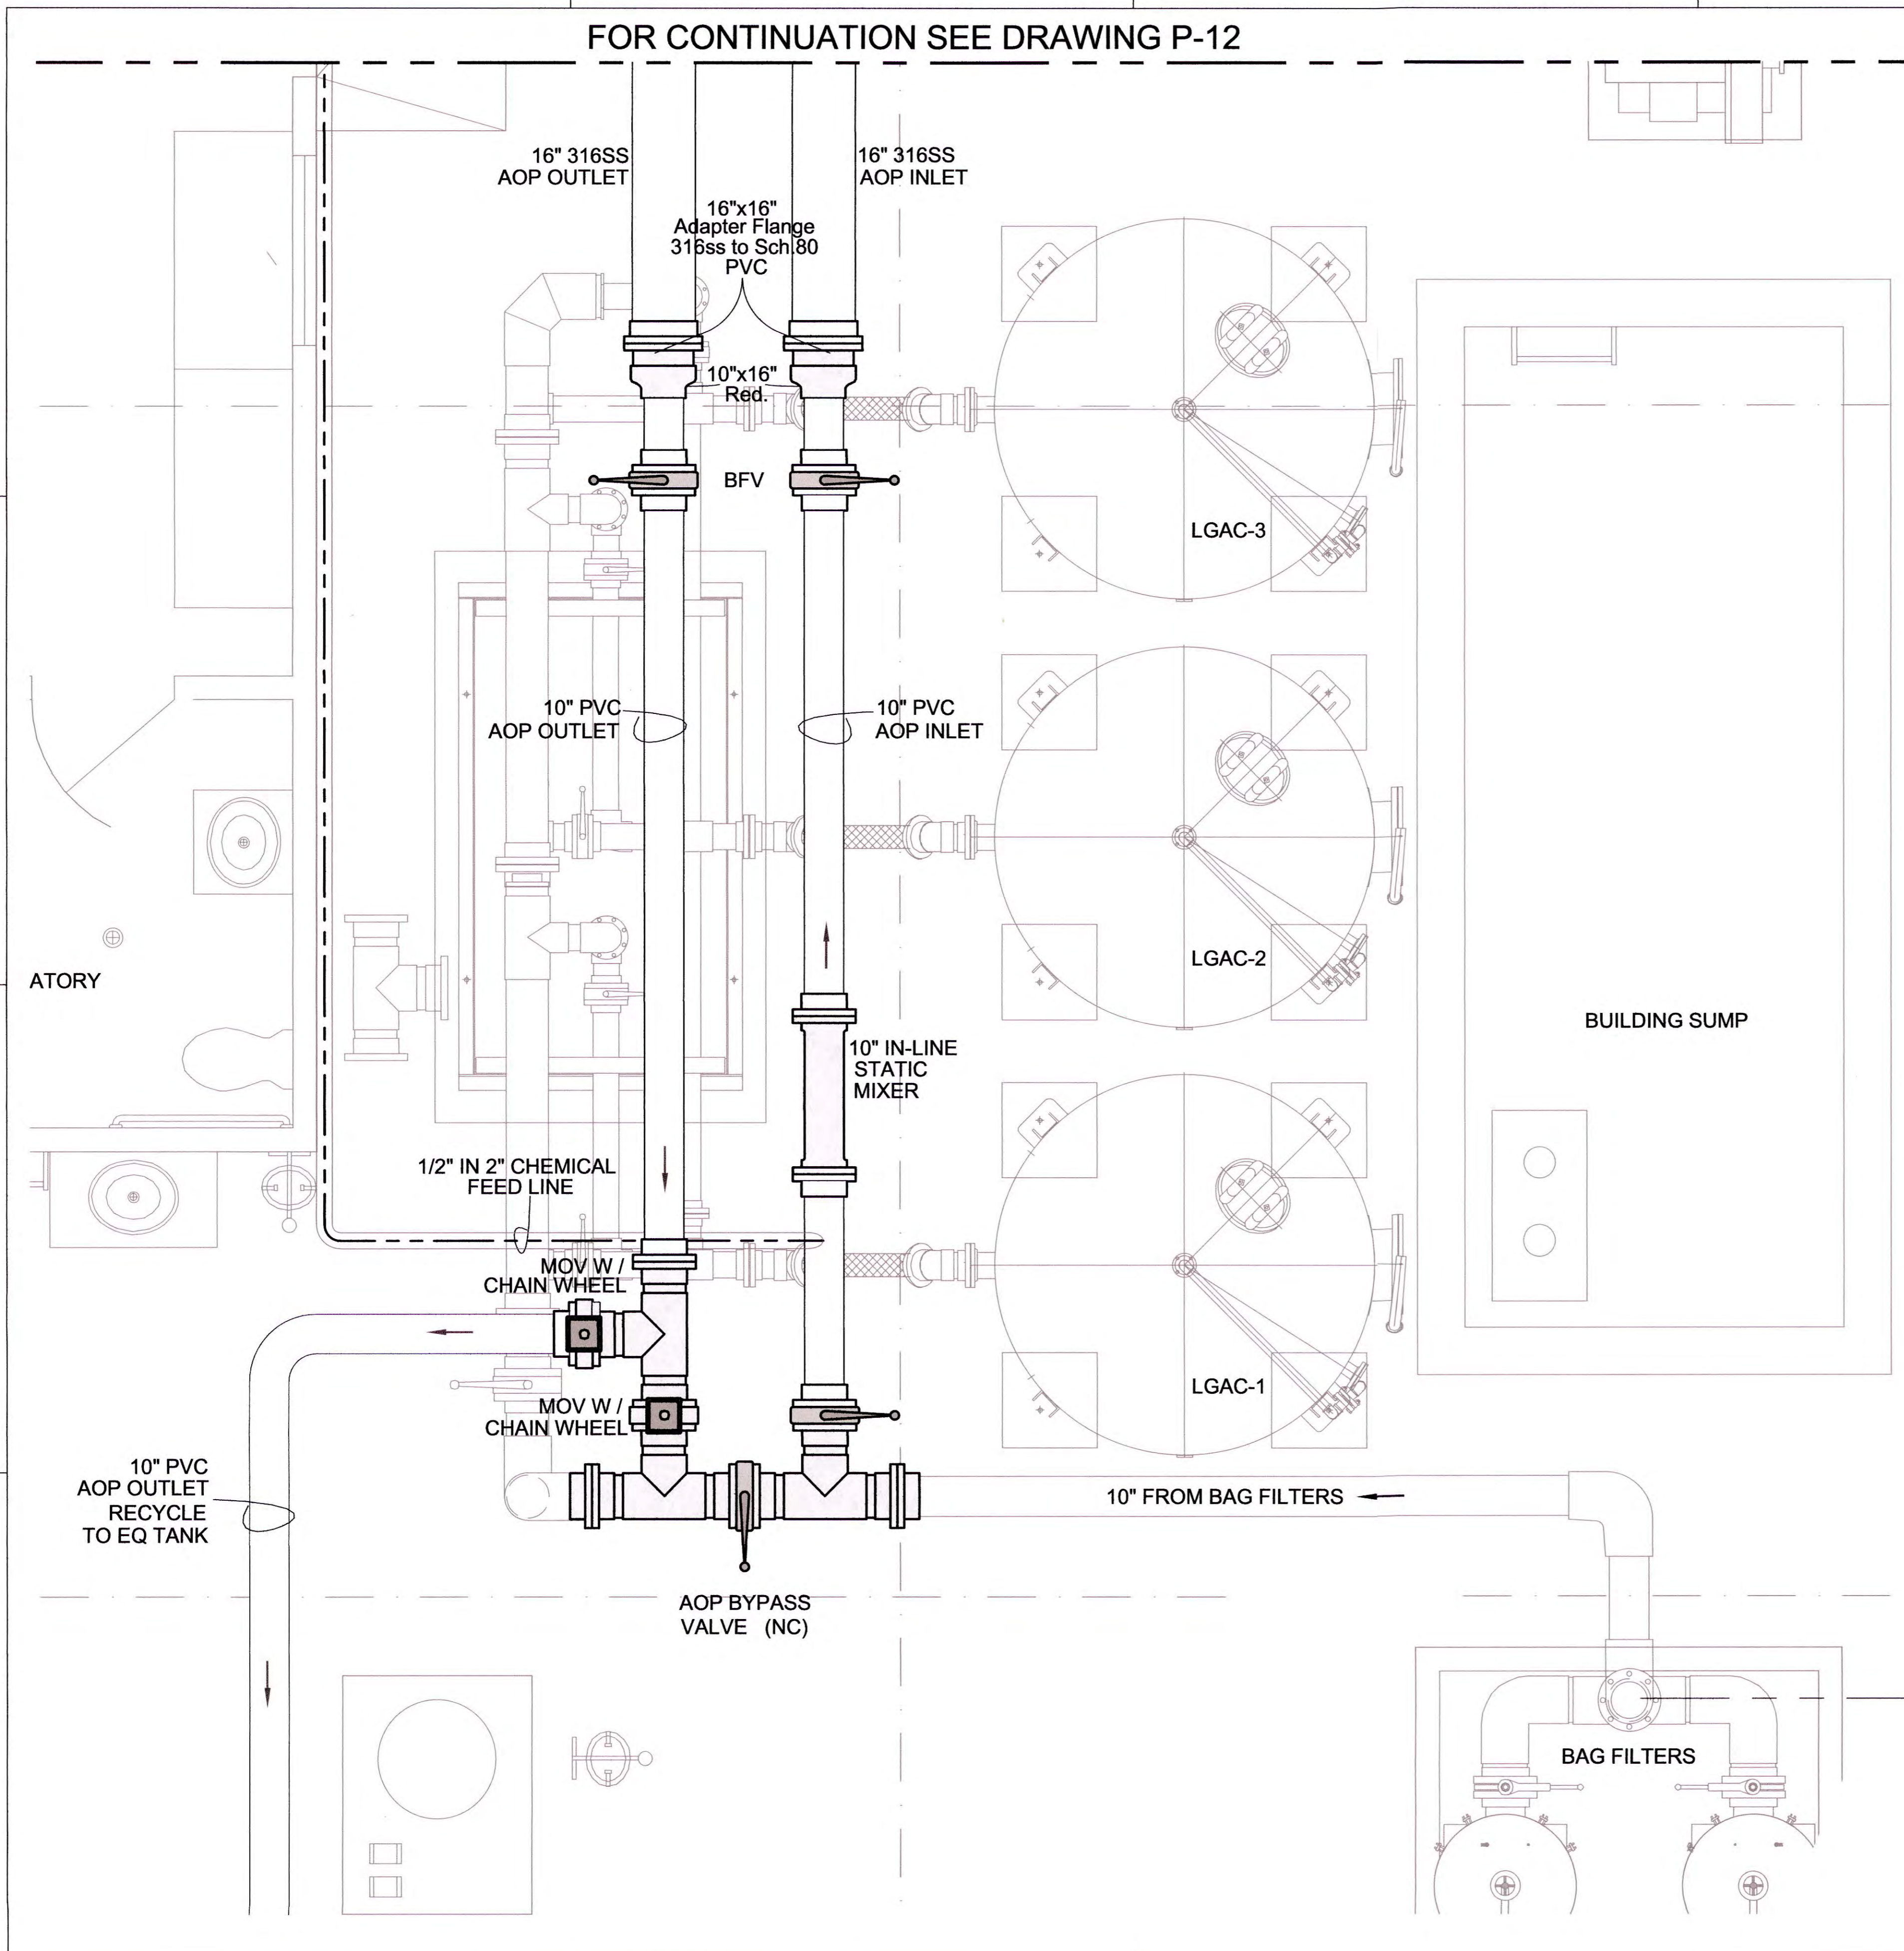

AOP PROPOSED OVERALL PIPING LAYOUT (2 OF 2)

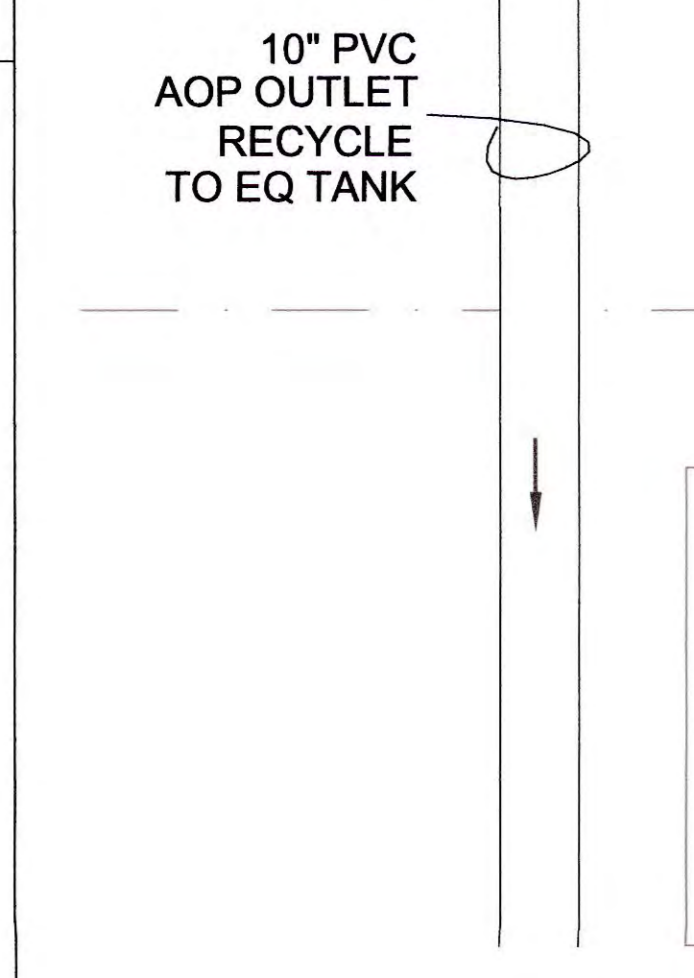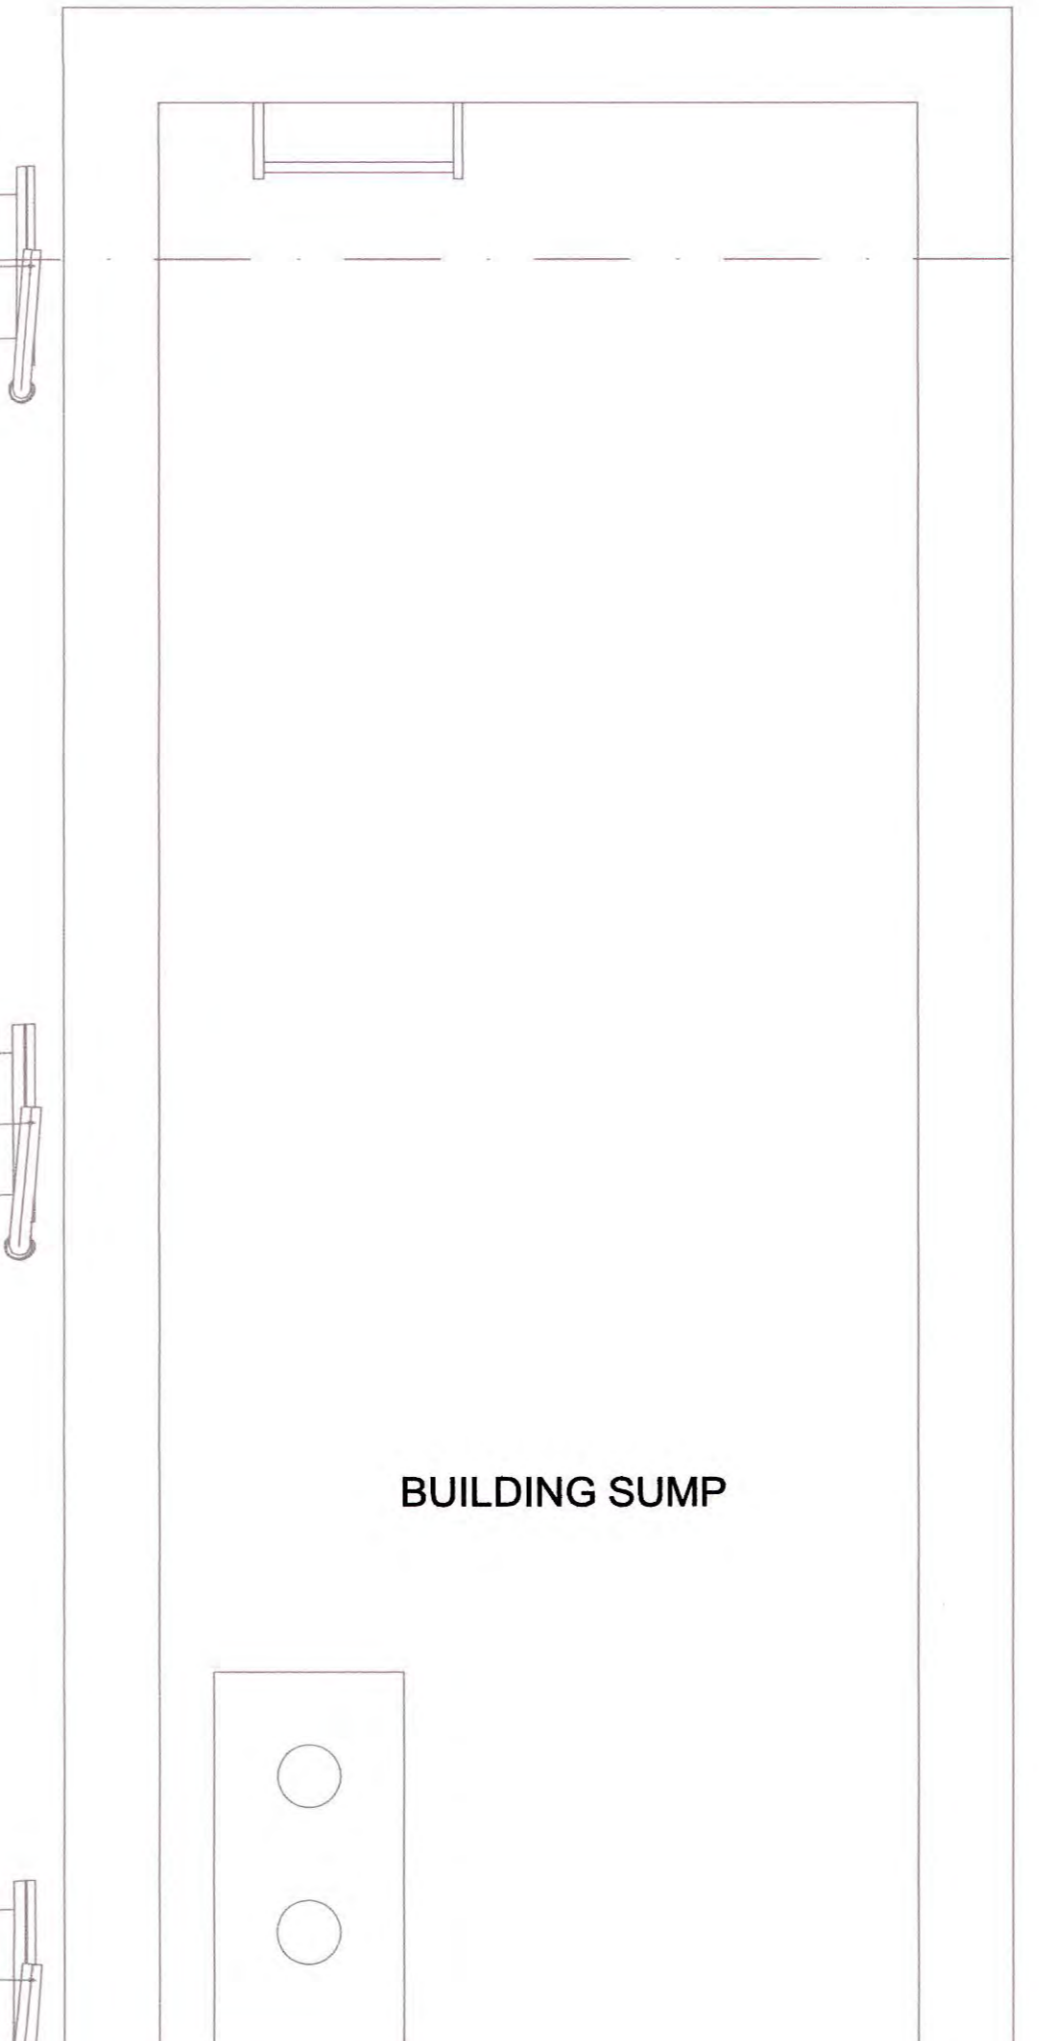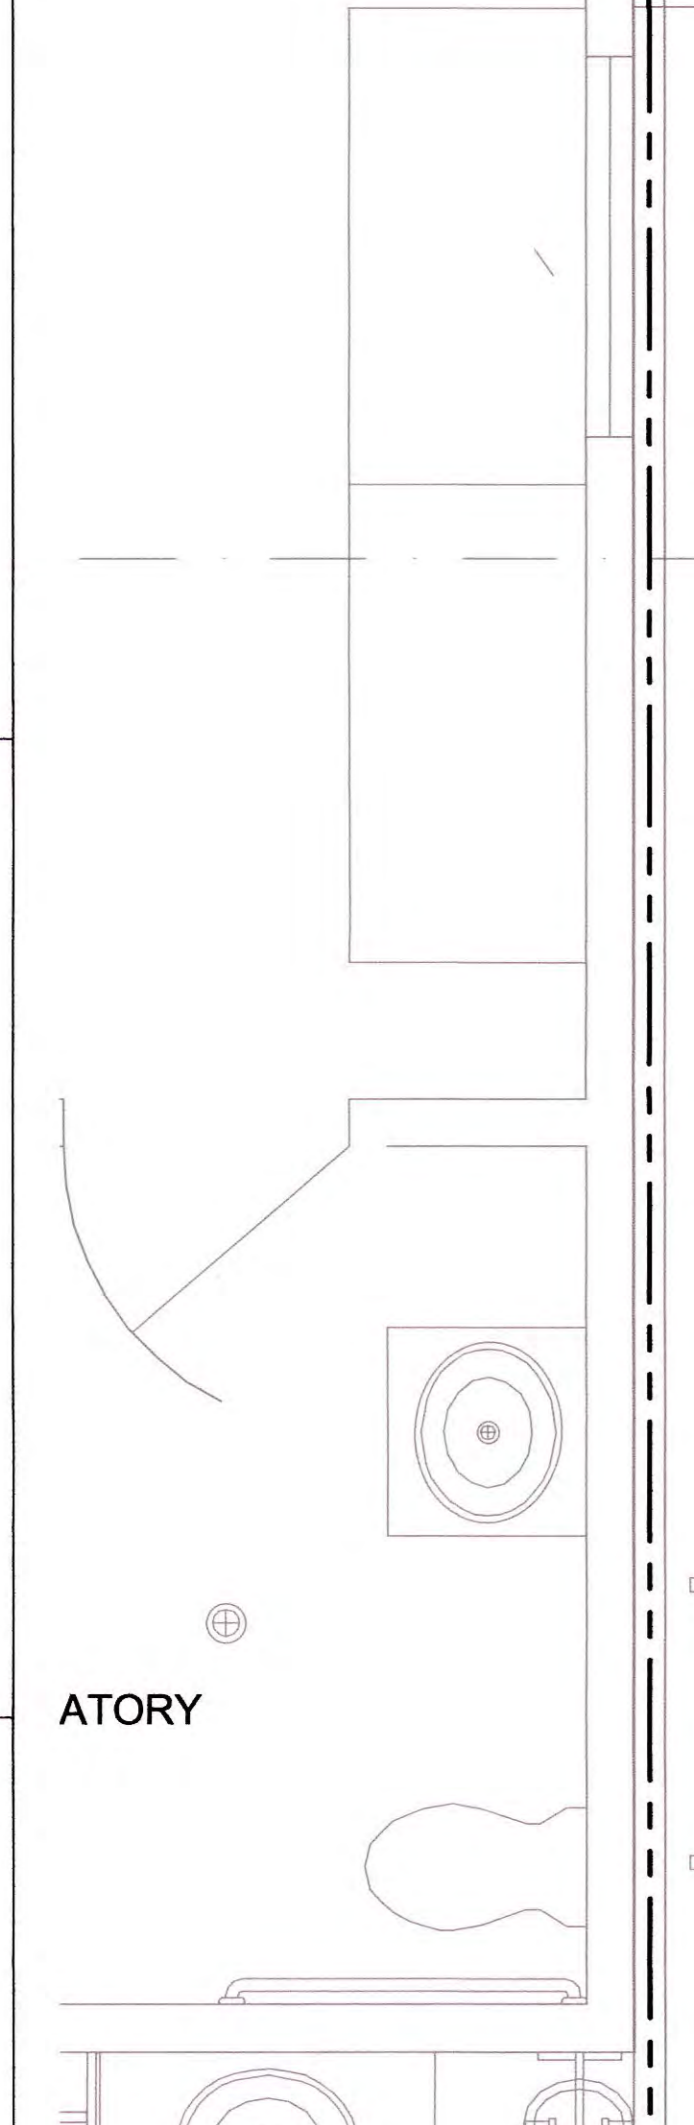

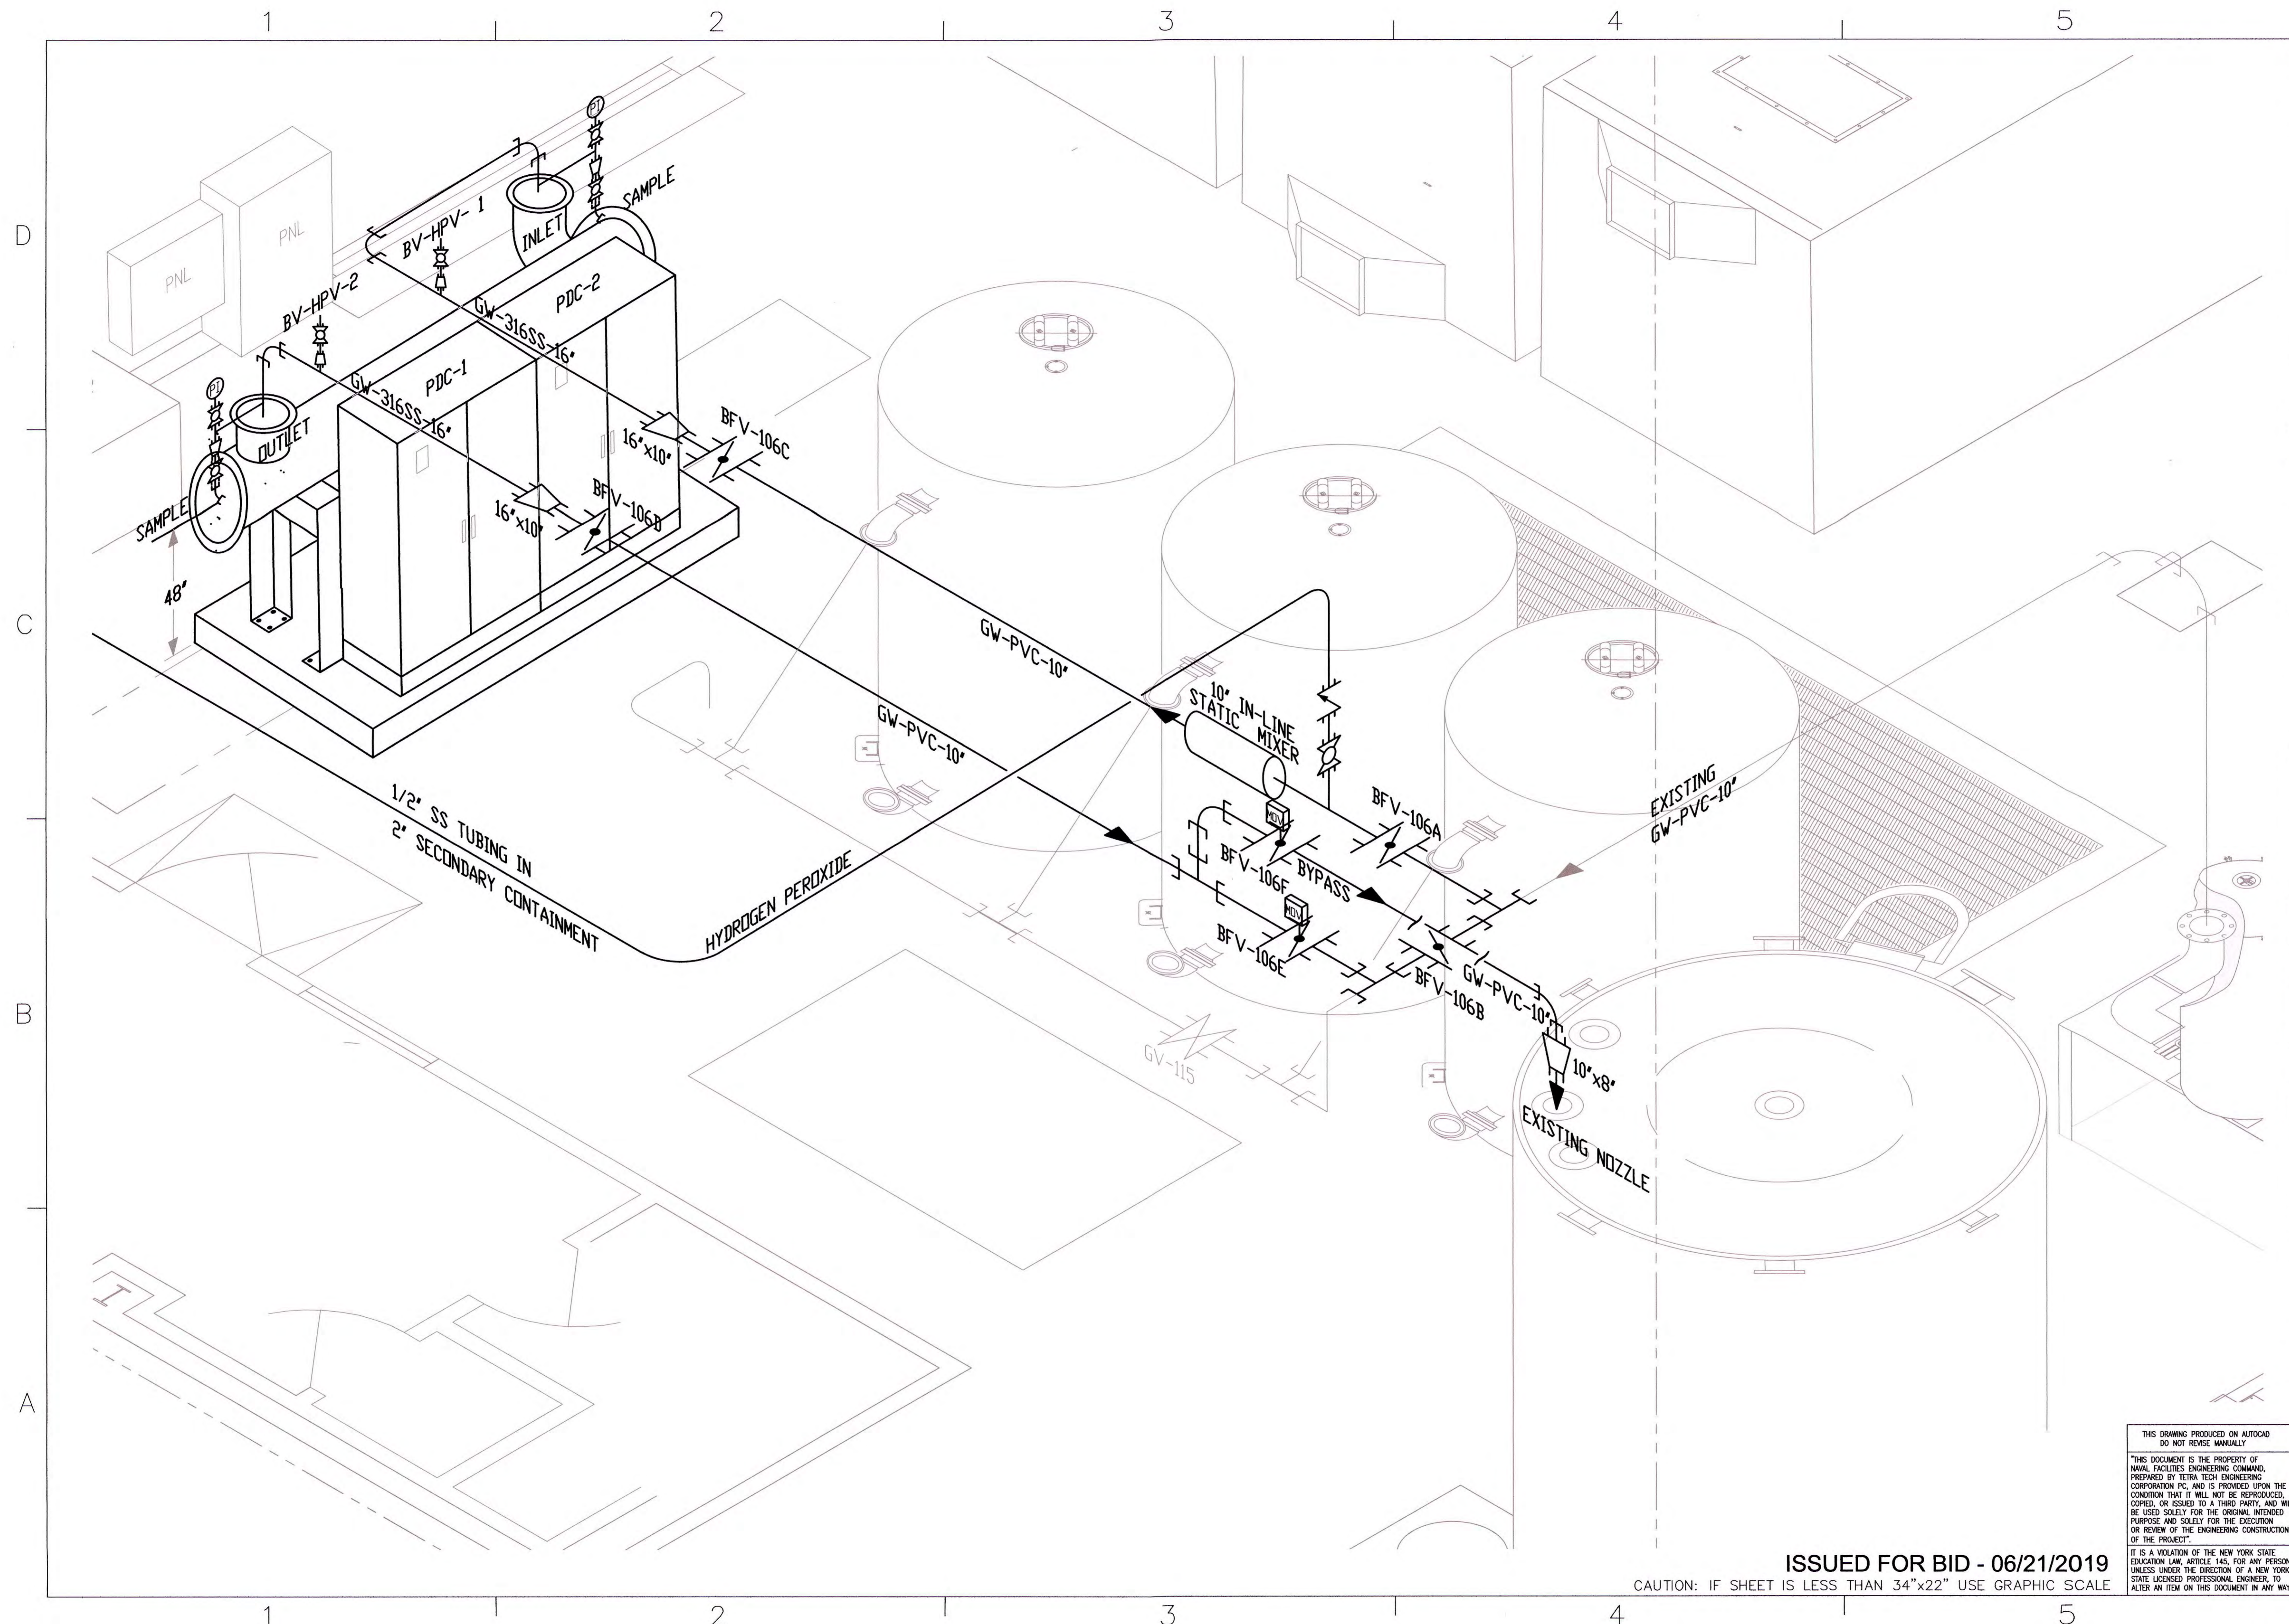


|  |  |   |
|--|--|---|
|  |  |   |
|  |  | <p>DEPARTMENT OF THE NAVY<br/>NAVAL FACILITIES ENGINEERING COMMAND<br/>NAVAL WEAPONS INDUSTRIAL RESERVE PLANT GM-38 AREA<br/>NAVAL INDUSTRIAL RESERVE PLANT<br/>BETHPAGE, NEW YORK</p> <p><b>GROUNDWATER TREATMENT PLANT<br/>AOP SYSTEM ADDITION</b></p> <p><b>TIE-IN ISOMETRIC</b></p> |


|  |                                     |        |
|--|-------------------------------------|--------|
| THIS DRAWING PRODUCED ON AUTOCAD<br>DO NOT REVISE MANUALLY   | CODE ID. NO. 80091                  | SIZE D |
| SCALE: NTS   | MAXIMO NO. N62475-05-D-1001         |        |
| THIS DOCUMENT IS THE PROPERTY OF<br>NAVAL FACILITIES ENGINEERING COMMAND,<br>PREPARED BY TETRA TECH ENGINEERING<br>CORPORATION PC, AND IS PROVIDED UPON THE<br>CONDITION THAT IT WILL NOT BE REPRODUCED,<br>COPIED, OR ISSUED TO A THIRD PARTY, AND WILL<br>BE USED SOLELY FOR THE ORIGINAL INTENDED<br>PURPOSE AND SOLELY FOR THE EXECUTION<br>OR REVIEW OF THE ENGINEERING CONSTRUCTION<br>OF THE PROJECT. | JOB ORDER NO. WE-24                 |        |
|  | SPEC. NO.                           |        |
|  | CONSTR. CONTR. NO. N62472-96-D-0032 |        |
|  | 112G08005                           |        |
| NAVFAC DRAWING NO.   | ....                                |        |
| SHEET  | OF                                  |        |

**P-14**


ISSUED FOR BID - 06/21/2019  
CAUTION: IF SHEET IS LESS THAN 34"x22" USE GRAPHIC SCALE.

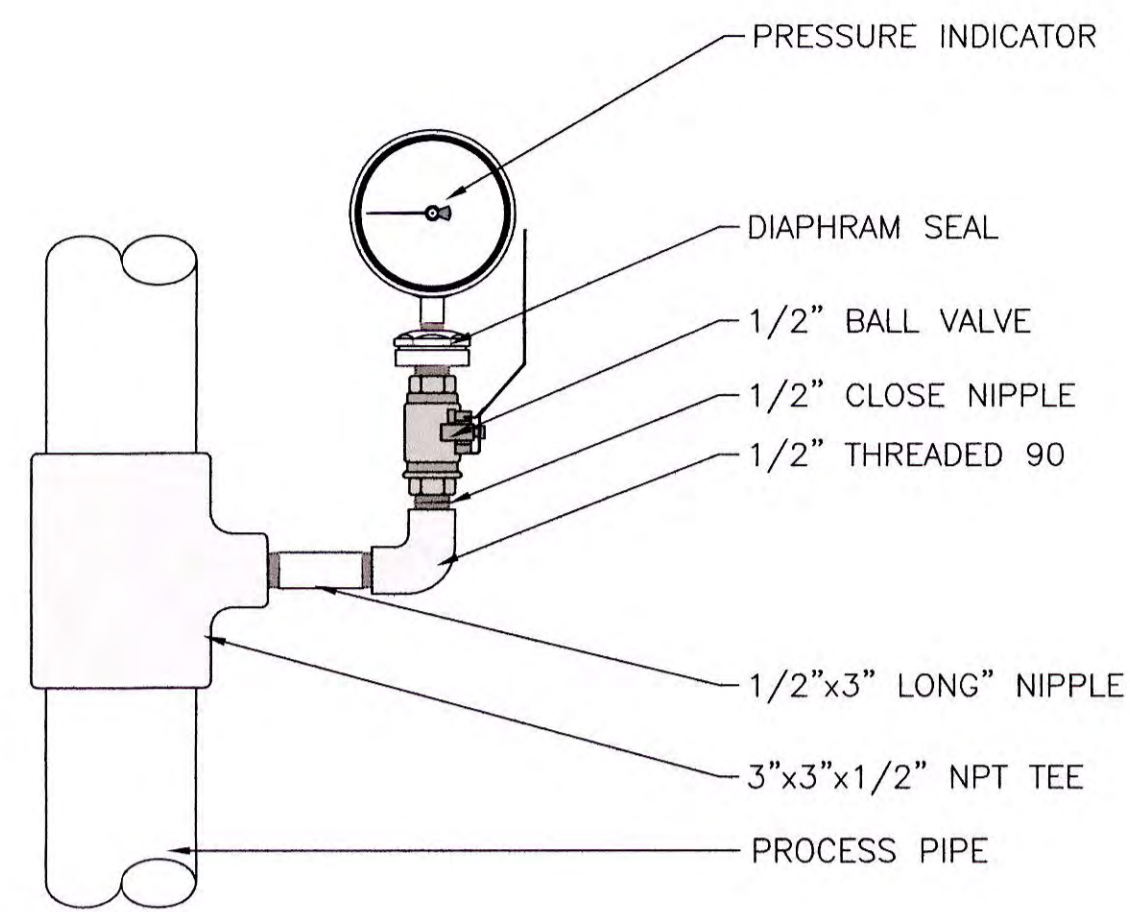


TYPICAL FOR ALL PUMP DISCHARGE INSTALLATIONS  
3" SHOWN - OTHERS TYPICAL

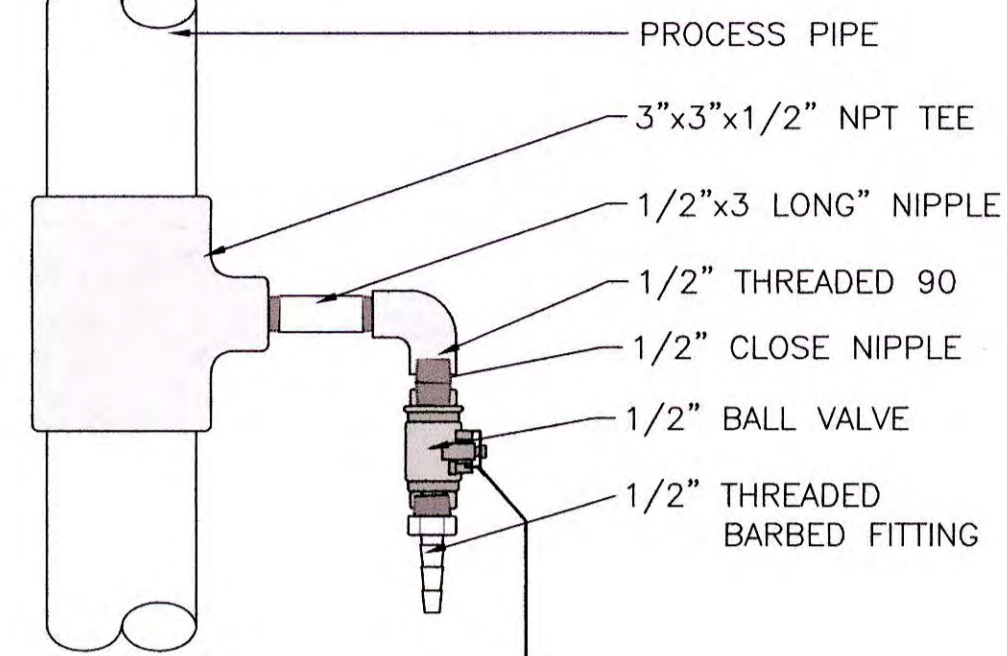


TYPICAL FOR ALL SAMPLE PORT INSTALLATIONS  
3" SHOWN - OTHERS TYPICAL  
MAX. HEIGHT 5'-0" AFF

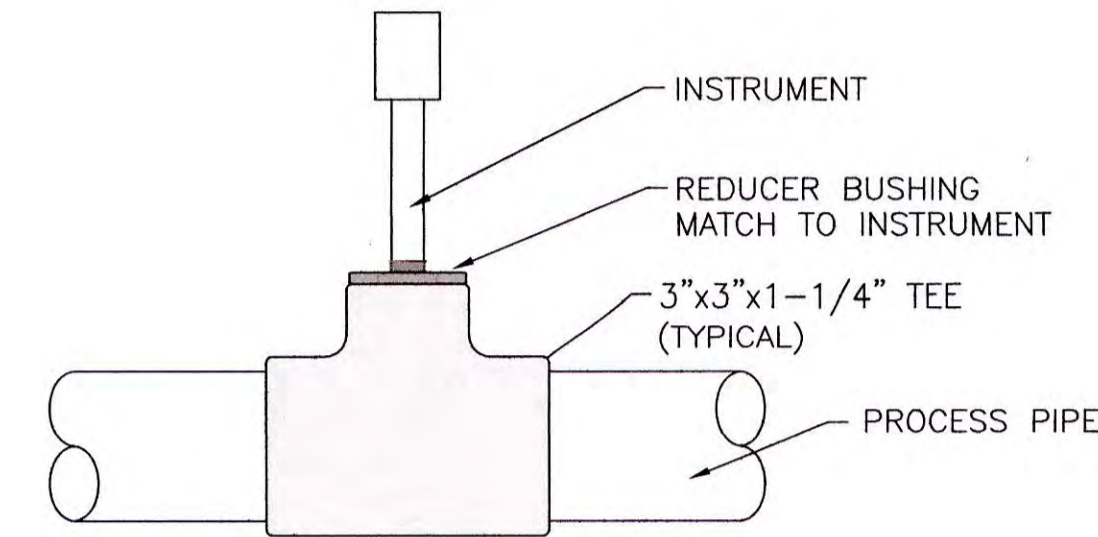


TYPICAL HANGER INSTALLATION  
Empire Ind. #11 or Equal.

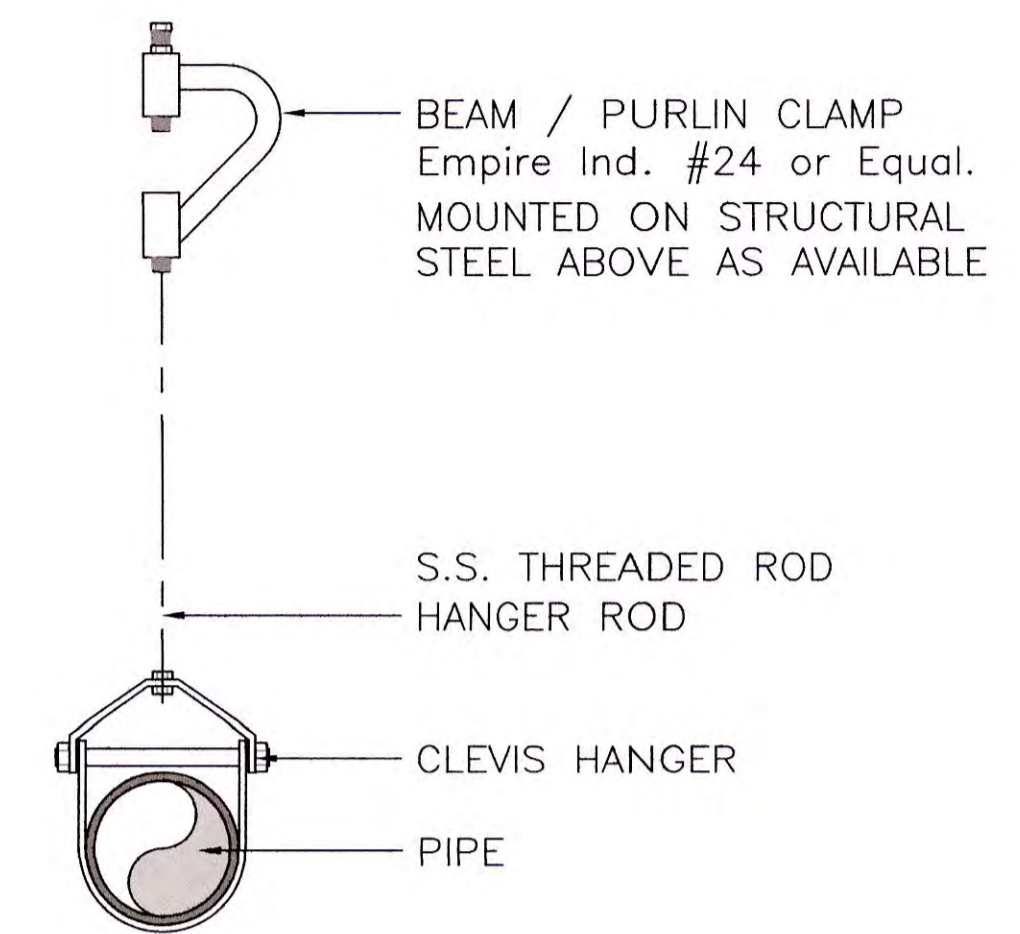


TYPICAL HANGER INSTALLATION  
Empire Ind. #11 or Equal.

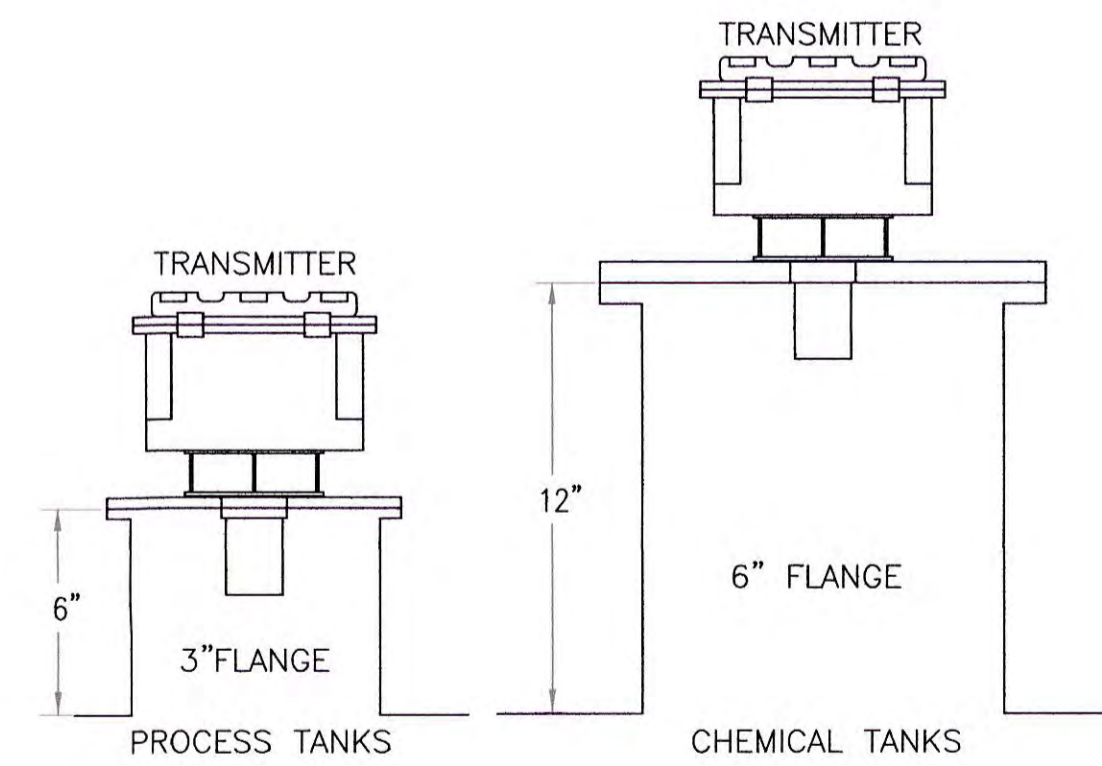


TYPICAL MOUNTING DETAIL  
FOR TRANSMITTERS

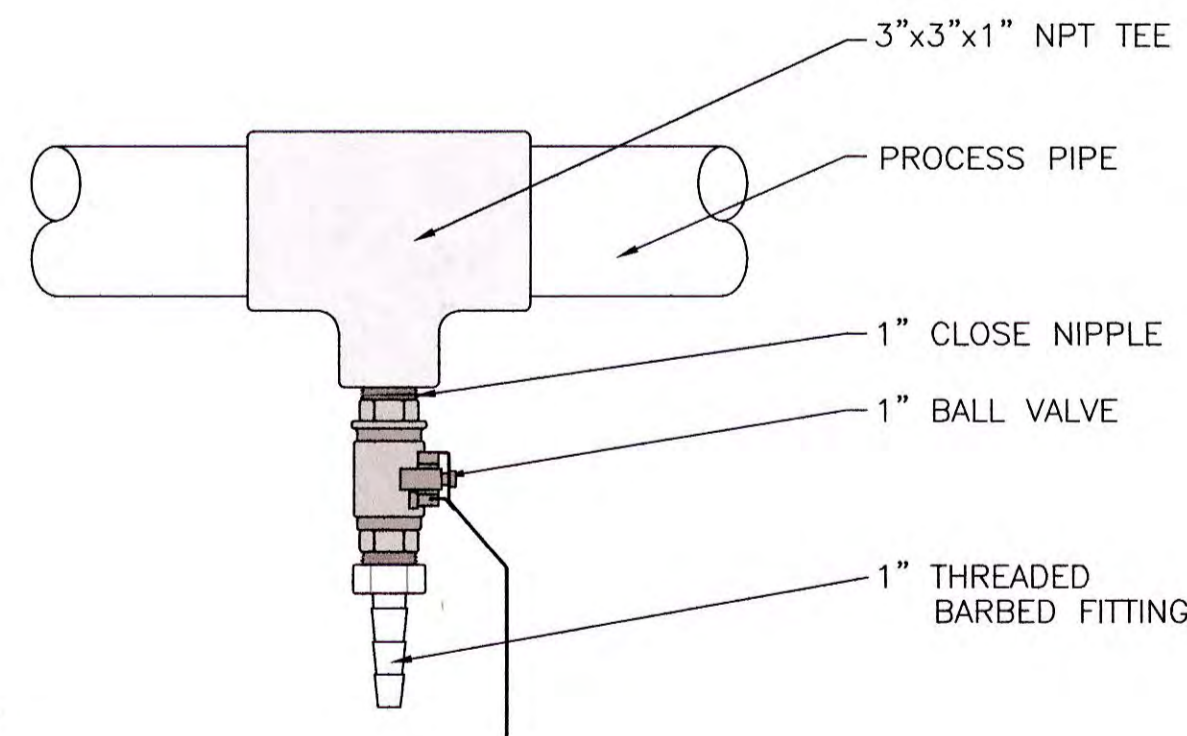


TYPICAL FOR ALL LOW POINT DRAIN INSTALLATIONS  
3" SHOWN - OTHERS TYPICAL

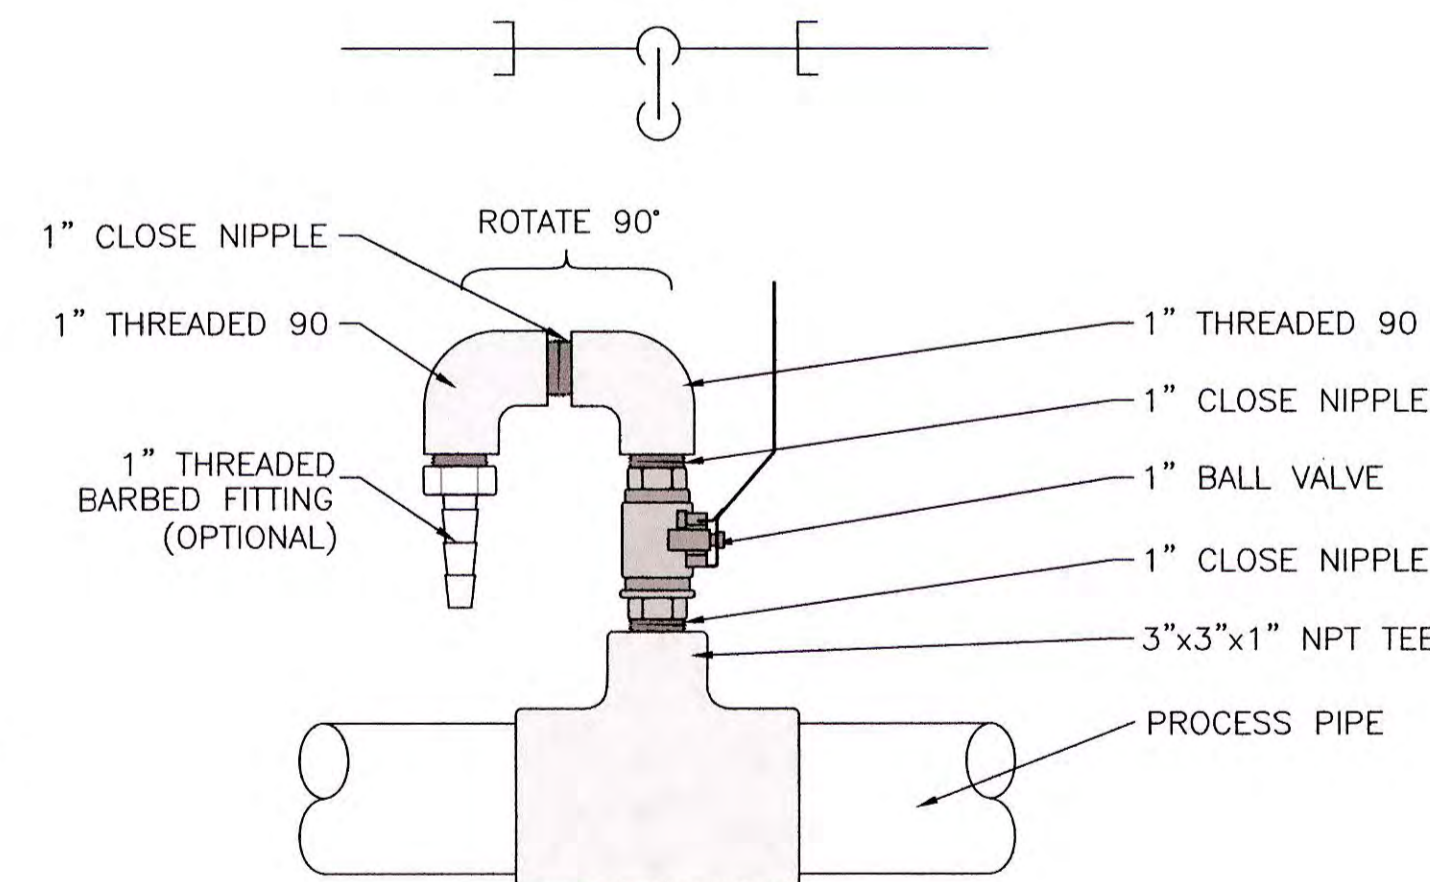

TYPICAL FOR ALL HIGH POINT VENT INSTALLATIONS  
3" SHOWN - OTHERS TYPICAL

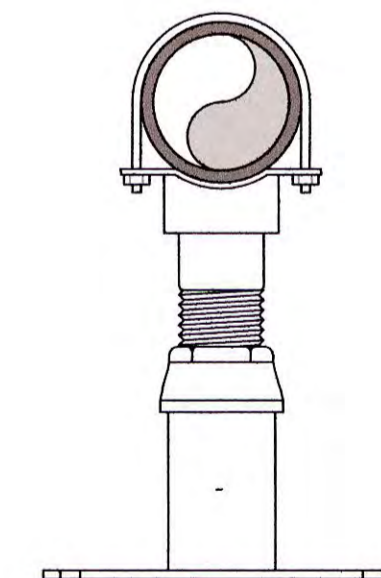

Adjustable Pipe Saddle Support  
Empire Ind. #427 or Equal.

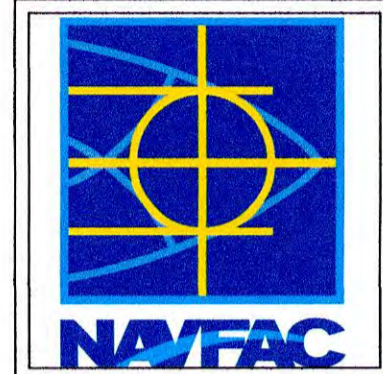

*Signature*  
6-21-2019

|                |     |    |     |
|----------------|-----|----|-----|
| DES            | HKM | DR | SNL |
| REVIEWED BY    | HKM |    |     |
| PM/DM          | HKM |    |     |
| CHIEF ENG/ARCH | HKM |    |     |

DEPARTMENT OF THE NAVY  
NAVAL FACILITIES ENGINEERING COMMAND ~ MID-ATLANTIC  
NAVAL INDUSTRIAL RESERVE ORDNANCE PLANT  
GM-38  
GM-38 AREA  
GROUNDWATER TREATMENT PLANT  
AOP SYSTEM ADDITION  
DETAILS

|  |                             |           |      |
|--|-----------------------------|-----------|------|
| THIS DRAWING PRODUCED ON AUTOCAD<br>DO NOT REVISE MANUALLY   | CODE ID. NO. 80091          | SIZE      | D    |
| THIS DOCUMENT IS THE PROPERTY OF<br>NAVAL FACILITIES ENGINEERING COMMAND,<br>PREPARED BY TETRA TECH ENGINEERING<br>CORPORATION PC, AND IS PROVIDED UPON THE<br>CONDITION THAT IT WILL NOT BE REPRODUCED,<br>COPIED, OR ISSUED TO A THIRD PARTY, AND WILL<br>BE USED SOLELY FOR THE ORIGINAL INTENDED<br>PURPOSE AND SOLELY FOR THE EXECUTION<br>OR REVIEW OF THE ENGINEERING CONSTRUCTION<br>OF THE PROJECT. | MAXIMO NO. 062470-08-0-1001 | SCALE:    | NTS  |
|  | JOB ORDER NO. WE-24         | SPEC. NO. |      |
|  | CONSTR. CONTR. NO.          |           |      |
|  | 112G08005                   |           |      |
|  | NAVFAC DRAWING NO.          |           |      |
|  | SHEET                       | OF        |      |
|  |                             |           | P-15 |

ISSUED FOR BID - 06/21/2019  
CAUTION: IF SHEET IS LESS THAN 34"x22" USE GRAPHIC SCALE

**ELECTRICAL LEGEND**

- EXISTING TO REMAIN
- EXISTING TO BE REMOVED
- NEW WORK
- EXTENT OF REMOVAL
- CONNECT NEW TO EXISTING
- DETAIL/EQUIPMENT BUBBLE
- REMOVAL NOTES
- NEW WORK NOTES FOR THE SHEET SHOWN
- 2x2' LAY-IN GRID FIXTURE # DENOTES TYPE
- 4' LINEAR SURFACE MTD FIXTURE LETTER DENOTE TYPE
- HIGH BAY LIGHT FIXTURE
- WALL MOUNTED FIXTURE LETTER DENOTES TYPE
- EXIT FIXTURE: WALL MOUNTED
- ELU: EMERGENCY LIGHTING UNIT
- LIGHTING SWITCH: '3' DENOTES 3-WAY
- TRANSFORMER
- DUPLEX RECEPTACLE: 20A, 125V, 2P GROUNDING
- DUPLEX RECEPTACLE: 20A, 125V, 2P GROUNDING, GROUND FAULT CIRCUIT INTERRUPTER
- NON-FUSED, HP-RATED DISCONNECT SWITCH VOLTAGE RATING AS REQUIRED, "30" INDICATES AVERAGE RATING, "3" INDICATES NUMBER OF POLES (TYP.)
- FUSED DISCONNECT SWITCH, HP-RATED
- COMBINATION FUSED DISCONNECT SWITCH WITH INTEGRAL MAGNETIC MOTOR STARTER. DISCONNECT SIZE AND FUSE RATING AS INDICATED.
- HP-RATED MOTOR STARTER
- JUNCTION BOX
- NEMA 6P SUBMERSIBLE, STAINLESS STEEL JUNCTION BOX UNLESS NOTED OTHERWISE (U.N.O.)
- EMERGENCY STOP-PUSH BUTTON STATION
- CONTROL STATION (SEL OR PB) SEE STARTER CIRCUITS FOR SPECIFIC TYPE
- THERMOSTAT
- MOTOR OR EQUIPMENT LOAD
- GROUNDING SYSTEM (3/4" DIA. ROD x 10'-0")

**ELECTRICAL ABBREVIATIONS**

|          |  |
|----------|--|
| CB/C.B.  | CIRCUIT BREAKER  |
| CIRC.    | CIRCUIT  |
| C.T.     | CURRENT TRANSFORMER  |
| DISC.    | DISCONNECT SWITCH  |
| DN       | DOWN   |
| DP       | DISTRIBUTION PANEL   |
| EDP      | EMERGENCY DISTRIBUTION PANEL   |
| ERP      | EMERGENCY RECEPTACLE PANEL   |
| EQUIP    | EQUIPMENT  |
| ER       | EXISTING TO REMAIN   |
| EUH      | ELECTRIC UNIT HEATER   |
| EX       | EXISTING   |
| EXR      | EXISTING TO REMAIN   |
| FACP     | FIRE ALARM CONTROL PANEL   |
| GFCI     | GROUND FAULT CIRCUIT INTERRUPTER (PERSONNEL)                                     |
| IC/ I.C. | INTERRUPTING CURRENT   |
| MCC      | MOTOR CONTROL CENTER   |
| MP       | MECHANICAL (POWER) PANEL   |
| MV       | MEDIUM VOLTAGE   |
| O/H, OH  | OVERHEAD   |
| PSEG     | PUBLIC SERVICE ENTERPRISES GROUP OF NEW YORK                                     |
| T        | TRANSFORMER  |
| TELCO    | TELEPHONE COMPANY  |
| U.O.N.   | UNLESS OTHERWISE NOTED   |
| U.N.O.   | UNLESS NOTED OTHERWISE   |
| UPS      | UNINTERRUPTIBLE POWER SUPPLY   |
| UPS Lxx  | UNINTERRUPTIBLE POWER SUPPLY LIGHTING (277/480 PANEL). 'XX' INDICATES BUILDING   |
| UPS Rxx  | UNINTERRUPTIBLE POWER SUPPLY RECEPTACLE (120/208 PANEL). 'XX' INDICATES BUILDING |
| WP       | WEATHERPROOF   |

**ELECTRICAL GENERAL NOTES:**

- WIRING AND CONDUIT SHALL BE RUN CONCEALED, WHERE POSSIBLE.
- CONTRACTOR SHALL IMMEDIATELY REPAIR AT NO COST TO THE OWNER ANY DAMAGE CAUSED BY THIS WORK.
- CONTRACTOR SHALL COORDINATE AND VERIFY ALL FIELD CONDITIONS, CLEARANCES AND WORKING SPACES WITH OTHER TRADES PRIOR TO THE START OF CONSTRUCTION.
- CONTRACTOR SHALL PROVIDE REVISED PANEL SCHEDULES FOR PANELBOARDS AFTER BALANCING LOAD AMONG PHASES IN THE PANELBOARD.
- CONTRACTOR SHALL LABEL RECEPTACLES WITH CIRCUIT NUMBER TO CORRESPONDING PANELBOARDS.
- WIRING SHALL MEET CURRENT NEW YORK & NEC CODES.
- RECEPTACLES SHALL BE GROUND FAULT INTERRUPTING (GFI/GFCI) - TYPE UNLESS NOTED OTHERWISE.
- CONTRACTOR SHALL PROVIDE SLEEVES AND SEALS WHERE REQUIRED.
- PENETRATIONS THROUGH FIRE RATED STRUCTURES (WALL/CEILING) SHALL HAVE AN APPROVED FIRE RATED STOPPING MATERIAL.
- DISCONNECT SWITCHES FOR MECHANICAL EQUIPMENT SHALL BE MOUNTED TO THE STRUCTURE, NOT TO THE EQUIPMENT UNLESS OTHERWISE NOTED. PROVIDE NECESSARY MOUNTING SUPPORT AS REQUIRED.
- MOTOR STARTERS FOR THE HVAC EQUIPMENT SHALL BE PROVIDED AND INSTALLED BY THE ELECTRICAL CONTRACTOR PER MANUFACTURERS INSTRUCTIONS OF HVAC EQUIPMENT. THE STARTER SHALL BE PROVIDED WITH HAND-OFF-AUTO SWITCH, PUSH TO TEST TYPE PILOT LIGHTS (RED-ON & GREEN-OFF), RESET BUTTON, CONTROL COIL, CONTACTOR WITH MINIMUM OF TWO SETS OF 'N.O.' & 'N.C.' CONTACTS. THE STARTER SHALL BE PROVIDED WITH CONTROL (FOR AUTOMATIC START/STOP PER SEQUENCE OF OPERATION) AND POWER WIRING IN CONDUIT.
- DISCONNECT SWITCHES SHALL BE HORSEPOWER RATED WITH VOLTAGE RATINGS & NUMBER OF POLES AS REQUIRED FOR EQUIPMENT ENCLOSURE TYPE SHALL BE NEMA 4X STAINLESS STEEL UNLESS NOTED OTHERWISE.
- CONDUIT AND WIRING FOR PRIMARY AND SECONDARY SIDE OF UTILITY TRANSFORMER SHALL BE COORDINATED WITH PSIG LONG ISLAND INCLUDING BUT NOT LIMITED TO ADVANCE NOTICE PRIOR TO ANY DEMOLITION AND/OR INSTALLATION WORK AND TAKING OUT THE NECESSARY WORK PERMITS.
- PROVIDE MATCHING CONDUIT-WIRING (UNDERGROUND AND OVERHEAD POWER SERVICE) THROUGH THE ELECTRICAL CONTRACTOR. ALL MATERIALS & SERVICE RELATED WORK SHALL BE PROVIDED IN COORDINATION WITH PSEG. THE ABOVE SHALL INCLUDE BUT IS NOT LIMITED TO THE FOLLOWING ITEMS:
  - PROVIDE UNDERGROUND 4" SCHEDULE 40 PVC CONDUITS FROM PRIMARY SIDE OF THE NEW UTILITY TRANSFORMER FOR MV CABLES AND EXTEND CONDUIT WITH CABLE UP TO NEW POLE MINIMUM OF 20'-0" ABOVE FINISHED GRADE OR AS DIRECTED BY PSEG. CONCRETE ENCASED CONDUIT DUCTBANK SHALL BE MIN 24" BELOW FINISHED GRADE.
  - PROVIDE MV CABLE IN CONDUIT AS STATED IN 15.1 ABOVE. PROVIDING ENOUGH SLACK OF CABLE SO THAT PSEG CAN BE ABLE TO CONNECT TO THE OVERHEAD MV WIRING ON POLE. COORDINATE WITH PSEG AND OWNER IN ADVANCE. PRIMARY CABLE SHALL BE MIN. (2) #2 OR 1/0 AL OR COPPER.
  - PROVIDE PROPER SIZE WIRE TROUGH WITH STEEL SUPPORT TO SPLIT MAIN POWER SERVICE INTO TWO NEW FUSED DISCONNECT SWITCHES AS INDICATED.
  - PROVIDE FEES AND ANY COSTS ASSOCIATED WITH BILL OF MATERIALS REQUIRED TO HAVE SERVICES.
  - PROVIDE OVERHEAD SERVICE DROP MV CABLES & CONDUITS WITH MV CABLES. CONDUITS SHALL BE PROPERLY CLAMPED ALONG POLE. CABLE LENGTH SHALL BE LEFT ENOUGH FOR PSEG TO MAKE FINAL CONNECTIONS AT THE POLE. THE ADDITIONAL CABLE SHALL BE COILED WITH A KELLUMS GRIP BASKET WITHOUT BEING DAMAGED BY BENDING AND IT SHALL BE ATTACHED TO THE POLE TO PREVENT DAMAGE OR VANDALISM. BOTH ENDS OF CABLES SHALL BE CAPPED WITH APPROVED TIGHT FITTING WATER TIGHT SEALING CAPS.
  - PROVIDE GROUND ROD & GROUNDING WIRE.
  - PROVIDE ANCHORS ON POLE, CLAMPS (GALVANIZED) AND ON WITH ALL NECESSARY HARDWARE, MAST, CLEVIS, INSULATOR, WEATHER PROOF METAL CONDUIT THREADED LBL EXPANSION JOINTS WHEREVER THEY ARE REQUIRED.
  - REPAIR ANY DAMAGES TO MATCH EXISTING AT NO ADDITIONAL COST TO THE OWNER.
  - PROVIDE TRANSFORMER PAD WITH CONCRETE VAULT IN COORDINATION WITH PSEG.
  - ALL ELECTRICAL WORK AND MATERIALS SHALL BE PROVIDED BY THE CONTRACTOR PER ELECTRICAL INSTALLATION SPECIFICATIONS FOR CUSTOMER AND CONTRACT PROVIDED IN ATTACHMENT 'A' TO SPECIFICATION 26 05 00.
- CONTRACTOR MUST CONTACT "MISS UTILITY" PRIOR TO CONSTRUCTION. ALL EXISTING UTILITIES (SANITARY, STORM WATER LINE, TELEPHONE AND COMMUNICATION LINES SHALL BE IDENTIFIED FOR PHYSICAL PROTECTION. IF ANY UTILITY LINE COMES IN THE SAME HORIZONTAL AND/OR VERTICAL LINE OR IN NEARBY LINE OF PROPOSED POWER LINE, BOTH SHALL BE CONCRETE ENCASED AND MUST MAINTAIN SLOPES AND INVERTS OF EXISTING UTILITY. EXTEND CONCRETE ENCASUREMENTS MINIMUM OF 24" ON ALL SIDES OF THAT INTERSECTION.
- PROVIDE GROUNDING CONNECTIONS WITH #4/0 COPPER WIRE AT MINIMUM OF TWO PLACES OF METAL FRAME STRUCTURE OF NEW EQUIPMENT WITH ALL NECESSARY ACCESSORIES AND HARDWARE.

**ELECTRICAL DEMOLITION WORK NOTES:**

- DISCONNECT AND REMOVE EXISTING 15 KV PRIMARY POWER CABLES FROM SIDE OF EXISTING 500 KVA OIL FILLED PAD MOUNTED TRANSFORMER.
- DISCONNECT EXISTING SECONDARY CABLES & CONDUITS (2) FROM THE SECONDARY SIDE OF THE TRANSFORMER AND REMOVE EXISTING TRANSFORMER, CONCRETE PAD AND BOLLARDS WITH ALL ACCESSORIES. PATCH AND REPAIR AREA TO MATCH EXISTING.
- DISCONNECT & REMOVE EXISTING WIRES & EXISTING (2) 4" CONDUITS. EXISTING CONDUITS CAN BE RE-USED IF POSSIBLE.
- PRIOR TO CONSTRUCTION, CONTRACTOR MUST COORDINATE WITH POWER COMPANY. (PSEG) TO GET SHUT DOWN.
- REMOVE EXISTING BONDING & WIRING FROM GROUNDING SYSTEM TO NEUTRAL TERMINAL.

**ELECTRICAL NEW WORK NOTES:**

- PROVIDE 800A, 600V, 3P, 4W SERVICE RATED TYPE FUSED DISCONNECT SWITCH IN NEMA 4X STAINLESS STEEL ENCL. PROVIDE (6) 800A FUSES TIME DELAY FUSE W/ 3 SPARES. PROVIDE COPPER NEUTRAL & GROUNDING KITS.
- PROVIDE 400A, 600V, 3P, 4W SERVICE RATED TYPE FUSED DISCONNECT SWITCH IN NEMA 4X STAINLESS STEEL ENCL. PROVIDE (6) 300A FUSES TIME DELAY FUSE W/ 3 SPARES. PROVIDE COPPER NEUTRAL & GROUNDING KITS.
- PROVIDE 3-4C, EA WITH (4) #350KCMIL, (1# 2/0 G)
- PROVIDE 2-4"C, EA WITH (4) #4/0, (1) #2 G)
- PROVIDE 1" C WITH #3/0 G. PER NEC 250. PROVIDE BONDING BETWEEN NEUTRAL AND GROUNDING BUSES.
- REPLACE EX. 13.2KV, 40A LINE FUSES (3) WITH MATCHING 100A FUSES (3).
- MIN. 16"D x 14"H NEMA 4x, FULL LENGTH HINGED DOOR STEEL WIRE TROUGH WITH LENGTH TO BE DETERMINED AT THE SITE CONDITION.
- FINAL REPLACEMENT PROCEDURE AND SIZE & TYPE OF 15KV UNDERGROUND CABLE/OVERHEAD CABLE LINE FUSES SHALL BE DETERMINED BY THE UTILITY COMPANY. COORDINATE ALL ASSOCIATED MATERIALS & WORK. PROVIDE UNDERGROUND CONCRETE ENCASED SCH. 40 PVC CONDUIT AS REQUIRED WITH (1) 4" CONDUIT SPARE.
- PROVIDE (4) 4"C EACH WITH (4) #350 KCMIL, XHHW CABLES.
- PROVIDE (1) 2"C WITH PULL STRING FROM EACH PDC AND SCC TO WALL MOUNTED NEMA 4x JUNCTION BOX (SIZE PER NEC). PROVIDE (2) 2"C TO BE ROUTED TO TERMINATE ALL CONTROL & DATA WIRING OF PDC/SSC ABOVE VIA JUNCTION BOX TO EXISTING MAIN CONTROL CENTER I/O CABINET IN CONTROL ROOM.
- PROVIDE MV CABLE IN CONCRETE ENCASED SCHEDULE 40 PVC CONDUIT EXTENDING MINIMUM OF 30" OF THE DRIVEWAY. TOP OF CONCRETE ENCASED DUCTBANK SHALL BE A MINIMUM OF 30" BELOW FINISHED GRADE. CONDUITS SHALL BE MINIMUM OF 2" COVERED WITH CONCRETE. PROVIDE "WARNING TAPE" PER SPECIFICATIONS.
- PROVIDE 45KVA, 3 PH, DRY TYPE TRANSFORMER IN NEMA 4x ENCLOSURE. PROVIDE MOUNTING BRACKET TO BE WELDED/BOLTED FROM STRUCTURAL STEEL OF BUILDING.
- PROVIDE CONDUIT & WIRING FOR POWER AND CONTROL FOR HEAT TRACE CABLE IN COORDINATION WITH MECHANICAL AND PLUMBING CONTRACTOR. PROVIDE LOCAL SWITCH.
- PROVIDE (4) #2/0 & (1) #4G, 1"C.
- PROVIDE (1) #4G, 1"C.
- PROVIDE LOCAL DISCONNECTING MEANS WITH WIRING IN ACCORDANCE WITH MANUFACTURERS RECOMMENDATIONS.
- EXISTING MAIN CIRCUIT BREAKER IS SERVICE ENTRANCE TYPE, SQ D, MODEL #PLP34080C1U444ASA WITH 42KAIC RATING AT 480V AND IT HAS TRIPPING UNIT WITH CT IN NEUTRAL. REMOVE BONDING WIRE BETWEEN NEUTRAL AND GROUNDING SYSTEM. REPLACE EXISTING TRIPPING UNIT WITH A NEW SQ.D. 'LSIG' TRIPPING UNIT.
- PROVIDE UTILITY COMPLIANT METER AND MINIMUM 1-1/2" RGS CONDUIT TO C.T. CABINET.
- PROVIDE 36"x36"x12" OR SIZED PER NEC PULL BOX IN 4x STAINLESS STEEL ENCLOSURE WITH FULL SIZE HINGED LOCKABLE DOOR.
- PROVIDE ENGRAVED SIGNAGE LABELS FOR SERVICE DISCONNECT SWITCHES AND LABEL DISCONNECTS "SERVICE DISCONNECT 1 OF 2" FOR 800A AND "SERVICE DISCONNECT 2 OF 2" FOR 400A.
- PROVIDE OVER 15KV WIRING TO EXTEND WIRING FROM EXISTING O/H POLE 1/16" PER PSEG.
- FAULT CURRENT VALUES SHOWN ARE BASED ON AVAILABLE FAULT CURRENT OF 31KA, WHICH HAS BEEN PROVIDED BY PSEG VIA EMAIL ON 06-14-2019. CALCULATED FAULT CURRENT SHOWN AT OTHER DOWNSTREAM OF EQUIPMENT ARE ONLY FOR INFORMATION PURPOSES ONLY. ACTUAL FAULT CURRENT VALUES SHALL BE CALCULATED BY THE CONTRACTOR TO DETERMINE SHORT CIRCUIT CURRENT WITHSTANDING RATINGS IN SHOP DRAWING. SHORT CIRCUIT CALCULATION SHALL BE BASED ON ACTUAL LENGTHS OF FEEDERS, BRANCHES, SIZES, TYPES OF CABLES AND TYPES OF CONDUITS (MAGNETIC OR NON-MAGNETIC).

**ELECTRICAL SHEET NOTES:**

- FOR SITE PLAN REMOVAL AND NEW WORK, REFER TO SHEET E-100.
- FOR FLOOR PLAN NEW WORK, REFER TO SHEET E-101.
- FOR SINGLE LINE DIAGRAM REMOVAL WORK, REFER TO SHEET E-601.
- FOR SINGLE LINE DIAGRAM NEW WORK, REFER TO SHEET E-602.
- FOR SCHEDULES REFER TO SHEET E-603.


|   |                  |      |     |
|---|------------------|------|-----|
| DATE  | APPR             |      |     |
| DESCRIPTION   | SYN              |      |     |
|   |                  |      |     |
|   |                  |      |     |
|   |                  |      |     |
| DES   | KKG              | DR   | JS  |
| REVIEWED BY   | KKG              |      |     |
| PM/DM   | HKH              |      |     |
| CHIEF ENG/ARCH  | HKH              |      |     |
| NAVAL FACILITIES ENGINEERING COMMAND<br>NAVAL FACILITIES ENGINEERING COMMAND ~ MID-ATLANTIC<br>NAVAL WEAPONS INDUSTRIAL RESERVE PLANT GM-38 AREA<br>NAVAL INDUSTRIAL RESERVE ORDNANCE PLANT BETHPAGE, NEW YORK<br>GROUNDWATER TREATMENT PLANT<br>AOP SYSTEM ADDITION  |                  |      |     |
| <b>ELECTRICAL GENERAL NOTES, LEGEND &amp; ABBREVIATIONS</b>   |                  |      |     |
| THIS DRAWING PRODUCED ON AUTOCAD DO NOT REVISE MANUALLY   |                  |      |     |
| CODE ID. NO.  | 80091            | SIZE | D   |
| SCALE:  |                  |      | NTS |
| THIS DOCUMENT IS THE PROPERTY OF NAVAL FACILITIES ENGINEERING COMMAND, PREPARED BY TETRA TECH ENGINEERING CORPORATION PC, AND IS PROVIDED UPON THE CONDITION THAT IT WILL NOT BE REPRODUCED, COPIED, OR ISSUED TO A THIRD PARTY, AND WILL BE USED SOLELY FOR THE ORIGINAL INTENDED PURPOSE AND SOLELY FOR THE EXECUTION OR REVIEW OF THE ENGINEERING CONSTRUCTION OF THE PROJECT. |                  |      |     |
| IT IS A VIOLATION OF THE NEW YORK STATE EDUCATION LAW, ARTICLE 145, FOR ANY PERSON, UNLESS UNDER THE DIRECTION OF A NEW YORK STATE LICENSED PROFESSIONAL ENGINEER, TO ALTER AN ITEM ON THIS DOCUMENT IN ANY WAY.  |                  |      |     |
| MAXIMO NO.  | N62470-08-0-1001 |      |     |
| JOB ORDER NO.   | WE-24            |      |     |
| SPEC. NO.   |                  |      |     |
| CONSTR. CONTR. NO.  | N62472-99-0-0032 |      |     |
|   | 112G08005        |      |     |
| NAVAFAC DRAWING NO.   |                  |      |     |
| SHEET   | OF               |      |     |
| <b>E-001</b>  |                  |      |     |

ISSUED FOR BID - 06/21/2019


CAUTION: IF SHEET IS LESS THAN 34"x22" USE GRAPHIC SCALE

**ELECTRICAL SHEET NOTES:**

1. FOR LEGEND, ABBREVIATIONS, GENERAL AND WORK NOTES, REFER TO SHEET E-001.
2. FOR FLOOR PLAN NEW WORK, REFER TO SHEET E-101.
3. FOR SINGLE LINE DIAGRAM REMOVAL WORK, REFER TO SHEET E-601.
4. FOR SINGLE LINE DIAGRAM NEW WORK, REFER TO SHEET E-602.
5. FOR SCHEDULES REFER TO SHEET E-603.

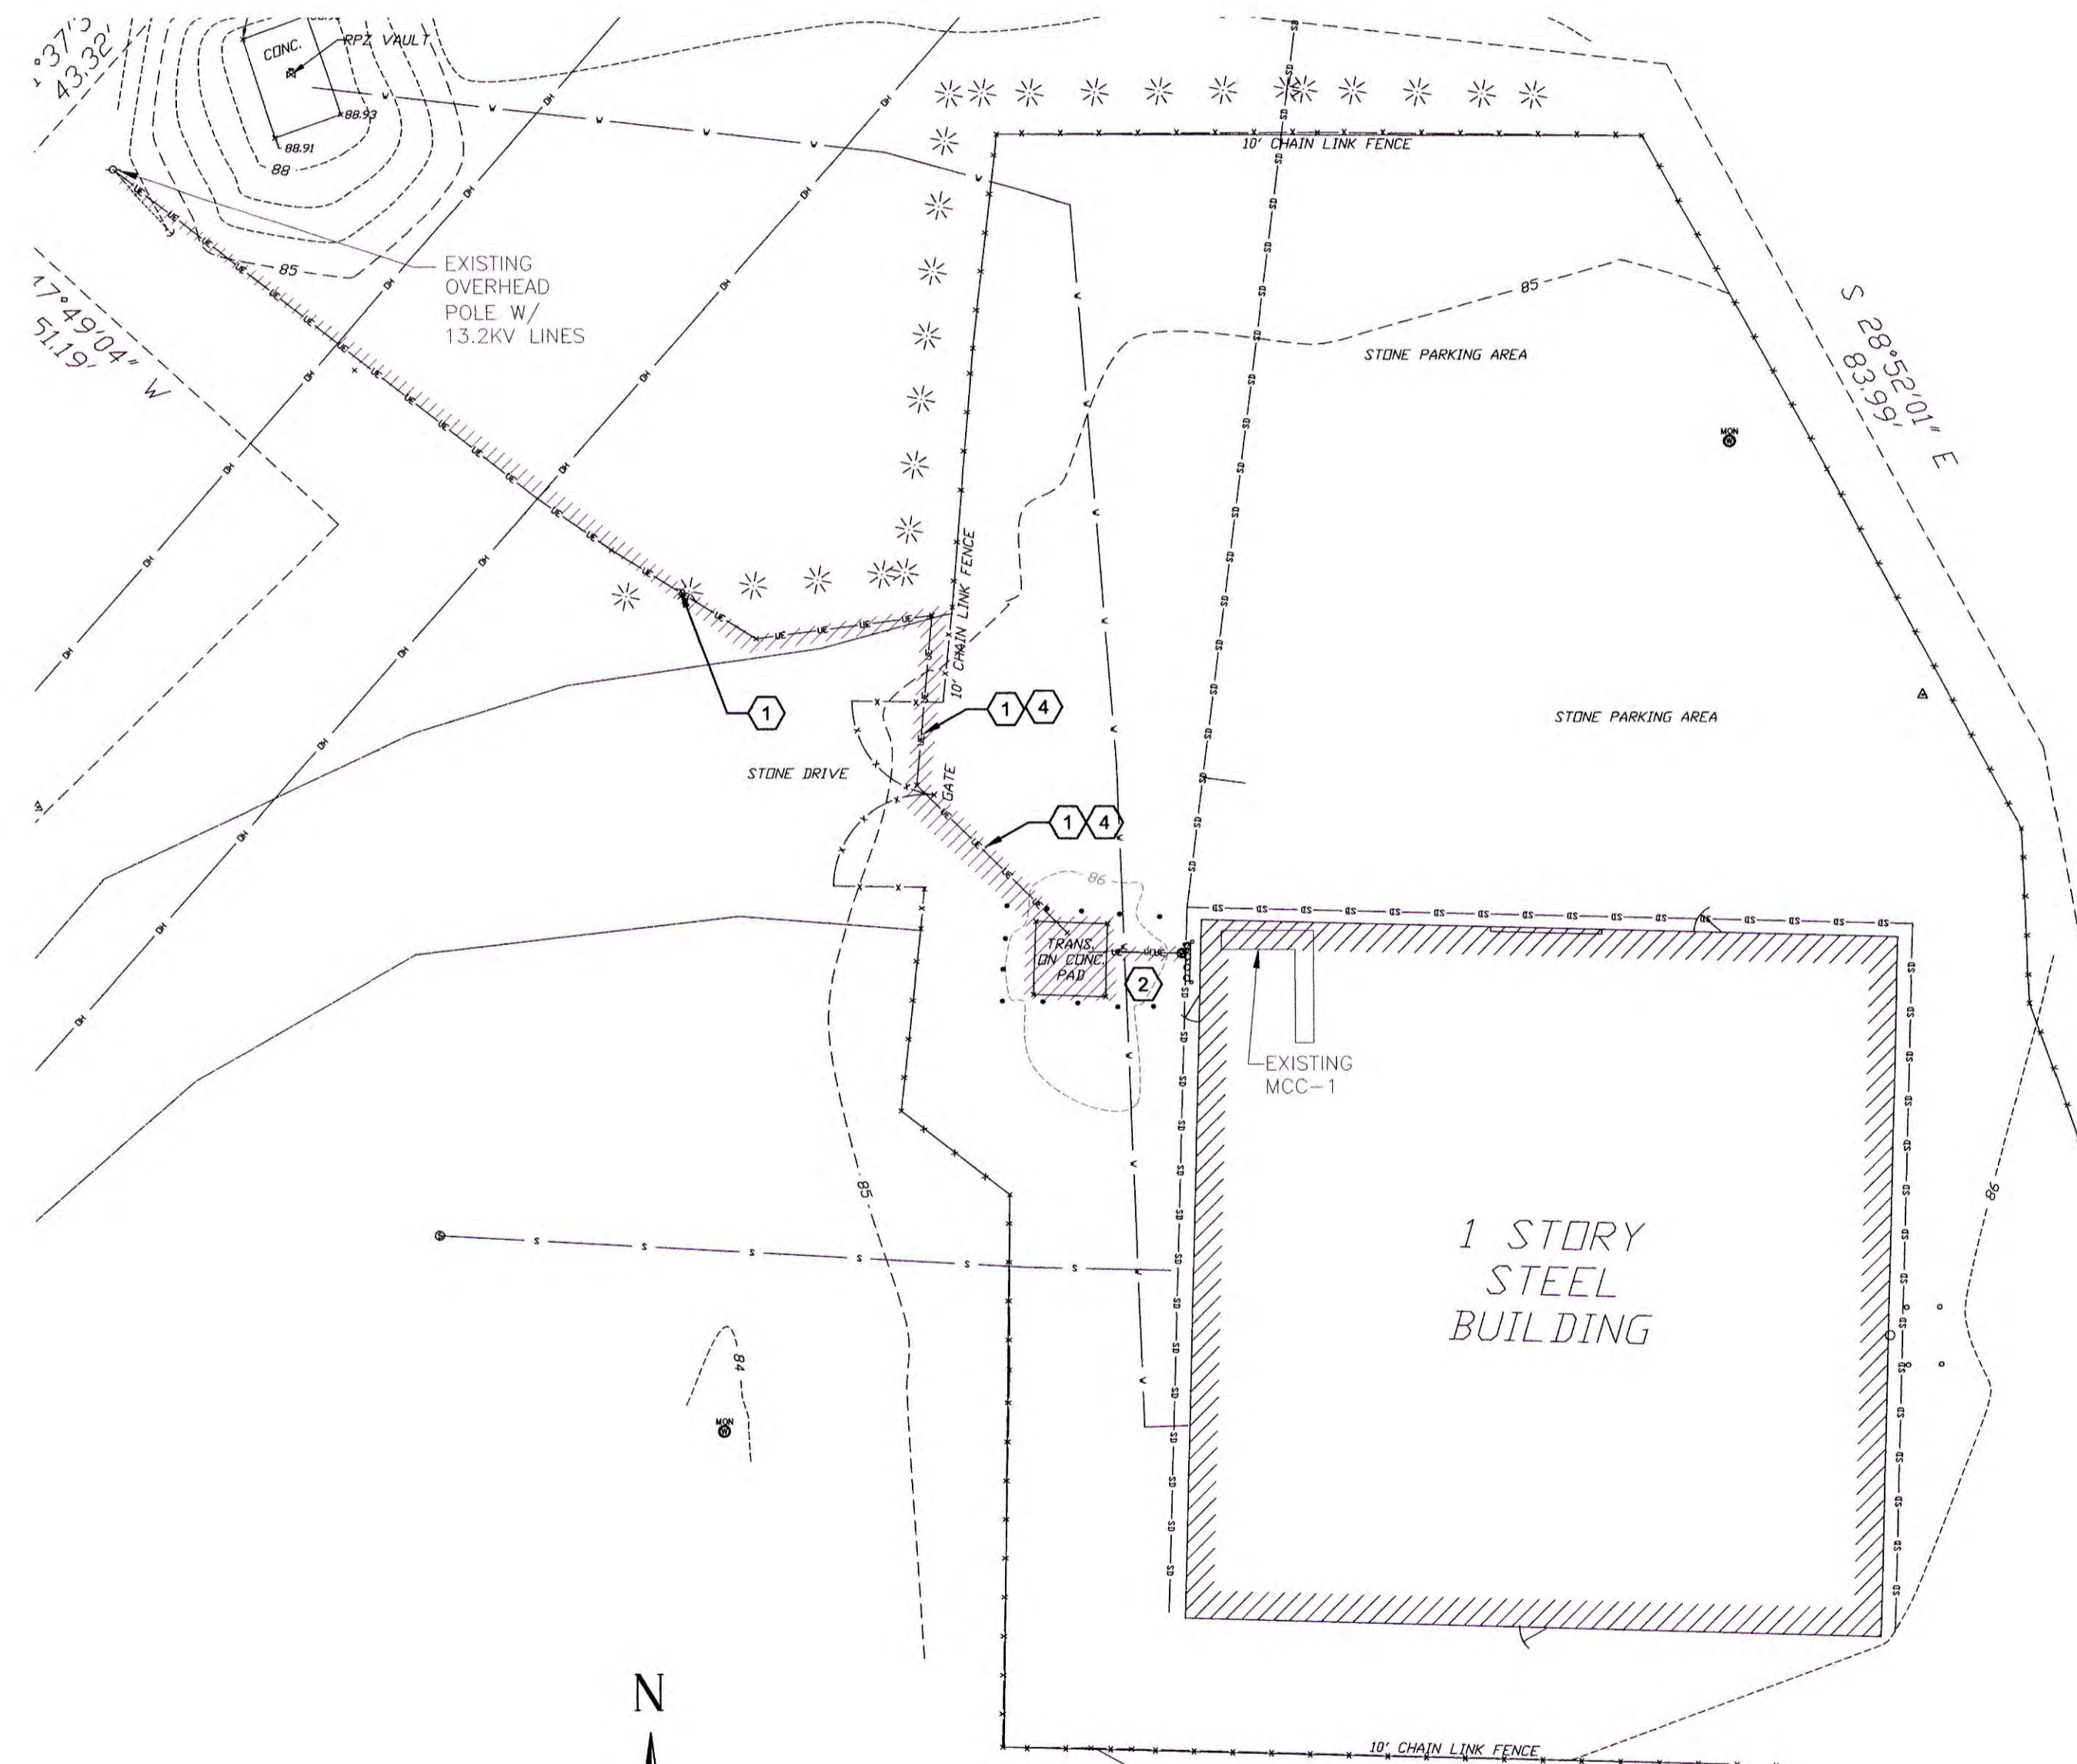

**1 SITE PLAN - REMOVAL WORK**  
E-100 SCALE: 1/16"=1'-0"

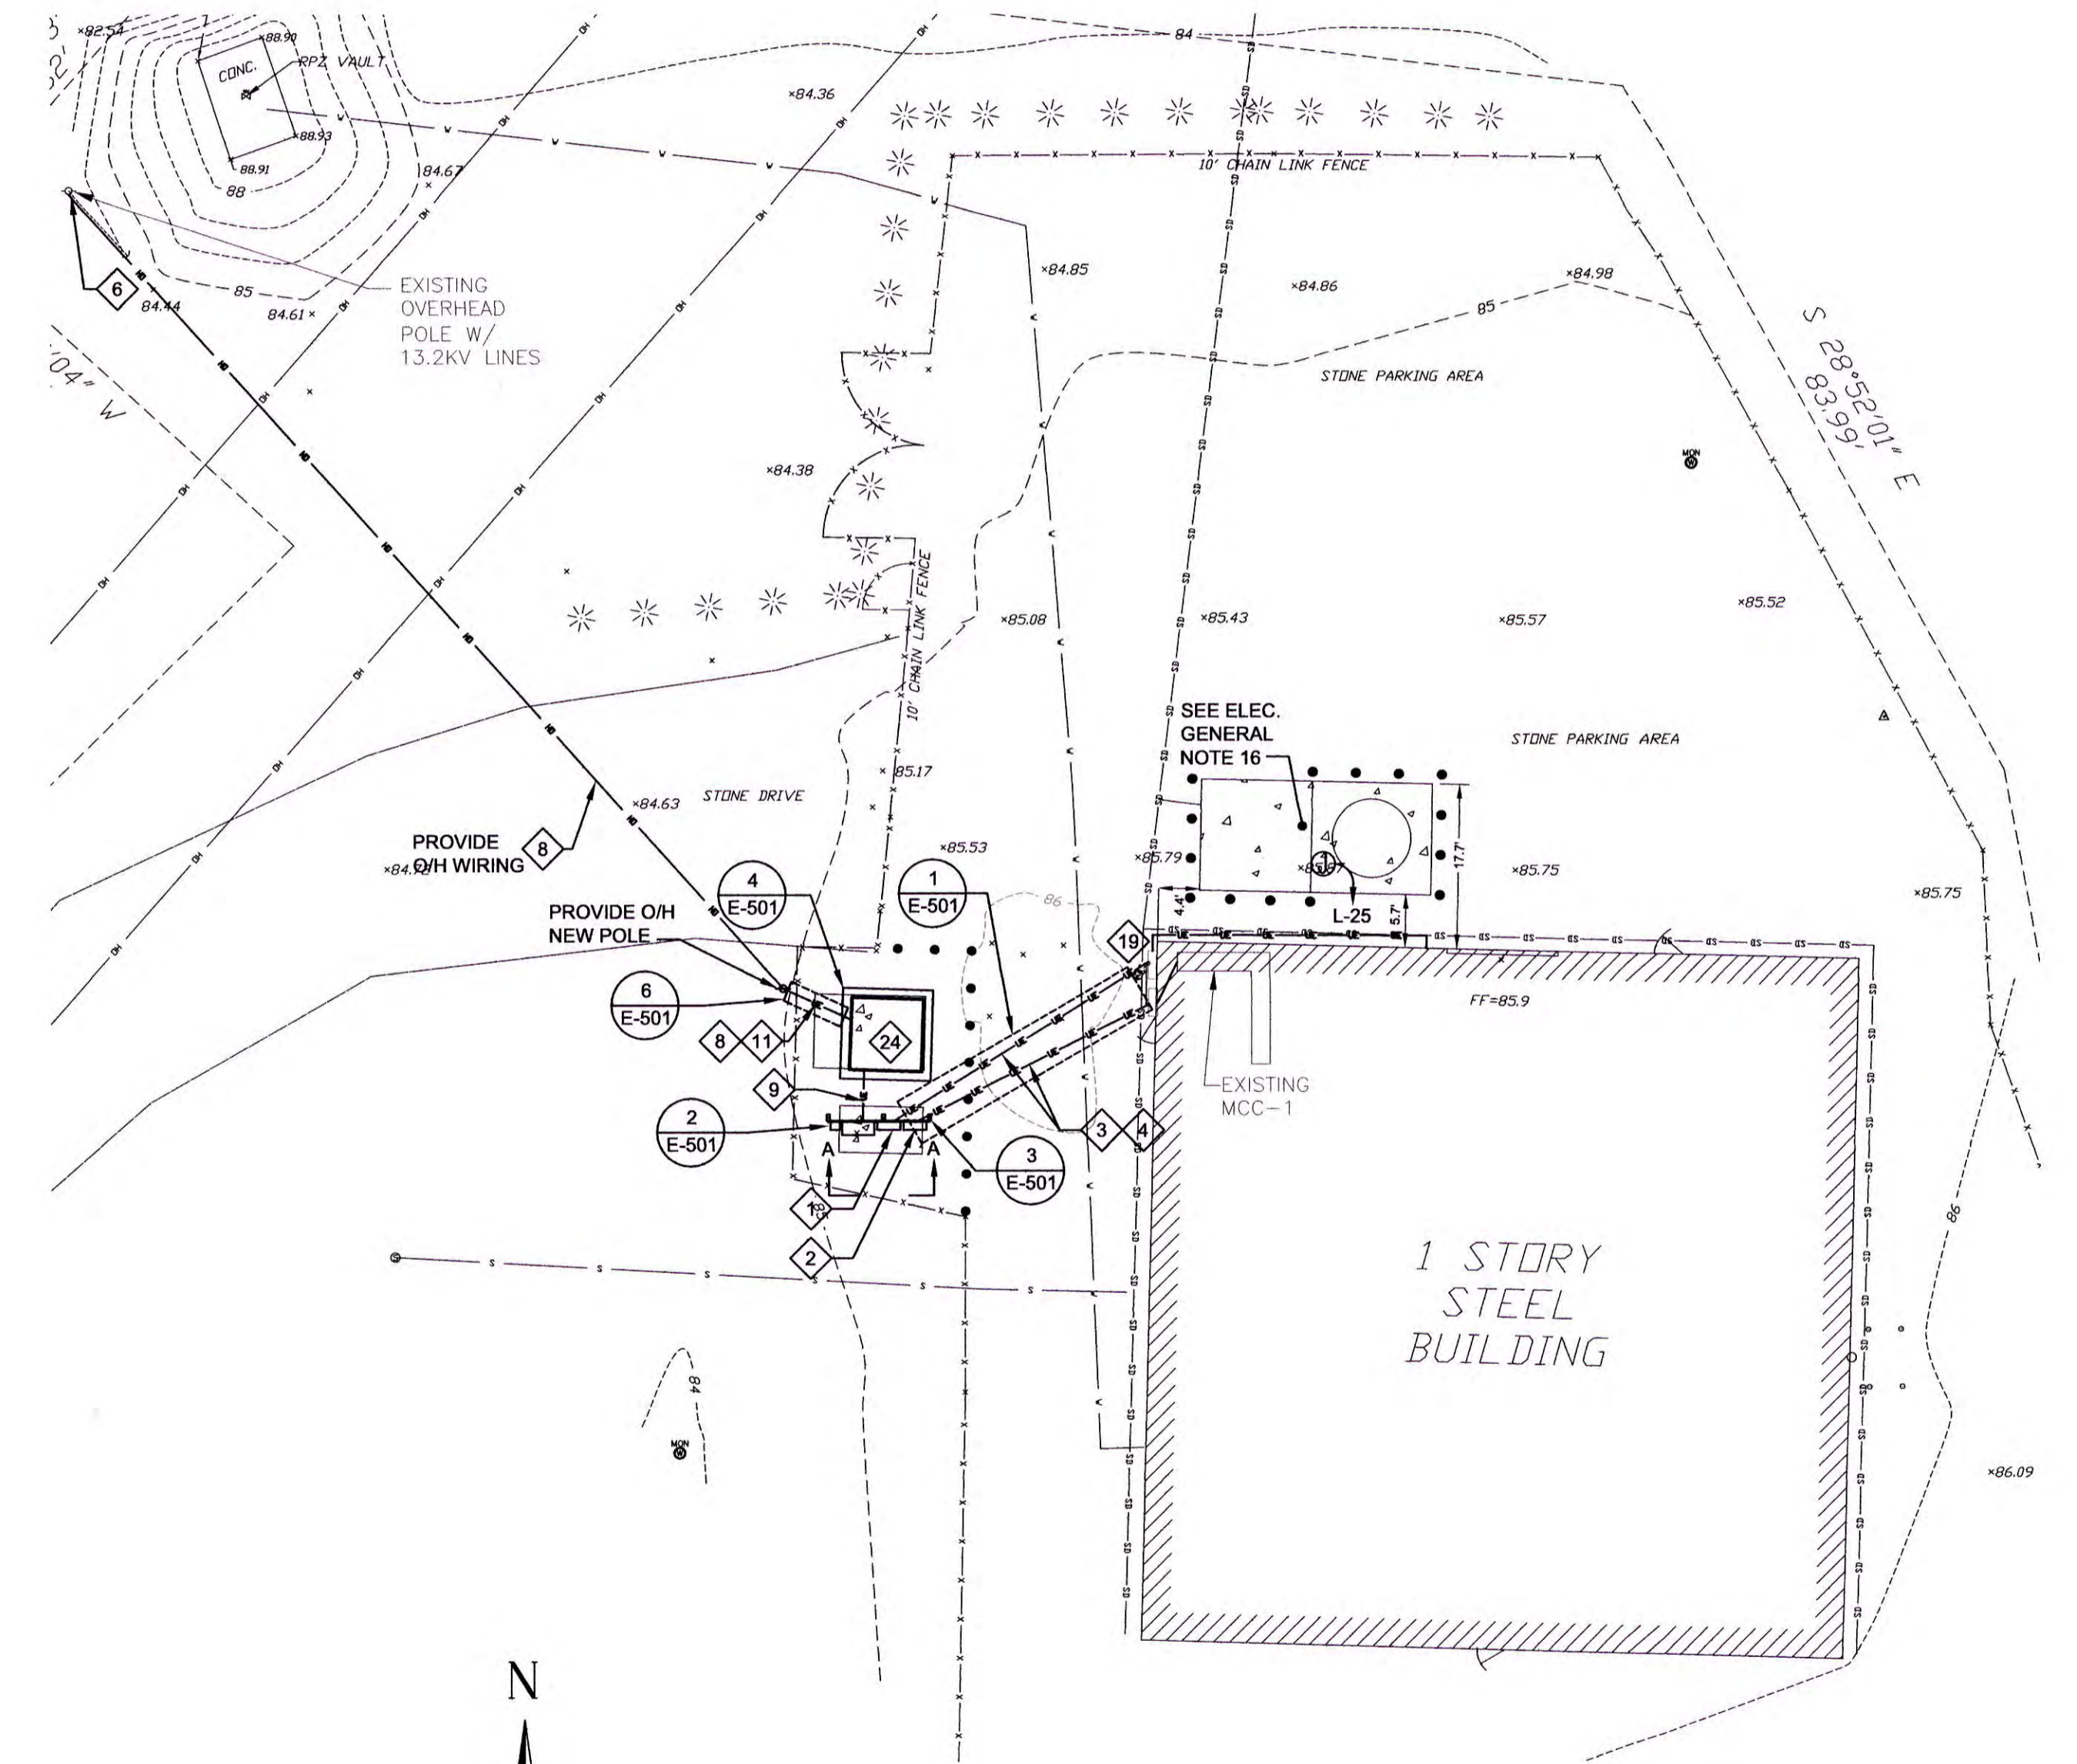

**2 SITE PLAN - NEW WORK**  
E-100 SCALE: 1/16"=1'-0"

THIS DRAWING PRODUCED ON AUTOCAD  
DO NOT REVISE MANUALLY


THIS DOCUMENT IS THE PROPERTY OF  
NAVAL FACILITIES ENGINEERING COMMAND,  
PREPARED BY TETRA TECH ENGINEERING  
CORPORATION PC, AND IS PROVIDED UPON THE  
CONDITION THAT IT WILL NOT BE REPRODUCED,  
COPIED, OR ISSUED TO A THIRD PARTY, AND WILL  
BE USED SOLELY FOR THE ORIGINAL INTENDED  
PURPOSE AND SOLELY FOR THE EXECUTION  
OR REVIEW OF THE ENGINEERING CONSTRUCTION  
OF THE PROJECT.

|                                     |         |
|-------------------------------------|---------|
| CODE ID. NO. 80091                  | SIZE: D |
| SCALE: NTS                          |         |
| MAXIMO NO. N62470-08-D-1001         |         |
| JOB ORDER NO. WE-24                 |         |
| SPEC. NO.                           |         |
| CONSTR. CONTR. NO. N62472-99-D-0002 |         |
| 112G08005                           |         |
| NAVFAC DRAWING NO.                  |         |
| SHEET                               | OF      |

**ISSUED FOR BID - 06/21/2019**

CAUTION: IF SHEET IS LESS THAN 34"x22" USE GRAPHIC SCALE

E-100

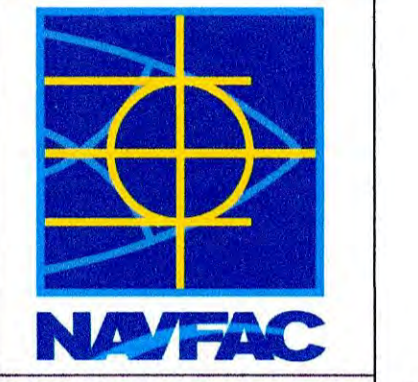

DEPARTMENT OF THE NAVY  
NAVAL FACILITIES ENGINEERING COMMAND  
NAVAL FACILITIES ENGINEERING COMMAND ~ MID-ATLANTIC  
NAVAL WEAPONS INDUSTRIAL RESERVE PLANT GM-38 AREA  
NAVAL WEAPONS INDUSTRIAL RESERVE PLANT GM-38 AREA  
GROUNDWATER TREATMENT PLANT  
AOP SYSTEM ADDITION  
ELECTRICAL SITE PLAN REMOVAL & NEW WORK

|                |     |    |    |
|----------------|-----|----|----|
| DIES           | KKG | DR | JS |
| REVIEWED BY    | KKG |    |    |
| PM/DM          | HKH |    |    |
| CHIEF ENG/ARCH | HKH |    |    |

|     |             |      |      |
|-----|-------------|------|------|
| SYN | DESCRIPTION | DATE | APPR |
|     |             |      |      |
|     |             |      |      |
|     |             |      |      |

**ELECTRICAL SHEET NOTES:**

- 1. FOR LEGEND, ABBREVIATIONS, GENERAL AND WORK NOTES, REFER TO SHEET E-001.
- 2. FOR SITE PLAN REMOVAL AND NEW WORK, REFER TO SHEET E-100.
- 3. FOR SINGLE LINE DIAGRAM REMOVAL WORK, REFER TO SHEET TO SHEET E-601.
- 4. FOR SINGLE LINE DIAGRAM NEW WORK, REFER TO SHEET TO SHEET E-602.
- 5. FOR SCHEDULES REFER TO SHEET E-603.

**1 ELECTRICAL FLOOR PLAN - NEW WORK**  
E-101 NO SCALE

THIS DRAWING PRODUCED ON AUTOCAD  
DO NOT REVISE MANUALLY

THIS DOCUMENT IS THE PROPERTY OF  
NAVAL FACILITIES ENGINEERING COMMAND,  
PREPARED BY TETRA TECH ENGINEERING  
CORPORATION PC, AND IS PROVIDED UPON THE  
CONDITION THAT IT WILL NOT BE REPRODUCED,  
COPIED, OR ISSUED TO A THIRD PARTY, AND WILL  
BE USED SOLELY FOR THE ORIGINAL INTENDED  
PURPOSE AND SOLELY FOR THE EXECUTION  
OR REVIEW OF THE ENGINEERING CONSTRUCTION  
OF THE PROJECT.

IT IS A VIOLATION OF THE NEW YORK STATE  
EDUCATION LAW, ARTICLE 145, FOR ANY PERSON,  
UNLESS UNDER THE DIRECTION OF A NEW YORK  
STATE LICENSED PROFESSIONAL ENGINEER, TO  
ALTER AN ITEM ON THIS DOCUMENT IN ANY WAY.

| DES            | CHK | DR | JS |
|----------------|-----|----|----|
|                | KKG |    |    |
| REVIEWED BY    | KKG |    |    |
| PN/CM          | HKH |    |    |
| CHIEF ENG/ARCH | HKH |    |    |

NAVAL FACILITIES ENGINEERING COMMAND  
NAVAL FACILITIES ENGINEERING COMMAND ~ MID-ATLANTIC  
NAVAL INDUSTRIAL RESERVE ORDNANCE PLANT  
GM-38  
NAVAL WEAPONS INDUSTRIAL RESERVE PLANT BEHRISE, NEW YORK

CM-38 AREA  
GROUNDWATER TREATMENT PLANT  
AOP SYSTEM ADDITION


**ELECTRICAL FLOOR PLAN NEW WORK**

| CODE ID             | NO.              | 00091 | SIZE | D   |
|---------------------|------------------|-------|------|-----|
| SCALE:              |                  |       |      | NTS |
| MAXIMO NO.          | N62470-08-D-1001 |       |      |     |
| JOB ORDER NO.       | WE-24            |       |      |     |
| SPEC. NO.           |                  |       |      |     |
| CONSTR. CONTR. NO.  | N62472-99-D-0032 |       |      |     |
|                     | 112G08005        |       |      |     |
| NAVAFAC DRAWING NO. |                  |       |      |     |
| SHEET               | OF               |       |      |     |

**E-101**

ISSUED FOR BID - 06/21/2019



CAUTION: IF SHEET IS LESS THAN 34"x22" USE GRAPHIC SCALE

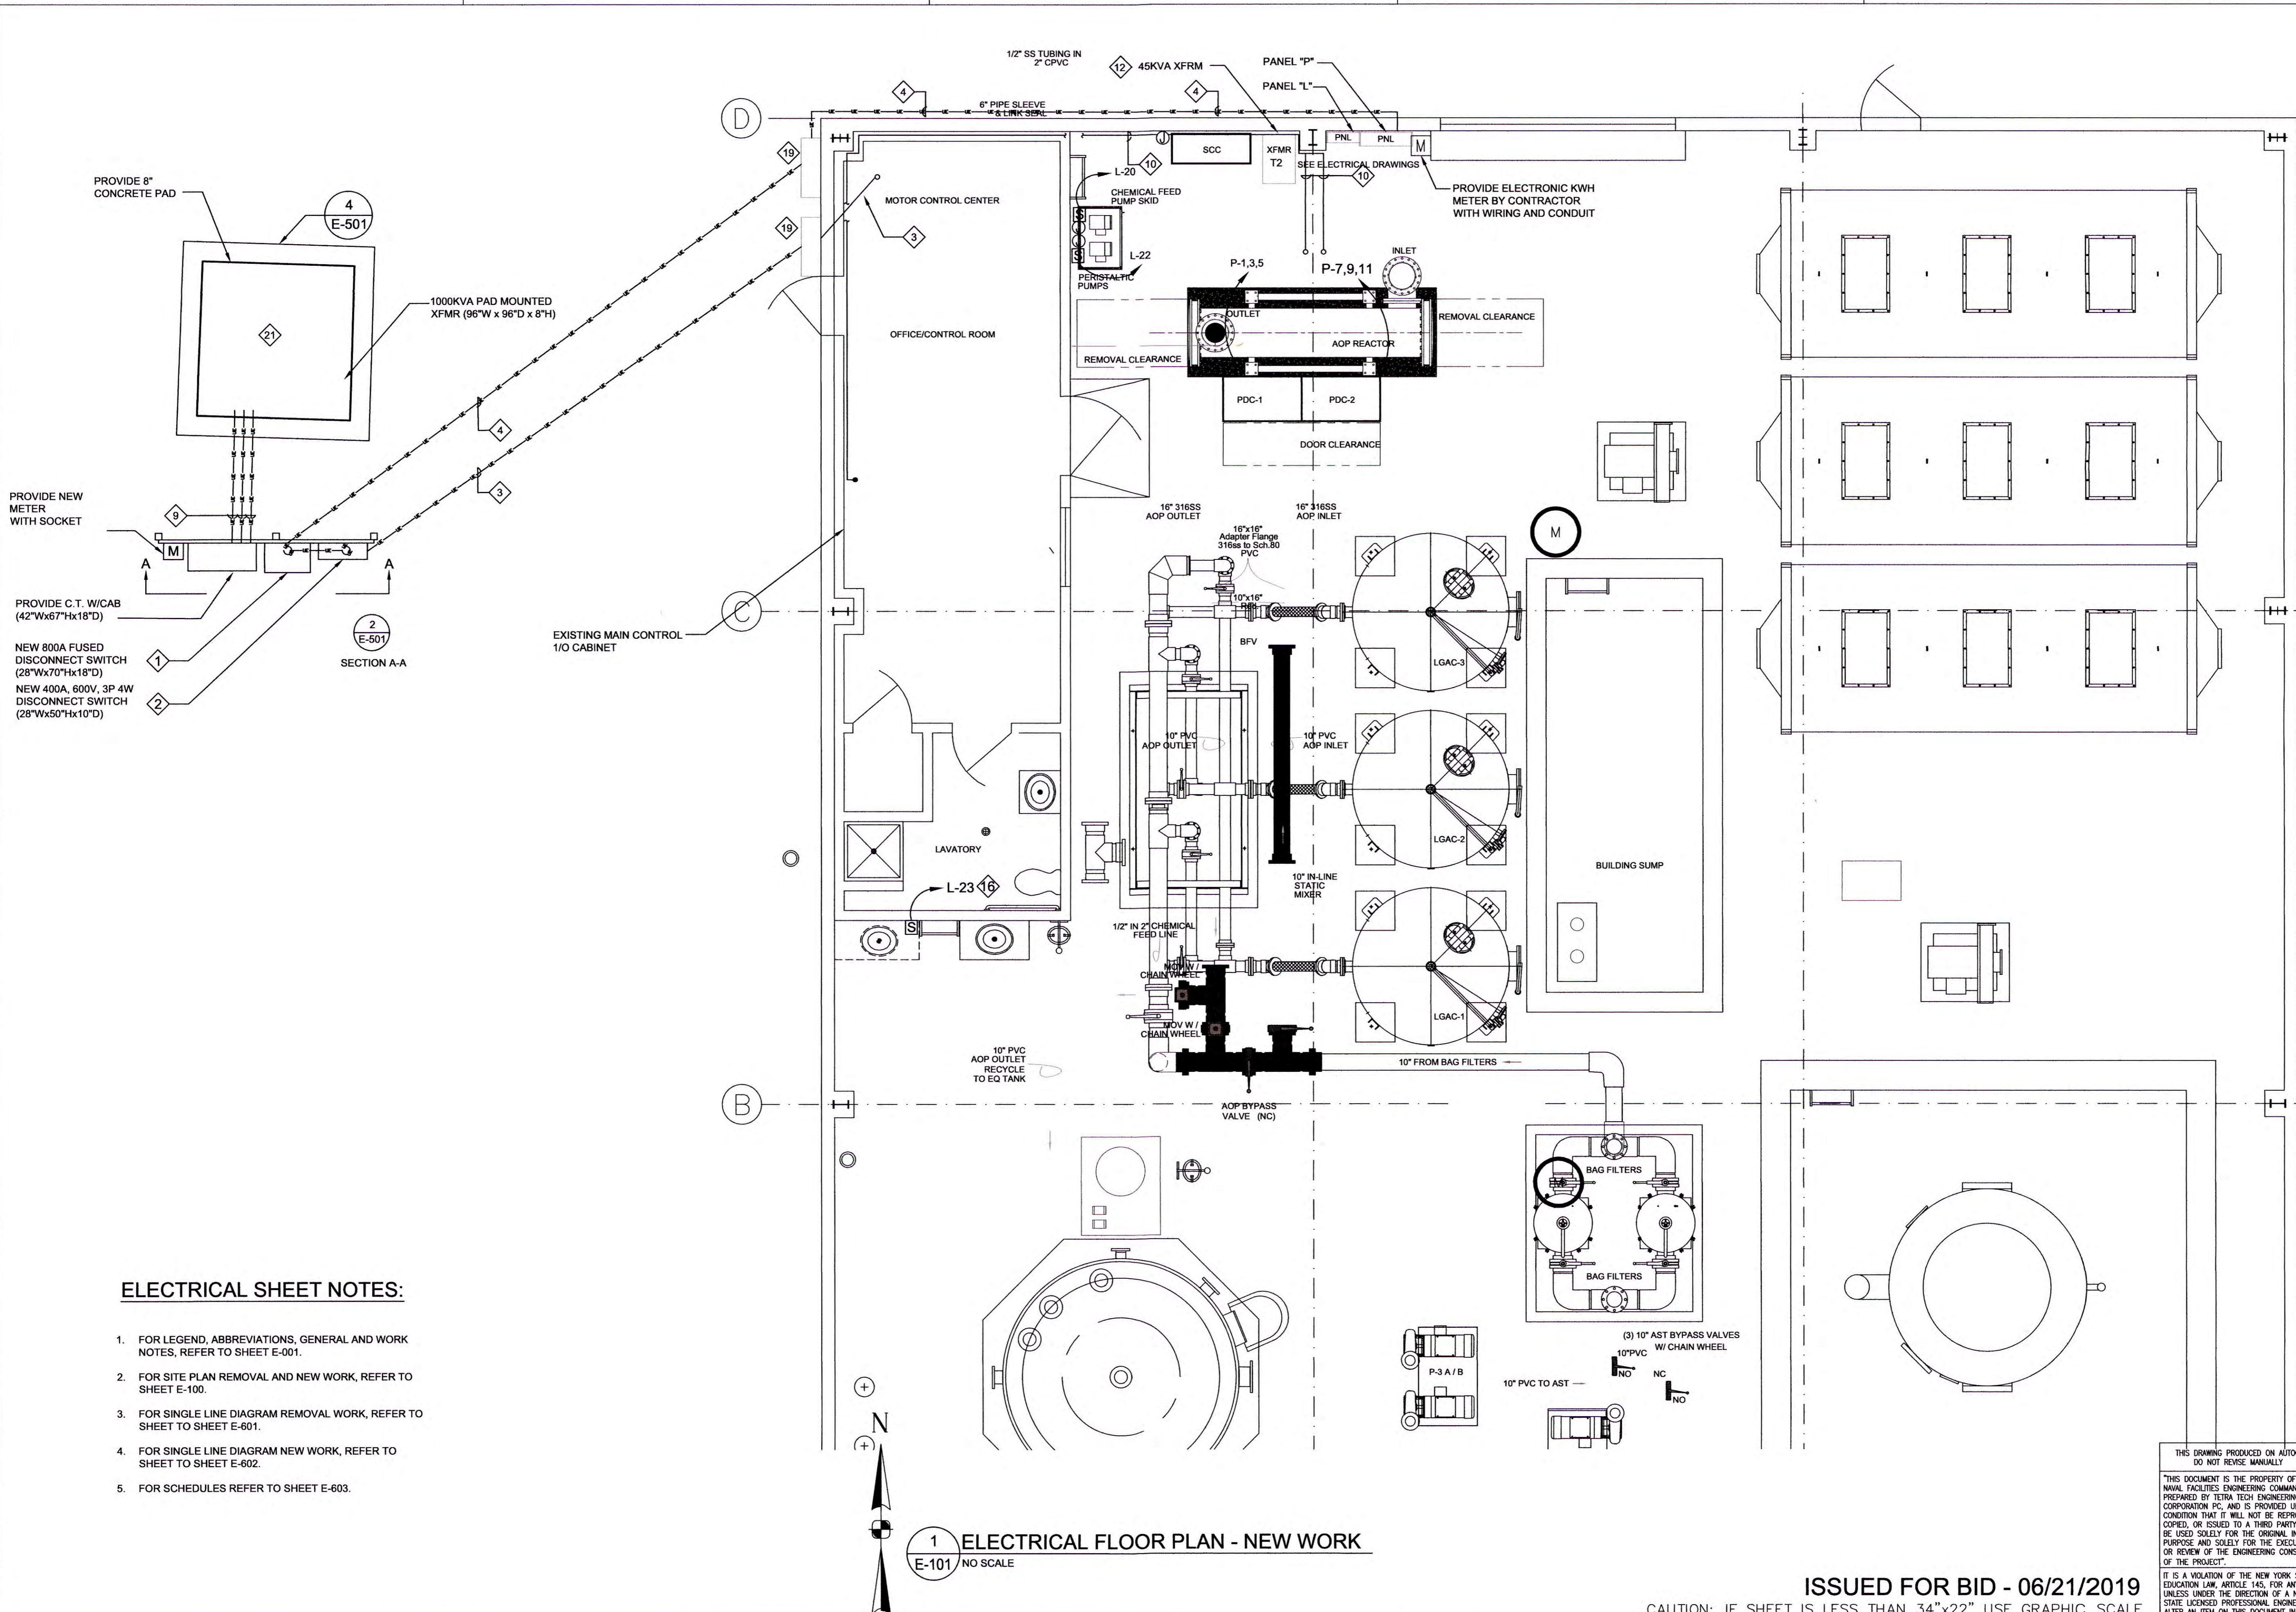

| DATE | APPR |
|------|------|
|      |      |

SYN

DESCRIPTION

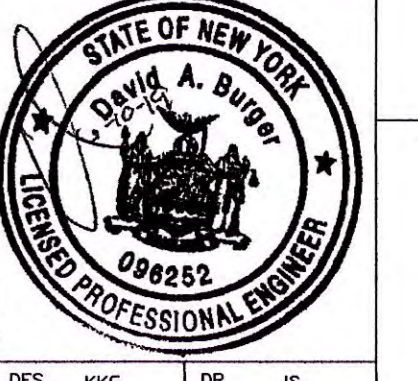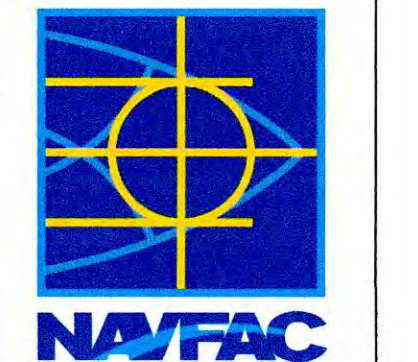


|                |     |    |    |
|----------------|-----|----|----|
| DES            | CHK | DR | JS |
|                | KKG |    |    |
| REVIEWED BY    | KKG |    |    |
| PN/CM          | HKH |    |    |
| CHIEF ENG/ARCH | HKH |    |    |


DEPARTMENT OF THE NAVY  
NAVAL FACILITIES ENGINEERING COMMAND  
NAVAL FACILITIES ENGINEERING COMMAND ~ MID-ATLANTIC  
NAVAL INDUSTRIAL RESERVE ORDNANCE PLANT  
GM-38  
NAVAL WEAPONS INDUSTRIAL RESERVE PLANT BEHRISE, NEW YORK

CM-38 AREA  
GROUNDWATER TREATMENT PLANT  
AOP SYSTEM ADDITION


**ELECTRICAL FLOOR PLAN NEW WORK**

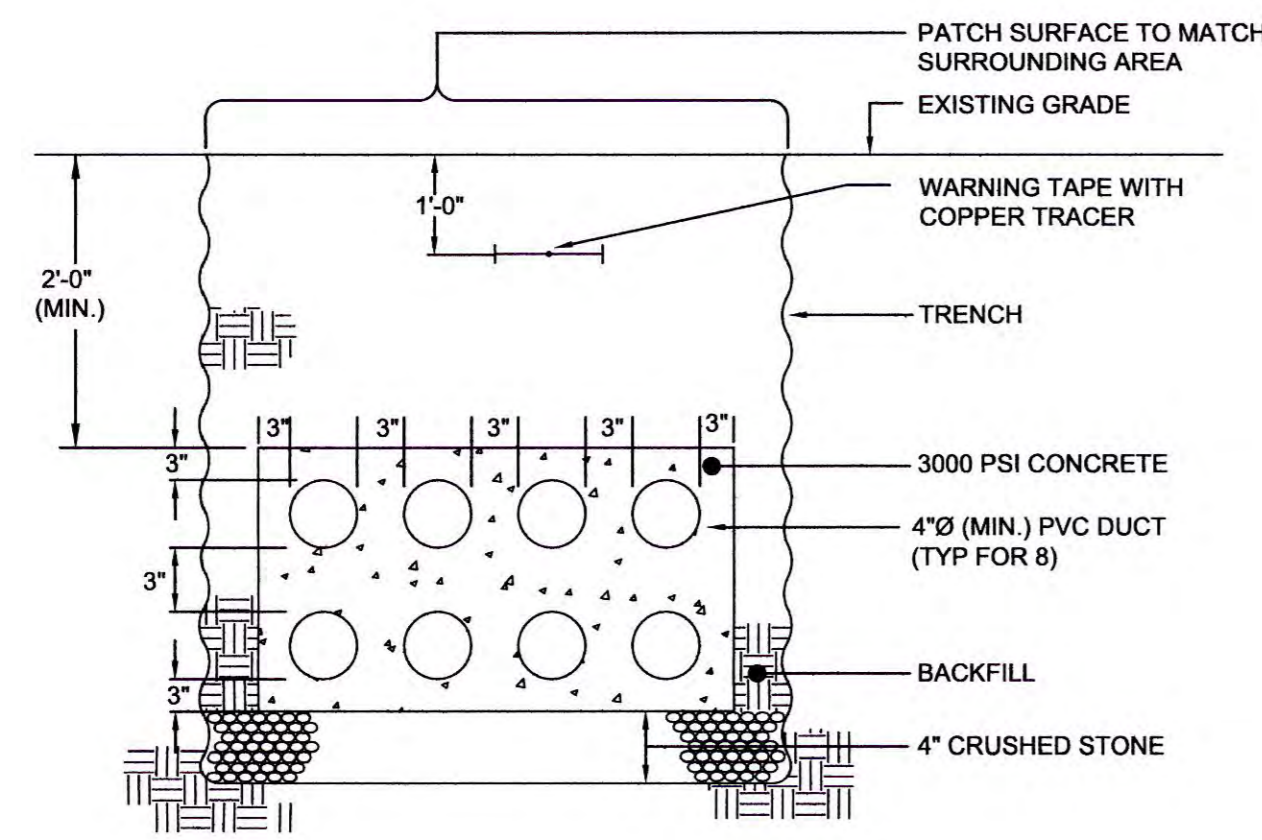


1 8-WAY DUCTBANK DETAIL  
E-501 NO SCALE

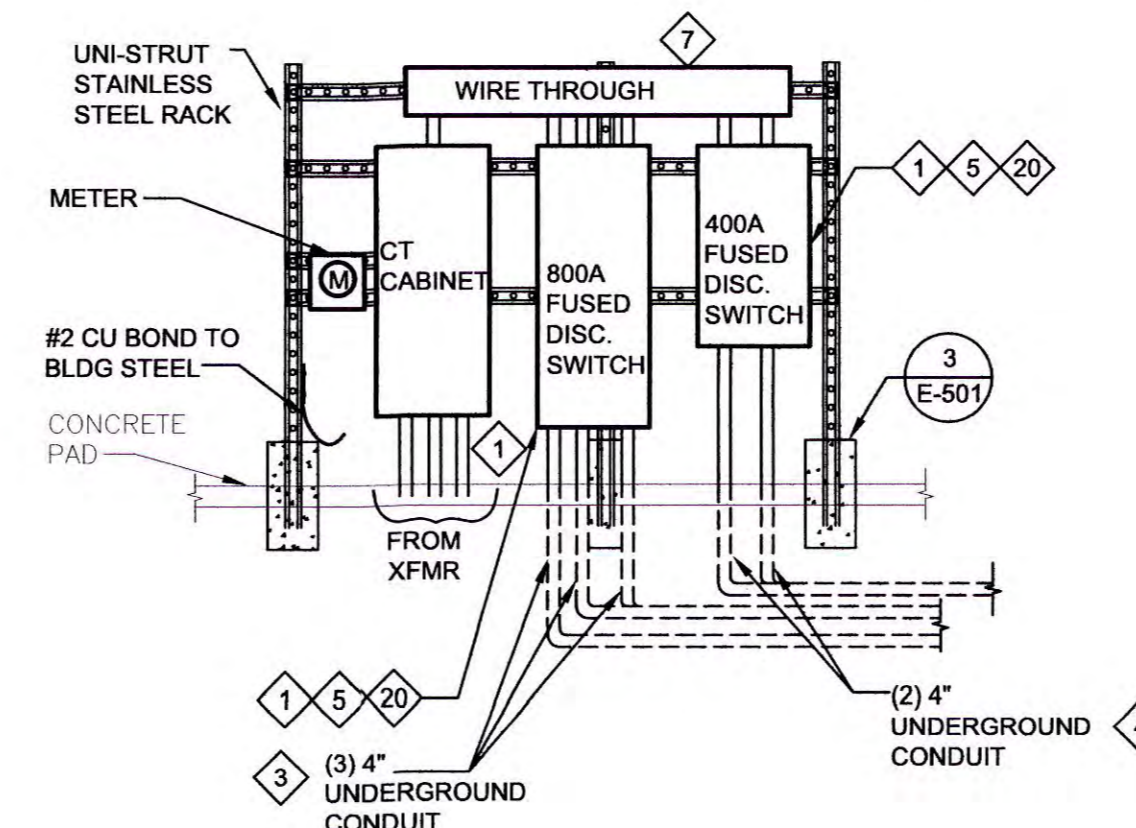

2 ELECTRICAL POWER ELEVATION DETAIL (SECT. A-A)  
E-501 NO SCALE

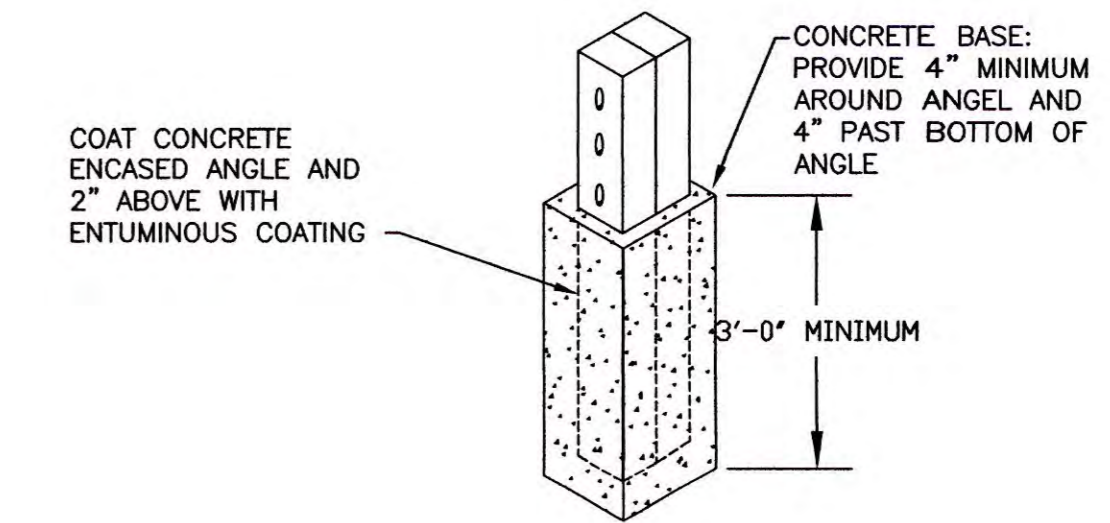


3 FREE STANDING RACK FOOTING DETAIL  
E-501 NO SCALE

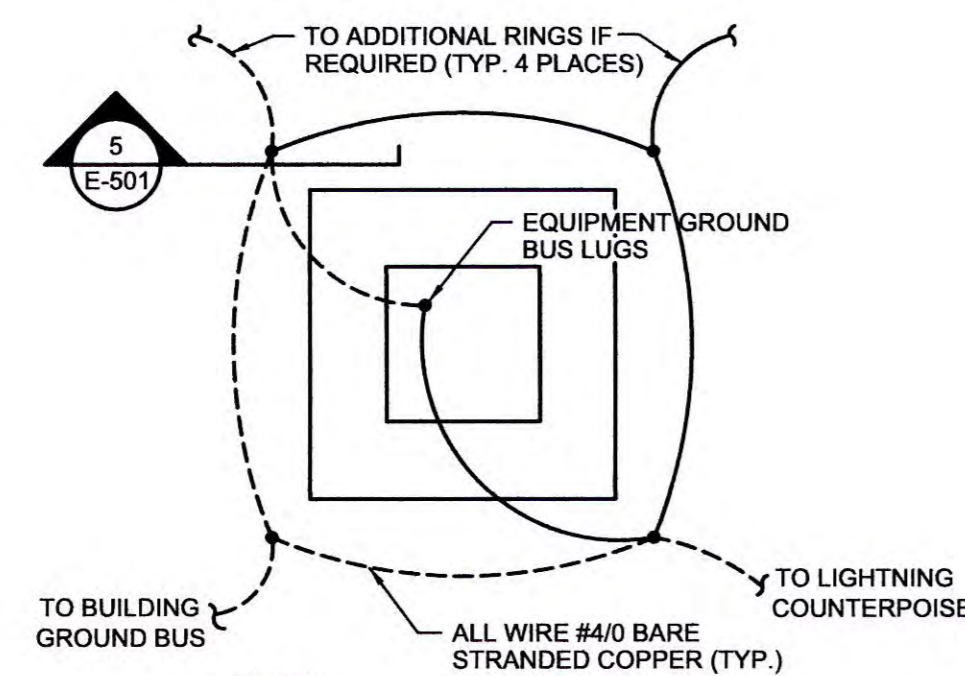


- NOTES:
- ADDITIONAL CONCENTRIC RINGS SHALL BE ADDED AS REQUIRED TO MEET THE (10) OHM SPECIFIED RESISTANCE. EACH RING TO HAVE 4 GROUND RODS AND SPACED 10 FEET FROM THE INNER RING.
  - BELOW 1000 KVA TRANSFORMER VAULT.


4 GROUND MAT DETAIL  
E-501 NO SCALE

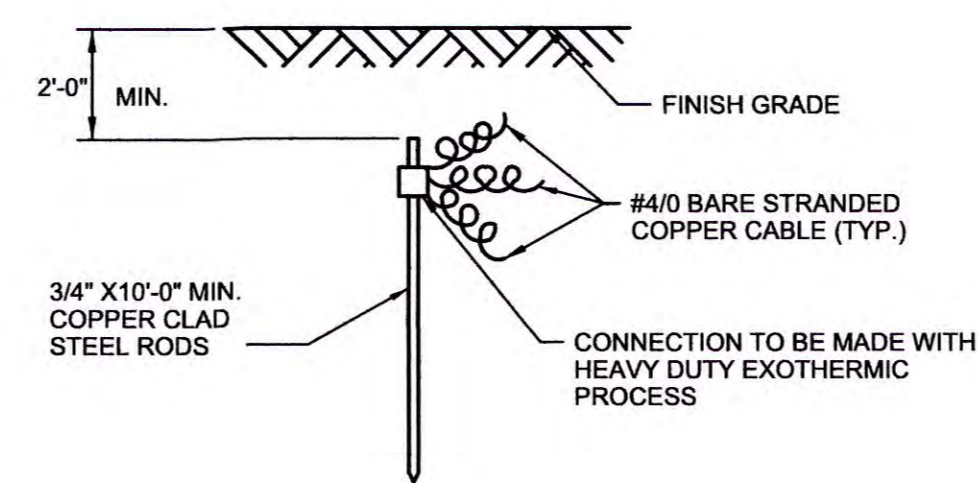

5 GROUND ROD SECTION DETAIL  
E-501 NO SCALE

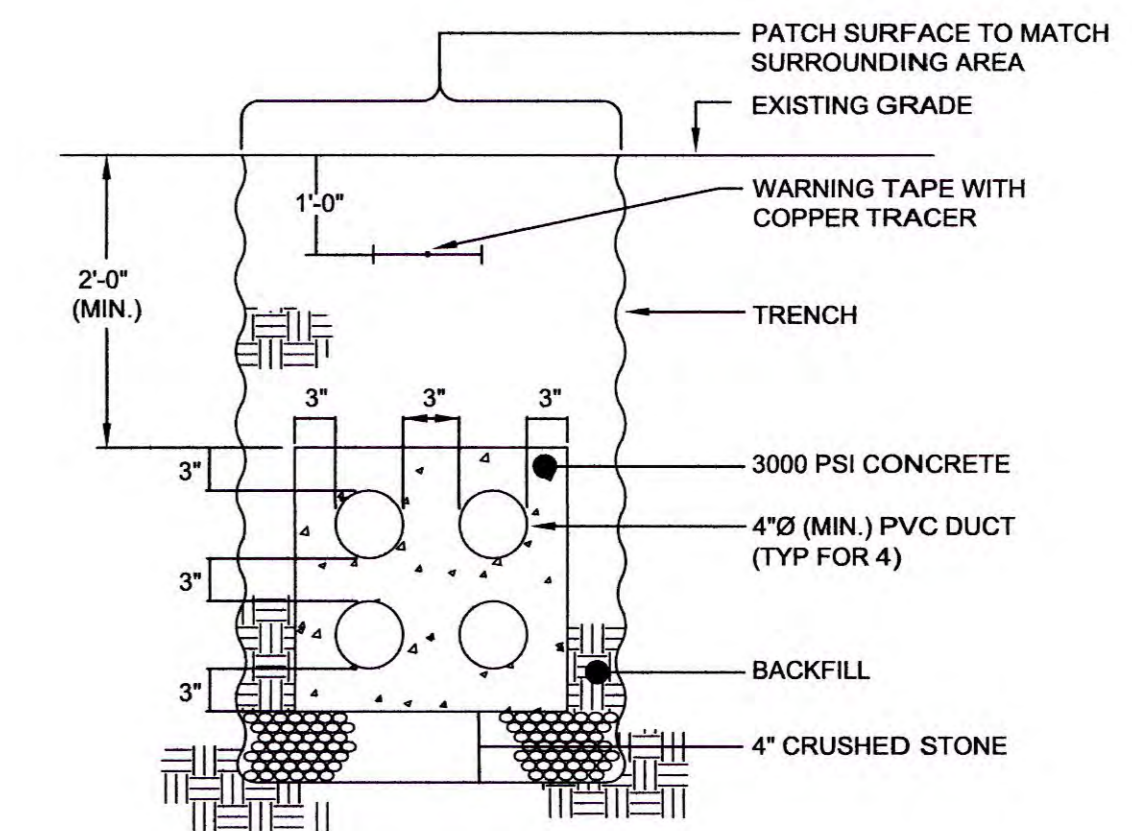

6 4-WAY DUCTBANK DETAIL  
E-501 NO SCALE

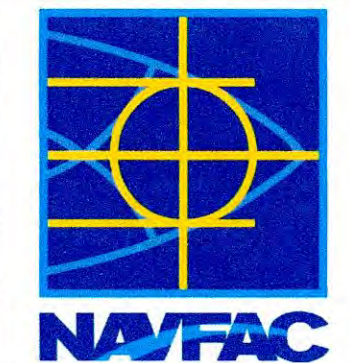

DES: KKG DR: JS  
REVIEWED BY: KKG  
PM/DM: HKM  
CHIEF ENG/ARCH: HKM

NAVAL FACILITIES ENGINEERING COMMAND  
NAVAL FACILITIES ENGINEERING COMMAND - MID-ATLANTIC  
NAVAL INDUSTRIAL RESERVE ORDNANCE PLANT  
NAVAL WEAPONS INDUSTRIAL RESERVE PLANT  
GM-38 AREA  
GROUNDWATER TREATMENT PLANT  
AOP SYSTEM ADDITION  
ELECTRICAL DETAILS


|   |                    |        |
|---|--------------------|--------|
| THIS DRAWING PRODUCED ON AUTOCAD DO NOT REVISE MANUALLY | CODE ID. NO. B0091 | SIZE D |
| SCALE: NTS  |                    |        |
| MAXIMO NO. N62470-08-D-1001                             |                    |        |
| JOB ORDER NO. WE-24                                     |                    |        |
| SPEC. NO.   |                    |        |
| CONSTR. CONTR. NO. N62472-99-D-0032                     |                    |        |
| 112G08005   |                    |        |
| NAVFAC DRAWING NO.                                      |                    |        |
| SHEET OF  |                    |        |
| E-501   |                    |        |

ISSUED FOR BID - 06/21/2019

CAUTION: IF SHEET IS LESS THAN 34"x22" USE GRAPHIC SCALE


IT IS A VIOLATION OF THE NEW YORK STATE EDUCATION LAW, ARTICLE 145, FOR ANY PERSON, UNLESS UNDER THE DIRECTION OF A NEW YORK STATE LICENSED PROFESSIONAL ENGINEER, TO ALTER AN ITEM ON THIS DOCUMENT IN ANY WAY.



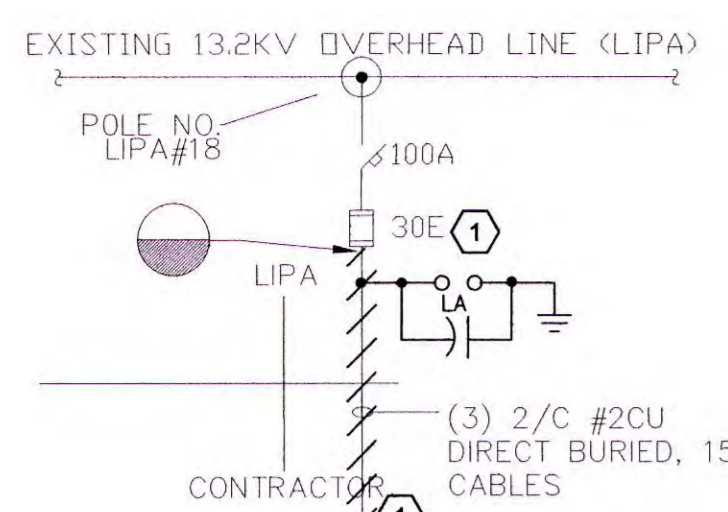

**ELECTRICAL DEMOLITION WORK NOTES:**

- 1 DISCONNECT AND REMOVE EXISTING 15 KV PRIMARY POWER CABLES FROM SIDE OF EXISTING 500 KVA OIL FILLED PAD MOUNTED TRANSFORMER.
- 2 DISCONNECT EXISTING SECONDARY CABLES & CONDUITS (2) FROM THE SECONDARY SIDE OF THE TRANSFORMER AND REMOVE EXISTING TRANSFORMER, CONCRETE PAD AND BOLLARDS WITH ALL ACCESSORIES. PATCH AND REPAIR AREA TO MATCH EXISTING.
- 3 DISCONNECT & REMOVE EXISTING WIRES & EXISTING (2) 4" CONDUITS. EXISTING CONDUITS CAN BE RE-USED IF POSSIBLE.
- 4 PRIOR TO CONSTRUCTION, CONTRACTOR MUST COORDINATE WITH POWER COMPANY, (PSEG) TO GET SHUT DOWN.
- 5 REMOVE EXISTING BONDING & WIRING FROM GROUNDING SYSTEM TO NEUTRAL TERMINAL.

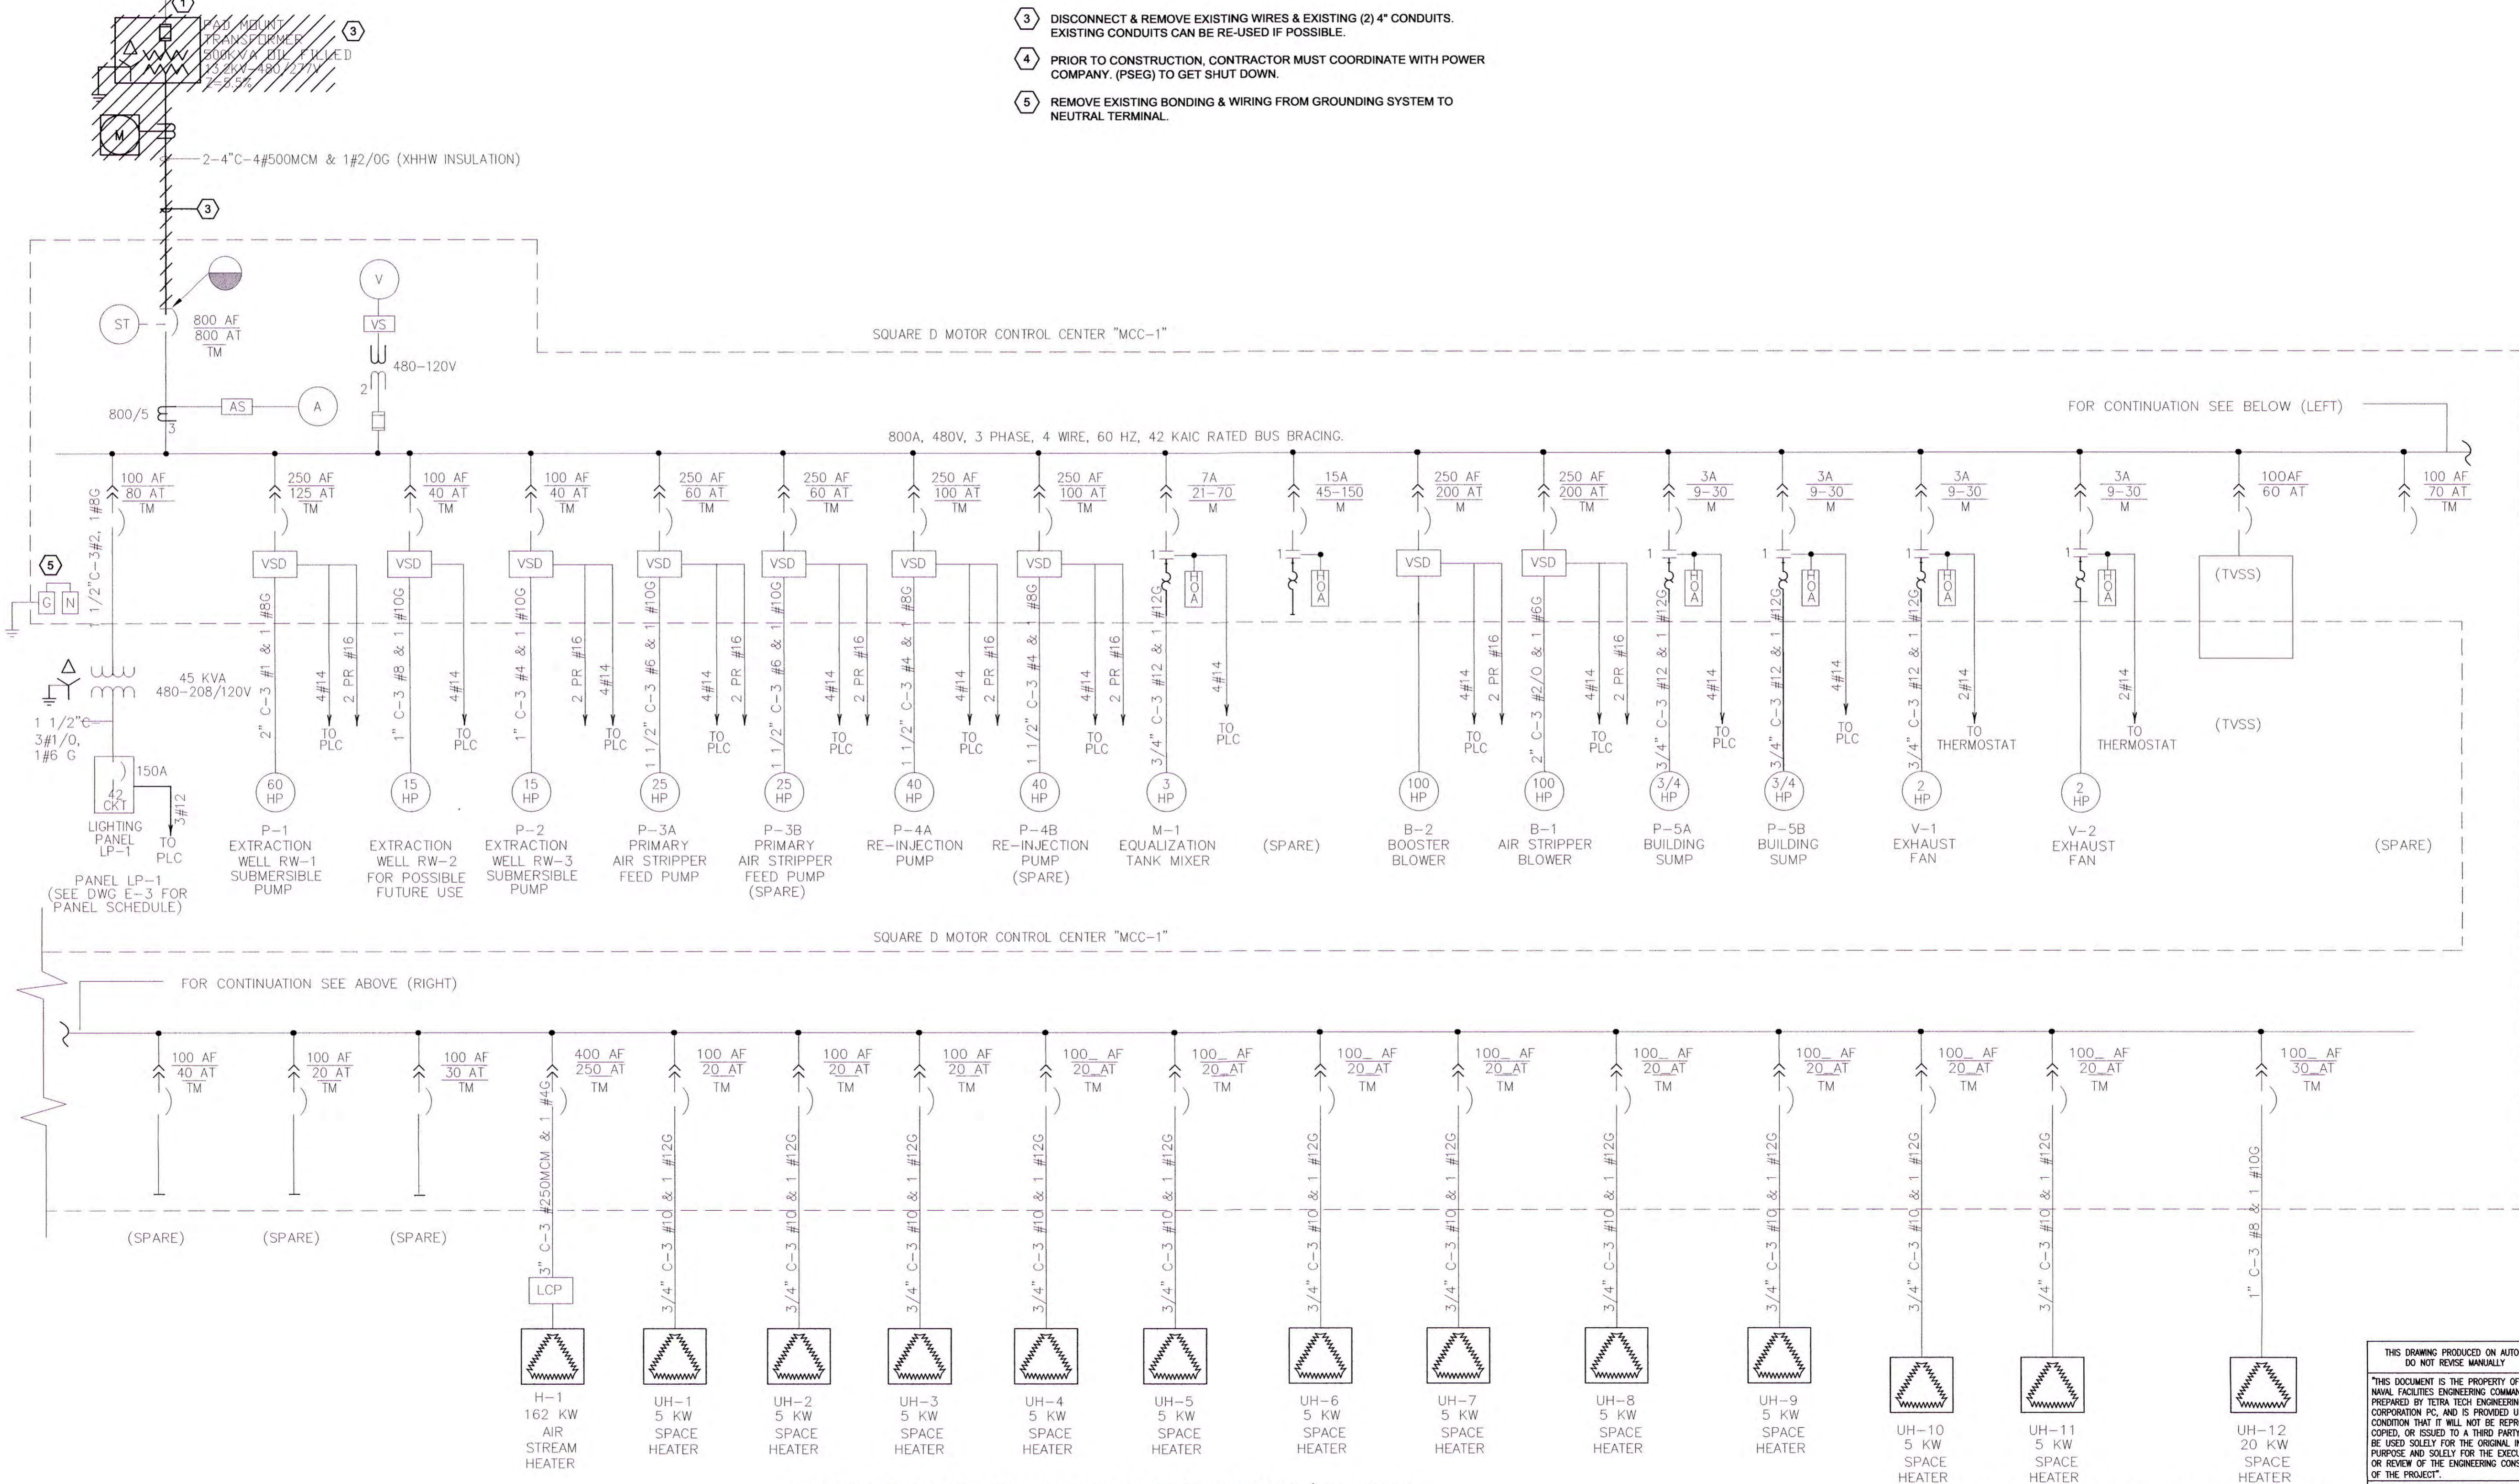


**SINGLE LINE DIAGRAM - REMOVAL WORK**

**ISSUED FOR BID - 06/21/2019**

CAUTION: IF SHEET IS LESS THAN 34"x22" USE GRAPHIC SCALE

|   |  
|---|--|--------------------|---------|--------|-------------|-----------------------------|--|---------------------|--|-----------|--|-------------------------------------|--|-----------|--|--------------------|--|----------|--|--------------|--|
| <br><br>  | <table border="1" style="width: 100%; border-collapse: collapse;"> <tr> <td style="width: 10%;">DATE</td> <td style="width: 10%;">APPN</td> </tr> <tr> <td style="width: 10%;">SYN</td> <td style="width: 10%;">DESCRIPTION</td> </tr> </table>  | DATE               | APPN    | SYN    | DESCRIPTION |                             |  |                     |  |           |  |                                     |  |           |  |                    |  |          |  |              |  |
| DATE  | APPN   |                    |         
| SYN   | DESCRIPTION  |                    |         
| <p>STATE OF NEW YORK<br/>         JAMES A. BUTLER<br/>         LICENSED PROFESSIONAL ENGINEER<br/>         086252</p>   |  |                    
| <p>DES: KKG DR: JS<br/>         REVIEWED BY: KKG<br/>         PM/DM: HKM<br/>         CHIEF ENG/ARCH: HKM</p>   | <p>NAVAL FACILITIES ENGINEERING COMMAND<br/>         NAVAL FACILITIES ENGINEERING COMMAND ~ MID-ATLANTIC<br/>         NAVAL INDUSTRIAL RESERVE ORDNANCE PLANT<br/>         BETHPAGE, NEW YORK<br/>         GM-38 AREA<br/>         GROUNDWATER TREATMENT PLANT<br/>         AOP SYSTEM ADDITION</p>  |                    |         
| <p>THIS DRAWING PRODUCED ON AUTOCAD<br/>         DO NOT REVISE MANUALLY</p> <p>THIS DOCUMENT IS THE PROPERTY OF<br/>         NAVAL FACILITIES ENGINEERING COMMAND,<br/>         PREPARED BY TETRA TECH ENGINEERING<br/>         CORPORATION PC, AND IS PROVIDED UPON THE<br/>         CONDITION THAT IT WILL NOT BE REPRODUCED,<br/>         COPIED, OR ISSUED TO A THIRD PARTY, AND WILL<br/>         BE USED SOLELY FOR THE ORIGINAL INTENDED<br/>         PURPOSE AND SOLELY FOR THE EXECUTION<br/>         OR REVIEW OF THE ENGINEERING CONSTRUCTION<br/>         OF THE PROJECT.</p> <p>IT IS A VIOLATION OF THE NEW YORK STATE<br/>         EDUCATION LAW, ARTICLE 145, FOR ANY PERSON,<br/>         UNLESS UNDER THE DIRECTION OF A NEW YORK<br/>         STATE LICENSED PROFESSIONAL ENGINEER, TO<br/>         ALTER AN ITEM ON THIS DOCUMENT IN ANY WAY.</p> | <table border="1" style="width: 100%; border-collapse: collapse;"> <tr> <td>CODE ID. NO. 80091</td> <td>SIZE: D</td> </tr> <tr> <td>SCALE:</td> <td>NTS</td> </tr> <tr> <td>MAXIMO NO. N62470-08-D-1001</td> <td></td> </tr> <tr> <td>JOB ORDER NO. WE-24</td> <td></td> </tr> <tr> <td>SPEC. NO.</td> <td></td> </tr> <tr> <td>CONSTR. CONTR. NO. N62472-99-D-0002</td> <td></td> </tr> <tr> <td>112G08005</td> <td></td> </tr> <tr> <td>NAVFAC DRAWING NO.</td> <td></td> </tr> <tr> <td>SHEET OF</td> <td></td> </tr> <tr> <td colspan="2" style="text-align: center;"><b>E-601</b></td> </tr>











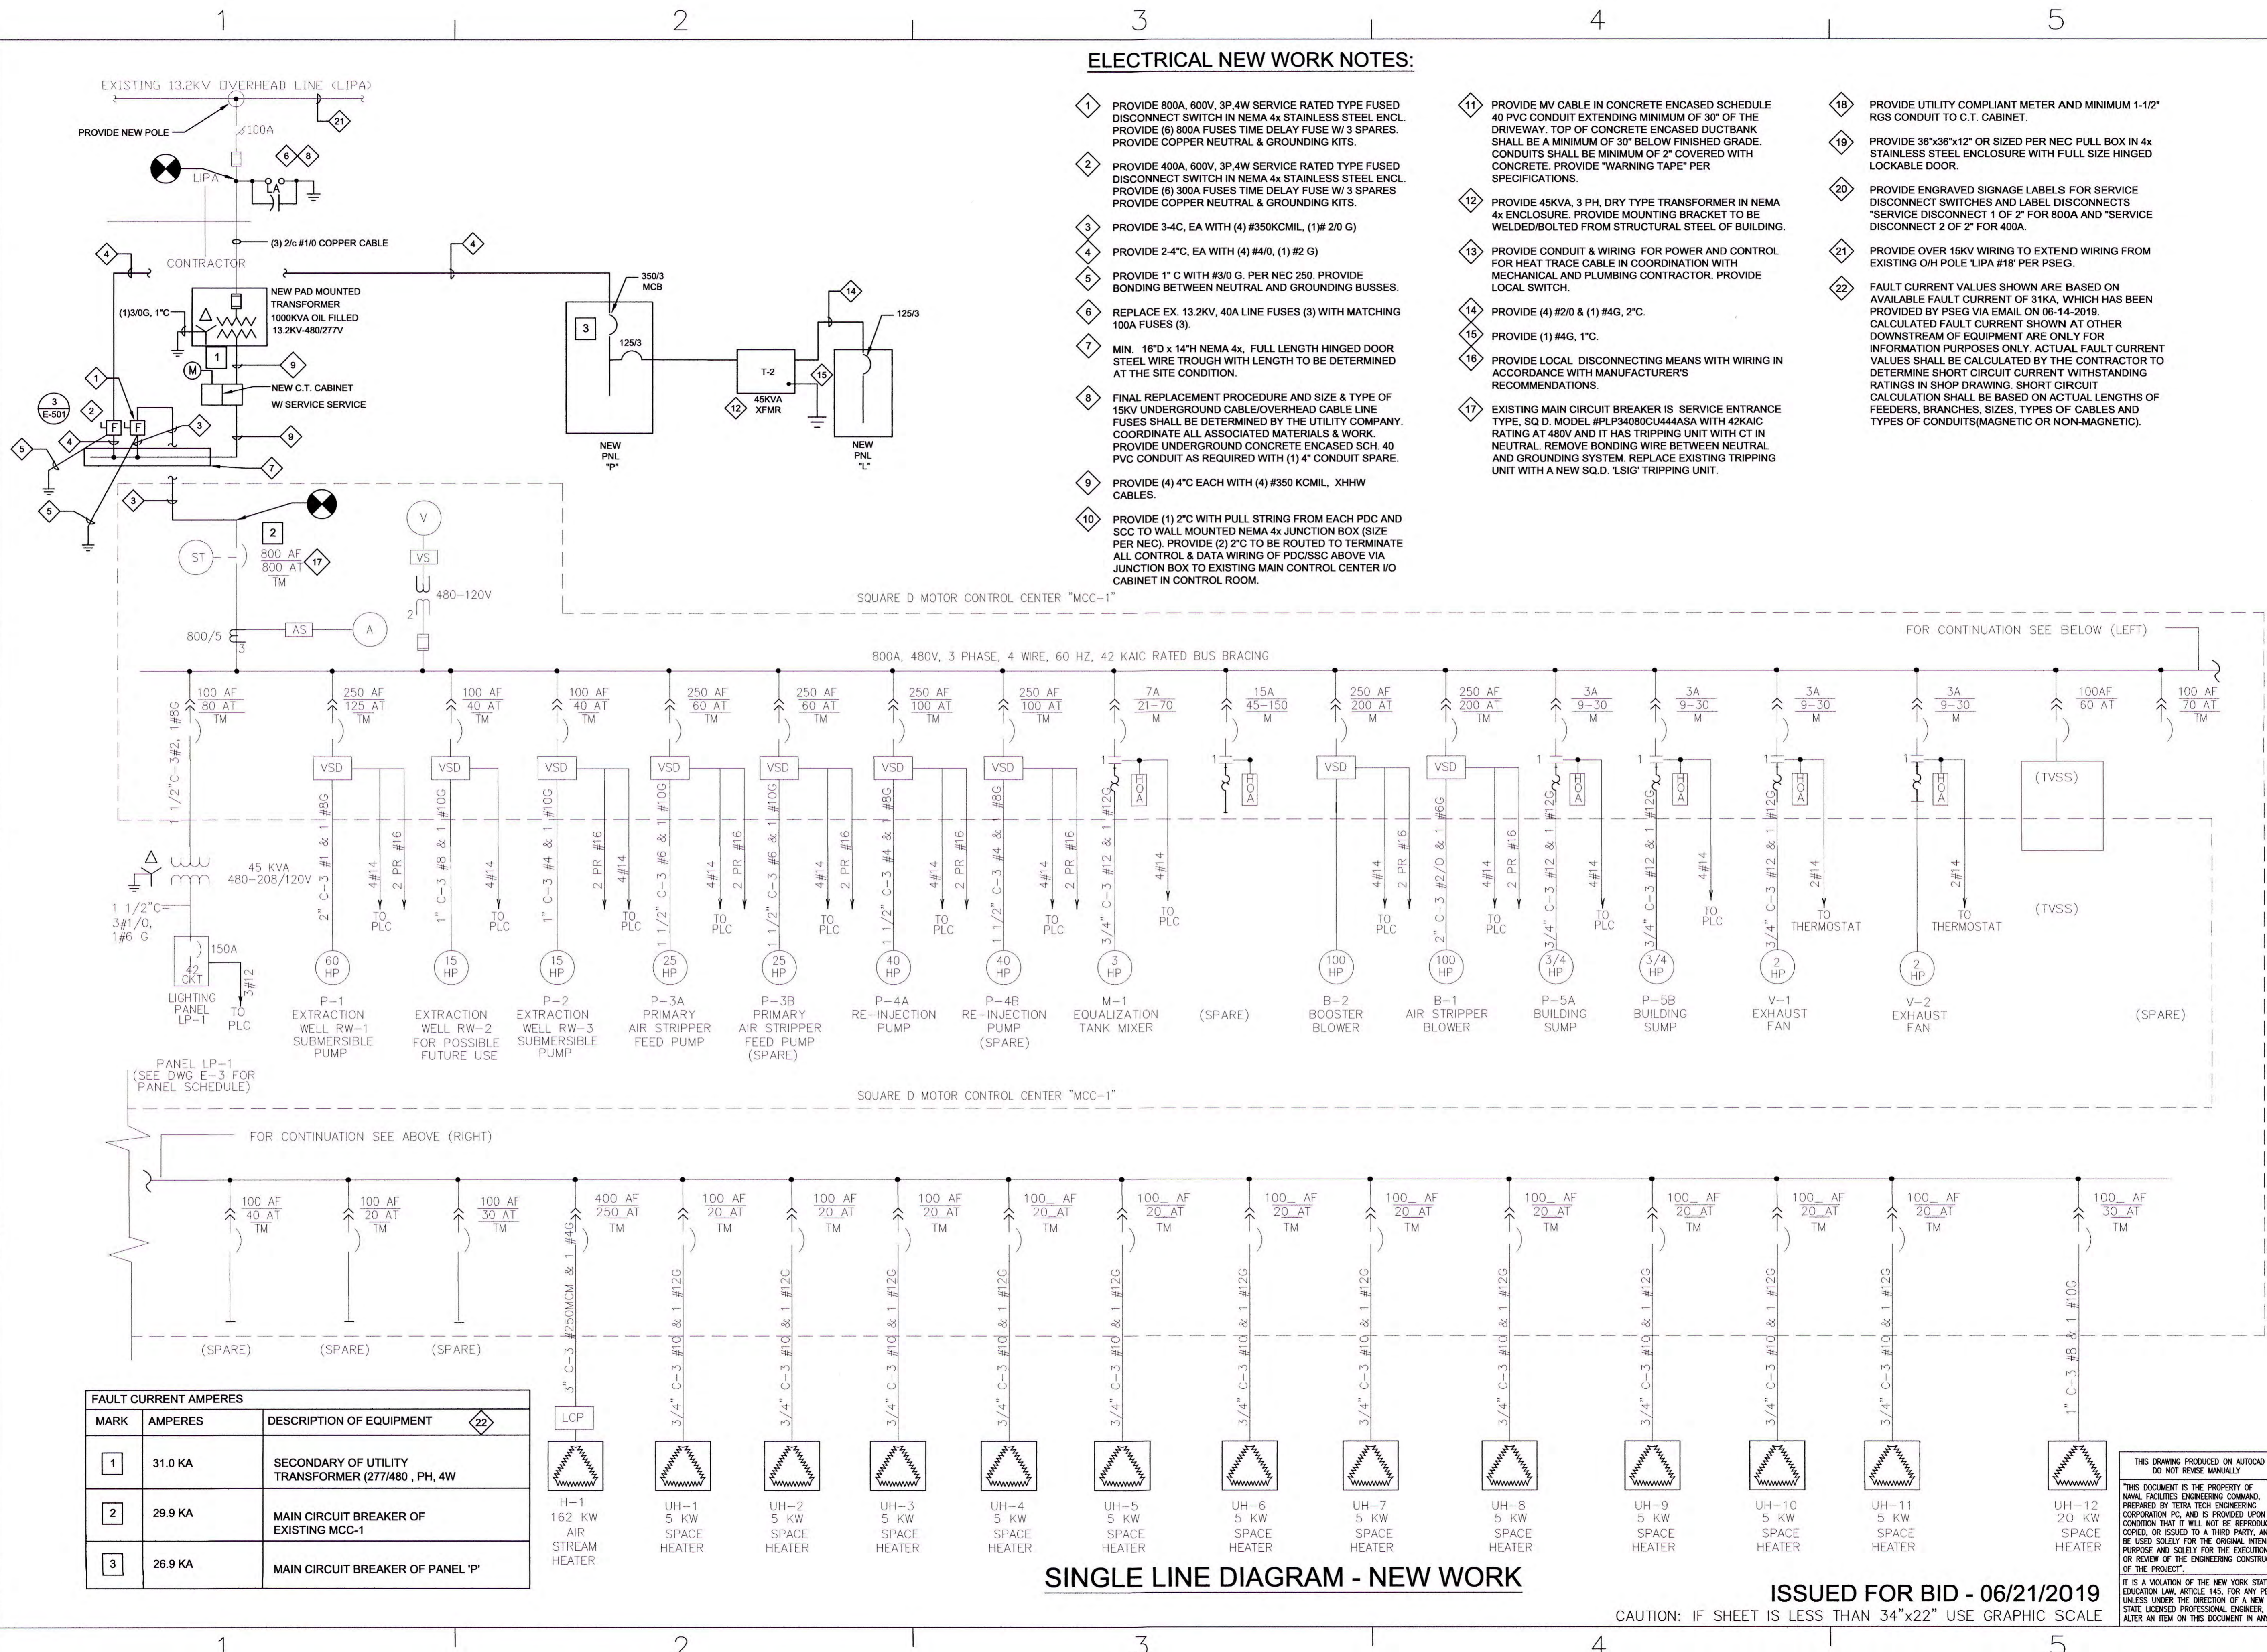

**ELECTRICAL NEW WORK NOTES:**

- 1 PROVIDE 800A, 600V, 3P, 4W SERVICE RATED TYPE FUSED DISCONNECT SWITCH IN NEMA 4X STAINLESS STEEL ENCL. PROVIDE (6) 800A FUSES TIME DELAY FUSE W/ 3 SPARES. PROVIDE COPPER NEUTRAL & GROUNDING KITS.
- 2 PROVIDE 400A, 600V, 3P, 4W SERVICE RATED TYPE FUSED DISCONNECT SWITCH IN NEMA 4X STAINLESS STEEL ENCL. PROVIDE (6) 300A FUSES TIME DELAY FUSE W/ 3 SPARES. PROVIDE COPPER NEUTRAL & GROUNDING KITS.
- 3 PROVIDE 3-4C, EA WITH (4) #350KCMIL, (1) #2/0 G
- 4 PROVIDE 2-4" C, EA WITH (4) #4/0, (1) #2 G
- 5 PROVIDE 1" C WITH #3/0 G. PER NEC 250. PROVIDE BONDING BETWEEN NEUTRAL AND GROUNDING BUSESSES.
- 6 REPLACE EX. 13.2KV, 40A LINE FUSES (3) WITH MATCHING 100A FUSES (3).
- 7 MIN. 16"D x 14"H NEMA 4x, FULL LENGTH HINGED DOOR STEEL WIRE TROUGH WITH LENGTH TO BE DETERMINED AT THE SITE CONDITION.
- 8 FINAL REPLACEMENT PROCEDURE AND SIZE & TYPE OF 15KV UNDERGROUND CABLE/OVERHEAD CABLE LINE FUSES SHALL BE DETERMINED BY THE UTILITY COMPANY. COORDINATE ALL ASSOCIATED MATERIALS & WORK. PROVIDE UNDERGROUND CONCRETE ENCASED SCH. 40 PVC CONDUIT AS REQUIRED WITH (1) 4" CONDUIT SPARE.
- 9 PROVIDE (4) 4" C EACH WITH (4) #350 KCMIL, XHHW CABLES.
- 10 PROVIDE (1) 2" C WITH PULL STRING FROM EACH PDC AND SCC TO WALL MOUNTED NEMA 4x JUNCTION BOX (SIZE PER NEC). PROVIDE (2) 2" C TO BE ROUTED TO TERMINATE ALL CONTROL & DATA WIRING OF PDC/SCC ABOVE VIA JUNCTION BOX TO EXISTING MAIN CONTROL CENTER I/O CABINET IN CONTROL ROOM.
- 11 PROVIDE MV CABLE IN CONCRETE ENCASED SCHEDULE 40 PVC CONDUIT EXTENDING MINIMUM OF 30" OF THE DRIVEWAY. TOP OF CONCRETE ENCASED DUCTBANK SHALL BE A MINIMUM OF 30" BELOW FINISHED GRADE. CONDUITS SHALL BE MINIMUM OF 2" COVERED WITH CONCRETE. PROVIDE "WARNING TAPE" PER SPECIFICATIONS.
- 12 PROVIDE 45KVA, 3 PH, DRY TYPE TRANSFORMER IN NEMA 4x ENCLOSURE. PROVIDE MOUNTING BRACKET TO BE WELDED/BOLTED FROM STRUCTURAL STEEL OF BUILDING.
- 13 PROVIDE CONDUIT & WIRING FOR POWER AND CONTROL FOR HEAT TRACE CABLE IN COORDINATION WITH MECHANICAL AND PLUMBING CONTRACTOR. PROVIDE LOCAL SWITCH.
- 14 PROVIDE (4) #2/0 & (1) #4G, 2"C.
- 15 PROVIDE (1) #4G, 1"C.
- 16 PROVIDE LOCAL DISCONNECTING MEANS WITH WIRING IN ACCORDANCE WITH MANUFACTURER'S RECOMMENDATIONS.
- 17 EXISTING MAIN CIRCUIT BREAKER IS SERVICE ENTRANCE TYPE, SQ D, MODEL #PLP34080CJ444ASA WITH 42KAIC RATING AT 480V AND IT HAS TRIPPING UNIT WITH CT IN NEUTRAL. REMOVE BONDING WIRE BETWEEN NEUTRAL AND GROUNDING SYSTEM. REPLACE EXISTING TRIPPING UNIT WITH A NEW SQ.D. 'LSIG' TRIPPING UNIT.
- 18 PROVIDE UTILITY COMPLIANT METER AND MINIMUM 1-1/2" RGS CONDUIT TO C.T. CABINET.
- 19 PROVIDE 36"x36"x12" OR SIZED PER NEC PULL BOX IN 4x STAINLESS STEEL ENCLOSURE WITH FULL SIZE HINGED LOCKABLE DOOR.
- 20 PROVIDE ENGRAVED SIGNAGE LABELS FOR SERVICE DISCONNECT SWITCHES AND LABEL DISCONNECTS "SERVICE DISCONNECT 1 OF 2" FOR 800A AND "SERVICE DISCONNECT 2 OF 2" FOR 400A.
- 21 PROVIDE OVER 15KV WIRING TO EXTEND WIRING FROM EXISTING O/H POLE 'LIPA #18' PER PSEB.
- 22 FAULT CURRENT VALUES SHOWN ARE BASED ON AVAILABLE FAULT CURRENT OF 31KA, WHICH HAS BEEN PROVIDED BY PSEB VIA EMAIL ON 06-14-2019. CALCULATED FAULT CURRENT SHOWN AT OTHER DOWNSTREAM OF EQUIPMENT ARE ONLY FOR INFORMATION PURPOSES ONLY. ACTUAL FAULT CURRENT VALUES SHALL BE CALCULATED BY THE CONTRACTOR TO DETERMINE SHORT CIRCUIT CURRENT WITHSTANDING RATINGS IN SHOP DRAWING. SHORT CIRCUIT CALCULATION SHALL BE BASED ON ACTUAL LENGTHS OF FEEDERS, BRANCHES, SIZES, TYPES OF CABLES AND TYPES OF CONDUITS (MAGNETIC OR NON-MAGNETIC).

| FAULT CURRENT AMPERES |         |  |
|-----------------------|---------|--|
| MARK                  | AMPERES | DESCRIPTION OF EQUIPMENT                           |
| 1                     | 31.0 KA | SECONDARY OF UTILITY TRANSFORMER (277/480, PH, 4W) |
| 2                     | 29.9 KA | MAIN CIRCUIT BREAKER OF EXISTING MCC-1             |
| 3                     | 26.9 KA | MAIN CIRCUIT BREAKER OF PANEL 'P'                  |

**SINGLE LINE DIAGRAM - NEW WORK**

ISSUED FOR BID - 06/21/2019

CAUTION: IF SHEET IS LESS THAN 34"x22" USE GRAPHIC SCALE

DATE
APPR

DESCRIPTION
SYN

|                |     |    |    |
|----------------|-----|----|----|
| DES            | KKG | DR | JS |
| REVIEWED BY    | KKG |    |    |
| PM/DM          | HKM |    |    |
| CHIEF ENG/ARCH | HKM |    |    |

NAVAL FACILITIES ENGINEERING COMMAND  
 NAVAL FACILITIES ENGINEERING COMMAND ~ MID-ATLANTIC  
 NAVAL INDUSTRIAL RESERVE ORDNANCE PLANT  
 BETHPAGE, NEW YORK  
 GM-38 AREA  
 GROUNDWATER TREATMENT PLANT  
 AOP SYSTEM ADDITION

|                    |                 |      |     |
|--------------------|-----------------|------|-----|
| CODE ID. NO.       | 80091           | SIZE | D   |
| SCALE:             |                 |      | NTS |
| MAXIMO NO.         | 62470-08-D-1001 |      |     |
| JOB ORDER NO.      | WE-24           |      |     |
| SPEC. NO.          |                 |      |     |
| CONSTR. CONTR. NO. | 112G08005       |      |     |
| NAVFAC DRAWING NO. |                 |      |     |

|   |  |
|---|--|
| THIS DRAWING PRODUCED ON AUTOCAD DO NOT REVISE MANUALLY   |  |
| THIS DOCUMENT IS THE PROPERTY OF NAVAL FACILITIES ENGINEERING COMMAND, PREPARED BY TETRA TECH ENGINEERING CORPORATION PC, AND IS PROVIDED UPON THE CONDITION THAT IT WILL NOT BE REPRODUCED, COPIED, OR ISSUED TO A THIRD PARTY, AND WILL BE USED SOLELY FOR THE ORIGINAL INTENDED PURPOSE AND SOLELY FOR THE EXECUTION OR REVIEW OF THE ENGINEERING CONSTRUCTION OF THE PROJECT. |  |
| IT IS A VIOLATION OF THE NEW YORK STATE EDUCATION LAW, ARTICLE 145, FOR ANY PERSON, UNLESS UNDER THE DIRECTION OF A NEW YORK STATE LICENSED PROFESSIONAL ENGINEER, TO ALTER AN ITEM ON THIS DOCUMENT IN ANY WAY.  |  |

