


# SITE MANAGEMENT PLAN

---

Former Bouchard Junkyard Site  
Site No. 411014

New Lebanon, Columbia County  
January 2015

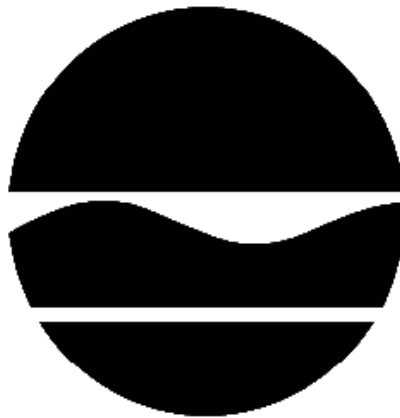

Prepared by  
Division of Environmental Remediation  
New York State Department of Environmental Conservation

## 1.0 INTRODUCTION

The Former Bouchard Junkyard Site, located in the Town of New Lebanon, Columbia County, New York (Figure 1), was a New York State inactive hazardous waste disposal site, registry number 4-11-014. In 2015 the New York State Department of Environmental Conservation (NYSDEC) delisted the site based on the completion of the remedial program that is described below.

There is contamination remaining within the U.S. Route 20 right of way. The soil in this area could not be removed during the remedial action without undermining the highway. Due to the presence of this remaining contamination, there is the need for an excavation control plan for excavation activities such as re-grading or re-contouring the shoulder of the highway, or intrusive work such as trenching that may occur in the future. The specific area of concern has been defined through an environmental notice and accompanying survey filed with Columbia County that are included in Appendix A. The purpose of these controls is to make sure that potentially contaminated soil from this area is handled properly.

## 2.0 SUMMARY OF SITE REMEDIATION

The remedy for this site was implemented in 2008 and involved the excavation and off-site disposal of contaminated soils and sediments. The primary contaminants of concern were polychlorinated biphenyls (PCBs), but lead was also a concern in limited areas of the site. The remedial design called for the removal of approximately 32,000 cubic yards of soil, however during implementation additional soils were ultimately excavated in order to achieve the soil cleanup objectives (SCOs) for the site. The actual measured excavated volume of PCB-contaminated soil was 44,512 cubic yards. Soil excavation was accomplished May 21- November 21, 2008. The remedial design also called for excavation of approximately 2,300 cubic yards of PCB-contaminated wetlands sediment. However, the actual measured excavated volume of PCB contaminated wetland sediment was 2,410 cubic yards. The final depth and extent of the excavations are shown on the remedial action as-built drawings (see Appendix B - Figure V2).

Post-excavation endpoint samples were collected from the excavation sidewall and bottom and analyzed by the laboratory, to document the removal of PCB-contaminated soil. Generally, one soil sample was collected from the top of each excavation sidewall for every 100 linear feet and one soil sample was collected from the excavation bottom for every 2,500 square feet. If PCBs were detected at concentrations greater than 1 ppm, additional excavation and sampling was performed until PCBs were detected at a concentration of 1 ppm or less. Using this approach, all soil containing PCBs greater than 1 ppm was removed from the site, with the exception of an area along the U.S. Route 20 right-of-way.

A total of 1,009 end point samples were collected. The locations of excavation endpoint samples are shown on Appendix B – Figure V4. Surveyed sample location coordinates are provided in Appendix B – Table 1. The excavation endpoint sample analytical results are provided in Appendix

B – Table 2. A discussion of the excavation endpoint sample results that exceeded the site SCOs at the conclusion of the remedial action is provided below.

### 3.0 RESIDUAL CONTAMINATION

Due to restrictions associated with working in the U.S. Route 20 right-of-way and potential adverse impacts to the road surface, excavation was terminated prior to removing all PCB-contaminated soil from the southern excavation boundary in Areas 5, 7, and 9. These areas are indicated on Appendix B – Figure V1. As a result, demarcation fabric was placed along a portion of the excavation sidewall in Area 5 and Area 9 that contains PCB-contaminated soil from grade surface to the excavation bottom. Demarcation was not placed along the southern excavation boundary in Area 7 containing residual PCB contamination. As depicted on the as-built drawings, the demarcation fabric extends from the area near Grid B-1 east toward the area near Grid K-1. The location of installed demarcation layer material is shown in Appendix B – Figure V6.

Post-excavation soil samples results associated with the area along the U.S. Route 20 right-of way are discussed in below. The following ten post-excavation sidewall samples document PCB contaminant concentrations remaining along the southern excavation sidewall in Areas 5, 7 and 9:

| Excavation Area | Grid Location | Sample Identification | PCB Concentration (PPM) |
|-----------------|---------------|-----------------------|-------------------------|
| Area 7          | YA-1          | EP-PSW32 (2)          | Non Detect              |
| Area 7          | YA-1          | EP-PSW32 (1)          | 16                      |
| Area 7          | A-1           | EP-PSW31              | 15                      |
| Area 5          | C-1           | EP-PSW30              | 190                     |
| Area 5          | D-1           | EP-PSW45              | Non Detect              |
| Area 5          | F-1           | EP-PSW46              | 28                      |
| Area 5          | H-1           | EP-PSW47              | 150                     |
| Area 9          | K-1           | EP-PSW20              | 6.5                     |
| Area 9          | K-1           | EP-PSW20 (A)          | 2.8                     |
| Area 9          | M-1           | EP-PSW19 (3)          | 0.94                    |

These sample points are highlighted on Appendix B – Figure V4.

### 4.0 EXCAVATION CONTROL REQUIREMENTS

Due to the residual contamination at the southern excavation sidewall, NYSDEC needs to be notified (see contact information below) in advance of proposed activities involving disturbance or excavation work within the area designated in the environmental notice. As this is within the U.S. Route 20 right of way, such actions will likely be associated with maintenance of the highway or possibly with curb cuts and driveway work occurring within the right of way. It is NYSDEC's understanding that these actions involve NYSDOT directly for highway maintenance, and indirectly through a NYSDOT permit process for curb cut and related work by others within the right of way.

Disturbance within the restricted area must be performed in accordance with a NYSDEC-approved excavation control plan. An outline of general soils management requirements for an excavation control plan is provided in Appendix C. Given the PCB concentrations remaining, work may involve the federal Toxic Substances Control Act (TSCA) provisions for handling and disposal of excess soils with PCB concentrations of 50 ppm or greater. Excess soils with PCB concentrations below 50 ppm are not subject to the TSCA requirements, but are subject to New York State solid waste requirements.

NYSDEC Contact Information:

NYSDEC Division of Environmental Remediation  
Remedial Bureau E  
625 Broadway – 12<sup>th</sup> Floor  
Albany, New York 12233-7017  
Phone: (518) 402-9813

5.0 Site Management Plan Appendices:

Appendix A – Environmental Notice  
Appendix B – “As-Built” Remedial Action Drawings  
Appendix B – Table 1 - Endpoint Sample Coordinates  
Appendix B – Table 2 - Endpoint Sample Results  
Appendix C – Soil Management Provisions

Site Management Plan  
APPENDIX A

Environmental Notice

---

Former Bouchard Junkyard Site  
Site No. 411014  
New Lebanon, Columbia County  
January 2015

Former Bouchard Junkyard  
Site No. 411014  
U.S. Route 20  
Columbia County, NY  
Tax Map: 19.01-1-88.1

## ENVIRONMENTAL NOTICE

**THIS ENVIRONMENTAL NOTICE** is made the 20<sup>th</sup> day of 2011, by the New York State Department of Environmental Conservation (Department), having an office for the transaction of business at 625 Broadway, Albany, New York 12233.

**WHEREAS**, a parcel of real property located on US Route 20 (Columbia Pike) in the Town of New Lebanon, County of Columbia, State of New York, known and designated on the tax map of the County Clerk of Columbia as tax map number: Section 19.01, Block 1, Lot 88.1 which is part of lands conveyed by the following:

- Fernande Bouchard to Ralph Chittenden by deed dated June 30, 1975 and recorded in the Columbia County Clerk's Office on June 30, 1975, in Book Liber 517 of Deeds at Page 17;
- Alan Skidelsky and Barry Skidelsky to Ralph W. Chittenden by deed dated November 20, 1981 and recorded in the Columbia County Clerk's Office on November 20, 1981, in Book Liber 558 of Deeds at Page 1088; and,
- Ralph W. Chittenden to Ralph W. Chittenden and Mary C. Chittenden by deed dated October 10, 1997 and recorded in the Columbia County Clerk's Office on October 10, 1997, in Cartridge 300 Frame 755;

and being more particularly described in Appendix "A," attached to this notice and made a part hereof, and hereinafter referred to as "the Property" is the subject of a remedial program performed by the Department; and

**WHEREAS**, the Department approved a cleanup to address contamination disposed at the Property and such cleanup was conditioned upon certain limitations.

**NOW, THEREFORE**, the Department provides notice that:

**FIRST**, the Property subject to this Environmental Notice is as shown on a map attached to this Notice as Appendix "B" and made a part hereof.

**SECOND**, unless prior written approval by the Department or, if the Department shall no longer exist, any New York State agency or agencies subsequently created to protect the environment of the State and the health of the State's citizens, hereinafter referred to as "the Relevant Agency," is first obtained, where contamination remains at the Property subject to the provisions of the Site Management Plan ("SMP"), there shall be no disturbance or excavation of the Property which threatens the integrity of the engineering controls or which results or may result in a significantly increased threat of harm or damage at any site as a result of exposure to soils. A violation of this provision is a violation of 6 NYCRR 375-1.1 1(b)(2).


Former Bouchard Junkyard  
Site No. 411014  
U.S. Route 20  
Columbia County, NY  
Tax Map: 19.01-1-88.1

**THIRD**, no person shall disturb, remove, or otherwise interfere with the installation, use, operation, and maintenance of engineering controls required for the Remedy, including but not limited to those engineering controls described in the SMP and listed below, unless in each instance they first obtain a written waiver of such prohibition from the Department or Relevant Agency.

**FOURTH**, the remedy was designed to be protective for the following uses: Commercial or Industrial. Therefore, any use for purposes other than for commercial or industrial use without the express written waiver of such prohibition by the Relevant Agency may result in a significantly increased threat of harm or damage at any site. No person shall use the groundwater underlying the Property without treatment rendering it safe for drinking water or industrial purposes, as appropriate, unless the user first obtains permission to do so from the Department or Relevant Agency. Use of the groundwater without appropriate treatment may result in a significantly increased threat of harm or damage at any site.

**FIFTH**, it is a violation of 6 NYCRR 375-1.11(b) to use the Property in a manner inconsistent with this environmental notice.

**IN WITNESS WHEREOF**, the undersigned has executed this instrument the day written below.


By:   
Dale A. Desnoyers, Director  
Division of Remediation

STATE OF NEW YORK )

) ss:

COUNTY OF ALBANY )

On the day of the 20<sup>th</sup>, in the year 2011, before me, the undersigned, personally appeared Dale A. Desnoyers, personally known to me or proved to me on the basis of satisfactory evidence to be the individual(s) whose name is (are) subscribed to the within instrument and acknowledged to me that he/she/ executed the same in his/her/ capacity as Designee of the Commissioner of the State of New York Department of Environmental conservation, and that by his/her signature on the instrument, the individual, or the person upon behalf of which the individual acted, executed the instrument.

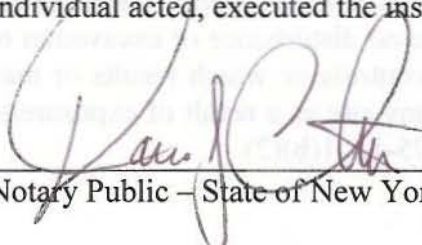  
Notary Public - State of New York

David J. Chiusano  
Notary Public, State of New York  
No. 01CH5032146  
Qualified in Schenectady County  
Commission Expires August 22, 2014

## Appendix A



Former Bouchard Junkyard  
Site No.: 411014  
US Route 20  
County of Columbia  
Tax Map: 19.01-1-88.1

### METES AND BOUNDS DESCRIPTION

All that piece or parcel of land situated in the Town of New Lebanon, County of Columbia, State of New York, being a portion of Tax Map Number 19.01, Block 1, last dated March 1976 and being within the right-of-way of an existing state highway known as US Highway 20, New Lebanon – Brainard State Highway No. 615 and locally as the Columbia Pike also more particularly described as follows:

BEGINNING at a point on the northerly highway boundary of US Highway 20 an existing state route, said point being 33.00 feet distant northerly, measured at right angles from Station R76+94 of the 1944 New York State Department of Transportation (NYSDOT) Centerline for the improvement of New Lebanon – Brainard State Highway No. 615; thence S77° 48' 04" E along the said northerly highway boundary a distance of 684.52 feet to a point of curvature, said point being 33.00 feet distant northerly, measured at right angles from PT Station R70+09.48 of said centerline; thence continuing easterly along the last mentioned boundary on a curve to the left having a radius of 3,786.72 feet a distance of 84.62 feet to a point, said point being distant radially from Station R69+24.10 of said centerline; thence S10° 55' 07" W through the bed of the said highway 66.00 feet more or less to a point on the southerly highway boundary, said point being 33.00 feet distant southerly measured radially from station R69+24.10 of the said centerline; thence westerly along the said southerly boundary on a curve to the right having a radius of 3,852.72 feet a distance of 86.10 feet to a point of tangency, said point being 33.00 feet distant southerly measured at right angles from Station R70+09.48 of said centerline; thence N77° 48' 04" W continuing along the said southerly highway boundary a distance of 684.52 feet to a point, said point being 33.00 feet distant southerly measured at right angles from station R76+94 from the said centerline; thence N12° 11' 56" E through the bed of US Highway 20 66.00 feet more or less to the point of beginning, being 50,812 ± square feet or 1.167 acres more or less.

## Appendix B

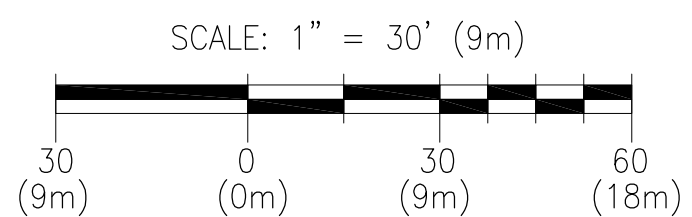
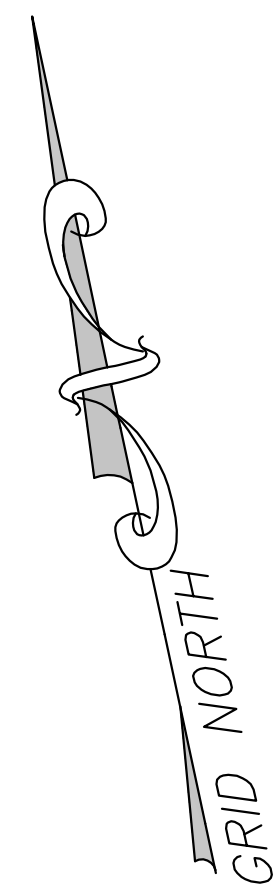


**BOUNDARY REFERENCES**

1. NEW YORK STATE DEPARTMENT OF PUBLIC WORKS HIGHWAY ACQUISITION MAPS DATED FEBRUARY 1941.

**SURVEY NOTES**

1. BEARINGS ARE REFERENCED TO THE NORTH AMERICAN DATUM OF 1983 (CORS) - NEW YORK STATE PLANE COORDINATE SYSTEM, EAST ZONE
2. ELEVATIONS SHOWN HEREON ARE REFERENCED TO THE NORTH AMERICAN VERTICAL DATUM OF 1988 (NAVD 88).
3. MAPPING UNITS ARE U.S. SURVEY FEET.
4. THE CONTOUR INTERVAL IS 1 FOOT.
5. UTILITIES SHOWN HEREON ARE BASED ON VISIBLE EVIDENCE. THE UNDERGROUND POSITION OF ALL UTILITIES SHOWN SHOULD BE CONSIDERED APPROXIMATE.

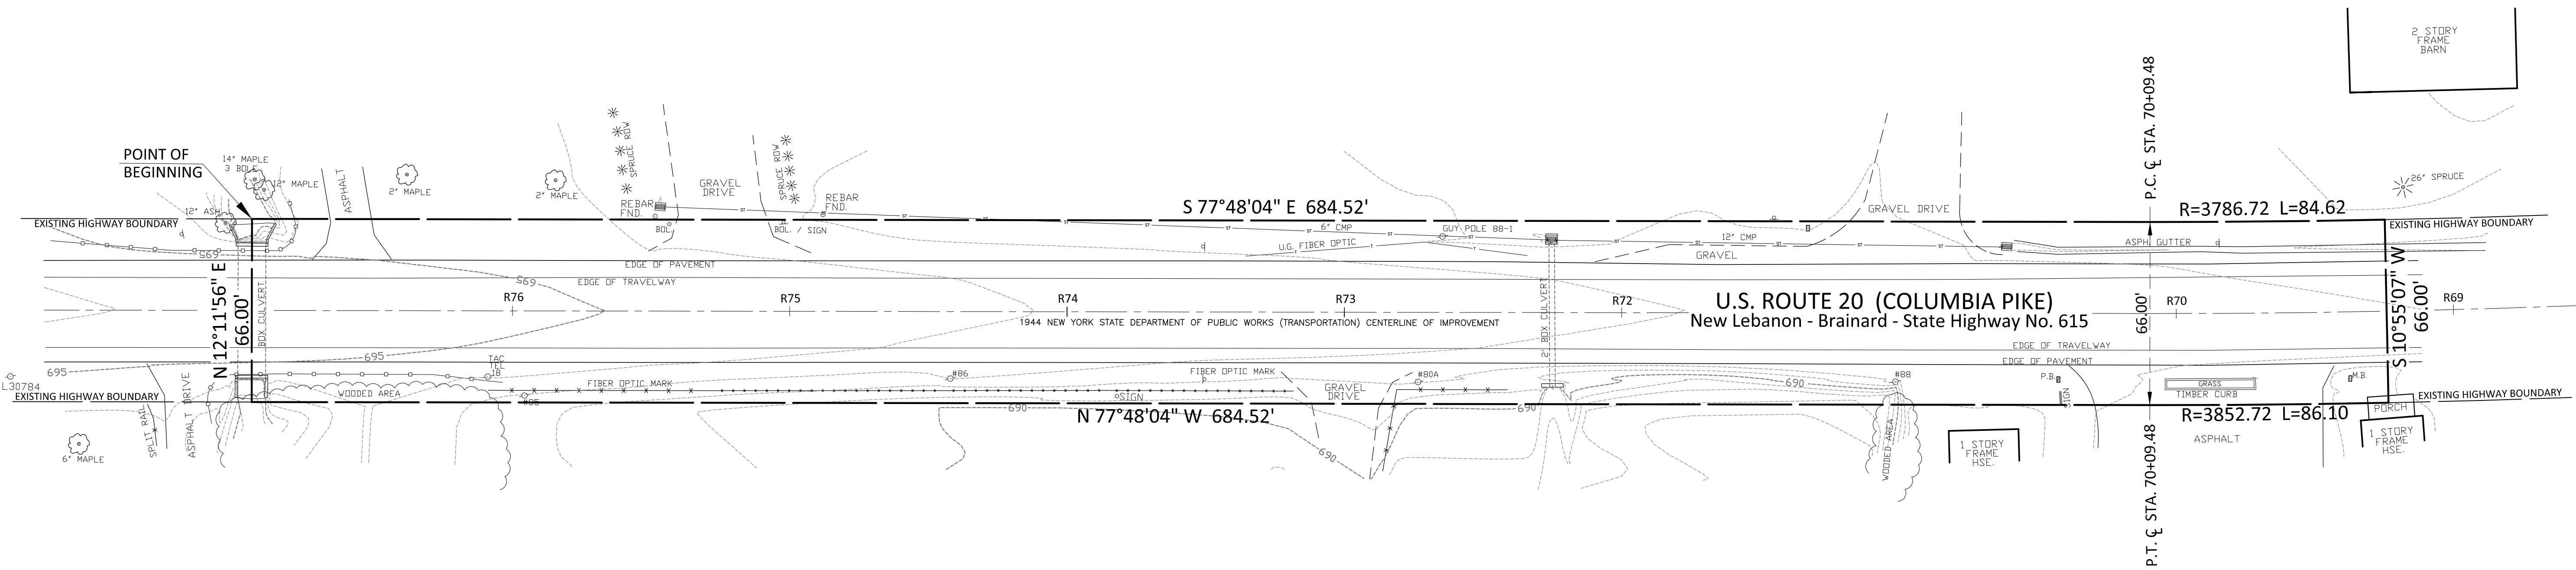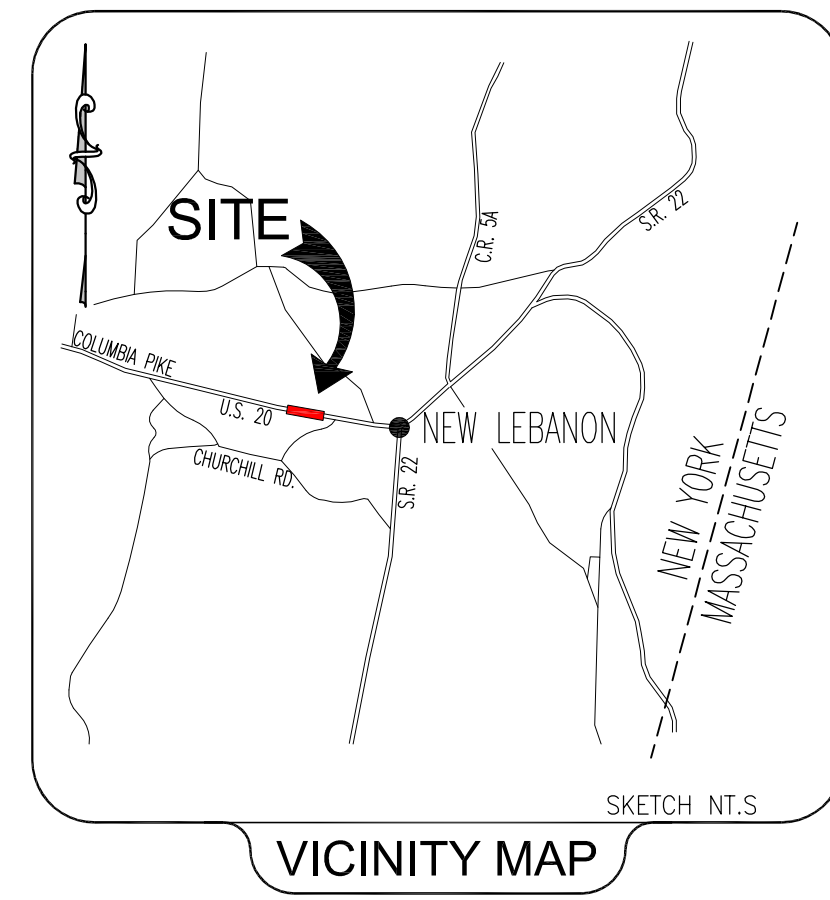

**AREA OF ENVIRONMENTAL NOTICE**

All that piece or parcel of land situate in the Town of New Lebanon, County of Columbia, State of New York, being a portion of Tax Map Number 19.01, Block 1, last dated March 1976 and being within the right-of-way of an existing state highway known as U.S. Highway 20, New Lebanon - Brainard State Highway No. 615 and locally as the Columbia Pike also more particularly described as follows:

BEGINNING at a point on the northerly highway boundary of US Highway 20 an existing state route, said point being 33.00 feet distant northerly, measured at right angles from Station R76+94 of the 1944 New York State Department of Transportation (NYS DOT) Centerline for the improvement of New Lebanon - Brainard State Highway No. 615; thence S 77°48'04"E along the said northerly highway boundary a distance of 684.52 feet to a point of curvature, said point being 33.00 feet distant northerly, measured at right angles from PT Station R70+09.48 of said centerline; thence continuing easterly along the last mentioned boundary on a curve to the left having a radius of 3,786.72 feet a distance of 84.62 feet to a point, said point being distant radially from Station R69+24.10 of said centerline; thence S10°55'07"W through the bed of the said highway 66.00 feet more or less to a point on the southerly highway boundary, said point being 33.00 feet distant southerly measured radially from station R69+24.10 of the said centerline; thence westerly along the said southerly boundary on a curve to the right having a radius of 3,852.72 feet a distance of 86.10 feet to a point of tangency, said point being 33.00 feet distant southerly measured at right angles from Station R70+09.48 of said centerline; thence N77°48'04"W continuing along the said southerly highway boundary a distance of 684.52 feet to a point, said point being 33.00 feet distant southerly measured at right angles from station R76+94 from the said centerline; thence N12°11'56"E through the bed of US Highway 20 66.00 feet more or less to the point of beginning, being 50,812± square feet or 1.167 acres more or less.

Intending to describe a strip of land inclusive of the right-of-way of US Route 20 as shown on the attached map.

All bearings are referenced to the North American Datum of 1983 (NAD83) New York State Plane Coordinate System, East Zone.

**SURVEYOR'S CERTIFICATION**

WE, POPLI, ARCHITECTURE + ENGINEERING & L.S., P.C., HEREBY CERTIFY TO THE NEW YORK STATE DEPARTMENT OF ENVIRONMENTAL CONSERVATION THAT THIS SURVEY AND MAP WAS PREPARED UNDER THE DIRECTION OF A LICENSED LAND SURVEYOR AND FROM THE NOTES OF AN INSTRUMENT SURVEY COMPLETED AUGUST 23, 2011 AND THE REFERENCES LISTED HEREON. THIS SURVEY IS SUBJECT TO ANY EASEMENTS AND/OR ENCUMBRANCES THAT MAY EXIST.



MICHAEL A. VENTURO, LS 50079  
 FOR: POPLI DESIGN GROUP  
 555 Pentrocks Drive  
 Penfield, NY 14526  
 Phone: 585-388-2060

UNAUTHORIZED ALTERATION OR ADDITION TO A SURVEY MAP BEARING A LICENSED LAND SURVEYOR'S SEAL IS A VIOLATION OF SECTION 7209, SUB-DIVISION 2, OF THE NEW YORK STATE EDUCATION LAW.

**LEGEND**

- CATCH BASIN
- STREET SIGN
- UTILITY POLE
- MAIL BOX
- PAPER BOX
- STORM DRAIN LINE
- UNDERGROUND TELE / COMMUNICATIONS

|   |  |  |
|---|--|--|
| SURVEY BY:<br><b>POPLI DESIGN GROUP</b> |  | PREPARED FOR:<br><b>DVIRKA AND BARTILUCCI CONSULTING ENGINEERS</b>   |
| SURVEYOR JOB NUMBER:<br>SU4040.02       |  | 5879 Fisher Road<br>East Syracuse, NY 13057<br>Phone: (315) 437-1142 |
| SURVEY CREW:<br>J. PHILLIPS W. STRATTON |  |  |
| DRAWN BY:<br>J. PHILLIPS                |  |  |
| CHECKED BY:<br>M. VENTURO               |  |  |
| REVISIONS                               |  |  |

FORMER  
BOUCHARD JUNKYARD SITE  
NYSDEC SITE NO. 4-11-014  
**ENVIRONMENTAL NOTICE PARCEL**

Town of New Lebanon, County of Columbia, State of New York


SCALE: 1" = 30' DATE: OCTOBER 5, 2011

Site Management Plan  
APPENDIX B

As-Built Drawings, Endpoint Sample Locations  
Endpoint Sample Results


---

Former Bouchard Junkyard Site  
Site No. 411014  
New Lebanon, Columbia County  
January 2015


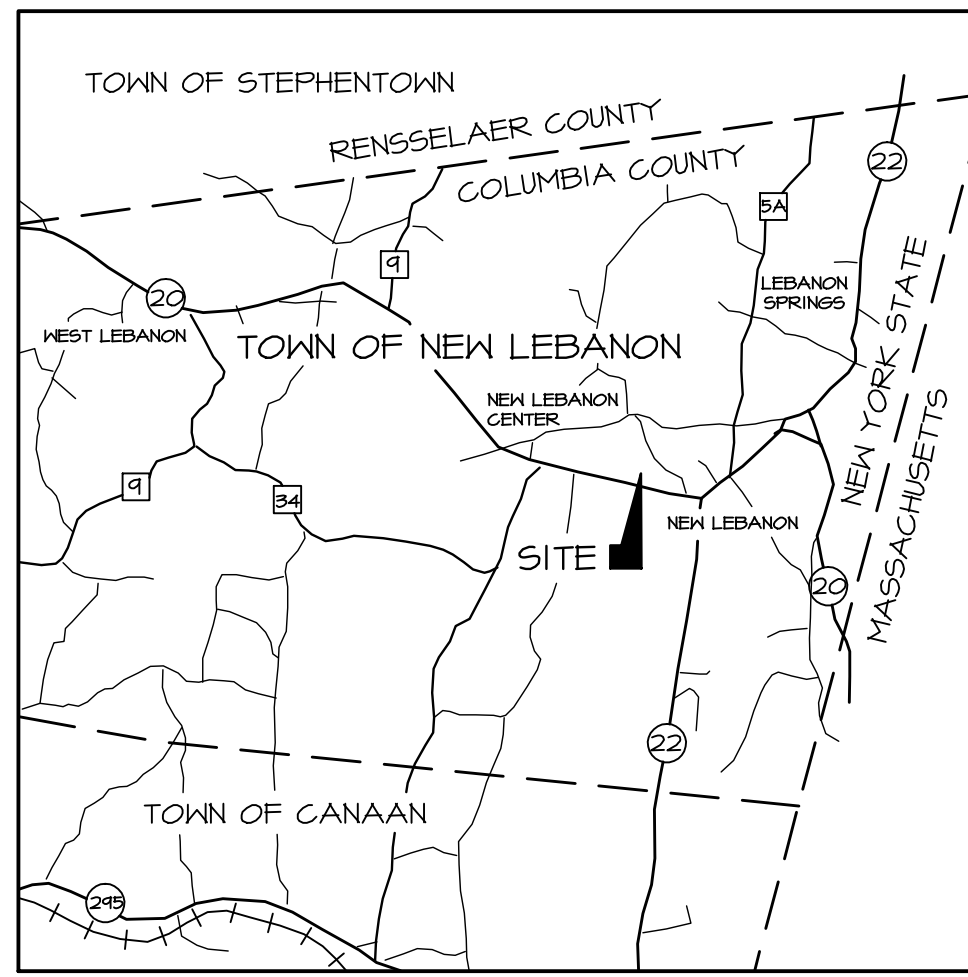


SITE LOCATION MAP  
NOT TO SCALE

© COPYRIGHT 2009 CLARK ENGINEERING & SURVEYING, P.C.  
"ALL RIGHTS RESERVED" AND "UNAUTHORIZED DUPLICATION IS A VIOLATION OF APPLICABLE LAWS."  
UNAUTHORIZED ALTERATIONS TO THIS DOCUMENT IS A VIOLATION OF SECTION 7209 SUBDIVISION 2 OF THE NEW YORK STATE EDUCATION LAW  
G:\Projects\30804\dwg\30804 PRE-CONSTRUCTION.dwg  
March 20, 2009

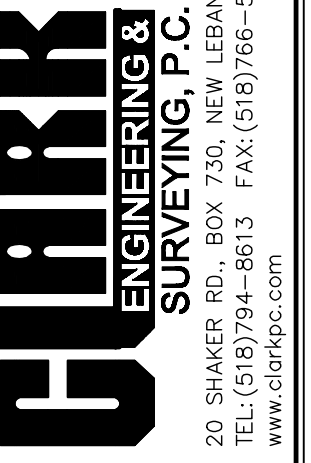


N.Y.S. DEPARTMENT OF ENVIRONMENTAL CONSERVATION  
REMIEDIATION SITE NO. 4-II-014  
FORMER BOUGHARD JUNKYARD  
NEW LEBANON, COLUMBIA COUNTY, NEW YORK

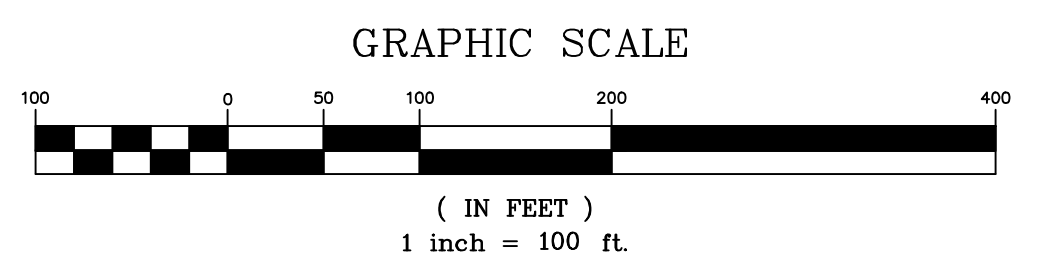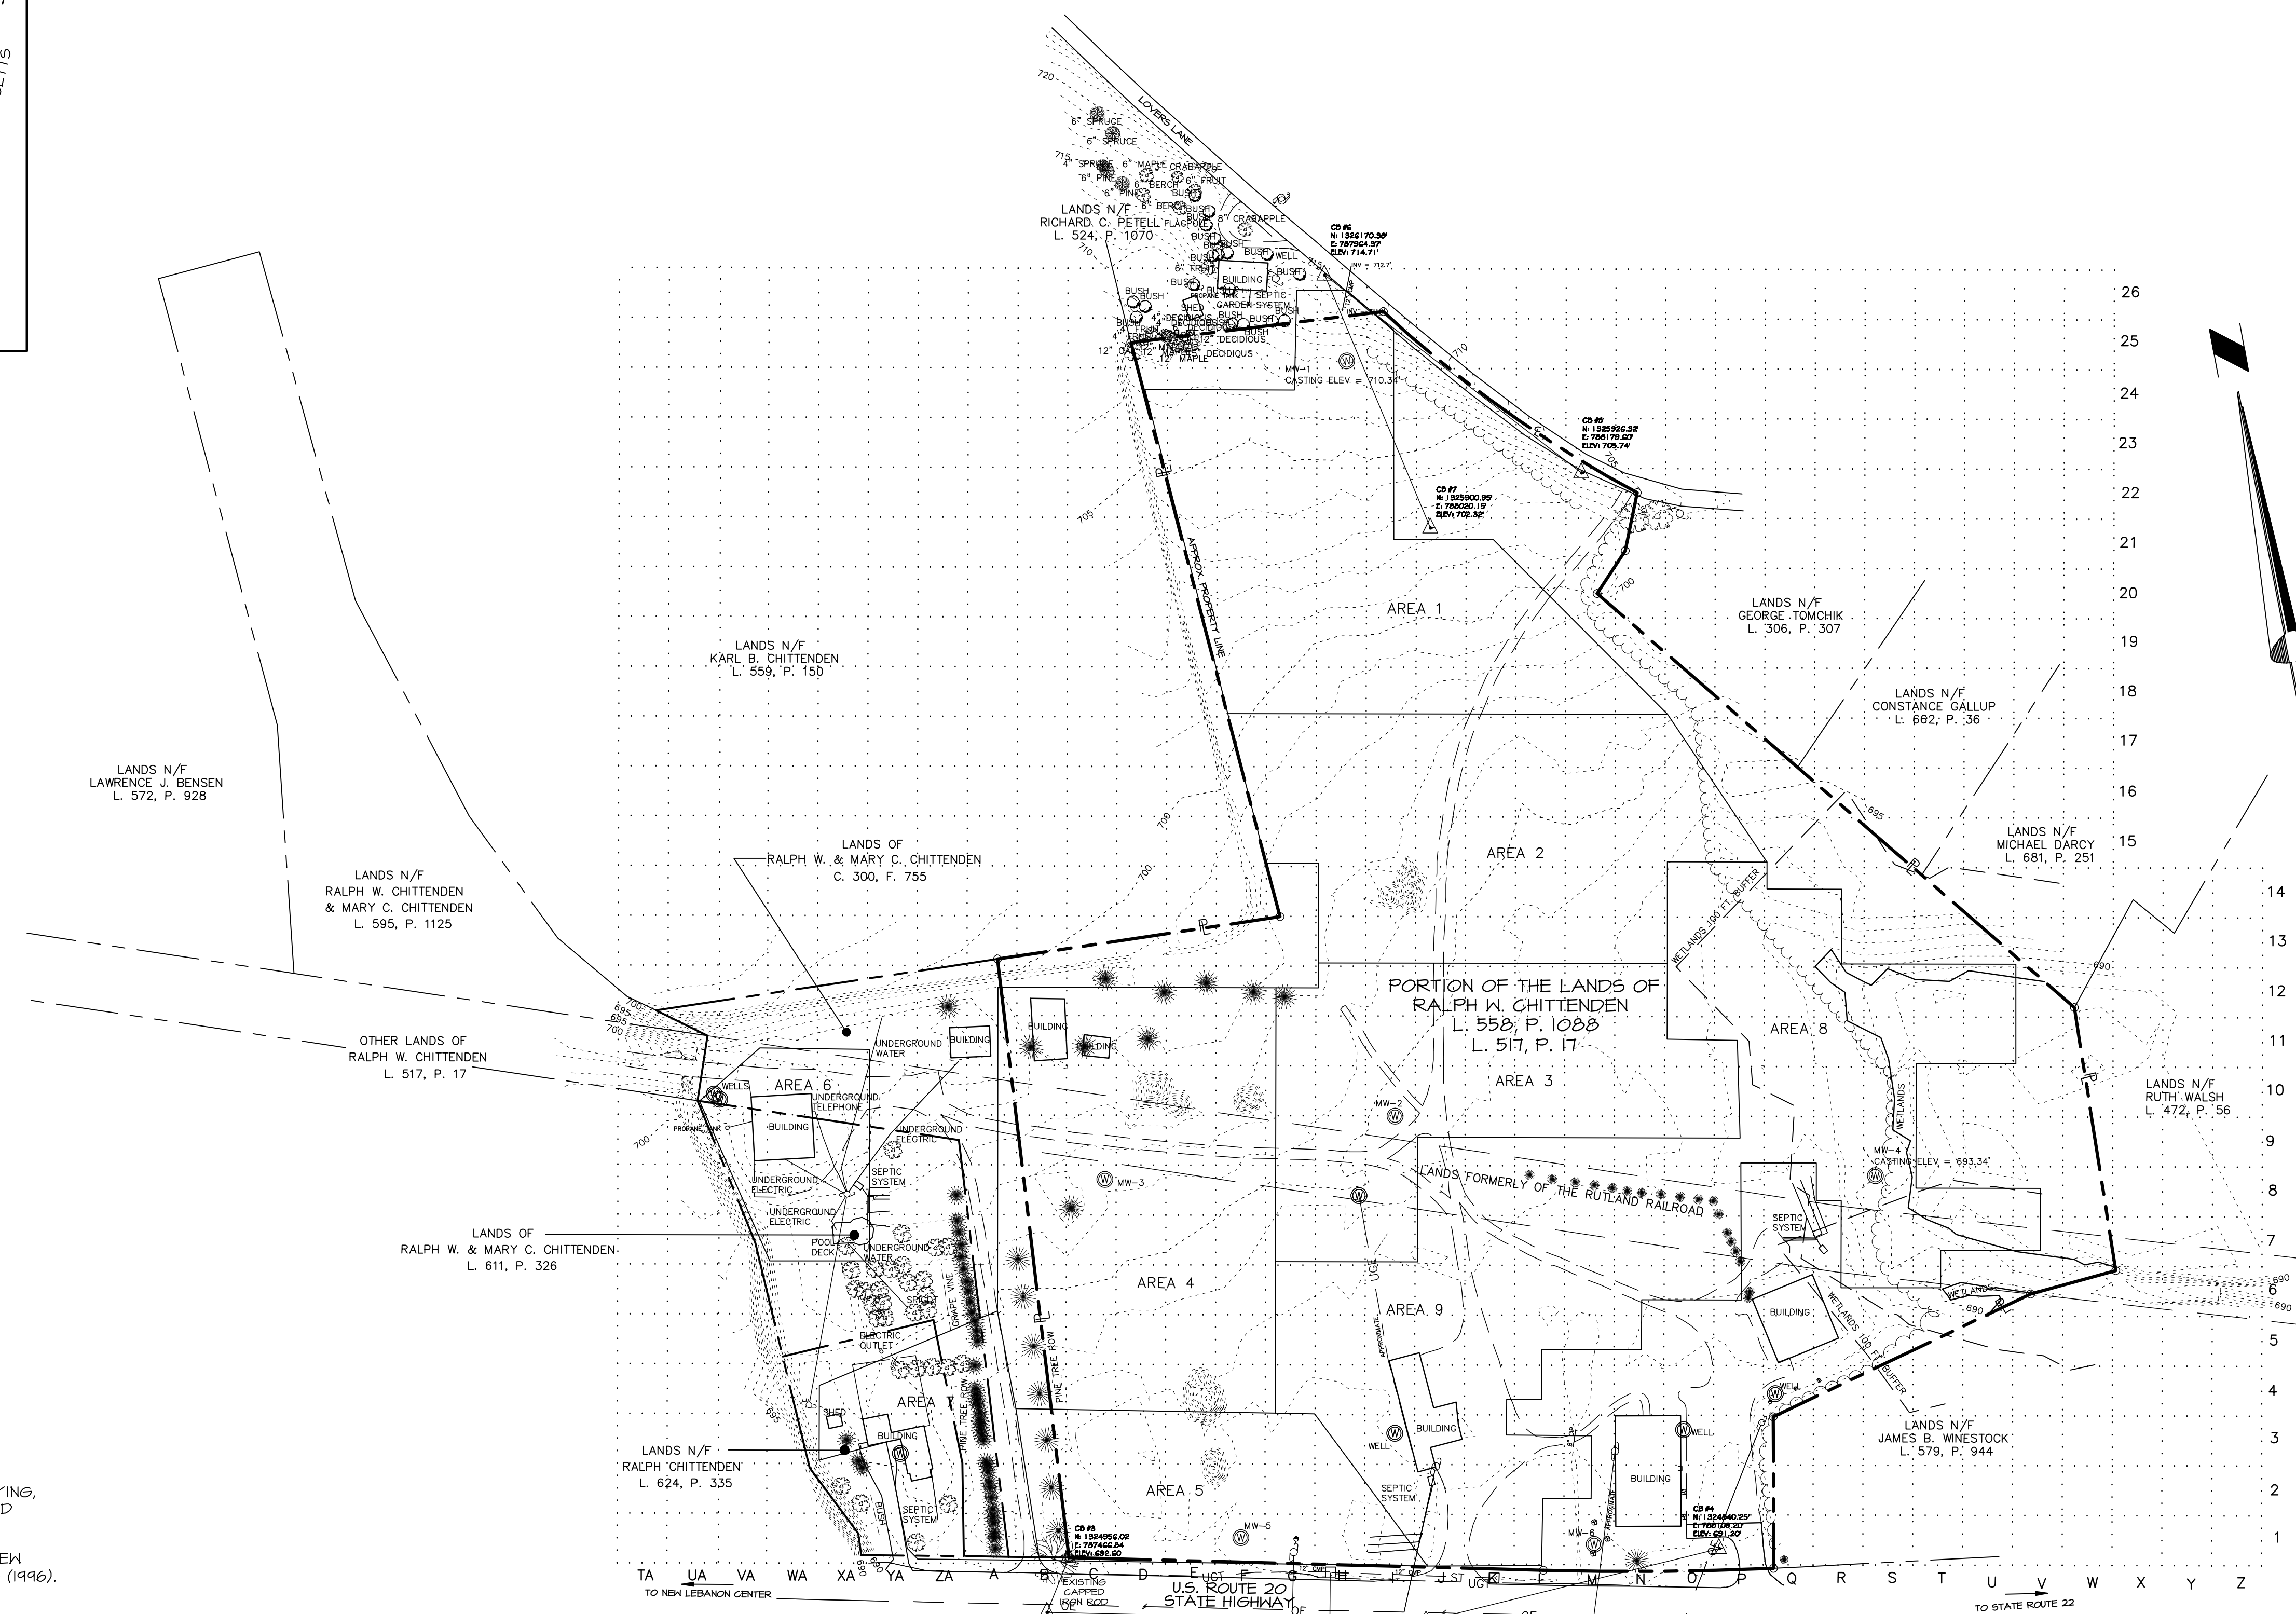

- NOTES:
- MAPPING PREPARED BY CLARK ENGINEERING & SURVEYING, P.C., FROM A FIELD SURVEY COMPLETED MAY 2008 AND UPDATED AUGUST 2008 AND OCTOBER 2008.
  - NORTH REFERENCE USED HEREON IS GRID NORTH PER NEW YORK STATE PLANE COORDINATE SYSTEM EAST NAD83 (1996).
  - VERTICAL REFERENCE USED HEREON IS NAVD 88.
  - UNDERGROUND UTILITIES AS SHOWN HEREON ARE FROM FIELD LOCATION, THEIR LOCATIONS ARE APPROXIMATE, OTHERS MAY EXIST, AND ALL ARE SUBJECT TO VERIFICATION BY OTHERS.
  - PARCEL SURVEYED MAY BE ALONG WITH AND/OR SUBJECT TO RIGHTS, TITLE AND/OR INTERESTS IN AND TO LANDS WITHIN THE BED OF THE ADJACENT ROADS LYING BETWEEN THE HIGHWAY BOUNDARIES SHOWN HEREON AND THE CENTERLINES THEREOF.
  - PARCEL SURVEYED IS FURTHER REFERENCED TO THE TOWN OF NEW LEBANON TAX MAP PARCEL ID NO. 19,02-1-88.
  - PARCEL SURVEYED WITHOUT BENEFIT OF, AND IS SUBJECT TO A COMPLETE AND UP-TO-DATE ABSTRACT OF TITLE.

- MAP REFERENCES:
- "PROPERTY LINE SURVEY MAP PORTION OF THE LANDS OF RALPH W. CHITTENDEN" DATED NOVEMBER 9, 2001 AS PREPARED BY CLARK ENGINEERING AND SURVEYING P.C.
  - "NEW YORK STATE DEPARTMENT OF ENVIRONMENTAL CONSERVATION REMEDIAL CONSTRUCTION CONTRACT NO. D006282 FORMER BOUGHARD JUNKYARD NEW LEBANON, NEW YORK SOIL EXCAVATION AND OFF-SITE DISPOSAL SITE NO. 4-II-014," SHEETS 1-5, DATED JANUARY 2008 AS PREPARED BY DVIRKA AND BARTILUCCI.

| SCALE  | 1" = 100'  | NO. | BY  | DATE     |
|--|------------|-----|-----|----------|
| DATE   | 10/16/2008 | 1   | LIB | 10/20/08 |
| DRAWN BY   | LIB        | 2   | REV | 10/22/08 |
| CHECKED BY   | LIB        |     | COM |          |
| APPROVED BY  | LIB        |     | ENG |          |
| REVISIONS:<br>1 ADDED PROPERTY LINES AND CASTING ELEV. LIB/20/08<br>2 REVISIONS PER DVIRKA & BARTILUCCI COMMENTS LIB/21/08 |            |     |     |          |
| TITLE<br>PRE-CONSTRUCTION TOPOGRAPHIC SURVEY   |            |     |     |          |
| PROJECT NO.<br>30804   |            |     |     |          |
| DRAWING NAME<br>30804 PRE-CONSTRUCTION   |            |     |     |          |
| DRAWING NO.<br>VI  |            |     |     |          |


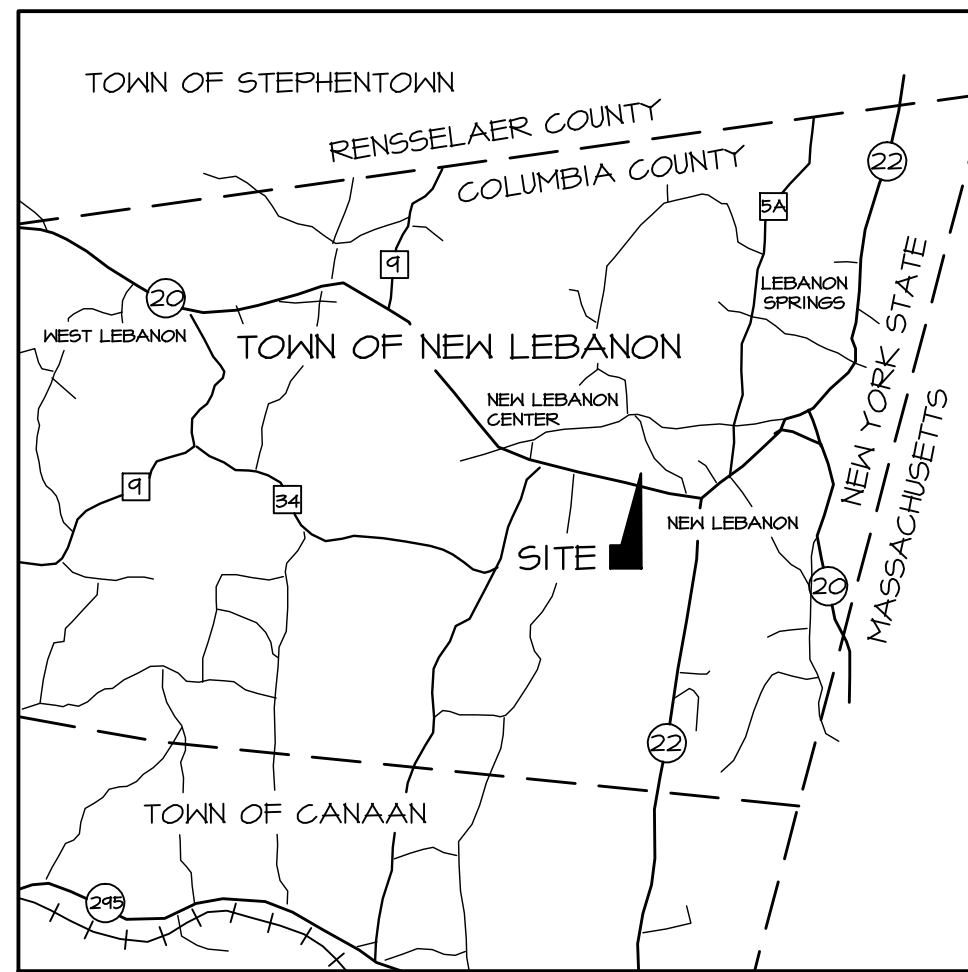


SITE LOCATION MAP  
NOT TO SCALE

© COPYRIGHT 2009 CLARK ENGINEERING & SURVEYING, P.C.  
"ALL RIGHTS RESERVED" AND "UNAUTHORIZED DUPLICATION IS A VIOLATION OF APPLICABLE LAWS."  
UNAUTHORIZED ALTERATIONS TO THIS DOCUMENT IS A VIOLATION OF SECTION 7209 SUBDIVISION 2 OF THE NEW YORK STATE EDUCATION LAW  
G:\Projects\30809\dwg\30809EXCAVATION.DWG  
March 20, 2009

**CLARK**  
ENGINEERING &  
SURVEYING, P.C.  
20 SHAKER RD., BOX 730, NEW LEBANON, NY 12125  
TEL: (518)794-8613 FAX: (518)766-5663  
www.clarkpc.com

N.Y.S. DEPARTMENT OF ENVIRONMENTAL CONSERVATION  
REMIEDIATION SITE NO. 4-II-014  
FORMER BOUGHARD JUNKYARD  
NEW LEBANON, COLUMBIA COUNTY, NEW YORK

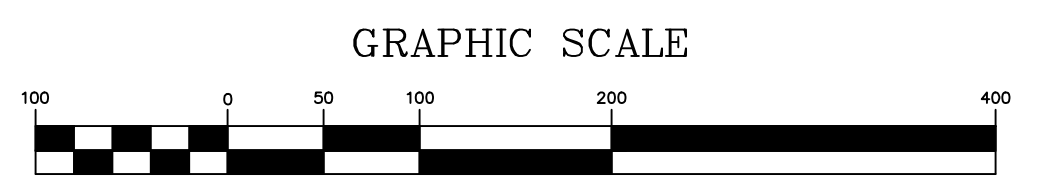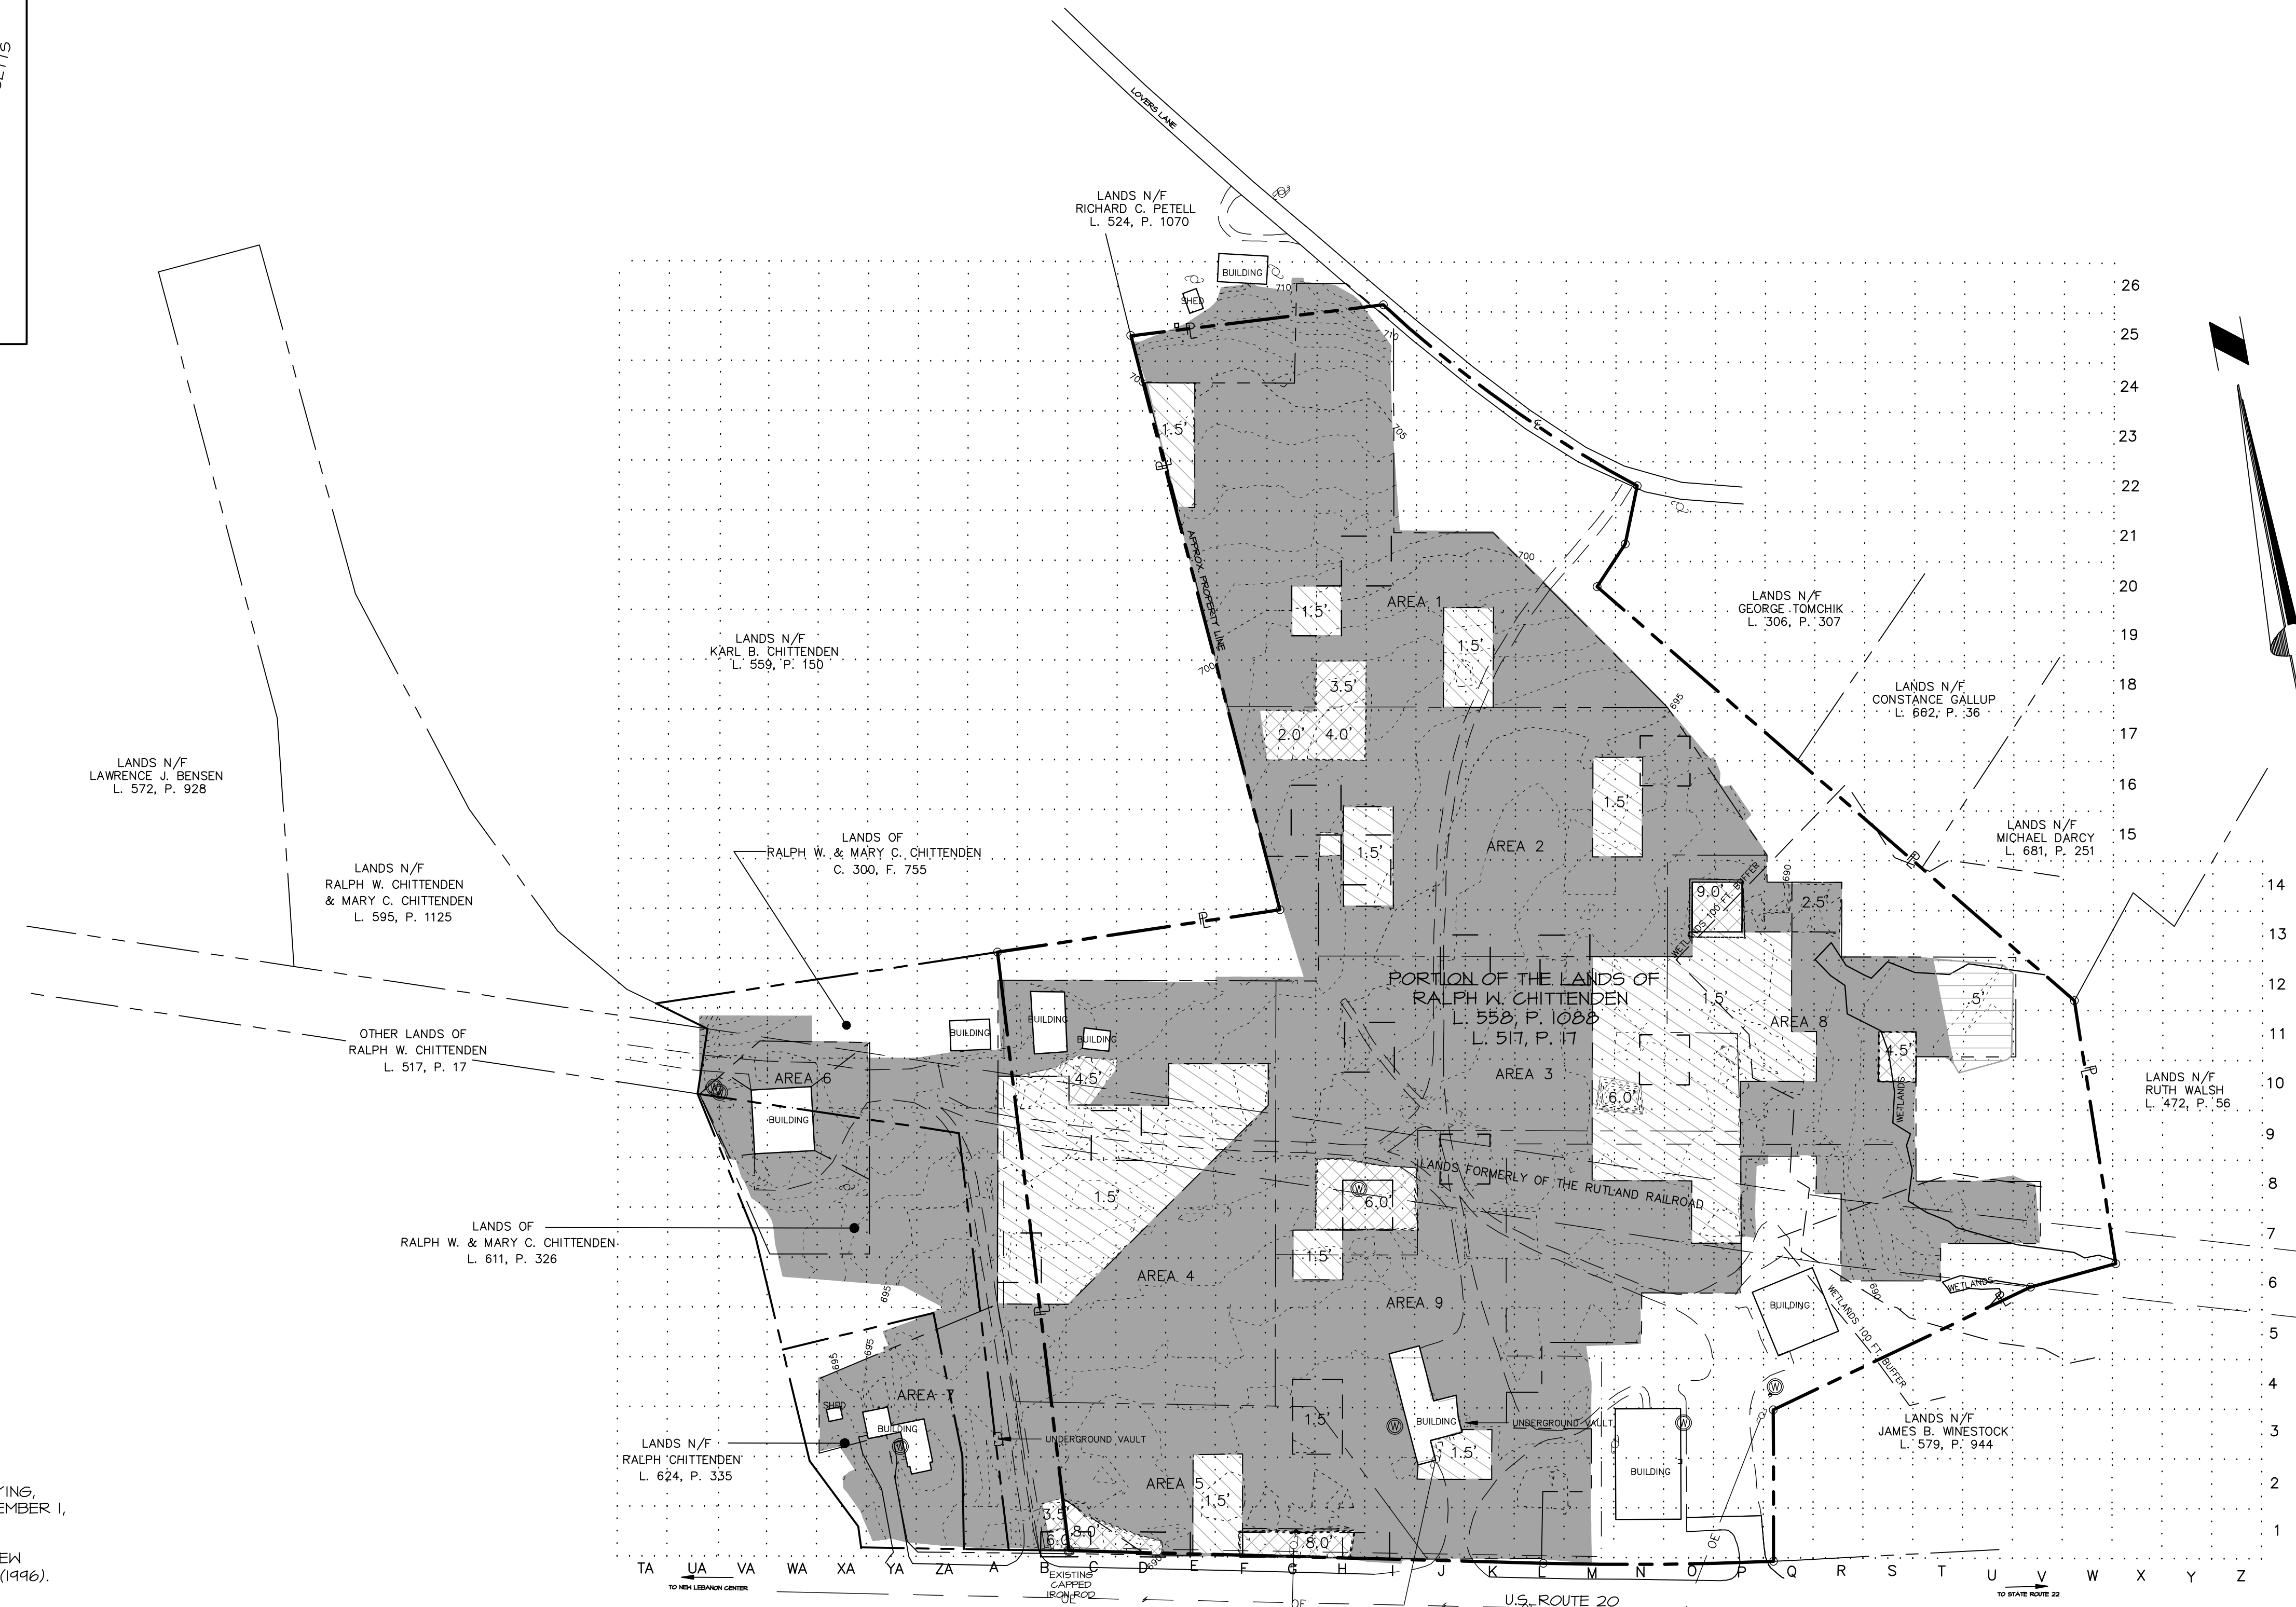

NOTES:

- MAPPING PREPARED BY CLARK ENGINEERING & SURVEYING, P.C., FROM A FIELD SURVEY COMPLETED THROUGH DECEMBER 1, 2008.
- NORTH REFERENCE USED HEREON IS GRID NORTH PER NEW YORK STATE PLANE COORDINATE SYSTEM EAST NAD83(1996).
- VERTICAL REFERENCE USED HEREON IS NAVD 88.
- UNDERGROUND UTILITIES AS SHOWN HEREON ARE FROM FIELD LOCATION, THEIR LOCATIONS ARE APPROXIMATE, OTHERS MAY EXIST, AND ALL ARE SUBJECT TO VERIFICATION BY OTHERS.
- PARCEL SURVEYED MAY BE ALONG WITH AND/OR SUBJECT TO RIGHTS, TITLE AND/OR INTERESTS IN AND TO LANDS WITHIN THE BED OF THE ADJACENT ROADS LYING BETWEEN THE HIGHWAY BOUNDARIES SHOWN HEREON AND THE CENTERLINES THEREOF.
- PARCEL SURVEYED IS FURTHER REFERENCED TO THE TOWN OF NEW LEBANON TAX MAP PARCEL ID NO. 14.02-1-08.
- PARCEL SURVEYED WITHOUT BENEFIT OF, AND IS SUBJECT TO A COMPLETE AND UP-TO-DATE ABSTRACT OF TITLE.

MAP REFERENCES:

- "PROPERTY LINE SURVEY MAP PORTION OF THE LANDS OF RALPH W. CHITTENDEN", DATED NOVEMBER 9, 2001 AS PREPARED BY CLARK ENGINEERING AND SURVEYING P.C.
- "NEW YORK STATE DEPARTMENT OF ENVIRONMENTAL CONSERVATION REMEDIAL CONSTRUCTION CONTRACT NO. D006282 FORMER BOUGHARD JUNKYARD NEW LEBANON, NEW YORK SOIL EXCAVATION AND OFF-SITE DISPOSAL SITE NO. 4-II-014," SHEETS 1-5, DATED JANUARY 2008 AS PREPARED BY DVIRKA AND BARTILUCCI.

Site Volume Table: Unadjusted

| Site     | Stratum       | Surf1            | Surf2 | Cut      |        | Fill   |        | Net    |        | Method    |
|----------|---------------|------------------|-------|----------|--------|--------|--------|--------|--------|-----------|
|          |               |                  |       | cu.yds   | cu.yds | cu.yds | cu.yds | cu.yds | cu.yds |           |
| JUNKYARD | november 2008 | pre-construction | 30809 | 12012008 | bottom | 44431  | 9      | 44422  | (C)    | Grid      |
|          |               |                  |       |          |        | 44612  | 10     | 44602  | (C)    | Composite |
|          |               |                  |       |          |        |        |        | 44512  | (C)    | AVERAGE   |
| WETLANDS | november 2008 | pre-construction | 30809 | 12012008 | bottom | 2317   | 0      | 2317   | (C)    | Grid      |
|          |               |                  |       |          |        | 2503   | 1      | 2502   | (C)    | Composite |
|          |               |                  |       |          |        |        |        | 2410   | (C)    | AVERAGE   |

- SOIL EXCAVATED TO A DEPTH OF 0.5' BELOW ORIGINAL SURFACE
- SOIL EXCAVATED TO A DEPTH OF 1.0' BELOW ORIGINAL SURFACE
- SOIL EXCAVATED TO A DEPTH OF 1.5' BELOW ORIGINAL SURFACE
- SOIL EXCAVATED TO A DEPTH OF AS INDICATED


REVISIONS:

| NO. | DATE       | BY  | DESCRIPTION  |
|-----|------------|-----|--|
| 1   | 10/16/2008 | LIB | 4 UPDATED CONTIGUOUS VOLUME TABLE AND ADDED WETLANDS |
| 2   | 10/22/08   | LIB | 5 REVISIONS PER DVIRKA AND BARTILUCCI COMMENTS       |
| 3   | 11/06/08   | LIB | 6 REVISIONS PER DVIRKA AND BARTILUCCI COMMENTS       |
| 4   | 11/20/08   | LIB | 7 REVISIONS PER DVIRKA AND BARTILUCCI COMMENTS       |

PROJECT NO.  
**30809**

DRAWING NAME  
**30809EXCAVATION.DWG**

DRAWING NO.  
**V2**

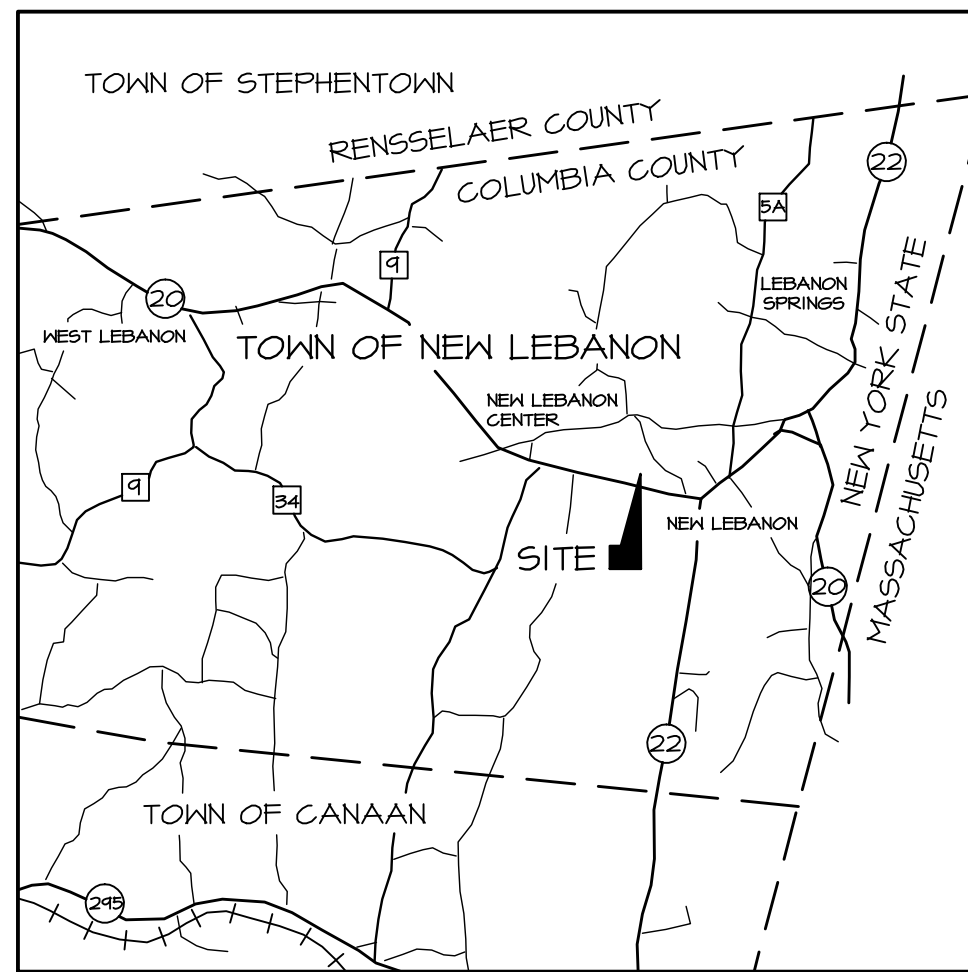

SITE LOCATION MAP  
NOT TO SCALE

© COPYRIGHT 2009 CLARK ENGINEERING & SURVEYING, P.C.  
"ALL RIGHTS RESERVED" AND "UNAUTHORIZED DUPLICATION  
IS A VIOLATION OF APPLICABLE LAWS."  
UNAUTHORIZED ALTERATIONS TO THIS DOCUMENT IS A VIOLATION OF  
SECTION 7209 SUBDIVISION 2 OF THE NEW YORK STATE EDUCATION LAW  
G:\Projects\30809\dwg\30809 EXCAVATION WETLANDS.DWG  
March 20, 2009





N.Y.S. DEPARTMENT OF ENVIRONMENTAL CONSERVATION  
REMEDATION SITE NO. 4-II-014  
FORMER BOUGHARD JUNKYARD  
NEW LEBANON, COLUMBIA COUNTY, NEW YORK

- SOIL EXCAVATED TO A DEPTH OF 0.5' BELOW ORIGINAL SURFACE
- SOIL EXCAVATED TO A DEPTH OF 1.0' BELOW ORIGINAL SURFACE
- SOIL EXCAVATED TO A DEPTH OF 1.5' BELOW ORIGINAL SURFACE
- SOIL EXCAVATED TO A DEPTH OF AS INDICATED

- NOTES:
- MAPPING PREPARED BY CLARK ENGINEERING & SURVEYING, P.C., FROM A FIELD SURVEY COMPLETED THROUGH DECEMBER, 2008.
  - NORTH REFERENCE USED HEREON IS GRID NORTH PER NEW YORK STATE PLANE COORDINATE SYSTEM EAST NAD83 (1996).
  - VERTICAL REFERENCE USED HEREON IS NAVD 88.
  - UNDERGROUND UTILITIES AS SHOWN HEREON ARE FROM FIELD LOCATION, THEIR LOCATIONS ARE APPROXIMATE, OTHERS MAY EXIST, AND ALL ARE SUBJECT TO VERIFICATION BY OTHERS.
  - PARCEL SURVEYED MAY BE ALONG WITH AND/OR SUBJECT TO RIGHTS, TITLE AND/OR INTERESTS IN AND TO LANDS WITHIN THE BED OF THE ADJACENT ROADS LYING BETWEEN THE HIGHWAY BOUNDARIES SHOWN HEREON AND THE CENTERLINES THEREOF.
  - PARCEL SURVEYED IS FURTHER REFERENCED TO THE TOWN OF NEW LEBANON TAX MAP PARCEL ID NO. 14.02-1-28.
  - PARCEL SURVEYED WITHOUT BENEFIT OF, AND IS SUBJECT TO A COMPLETE AND UP-TO-DATE ABSTRACT OF TITLE.

- MAP REFERENCES:
- "PROPERTY LINE SURVEY MAP PORTION OF THE LANDS OF RALPH W. CHITTENDEN", DATED NOVEMBER 9, 2001 AS PREPARED BY CLARK ENGINEERING AND SURVEYING P.C.
  - "NEW YORK STATE DEPARTMENT OF ENVIRONMENTAL CONSERVATION REMEDIAL CONSTRUCTION CONTRACT NO. D006282 FORMER BOUGHARD 'JUNKYARD' NEW LEBANON, NEW YORK SOIL EXCAVATION AND OFF-SITE DISPOSAL SITE NO. 4-II-014," SHEETS 1-5, DATED JANUARY 2008 AS PREPARED BY DVIRKA AND BARTILUCCI.

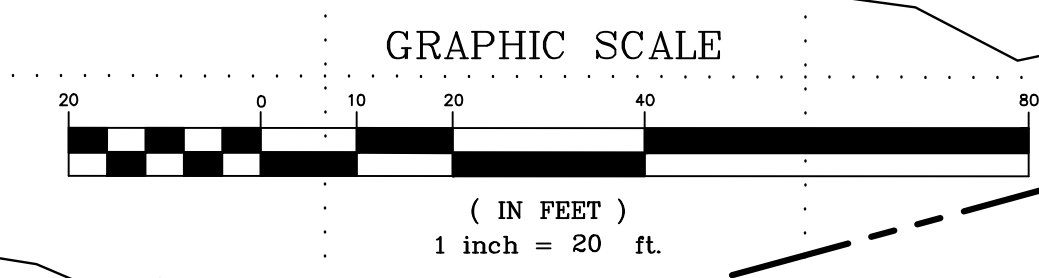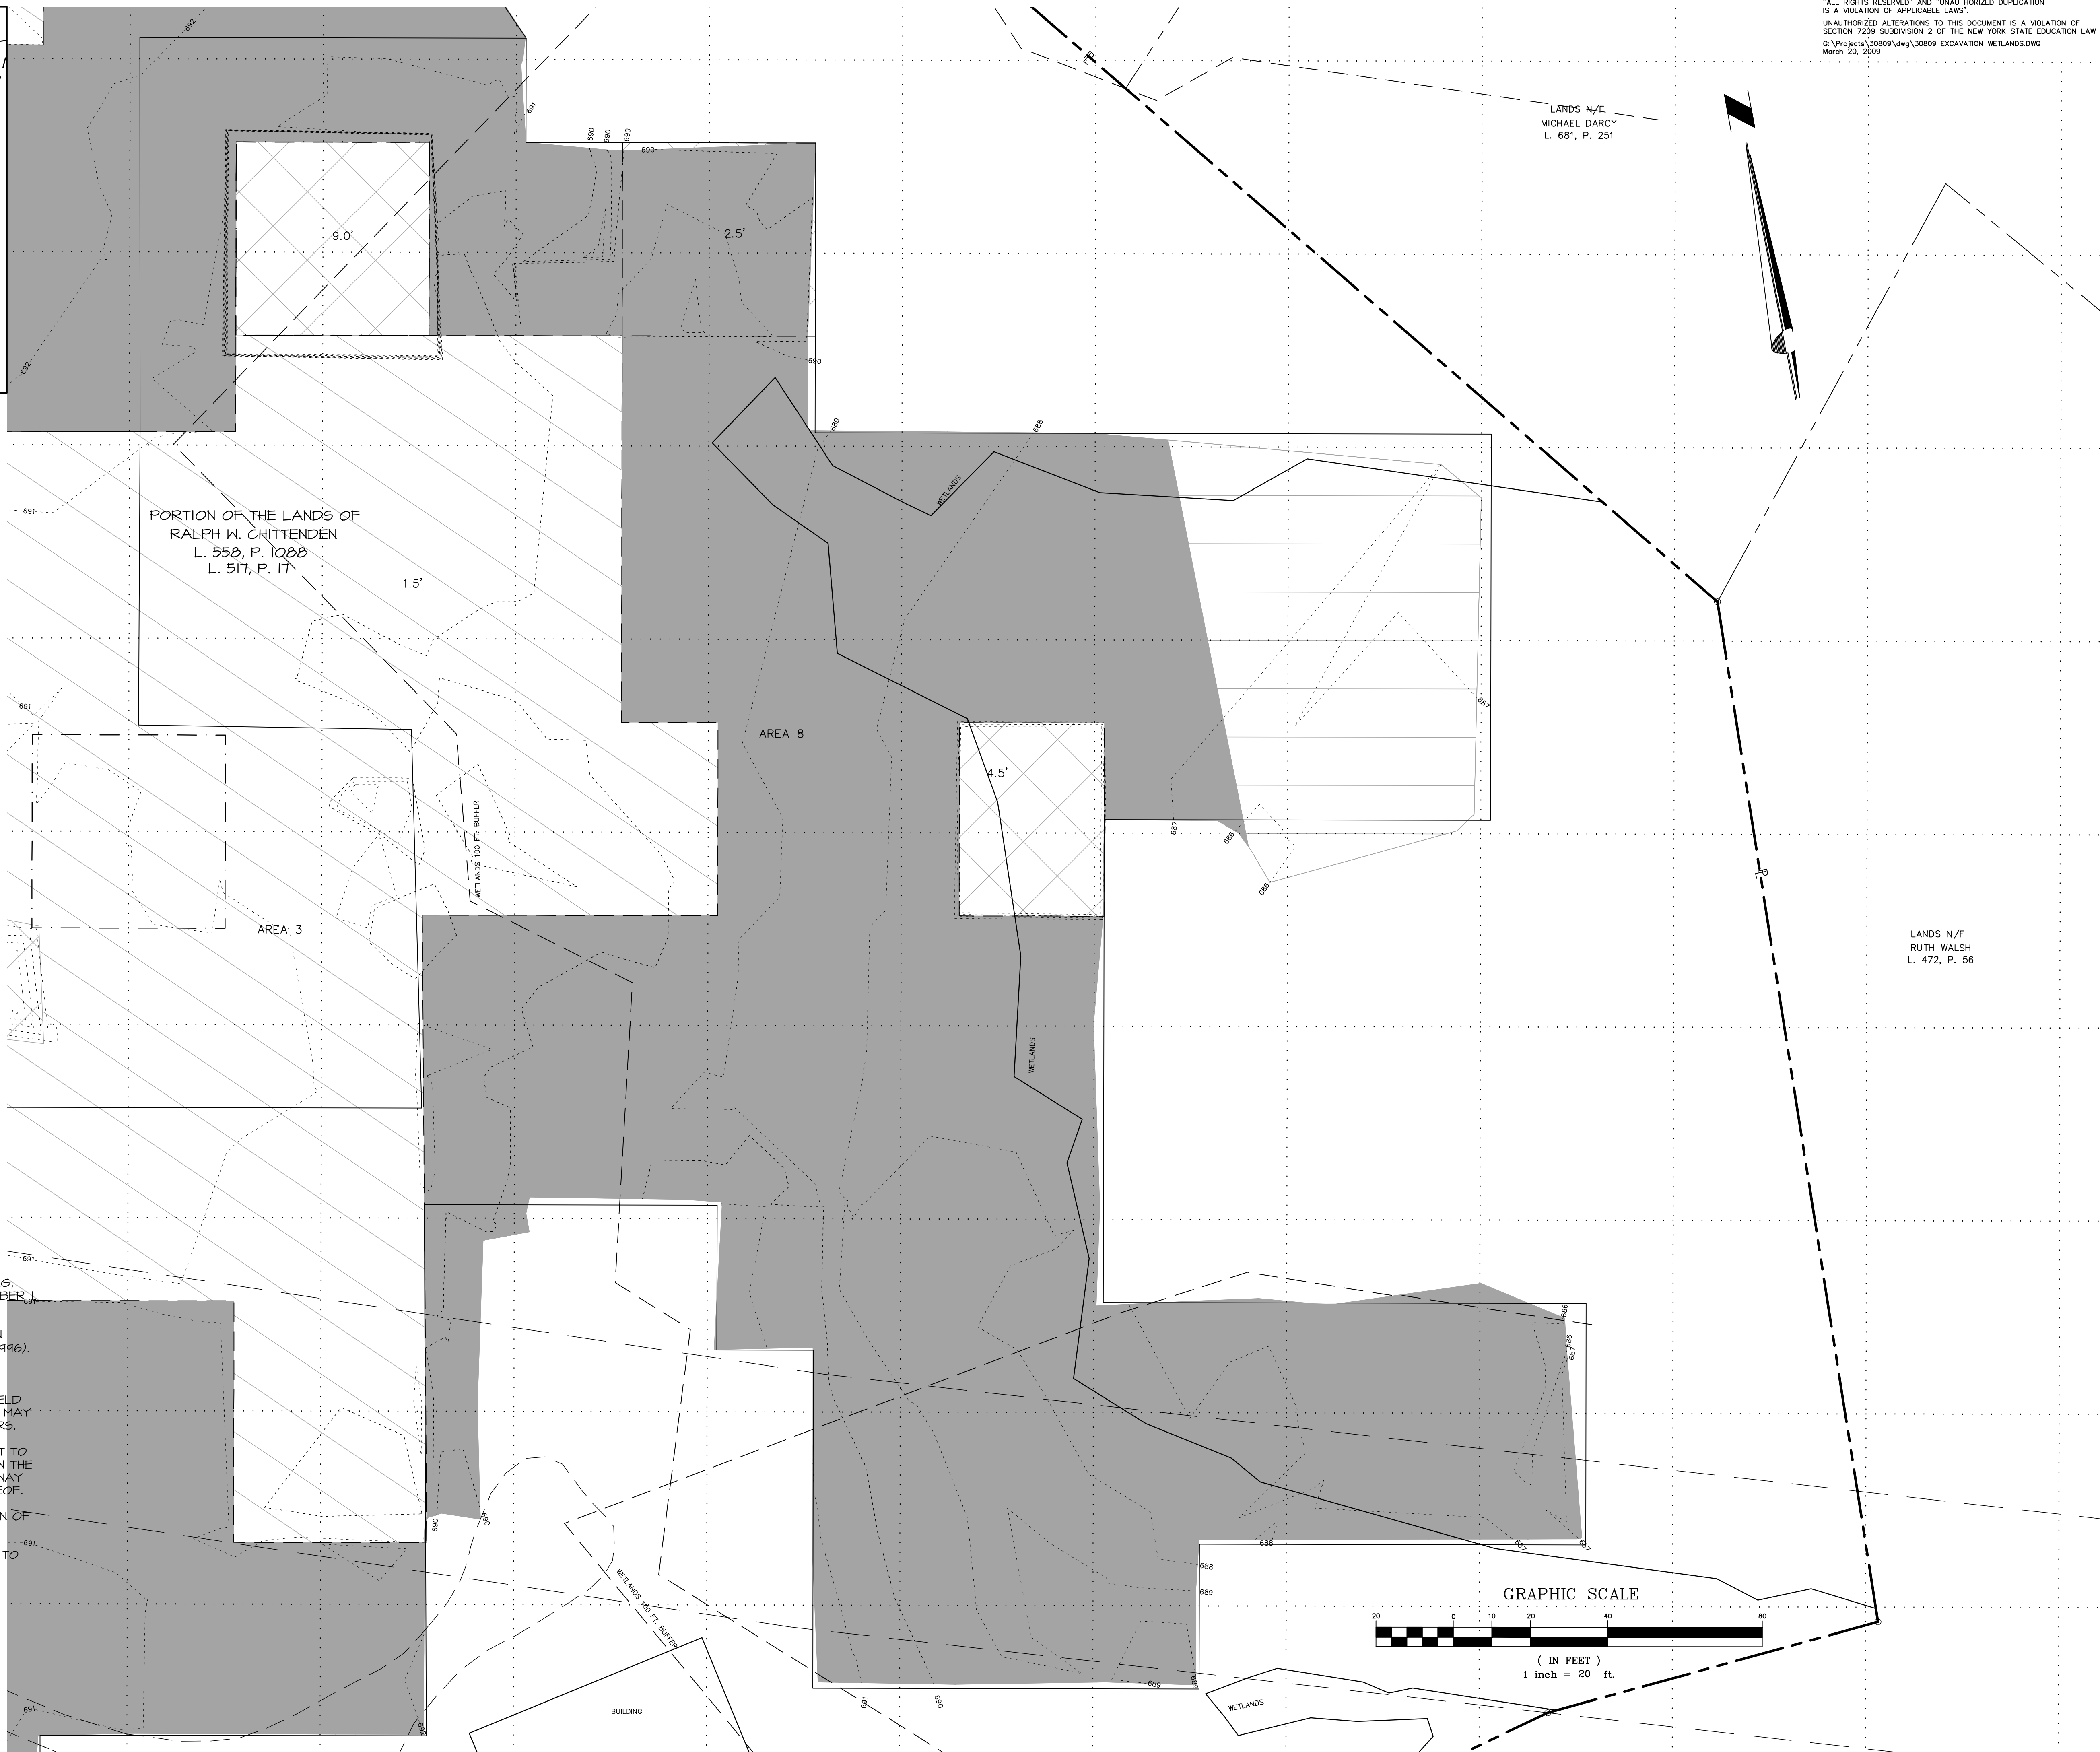


| SCALE       | 1" = 20'  | NO. | BY  | DATE    |
|-------------|-----------|-----|-----|---------|
| DATE        | 1/20/2009 | 1   | LIB | 2/6/09  |
| DRAWN BY    | LIB       | 2   | LIB | 3/11/09 |
| CHECKED BY  | ERG       | 3   | LIB | 3/20/09 |
| APPROVED BY | ERG       |     |     |         |

REVISIONS:


1 REVISIONS PER DVIRKA AND BARTILUCCI COMMENTS  
2 REVISIONS PER DVIRKA AND BARTILUCCI COMMENTS  
3 REVISIONS PER DVIRKA AND BARTILUCCI COMMENTS

PROJECT NO. 30809  
DRAWING NAME 30809 EXCAVATION WETLANDS  
DRAWING NO. V3

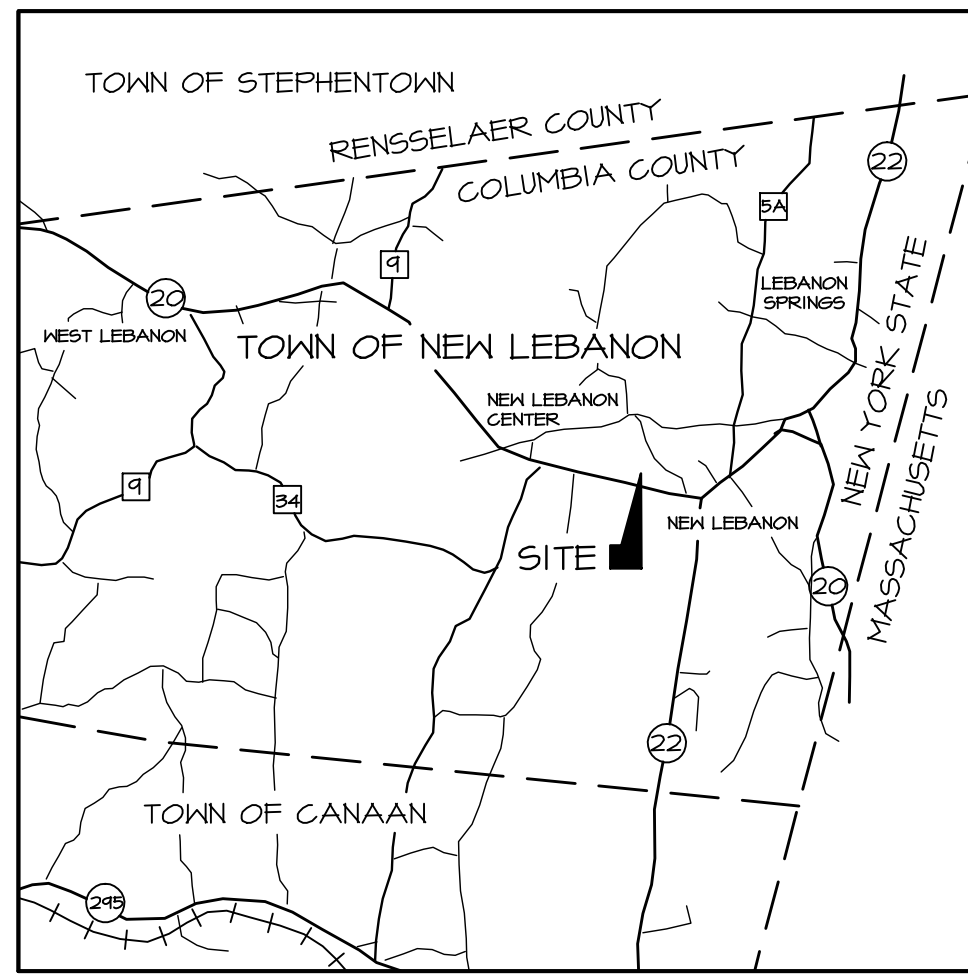

SITE LOCATION MAP  
NOT TO SCALE

© COPYRIGHT 2009 CLARK ENGINEERING & SURVEYING, P.C.  
"ALL RIGHTS RESERVED" AND "UNAUTHORIZED DUPLICATION IS A VIOLATION OF APPLICABLE LAWS."  
UNAUTHORIZED ALTERATIONS TO THIS DOCUMENT IS A VIOLATION OF SECTION 7209 SUBDIVISION 2 OF THE NEW YORK STATE EDUCATION LAW  
G:\Projects\30809\dwg\30809 SAMPLE.dwg  
March 20, 2009

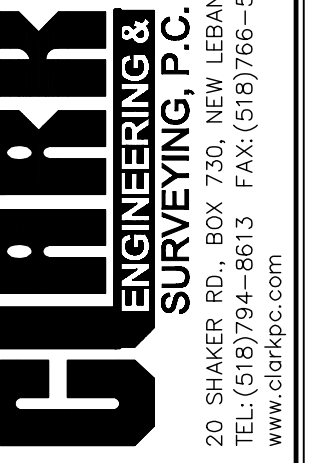

N.Y.S. DEPARTMENT OF ENVIRONMENTAL CONSERVATION  
REMIEDIATION SITE NO. 4-II-014  
FORMER BOUGHARD JUNKYARD  
NEW LEBANON, COLUMBIA COUNTY, NEW YORK




NOTES:


- MAPPING PREPARED BY CLARK ENGINEERING & SURVEYING, P.C., FROM A FIELD SURVEY COMPLETED THROUGH DECEMBER 1, 2008.
- NORTH REFERENCE USED HEREON IS GRID NORTH PER NEW YORK STATE PLANE COORDINATE SYSTEM EAST NAD83 (1946).
- VERTICAL REFERENCE USED HEREON IS NAVD 88.
- UNDERGROUND UTILITIES AS SHOWN HEREON ARE FROM FIELD LOCATION, THEIR LOCATIONS ARE APPROXIMATE, OTHERS MAY EXIST, AND ALL ARE SUBJECT TO VERIFICATION BY OTHERS.
- PARCEL SURVEYED MAY BE ALONG WITH AND/OR SUBJECT TO RIGHTS, TITLE AND/OR INTERESTS IN AND TO LANDS WITHIN THE BED OF THE ADJACENT ROADS LYING BETWEEN THE HIGHWAY BOUNDARIES SHOWN HEREON AND THE CENTERLINES THEREOF.
- PARCEL SURVEYED IS FURTHER REFERENCED TO THE TOWN OF NEW LEBANON TAX MAP PARCEL ID NO. 19.02-1-08.
- PARCEL SURVEYED WITHOUT BENEFIT OF, AND IS SUBJECT TO A COMPLETE AND UP-TO-DATE ABSTRACT OF TITLE.

MAP REFERENCES:

- "PROPERTY LINE SURVEY MAP PORTION OF THE LANDS OF RALPH W. CHITTENDEN", DATED NOVEMBER 9, 2001 AS PREPARED BY CLARK ENGINEERING AND SURVEYING P.C.
- "NEW YORK STATE DEPARTMENT OF ENVIRONMENTAL CONSERVATION REMEDIAL CONSTRUCTION CONTRACT NO. D006282 FORMER BOUGHARD JUNKYARD NEW LEBANON, NEW YORK SOIL EXCAVATION AND OFF-SITE DISPOSAL SITE NO. 4-II-014," SHEETS 1-5, DATED JANUARY 2008 AS PREPARED BY DVIRKA AND BARTILUCCI.

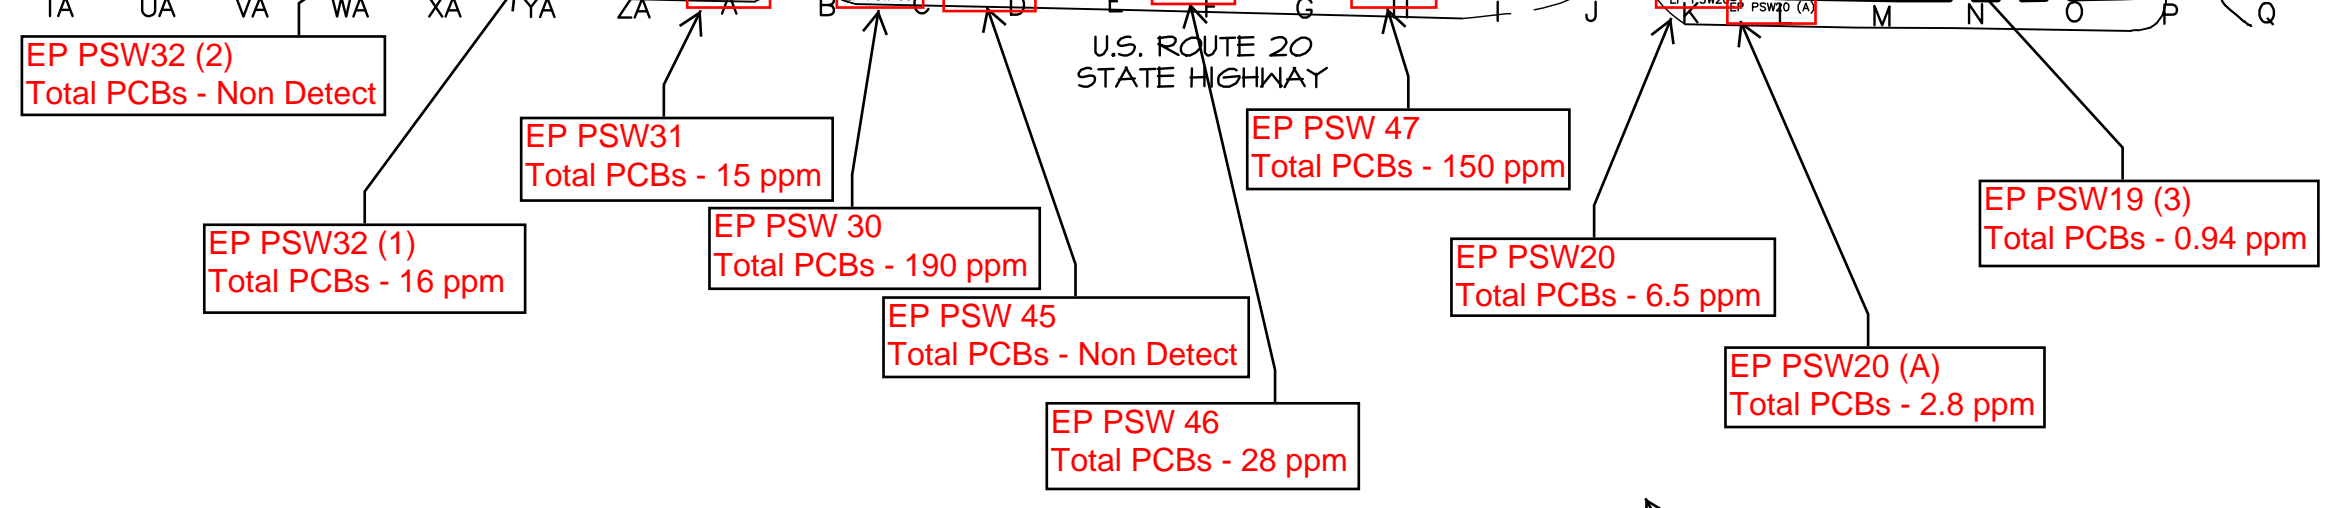


Note: End point samples located along U.S. Route 20 are highlighted and analytical results for those points are shown.

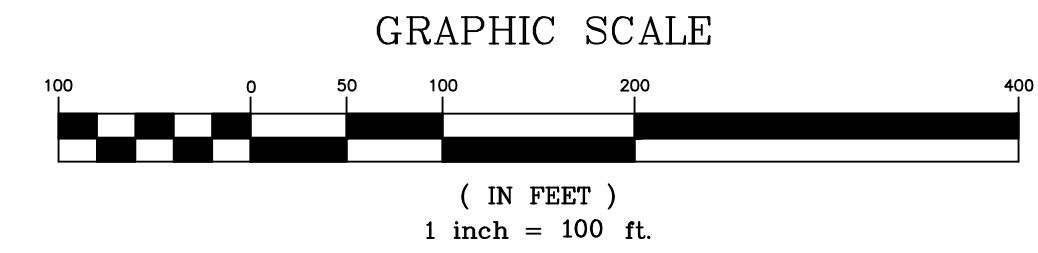

| NO. | DATE     | BY  | REVISIONS:               |
|-----|----------|-----|--------------------------|
| 1   | 11/04/08 | LIB | UPDATED SAMPLE LOCATIONS |
| 2   | 12/04/08 | LIB | UPDATED SAMPLE LOCATIONS |


|              |                  |
|--------------|------------------|
| PROJECT NO.  | 30809            |
| DRAWING NAME | 30809 SAMPLE.DWG |
| DRAWING NO.  | V4               |

SAMPLE LOCATIONS

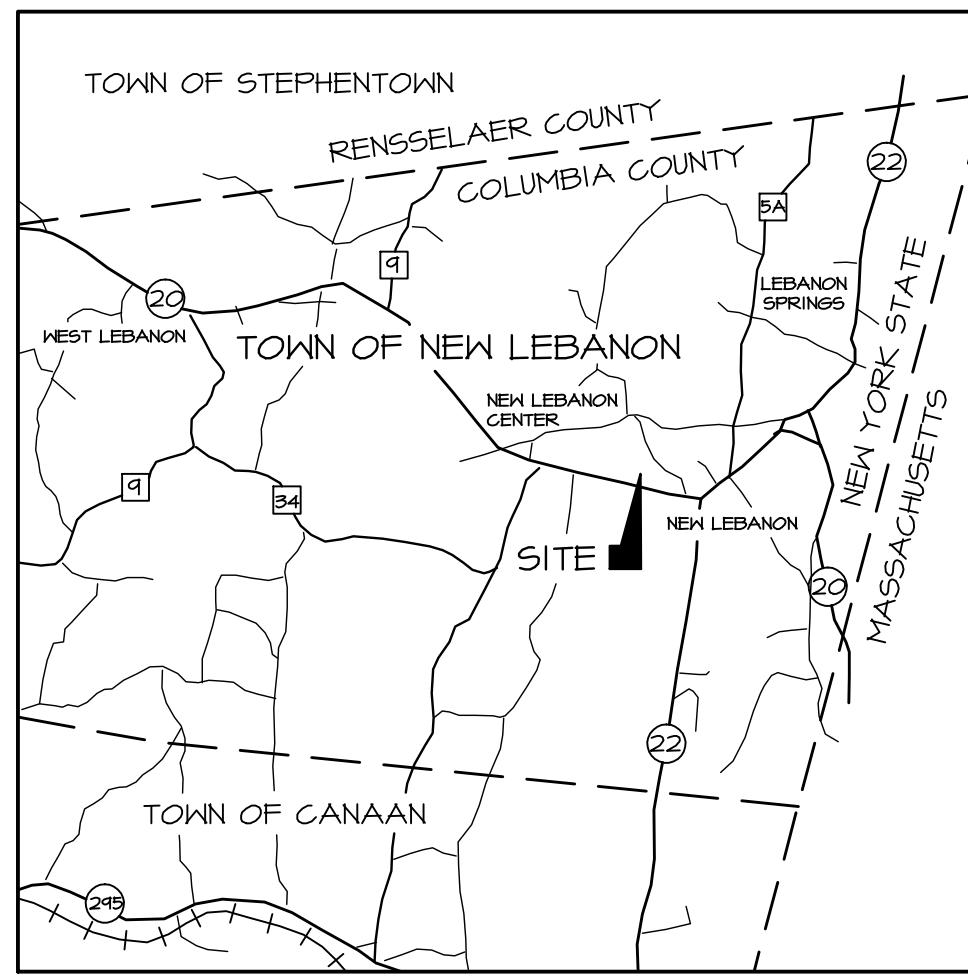

SITE LOCATION MAP  
NOT TO SCALE

© COPYRIGHT 2009 CLARK ENGINEERING & SURVEYING, P.C.  
"ALL RIGHTS RESERVED" AND "UNAUTHORIZED DUPLICATION  
IS A VIOLATION OF APPLICABLE LAWS."  
UNAUTHORIZED ALTERATIONS TO THIS DOCUMENT IS A VIOLATION OF  
SECTION 7209 SUBDIVISION 2 OF THE NEW YORK STATE EDUCATION LAW  
G:\Projects\30809\dwg\30809 BACKFILL.dwg  
March 20, 2009

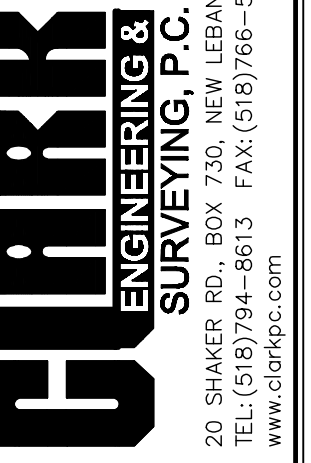

N.Y.S. DEPARTMENT OF ENVIRONMENTAL CONSERVATION  
REMIEDIATION SITE NO. 4-II-014  
FORMER BOUGHARD JUNKYARD  
NEW LEBANON, COLUMBIA COUNTY, NEW YORK




- NOTES:
- MAPPING PREPARED BY CLARK ENGINEERING & SURVEYING, P.C., FROM A FIELD SURVEY COMPLETED DECEMBER 16, 2008 AND UPDATED JANUARY 30, 2009.
  - NORTH REFERENCE USED HEREON IS GRID NORTH PER NEW YORK STATE PLANE COORDINATE SYSTEM EAST NAD83 (1996).
  - VERTICAL REFERENCE USED HEREON IS NAVD 88.
  - UNDERGROUND UTILITIES AS SHOWN HEREON ARE FROM FIELD LOCATION, THEIR LOCATIONS ARE APPROXIMATE, OTHERS MAY EXIST, AND ALL ARE SUBJECT TO VERIFICATION BY OTHERS.
  - PARCEL SURVEYED MAY BE ALONG WITH AND/OR SUBJECT TO RIGHTS, TITLE AND/OR INTERESTS IN AND TO LANDS WITHIN THE BED OF THE ADJACENT ROADS LYING BETWEEN THE HIGHWAY BOUNDARIES SHOWN HEREON AND THE CENTERLINES THEREOF.
  - PARCEL SURVEYED IS FURTHER REFERENCED TO THE TOWN OF NEW LEBANON TAX MAP PARCEL ID NO. 19,02-1-88.
  - PARCEL SURVEYED WITHOUT BENEFIT OF, AND IS SUBJECT TO A COMPLETE AND UP-TO-DATE ABSTRACT OF TITLE.

- MAP REFERENCES:
- "PROPERTY LINE SURVEY MAP PORTION OF THE LANDS OF RALPH W. CHITTENDEN", DATED NOVEMBER 4, 2001 AS PREPARED BY CLARK ENGINEERING AND SURVEYING P.C.
  - "NEW YORK STATE DEPARTMENT OF ENVIRONMENTAL CONSERVATION REMEDIAL CONSTRUCTION CONTRACT NO. D006282 FORMER BOUGHARD JUNKYARD NEW LEBANON, NEW YORK SOIL EXCAVATION AND OFF-SITE DISPOSAL SITE NO. 4-II-014," SHEETS 1-5, DATED JANUARY 2008 AS PREPARED BY DVIRKA AND BARTILUCCI.

Site Volume Table: Unadjusted

| Site           | Stratum  | Surf1 | Surf2    | cu.yds | cu.yds | cu.yds   | Net       | Method    |
|----------------|----------|-------|----------|--------|--------|----------|-----------|-----------|
|                |          |       |          | Cut    | Fill   |          |           |           |
| =====          |          |       |          |        |        |          |           |           |
| JUNKYARD TOTAL |          |       |          |        |        |          |           |           |
| backfill       | 01202009 | 30809 | 12012008 | bottom | 30809  | backfill | 01202009  |           |
|                |          |       |          |        | 11     | 30727    | 30716 (F) | Grid      |
|                |          |       |          |        | 12     | 30865    | 30853 (F) | Composite |
|                |          |       |          |        |        |          | 30785 (F) | AVERAGE   |
| WETLANDS       |          |       |          |        |        |          |           |           |
| backfill       | 01202009 | 30809 | 12012008 | bottom | 30809  | backfill | 01202009  |           |
|                |          |       |          |        | 0      | 1846     | 1846 (F)  | Grid      |
|                |          |       |          |        | 1      | 2002     | 2001 (F)  | Composite |
|                |          |       |          |        |        |          | 1924 (F)  | AVERAGE   |

GRAVEL: 7230 SQ. YD.  
ASPHALT: 499 SQ. FT.  
TOP SOIL: 16.96 ACRES

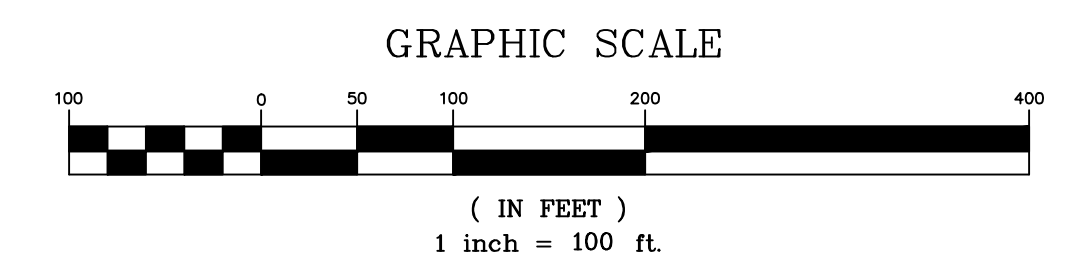


REVISIONS:

| NO. | DATE      | BY  | DESCRIPTION                                |
|-----|-----------|-----|--|
| 1   | 3/2/2009  | LIB | REVISED PER DVIRKA AND BARTILUCCI COMMENTS |
| 2   | 3/19/2009 | LIB | REVISED PER DVIRKA AND BARTILUCCI COMMENTS |

PROJECT NO.  
**30809**

DRAWING NAME  
**30809 BACKFILLING**

DRAWING NO.  
**V5**

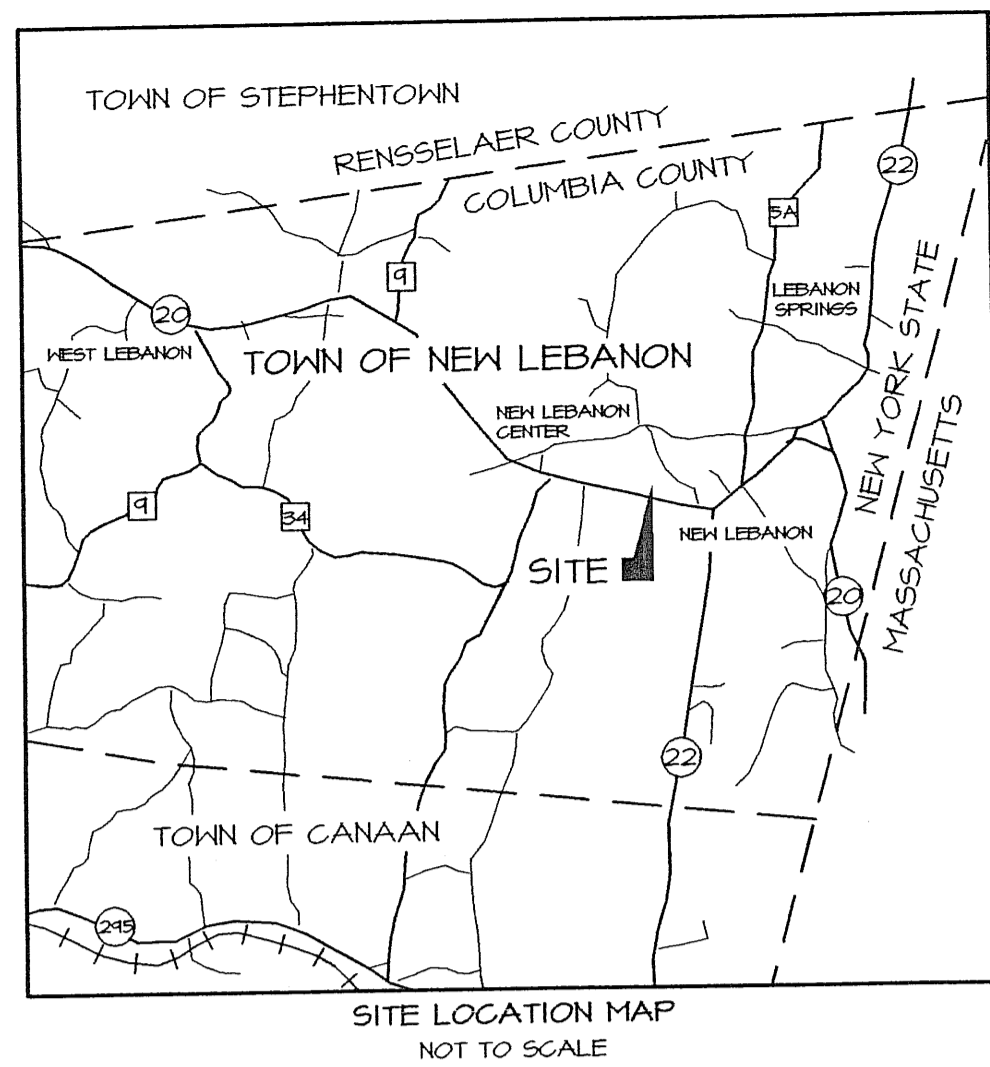

© COPYRIGHT 2009 CLARK ENGINEERING & SURVEYING, P.C.  
 ALL RIGHTS RESERVED AND UNAUTHORIZED DUPLICATION IS A VIOLATION OF APPLICABLE LAWS.  
 UNAUTHORIZED ALTERATIONS TO THIS DOCUMENT IS A VIOLATION OF SECTION 2209 SUBDIVISION 2 OF THE NEW YORK STATE EDUCATION LAW  
 G:\Projects\30809\dwg\30809 ASBULT.dwg  
 July 01, 2009

**CLARK**  
 ENGINEERING &  
 SURVEYING, P.C.  
 20 SHAKER RD., BOX 730, NEW LEBANON, NY 12125  
 TEL: (518) 794-8613 FAX: (518) 766-5663  
 www.clarkpc.com

N.Y.S. DEPARTMENT OF ENVIRONMENTAL CONSERVATION  
 REMEDIATION SITE NO. 4-11-014  
 FORMER BOUGHARD JUNKYARD  
 NEW LEBANON, COLUMBIA COUNTY, NEW YORK



- NOTES:
- MAPPING PREPARED BY CLARK ENGINEERING & SURVEYING, P.C., FROM A FIELD SURVEY COMPLETED DECEMBER 16, 2008 AND UPDATED JANUARY 30, 2009.
  - NORTH REFERENCE USED HEREON IS GRID NORTH PER NEW YORK STATE PLANE COORDINATE SYSTEM EAST NAD83 (1996).
  - VERTICAL REFERENCE USED HEREON IS NAVD 88.
  - UNDERGROUND UTILITIES AS SHOWN HEREON ARE FROM FIELD LOCATION, THEIR LOCATIONS ARE APPROXIMATE, OTHERS MAY EXIST, AND ALL ARE SUBJECT TO VERIFICATION BY OTHERS.
  - PARCEL SURVEYED MAY BE ALONG WITH AND/OR SUBJECT TO RIGHTS, TITLE AND/OR INTERESTS IN AND TO LANDS WITHIN THE BED OF THE ADJACENT ROADS LYING BETWEEN THE HIGHWAY BOUNDARIES SHOWN HEREON AND THE CENTERLINES THEREOF.
  - PARCEL SURVEYED IS FURTHER REFERENCED TO THE TOWN OF NEW LEBANON TAX MAP PARCEL ID NO. 19.02-1-88.
  - PARCEL SURVEYED WITHOUT BENEFIT OF, AND IS SUBJECT TO A COMPLETE AND UP-TO-DATE ABSTRACT OF TITLE.
  - LOCATION OF DEMARCATION MATERIAL AS SHOWN HEREON AS REPORTED BY D.A. COLLINS, LOCATION NOT SURVEYED IN FIELD.

- MAP REFERENCES:
- "PROPERTY LINE SURVEY MAP PORTION OF THE LANDS OF RALPH W. CHITTENDEN", DATED NOVEMBER 9, 2001 AS PREPARED BY CLARK ENGINEERING AND SURVEYING P.C.
  - "NEW YORK STATE DEPARTMENT OF ENVIRONMENTAL CONSERVATION REMEDIATION CONSTRUCTION CONTRACT NO. D006282 FORMER BOUGHARD JUNKYARD NEW LEBANON, NEW YORK SOIL EXCAVATION AND OFF-SITE DISPOSAL, SITE NO. 4-11-014," SHEETS 1-5, DATED JANUARY 2008 AS PREPARED BY DVIRKA AND BARTILUCCI.


Site Volume Table: Unadjusted

| Site           | Stratum  | Surf1    | Surf2 | cu.yds   | Cut    | cu.yds | Fill     | cu.yds   | Net       | cu.yds    | Method |
|----------------|----------|----------|-------|----------|--------|--------|----------|----------|-----------|-----------|--------|
| JUNKYARD TOTAL | backfill | 01202009 | 30809 | 12012008 | bottom | 30809  | backfill | 01202009 |           |           |        |
|                |          |          |       |          |        | 11     |          | 30727    | 30716 (F) | Grid      |        |
|                |          |          |       |          |        | 12     |          | 30865    | 30853 (F) | Composite |        |
|                |          |          |       |          |        |        |          |          | 30785 (F) | AVERAGE   |        |
| WETLANDS       | backfill | 01202009 | 30809 | 12012008 | bottom | 30809  | backfill | 01202009 |           |           |        |
|                |          |          |       |          |        | 0      |          | 1846     | 1846 (F)  | Grid      |        |
|                |          |          |       |          |        | 1      |          | 2002     | 2001 (F)  | Composite |        |
|                |          |          |       |          |        |        |          |          | 1924 (F)  | AVERAGE   |        |

GRAVEL: 7230 SQ. YD.  
 ASPHALT: 499 SQ. FT.  
 TOP SOIL: 16.96 ACRES

GRAVEL ROAD (PAY ITEM)  
 CONSTRUCTION ROAD LEFT IN PLACE, AS PER OWNER


Note that NYSDEC has added the mark-up in red to highlight the areas where a demarcation layer was placed prior to backfilling the excavations.

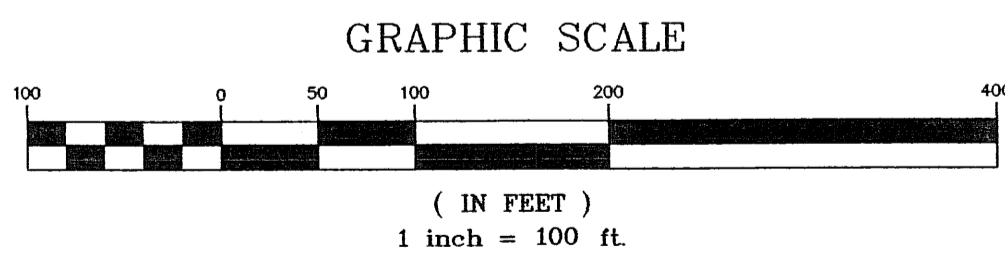


*E.A. Bartilucci*

| SCALE     | DATE      | BY  | REVISIONS |
|-----------|-----------|-----|-----------|
| 1" = 100' | 1/20/2009 | LIB | 1         |
|           | 1/20/2009 | LIB | 2         |
|           | 1/20/2009 | LIB | 3         |
|           | 1/20/2009 | LIB | 4         |
|           | 1/20/2009 | LIB | 5         |
|           | 1/20/2009 | LIB | 6         |
|           | 1/20/2009 | LIB | 7         |
|           | 1/20/2009 | LIB | 8         |
|           | 1/20/2009 | LIB | 9         |
|           | 1/20/2009 | LIB | 10        |
|           | 1/20/2009 | LIB | 11        |
PROJECT NO. 30809  
 DRAWING NAME 30809 ASBULT.DWG  
 DRAWING NO. V6

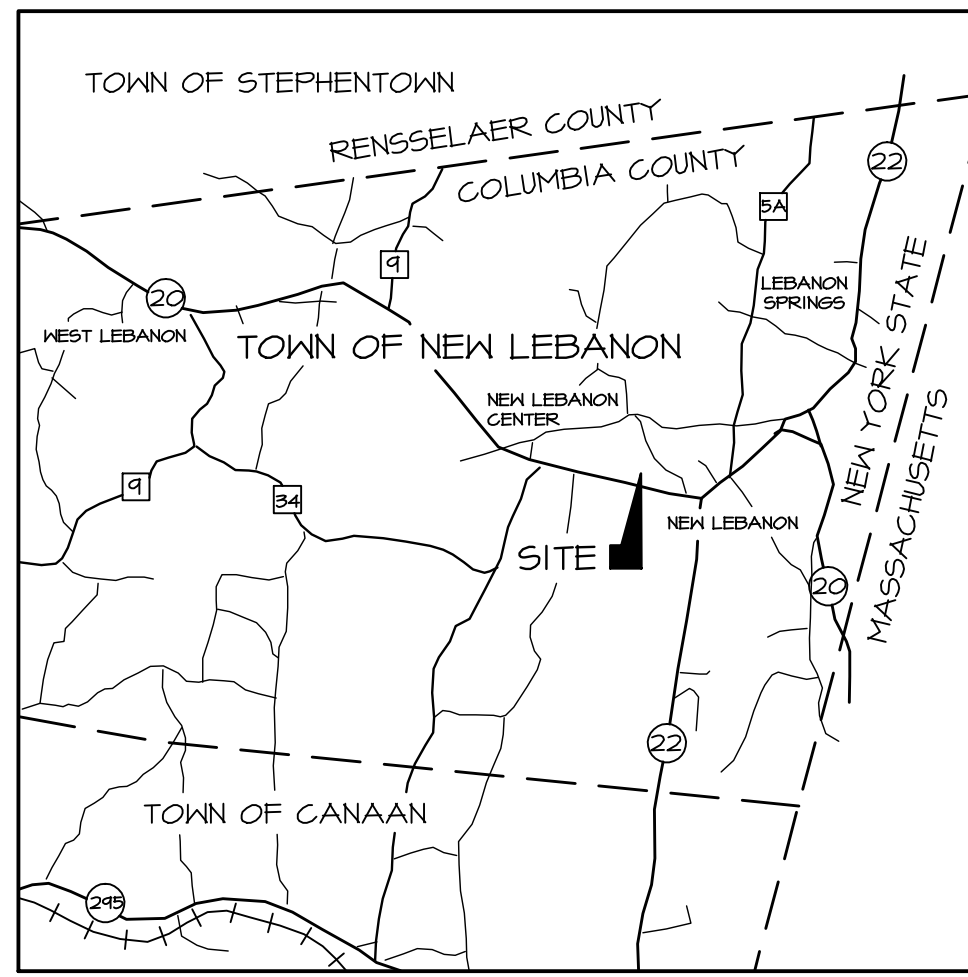

SITE LOCATION MAP  
NOT TO SCALE

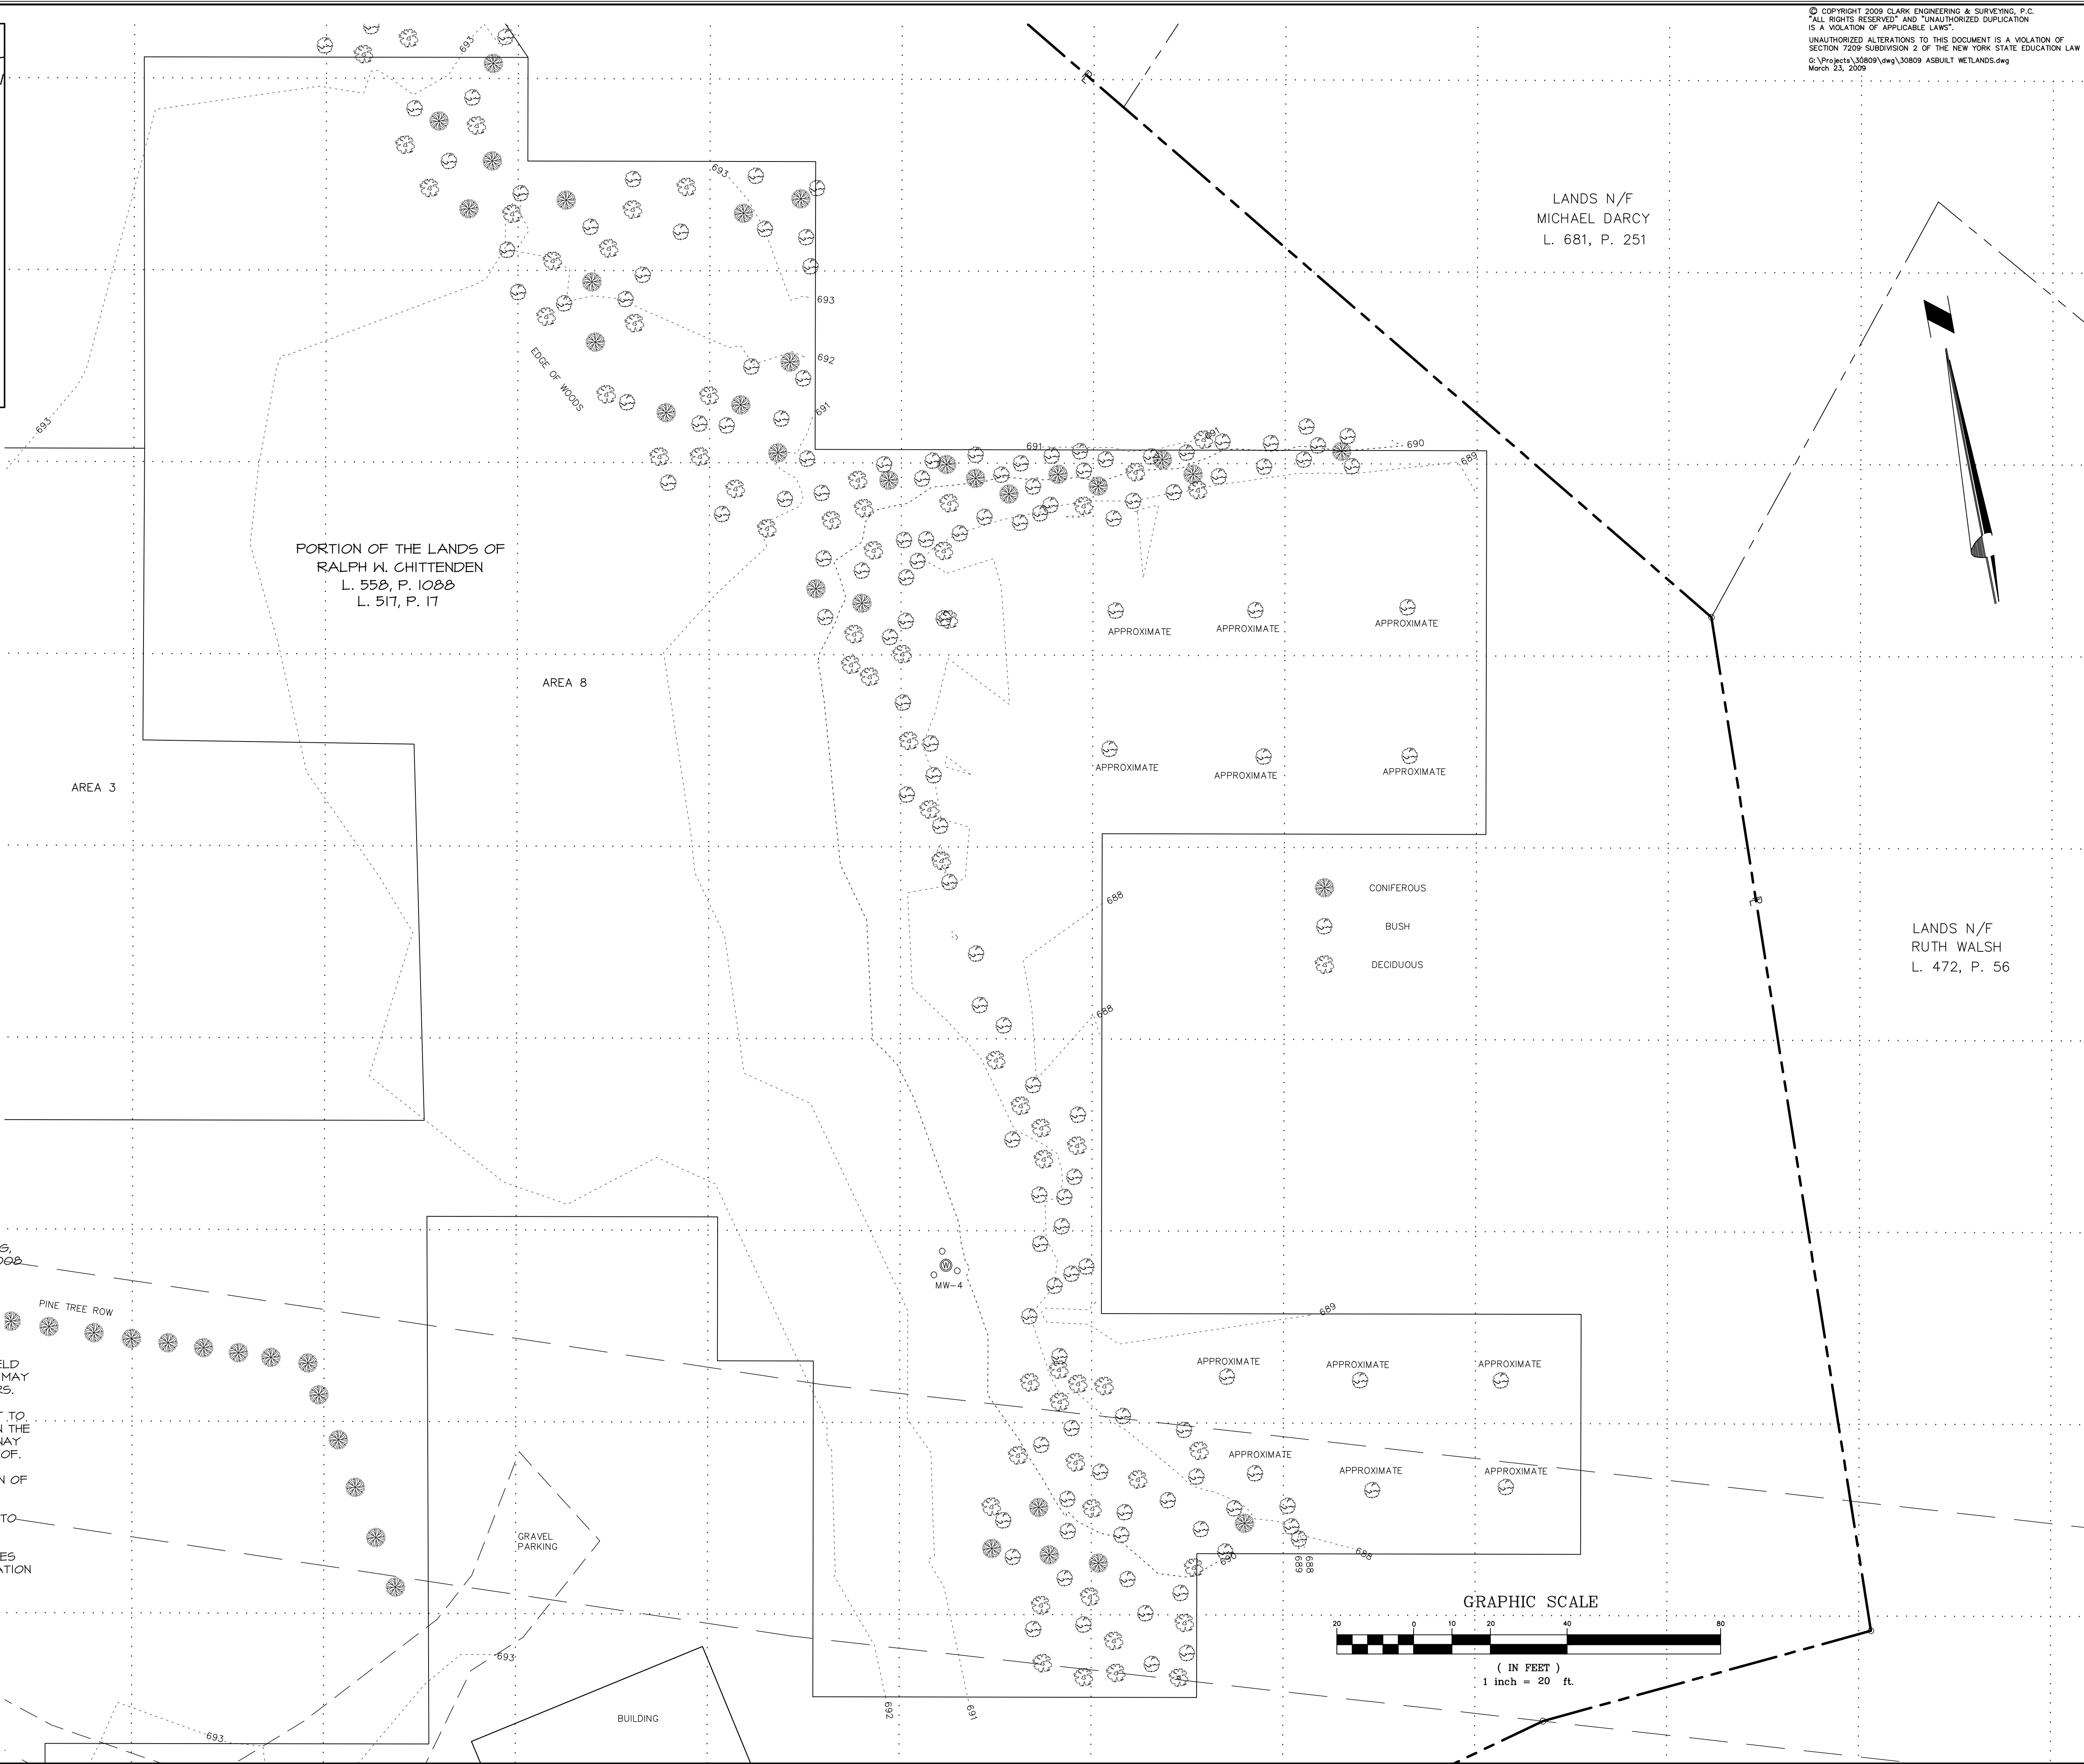

© COPYRIGHT 2009 CLARK ENGINEERING & SURVEYING, P.C.  
 "ALL RIGHTS RESERVED" AND "UNAUTHORIZED DUPLICATION  
 IS A VIOLATION OF APPLICABLE LAWS".  
 UNAUTHORIZED ALTERATIONS TO THIS DOCUMENT IS A VIOLATION OF  
 SECTION 7209 SUBDIVISION 2 OF THE NEW YORK STATE EDUCATION LAW  
 G:\Projects\30809\dwg\30809 ASSULT WETLANDS.dwg  
 March 23, 2009

**CLARK**  
 ENGINEERING &  
 SURVEYING, P.C.  
 20 SHAKER RD., BOX 730, NEW LEBANON, NY 12125  
 TEL: (518)794-8613 FAX: (518)766-5663  
 www.clarkpc.com

N.Y.S. DEPARTMENT OF ENVIRONMENTAL CONSERVATION  
 REMEDIATION SITE NO. 4-II-014  
 FORMER BOUGHARD JUNKYARD  
 NEW LEBANON, COLUMBIA COUNTY, NEW YORK

- NOTES:
- MAPPING PREPARED BY CLARK ENGINEERING & SURVEYING, P.C., FROM A FIELD SURVEY COMPLETED DECEMBER 16, 2008 AND UPDATED JANUARY 30, 2009.
  - NORTH REFERENCE USED HEREON IS GRID NORTH PER NEW YORK STATE PLANE COORDINATE SYSTEM EAST(NAD83).
  - VERTICAL REFERENCE USED HEREON IS NAVD 88.
  - UNDERGROUND UTILITIES AS SHOWN HEREON ARE FROM FIELD LOCATION, THEIR LOCATIONS ARE APPROXIMATE, OTHERS MAY EXIST, AND ALL ARE SUBJECT TO VERIFICATION BY OTHERS.
  - PARCEL SURVEYED MAY BE ALONG WITH AND/OR SUBJECT TO RIGHTS, TITLE AND/OR INTERESTS IN AND TO LANDS WITHIN THE BED OF THE ADJACENT ROADS LYING BETWEEN THE HIGHWAY BOUNDARIES SHOWN HEREON AND THE CENTERLINES THEREOF.
  - PARCEL SURVEYED IS FURTHER REFERENCED TO THE TOWN OF NEW LEBANON TAX MAP PARCEL ID NO. 14.02-1-28.
  - PARCEL SURVEYED WITHOUT BENEFIT OF, AND IS SUBJECT TO A COMPLETE AND UP-TO-DATE ABSTRACT OF TITLE.
  - SPECIES AND FREQUENCY OF WETLAND PLANTS AND BUSHES ARE REPORTED IN D.A. COLLINS FINAL WETLAND RESTORATION REPORT 02488-003-A DATED DECEMBER 22, 2008.
- MAP REFERENCES:
- "PROPERTY LINE SURVEY MAP PORTION OF THE LANDS OF RALPH W. CHITTENDEN", DATED NOVEMBER 9, 2001 AS PREPARED BY CLARK ENGINEERING AND SURVEYING P.C.
  - "NEW YORK STATE DEPARTMENT OF ENVIRONMENTAL CONSERVATION REMEDIAL CONSTRUCTION CONTRACT NO. D006282 FORMER BOUGHARD JUNKYARD NEW LEBANON, NEW YORK SOIL EXCAVATION AND OFF-SITE DISPOSAL SITE NO. 4-II-014," SHEETS 1-5, DATED JANUARY 2008 AS PREPARED BY DVIRKA AND BARTILUCCI.

| NO. | BY | DATE     | REVISIONS:                                   |
|-----|----|----------|--|
| 1   | LB | 12/16/04 | 1 REVISED PAGE NUMBER                        |
| 2   | LB | 12/20/04 | 2 REVISED PER DVIRKA AND BARTILUCCI COMMENTS |
| 3   | LB | 12/23/04 | 3 REVISED PER DVIRKA AND BARTILUCCI COMMENTS |

SCALE: 1" = 20'  
 DATE: 1/29/2009  
 DRAWN BY: LB  
 CHECKED BY: EDC  
 APPROVED BY: EDC

PROJECT NO. 30804  
 DRAWING NAME 30804 ASSULT WETLANDS.DWG  
 DRAWING NO. 17

AS-BUILT  
 TOPOGRAPHIC SURVEY

March 25, 2009

D.A. Collins  
101 Route 67, P.O. Box 191  
Mechanicville, New York 12188


Re: Sample Location Survey Certification

**To Whom It May Concern:**

The sampling points contained in this report were surveyed in the field between the months of May and December in 2008 by Clark Engineering & Surveying.

The coordinates and elevations as reported herein were derived from the field survey data collected.

Respectfully,

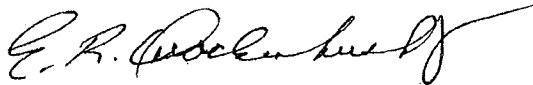


Everett R. Quackenbush, Jr. PLS  
Clark Engineering & Surveying P.C.

Enclosure

File: G:\Projects\30809\Documents\30809 Sample Cert. Letter.docx



20 Shaker Road - P.O. Box 730, New Lebanon, N.Y. 12125  
P: (518) 794-8613 F: (518) 766-5663 www.clarkpc.com

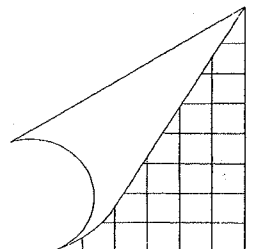

ENDPOINT SAMPLES

| Sample # | SAMPLE ID           | SAMPLED   | NORTHING (ft) | EASTING (ft) | Elevation (ft) |
|----------|---------------------|-----------|---------------|--------------|----------------|
| 1        | EP-I1               | 5/21/2008 | 1324929.0     | 787786.2     | 690.5          |
| 2        | EP-I2               | 5/21/2008 | 1324965.7     | 797795.6     | 690.9          |
|          | EP-I2 (MS/MSD/MSB)  | 5/21/2008 |               |              |                |
| 3        |                     | 5/21/2008 | 1325009.8     | 787809.6     | 691.2          |
|          | EP-Dup-1 (EP-I3)    | 5/21/2008 |               |              |                |
| 4        |                     | 5/21/2008 | 1325063.5     | 787803.7     | 690.9          |
| 5        | EP-G2               | 5/23/2008 | 1324971.2     | 787697.3     | 690.4          |
| 6        | EP-H2               | 5/23/2008 | 1324971.2     | 787756.7     | 690.2          |
| 7        | EP-H3               | 5/23/2008 | 1325017.4     | 787766.3     | 690.4          |
| 8        | EP-H4               | 5/23/2008 | 1325063.3     | 787773.9     | 690.4          |
| 9        | EP-H5               | 5/23/2008 | 1325114.9     | 787771.7     | 691.1          |
| 10       | EP-H6               | 5/23/2008 | 1325174.8     | 787784.2     | 691.5          |
| 11       | EP-I5               | 5/23/2008 | 1325114.5     | 787814.6     | 691.7          |
| 12       | EP-I6               | 5/23/2008 | 1325162.6     | 787826.5     | 692.0          |
| 13       | EP-J5               | 5/23/2008 | 1325096.7     | 787881.8     | 691.5          |
| 14       | EP-J6               | 5/23/2008 | 1325138.8     | 787886.1     | 691.7          |
| 15       | EP-I3A (1)          | 5/27/2008 | 1324995.0     | 787817.0     | 691.1          |
| 16       |                     | 5/27/2008 | 1325003.9     | 787787.5     | 690.7          |
| 17       | EP-I3A (3)          | 5/27/2008 | 1325031.0     | 787790.1     | 690.7          |
| 18       | EP-I3A (4)          | 5/27/2008 | 1325029.2     | 787818.5     | 691.2          |
| 19       |                     | 5/27/2008 | 1325049.1     | 787794.4     | 690.7          |
| 20       | EP-I4A (2)          | 5/27/2008 | 1325045.9     | 787816.2     | 691.0          |
| 21       | EP-I4A (3)          | 5/27/2008 | 1325073.2     | 787801.3     | 690.8          |
| 22       | EP-I4A (4)          | 5/27/2008 | 1325074.4     | 787816.3     | 691.2          |
| 23       | EP-F2               | 5/27/2008 | 1324995.2     | 787651.4     | 689.9          |
| 24       | EP-F3               | 5/28/2008 | 1325047.3     | 787664.0     | 690.5          |
| 25       | EP-F4               | 5/28/2008 | 1325085.8     | 787671.8     | 691.1          |
|          | EP-Dup-2 (EP-F4)    | 5/28/2008 |               |              |                |
| 26       | EP-G3               | 5/28/2008 | 1325033.7     | 787712.9     | 689.8          |
|          | EP-G3 (MS/MSD/MSB)  | 5/28/2008 |               |              |                |
| 27       | EP-G4               | 5/28/2008 | 1325074.7     | 787720.6     | 690.4          |
| 28       | EP-F5               | 5/29/2008 | 1325126.1     | 787687.5     | 691.8          |
| 29       | EP-G5               | 5/29/2008 | 1325133.5     | 787731.5     | 691.6          |
| 30       | EP-G6               | 5/29/2008 | 1325167.5     | 787730.0     | 692.3          |
| 31       | EP-F6               | 5/30/2008 | 1325179.3     | 787695.1     | 692.4          |
| 32       | EP-G7               | 5/30/2008 | 1325223.7     | 787750.3     | 692.3          |
| 33       | EP-H7               | 5/30/2008 | 1325402.0     | 787699.0     | 692.3          |
| 34       |                     | 5/30/2008 | 1325206.7     | 787838.3     | 692.3          |
| 35       | EP-I3B              | 5/30/2008 | 1325009.6     | 787801.9     | 690.5          |
| 36       | EP-I4B              | 5/30/2008 | 1325048.7     | 787805.2     | 690.2          |
| 37       | EP-I7A(1)           | 6/2/2008  | 1325207.6     | 787829.6     | 692.1          |
| 38       | EP-I7A(2)           | 6/2/2008  | 1325190.3     | 787826.2     | 692.0          |
| 39       | EP-F7               | 6/2/2008  | 1325234.0     | 787704.8     | 693.4          |
| 40       | EP-G8               | 6/2/2008  | 1325271.9     | 787754.2     | 693.6          |
| 41       |                     | 6/2/2008  | 1325258.2     | 787792.1     | 693.4          |
| 42       | EP-E10              | 6/6/2008  | 1325402.0     | 787699.0     | 695.5          |
|          | EP-DUP-3 (E10)      | 6/6/2008  |               |              |                |
| 43       | EP-E11              | 6/8/2008  | 1325445.0     | 787703.1     | 696.3          |
|          | EP-E11 (MS/MSD/MSB) | 6/8/2008  |               |              |                |
| 44       | EP-E12              | 6/6/2008  | 1325479.3     | 787706.8     | 697.3          |
| 45       | EP-F10              | 6/6/2008  | 1325394.6     | 787731.3     | 694.8          |
| 46       | EP-F11              | 6/6/2008  | 1325423.7     | 787730.7     | 695.8          |
| 47       | EP-F12              | 6/6/2008  | 1325474.5     | 787735.9     | 696.9          |
| 48       | EP-G10              | 6/6/2008  | 1325388.6     | 787771.7     | 695.1          |
| 49       | EP-G11              | 6/6/2008  | 1325431.1     | 787772.5     | 695.8          |
| 50       | EP-G12              | 6/6/2008  | 1325463.2     | 787778.9     | 696.0          |
| 51       | EP-H7(2)            | 6/6/2008  | 1325236.4     | 787781.8     | 688.6          |
| 52       | EP-H7SW(W)          | 6/6/2008  | 1325236.3     | 787773.7     | 689.9          |
| 53       | EP-H7SW(S)          | 6/6/2008  | 1325222.5     | 787780.0     | 690.0          |
|          | Rissate-01 (auger)  | 6/6/2008  |               |              |                |
| 54       | EP-H8A              | 6/6/2008  | 1325275.1     | 787794.3     | 688.8          |
| 55       | EP-H8SW(N)          | 6/6/2008  | 1325292.3     | 787798.8     | 691.2          |
| 56       | EP-H8SW(W)          | 6/6/2008  | 1325274.9     | 787784.2     |                |
| 57       | EP-G15              | 6/10/2008 | 1325622.0     | 787806.6     | 696.8          |
| 58       | EP-F16              | 6/10/2008 | 1325673.7     | 787797.5     | 698.0          |
| 59       | EP-F17              | 6/10/2008 | 1325723.1     | 787796.4     | 698.8          |
| 60       | EP-F18              | 6/10/2008 | 1325777.2     | 787799.0     | 699.3          |
| 61       | EP-F19              | 6/10/2008 | 1325809.9     | 787795.6     | 699.3          |
| 62       | EP-F22              | 6/10/2008 | 1325969.0     | 787823.7     | 703.0          |
| 63       | EP-E19              | 6/10/2008 | 1325831.8     | 787783.6     | 700.4          |
| 64       | EP-E20              | 6/10/2008 | 1325868.5     | 787785.1     | 701.5          |
| 65       | EP-E21              | 6/10/2008 | 1325939.5     | 787780.7     | 702.6          |
| 66       | EP-G9               | 6/10/2008 | 1325330.0     | 787753.9     | 695.3          |
| 67       | EP-H9               | 6/10/2008 | 1325317.0     | 787813.4     | 694.6          |
| 68       | EP-H10              | 6/10/2008 | 1325374.2     | 787815.6     | 695.2          |
|          | Rissate-02 (auger)  | 6/10/2008 |               |              |                |
| 69       | EP-H22              | 6/11/2008 | 1325952.4     | 787933.8     | 703.0          |
| 70       | EP-G22              | 6/11/2008 | 1325968.5     | 787892.4     | 703.3          |
| 71       | EP-L20              | 6/12/2008 | 1325800.6     | 788091.8     | 698.4          |
| 72       | EP-J21              | 6/12/2008 | 1325867.7     | 788003.9     | 701.6          |
| 73       | EP-M16              | 6/12/2008 | 1325612.9     | 788145.2     | 693.8          |
| 74       | EP-I21              | 6/12/2008 | 1325893.2     | 787973.3     | 701.6          |
| 75       | EP-L19              | 6/12/2008 | 1325764.7     | 788109.8     | 697.7          |
|          | EP-L19 (MS/MSD/MSB) | 6/12/2008 |               |              |                |
| 76       | EP-K20              | 6/12/2008 | 1325815.5     | 788065.3     | 698.9          |
| 77       | EP-M17              | 6/12/2008 | 1325658.9     | 788139.5     | 695.1          |
| 78       | EP-I20              | 6/12/2008 | 1325849.4     | 788012.8     | 699.4          |
| 79       | EP-M18              | 6/12/2008 | 1325701.3     | 788134.1     | 695.8          |
|          | EP-DUP-04 (EP-I21)  | 6/12/2008 |               |              |                |
| 80       | EP-N16              | 6/13/2008 | 1325594.6     | 788159.2     | 693.1          |
| 81       | EP-N13              | 6/13/2008 | 1325463.1     | 788171.3     | 691.2          |
| 82       | EP-N15              | 6/13/2008 | 1325555.4     | 788164.2     | 692.3          |
| 83       | EP-I20              | 6/13/2008 | 1325863.5     | 787988.0     | 700.5          |
| 84       |                     | 6/13/2008 | 1325907.5     | 787960.2     | 702.1          |
| 85       | EP-I22              | 6/13/2008 | 1325824.7     | 787964.2     | 702.6          |
| 86       | EP-K19              | 6/13/2008 | 1325791.6     | 788082.6     | 698.3          |
| 87       | EP-L18              | 6/13/2008 | 1325726.0     | 788118.9     | 696.5          |
| 88       | EP-O13              | 6/13/2008 | 1325452.0     | 788165.6     | 691.0          |
| 89       | EP-O14              | 6/13/2008 | 1325486.2     | 788183.0     | 691.4          |
| 90       | EP-N14              | 6/13/2008 | 1325499.5     | 788175.4     | 691.7          |

## ENDPOINT SAMPLES

|     |                          |           |            |           |        |
|-----|--------------------------|-----------|------------|-----------|--------|
| 91  | EP-M19                   | 6/13/2008 | 1325739.3  | 788129.5  | 696.8  |
|     | Rinsate-03 (auger)       | 6/13/2008 |            |           |        |
| 93  | EP-Q12                   | 6/17/2008 | 1325401.4  | 788190.5  | 690.5  |
| 94  | EP-P12                   | 6/17/2008 | 1325372.5  | 788228.1  | 690.4  |
| 95  | EP-Q12                   | 6/17/2008 | 1325358.1  | 788262.1  | 689.9  |
| 96  | EP-Q11                   | 6/17/2008 | 1325326.3  | 788268.3  | 690.0  |
| 97  | EP-Q10                   | 6/17/2008 | 1325281.2  | 788271.6  | 690.1  |
| 98  | EP-Q9                    | 6/17/2008 | 1325232.8  | 788247.7  | 690.4  |
| 99  | EP-M9                    | 6/17/2008 | 1325282.0  | 788068.6  | 691.6  |
|     | EP-M9(MS/MSD/MSB)        | 6/17/2008 |            |           |        |
| 100 | EP-N9                    | 6/17/2008 | 1325266.8  | 788107.2  | 691.7  |
|     | EP-DUP-05 (EP-N9)        | 6/17/2008 |            |           |        |
| 101 | EP-P9                    | 6/17/2008 | 1325235.1  | 788198.2  | 690.1  |
| 102 | EPO9                     | 6/17/2008 | 1325248.1  | 788158.4  | 691.5  |
| 103 | EP-P11                   | 6/17/2008 | 1325349.7  | 788244.7  | 689.7  |
| 104 | EP-H21(1)                | 6/17/2008 | 1325916.0  | 787951.1  | 701.6  |
| 105 | EP-E22                   | 6/17/2008 | 1325959.5  | 787778.4  | 703.1  |
| 106 | EP-PSW-01                | 6/17/2008 | 1325603.5  | 787793.6  | 697.2  |
| 107 | EP-PSW-02                | 6/17/2008 | 1325703.2  | 787786.3  | 699.4  |
| 108 | EP-BSW-03                | 6/17/2008 | 1325802.8  | 787780.7  | 700.2  |
| 109 | EP-PSW-04                | 6/17/2008 | 1325901.5  | 787775.7  | 701.8  |
|     | Rinsate-04 (auger)       | 6/17/2008 |            |           |        |
| 110 | EP-H11                   | 6/18/2008 | 1325413.6  | 787827.6  | 695.4  |
| 111 | EP-K10                   | 6/18/2008 | 1325324.9  | 797959.9  | 682.4  |
| 112 | EP-M10                   | 6/18/2008 | 1325298.7  | 788043.1  | 682.6  |
| 113 | EP-L9                    | 6/18/2008 | 1325291.5  | 788027.4  | 682.6  |
| 114 | EP-L10                   | 6/18/2008 | 1325308.3  | 788016.1  | 682.4  |
| 115 | EP-J10                   | 6/18/2008 | 1325340.7  | 787920.0  | 693.0  |
| 116 | EP-I10                   | 6/18/2008 | 1325356.4  | 787876.7  | 693.6  |
| 117 | EP-K9                    | 6/18/2008 | 1325306.0  | 787989.6  | 692.3  |
|     | EP-Q9A                   | 6/24/08   | 1325233.8  | 788249.1  | 689.7  |
| 118 | EP-D23                   | 6/25/08   | 1326027.10 | 787771.60 | 703.80 |
|     | EP-DUP-06 (EP-D23)       | 6/25/08   |            |           |        |
|     | EP-D23 (MS/MSD/MSB)      | 6/25/08   |            |           |        |
| 120 | EP-D24                   | 6/25/08   | 1326076.7  | 787770.7  | 704.6  |
| 121 | EP-E23                   | 6/25/08   | 1326028.4  | 787792.3  | 703.7  |
| 122 | EP-E24                   | 6/25/08   | 1326072.2  | 787795.9  | 704.4  |
| 123 | EP-G26                   | 6/25/08   | 1326154.6  | 787942.4  | 710.2  |
| 124 | EP-H26                   | 6/25/08   | 1326141.10 | 787974.90 | 712.20 |
| 125 | EP-PSW-05                | 6/25/08   | 1326001.9  | 787770.9  | 704.0  |
| 126 | EP-PSW-06                | 6/25/08   | 1326091.2  | 787770.9  | 705.3  |
|     | Rinsate-05 (auger)       | 6/25/08   |            |           |        |
| 124 | EP-H24                   | 6/26/08   | 1326069.20 | 787964.00 | 705.90 |
|     | EP-H24 (MS/MSD/MSB)      | 6/26/08   |            |           |        |
| 125 | EP-H25                   | 6/26/08   | 1326098.1  | 787974.0  | 707.8  |
| 126 | EP-I24                   | 6/26/08   | 1326051.4  | 788002.3  | 706.2  |
| 127 | EP-I25                   | 6/26/08   | 1326073.8  | 788002.3  | 707.1  |
| 128 | EP-G24                   | 6/26/08   | 1326057.6  | 787899.0  | 705.3  |
| 129 | EP-G25                   | 6/26/08   | 1326113.9  | 787937.6  | 708.5  |
|     | EP-DUP-07 (EP-G25)       | 6/26/08   |            |           |        |
| 130 | EP-G25 (tree)            | 6/26/08   | 1326134.3  | 787942.6  | 710.1  |
| 131 |                          | 6/26/08   | 1326084.9  | 787863.6  | 704.8  |
|     |                          | 6/26/08   | 1326072.6  | 787872.0  | 705.1  |
| 133 |                          | 6/26/08   | 1326119.9  | 787924.3  | 708.6  |
| 134 | EP-PSW-09                | 6/26/08   | 1326140.7  | 787984.6  | 710.8  |
| 135 | EP-PSW-10                | 6/26/08   | 1326060.0  | 788010.3  | 707.1  |
|     | SS-Smith-0608            | 6/26/2008 |            | PCBs      |        |
| 136 | EP-F21                   | 6/27/08   | 1325909.4  | 787823.8  | 701.8  |
| 137 | EP-H19                   | 6/27/08   | 1325813.2  | 787920.0  | 699.0  |
| 138 | EP-H20                   | 6/27/08   | 1325864.5  | 787915.9  | 700.5  |
| 139 | EP-I19                   | 6/27/08   | 1325809.8  | 787950.2  | 698.7  |
| 140 | EP-J23                   | 6/27/08   | 1326009.3  | 787992.3  | 704.6  |
|     | Rinsate-06 (auger)       | 6/27/08   |            |           |        |
| 141 | EP-G19-T2                | 6/30/08   | 1325824.8  | 787881.0  | 699.7  |
|     | EP-DUP-08 (EP-G19-T2)    | 6/30/08   |            |           |        |
|     | EP-G19-T2 (MS/MSD/MSB)   | 6/30/08   |            |           |        |
| 142 | EP-G20-T2                | 6/30/08   | 1325848.1  | 787884.4  | 700.2  |
| 143 | EP-H19-T2                | 6/30/08   | 1325824.0  | 787903.7  | 699.5  |
| 144 | EP-H20-T1                | 6/30/08   | 1325863.7  | 787934.4  | 701.0  |
| 145 |                          | 6/30/08   | 1325844.3  | 787907.8  | 700.2  |
| 146 | EP-H21-T1                | 6/30/08   | 1325886.0  | 787939.1  | 701.4  |
| 147 | EP-I20-T1                | 6/30/08   | 1325855.6  | 787955.6  | 700.3  |
| 148 | EP-F24 (1)               | 7/1/08    | 1326048.0  | 787875.0  | 704.5  |
| 149 | EP-F24 (2)               | 7/1/08    | 1326065.8  | 787876.1  | 704.8  |
| 150 | EP-F24 (3)               | 7/1/08    | 1326070.6  | 787843.7  | 704.6  |
| 151 | EP-F24 (4)               | 7/1/08    | 1326056.1  | 787841.5  | 704.5  |
| 152 | EP-F23                   | 7/1/08    | 1326020.0  | 787854.2  | 704.0  |
| 153 | EP-F20                   | 7/1/08    | 1325875.3  | 787814.2  | 701.0  |
| 154 | EP-G23                   | 7/1/08    | 1326012.3  | 787895.9  | 704.3  |
| 155 | EP-G21                   | 7/1/08    | 1325912.3  | 787885.2  | 702.7  |
| 156 | EP-G20 N.TSCA            | 7/1/08    | 1325876.7  | 787884.5  | 701.2  |
| 157 |                          | 7/1/08    | 1325766.2  | 787912.1  | 697.4  |
| 158 | EP-I18                   | 7/1/08    | 1325752.6  | 787945.9  | 697.9  |
| 159 | EP-I17                   | 7/1/08    | 1325706.0  | 787949.0  | 696.9  |
|     | EP-PSW-07 (A)            | 7/1/08    | 1326072.6  | 787872.0  | 705.1  |
|     | EP-PSW-08 (A)            | 7/1/08    | 1326119.9  | 787924.3  | 708.6  |
| 160 |                          | 7/2/08    | 1326077.4  | 787872.0  | 704.9  |
| 161 |                          | 7/2/08    | 1326126.7  | 787920.8  | 709.1  |
| 162 | EP-H20-T2(A)             | 7/3/08    | 1325844.3  | 787907.8  | 700.2  |
| 163 | EP-J17                   | 7/3/08    | 1325696.5  | 787984.2  | 696.0  |
|     | EP-DUP-09 (EP-J17)       | 7/3/08    |            |           |        |
| 164 | EP-J18(12")              | 7/3/08    | 1325734.4  | 787993.7  | 696.6  |
|     | EP-J18(12") (MS/MSD/MSB) | 7/3/08    |            |           |        |
| 165 | EP-J18(18")              | 7/3/08    | 1325729.8  | 788010.8  | 695.7  |
| 166 | EP-J/K18(overdig)        | 7/3/08    | 1325742.9  | 788022.4  | 694.9  |
| 167 | EP-K18                   | 7/3/08    | 1325727.2  | 788038.6  | 695.8  |
|     | Rinsate-07 (auger)       | 7/3/08    |            |           |        |
| 168 |                          | 7/3/08    | 1326097.2  | 787822.9  | 706.4  |
| 169 |                          | 7/3/08    | 1326098.0  | 787846.2  | 703.4  |
| 170 | Patell-03                | 7/3/08    | 1326098.9  | 787871.4  | 706.8  |
| 171 | Patell-04                | 7/3/08    | 1326098.0  | 787893.6  | 707.5  |
| 172 |                          | 7/3/08    | 1326101.0  | 787907.2  | 707.9  |
| 173 |                          | 7/3/08    | 1326129.3  | 787912.1  | 709.3  |
| 174 | Patell-07                | 7/3/08    | 1326154.7  | 787919.6  | 710.3  |

ENDPOINT SAMPLES

|     |                          |         |            |           |        |
|-----|--------------------------|---------|------------|-----------|--------|
| 175 | Patell-08                | 7/3/08  | 1326177.0  | 787932.2  | 713.3  |
| 176 |                          | 7/3/08  | 1326123.8  | 787835.8  | 706.9  |
| 177 | Patell-10                | 7/3/08  | 1326118.9  | 7878612.0 | 707.4  |
| 178 |                          | 7/3/08  | 1326117.6  | 787885.4  | 707.7  |
| 179 |                          | 7/3/08  | 1326135.6  | 787890.7  | 709.1  |
| 180 | Patell-13                | 7/3/08  | 1326163.1  | 787904.4  | 710.0  |
| 181 |                          | 7/3/08  | 1326147.0  | 787870.2  | 709.4  |
| 182 | Patell-15                | 7/7/08  | 1326167.9  | 787951.2  | 713.0  |
| 183 | Patell-16                | 7/7/08  | 1326197.3  | 787937.2  | 715.3  |
| 184 |                          | 7/7/08  | 1325826.8  | 787847.2  | 698.9  |
| 185 | EP-H23                   | 7/7/08  | 1325995.50 | 787951.90 | 703.70 |
|     | EP-H23 (MS/MSD/MSB)      | 7/7/08  |            |           |        |
| 186 | EP-PSW11                 | 7/7/08  | 1325960.60 | 787994.80 | 703.50 |
|     | Rmsate-08 (auger)        | 7/9/08  |            |           |        |
| 187 | EP-G18                   | 7/9/08  | 1325770.90 | 787838.90 | 698.70 |
| 188 | EP-G19(A)                | 7/9/08  | 1325810.40 | 787850.90 | 698.40 |
|     | EP-DUP-10 (EP-G19(A))    | 7/9/08  |            |           |        |
| 189 | EP-H18(A)                | 7/9/08  | 1325764.90 | 787892.20 | 697.50 |
|     | EP-H18(A) (MS/MSD/MSB)   | 7/9/08  |            |           |        |
| 190 | EP-K21                   | 7/9/08  | 1325866.50 | 788064.70 | 700.00 |
| 191 | EP-N17                   | 7/9/08  | 1325663.60 | 788205.40 | 695.20 |
| 192 | EP-N18                   | 7/9/08  | 1325704.40 | 788182.70 | 695.90 |
| 193 | EP-PSW-12                | 7/9/08  | 1325891.40 | 788018.60 | 701.00 |
| 194 | EP-PSW-13                | 7/9/08  | 1325847.60 | 788101.10 | 699.80 |
| 195 | EP-PSW-14                | 7/9/08  | 1325765.80 | 788155.80 | 697.50 |
| 196 | EP-PSW-15                | 7/9/08  | 1325765.80 | 788155.80 | 695.70 |
| 197 | Patell-17                | 7/9/08  | 1326169.20 | 787871.90 | 711.10 |
| 198 | Patell-18                | 7/9/08  | 1326152.00 | 787839.30 | 708.40 |
| 199 |                          | 7/9/08  | 1326121.50 | 787807.10 | 705.70 |
| 200 | EP-119(12")              | 7/10/08 | 1325794.60 | 788003.40 | 698.40 |
|     | EP-119(12") (MS/MSD/MSB) | 7/10/08 |            |           |        |
| 201 | EP-119(18")              | 7/10/08 | 1325790.20 | 788019.20 | 697.90 |
| 202 |                          | 7/10/08 | 1325609.20 | 788187.80 | 693.40 |
| 203 | EP-N17-T3                | 7/10/08 | 1325630.80 | 788193.80 | 694.30 |
| 204 | EP-O16-T3                | 7/10/08 | 1325607.40 | 788214.90 | 693.10 |
| 205 | EP-O17-T3                | 7/10/08 | 1325629.50 | 788223.30 | 693.70 |
| 206 | EP-O17                   | 7/10/08 | 1325648.10 | 788227.20 | 694.10 |
|     | EP-DUP-11 (EP-O17)       | 7/10/08 |            |           |        |
| 207 | EP-L17                   | 7/14/08 | 1325674.70 | 788084.80 | 694.80 |
| 208 | EP-K17                   | 7/14/08 | 1325686.90 | 788038.80 | 695.40 |
| 209 |                          | 7/14/08 | 1325715.40 | 787890.70 | 697.50 |
| 210 | EP-G16                   | 7/14/08 | 1325679.40 | 787833.80 | 697.10 |
| 211 |                          | 7/14/08 | 1325716.20 | 787843.50 | 697.90 |
|     | EP-G17 (MS/MSD/MSB)      | 7/14/08 |            |           |        |
| 212 | EP-K19 (18")             | 7/14/08 | 1325773.30 | 788046.10 | 697.30 |
|     | EP-DUP-12 (EP-K19(18"))  | 7/14/08 |            |           |        |
|     | Rmsate-09 (auger)        | 7/14/08 |            |           |        |
| 213 |                          | 7/14/08 | 1325607.10 | 788181.80 | 693.70 |
| 214 | EP-N16-T3(2)             | 7/14/08 | 1325619.20 | 788190.30 | 693.70 |
| 215 |                          | 7/15/08 | 1325381.20 | 787660.20 | 695.90 |
| 216 | EP-F9 (12")              | 7/15/08 | 1325332.30 | 787732.20 | 695.20 |
| 217 | EP-F9 (18")              | 7/15/08 | 1325353.40 | 787728.30 | 694.90 |
| 218 | EP-116(12")              | 7/15/08 | 1325629.90 | 787945.60 | 696.20 |
| 219 | EP-115(12")              | 7/15/08 | 1325578.1  | 787936.5  | 695.5  |
| 220 | EP-114(12")              | 7/15/08 | 1325533.2  | 787926.2  | 695.1  |
| 221 |                          | 7/15/08 | 1325548.3  | 787849.2  | 696.4  |
| 222 | Patell-20                | 7/15/08 | 1326144.7  | 787798.9  | 708.7  |
| 223 | Patell-21                | 7/15/08 | 1326187.2  | 787755.7  | 709.0  |
| 224 | Patell-22                | 7/15/08 | 1326309.1  | 787776.1  | 715.5  |
| 225 | Patell-23                | 7/15/08 | 1326290.5  | 787827.8  | 716.3  |
| 226 | Patell-24                | 7/15/08 | 1326228.9  | 787895.3  | 716.4  |
| 227 | Patell-25                | 7/15/08 | 1326182.8  | 787855.1  | 710.1  |
| 228 | Patell-26                | 7/15/08 | 1326199.5  | 787877.8  | 716.2  |
| 229 | Patell-27                | 7/15/08 | 1326202.5  | 787875.3  | 716.4  |
| 230 | Patell-28                | 7/15/08 | 1326225.4  | 787913.2  | 716.2  |
|     | Patell-28 (MS/MSD/MSB)   | 7/15/08 |            |           |        |
| 231 | Patell-29                | 7/15/08 | 1326198.7  | 787820.3  | 709.2  |
| 232 | Patell-30                | 7/15/08 | 1326239.7  | 787821.6  | 711.9  |
| 233 | Patell-31                | 7/15/08 | 1326260.7  | 787772.7  | 712.5  |
| 234 | Patell-32                | 7/15/08 | 1326227.7  | 787778.0  | 709.9  |
|     | EP-DUP-14 (Patell-32)    | 7/15/08 |            |           |        |
|     | Rmsate-10 (auger)        | 7/15/08 |            |           |        |
| 235 | Patell-33                | 7/15/08 | 1326239.9  | 787855.7  | 715.6  |
| 236 | Patell-34                | 7/15/08 | 1326293.2  | 787856.9  | 715.6  |
| 237 | Patell-35                | 7/15/08 | 1326333.1  | 787821.9  | 718.9  |
| 238 | Patell-36                | 7/15/08 | 1326424.4  | 787749.4  | 721.1  |
| 239 | Patell-37                | 7/15/08 | 1326123.5  | 787778.1  | 709.0  |
| 240 | Patell-38                | 7/15/08 | 1326207.6  | 787861.6  | 714.6  |
| 241 | Patell-39                | 7/15/08 | 1326175.5  | 787823.0  | 709.4  |
| 242 | EP-G17(1)                | 7/16/08 | 1325702.0  | 787852.8  | 697.9  |
| 243 | EP-G17(2)                | 7/16/08 | 1325707.4  | 787829.1  | 698.1  |
| 244 | EP-G17(3)                | 7/16/08 | 1325730.3  | 787831.1  | 698.4  |
| 245 |                          | 7/16/08 | 1325727.1  | 787856.9  | 697.8  |
| 246 |                          | 7/16/08 | 1325690.5  | 787905.1  | 696.9  |
| 247 | EP-H17(2)                | 7/16/08 | 1325697.7  | 787880.7  | 697.3  |
| 248 | EP-H17(3)                | 7/16/08 | 1325721.7  | 787879.2  | 697.6  |
| 249 |                          | 7/16/08 | 1325716.2  | 787905.1  | 697.2  |
|     | EP-H17(4) (MS/MSD/MSB)   | 7/16/08 |            |           |        |
| 250 | EP-J1-T17                | 7/16/08 | 1324896.8  | 787773.9  | 690.2  |
|     | EP-DUP-13 (EP-H17(1))    | 7/16/08 |            |           |        |
|     | Rmsate-11 (auger)        | 7/16/08 |            |           |        |
| 251 | EP-L16                   | 7/16/08 | 1325629.4  | 788074.7  | 694.1  |
| 252 |                          | 7/16/08 | 1325664.4  | 787879.4  | 697.1  |
| 253 | EP-J16                   | 7/16/08 | 1325644.7  | 787973.0  | 695.7  |
| 254 | EP-K16                   | 7/16/08 | 1325636.2  | 788024.3  | 694.3  |
| 255 | EP-H14 (12")X1           | 7/18/08 | 1325564.7  | 787853.8  | 696.2  |
| 256 | EP-H14 (12")X2           | 7/28/08 | 1325542.9  | 787842.4  | 696.3  |
| 257 | EP-H14 (18")             | 7/18/08 | 1325546.2  | 787873.8  | 695.3  |
| 258 | EP-H15 (18")             | 7/18/08 | 1325610.6  | 787884.5  | 695.4  |
| 259 | EP-114(18")              | 7/18/08 | 1325541.0  | 787905.1  | 694.7  |
| 260 | EP-115(18")              | 7/18/08 | 1325578.1  | 787936.5  | 695.5  |
| 261 | EP-J13                   | 7/18/08 | 1325501.5  | 787948.4  | 694.5  |
| 262 | EP-J14                   | 7/18/08 | 1325544.9  | 787960.3  | 695.1  |
| 263 | EP-J15                   | 7/18/08 | 1325589.0  | 787966.6  | 695.2  |
| 264 | EP-K12                   | 7/18/08 | 1325439.7  | 788000.4  | 693.7  |
| 265 | EP-K13                   | 7/18/08 | 1325495.3  | 788015.4  | 693.2  |

ENDPOINT SAMPLES

|     |                         |         |           |          |       |
|-----|-------------------------|---------|-----------|----------|-------|
| 266 | EP-K14                  | 7/18/08 | 1325534.5 | 788008.2 | 693.8 |
| 267 | EP-K15                  | 7/18/08 | 1325580.3 | 788019.4 | 694.0 |
| 268 | EP-L12                  | 7/18/08 | 1325433.7 | 788029.8 | 692.9 |
| 269 | EP-L13                  | 7/18/08 | 1325488.4 | 788061.7 | 692.6 |
| 270 | EP-L14                  | 7/18/08 | 1325529.0 | 788057.8 | 693.1 |
| 271 | EP-L15                  | 7/18/08 | 1325570.6 | 788066.4 | 693.8 |
| 272 | EP-DUP-15 (EP-M15(12")) | 7/18/08 |           |          |       |
|     | EP-K14 (MS/MSD/MSB)     | 7/18/08 | 1325565.1 | 788131.7 | 693.4 |
|     | Rinsate-12 (auger)      | 7/18/08 |           |          |       |
| 273 | EP-M15(12")             | 7/18/08 | 1325566.4 | 788113.4 | 694.1 |
| 274 | EP-K                    | 7/18/08 | 1325514.9 | 788094.3 | 692.5 |
| 275 | EP-N10-T9               | 7/22/08 | 1325315.0 | 788134.3 | 691.4 |
| 276 |                         | 7/22/08 | 1325337.0 | 788138.3 | 691.4 |
| 277 |                         | 7/22/08 | 1325311.3 | 788155.8 | 691.3 |
| 278 | EP-011-T9               | 7/22/08 | 1325334.0 | 788160.0 | 690.8 |
| 279 |                         | 7/22/08 | 1325366.7 | 788139.0 | 691.0 |
|     | EP-N11 (MS/MSD/MSB)     | 7/22/08 |           |          |       |
| 280 |                         | 7/22/08 | 1325409.9 | 788143.4 | 691.0 |
| 281 | EP-M12(18")             | 7/22/08 | 1325427.2 | 788100.4 | 691.5 |
| 282 |                         | 7/22/08 | 1325475.3 | 788099.1 | 692.4 |
| 283 |                         | 7/22/08 | 1325455.7 | 788081.8 | 692.0 |
| 284 | EP-M11(18")             | 7/22/08 | 1325372.0 | 788105.7 | 691.3 |
| 285 |                         | 7/22/08 | 1325468.7 | 787880.9 | 695.2 |
| 286 |                         | 7/22/08 | 1325513.0 | 787899.4 | 695.2 |
| 287 | EP-H13                  | 7/22/08 | 1325518.1 | 787860.0 | 696.0 |
| 288 |                         | 7/22/08 | 1325461.2 | 787958.3 | 693.9 |
| 289 | EP-J13-T7               | 7/22/08 | 1325480.3 | 787960.8 | 694.1 |
| 290 | EP-K12-T7               | 7/22/08 | 1325453.0 | 787984.0 | 693.4 |
| 291 | EP-K13-T7               | 7/22/08 | 1325475.6 | 787985.4 | 693.6 |
| 292 | EP-H16(A)               | 7/22/08 | 1325656.4 | 787881.3 | 696.7 |
|     | EP-DUP-16 (EP-H12)      | 7/22/08 |           |          |       |
|     | Rinsate-13 (auger)      | 7/22/08 |           |          |       |
| 293 | EP-N16-T3(1A)           | 7/22/08 | 1325614.4 | 788191.1 | 693.1 |
| 294 | EP-H12                  | 7/22/08 | 1325470.4 | 787858.2 | 695.6 |
| 295 | EP-J12                  | 7/22/08 | 1325462.0 | 787934.5 | 694.6 |
| 296 |                         | 7/22/08 | 1325609.3 | 787861.4 | 696.4 |
| 297 |                         | 7/22/08 | 1325707.6 | 787887.7 | 696.9 |
| 298 | EP-G17(A)               | 7/22/08 | 1325713.4 | 787849.7 | 697.3 |
| 299 | EP-J2(12")              | 7/28/08 | 1324945.1 | 787855.4 | 690.9 |
| 300 | EP-J2(18")              | 7/28/08 | 1324974.1 | 787848.6 | 690.9 |
| 301 |                         | 7/28/08 | 1324990.3 | 787859.4 | 690.8 |
|     | EP-J3(18") (MS/MSD/MSB) | 7/28/08 |           |          |       |
| 302 | EP-K1                   | 7/28/08 | 1324891.5 | 787862.5 | 690.5 |
| 303 | EP-K2(12")              | 7/28/08 | 1324932.6 | 787872.0 | 691.0 |
| 304 | EP-K2(18")              | 7/28/08 | 1324955.9 | 787875.9 | 690.7 |
| 305 | EP-K3(12")              | 7/28/08 | 1324978.6 | 787915.9 | 691.1 |
| 306 | EP-K3(18")              | 7/28/08 | 1324977.4 | 787881.7 | 690.6 |
| 307 | EP-L1                   | 7/28/08 | 1324881.7 | 787901.9 | 690.6 |
| 308 |                         | 7/28/08 | 1325469.7 | 787895.7 | 695.1 |
| 309 | EP-I12(2)               | 7/28/08 | 1325453.5 | 787893.5 | 695.2 |
| 310 | EP-I12(3)               | 7/28/08 | 1325451.6 | 787869.6 | 695.3 |
| 311 |                         | 7/28/08 | 1325473.1 | 787872.3 | 695.2 |
| 312 | EP-C4                   | 7/28/08 | 1325100.6 | 787514.8 | 691.3 |
|     | EP-DUP-17 (EP-G4)       | 7/28/08 |           |          |       |
|     | RINSATE-14              | 7/28/08 |           |          |       |
| 313 |                         | 7/28/08 | 1324921.8 | 787924.8 | 690.6 |
| 314 | EP-H15(12") (1)         | 7/28/08 | 1325598.7 | 787860.5 | 696.1 |
| 315 |                         | 7/28/08 | 1325622.3 | 787861.1 | 696.3 |
| 316 | EP-M13(1)               | 7/28/08 | 1325479.1 | 788086.4 | 692.6 |
| 317 |                         | 7/28/08 | 1325475.3 | 788105.1 | 692.4 |
| 318 |                         | 7/28/08 | 1325454.8 | 788104.9 | 692.3 |
| 319 | EP-J1                   | 7/28/08 | 1324902.0 | 787831.4 | 690.5 |
| 320 | EP-L3                   | 7/28/08 | 1324972.2 | 787940.1 | 691.0 |
| 321 | EP-M2                   | 7/28/08 | 1324927.3 | 787973.5 | 690.4 |
| 322 | EP-M3                   | 7/28/08 | 1324965.2 | 787978.9 | 691.0 |
| 323 | EP-E3                   | 7/28/08 | 1325037.8 | 787604.9 | 691.2 |
| 324 |                         | 7/28/08 | 1325075.2 | 787623.5 | 691.4 |
| 325 | EP-D3                   | 7/28/08 | 1324905.6 | 787434.7 | 690.6 |
| 326 | EP-D4                   | 7/28/08 | 1325093.7 | 787571.5 | 691.3 |
| 327 | EP-C3                   | 7/28/08 | 1325081.7 | 787510.3 | 690.4 |
| 328 | EP-J4                   | 7/28/08 | 1325050.3 | 787864.6 | 691.9 |
| 329 | EP-M14(1)               | 7/29/08 | 1325499.2 | 788105.1 | 692.4 |
| 330 | EP-M14(2)               | 7/29/08 | 1325508.2 | 788083.8 | 692.4 |
| 331 | EP-M14(3)               | 7/29/08 | 1325527.0 | 788092.4 | 693.0 |
| 332 |                         | 7/29/08 | 1325524.5 | 788113.6 | 691.5 |
|     | EP-M14(3) (MS/MSD/MSB)  | 7/29/08 |           |          |       |
| 333 | EP-B5                   | 7/29/08 | 1325164.9 | 787494.5 | 693.0 |
|     | EP-DUP-17 (EP-B5)       | 7/29/08 |           |          |       |
|     | Rinsate-15              | 7/29/08 |           |          |       |
| 334 |                         | 7/29/08 | 1325005.0 | 787878.9 | 691.7 |
| 335 | EP-K4                   | 7/29/08 | 1325045.8 | 787901.7 | 691.1 |
| 336 | EP-L4                   | 7/29/08 | 1325041.2 | 787952.4 | 691.1 |
| 337 |                         | 7/29/08 | 1325054.4 | 787968.8 | 691.4 |
| 338 |                         | 7/29/08 | 1324988.9 | 787940.5 | 691.3 |
| 339 | EP-PSW-18               | 7/29/08 | 1324940.4 | 787998.1 | 691.3 |
| 340 |                         | 7/29/08 | 1324895.2 | 787938.5 | 690.3 |
| 341 |                         | 7/29/08 | 1324868.7 | 787873.6 | 690.6 |
| 342 | EP-B4                   | 7/29/08 | 1325129.3 | 787488.0 | 693.0 |
| 343 | EP-B6                   | 7/29/08 | 1325215.3 | 787500.3 | 693.2 |
| 344 | EP-B7                   | 7/29/08 | 1325267.0 | 787509.8 | 694.1 |
| 345 | EP-C5                   | 7/29/08 | 1325183.6 | 787515.9 | 692.9 |
| 346 | EP-C6(12")              | 7/29/08 | 1325199.4 | 787536.1 | 693.1 |
| 347 | EP-C6(18")              | 7/29/08 | 1325214.9 | 787527.4 | 692.7 |
| 348 | EP-C7                   | 7/29/08 | 1325267.7 | 787536.3 | 694.2 |
| 349 | EP-D5                   | 7/29/08 | 1325144.5 | 787574.3 | 692.2 |
| 350 | EP-O11                  | 7/31/08 | 1325333.4 | 788159.9 | 690.8 |
|     | EP-O11 (MS/MSD/MSB)     | 7/31/08 |           |          |       |
| 351 | EP-K5                   | 7/31/08 | 1325093.2 | 787911.5 | 691.2 |
| 352 |                         | 7/31/08 | 1325086.8 | 787959.2 | 691.1 |
|     | EP-DUP-18 (EP-K5)       | 7/31/08 |           |          |       |
|     | Rinsate-16              | 7/31/08 |           |          |       |
| 353 |                         | 7/31/08 | 1324937.6 | 787909.7 | 690.4 |
| 354 | EP-L2(2)                | 7/31/08 | 1324932.1 | 787939.1 | 690.7 |
| 355 |                         | 7/31/08 | 1324907.2 | 787933.7 | 690.3 |
| 356 | EP-L2(4)                | 7/31/08 | 1324914.8 | 787904.9 | 690.3 |

ENDPOINT SAMPLES

|     |                          |         |           |           |        |
|-----|--------------------------|---------|-----------|-----------|--------|
| 357 | EP-L6                    | 7/31/08 | 1325126.1 | 787966.6  | 691.1  |
| 358 | EP-L6                    | 7/31/08 | 1325173.4 | 787975.4  | 691.7  |
| 359 | EP-L8                    | 7/31/08 | 1325215.6 | 787983.7  | 692.2  |
| 360 | EP-K6                    | 7/31/08 | 1325131.1 | 787916.6  | 691.6  |
| 361 | EP-E4(1)                 | 7/31/08 | 1325109.1 | 787604.1  | 690.9  |
| 362 | EP-E4(2)                 | 7/31/08 | 1325102.4 | 787633.2  | 690.9  |
| 363 | EP-L6                    | 7/31/08 | 1325081.2 | 787630.8  | 690.9  |
| 364 | EP-L6                    | 7/31/08 | 1325081.5 | 787598.3  | 690.9  |
| 365 | EP-O10-T9(A)             | 7/31/08 | 1325311.3 | 788155.8  | 691.3  |
| 366 | EP-N11-T9(A)             | 7/31/08 | 1325337.0 | 788138.3  | 691.4  |
| 367 | EP-J12-T7(A)             | 7/31/08 | 1325461.2 | 787958.3  | 693.9  |
| 368 | EP-L6                    | 7/31/08 | 1325456.8 | 7880081.8 | 691.9  |
| 369 | EP-J3(18)(A)             | 7/31/08 | 1324986.7 | 787847.3  | 688.8  |
| 370 | EP-J3(18)(B)             | 7/31/08 | 1324979.8 | 787869.1  | 688.3  |
| 371 | EP-L6                    | 8/4/08  | 1325304.1 | 787921.6  | 693.1  |
|     | EP-19(MS/MSD/MSB)        | 8/4/08  | 694.2     |           |        |
|     | EP-DUP-19 (EP-J9)        | 8/4/08  |           |           |        |
|     | Rinstate-17              | 8/4/08  |           |           |        |
| 372 | EP-I12(A)                | 8/4/08  | 1325449.6 | 787888.2  | 695.2  |
| 373 | EP-J13(A)                | 8/4/08  | 1325500.2 | 787904.1  | 694.2  |
| 374 | EP-I11                   | 8/4/08  | 1325404.6 | 787879.1  | 694.40 |
| 375 | EP-O15                   | 8/4/08  | 1325545.6 | 788229.9  | 692.0  |
| 376 | EP-L6                    | 8/4/08  | 1325590.5 | 788234.3  | 692.5  |
| 377 | EP-P15                   | 8/4/08  | 1325535.6 | 788267.0  | 691.5  |
| 378 | EP-P16                   | 8/4/08  | 1325573.0 | 788258.1  | 692.4  |
| 379 | EP-L5(1)                 | 8/5/08  | 1325096.7 | 787948.2  | 690.8  |
|     | EP-L5(1) (MS/MSD/MSB)    | 8/5/08  |           |           |        |
| 380 | EP-L5(1)                 | 8/5/08  | 1325093.0 | 787969.5  | 691.1  |
|     | EP-DUP-20 (EP-L5(2))     | 8/5/08  |           |           |        |
| 381 | EP-L5(3)                 | 8/5/08  | 1325072.3 | 787966.4  | 691.3  |
| 382 | EP-L5(4)                 | 8/5/08  | 1325077.0 | 787944.1  | 691.0  |

ENDPOINT SAMPLES

|     |                        |         |           |          |       |
|-----|------------------------|---------|-----------|----------|-------|
| 442 |                        | 8/13/08 | 1325430.2 | 787570.7 | 697.5 |
| 443 | EP-D8                  | 8/13/08 | 1325300.5 | 787593.5 | 694.0 |
| 444 | EP-D10                 | 8/13/08 | 1325423.7 | 787605.8 | 697.1 |
| 445 | EP-PSW-24 (MS/MSD/MSB) | 8/13/08 | 1325455.8 | 787493.3 | 699.0 |
| 446 | EP-PSW-25 (MS/MSD/MSB) | 8/13/08 | 1325526.2 | 787532.2 | 698.1 |
| 447 | EP-PSW-26              | 8/13/08 | 1325507.6 | 787630.4 | 698.5 |
| 448 | EP-DUP-24 (EP-PSW-26)  | 8/13/08 |           |          |       |
| 448 |                        | 8/13/08 | 1325486.8 | 787724.8 | 697.2 |
| 449 |                        | 8/13/08 | 1325470.5 | 787823.7 | 696.7 |
| 450 |                        | 8/13/08 | 1325549.2 | 787836.1 | 697.7 |
| 451 | EP-M13(A)              | 8/14/08 | 1325485.6 | 788101.8 | 691.0 |
| 452 | EP-M13-T8(B)           | 8/14/08 | 1325453.8 | 788083.7 | 690.9 |
| 453 | EP-M14(A)              | 8/14/08 | 1325520.9 | 788107.7 | 691.5 |
| 454 | EP-M15(18")A)          | 8/14/08 | 1325579.9 | 788101.8 | 692.9 |
| 455 | EP-O16                 | 8/14/08 | 1325590.5 | 788234.3 | 692.5 |
| 456 |                        | 8/14/08 | 1324988.1 | 787467.1 | 691.1 |
| 457 |                        | 8/14/08 | 1324965.6 | 787467.2 | 691.3 |
| 458 |                        | 8/14/08 | 1324948.5 | 787466.3 | 692.9 |
| 459 |                        | 8/14/08 | 1324968.4 | 787379.7 | 693.3 |
| 460 |                        | 8/14/08 | 1325024.8 | 787293.0 | 694.2 |
| 461 | EP-PSW-33              | 8/14/08 | 1325103.3 | 787240.9 | 693.8 |
| 462 | EP-PSW-36              | 8/14/08 | 1325178.6 | 787280.8 | 696.6 |
| 463 | EP-PSW-35              | 8/14/08 | 1325196.0 | 787382.9 | 694.3 |
| 464 | RUNSAFB-20             | 8/14/08 |           |          |       |
| 464 |                        | 8/18/08 | 1325467.5 | 787500.4 | 699.0 |
| 465 | EP-C8(1)               | 8/18/08 | 1325323.9 | 787557.6 | 694.4 |
| 466 | EP-C8(2)               | 8/18/08 | 1325322.1 | 787574.2 | 694.3 |
| 467 |                        | 8/18/08 | 1325302.1 | 787570.5 | 694.0 |
| 468 | EP-C8(4)               | 8/18/08 | 1325304.2 | 787552.5 | 694.5 |
| 469 |                        | 8/18/08 | 1325435.1 | 787565.1 | 697.7 |
| 470 | EP-C10(2)              | 8/18/08 | 1325430.0 | 787591.4 | 697.4 |
| 471 | EP-C10(3)              | 8/18/08 | 1325401.7 | 787579.2 | 696.8 |
| 472 | EP-C10(4)              | 8/18/08 | 1325405.2 | 787565.3 | 696.0 |
| 473 | EP-E7(A)               | 8/18/08 | 1325243.1 | 787650.9 | 693.1 |
| 474 | EP-H15(B)              | 8/18/08 | 1325602.7 | 787865.5 | 694.2 |
| 475 | EP-H17-C               | 8/18/08 | 1325727.3 | 787883.0 | 694.7 |
| 476 |                        | 8/18/08 | 1325309.5 | 787926.3 | 692.2 |
| 477 | EP-L5(A)               | 8/18/08 | 1325089.7 | 787963.2 | 690.0 |
| 478 | EP-L7(A)               | 8/18/08 | 1325193.3 | 787986.9 | 690.0 |
| 479 | EP-L2(A)               | 8/18/08 | 1324937.1 | 787939.7 | 689.6 |
| 480 |                        | 8/18/08 | 1324858.9 | 787903.6 | 690.0 |
| 481 |                        | 8/18/08 | 1325580.4 | 788256.8 | 691.6 |
| 482 | EP-M1                  | 8/18/08 | 1324863.7 | 787971.7 | 690.1 |
| 483 | EP-DUP-25 (EP-M1)      | 8/18/08 |           |          |       |
| 483 | EP-A11(1)              | 8/18/08 | 1325487.6 | 787503.5 | 698.9 |
| 484 | EP-A11(1) (MS/MSD/MSB) | 8/18/08 |           |          |       |
| 484 | EP-M12(12")            | 8/18/08 | 1325420.6 | 788088.2 | 692.0 |
| 485 |                        | 8/18/08 | 1325381.3 | 788073.6 | 682.1 |
| 486 | EP-L12-T8              | 8/19/08 | 1325434.1 | 788054.5 | 692.2 |
| 487 |                        | 8/19/08 | 1325456.6 | 788059.2 | 691.9 |
| 488 |                        | 8/19/08 | 1325429.8 | 788078.8 | 692.0 |
| 489 | EP-A7                  | 8/19/08 | 1325301.6 | 787465.3 | 694.8 |
| 490 |                        | 8/19/08 | 1325337.2 | 787468.5 | 695.2 |
| 491 | EP-A9                  | 8/19/08 | 1325383.8 | 787478.3 | 696.3 |
| 492 | EP-B8                  | 8/19/08 | 1325328.1 | 787497.7 | 695.0 |
| 493 | EP-D25                 | 8/19/08 | 1326124.8 | 787781.5 | 706.0 |
| 494 |                        | 8/19/08 | 1326130.7 | 787763.7 | 708.0 |
| 495 | EP-E25                 | 8/19/08 | 1326116.4 | 787818.7 | 705.7 |
| 496 |                        | 8/19/08 | 1326130.4 | 787814.4 | 707.4 |
| 497 | EP-F25                 | 8/19/08 | 1326135.5 | 787852.8 | 707.6 |
| 498 | EP-F26                 | 8/19/08 | 1326161.8 | 787877.6 | 709.4 |
| 499 |                        | 8/19/08 | 1325444.7 | 787499.3 | 698.1 |
| 500 | EP-A10(18")            | 8/19/08 | 1325427.7 | 787494.2 | 697.3 |
| 501 | EP-B10(12")            | 8/19/08 | 1325440.0 | 787522.1 | 697.9 |
| 502 | EP-DUP-26 (EP-A7)      | 8/19/08 |           |          |       |
| 502 | EP-E26                 | 8/19/08 | 1326153.4 | 787844.9 | 708.5 |
| 503 |                        | 8/19/08 | 1325200.9 | 787382.1 | 694.5 |
| 504 |                        | 8/19/08 | 1325206.6 | 787380.4 | 694.8 |
| 505 |                        | 8/19/08 | 1324996.1 | 787286.0 | 693.8 |
| 506 | EP-SW-32(2)            | 8/19/08 | 1325030.4 | 787278.4 | 694.4 |
| 507 | EP-SW-32(3)            | 8/19/08 | 1325066.6 | 787277.8 | 694.3 |
| 508 | EP-SW-32(4)            | 8/19/08 | 1325075.9 | 787265.5 | 694.6 |
| 509 |                        | 8/20/08 | 1325262.0 | 787454.4 | 694.6 |
| 510 |                        | 8/20/08 | 1325362.8 | 787463.1 | 696.2 |
| 511 |                        | 8/20/08 | 1325425.3 | 787507.6 | 697.4 |
| 512 | EP-B9(A)               | 8/20/08 | 1325366.6 | 787510.4 | 695.5 |
| 513 | EP-B9(A) (MS/MSD/MSB)  | 8/20/08 |           |          |       |
| 513 | EP-C9(A)               | 8/20/08 | 1325358.7 | 787559.6 | 694.9 |
| 514 |                        | 8/20/08 | 1325333.3 | 787604.4 | 694.5 |
| 515 | EP-B1(B)               | 8/20/08 | 1324992.1 | 787468.0 | 689.1 |
| 516 |                        | 8/20/08 | 1324968.7 | 787469.2 | 689.4 |
| 517 | EP-DUP-27 (EP-PSW-37)  | 8/20/08 |           |          |       |
| 517 | EP-F24 (Bush)          | 8/20/08 | 1326140.3 | 787866.6 | 709.2 |
| 518 |                        | 8/20/08 | 1325283.7 | 788100.2 | 687.6 |
| 519 |                        | 8/20/08 | 1325299.7 | 788091.5 | 689.0 |
| 520 | EP-N10(72")-SW(E)      | 8/20/08 | 1325289.5 | 788116.1 | 689.3 |
| 521 | EP-G16-T4              | 8/20/08 | 1325672.0 | 787833.5 | 697.0 |
| 522 | EP-G15-T4              | 8/20/08 | 1325616.0 | 787825.5 | 696.6 |
| 523 | EP-H16-T4              | 8/20/08 | 1325664.3 | 787875.8 | 696.7 |
| 524 |                        | 8/20/08 | 1325620.3 | 787864.1 | 696.0 |
| 525 | EP-DW-(N)              | 8/21/08 | 1325065.0 | 787300.4 | 694.8 |
| 526 |                        | 8/21/08 | 1325016.9 | 787301.9 | 694.4 |
| 527 | EP-PSW-35(3)           | 8/21/08 | 1325218.3 | 787379.2 | 694.5 |
| 528 | EP-PSW-35(4)           | 8/21/08 | 1325229.3 | 787376.0 | 694.9 |
| 529 |                        | 8/21/08 | 1325262.2 | 787432.4 | 696.1 |
| 530 |                        | 8/21/08 | 1325263.2 | 787421.2 | 695.8 |
| 531 |                        | 8/21/08 | 1325365.0 | 787431.4 | 698.0 |
| 532 |                        | 8/21/08 | 1325365.0 | 787421.4 | 698.0 |
| 533 | EP-H18(B)              | 8/21/08 | 1325762.4 | 787906.5 | 695.9 |
| 534 | EP-E25(Tree)(1)        | 8/22/08 | 1326142.4 | 787816.2 | 708.8 |
| 535 |                        | 8/22/08 | 1326134.6 | 787834.8 | 708.7 |
| 536 | EP-E25(Tree)(3)        | 8/22/08 | 1326117.8 | 787810.2 | 705.7 |
| 537 |                        | 8/22/08 | 1326128.4 | 787800.6 | 706.9 |

ENDPOINT SAMPLES

|     |                          |         |           |          |       |
|-----|--------------------------|---------|-----------|----------|-------|
| 538 | EP-D25(Tree)(1)          | 8/22/08 | 1326157.2 | 787766.9 | 708.8 |
| 539 | EP-D25(Tree)(2)          | 8/22/08 | 1326120.9 | 787767.5 | 706.4 |
| 540 | EP-B1-T15-C              | 8/22/08 | 1324977.6 | 787452.5 | 686.8 |
| 541 | EP-XA2                   | 8/26/08 | 1325062.7 | 787264.9 | 693.3 |
|     | EP-XA2(MS/MSD/MSB)       | 8/26/08 |           |          |       |
| 542 | EP-XA3                   | 8/26/08 | 1325103.1 | 787261.2 | 691.9 |
| 543 | EP-XA4                   | 8/26/08 | 1325148.9 | 787264.0 | 693.7 |
| 544 | EP-YA1                   | 8/26/08 | 1325016.0 | 787281.3 | 692.8 |
| 545 | EP-YA2                   | 8/26/08 | 1325090.1 | 787321.8 | 694.3 |
|     | EP-DUP-28 (EP-YA2)       | 8/26/08 |           |          |       |
| 546 |                          | 8/26/08 | 1325090.1 | 787321.8 | 694.3 |
| 547 |                          | 8/26/08 | 1325155.9 | 787334.8 | 693.2 |
| 548 | EP-A1                    | 8/26/08 | 1324980.9 | 787405.3 | 691.5 |
| 549 |                          | 8/26/08 | 1325032.6 | 787414.6 | 691.6 |
| 550 | EP-ZA1                   | 8/26/08 | 1325004.9 | 787347.1 | 693.1 |
| 551 | EP-ZA2                   | 8/26/08 | 1325055.4 | 787356.8 | 694.5 |
| 552 | EP-ZA3                   | 8/26/08 | 1325110.5 | 787356.4 | 693.8 |
| 553 |                          | 8/26/08 | 1325259.6 | 787402.8 | 696.0 |
| 554 |                          | 8/26/08 | 1325259.6 | 787387.8 | 696.1 |
| 555 |                          | 8/26/08 | 1325363.9 | 787406.5 | 698.0 |
| 556 |                          | 8/26/08 | 1325364.0 | 787391.6 | 698.0 |
| 557 | EP-ZA4                   | 8/26/08 | 1325134.0 | 787366.5 | 692.8 |
| 558 | EP-ZA5                   | 8/26/08 | 1325183.4 | 787384.2 | 693.5 |
| 559 |                          | 8/26/08 | 1325180.3 | 787326.9 | 694.3 |
| 560 |                          | 8/26/08 | 1325095.7 | 787419.9 | 692.3 |
| 561 | EP-A4                    | 8/26/08 | 1325137.2 | 787425.9 | 692.9 |
| 562 | EP-A5                    | 8/26/08 | 1325186.7 | 787426.3 | 693.5 |
| 563 | EP-A11(A)                | 8/26/08 | 1325495.6 | 787507.2 | 698.0 |
| 564 |                          | 8/28/08 | 1324938.3 | 787732.3 | 690.1 |
|     | EP-H1(MS/MSD/MSB)        | 8/28/08 |           |          |       |
| 565 |                          | 8/28/08 | 1324947.2 | 787693.1 | 689.8 |
|     | EP-DUP-29 (EP-G1)        | 8/28/08 |           |          |       |
| 566 |                          | 8/28/08 | 1324964.2 | 787653.5 | 690.4 |
| 567 | EP-F1(18")               | 8/28/08 | 1324952.0 | 787630.1 | 689.9 |
| 568 | EP-E1(12")               | 8/28/08 | 1324961.0 | 787582.1 | 691.0 |
| 569 | EP-E1(18")               | 8/28/08 | 1324949.0 | 787606.6 | 690.2 |
| 570 |                          | 8/28/08 | 1324965.0 | 787546.4 | 690.9 |
| 571 | EP-C1(12")               | 8/28/08 | 1324985.7 | 787498.0 | 690.8 |
| 572 | EP-D2                    | 8/28/08 | 1325020.9 | 787545.1 | 690.7 |
| 573 | EP-C2                    | 8/28/08 | 1325021.4 | 787507.2 | 690.7 |
| 574 |                          | 8/28/08 | 1325404.0 | 787512.4 | 694.5 |
| 575 | EP-C8(A)                 | 8/28/08 | 1325306.2 | 787554.0 | 693.6 |
| 576 |                          | 8/28/08 | 1325285.5 | 788099.4 | 686.6 |
| 577 | EP-D25(TREE)(A)          | 8/28/08 | 1326141.8 | 787769.7 | 708.0 |
| 578 | EP-E25(TREE)(A)          | 8/28/08 | 1326130.7 | 787814.6 | 706.9 |
| 579 | EP-A2(A)                 | 8/28/08 | 1325037.0 | 787404.5 | 690.4 |
| 580 | EP-A3(A)                 | 8/28/08 | 1325086.7 | 787406.8 | 691.1 |
| 581 | EP-YA3(A)                | 8/28/08 | 1325091.3 | 787322.8 | 693.8 |
| 582 |                          | 8/28/08 | 1325179.7 | 787315.7 | 694.5 |
| 583 | EP-YA5(A)                | 8/28/08 | 1325200.9 | 787337.7 | 692.9 |
| 584 | EP-YA4(B)                | 9/2/08  | 1325136.6 | 787323.9 | 692.6 |
| 585 | EP-G1(1)                 | 9/2/08  | 1324947.2 | 787693.1 | 689.8 |
|     | EP-G1(1)(MS/MSD/MSB)     | 9/2/08  |           |          |       |
| 586 | EP-G1(2)                 | 9/2/08  | 1324937.1 | 787739.4 | 690.0 |
|     | EP-DUP-30 (EP-G1(2))     | 9/2/08  |           |          |       |
| 587 | EP-H1(1)                 | 9/2/08  | 1324948.2 | 787685.0 | 690.1 |
| 588 |                          | 9/2/08  | 1324945.8 | 787702.6 | 689.7 |
| 589 | EP-D1(1)                 | 9/2/08  | 1324971.2 | 787536.4 | 690.8 |
| 590 | EP-D1(2)                 | 9/2/08  | 1324984.0 | 787554.1 | 690.8 |
| 591 | EP-H7(A)                 | 9/2/08  | 1325200.7 | 787813.5 | 691.4 |
| 592 | EP-J7                    | 9/2/08  | 1325189.9 | 787890.2 | 692.3 |
| 593 |                          | 9/2/08  | 1325224.0 | 787892.9 | 692.6 |
| 594 |                          | 9/2/08  | 1325189.1 | 787922.7 | 691.8 |
| 595 | EP-PSW-21(B)             | 9/4/08  | 1325570.1 | 788273.4 | 691.9 |
|     | EP-DUP-31 (EP-PSW-21(B)) | 9/4/08  |           |          |       |
| 596 | EP-H15-T4(A)             | 9/4/08  | 1325611.2 | 787857.5 | 694.6 |
|     | EP-H12-T4(A)(MS/MSD/MSB) | 9/4/08  |           |          |       |
| 597 | EP-N10(72")-SW(W)(A)     | 9/4/08  | 1325299.6 | 788078.6 | 690.0 |
| 598 | EP-J8(1)                 | 9/4/08  | 1325232.7 | 787889.6 | 692.6 |
| 599 |                          | 9/4/08  | 1325231.4 | 787904.8 | 692.8 |
| 600 |                          | 9/4/08  | 1325215.9 | 787900.8 | 692.3 |
| 601 |                          | 9/4/08  | 1325215.4 | 787886.8 | 692.5 |
| 602 | EP-K7(1)                 | 9/4/08  | 1325198.3 | 787913.9 | 692.3 |
| 603 | EP-K7(2)                 | 9/4/08  | 1325195.5 | 787934.0 | 691.8 |
| 604 | EP-K7(3)                 | 9/4/08  | 1325177.8 | 787927.4 | 691.9 |
| 605 |                          | 9/4/08  | 1325181.9 | 787910.2 | 692.2 |
| 606 | EP-K8                    | 9/4/08  | 1325219.3 | 787932.3 | 691.5 |
| 607 |                          | 9/4/08  | 1325228.5 | 788022.5 | 691.7 |
| 608 | EP-A10(12")(A)           | 9/4/08  | 1325444.7 | 787500.4 | 697.1 |
| 609 | EP-B10(18")(B)           | 9/4/08  | 1325415.5 | 787516.8 | 694.1 |
| 610 | EP-C10(18")(A)           | 9/4/08  | 1325427.8 | 787566.8 | 693.8 |
| 611 | EP-B10(18")-SW(N)        | 9/4/08  | 1325433.9 | 787531.1 | 695.4 |
| 612 | EP-E9(1)                 | 9/5/08  | 1325356.9 | 787650.7 | 694.5 |
|     | EP-E9(1)(MS/MSD/MSB)     | 9/5/08  |           |          |       |
| 613 | EP-E9(2)                 | 9/5/08  | 1325349.6 | 787681.8 | 694.6 |
|     | EP-DUP-32 (EP-E9(2))     | 9/5/08  |           |          |       |
| 614 | EP-E9(3)                 | 9/5/08  | 1325323.5 | 787675.1 | 694.2 |
| 615 |                          | 9/5/08  | 1325329.7 | 787645.6 | 694.1 |
| 616 | EP-D9(B)                 | 9/5/08  | 1325362.7 | 787630.7 | 694.0 |
| 617 |                          | 9/5/08  | 1325290.3 | 787657.0 | 694.3 |
| 618 |                          | 9/5/08  | 1325319.5 | 787639.6 | 693.8 |
| 619 | EP-F8                    | 9/5/08  | 1325294.8 | 787702.5 | 694.8 |
| 620 |                          | 9/5/08  | 1325187.4 | 788196.8 | 690.4 |
| 621 | EP-P8(18")               | 9/5/08  | 1325187.1 | 788188.8 | 690.4 |
| 622 | EP-A8(A)                 | 9/5/08  | 1325340.3 | 787477.6 | 694.7 |
| 623 |                          | 9/11/08 | 1325297.8 | 787674.9 | 693.7 |
| 624 | EP-E8(18")(A)            | 9/11/08 | 1325307.1 | 787657.5 | 693.3 |
| 625 | EP-E9(A)                 | 9/11/08 | 1325337.5 | 787663.7 | 693.7 |
| 626 |                          | 9/11/08 | 1325577.3 | 787835.4 | 696.6 |
| 627 |                          | 9/11/08 | 1325487.3 | 787820.9 | 696.6 |
| 628 | EP-PSW-37(5)             | 9/11/08 | 1325366.0 | 787366.5 | 698.7 |
| 629 |                          | 9/11/08 | 1325269.6 | 787357.9 | 696.0 |
| 630 | EP-PSW-38                | 9/11/08 | 1325281.8 | 787267.2 | 698.1 |
| 631 | EP-PSW-39                | 9/11/08 | 1325361.2 | 787227.0 | 698.3 |
| 632 |                          | 9/11/08 | 1325447.8 | 787207.6 | 701.0 |
| 633 |                          | 9/11/08 | 1325512.6 | 787249.4 | 701.0 |

ENDPOINT SAMPLES

|     |                             |         |           |          |       |
|-----|-----------------------------|---------|-----------|----------|-------|
| 634 | EP-PSW-43                   | 9/11/08 | 1325502.1 | 787349.8 | 700.5 |
| 635 |                             | 9/11/08 | 1325413.7 | 787356.3 | 699.9 |
| 636 | EP-F1(12")(A)               | 9/11/08 | 1324952.3 | 787654.4 | 690.4 |
|     | EP-DUP-33 (EP-F1(12")(A))   | 9/11/08 |           |          |       |
| 637 | EP-H1(A)                    | 9/11/08 | 1324940.1 | 787732.5 | 689.3 |
|     | EP-H1(A) (MS/MSD/MSB)       | 9/11/08 |           |          |       |
| 638 |                             | 9/11/08 | 1325256.9 | 787366.8 | 695.9 |
| 639 |                             | 9/11/08 | 1325237.0 | 787420.8 | 694.6 |
| 640 | EP-M12-T8(A)                | 9/11/08 | 1325428.7 | 788079.9 | 690.7 |
| 641 | EP-L13-T8(A)                | 9/11/08 | 1325458.3 | 788058.4 | 691.6 |
| 642 | EP-M11(12")(A)              | 9/11/08 | 1325356.3 | 788087.9 | 691.6 |
| 643 | EP-N12(18")(A)              | 9/11/08 | 1325415.9 | 788156.3 | 690.5 |
| 644 | EP-F14(A)                   | 9/11/08 | 1325293.6 | 788107.4 | 690.5 |
| 644 | EP-N10(72")(B)              | 9/11/08 | 1325494.4 | 788269.0 | 686.1 |
| 646 |                             | 9/12/08 | 1325377.0 | 787845.2 | 693.9 |
| 647 |                             | 9/12/08 | 1325398.0 | 787848.4 | 694.7 |
| 648 | EP-I10-T10                  | 9/12/08 | 1325374.4 | 787875.7 | 693.7 |
| 649 | EP-I11-T10                  | 9/12/08 | 1325396.4 | 787878.5 | 694.6 |
| 650 | EP-N10(12")(A)              | 9/12/08 | 1325292.8 | 788130.6 | 691.2 |
| 651 | EP-M8(A)                    | 9/12/08 | 1325234.7 | 788036.3 | 690.9 |
| 652 | EP-K7(A)                    | 9/12/08 | 1325174.7 | 787944.6 | 690.1 |
| 653 |                             | 9/15/08 | 1325294.2 | 787908.1 | 693.2 |
| 654 | EP-J8(A)                    | 9/15/08 | 1325229.6 | 787903.6 | 691.4 |
|     | EP-J8(A) (MS/MSD/MSB)       | 9/15/08 |           |          |       |
| 655 |                             | 9/15/08 | 1325271.2 | 787919.1 | 693.0 |
| 656 |                             | 9/15/08 | 1325291.6 | 787923.9 | 692.9 |
| 657 |                             | 9/15/08 | 1325271.6 | 787945.3 | 692.4 |
| 658 |                             | 9/15/08 | 1325286.5 | 787949.0 | 692.6 |
| 659 | EP-N8(18")                  | 9/15/08 | 1325213.2 | 788088.9 | 691.3 |
| 660 | EP-O8(18")                  | 9/15/08 | 1325208.6 | 788137.2 | 691.1 |
|     | EP-DUP-34 (EP-O8(18"))      | 9/15/08 |           |          |       |
| 661 | EP-M8(18")                  | 9/15/08 | 1325230.8 | 788065.2 | 690.8 |
| 662 |                             | 9/15/08 | 1325432.7 | 788278.2 | 689.4 |
| 663 |                             | 9/16/08 | 1325377.9 | 787228.2 | 689.1 |
| 664 | EP-VA9                      | 9/16/08 | 1325419.6 | 787243.2 | 688.1 |
| 665 | EP-WA8                      | 9/16/08 | 1325381.1 | 787246.3 | 689.8 |
| 666 | EP-WA9                      | 9/16/08 | 1325401.5 | 787258.4 | 689.0 |
| 667 | EP-WA7                      | 9/17/08 | 1325293.6 | 787251.1 | 686.8 |
| 668 | EP-XA7                      | 9/17/08 | 1325295.8 | 787283.1 | 697.5 |
| 669 |                             | 9/17/08 | 1325343.0 | 787287.1 | 697.5 |
| 670 | EP-YA6                      | 9/17/08 | 1325255.9 | 787351.2 | 693.9 |
| 671 | EP-YA7                      | 9/17/08 | 1325305.4 | 787337.2 | 695.0 |
| 672 |                             | 9/17/08 | 1325328.3 | 787340.0 | 696.6 |
| 673 | EP-ZA6                      | 9/17/08 | 1325251.7 | 787385.7 | 694.6 |
| 674 |                             | 9/17/08 | 1325271.0 | 787410.9 | 694.9 |
| 675 | EP-H7-T13                   | 9/18/08 | 1325227.0 | 787816.2 | 688.5 |
| 676 | EP-H8-T13                   | 9/18/08 | 1325248.4 | 787820.9 | 688.9 |
| 677 | EP-I7-T13                   | 9/18/08 | 1325223.5 | 787834.5 | 688.4 |
| 678 | EP-E8(12")(B)               | 9/19/08 | 1325290.7 | 787664.5 | 693.0 |
|     | EP-E8(12")(B) (MS/MSD/MSB)  | 9/19/08 |           |          |       |
| 679 |                             | 9/19/08 | 1325517.2 | 787245.0 | 700.9 |
| 680 | EP-PSW-27(A)                | 9/19/08 | 1325497.1 | 787716.5 | 698.9 |
|     | EP-DUP-35 (EP-PSW-27(A))    | 9/19/08 |           |          |       |
|     | RINSA7E-21                  | 9/19/08 |           |          |       |
| 681 | EP-I8-T13                   | 9/22/08 | 1325263.6 | 787866.0 | 689.2 |
| 682 |                             | 9/22/08 | 1325271.2 | 787868.2 | 694.7 |
| 683 | EP-I7SW(E)                  | 9/22/08 | 1325217.0 | 787874.7 | 692.6 |
| 684 | EP-D1-T16(12")              | 9/23/08 | 1324948.8 | 787542.0 | 687.9 |
|     | EP-D1-T16(12") (MS/MSD/MSB) | 9/23/08 |           |          |       |
| 685 | EP-C2SW(W)                  | 9/23/08 | 1324983.0 | 787469.7 |       |
| 686 | EP-C1/C2(96")               | 9/23/08 | 1325000.3 | 787474.2 | 686.0 |
| 687 | EP-C1-T15(96")              | 9/23/08 | 1324956.1 | 787480.6 | 686.4 |
| 688 | EP-PSW-45                   | 9/23/08 | 1324939.3 | 787523.4 | 692.5 |
| 689 | EP-D1-T16(96")              | 9/23/08 | 1324942.9 | 787517.6 | 687.1 |
| 690 | EP-C1SW(N)                  | 9/23/08 | 1324974.1 | 787491.5 |       |
| 691 | EP-E1-T16(12")              | 9/23/08 | 1324939.0 | 787578.6 | 690.8 |
| 692 | EP-F1-T17(96")              | 9/23/08 | 1324932.1 | 787646.2 | 684.0 |
| 693 | EP-F1SW(W)                  | 9/23/08 | 1324930.4 | 787637.3 | 687.6 |
| 694 |                             | 9/23/08 | 1324920.1 | 787626.8 | 692.4 |
| 695 | EP-E2(12")                  | 9/23/08 | 1324993.3 | 787600.3 | 690.5 |
| 696 | EP-E2(18")                  | 9/23/08 | 1324977.4 | 787609.6 | 689.8 |
| 697 | EP-YA8(A)                   | 9/24/08 | 1325326.0 | 787346.7 | 695.6 |
|     | EP-DUP-36 (EP-YA8(A))       | 9/24/08 |           |          |       |
| 698 | EP-ZA7(A)                   | 9/24/08 | 1325277.9 | 787408.2 | 693.8 |
| 699 | EP-YA8(18")                 | 9/24/08 | 1325334.6 | 787361.3 | 695.8 |
| 700 |                             | 9/24/08 | 1325387.1 | 787359.7 | 698.3 |
| 701 | EP-ZA8(18")                 | 9/24/08 | 1325331.7 | 787412.2 | 695.1 |
| 702 |                             | 9/24/08 | 1325395.9 | 787339.0 | 698.6 |
|     | EP-XA9(18") (MS/MSD/MSB)    | 9/24/08 |           |          |       |
| 703 |                             | 9/24/08 | 1325428.4 | 787371.4 | 698.1 |
| 704 |                             | 9/24/08 | 1325428.6 | 787351.9 | 698.9 |
| 705 | EP-T11(6")                  | 9/25/08 | 1325302.2 | 788424.9 | 687.1 |
| 706 | EP-T12(6")                  | 9/25/08 | 1325348.6 | 788436.5 | 687.4 |
| 707 | EP-U11(6")                  | 9/25/08 | 1325292.5 | 788471.7 | 686.6 |
| 708 | EP-U12(6")                  | 9/25/08 | 1325340.2 | 788477.6 | 687.0 |
| 709 | EP-J9(B)                    | 9/29/08 | 1325304.1 | 787932.5 | 691.6 |
| 710 | EP-J9(Non-TSCA)(A)          | 9/29/08 | 1325280.7 | 787901.6 | 692.7 |
| 711 | EP-J9-T12(A)                | 9/29/08 | 1325280.2 | 787917.8 | 692.9 |
| 712 | EP-J8-T12(A)                | 9/29/08 | 1325248.0 | 787916.6 | 692.3 |
| 713 | EP-K8-T12(A)                | 9/29/08 | 1325249.0 | 787944.6 | 691.6 |
| 714 | EP-K9-T12(A)                | 9/29/08 | 1325278.9 | 787944.6 | 692.0 |
| 715 | EP-G1-T17                   | 9/29/08 | 1324926.8 | 787677.2 | 684.5 |
| 716 | EP-G1SW(N)                  | 9/29/08 | 1324934.9 | 787678.6 | 690.2 |
|     | EP-G1SW(N) (MS/MSD/MSB)     | 9/29/08 |           |          |       |
|     | EP-DUP-37 (EP-G1SW(N))      | 9/29/08 |           |          |       |
| 717 |                             | 9/29/08 | 1325485.8 | 787782.6 | 697.7 |
| 718 |                             | 9/29/08 | 1325553.3 | 787813.8 | 698.1 |
| 719 | EP-V7                       | 9/29/08 | 1325100.6 | 788469.2 | 686.2 |
| 720 | EP-V8                       | 9/29/08 | 1325122.9 | 788475.3 | 686.2 |
| 721 | EP-U7                       | 9/29/08 | 1325107.3 | 788434.9 | 686.6 |
| 722 | EP-U8                       | 9/29/08 | 1325130.3 | 788437.5 | 686.4 |
| 723 |                             | 9/29/08 | 1325113.5 | 788378.0 | 687.4 |
| 724 | EP-T8                       | 9/29/08 | 1325150.1 | 788364.9 | 686.9 |
| 725 | EP-H1-T17(96")              | 9/30/08 | 1324918.3 | 787732.0 | 683.1 |
| 726 | EP-I8SW(N)(A)               | 9/30/08 | 1325279.9 | 787855.8 | 693.5 |
| 727 |                             | 9/30/08 | 1325303.8 | 787872.8 | 693.5 |

ENDPOINT SAMPLES

|     |                                |          |           |          |       |
|-----|--------------------------------|----------|-----------|----------|-------|
| 728 | EP-18                          | 9/30/08  | 1325256.8 | 787884.3 | 693.2 |
| 729 | EP-T11(12")                    | 10/1/08  | 1325306.8 | 788409.5 | 686.6 |
| 730 | EP-T12(12")                    | 10/1/08  | 1325352.8 | 788420.4 | 686.9 |
| 731 | EP-T6                          | 10/6/08  | 1325065.5 | 788373.6 | 688.3 |
| 732 | EP-S6                          | 10/6/08  | 1325074.0 | 788332.1 | 688.8 |
| 733 | EP-R6                          | 10/6/08  | 1325080.3 | 788289.0 | 691.1 |
| 734 | EP-R7                          | 10/6/08  | 1325118.6 | 788292.9 | 690.7 |
| 735 | EP-R8                          | 10/6/08  | 1325183.2 | 788291.5 | 690.8 |
| 736 | EP-S7                          | 10/6/08  | 1325114.7 | 788333.8 | 688.9 |
| 737 |                                | 10/6/08  | 1325170.5 | 788358.3 | 688.5 |
| 738 |                                | 10/6/08  | 1325205.4 | 788363.5 | 688.3 |
| 739 |                                | 10/6/08  | 1325245.9 | 788350.3 | 688.4 |
| 740 | EP-XA8(A)                      | 10/6/08  | 1325356.6 | 787309.5 | 697.0 |
| 741 |                                | 10/6/08  | 1324898.7 | 787728.5 |       |
| 742 |                                | 10/6/08  | 1324909.6 | 787743.4 | 682.8 |
| 743 |                                | 10/7/08  | 1325385.4 | 787223.0 | 698.9 |
|     | EP-VA8(A)(MS/MSD/MSB)          | 10/7/08  |           |          |       |
|     | EP-DUR-38(EP-VA8(A))           | 10/7/08  |           |          |       |
| 744 | EP-S11(12")                    | 10/7/08  | 1325309.7 | 788372.5 | 684.5 |
| 745 | EP-S12                         | 10/7/08  | 1325358.2 | 788382.0 | 687.9 |
| 746 | EP-S9(A)                       | 10/7/08  | 1325208.4 | 788367.0 | 687.8 |
| 747 | EP-T7(A)                       | 10/7/08  | 1325117.6 | 788382.2 | 686.9 |
| 748 | EP-S8(A)                       | 10/7/08  | 1325174.1 | 788362.3 | 688.0 |
| 749 |                                | 10/7/08  | 1325211.6 | 788292.1 | 690.8 |
| 750 | EP-S10(12")X(A)                | 10/8/08  | 1325249.2 | 788355.3 | 687.4 |
| 751 |                                | 10/8/08  | 1325431.0 | 787372.3 | 697.5 |
| 752 | EP-XA10(18")X(A)               | 10/8/08  | 1325432.2 | 787359.2 | 697.4 |
| 753 | EP-XA9(18")X(A)                | 10/8/08  | 1325396.8 | 787339.7 | 697.9 |
| 754 | EP-YA9(18")X(A)                | 10/8/08  | 1325400.3 | 787355.5 | 697.8 |
| 755 |                                | 10/8/08  | 1325185.1 | 788203.9 | 690.2 |
| 756 | EP-PWS-43                      | 10/9/08  | 1325097.5 | 788089.9 | 693.0 |
| 757 | EP-PWS-49                      | 10/9/08  | 1325083.2 | 788182.8 | 692.8 |
| 758 | EP-PWS-50                      | 10/9/08  | 1325198.6 | 788278.8 | 691.7 |
| 759 | EP-PWS-51                      | 10/9/08  | 1325120.3 | 788287.7 | 691.1 |
| 760 | EP-PWS-52                      | 10/9/08  | 1325062.7 | 788337.9 | 689.4 |
| 761 |                                | 10/10/08 | 1325386.0 | 787404.6 | 697.0 |
| 762 |                                | 10/10/08 | 1325413.7 | 787410.1 | 686.9 |
| 763 |                                | 10/10/08 | 1325379.6 | 787838.7 | 693.5 |
| 764 | EP-H11-T10(A)                  | 10/10/08 | 1325402.9 | 787844.9 | 693.6 |
|     | EP-DUR-39(EP-H11-T10(A))       | 10/10/08 |           |          |       |
| 765 | EP-I8(A)                       | 10/10/08 | 1325246.1 | 787851.1 | 692.2 |
|     | EP-I8(A)(MS/MSD/MSB)           | 10/10/08 |           |          |       |
| 766 | EP-I9(A)                       | 10/10/08 | 1325901.0 | 788020.2 | 692.7 |
| 767 | EP-O7(12")                     | 10/10/08 | 1325130.3 | 788117.0 | 691.4 |
| 768 | EP-P6(12")                     | 10/10/08 | 1325097.9 | 788171.9 | 691.6 |
| 769 | EP-P7(12")                     | 10/10/08 | 1325128.7 | 788174.7 | 690.9 |
| 770 | EP-O6(12")                     | 10/10/08 | 1325094.0 | 788139.1 | 691.7 |
| 771 | EP-P7(18")                     | 10/10/08 | 1325152.3 | 788184.8 | 689.7 |
| 772 | EP-R9(A)                       | 10/13/08 | 1325226.3 | 788287.4 | 688.9 |
|     | EP-DUR-40(EP-R9(A))            |          |           |          |       |
| 773 | EP-VA8(B)                      | 10/13/08 | 1325372.9 | 787225.4 | 697.7 |
| 774 |                                | 10/13/08 | 1325186.8 | 788210.5 | 689.5 |
|     | EP-PSW-38(B)(MS/MSD/MSB)       |          |           |          |       |
| 775 |                                | 10/13/08 | 1325435.7 | 788304.8 | 687.5 |
| 776 | EP-O13(12")X(B)                | 10/13/08 | 1325434.3 | 788283.5 | 689.2 |
| 777 | EP-O13(30")SW(W)(A)            | 10/13/08 | 1325462.5 | 788300.1 | 689.1 |
| 778 | EP-H15W(E)(A)                  | 10/13/08 | 1324899.9 | 787743.8 | 683.2 |
| 779 | EP-M4                          | 10/13/08 | 1325027.7 | 788004.5 | 691.3 |
| 780 | EP-M5                          | 10/13/08 | 1325066.6 | 788032.9 | 690.6 |
| 781 | EP-M6                          | 10/13/08 | 1325121.4 | 788045.0 | 691.3 |
| 782 |                                | 10/13/08 | 1325163.8 | 788059.4 | 691.5 |
| 783 | EP-N5                          | 10/13/08 | 1325069.7 | 788063.7 | 691.8 |
| 784 |                                | 10/13/08 | 1325113.2 | 788075.0 | 691.7 |
| 785 | EP-N7                          | 10/13/08 | 1325158.9 | 788073.6 | 691.3 |
| 786 | EP-N8(12")                     | 10/13/08 | 1325196.8 | 788084.0 | 691.3 |
| 787 | EP-P13-T6(108")                | 10/14/08 | 1325446.9 | 788236.0 | 682.0 |
| 788 | EP-P14-T6(108")                | 10/14/08 | 1325476.7 | 788242.4 | 682.0 |
| 789 | EP-O13-T6(108")                | 10/14/08 | 1325453.3 | 788211.1 | 682.0 |
| 790 | EP-O14-T6(108")                | 10/14/08 | 1325480.9 | 788217.5 | 682.0 |
| 791 | EP-P13-T6SW(E)                 | 10/14/08 | 1325448.4 | 788247.8 |       |
| 792 | EP-O14-T6SW(W)                 | 10/14/08 | 1325486.8 | 788209.7 | 681.1 |
| 793 | EP-O13(30")X(B)                | 10/16/08 | 1325438.4 | 788314.1 | 686.9 |
| 794 | EP-N6(A)                       | 10/17/08 | 1325117.8 | 788077.1 | 690.8 |
| 795 | EP-M7(A)                       | 10/17/08 | 1325165.4 | 788050.1 | 691.0 |
| 796 | EP-PSW-38-C                    | 10/17/08 | 1325162.2 | 788207.7 | 689.6 |
| 797 | EP-ZA9(18")X(A)(1)             | 10/17/08 | 1325386.0 | 787404.6 | 696.0 |
|     | EP-ZA9(18")X(A)(1)(MS/MSD/MSB) | 10/17/08 |           |          |       |
| 798 | EP-ZA9(18")X(A)(2)             | 10/17/08 | 1325386.0 | 787404.6 | 695.0 |
| 799 | EP-ZA9(18")X(A)(3)             | 10/17/08 | 1325386.0 | 787404.6 | 694.2 |
| 800 | EP-ZA10(18")X(A)(1)            | 10/17/08 | 1325413.7 | 787410.1 | 695.9 |
|     | EP-DUR-41(EP-ZA10(18")X(A)(1)) | 10/17/08 |           |          |       |
| 801 | EP-ZA10(18")X(A)(2)            | 10/17/08 | 1325413.7 | 787410.1 | 694.9 |
| 802 | EP-ZA10(18")X(A)(3)            | 10/17/08 | 1325413.7 | 787410.1 | 694.1 |
| 803 | EP-O7(18")                     | 10/17/08 | 1325146.8 | 788147.0 | 690.0 |
| 804 | EP-O8(12")                     | 10/17/08 | 1325191.9 | 788156.3 | 690.4 |
| 805 | EP-H10-T10(B)                  | 10/20/08 | 1325379.6 | 787838.7 | 693.5 |
| 806 | EP-S10(54")                    | 10/28/08 | 1325272.6 | 788373.6 | 683.9 |
| 807 | EP-S11(54")                    | 10/28/08 | 1325294.5 | 788377.2 | 681.0 |
| 808 | EP-S11(54")SW(N)               | 10/28/08 | 1325306.9 | 788381.5 |       |
| 809 | EP-S10(54")SW(S)               | 10/28/08 | 1325260.7 | 788370.4 |       |
| 810 | EP-ZA11(18")                   | 10/29/08 | 1325472.7 | 787430.3 | 698.7 |
| 811 | EP-YA10(18")X(B)               | 10/29/08 | 1325433.2 | 787376.1 | 697.7 |
| 812 |                                | 10/29/08 | 1325483.1 | 787385.2 | 697.8 |
|     | EP-YA10(18")X(B)(MS/MSD/MSB)   | 10/29/08 |           |          |       |
| 813 | EP-WA10(12")                   | 10/29/08 | 1325485.2 | 787279.1 | 700.3 |
|     | EP-DUR-42(EP-WA10(12"))        | 10/29/08 |           |          |       |
| 814 | EP-WA11(12")                   | 10/29/08 | 1325505.5 | 787286.6 | 699.8 |
| 815 | EP-XA11(12")                   | 10/29/08 | 1325494.8 | 787334.0 | 699.7 |
| 816 |                                | 10/29/08 | 1325491.4 | 787252.0 | 700.0 |
| 817 |                                | 10/29/08 | 1325469.0 | 787232.8 | 699.4 |
| 818 |                                | 10/29/08 | 1325514.1 | 787239.2 | 699.3 |
| 819 |                                | 10/29/08 | 1325470.5 | 787198.1 | 698.7 |
| 820 | EP-UA11(12")                   | 10/29/08 | 1325521.8 | 787196.3 | 699.0 |
| 821 | EP-UA10(12")                   | 10/29/08 | 1325500.7 | 787178.9 | 699.8 |
|     | EP-ZA11(18")X(A)               |          | 1325472.7 | 787430.3 | 698.3 |
| 822 | EP-YA11(18")X(A)               | 10/29/08 | 1325483.1 | 787385.2 | 697.8 |



**FORMER BOUCHARD JUNKYARD SITE  
FINAL REMEDIATION REPORT  
POST-EXCAVATION SOIL SAMPLE RESULTS  
POLYCHLORINATED BIPHENYLS**

| Sample Identification | EP-A1   | EP-A2        | EP-A2A  | EP-A3        | EP-A3A  | EP-A4   | EP-A5   | EP-A6   | EP-A6(T14) | EP-GRAPE VINE | EP-A7(T14) |   |
|-----------------------|---------|--------------|---------|--------------|---------|---------|---------|---------|------------|---------------|------------|---|
| Grid Location         | A, 1    | A, 2         | A, 2    | A, 3         | A, 3    | A, 4    | A, 5    | A, 6    | A, 6       | A, 6          | A, 7       | NYSDEC<br>Unrestricted Use<br>Soil Clean-Up<br>Objective<br>(ug/kg) |
| Sample Depth (feet)   | 1       | 1            | 1.5     | 1            | 1.5     | 1       | 1       | 1       | 1          | 0.2           | 1          |   |
| Date of Collection    | 8/26/08 | 8/26/08      | 8/28/08 | 8/26/08      | 8/28/08 | 8/26/08 | 8/26/08 | 8/12/08 | 8/12/08    | 9/11/08       | 8/12/08    |   |
| Dilution Factor       | 1.0     | 1.0          | 1.0     | 1.0          | 1.0     | 1.0     | 1.0     | 1.0     | 1.0        | 1.0           | 1.0        |   |
| Percent Moisture      | 7       | 30           | 19      | 21           | 21      | 13      | 9       | 10      | 9          | 19            | 9          |   |
| Units                 | (ug/kg) | (ug/kg)      | (ug/kg) | (ug/kg)      | (ug/kg) | (ug/kg) | (ug/kg) | (ug/kg) | (ug/kg)    | (ug/kg)       | (ug/kg)    | (ug/kg)   |
| Aroclor-1016          | 550 U   | 730 U        | 590 U   | 650 U        | 580 U   | 550 U   | 550 U   | 530 U   | 550 U      | 530 U         | 530 U      | 1,000   |
| Aroclor-1221          | 550 U   | 730 U        | 590 U   | 650 U        | 580 U   | 550 U   | 550 U   | 530 U   | 550 U      | 530 U         | 530 U      | 1,000   |
| Aroclor-1232          | 550 U   | 730 U        | 590 U   | 650 U        | 580 U   | 550 U   | 550 U   | 530 U   | 550 U      | 530 U         | 530 U      | 1,000   |
| Aroclor-1242          | 550 U   | 730 U        | 590 U   | 650 U        | 580 U   | 550 U   | 550 U   | 530 U   | 550 U      | 530 U         | 530 U      | 1,000   |
| Aroclor-1248          | 550 U   | 730 U        | 590 U   | 650 U        | 580 U   | 550 U   | 550 U   | 530 U   | 550 U      | 530 U         | 530 U      | 1,000   |
| Aroclor-1254          | 550 U   | 730 U        | 590 U   | 650 U        | 580 U   | 550 U   | 550 U   | 530 U   | 550 U      | 530 U         | 530 U      | 1,000   |
| Aroclor-1260          | 550 U   | <b>5,400</b> | 590 U   | <b>1,800</b> | 580 U   | 750     | 880     | 530 U   | 550 U      | <b>3,200</b>  | 530 U      | 1,000   |
| <b>Total PCBs</b>     | ----    | <b>1800</b>  | ----    | <b>1800</b>  | ----    | 750     | 880     | ----    | ----       | <b>3,200</b>  | ----       | 1,000   |

| Sample Identification | EP-A7   | EP-A8        | EP-A8A  | EP-A9   | EP-A10(12)   | EP-A10(12A) | EP-A10(18) | EP-A11       | EP-A11(1) | EP-A11(2)    |   |
|-----------------------|---------|--------------|---------|---------|--------------|-------------|------------|--------------|-----------|--------------|---|
| Grid Location         | A, 7    | A, 8         | A, 8    | A, 9    | A, 10        | A, 10       | A, 10      | A, 11        | A, 11     | A, 11        | NYSDEC<br>Unrestricted Use<br>Soil Clean-Up<br>Objective<br>(ug/kg) |
| Sample Depth (feet)   | 1       | 1            | 1.5     | 1       | 1            | 1.5         | 1.5        | 1            | 1         | 1            |   |
| Date of Collection    | 8/19/08 | 8/19/08      | 9/5/08  | 8/19/08 | 8/19/08      | 9/4/08      | 8/19/08    | 8/13/08      | 8/18/08   | 8/18/08      |   |
| Dilution Factor       | 1.0     | 1.0          | 1.0     | 1.0     | 1.0          | 1.0         | 1.0        | 1.0          | 1.0       | 1.0          |   |
| Percent Moisture      | 8       | 24           | 6       | 18      | 23           | 12          | 27         | 17           | 21        | 14           |   |
| Units                 | (ug/kg) | (ug/kg)      | (ug/kg) | (ug/kg) | (ug/kg)      | (ug/kg)     | (ug/kg)    | (ug/kg)      | (ug/kg)   | (ug/kg)      | (ug/kg)   |
| Aroclor-1016          | 550 U   | 670 U        | 490 U   | 590 U   | 650 U        | 550 U       | 700 U      | 600 U        | 600 U     | 540 U        | 1,000   |
| Aroclor-1221          | 550 U   | 670 U        | 490 U   | 590 U   | 650 U        | 550 U       | 700 U      | 600 U        | 600 U     | 540 U        | 1,000   |
| Aroclor-1232          | 550 U   | 670 U        | 490 U   | 590 U   | 650 U        | 550 U       | 700 U      | 600 U        | 600 U     | 540 U        | 1,000   |
| Aroclor-1242          | 550 U   | 670 U        | 490 U   | 590 U   | 650 U        | 550 U       | 700 U      | 600 U        | 600 U     | 540 U        | 1,000   |
| Aroclor-1248          | 550 U   | 670 U        | 490 U   | 590 U   | 650 U        | 550 U       | 700 U      | 600 U        | 600 U     | 540 U        | 1,000   |
| Aroclor-1254          | 550 U   | 670 U        | 490 U   | 590 U   | 650 U        | 550 U       | 700 U      | 600 U        | 600 U     | 540 U        | 1,000   |
| Aroclor-1260          | 550 U   | <b>3,600</b> | 490 U   | 590 U   | <b>3,700</b> | 550 U       | 700 U      | <b>1,800</b> | 600 U     | <b>7,400</b> | 1,000   |
| <b>Total PCBs</b>     | ----    | <b>3,600</b> | ----    | ----    | <b>3,700</b> | ----        | ----       | <b>1,800</b> | ----      | <b>7,400</b> | 1,000   |

**QUALIFIERS:**

- B: Compound found in the method blank as well as the sample
- D: Result taken from a reanalysis at a secondary dilution
- J: Compound found at a concentration below the CRDL, value estimated
- U: Compound analyzed for but not detected

**NOTES:**

All concentrations are in micrograms per kilogram (ug/kg) or parts per billion (ppb)  
 1: 6 NYCRR PART 375 - Table 375-6.8(a): Unrestricted Use Soil Cleanup Objectives (SCOs)  
  Indicates value exceeds standard or guidance value

**FORMER BOUCHARD JUNKYARD SITE  
FINAL REMEDIATION REPORT  
POST-EXCAVATION SOIL SAMPLE RESULTS  
POLYCHLORINATED BIPHENYLS**

| Sample Identification | EP-A11A | EP-A12  | EP-B1        | EP-B1A       | EP-B1B  | EP-B1(T15)    | EP-B1(T15A)  | EP-B1(T15B)    | EP-B1(T15C) | EP-B2   |               |
|-----------------------|---------|---------|--------------|--------------|---------|---------------|--------------|----------------|-------------|---------|---------------|
| Grid Location         | A, 11   | A, 12   | B, 1         | B, 1         | B, 1    | B, 1          | B, 1         | B, 1           | B, 1        | B, 2    | NYSDEC        |
| Sample Depth (feet)   | 1.5     | 1       | 1            | 2            | 2.5     | 1             | 2            | 2.5            | 4.5         | 1       |               |
| Date of Collection    | 8/26/08 | 8/13/08 | 8/12/08      | 8/14/08      | 8/20/08 | 8/12/08       | 8/14/08      | 8/20/08        | 8/22/08     | 8/12/08 |               |
| Dilution Factor       | 1.0     | 1.0     | 1.0          | 1.0          | 1.0     | 1.0           | 1.0          | 1.0            | 1.0         | 1.0     | Soil Clean-Up |
| Percent Moisture      | 5       | 13      | 20           | 19           | 8       | 20            | 19           | 18             | 16          | 9       | Objective     |
| Units                 | (ug/kg) | (ug/kg) | (ug/kg)      | (ug/kg)      | (ug/kg) | (ug/kg)       | (ug/kg)      | (ug/kg)        | (ug/kg)     | (ug/kg) | (ug/kg)       |
| Aroclor-1016          | 520 U   | 530 U   | 640 U        | 630 U        | 540 U   | 590 U         | 630 U        | 6,200 U        | 600 U       | 560 U   | 1,000         |
| Aroclor-1221          | 520 U   | 530 U   | 640 U        | 630 U        | 540 U   | 590 U         | 630 U        | 6,200 U        | 600 U       | 560 U   | 1,000         |
| Aroclor-1232          | 520 U   | 530 U   | 640 U        | 630 U        | 540 U   | 590 U         | 630 U        | 6,200 U        | 600 U       | 560 U   | 1,000         |
| Aroclor-1242          | 520 U   | 530 U   | 640 U        | 630 U        | 540 U   | 590 U         | 630 U        | 6,200 U        | 600 U       | 560 U   | 1,000         |
| Aroclor-1248          | 520 U   | 530 U   | 640 U        | 630 U        | 540 U   | 590 U         | 630 U        | 6,200 U        | 600 U       | 560 U   | 1,000         |
| Aroclor-1254          | 520 U   | 530 U   | 640 U        | 630 U        | 540 U   | 590 U         | 630 U        | 30,000 P       | 600 U       | 560 U   | 1,000         |
| Aroclor-1260          | 520 U   | 530 U   | 5,600        | 2,800        | 540 U   | 39,000        | 1,900        | 100,000        | 600 U       | 560 U   | 1,000         |
| <b>Total PCBs</b>     | ----    | ----    | <b>5,600</b> | <b>2,800</b> | ----    | <b>39,000</b> | <b>1,900</b> | <b>130,000</b> | ----        | ----    | 1,000         |

| Sample Identification | EP-B3   | EP-B4   | EP-B5   | EP-B6   | EP-B6(T14) | EP-B7   | EP-B7(T14) | EP-B8   | EP-B9        | EP-B9A  |               |
|-----------------------|---------|---------|---------|---------|------------|---------|------------|---------|--------------|---------|---------------|
| Grid Location         | B, 3    | B, 4    | B, 5    | B, 6    | B, 6       | B, 7    | B, 7       | B, 8    | B, 9         | B, 9    | NYSDEC        |
| Sample Depth (feet)   | 1       | 1       | 1       | 1       | 1          | 1       | 1          | 1       | 1            | 1.5     |               |
| Date of Collection    | 8/8/08  | 7/29/08 | 7/29/08 | 7/29/08 | 8/12/08    | 7/29/08 | 8/12/08    | 8/19/08 | 8/12/08      | 8/20/08 |               |
| Dilution Factor       | 1.0     | 1.0     | 1.0     | 1.0     | 1.0        | 1.0     | 1.0        | 1.0     | 1.0          | 1.0     | Soil Clean-Up |
| Percent Moisture      | 19      | 16      | 20      | 14      | 14         | 7       | 11         | 17      | 15           | 12      | Objective     |
| Units                 | (ug/kg) | (ug/kg) | (ug/kg) | (ug/kg) | (ug/kg)    | (ug/kg) | (ug/kg)    | (ug/kg) | (ug/kg)      | (ug/kg) | (ug/kg)       |
| Aroclor-1016          | 610 U   | 570 U   | 600 U   | 590 U   | 570 U      | 540 U   | 520 U      | 600 U   | 600 U        | 570 U   | 1,000         |
| Aroclor-1221          | 610 U   | 570 U   | 600 U   | 590 U   | 570 U      | 540 U   | 520 U      | 600 U   | 600 U        | 570 U   | 1,000         |
| Aroclor-1232          | 610 U   | 570 U   | 600 U   | 590 U   | 570 U      | 540 U   | 520 U      | 600 U   | 600 U        | 570 U   | 1,000         |
| Aroclor-1242          | 610 U   | 570 U   | 600 U   | 590 U   | 570 U      | 540 U   | 520 U      | 600 U   | 600 U        | 570 U   | 1,000         |
| Aroclor-1248          | 610 U   | 570 U   | 600 U   | 590 U   | 570 U      | 540 U   | 520 U      | 600 U   | 600 U        | 570 U   | 1,000         |
| Aroclor-1254          | 610 U   | 570 U   | 600 U   | 590 U   | 570 U      | 540 U   | 520 U      | 600 U   | 600 U        | 570 U   | 1,000         |
| Aroclor-1260          | 610 U   | 570 U   | 600 U   | 590 U   | 570 U      | 540 U   | 520 U      | 600 U   | 9,300        | 570 U   | 1,000         |
| <b>Total PCBs</b>     | ----    | ----    | ----    | ----    | ----       | ----    | ----       | ----    | <b>9,300</b> | ----    | 1,000         |

**QUALIFIERS:**

- B: Compound found in the method blank as well as the sample
- D: Result taken from a reanalysis at a secondary dilution
- J: Compound found at a concentration below the CRDL, value estimated
- U: Compound analyzed for but not detected
- P: Greater than 25% difference for detected concentrations between the two GC columns

**NOTES:**

- All concentrations are in micrograms per kilogram (ug/kg) or parts per billion (ppb)
- 1: 6 NYCRR PART 375 - Table 375-6.8(a): Unrestricted Use Soil Cleanup Objectives (SCOs)
- Indicates value exceeds standard or guidance value

**FORMER BOUCHARD JUNKYARD SITE  
FINAL REMEDIATION REPORT  
POST-EXCAVATION SOIL SAMPLE RESULTS  
POLYCHLORINATED BIPHENYLS**

| Sample Identification | EP-B10(12) | EP-B10(18) | EP-B10(18A) | EP-B10(18B) | EP-B11  | EP-B12  | EP-C1   | EP-C1(T15)(96) | EP-C1/C2(96) | EP-C2   | EP-C3   |   |
|-----------------------|------------|------------|-------------|-------------|---------|---------|---------|----------------|--------------|---------|---------|---|
| Grid Location         | B, 10      | B, 10      | B, 10       | B, 10       | B, 11   | B, 12   | C, 1    | C, 1           | C, 1/C, 2    | C, 2    | C, 3    | NYSDEC<br>Unrestricted Use<br>Soil Clean-Up<br>Objective<br>(ug/kg) |
| Sample Depth (feet)   | 1          | 1.5        | 2           | 3           | 1       | 1       | 1       | 8              | 8            | 1       | 1       |   |
| Date of Collection    | 8/19/08    | 8/20/08    | 8/28/08     | 9/4/08      | 8/13/08 | 8/13/08 | 8/28/08 | 9/23/08        | 9/23/08      | 8/28/08 | 7/28/08 |   |
| Dilution Factor       | 1.0        | 1.0        | 1.0         | 1.0         | 1.0     | 1.0     | 1.0     | 1.0            | 1.0          | 1.0     | 1.0     |   |
| Percent Moisture      | 18         | 23         | 9           | 8           | 10      | 19      | 19      | 8              | 13           | 5       | 13      |   |
| Units                 | (ug/kg)    | (ug/kg)    | (ug/kg)     | (ug/kg)     | (ug/kg) | (ug/kg) | (ug/kg) | (ug/kg)        | (ug/kg)      | (ug/kg) | (ug/kg) | (ug/kg)   |
| Aroclor-1016          | 600 U      | 600 U      | 540 J       | 520 U       | 520 U   | 580 U   | 610 U   | 520 U          | 570 U        | 520 U   | 590 U   | 1,000   |
| Aroclor-1221          | 600 U      | 600 U      | 540         | 520 U       | 520 U   | 580 U   | 610 U   | 520 U          | 570 U        | 520 U   | 590 U   | 1,000   |
| Aroclor-1232          | 600 U      | 600 U      | 540 J       | 520 U       | 520 U   | 580 U   | 610 U   | 520 U          | 570 U        | 520 U   | 590 U   | 1,000   |
| Aroclor-1242          | 600 U      | 600 U      | 540 J       | 520 U       | 520 U   | 580 U   | 610 U   | 520 U          | 570 U        | 520 U   | 590 U   | 1,000   |
| Aroclor-1248          | 600 U      | 600 U      | 540 U       | 520 U       | 520 U   | 580 U   | 610 U   | 520 U          | 570 U        | 520 U   | 590 U   | 1,000   |
| Aroclor-1254          | 600 U      | 600 U      | 540 U       | 520 U       | 520 U   | 580 U   | 610 U   | 520 U          | 570 U        | 520 U   | 590 U   | 1,000   |
| Aroclor-1260          | 600 U      | 2,600      | 10,000      | 520 U       | 520 U   | 580 U   | 610 U   | 520 U          | 570 U        | 520 U   | 590 U   | 1,000   |
| <b>Total PCBs</b>     | ---        | 2,600      | 10,540      | ---         | ---     | ---     | ---     | ---            | ---          | ---     | ---     | 1,000   |

| Sample Identification | EP-C4   | EP-C5   | EP-C6(12) | EP-C6(18) | EP-C7   | EP-C8   | EP-C8(1) | EP-C8(2) | EP-C8(3) | EP-C8(4) | EP-C8(A) |   |
|-----------------------|---------|---------|-----------|-----------|---------|---------|----------|----------|----------|----------|----------|---|
| Grid Location         | C, 4    | C, 5    | C, 6      | C, 6      | C, 7    | C, 8    | C, 8     | C, 8     | C, 8     | C, 8     | C, 8     | NYSDEC<br>Unrestricted Use<br>Soil Clean-Up<br>Objective<br>(ug/kg) |
| Sample Depth (feet)   | 1       | 1       | 1         | 1.5       | 1       | 1       | 1        | 1        | 1        | 1        | 1.5      |   |
| Date of Collection    | 7/28/08 | 7/29/08 | 7/29/08   | 7/29/08   | 7/29/08 | 8/13/08 | 8/18/08  | 8/18/08  | 8/18/08  | 8/18/08  | 8/28/08  |   |
| Dilution Factor       | 1.0     | 1.0     | 1.0       | 1.0       | 1.0     | 1.0     | 1.0      | 1.0      | 1.0      | 1.0      | 1.0      |   |
| Percent Moisture      | 8       | 14      | 5         | 12        | 10      | 11      | 8        | 4        | 6        | 4        | 3        |   |
| Units                 | (ug/kg) | (ug/kg) | (ug/kg)   | (ug/kg)   | (ug/kg) | (ug/kg) | (ug/kg)  | (ug/kg)  | (ug/kg)  | (ug/kg)  | (ug/kg)  | (ug/kg)   |
| Aroclor-1016          | 530 U   | 570 U   | 530 U     | 570 U     | 570 U   | 540 U   | 510 U    | 490 U    | 490 U    | 530 U    | 500 U    | 1,000   |
| Aroclor-1221          | 530 U   | 570 U   | 530 U     | 570 U     | 570 U   | 540 U   | 510 U    | 490 U    | 490 U    | 530 U    | 500 U    | 1,000   |
| Aroclor-1232          | 530 U   | 570 U   | 530 U     | 570 U     | 570 U   | 540 U   | 510 U    | 490 U    | 490 U    | 530 U    | 500 U    | 1,000   |
| Aroclor-1242          | 530 U   | 570 U   | 530 U     | 570 U     | 570 U   | 540 U   | 510 U    | 490 U    | 490 U    | 530 U    | 500 U    | 1,000   |
| Aroclor-1248          | 530 U   | 570 U   | 530 U     | 570 U     | 570 U   | 540 U   | 510 U    | 490 U    | 490 U    | 530 U    | 500 U    | 1,000   |
| Aroclor-1254          | 530 U   | 570 U   | 530 U     | 570 U     | 570 U   | 540 U   | 510 U    | 490 U    | 490 U    | 530 U    | 500 U    | 1,000   |
| Aroclor-1260          | 530 U   | 630     | 530 U     | 570 U     | 570 U   | 1,600   | 510 U    | 610      | 2,500    | 530 U    | 500 U    | 1,000   |
| <b>Total PCBs</b>     | ---     | 630     | ---       | ---       | ---     | 1,600   | ---      | 610      | 2,500    | ---      | ---      | 1,000   |

**QUALIFIERS:**

- B: Compound found in the method blank as well as the sample
- D: Result taken from a reanalysis at a secondary dilution
- J: Compound found at a concentration below the CRDL, value estimated
- U: Compound analyzed for but not detected

**NOTES:**

- All concentrations are in micrograms per kilogram (ug/kg) or parts per billion (ppb)
- 1: 6 NYCRR PART 375 - Table 375-6.8(a): Unrestricted Use Soil Cleanup Objectives (SCOs)
- Indicates value exceeds standard or guidance value

**FORMER BOUCHARD JUNKYARD SITE  
FINAL REMEDIATION REPORT  
POST-EXCAVATION SOIL SAMPLE RESULTS  
POLYCHLORINATED BIPHENYLS**

| Sample Identification | EP-C9(T9)    | EP-C9(A) | EP-C10       | EP-C10(1)     | EP-C10(2) | EP-C10(3) | EP-C10(4) | EP-C10(18)(A) | EP-C11  | EP-C12  | EP-D1        | EP-D1(1) | EP-D1(2) | EP-D1(T16)(12) |           |                                   |
|-----------------------|--------------|----------|--------------|---------------|-----------|-----------|-----------|---------------|---------|---------|--------------|----------|----------|----------------|-----------|-----------------------------------|
| Grid Location         | C, 9         | C, 9     | C, 10        | C, 10         | C, 10     | C, 10     | C, 10     | C, 10         | C, 11   | C, 12   | D, 1         | D, 1     | D, 1     | D, 1           | NYSDEC    |                                   |
| Sample Depth (feet)   | 1            | 1.5      | 1            | 1             | 1         | 1         | 1         | 2             | 1       | 1       | 1            | 1        | 1        | 4              |           | Unrestricted Use<br>Soil Clean-Up |
| Date of Collection    | 8/12/08      | 8/20/08  | 8/13/08      | 8/18/08       | 8/18/08   | 8/18/08   | 8/18/08   | 9/4/08        | 8/12/08 | 8/12/08 | 8/28/08      | 9/2/08   | 9/2/08   | 9/23/08        |           |                                   |
| Dilution Factor       | 1.0          | 1.0      | 1.0          | 1.0           | 1.0       | 1.0       | 1.0       | 1.0           | 1.0     | 1.0     | 1.0          | 1.0      | 1.0      | 1.0            | Objective |                                   |
| Percent Moisture      | 18           | 5        | 16           | 10            | 6         | 5         | 8         | 4             | 20      | 18      | 21           | 13       | 7        | 19             |           |                                   |
| Units                 | (ug/kg)      | (ug/kg)  | (ug/kg)      | (ug/kg)       | (ug/kg)   | (ug/kg)   | (ug/kg)   | (ug/kg)       | (ug/kg) | (ug/kg) | (ug/kg)      | (ug/kg)  | (ug/kg)  | (ug/kg)        | (ug/kg)   |                                   |
| Aroclor-1016          | 570 U        | 540 U    | 580 U        | 520 U         | 490 U     | 490 U     | 530 U     | 520 U         | 640 U   | 580 U   | 600 U        | 560 U    | 530 U    | 630 U          | 1,000     |                                   |
| Aroclor-1221          | 570 U        | 540 U    | 580 U        | 520 U         | 490 U     | 490 U     | 530 U     | 520 U         | 640 U   | 580 U   | 600 U        | 560 U    | 530 U    | 630 U          | 1,000     |                                   |
| Aroclor-1232          | 570 U        | 540 U    | 580 U        | 520 U         | 490 U     | 490 U     | 530 U     | 520 U         | 640 U   | 580 U   | 600 U        | 560 U    | 530 U    | 630 U          | 1,000     |                                   |
| Aroclor-1242          | 570 U        | 540 U    | 580 U        | 520 U         | 490 U     | 490 U     | 530 U     | 520 U         | 640 U   | 580 U   | 600 U        | 560 U    | 530 U    | 630 U          | 1,000     |                                   |
| Aroclor-1248          | 570 U        | 540 U    | 580 U        | 520 U         | 490 U     | 490 U     | 530 U     | 520 U         | 640 U   | 580 U   | 600 U        | 560 U    | 530 U    | 630 U          | 1,000     |                                   |
| Aroclor-1254          | 570 U        | 540 U    | 580 U        | 520 U         | 490 U     | 490 U     | 530 U     | 520 U         | 640 U   | 580 U   | 600 U        | 560 U    | 530 U    | 630 U          | 1,000     |                                   |
| Aroclor-1260          | <b>7,600</b> | 540 U    | <b>2,400</b> | <b>19,000</b> | 490 U     | 490 U     | 530 U     | 520 U         | 640 U   | 580 U   | <b>1,200</b> | 560 U    | 530 U    | 630 U          | 1,000     |                                   |
| <b>Total PCBs</b>     | <b>7,600</b> | ---      | <b>2,400</b> | <b>19,000</b> | ---       | ---       | ---       | ---           | ---     | ---     | <b>1,200</b> | ---      | ---      | ---            | 1,000     |                                   |

| Sample Identification | EP-D1(T16)(96) | EP-D2   | EP-D3   | EP-D4   | EP-D5   | EP-D6   | EP-D7(12) | EP-D7(18) | EP-D8   | EP-D9(T9)    | EP-D9(T9A)   | EP-D9(T9B) | EP-D10  | EP-D11  |           |                                   |
|-----------------------|----------------|---------|---------|---------|---------|---------|-----------|-----------|---------|--------------|--------------|------------|---------|---------|-----------|-----------------------------------|
| Grid Location         | D, 1           | D, 2    | D, 3    | D, 4    | D, 5    | D, 6    | D, 7      | D, 7      | D, 8    | D, 9         | D, 9         | D, 9       | D, 10   | D, 11   | NYSDEC    |                                   |
| Sample Depth (feet)   | 8              | 1       | 1       | 1       | 1       | 1       | 1         | 1.5       | 1       | 1            | 1.5          | 2          | 1       | 1       |           | Unrestricted Use<br>Soil Clean-Up |
| Date of Collection    | 9/23/08        | 8/28/08 | 7/28/08 | 7/28/08 | 7/29/08 | 8/8/08  | 8/8/08    | 8/8/08    | 8/13/08 | 8/12/08      | 8/20/08      | 9/5/08     | 8/13/08 | 8/12/08 |           |                                   |
| Dilution Factor       | 1.0            | 1.0     | 1.0     | 1.0     | 1.0     | 1.0     | 1.0       | 1.0       | 1.0     | 1.0          | 1.0          | 1.0        | 1.0     | 1.0     | Objective |                                   |
| Percent Moisture      | 15             | 14      | 11      | 6       | 16      | 8       | 7         | 6         | 5       | 16           | 26           | 4          | 13      | 19      |           |                                   |
| Units                 | (ug/kg)        | (ug/kg) | (ug/kg) | (ug/kg) | (ug/kg) | (ug/kg) | (ug/kg)   | (ug/kg)   | (ug/kg) | (ug/kg)      | (ug/kg)      | (ug/kg)    | (ug/kg) | (ug/kg) | (ug/kg)   |                                   |
| Aroclor-1016          | 600 U          | 560 U   | 550 U   | 500 U   | 580 U   | 530 U   | 500 U     | 530 U     | 530 U   | 560 U        | 630 U        | 500 U      | 570 U   | 580 U   | 1,000     |                                   |
| Aroclor-1221          | 600 U          | 560 U   | 550 U   | 500 U   | 580 U   | 530 U   | 500 U     | 530 U     | 530 U   | 560 U        | 630 U        | 500 U      | 570 U   | 580 U   | 1,000     |                                   |
| Aroclor-1232          | 600 U          | 560 U   | 550 U   | 500 U   | 580 U   | 530 U   | 500 U     | 530 U     | 530 U   | 560 U        | 630 U        | 500 U      | 570 U   | 580 U   | 1,000     |                                   |
| Aroclor-1242          | 600 U          | 560 U   | 550 U   | 500 U   | 580 U   | 530 U   | 500 U     | 530 U     | 530 U   | 560 U        | 630 U        | 500 U      | 570 U   | 580 U   | 1,000     |                                   |
| Aroclor-1248          | 600 U          | 560 U   | 550 U   | 500 U   | 580 U   | 530 U   | 500 U     | 530 U     | 530 U   | 560 U        | 630 U        | 500 U      | 570 U   | 580 U   | 1,000     |                                   |
| Aroclor-1254          | 600 U          | 560 U   | 550 U   | 500 U   | 580 U   | 530 U   | 500 U     | 530 U     | 530 U   | 560 U        | 630 U        | 500 U      | 570 U   | 580 U   | 1,000     |                                   |
| Aroclor-1260          | 600 U          | 560 U   | 550 U   | 500 U   | 580 U   | 530 U   | 500 U     | 530 U     | 530 U   | <b>2,500</b> | <b>2,300</b> | 500 U      | 810     | 580 U   | 1,000     |                                   |
| <b>Total PCBs</b>     | ---            | ---     | ---     | ---     | ---     | ---     | ---       | ---       | ---     | <b>2,500</b> | <b>2,300</b> | ---        | 810     | ---     | 1,000     |                                   |

**QUALIFIERS:**

- B: Compound found in the method blank as well as the sample
- D: Result taken from a reanalysis at a secondary dilution
- J: Compound found at a concentration below the CRDL, value estimated
- U: Compound analyzed for but not detected

**NOTES:**

- All concentrations are in micrograms per kilogram (ug/kg) or parts per billion (ppb)
- 1: 6 NYCRR PART 375 - Table 375-6.8(a): Unrestricted Use Soil Cleanup Objectives (SCOs)
- Indicates value exceeds standard or guidance value

FORMER BOUCHARD JUNKYARD SITE  
FINAL REMEDIATION REPORT  
POST-EXCAVATION SOIL SAMPLE RESULTS  
POLYCHLORINATED BIPHENYLS

| Sample Identification | EP-D12  | EP-D23  | EP-D24  | EP-D25  | EP-D25(TREE) | EP-D25(TREE)(1) | EP-D25(TREE)(2) | EP-D25(TREE)(A) | EP-E1(12) | EP-E1(18) |   |
|-----------------------|---------|---------|---------|---------|--------------|-----------------|-----------------|-----------------|-----------|-----------|---|
| Grid Location         | D, 12   | D, 23   | D, 24   | D, 25   | D, 25        | D, 25           | D, 25           | D, 25           | E, 1      | E, 1      | NYSDEC<br>Unrestricted Use<br>Soil Clean-Up<br>Objective<br>(ug/kg) |
| Sample Depth (feet)   | 1       | 1       | 1       | 1       | 1            | 1               | 1               | 1               | 1         | 1.5       |   |
| Date of Collection    | 8/12/08 | 6/25/08 | 6/25/08 | 8/19/08 | 8/19/08      | 8/22/08         | 8/22/08         | 8/28/08         | 8/28/08   | 8/28/08   |   |
| Dilution Factor       | 1.0     | 1.0     | 1.0     | 1.0     | 1.0          | 1.0             | 1.0             | 1.0             | 1.0       | 1.0       |   |
| Percent Moisture      | 19      | 8       | 7       | 16      | 26           | 18              | 7               | 11              | 7         | 19        |   |
| Units                 | (ug/kg) | (ug/kg) | (ug/kg) | (ug/kg) | (ug/kg)      | (ug/kg)         | (ug/kg)         | (ug/kg)         | (ug/kg)   | (ug/kg)   |   |
| Aroclor-1016          | 620 U   | 510 U   | 550 U   | 580 U   | 690 U        | 620 U           | 530 U           | 560 U           | 550 U     | 580 U     | 1,000   |
| Aroclor-1221          | 620 U   | 510 U   | 550 U   | 580 U   | 690 U        | 620 U           | 530 U           | 560 U           | 550 U     | 580 U     | 1,000   |
| Aroclor-1232          | 620 U   | 510 U   | 550 U   | 580 U   | 690 U        | 620 U           | 530 U           | 560 U           | 550 U     | 580 U     | 1,000   |
| Aroclor-1242          | 620 U   | 510 U   | 550 U   | 580 U   | 690 U        | 620 U           | 530 U           | 560 U           | 550 U     | 580 U     | 1,000   |
| Aroclor-1248          | 620 U   | 510 U   | 550 U   | 580 U   | 690 U        | 620 U           | 530 U           | 560 U           | 550 U     | 580 U     | 1,000   |
| Aroclor-1254          | 620 U   | 510 U   | 550 U   | 580 U   | 690 U        | 620 U           | 530 U           | 560 U           | 550 U     | 580 U     | 1,000   |
| Aroclor-1260          | 620 U   | 510 U   | 550 U   | 580 U   | 3,000        | 620 U           | 910             | 560 U           | 550 U     | 800       | 1,000   |
| <b>Total PCBs</b>     | ---     | ---     | ---     | ---     | 3,000        | ---             | 910             | ---             | ---       | 800       | 1,000   |

| Sample Identification | EP-E1(T16)(12) | EP-E2(12) | EP-E2(18) | EP-E3   | EP-E4   | EP-E4(1) | EP-E4(2) | EP-E4(3) | EP-E4(4) | EP-E4A  |   |
|-----------------------|----------------|-----------|-----------|---------|---------|----------|----------|----------|----------|---------|---|
| Grid Location         | E, 1           | E, 2      | E, 2      | E, 3    | E, 4    | E, 4     | E, 4     | E, 4     | E, 4     | E, 4    | NYSDEC<br>Unrestricted Use<br>Soil Clean-Up<br>Objective<br>(ug/kg) |
| Sample Depth (feet)   | 1              | 1         | 1.5       | 1       | 1       | 1        | 1        | 1        | 1        | 1.5     |   |
| Date of Collection    | 9/23/08        | 9/23/08   | 9/23/08   | 7/28/08 | 7/28/08 | 7/31/08  | 7/31/08  | 7/31/08  | 7/31/08  | 8/8/08  |   |
| Dilution Factor       | 1.0            | 1.0       | 1.0       | 1.0     | 1.0     | 1.0      | 1.0      | 1.0      | 1.0      | 1.0     |   |
| Percent Moisture      | 11             | 23        | 17        | 23      | 18      | 8        | 6        | 18       | 17       | 8       |   |
| Units                 | (ug/kg)        | (ug/kg)   | (ug/kg)   | (ug/kg) | (ug/kg) | (ug/kg)  | (ug/kg)  | (ug/kg)  | (ug/kg)  | (ug/kg) |   |
| Aroclor-1016          | 560 U          | 620 U     | 610 U     | 650 U   | 590 U   | 550 U    | 530 U    | 610 U    | 610 U    | 540 U   | 1,000   |
| Aroclor-1221          | 560 U          | 620 U     | 610 U     | 650 U   | 590 U   | 550 U    | 530 U    | 610 U    | 610 U    | 540 U   | 1,000   |
| Aroclor-1232          | 560 U          | 620 U     | 610 U     | 650 U   | 590 U   | 550 U    | 530 U    | 610 U    | 610 U    | 540 U   | 1,000   |
| Aroclor-1242          | 560 U          | 620 U     | 610 U     | 650 U   | 590 U   | 550 U    | 530 U    | 610 U    | 610 U    | 540 U   | 1,000   |
| Aroclor-1248          | 560 U          | 620 U     | 610 U     | 650 U   | 590 U   | 550 U    | 530 U    | 610 U    | 610 U    | 540 U   | 1,000   |
| Aroclor-1254          | 560 U          | 620 U     | 610 U     | 650 U   | 590 U   | 550 U    | 530 U    | 610 U    | 610 U    | 540 U   | 1,000   |
| Aroclor-1260          | 670            | 840       | 840       | 650 U   | 3,500   | 550 U    | 530 U    | 14,000   | 1,400    | 540 U   | 1,000   |
| <b>Total PCBs</b>     | 670            | 840       | 840       | ---     | 3,500   | ---      | ---      | 14,000   | 1,400    | ---     | 1,000   |

QUALIFIERS:

- B: Compound found in the method blank as well as the sample
- D: Result taken from a reanalysis at a secondary dilution
- J: Compound found at a concentration below the CRDL, value estimated
- U: Compound analyzed for but not detected

NOTES:

- All concentrations are in micrograms per kilogram (ug/kg) or parts per billion (ppb)
- 1: 6 NYCRR PART 375 - Table 375-6.8(a): Unrestricted Use Soil Cleanup Objectives (SCOs)
- Indicates value exceeds standard or guidance value

FORMER BOUCHARD JUNKYARD SITE  
FINAL REMEDIATION REPORT  
POST-EXCAVATION SOIL SAMPLE RESULTS  
POLYCHLORINATED BIPHENYLS

| Sample Identification | EP-E5   | EP-E6   | EP-E7   | EP-E7(1) | EP-E7(2) | EP-E7(3) | EP-E7(4) | EP-E7A  | EP-E8(12) | EP-E8(12)(A) | EP-E8(12)(B) | EP-E8(18) | EP-E8(18)(A) | EP-E9   | EP-E9(1) |  |
|-----------------------|---------|---------|---------|----------|----------|----------|----------|---------|-----------|--------------|--------------|-----------|--------------|---------|----------|--|
| Grid Location         | E, 5    | E, 6    | E, 7    | E, 7     | E, 7     | E, 7     | E, 7     | E, 7    | E, 8      | E, 8         | E, 8         | E, 8      | E, 8         | E, 9    | E, 9     | NYSDEC<br>Unrestricted Use<br>Soil Clean-Up<br>Objective |
| Sample Depth (feet)   | 1       | 1       | 1       | 1        | 1        | 1        | 1        | 1.5     | 1         | 1.5          | 2            | 1.5       | 2            | 1       | 1        |  |
| Date of Collection    | 8/8/08  | 8/8/08  | 8/8/08  | 8/12/08  | 8/12/08  | 8/12/08  | 8/12/08  | 8/18/08 | 9/5/08    | 9/11/08      | 9/19/08      | 9/5/08    | 9/11/08      | 7/15/08 | 9/5/08   |  |
| Dilution Factor       | 1.0     | 1.0     | 1.0     | 1.0      | 1.0      | 1.0      | 1.0      | 1.0     | 1.0       | 1.0          | 1.0          | 1.0       | 1.0          | 1.0     | 1.0      |  |
| Percent Moisture      | 9       | 6       | 10      | 6        | 13       | 8        | 11       | 6       | 8         | 10           | 4            | 13        | 9            | 18      | 8        |  |
| Units                 | (ug/kg) | (ug/kg) | (ug/kg) | (ug/kg)  | (ug/kg)  | (ug/kg)  | (ug/kg)  | (ug/kg) | (ug/kg)   | (ug/kg)      | (ug/kg)      | (ug/kg)   | (ug/kg)      | (ug/kg) | (ug/kg)  | (ug/kg)  |
| Aroclor-1016          | 520 U   | 530 U   | 540 U   | 540 U    | 570 U    | 520 U    | 570 U    | 500 U   | 530 U     | 480 U        | 530 U        | 530 U     | 550 U        | 590 U   | 540 U    | 1,000  |
| Aroclor-1221          | 520 U   | 530 U   | 540 U   | 540 U    | 570 U    | 520 U    | 570 U    | 500 U   | 530 U     | 480 U        | 530 U        | 530 U     | 550 U        | 590 U   | 540 U    | 1,000  |
| Aroclor-1232          | 520 U   | 530 U   | 540 U   | 540 U    | 570 U    | 520 U    | 570 U    | 500 U   | 530 U     | 480 U        | 530 U        | 530 U     | 550 U        | 590 U   | 540 U    | 1,000  |
| Aroclor-1242          | 520 U   | 530 U   | 540 U   | 540 U    | 570 U    | 520 U    | 570 U    | 500 U   | 530 U     | 480 U        | 530 U        | 530 U     | 550 U        | 590 U   | 540 U    | 1,000  |
| Aroclor-1248          | 520 U   | 530 U   | 540 U   | 540 U    | 570 U    | 520 U    | 570 U    | 500 U   | 530 U     | 480 U        | 530 U        | 530 U     | 550 U        | 590 U   | 540 U    | 1,000  |
| Aroclor-1254          | 520 U   | 530 U   | 540 U   | 540 U    | 570 U    | 520 U    | 570 U    | 500 U   | 530 U     | 480 U        | 530 U        | 530 U     | 550 U        | 590 U   | 540 U    | 1,000  |
| Aroclor-1260          | 520 U   | 530 U   | 1,200   | 2,600    | 570 U    | 1,600    | 570 U    | 500 U   | 1,300     | 2,000        | 530 U        | 1,500     | 550 U        | 1,100   | 540 U    | 1,000  |
| <b>Total PCBs</b>     | ----    | ----    | 1,200   | 2,600    | ----     | 1,600    | ----     | ----    | 1,300     | 2,000        | ----         | 1,500     | ----         | 1,100   | ----     | 1,000  |

| Sample Identification | EP-E9(2) | EP-E9(3) | EP-E9(4) | EP-E9(A) | EP-E10  | EP-E11  | EP-E12  | EP-E19  | EP-E20  | EP-E21  | EP-E22  | EP-E23  | EP-E24  | EP-E25  | EP-E25(TREE) |  |
|-----------------------|----------|----------|----------|----------|---------|---------|---------|---------|---------|---------|---------|---------|---------|---------|--------------|--|
| Grid Location         | E, 9     | E, 9     | E, 9     | E, 9     | E, 10   | E, 11   | E, 12   | E, 19   | E, 20   | E, 21   | E, 22   | E, 23   | E, 24   | E, 25   | E, 25        | NYSDEC<br>Unrestricted Use<br>Soil Clean-Up<br>Objective |
| Sample Depth (feet)   | 1        | 1        | 1        | 2        | 1       | 1       | 1       | 1       | 1       | 1       | 1       | 1       | 1       | 1       | 1            |  |
| Date of Collection    | 9/5/08   | 9/5/08   | 9/5/08   | 9/11/08  | 6/6/08  | 6/6/08  | 6/6/08  | 6/10/08 | 6/10/08 | 6/10/08 | 6/17/08 | 6/25/08 | 6/25/08 | 8/19/08 | 8/19/08      |  |
| Dilution Factor       | 1.0      | 1.0      | 1.0      | 1.0      | 1.0     | 1.0     | 1.0     | 1.0     | 1.0     | 1.0     | 1.0     | 1.0     | 1.0     | 1.0     | 1.0          |  |
| Percent Moisture      | 7        | 11       | 8        | 3        | 12      | 11      | 22      | 21      | 17      | 14      | 13      | 6       | 12      | 13      | 26           |  |
| Units                 | (ug/kg)  | (ug/kg)  | (ug/kg)  | (ug/kg)  | (ug/kg) | (ug/kg) | (ug/kg) | (ug/kg) | (ug/kg) | (ug/kg) | (ug/kg) | (ug/kg) | (ug/kg) | (ug/kg) | (ug/kg)      | (ug/kg)  |
| Aroclor-1016          | 510 U    | 570 U    | 520 U    | 500 U    | 560 U   | 560 U   | 650 U   | 630 U   | 600 U   | 590 U   | 520 U   | 490 U   | 550 U   | 570 U   | 650 U        | 1,000  |
| Aroclor-1221          | 510 U    | 570 U    | 520 U    | 500 U    | 560 U   | 560 U   | 650 U   | 630 U   | 600 U   | 590 U   | 520 U   | 490 U   | 550 U   | 570 U   | 650 U        | 1,000  |
| Aroclor-1232          | 510 U    | 570 U    | 520 U    | 500 U    | 560 U   | 560 U   | 650 U   | 630 U   | 600 U   | 590 U   | 520 U   | 490 U   | 550 U   | 570 U   | 650 U        | 1,000  |
| Aroclor-1242          | 510 U    | 570 U    | 520 U    | 500 U    | 560 U   | 560 U   | 650 U   | 630 U   | 600 U   | 590 U   | 520 U   | 490 U   | 550 U   | 570 U   | 650 U        | 1,000  |
| Aroclor-1248          | 510 U    | 570 U    | 520 U    | 500 U    | 560 U   | 560 U   | 650 U   | 630 U   | 600 U   | 590 U   | 520 U   | 490 U   | 550 U   | 570 U   | 650 U        | 1,000  |
| Aroclor-1254          | 510 U    | 570 U    | 520 U    | 500 U    | 560 U   | 560 U   | 650 U   | 630 U   | 600 U   | 590 U   | 520 U   | 490 U   | 550 U   | 570 U   | 650 U        | 1,000  |
| Aroclor-1260          | 510 U    | 570 U    | 32,000   | 500 U    | 560 U   | 560 U   | 650 U   | 630 U   | 600 U   | 590 U   | 520 U   | 490 U   | 550 U   | 570 U   | 2,100        | 1,000  |
| <b>Total PCBs</b>     | ----     | ----     | 32,000   | ----     | ----    | ----    | ----    | ----    | ----    | ----    | ----    | ----    | ----    | ----    | 2,100        | 1,000  |

QUALIFIERS:

- B: Compound found in the method blank as well as the sample
- D: Result taken from a reanalysis at a secondary dilution
- J: Compound found at a concentration below the CRDL, value estimated
- U: Compound analyzed for but not detected

NOTES:

- All concentrations are in micrograms per kilogram (ug/kg) or parts per billion (ppb)
- 1: 6 NYCRR PART 375 - Table 375-6.8(a): Unrestricted Use Soil Cleanup Objectives (SCOs)
- Indicates value exceeds standard or guidance value

FORMER BOUCHARD JUNKYARD SITE  
FINAL REMEDIATION REPORT  
POST-EXCAVATION SOIL SAMPLE RESULTS  
POLYCHLORINATED BIPHENYLS

| Sample Identification | EP-E25(TREE)(1) | EP-E25(TREE)(2) | EP-E25(TREE)(3) | EP-E25(TREE)(4) | EP-E25(TREE)(A) | EP-E26  | EP-F1(12)    | EP-F1(12A) | EP-F1(18) | EP-F1(T17)(96) |   |
|-----------------------|-----------------|-----------------|-----------------|-----------------|-----------------|---------|--------------|------------|-----------|----------------|---|
| Grid Location         | E, 25           | E, 25           | E, 25           | E, 25           | E, 25           | E, 26   | F, 1         | F, 1       | F, 1      | F, 1           | NYSDEC<br>Unrestricted Use<br>Soil Clean-Up<br>Objective<br>(ug/kg) |
| Sample Depth (feet)   | 1               | 1               | 1               | 1               | 2               | 1       | 1            | 1.5        | 1.5       | 8              |   |
| Date of Collection    | 8/22/08         | 8/22/08         | 8/22/08         | 8/22/08         | 8/28/08         | 8/19/08 | 8/28/08      | 9/11/08    | 8/28/08   | 9/23/08        |   |
| Dilution Factor       | 1.0             | 1.0             | 1.0             | 1.0             | 1.0             | 1.0     | 1.0          | 1.0        | 1.0       | 1.0            |   |
| Percent Moisture      | 14              | 14              | 9               | 11              | 10              | 20      | 13           | 26         | 24        | 24             |   |
| Units                 | (ug/kg)         | (ug/kg)         | (ug/kg)         | (ug/kg)         | (ug/kg)         | (ug/kg) | (ug/kg)      | (ug/kg)    | (ug/kg)   | (ug/kg)        |   |
| Aroclor-1016          | 580 U           | 570 U           | 540 U           | 560 U           | 570 U           | 610 U   | 590 U        | 590 U      | 630 U     | 660 U          | 1,000   |
| Aroclor-1221          | 580 U           | 570 U           | 540 U           | 560 U           | 570 U           | 610 U   | 590 U        | 590 U      | 630 U     | 660 U          | 1,000   |
| Aroclor-1232          | 580 U           | 570 U           | 540 U           | 560 U           | 570 U           | 610 U   | 590 U        | 590 U      | 630 U     | 660 U          | 1,000   |
| Aroclor-1242          | 580 U           | 570 U           | 540 U           | 560 U           | 570 U           | 610 U   | 590 U        | 590 U      | 630 U     | 660 U          | 1,000   |
| Aroclor-1248          | 580 U           | 570 U           | 540 U           | 560 U           | 570 U           | 610 U   | 590 U        | 590 U      | 630 U     | 660 U          | 1,000   |
| Aroclor-1254          | 580 U           | 570 U           | 540 U           | 560 U           | 570 U           | 610 U   | 590 U        | 590 U      | 630 U     | 660 U          | 1,000   |
| Aroclor-1260          | 580 U           | <b>1,200</b>    | 540 U           | <b>1,200</b>    | 570 U           | 610 U   | <b>4,600</b> | 590 U      | 630 U     | 660 U          | 1,000   |
| <b>Total PCBs</b>     | ---             | <b>1,200</b>    | ---             | <b>1,200</b>    | ---             | ---     | <b>4,600</b> | ---        | ---       | ---            | 1,000   |

| Sample Identification | EP-F2   | EP-F3   | EP-F4   | EP-F5   | EP-F6   | EP-F7   | EP-F8   | EP-F9(12) | EP-F9(18) | EP-F10  |   |
|-----------------------|---------|---------|---------|---------|---------|---------|---------|-----------|-----------|---------|---|
| Grid Location         | F, 2    | F, 3    | F, 4    | F, 5    | F, 6    | F, 7    | F, 8    | F, 9      | F, 9      | F, 10   | NYSDEC<br>Unrestricted Use<br>Soil Clean-Up<br>Objective<br>(ug/kg) |
| Sample Depth (feet)   | 1       | 1       | 1       | 1       | 1       | 1       | 1       | 1         | 1         | 1       |   |
| Date of Collection    | 5/27/08 | 5/28/08 | 5/38/08 | 5/29/08 | 5/30/08 | 6/2/08  | 9/5/08  | 7/15/08   | 7/15/08   | 6/6/08  |   |
| Dilution Factor       | 1.0     | 1.0     | 1.0     | 1.0     | 1.0     | 1.0     | 1.0     | 1.0       | 1.0       | 1.0     |   |
| Percent Moisture      | 23      | 26      | 9       | 5       | 5       | 5       | 9       | 13        | 11        | 8       |   |
| Units                 | (ug/kg) | (ug/kg) | (ug/kg) | (ug/kg) | (ug/kg) | (ug/kg) | (ug/kg) | (ug/kg)   | (ug/kg)   | (ug/kg) |   |
| Aroclor-1016          | 620 U   | 680 U   | 540 U   | 490 U   | 500 U   | 490 U   | 530 U   | 570 U     | 570 U     | 520 U   | 1,000   |
| Aroclor-1221          | 620 U   | 680 U   | 540 U   | 490 U   | 500 U   | 490 U   | 530 U   | 570 U     | 570 U     | 520 U   | 1,000   |
| Aroclor-1232          | 620 U   | 680 U   | 540 U   | 490 U   | 500 U   | 490 U   | 530 U   | 570 U     | 570 U     | 520 U   | 1,000   |
| Aroclor-1242          | 620 U   | 680 U   | 540 U   | 490 U   | 500 U   | 490 U   | 530 U   | 570 U     | 570 U     | 520 U   | 1,000   |
| Aroclor-1248          | 620 U   | 680 U   | 540 U   | 490 U   | 500 U   | 490 U   | 530 U   | 570 U     | 570 U     | 520 U   | 1,000   |
| Aroclor-1254          | 620 U   | 680 U   | 540 U   | 490 U   | 500 U   | 490 U   | 530 U   | 570 U     | 570 U     | 520 U   | 1,000   |
| Aroclor-1260          | 620 U   | 680 U   | 540 U   | 490 U   | 500 U   | 490 U   | 820     | 570 U     | 570 U     | 520 U   | 1,000   |
| <b>Total PCBs</b>     | ---     | ---     | ---     | ---     | ---     | ---     | 820     | ---       | ---       | ---     | 1,000   |

QUALIFIERS:

- B: Compound found in the method blank as well as the sample
- D: Result taken from a reanalysis at a secondary dilution
- J: Compound found at a concentration below the CRDL, value estimated
- U: Compound analyzed for but not detected

NOTES:

- All concentrations are in micrograms per kilogram (ug/kg) or parts per billion (ppb)
- 1: 6 NYCRR PART 375 - Table 375-6.8(a): Unrestricted Use Soil Cleanup Objectives (SCOs)
- Indicates value exceeds standard or guidance value

**FORMER BOUCHARD JUNKYARD SITE  
FINAL REMEDIATION REPORT  
POST-EXCAVATION SOIL SAMPLE RESULTS  
POLYCHLORINATED BIPHENYLS**

| Sample Identification | EP-F11  | EP-F12  | EP-F16  | EP-F17  | EP-F18  | EP-F19  | EP-F20  | EP-F21  | EP-F22  | EP-F23  |               |
|-----------------------|---------|---------|---------|---------|---------|---------|---------|---------|---------|---------|---------------|
| Grid Location         | F, 11   | F, 12   | F, 16   | F, 17   | F, 18   | F, 19   | F, 20   | F, 21   | F, 22   | F, 23   | NYSDEC        |
| Sample Depth (feet)   | 1       | 1       | 1       | 1       | 1       | 1       | 1       | 1       | 1       | 1       |               |
| Date of Collection    | 6/6/08  | 6/6/08  | 6/10/08 | 6/10/08 | 6/10/08 | 6/10/08 | 7/1/08  | 6/27/08 | 6/11/08 | 7/1/08  |               |
| Dilution Factor       | 1.0     | 1.0     | 1.0     | 1.0     | 1.0     | 1.0     | 1.0     | 1.0     | 1.0     | 1.0     | Soil Clean-Up |
| Percent Moisture      | 11      | 16      | 5       | 7       | 15      | 11      | 15      | 6       | 9       | 22      | Objective     |
| Units                 | (ug/kg) | (ug/kg) | (ug/kg) | (ug/kg) | (ug/kg) | (ug/kg) | (ug/kg) | (ug/kg) | (ug/kg) | (ug/kg) | (ug/kg)       |
| Aroclor-1016          | 530 U   | 610 U   | 510 U   | 520 U   | 560 U   | 540 U   | 570 U   | 530 U   | 560 U   | 630 U   | 1,000         |
| Aroclor-1221          | 530 U   | 610 U   | 510 U   | 520 U   | 560 U   | 540 U   | 570 U   | 530 U   | 560 U   | 630 U   | 1,000         |
| Aroclor-1232          | 530 U   | 610 U   | 510 U   | 520 U   | 560 U   | 540 U   | 570 U   | 530 U   | 560 U   | 630 U   | 1,000         |
| Aroclor-1242          | 530 U   | 610 U   | 510 U   | 520 U   | 560 U   | 540 U   | 570 U   | 530 U   | 560 U   | 630 U   | 1,000         |
| Aroclor-1248          | 530 U   | 610 U   | 510 U   | 520 U   | 560 U   | 540 U   | 570 U   | 530 U   | 560 U   | 630 U   | 1,000         |
| Aroclor-1254          | 530 U   | 610 U   | 510 U   | 520 U   | 560 U   | 540 U   | 570 U   | 530 U   | 560 U   | 630 U   | 1,000         |
| Aroclor-1260          | 530 U   | 610 U   | 510 U   | 520 U   | 560 U   | 540 U   | 570 U   | 530 U   | 560 U   | 630 U   | 1,000         |
| <b>Total PCBs</b>     | ---     | ---     | ---     | ---     | ---     | ---     | ---     | ---     | ---     | ---     | 1,000         |

| Sample Identification | EP-F24       | EP-F24(1) | EP-F24(2) | EP-F24(3) | EP-F24(4) | EP-F24(BUSH) | EP-F25  | EP-F26  | EP-G1        | EP-G1(1) |               |
|-----------------------|--------------|-----------|-----------|-----------|-----------|--------------|---------|---------|--------------|----------|---------------|
| Grid Location         | F, 24        | F, 24     | F, 24     | F, 24     | F, 24     | F, 24        | F, 25   | F, 26   | G, 1         | G, 1     | NYSDEC        |
| Sample Depth (feet)   | 1            | 1         | 1         | 1         | 1         | 1            | 1       | 1       | 1            | 1        |               |
| Date of Collection    | 6/26/08      | 7/1/08    | 7/1/08    | 7/1/08    | 7/1/08    | 8/20/08      | 8/19/08 | 8/19/08 | 8/28/08      | 9/2/08   |               |
| Dilution Factor       | 1.0          | 1.0       | 1.0       | 1.0       | 1.0       | 1.0          | 1.0     | 1.0     | 1.0          | 1.0      | Soil Clean-Up |
| Percent Moisture      | 23           | 11        | 24        | 19        | 21        | 23           | 26      | 8       | 17           | 12       | Objective     |
| Units                 | (ug/kg)      | (ug/kg)   | (ug/kg)   | (ug/kg)   | (ug/kg)   | (ug/kg)      | (ug/kg) | (ug/kg) | (ug/kg)      | (ug/kg)  | (ug/kg)       |
| Aroclor-1016          | 600 U        | 560 U     | 670 U     | 580 U     | 630 U     | 660 U        | 660 U   | 550 U   | 600 U        | 580 U    | 1,000         |
| Aroclor-1221          | 600 U        | 560 U     | 670 U     | 580 U     | 630 U     | 660 U        | 660 U   | 550 U   | 600 U        | 580 U    | 1,000         |
| Aroclor-1232          | 600 U        | 560 U     | 670 U     | 580 U     | 630 U     | 660 U        | 660 U   | 550 U   | 600 U        | 580 U    | 1,000         |
| Aroclor-1242          | 600 U        | 560 U     | 670 U     | 580 U     | 630 U     | 660 U        | 660 U   | 550 U   | 600 U        | 580 U    | 1,000         |
| Aroclor-1248          | 600 U        | 560 U     | 670 U     | 580 U     | 630 U     | 660 U        | 660 U   | 550 U   | 600 U        | 580 U    | 1,000         |
| Aroclor-1254          | 600 U        | 560 U     | 670 U     | 580 U     | 630 U     | 660 U        | 660 U   | 550 U   | 600 U        | 580 U    | 1,000         |
| Aroclor-1260          | <b>1,300</b> | 560 U     | 670 U     | 580 U     | 630 U     | 660 U        | 660 U   | 550 U   | <b>1,000</b> | 580 U    | 1,000         |
| <b>Total PCBs</b>     | <b>1,300</b> | ---       | ---       | ---       | ---       | ---          | ---     | ---     | <b>1,000</b> | ---      | 1,000         |

**QUALIFIERS:**

- B: Compound found in the method blank as well as the sample
- D: Result taken from a reanalysis at a secondary dilution
- J: Compound found at a concentration below the CRDL, value estimated
- U: Compound analyzed for but not detected

**NOTES:**

- All concentrations are in micrograms per kilogram (ug/kg) or parts per billion (ppb)
- 1: 6 NYCRR PART 375 - Table 375-6.8(a): Unrestricted Use Soil Cleanup Objectives (SCOs)
- Indicates value exceeds standard or guidance value

**FORMER BOUCHARD JUNKYARD SITE  
FINAL REMEDIATION REPORT  
POST-EXCAVATION SOIL SAMPLE RESULTS  
POLYCHLORINATED BIPHENYLS**

| Sample Identification | EP-G1(2) | EP-G1(T17) | EP-G2   | EP-G3   | EP-G4   | EP-G5   | EP-G6   | EP-G7   | EP-H8 * | EP-G9   |   |       |
|-----------------------|----------|------------|---------|---------|---------|---------|---------|---------|---------|---------|---|-------|
| Grid Location         | G, 1     | G, 1       | G, 2    | G, 3    | G, 4    | G, 5    | G, 6    | G, 7    | G, 8    | G, 9    | NYSDEC<br>Unrestricted Use<br>Soil Clean-Up<br>Objective<br>(ug/kg) |       |
| Sample Depth (feet)   | 1        | 1          | 1       | 1       | 1       | 1       | 1       | 1       | 1       | 1       |   |       |
| Date of Collection    | 9/2/08   | 9/29/08    | 5/23/08 | 5/28/08 | 5/28/08 | 5/29/08 | 5/29/08 | 5/30/08 | 6/2/08  | 6/10/08 |   |       |
| Dilution Factor       | 1.0      | 1.0        | 1.0     | 1.0     | 1.0     | 1.0     | 1.0     | 1.0     | 1.0     | 1.0     |   |       |
| Percent Moisture      | 16       | 21         | 18      | 11      | 10      | 18      | 16      | 16      | 17      | 11      |   |       |
| Units                 | (ug/kg)  | (ug/kg)    | (ug/kg) | (ug/kg) | (ug/kg) | (ug/kg) | (ug/kg) | (ug/kg) | (ug/kg) | (ug/kg) |   |       |
| Aroclor-1016          | 560 U    | 600 U      | 590 U   | 570 U   | 560 U   | 620 U   | 600 U   | 530 U   | 550 U   | 520 U   |   | 1,000 |
| Aroclor-1221          | 560 U    | 600 U      | 590 U   | 570 U   | 560 U   | 620 U   | 600 U   | 530 U   | 550 U   | 520 U   |   | 1,000 |
| Aroclor-1232          | 560 U    | 600 U      | 590 U   | 570 U   | 560 U   | 620 U   | 600 U   | 530 U   | 550 U   | 520 U   |   | 1,000 |
| Aroclor-1242          | 560 U    | 600 U      | 590 U   | 570 U   | 560 U   | 620 U   | 600 U   | 530 U   | 550 U   | 520 U   |   | 1,000 |
| Aroclor-1248          | 560 U    | 600 U      | 590 U   | 570 U   | 560 U   | 620 U   | 600 U   | 530 U   | 550 U   | 520 U   | 1,000   |       |
| Aroclor-1254          | 560 U    | 600 U      | 590 U   | 570 U   | 560 U   | 620 U   | 600 U   | 530 U   | 550 U   | 520 U   | 1,000   |       |
| Aroclor-1260          | 720      | 600 U      | 590 U   | 570 U   | 560 U   | 620 U   | 600 U   | 530 U   | 550 U   | 520 U   | 1,000   |       |
| <b>Total PCBs</b>     | 720      | ----       | ----    | ----    | ----    | ----    | ----    | ----    | ----    | ----    | 1,000   |       |

| Sample Identification | EP-G10  | EP-G11  | EP-G12  | EP-G15  | EP-G15(T4) | EP-G16  | EP-G16(T4) | EP-G17       | EP-G17(1) | EP-G17(2) |   |       |
|-----------------------|---------|---------|---------|---------|------------|---------|------------|--------------|-----------|-----------|---|-------|
| Grid Location         | G, 10   | G, 11   | G, 12   | G, 15   | G, 15      | G, 16   | G, 16      | G, 17        | G, 17     | G, 17     | NYSDEC<br>Unrestricted Use<br>Soil Clean-Up<br>Objective<br>(ug/kg) |       |
| Sample Depth (feet)   | 1       | 1       | 1       | 1       | 1          | 1       | 1          | 1            | 1         | 1         |   |       |
| Date of Collection    | 6/6/08  | 6/6/08  | 6/6/08  | 6/10/08 | 8/20/08    | 7/14/08 | 8/20/08    | 7/14/08      | 7/16/08   | 7/16/08   |   |       |
| Dilution Factor       | 1.0     | 1.0     | 1.0     | 1.0     | 1.0        | 1.0     | 1.0        | 1.0          | 1.0       | 1.0       |   |       |
| Percent Moisture      | 14      | 11      | 19      | 6       | 11         | 9       | 5          | 9            | 13        | 17        |   |       |
| Units                 | (ug/kg) | (ug/kg) | (ug/kg) | (ug/kg) | (ug/kg)    | (ug/kg) | (ug/kg)    | (ug/kg)      | (ug/kg)   | (ug/kg)   |   |       |
| Aroclor-1016          | 570 U   | 560 U   | 620 U   | 510 U   | 560 U      | 500 U   | 520 U      | 540 U        | 590 U     | 610 U     |   | 1,000 |
| Aroclor-1221          | 570 U   | 560 U   | 620 U   | 510 U   | 560 U      | 500 U   | 520 U      | 540 U        | 590 U     | 610 U     |   | 1,000 |
| Aroclor-1232          | 570 U   | 560 U   | 620 U   | 510 U   | 560 U      | 500 U   | 520 U      | 540 U        | 590 U     | 610 U     |   | 1,000 |
| Aroclor-1242          | 570 U   | 560 U   | 620 U   | 510 U   | 560 U      | 500 U   | 520 U      | 540 U        | 590 U     | 610 U     |   | 1,000 |
| Aroclor-1248          | 570 U   | 560 U   | 620 U   | 510 U   | 560 U      | 500 U   | 520 U      | 540 U        | 590 U     | 610 U     | 1,000   |       |
| Aroclor-1254          | 570 U   | 560 U   | 620 U   | 510 U   | 560 U      | 500 U   | 520 U      | 540 U        | 590 U     | 610 U     | 1,000   |       |
| Aroclor-1260          | 570 U   | 560 U   | 620 U   | 510 U   | 560 U      | 500 U   | 520 U      | <b>1,700</b> | 590 U     | 610 U     | 1,000   |       |
| <b>Total PCBs</b>     | ----    | ----    | ----    | ----    | ----       | ----    | ----       | <b>1,700</b> | ----      | ----      | 1,000   |       |

**QUALIFIERS:**

- B: Compound found in the method blank as well as the sample
- D: Result taken from a reanalysis at a secondary dilution
- J: Compound found at a concentration below the CRDL, value estimated
- U: Compound analyzed for but not detected

**NOTES:**

- All concentrations are in micrograms per kilogram (ug/kg) or parts per billion (ppb)
- 1: 6 NYCRR PART 375 - Table 375-6.8(a): Unrestricted Use Soil Cleanup Objectives (SCOs)
- \* Sample labeled incorrectly in the field
- Indicates value exceeds standard or guidance value

**FORMER BOUCHARD JUNKYARD SITE  
FINAL REMEDIATION REPORT  
POST-EXCAVATION SOIL SAMPLE RESULTS  
POLYCHLORINATED BIPHENYLS**

| Sample Identification | EP-G17(3) | EP-G17(4)    | EP-G17A | EP-G18  | EP-G19(T2) | EP-G19       | EP-G19(A) | EP-G20 (T2) | EP-G20(N TSCA) | EP-G21  |               |
|-----------------------|-----------|--------------|---------|---------|------------|--------------|-----------|-------------|----------------|---------|---------------|
| Grid Location         | G, 17     | G, 17        | G, 17   | G, 18   | G, 19      | G, 19        | G, 19     | G, 20       | G, 20          | G, 21   | NYSDEC        |
| Sample Depth (feet)   | 1         | 1            | 1.5     | 1       | 1          | 1            | 1.5       | 1           | 1              | 1       |               |
| Date of Collection    | 7/16/08   | 7/16/08      | 7/22/08 | 7/9/08  | 6/30/08    | 7/7/08       | 7/9/08    | 6/30/08     | 7/1/08         | 7/1/08  |               |
| Dilution Factor       | 1.0       | 1.0          | 1.0     | 1.0     | 1.0        | 1.0          | 1.0       | 1.0         | 1.0            | 1.0     | Soil Clean-Up |
| Percent Moisture      | 10        | 9            | 9       | 11      | 13         | 13           | 7         | 6           | 6              | 12      | Objective     |
| Units                 | (ug/kg)   | (ug/kg)      | (ug/kg) | (ug/kg) | (ug/kg)    | (ug/kg)      | (ug/kg)   | (ug/kg)     | (ug/kg)        | (ug/kg) | (ug/kg)       |
| Aroclor-1016          | 560 U     | 550 U        | 540 U   | 570 U   | 570 U      | 590 U        | 550 U     | 490 U       | 540 U          | 560 U   | 1,000         |
| Aroclor-1221          | 560 U     | 550 U        | 540 U   | 570 U   | 570 U      | 590 U        | 550 U     | 490 U       | 540 U          | 560 U   | 1,000         |
| Aroclor-1232          | 560 U     | 550 U        | 540 U   | 570 U   | 570 U      | 590 U        | 550 U     | 490 U       | 540 U          | 560 U   | 1,000         |
| Aroclor-1242          | 560 U     | 550 U        | 540 U   | 570 U   | 570 U      | 590 U        | 550 U     | 490 U       | 540 U          | 560 U   | 1,000         |
| Aroclor-1248          | 560 U     | 550 U        | 540 U   | 570 U   | 570 U      | 590 U        | 550 U     | 490 U       | 540 U          | 560 U   | 1,000         |
| Aroclor-1254          | 560 U     | 550 U        | 540 U   | 570 U   | 570 U      | 590 U        | 550 U     | 490 U       | 540 U          | 560 U   | 1,000         |
| Aroclor-1260          | 560 U     | <b>1,300</b> | 990     | 570 U   | 570 U      | <b>8,300</b> | 550 U     | 490 U       | 540 U          | 560 U   | 1,000         |
| <b>Total PCBs</b>     | ----      | <b>1,300</b> | 990     | ----    | ----       | <b>8,300</b> | ----      | ----        | ----           | ----    | 1,000         |

| Sample Identification | EP-G22  | EP-G23  | EP-G24  | EP-G25  | EP-G25(TREE) | EP-G26  | EP-H1        | EP-H1(1) | EP-H1(2)     | EP-H1A  |               |
|-----------------------|---------|---------|---------|---------|--------------|---------|--------------|----------|--------------|---------|---------------|
| Grid Location         | G, 22   | G, 23   | G, 24   | G, 25   | G, 25        | G, 26   | H, 1         | H, 1     | H, 1         | H, 1    | NYSDEC        |
| Sample Depth (feet)   | 1       | 1       | 1       | 1       | 1            | 1       | 1            | 1        | 1            | 1.5     |               |
| Date of Collection    | 6/11/08 | 7/1/08  | 6/26/08 | 6/26/08 | 6/26/08      | 6/25/08 | 8/29/08      | 9/2/08   | 9/2/08       | 9/11/08 |               |
| Dilution Factor       | 1.0     | 1.0     | 1.0     | 1.0     | 1.0          | 1.0     | 1.0          | 1.0      | 1.0          | 1.0     | Soil Clean-Up |
| Percent Moisture      | 6       | 14      | 5       | 17      | 19           | 17      | 14           | 20       | 7            | 22      | Objective     |
| Units                 | (ug/kg) | (ug/kg) | (ug/kg) | (ug/kg) | (ug/kg)      | (ug/kg) | (ug/kg)      | (ug/kg)  | (ug/kg)      | (ug/kg) | (ug/kg)       |
| Aroclor-1016          | 490 U   | 540 U   | 500 U   | 560 U   | 610 U        | 600 U   | 540 U        | 630 U    | 550 U        | 570 U   | 1,000         |
| Aroclor-1221          | 490 U   | 540 U   | 500 U   | 560 U   | 610 U        | 600 U   | 540 U        | 630 U    | 550 U        | 570 U   | 1,000         |
| Aroclor-1232          | 490 U   | 540 U   | 500 U   | 560 U   | 610 U        | 600 U   | 540 U        | 630 U    | 550 U        | 570 U   | 1,000         |
| Aroclor-1242          | 490 U   | 540 U   | 500 U   | 560 U   | 610 U        | 600 U   | 540 U        | 630 U    | 550 U        | 570 U   | 1,000         |
| Aroclor-1248          | 490 U   | 540 U   | 500 U   | 560 U   | 610 U        | 600 U   | 540 U        | 630 U    | 550 U        | 570 U   | 1,000         |
| Aroclor-1254          | 490 U   | 540 U   | 500 U   | 560 U   | 610 U        | 600 U   | 540 U        | 630 U    | 550 U        | 570 U   | 1,000         |
| Aroclor-1260          | 490 U   | 540 U   | 500 U   | 560 U   | 610 U        | 600 U   | <b>1,300</b> | 630 U    | <b>1,400</b> | 570 U   | 1,000         |
| <b>Total PCBs</b>     | ----    | ----    | ----    | ----    | ----         | ----    | <b>1,300</b> | ----     | <b>1,400</b> | ----    | 1,000         |

**QUALIFIERS:**

- B: Compound found in the method blank as well as the sample
- D: Result taken from a reanalysis at a secondary dilution
- J: Compound found at a concentration below the CRDL, value estimated
- U: Compound analyzed for but not detected

**NOTES:**

- All concentrations are in micrograms per kilogram (ug/kg) or parts per billion (ppb)
- 1: 6 NYCRR PART 375 - Table 375-6.8(a): Unrestricted Use Soil Cleanup Objectives (SCOs)
- Indicates value exceeds standard or guidance value

**FORMER BOUCHARD JUNKYARD SITE  
FINAL REMEDIATION REPORT  
POST-EXCAVATION SOIL SAMPLE RESULTS  
POLYCHLORINATED BIPHENYLS**

| Sample Identification | EP-H1(T17)(96) | EP-H2   | EP-H3   | EP-H4   | EP-H5   | EP-H6   | EP-H7   | EP-H7(2) | EP-H7A  | EP-H7(T13) |               |
|-----------------------|----------------|---------|---------|---------|---------|---------|---------|----------|---------|------------|---------------|
| Grid Location         | H, 1           | H, 2    | H, 3    | H, 4    | H, 5    | H, 6    | H, 7    | H, 7     | H, 7    | H, 7       | NYSDEC        |
| Sample Depth (feet)   | 8              | 1       | 1       | 1       | 1       | 1       | 1.5     | 1.5      | 2       | 6          |               |
| Date of Collection    | 9/30/08        | 5/23/08 | 5/23/08 | 5/23/08 | 5/23/08 | 5/23/08 | 5/30/08 | 6/6/08   | 9/2/08  | 9/18/08    |               |
| Dilution Factor       | 1.0            | 1.0     | 1.0     | 1.0     | 1.0     | 1.0     | 1.0     | 1.0      | 1.0     | 1.0        | Soil Clean-Up |
| Percent Moisture      | 22             | 27      | 19      | 11      | 16      | 13      | 5       | 21       | 7       | 19         | Objective     |
| Units                 | (ug/kg)        | (ug/kg) | (ug/kg) | (ug/kg) | (ug/kg) | (ug/kg) | (ug/kg) | (ug/kg)  | (ug/kg) | (ug/kg)    | (ug/kg)       |
| Aroclor-1016          | 650 U          | 700 U   | 620 U   | 550 U   | 580 U   | 560 U   | 500 U   | 610 U    | 540 U   | 590 U      | 1,000         |
| Aroclor-1221          | 650 U          | 700 U   | 620 U   | 550 U   | 580 U   | 560 U   | 500 U   | 610 U    | 540 U   | 590 U      | 1,000         |
| Aroclor-1232          | 650 U          | 700 U   | 620 U   | 550 U   | 580 U   | 560 U   | 500 U   | 610 U    | 540 U   | 590 U      | 1,000         |
| Aroclor-1242          | 650 U          | 700 U   | 620 U   | 550 U   | 580 U   | 560 U   | 500 U   | 610 U    | 540 U   | 590 U      | 1,000         |
| Aroclor-1248          | 650 U          | 700 U   | 620 U   | 550 U   | 580 U   | 560 U   | 500 U   | 610 U    | 540 U   | 590 U      | 1,000         |
| Aroclor-1254          | 650 U          | 700 U   | 620 U   | 550 U   | 580 U   | 560 U   | 500 U   | 610 U    | 540 U   | 590 U      | 1,000         |
| Aroclor-1260          | 650 U          | 700 U   | 620 U   | 550 U   | 580 U   | 560 U   | 1,200   | 610 U    | 540 U   | 590 U      | 1,000         |
| <b>Total PCBs</b>     | ----           | ----    | ----    | ----    | ----    | ----    | 1,200   | ----     | ----    | ----       | 1,000         |

| Sample Identification | EP-G8 *   | EP-H8A  | EP-H8(T13) | EP-H9   | EP-H10  | EP-H10(T10) | EP-H10(T10A) | EP-H10(T10B) | EP-H11  | EP-H11(T10) |               |
|-----------------------|-----------|---------|------------|---------|---------|-------------|--------------|--------------|---------|-------------|---------------|
| Grid Location         | H, 8      | H, 8    | H, 8       | H, 9    | H, 10   | H, 10       | H, 10        | H, 10        | H, 11   | H, 11       | NYSDEC        |
| Sample Depth (feet)   | 1         | 6       | 6          | 1       | 1       | 1           | 1.5          | 2            | 1       | 1           |               |
| Date of Collection    | 6/2/08    | 6/6/08  | 9/18/08    | 6/10/08 | 6/10/08 | 9/12/08     | 10/10/08     | 10/17/08     | 6/18/08 | 9/12/08     |               |
| Dilution Factor       | 1.0       | 1.0     | 1.0        | 1.0     | 1.0     | 1.0         | 1.0          | 1.0          | 1.0     | 1.0         | Soil Clean-Up |
| Percent Moisture      | 9         | 19      | 12         | 16      | 18      | 8           | 10           | 7            | 19      |             | Objective     |
| Units                 | (ug/kg)   | (ug/kg) | (ug/kg)    | (ug/kg) | (ug/kg) | (ug/kg)     | (ug/kg)      | (ug/kg)      | (ug/kg) | (ug/kg)     | (ug/kg)       |
| Aroclor-1016          | 560 U     | 630 U   | 570 U      | 540 U   | 610 U   | 530 U       | 570 U        | 520 U        | 620 U   | 540 U       | 1,000         |
| Aroclor-1221          | 560 U     | 630 U   | 570 U      | 540 U   | 610 U   | 530 U       | 570 U        | 520 U        | 620 U   | 540 U       | 1,000         |
| Aroclor-1232          | 560 U     | 630 U   | 570 U      | 540 U   | 610 U   | 530 U       | 570 U        | 520 U        | 620 U   | 540 U       | 1,000         |
| Aroclor-1242          | 560 U     | 630 U   | 570 U      | 540 U   | 610 U   | 530 U       | 570 U        | 520 U        | 620 U   | 540 U       | 1,000         |
| Aroclor-1248          | 560 U     | 630 U   | 570 U      | 540 U   | 610 U   | 530 U       | 570 U        | 520 U        | 620 U   | 540 U       | 1,000         |
| Aroclor-1254          | 560 U     | 630 U   | 570 U      | 540 U   | 610 U   | 530 U       | 570 U        | 520 U        | 620 U   | 540 U       | 1,000         |
| Aroclor-1260          | 130,000 E | 630 U   | 570 U      | 540 U   | 610 U   | 1,200       | 1,200        | 520 U        | 620 U   | 3,900       | 1,000         |
| <b>Total PCBs</b>     | 130,000   | ----    | ----       | ----    | ----    | 1,200       | 1,200        | ----         | ----    | 3,900       | 1,000         |

**QUALIFIERS:**

- B: Compound found in the method blank as well as the sample
- D: Result taken from a reanalysis at a secondary dilution
- J: Compound found at a concentration below the CRDL, value estimated
- U: Compound analyzed for but not detected
- E: Compound concentration exceeds the calibration range for analysis

**NOTES:**

- All concentrations are in micrograms per kilogram (ug/kg) or parts per billion (ppb)
- 1: 6 NYCRR PART 375 - Table 375-6.8(a): Unrestricted Use Soil Cleanup Objectives (SCOs)
- \* Sample labeled incorrectly in the field
- Indicates value exceeds standard or guidance value

FORMER BOUCHARD JUNKYARD SITE  
FINAL REMEDIATION REPORT  
POST-EXCAVATION SOIL SAMPLE RESULTS  
POLYCHLORINATED BIPHENYLS

| Sample Identification | EP-H11(T10A) | EP-H12  | EP-H13  | EP-H14(12) | EP-H14(12)(1) | EP-H14(12)(2) | EP-H14(18) | EP-H15(18) | EP-H15(12) | EP-H15(12)(1) |               |
|-----------------------|--------------|---------|---------|------------|---------------|---------------|------------|------------|------------|---------------|---------------|
| Grid Location         | H, 11        | H, 12   | H, 13   | H, 14      | H, 14         | H, 14         | H, 14      | H, 15      | H, 15      | H, 15         | NYSDEC        |
| Sample Depth (feet)   | 1.5          | 1       | 1       | 1          | 1             | 1             | 1          | 1.5        | 1          | 1             |               |
| Date of Collection    | 10/10/08     | 7/22/08 | 7/22/08 | 7/15/08    | 7/18/08       | 7/18/08       | 7/18/08    | 7/18/08    | 7/22/08    | 7/28/08       |               |
| Dilution Factor       | 1.0          | 1.0     | 1.0     | 1.0        | 1.0           | 1.0           | 1.0        | 1.0        | 1.0        | 1.0           | Soil Clean-Up |
| Percent Moisture      | 4            | 14      | 3       | 19         | 29            | 13            | 4          | 7          | 15         | 23            | Objective     |
| Units                 | (ug/kg)      | (ug/kg) | (ug/kg) | (ug/kg)    | (ug/kg)       | (ug/kg)       | (ug/kg)    | (ug/kg)    | (ug/kg)    | (ug/kg)       | (ug/kg)       |
| Aroclor-1016          | 530 U        | 570 U   | 510 U   | 570 U      | 720 U         | 550 U         | 530 U      | 550 U      | 580 U      | 590 U         | 1,000         |
| Aroclor-1221          | 530 U        | 570 U   | 510 U   | 570 U      | 720 U         | 550 U         | 530 U      | 550 U      | 580 U      | 590 U         | 1,000         |
| Aroclor-1232          | 530 U        | 570 U   | 510 U   | 570 U      | 720 U         | 550 U         | 530 U      | 550 U      | 580 U      | 590 U         | 1,000         |
| Aroclor-1242          | 530 U        | 570 U   | 510 U   | 570 U      | 720 U         | 550 U         | 530 U      | 550 U      | 580 U      | 590 U         | 1,000         |
| Aroclor-1248          | 530 U        | 570 U   | 510 U   | 570 U      | 720 U         | 550 U         | 530 U      | 550 U      | 580 U      | 590 U         | 1,000         |
| Aroclor-1254          | 530 U        | 570 U   | 510 U   | 570 U      | 720 U         | 550 U         | 530 U      | 550 U      | 580 U      | 590 U         | 1,000         |
| Aroclor-1260          | 530 U        | 570 U   | 510 U   | 1,200      | 770           | 550 U         | 680        | 7,700      | 1,400      | 590 U         | 1,000         |
| <b>Total PCBs</b>     | ----         | ----    | ----    | 1,200      | 770           | ----          | 680        | 7,700      | 1,400      | ----          | 1,000         |

| Sample Identification | EP-H15(12)(2) | EP-H15(12A) | EP-H15(12B) | EP-H15(T4) | EP-H15(T4A) | EP-H16  | EP-H16A | EP-H16(T4) | EP-H17  | EP-H17(1) |               |
|-----------------------|---------------|-------------|-------------|------------|-------------|---------|---------|------------|---------|-----------|---------------|
| Grid Location         | H, 15         | H, 15       | H, 15       | H, 15      | H, 15       | H, 16   | H, 16   | H, 16      | H, 17   | H, 17     | NYSDEC        |
| Sample Depth (feet)   | 1             | 1.5         | 2           | 1          | 1.5         | 1       | 1.5     | 1          | 1       | 1         |               |
| Date of Collection    | 7/28/08       | 8/7/08      | 8/18/08     | 8/25/08    | 9/2/08      | 7/16/08 | 7/22/08 | 8/20/08    | 7/14/08 | 7/16/08   |               |
| Dilution Factor       | 1.0           | 1.0         | 1.0         | 1.0        | 1.0         | 1.0     | 1.0     | 1.0        | 1.0     | 1.0       | Soil Clean-Up |
| Percent Moisture      | 13            | 13          | 14          | 9          | 17          | 23      | 13      | 13         | 15      | 20        | Objective     |
| Units                 | (ug/kg)       | (ug/kg)     | (ug/kg)     | (ug/kg)    | (ug/kg)     | (ug/kg) | (ug/kg) | (ug/kg)    | (ug/kg) | (ug/kg)   | (ug/kg)       |
| Aroclor-1016          | 590 U         | 540 U       | 580 U       | 540 U      | 600 U       | 640 U   | 570 U   | 540 U      | 570 U   | 630 U     | 1,000         |
| Aroclor-1221          | 590 U         | 540 U       | 580 U       | 540 U      | 600 U       | 640 U   | 570 U   | 540 U      | 570 U   | 630 U     | 1,000         |
| Aroclor-1232          | 590 U         | 540 U       | 580 U       | 540 U      | 600 U       | 640 U   | 570 U   | 540 U      | 570 U   | 630 U     | 1,000         |
| Aroclor-1242          | 590 U         | 540 U       | 580 U       | 540 U      | 600 U       | 640 U   | 570 U   | 540 U      | 570 U   | 630 U     | 1,000         |
| Aroclor-1248          | 590 U         | 540 U       | 580 U       | 540 U      | 600 U       | 640 U   | 570 U   | 540 U      | 570 U   | 630 U     | 1,000         |
| Aroclor-1254          | 590 U         | 540 U       | 580 U       | 540 U      | 600 U       | 640 U   | 570 U   | 540 U      | 570 U   | 630 U     | 1,000         |
| Aroclor-1260          | 4,000         | 1,800       | 580 U       | 4,500      | 660         | 6,600   | 610 P   | 540 U      | 1,900   | 1,600     | 1,000         |
| <b>Total PCBs</b>     | 4,000         | 1,800       | ----        | 4,500      | 660         | 6,600   | 610     | ----       | 1,900   | 1,600     | 1,000         |

QUALIFIERS:

- B: Compound found in the method blank as well as the sample
- D: Result taken from a reanalysis at a secondary dilution
- J: Compound found at a concentration below the CRDL, value estimated
- U: Compound analyzed for but not detected
- P: Greater than 25% difference for detected concentrations between the two GC columns

NOTES:

- All concentrations are in micrograms per kilogram (ug/kg) or parts per billion (ppb)
- 1: 6 NYCRR PART 375 - Table 375-6.8(a): Unrestricted Use Soil Cleanup Objectives (SCOs)
- Indicates value exceeds standard or guidance value

**FORMER BOUCHARD JUNKYARD SITE  
FINAL REMEDIATION REPORT  
POST-EXCAVATION SOIL SAMPLE RESULTS  
POLYCHLORINATED BIPHENYLS**

| Sample Identification | EP-H17(2) | EP-H17(3) | EP-H17(4)    | EP-H17A         | EP-H17B       | EP-H17C | EP-H18       | EP-H18A      | EP-H18B | EP-H19  |               |
|-----------------------|-----------|-----------|--------------|-----------------|---------------|---------|--------------|--------------|---------|---------|---------------|
| Grid Location         | H, 17     | H, 17     | H, 17        | H, 17           | H, 17         | H, 17   | H, 18        | H, 18        | H, 18   | H, 19   | NYSDEC        |
| Sample Depth (feet)   | 1         | 1         | 1            | 1.5             | 2.5           | 3       | 1            | 1.5          | 2.5     | 1       |               |
| Date of Collection    | 7/16/08   | 7/16/08   | 7/16/08      | 7/22/08         | 8/7/08        | 8/18/08 | 7/1/08       | 7/9/08       | 8/21/08 | 6/27/08 |               |
| Dilution Factor       | 1.0       | 1.0       | 1.0          | 1.0             | 1.0           | 1.0     | 1.0          | 1.0          | 1.0     | 1.0     | Soil Clean-Up |
| Percent Moisture      | 13        | 29        | 11           | 8               | 11            | 17      | 12           | 17           | 7       | 10      | Objective     |
| Units                 | (ug/kg)   | (ug/kg)   | (ug/kg)      | (ug/kg)         | (ug/kg)       | (ug/kg) | (ug/kg)      | (ug/kg)      | (ug/kg) | (ug/kg) | (ug/kg)       |
| Aroclor-1016          | 570 U     | 700 U     | 570 U        | 530 U           | 550 U         | 580 U   | 570 U        | 580 U        | 520 U   | 540 U   | 1,000         |
| Aroclor-1221          | 570 U     | 700 U     | 570 U        | 530 U           | 550 U         | 580 U   | 570 U        | 580 U        | 520 U   | 540 U   | 1,000         |
| Aroclor-1232          | 570 U     | 700 U     | 570 U        | 530 U           | 550 U         | 580 U   | 570 U        | 580 U        | 520 U   | 540 U   | 1,000         |
| Aroclor-1242          | 570 U     | 700 U     | 570 U        | 530 U           | 550 U         | 580 U   | 570 U        | 580 U        | 520 U   | 540 U   | 1,000         |
| Aroclor-1248          | 570 U     | 700 U     | 570 U        | 530 U           | 550 U         | 580 U   | 570 U        | 580 U        | 520 U   | 540 U   | 1,000         |
| Aroclor-1254          | 570 U     | 700 U     | 570 U        | 530 U           | 550 U         | 580 U   | 570 U        | 580 U        | 520 U   | 540 U   | 1,000         |
| Aroclor-1260          | 790       | 700 U     | <b>1,100</b> | <b>90,000 E</b> | <b>11,000</b> | 580 U   | <b>5,000</b> | <b>2,200</b> | 520 U   | 540 U   | 1,000         |
| <b>Total PCBs</b>     | 790       | ----      | <b>1,100</b> | <b>90,000</b>   | <b>11,000</b> | ----    | <b>5,000</b> | <b>2,200</b> | ----    | ----    | 1,000         |

| Sample Identification | EP-H19 (T2) | EP-H20  | EP-H20(T1) | EP-H20(T2)   | EP-H20(T2)(A) | EP-H21        | EP-H21(1) | EP-H21(T1) | EP-H22  | EP-H23  |               |
|-----------------------|-------------|---------|------------|--------------|---------------|---------------|-----------|------------|---------|---------|---------------|
| Grid Location         | H, 19       | H, 20   | H, 20      | H, 20        | H, 20         | H, 21         | H, 21     | H, 21      | H, 22   | H, 23   | NYSDEC        |
| Sample Depth (feet)   | 1           | 1       | 1          | 1            | 1.5           | 1             | 1.5       | 1          | 1       | 1       |               |
| Date of Collection    | 6/30/08     | 6/27/08 | 6/30/08    | 6/30/08      | 7/3/08        | 6/13/08       | 6/17/08   | 6/30/08    | 6/11/08 | 7/7/08  |               |
| Dilution Factor       | 1.0         | 1.0     | 1.0        | 1.0          | 1.0           | 1.0           | 1.0       | 1.0        | 1.0     | 1.0     | Soil Clean-Up |
| Percent Moisture      | 13          | 11      | 21         | 6            | 4             | 7             | 7         | 8          | 6       | 8       | Objective     |
| Units                 | (ug/kg)     | (ug/kg) | (ug/kg)    | (ug/kg)      | (ug/kg)       | (ug/kg)       | (ug/kg)   | (ug/kg)    | (ug/kg) | (ug/kg) | (ug/kg)       |
| Aroclor-1016          | 570 U       | 570 U   | 600 U      | 540 U        | 490 U         | 550 U         | 550 U     | 490 U      | 530 U   | 540 U   | 1,000         |
| Aroclor-1221          | 570 U       | 570 U   | 600 U      | 540 U        | 490 U         | 550 U         | 550 U     | 490 U      | 530 U   | 540 U   | 1,000         |
| Aroclor-1232          | 570 U       | 570 U   | 600 U      | 540 U        | 490 U         | 550 U         | 550 U     | 490 U      | 530 U   | 540 U   | 1,000         |
| Aroclor-1242          | 570 U       | 570 U   | 600 U      | 540 U        | 490 U         | 550 U         | 550 U     | 490 U      | 530 U   | 540 U   | 1,000         |
| Aroclor-1248          | 570 U       | 570 U   | 600 U      | 540 U        | 490 U         | 550 U         | 550 U     | 490 U      | 530 U   | 540 U   | 1,000         |
| Aroclor-1254          | 570 U       | 570 U   | 600 U      | 540 U        | 490 U         | 550 U         | 550 U     | 490 U      | 530 U   | 540 U   | 1,000         |
| Aroclor-1260          | 830         | 570 U   | 600 U      | <b>1,200</b> | 490 U         | <b>29,000</b> | 550 U     | 490 U      | 530 U   | 540 U   | 1,000         |
| <b>Total PCBs</b>     | 830         | ----    | ----       | <b>1,200</b> | ----          | <b>29,000</b> | ----      | ----       | ----    | ----    | 1,000         |

**QUALIFIERS:**

- B: Compound found in the method blank as well as the sample
- D: Result taken from a reanalysis at a secondary dilution
- J: Compound found at a concentration below the CRDL, value estimated
- U: Compound analyzed for but not detected
- E: Compound concentration exceeds the calibration range for analysis

**NOTES:**

- All concentrations are in micrograms per kilogram (ug/kg) or parts per billion (ppb)
- 1: 6 NYCRR PART 375 - Table 375-6.8(a): Unrestricted Use Soil Cleanup Objectives (SCOs)
- Indicates value exceeds standard or guidance value

**FORMER BOUCHARD JUNKYARD SITE  
FINAL REMEDIATION REPORT  
POST-EXCAVATION SOIL SAMPLE RESULTS  
POLYCHLORINATED BIPHENYLS**

| Sample Identification | EP-H24  | EP-H25  | EP-H26  | EP-I1   | EP-I1(T17) | EP-I2   | EP-I3   | EP-I3A(1) | EP-I3A(2) | EP-I3A(3) |                            |
|-----------------------|---------|---------|---------|---------|------------|---------|---------|-----------|-----------|-----------|----------------------------|
| Grid Location         | H, 24   | H, 25   | H, 26   | I, 1    | I, 1       | I, 2    | I, 3    | I, 3      | I, 3      | I, 3      | NYSDEC<br>Unrestricted Use |
| Sample Depth (feet)   | 1       | 1       | 1       | 1       | 1          | 1       | 1       | 1         | 1         | 1         |                            |
| Date of Collection    | 6/26/08 | 6/26/08 | 6/25/08 | 5/21/08 | 7/16/08    | 5/21/08 | 5/21/08 | 5/27/08   | 5/27/08   | 5/27/08   |                            |
| Dilution Factor       | 1.0     | 1.0     | 1.0     | 1.0     | 1.0        | 1.0     | 1.0     | 1.0       | 1.0       | 1.0       |                            |
| Percent Moisture      | 16      | 7       | 7       | 16      | 8          | 9       | 19      | 17        | 26        | 14        | Objective                  |
| Units                 | (ug/kg) | (ug/kg) | (ug/kg) | (ug/kg) | (ug/kg)    | (ug/kg) | (ug/kg) | (ug/kg)   | (ug/kg)   | (ug/kg)   | (ug/kg)                    |
| Aroclor-1016          | 550 U   | 500 U   | 510 U   | 570 U   | 550 U      | 550 U   | 610 U   | 610 U     | 680 U     | 590 U     | 1,000                      |
| Aroclor-1221          | 550 U   | 500 U   | 510 U   | 570 U   | 550 U      | 550 U   | 610 U   | 610 U     | 680 U     | 590 U     | 1,000                      |
| Aroclor-1232          | 550 U   | 500 U   | 510 U   | 570 U   | 550 U      | 550 U   | 610 U   | 610 U     | 680 U     | 590 U     | 1,000                      |
| Aroclor-1242          | 550 U   | 500 U   | 510 U   | 570 U   | 550 U      | 550 U   | 610 U   | 610 U     | 680 U     | 590 U     | 1,000                      |
| Aroclor-1248          | 550 U   | 500 U   | 510 U   | 570 U   | 550 U      | 550 U   | 610 U   | 610 U     | 680 U     | 590 U     | 1,000                      |
| Aroclor-1254          | 550 U   | 500 U   | 510 U   | 570 U   | 550 U      | 550 U   | 610 U   | 610 U     | 680 U     | 590 U     | 1,000                      |
| Aroclor-1260          | 550 U   | 500 U   | 510 U   | 570 U   | 550 U      | 550 U   | 2,000   | 720 P     | 1,400     | 590 U     | 1,000                      |
| <b>Total PCBs</b>     | ---     | ---     | ---     | ---     | ---        | ---     | 2,000   | 720       | 1,400     | ---       | 1,000                      |

| Sample Identification | EP-I3A(4) | EP-I3B  | EP-I4   | EP-I4A(1) | EP-I4A(2) | EP-I4A(3) | EP-I4A(4) | EP-I4B  | EP-I5   | EP-I6   |                            |
|-----------------------|-----------|---------|---------|-----------|-----------|-----------|-----------|---------|---------|---------|----------------------------|
| Grid Location         | I, 3      | I, 3    | I, 4    | I, 4      | I, 4      | I, 4      | I, 4      | I, 4    | I, 5    | I, 6    | NYSDEC<br>Unrestricted Use |
| Sample Depth (feet)   | 1         | 1.5     | 1       | 1         | 1         | 1         | 1         | 1.5     | 1       | 1       |                            |
| Date of Collection    | 5/27/08   | 5/30/08 | 5/21/08 | 5/27/08   | 5/27/08   | 5/27/08   | 5/27/08   | 5/30/08 | 5/23/08 | 5/23/08 |                            |
| Dilution Factor       | 1.0       | 1.0     | 1.0     | 1.0       | 1.0       | 1.0       | 1.0       | 1.0     | 1.0     | 1.0     |                            |
| Percent Moisture      | 25        | 15      | 21      | 13        | 24        | 14        | 19        | 12      | 23      | 23      | Objective                  |
| Units                 | (ug/kg)   | (ug/kg) | (ug/kg) | (ug/kg)   | (ug/kg)   | (ug/kg)   | (ug/kg)   | (ug/kg) | (ug/kg) | (ug/kg) | (ug/kg)                    |
| Aroclor-1016          | 650 U     | 560 U   | 650 U   | 530 U     | 610 U     | 580 U     | 610 U     | 530 U   | 650 U   | 600 U   | 1,000                      |
| Aroclor-1221          | 650 U     | 560 U   | 650 U   | 530 U     | 610 U     | 580 U     | 610 U     | 530 U   | 650 U   | 600 U   | 1,000                      |
| Aroclor-1232          | 650 U     | 560 U   | 650 U   | 530 U     | 610 U     | 580 U     | 610 U     | 530 U   | 650 U   | 600 U   | 1,000                      |
| Aroclor-1242          | 650 U     | 560 U   | 650 U   | 530 U     | 610 U     | 580 U     | 610 U     | 530 U   | 650 U   | 600 U   | 1,000                      |
| Aroclor-1248          | 650 U     | 560 U   | 650 U   | 530 U     | 610 U     | 580 U     | 610 U     | 530 U   | 650 U   | 600 U   | 1,000                      |
| Aroclor-1254          | 650 U     | 560 U   | 650 U   | 530 U     | 610 U     | 580 U     | 610 U     | 530 U   | 650 U   | 600 U   | 1,000                      |
| Aroclor-1260          | 650 U     | 560 U   | 1,500   | 2,200     | 610 U     | 580 U     | 610 U     | 530 U   | 650 U   | 600 U   | 1,000                      |
| <b>Total PCBs</b>     | ---       | ---     | 1,500   | 2,200     | ---       | ---       | ---       | ---     | ---     | ---     | 1,000                      |

**QUALIFIERS:**

- B: Compound found in the method blank as well as the sample
- D: Result taken from a reanalysis at a secondary dilution
- J: Compound found at a concentration below the CRDL, value estimated
- U: Compound analyzed for but not detected
- P: Greater than 25% difference for detected concentrations between the two GC columns

**NOTES:**

- All concentrations are in micrograms per kilogram (ug/kg) or parts per billion (ppb)
- 1: 6 NYCRR PART 375 - Table 375-6.8(a): Unrestricted Use Soil Cleanup Objectives (SCOs)
- Indicates value exceeds standard or guidance value

**FORMER BOUCHARD JUNKYARD SITE  
FINAL REMEDIATION REPORT  
POST-EXCAVATION SOIL SAMPLE RESULTS  
POLYCHLORINATED BIPHENYLS**

| Sample Identification | EP-17        | EP-17A(1)    | EP-17A(2) | EP-17(T13) | EP-18(T13) | EP-18         | EP-18A   | EP-19   | EP-110  | EP-110(T10) |   |       |
|-----------------------|--------------|--------------|-----------|------------|------------|---------------|----------|---------|---------|-------------|---|-------|
| Grid Location         | I, 7         | I, 7         | I, 7      | I, 7       | I, 8       | I, 8          | I, 8     | I, 9    | I, 10   | I, 10       | NYSDEC<br>Unrestricted Use<br>Soil Clean-Up<br>Objective<br>(ug/kg) |       |
| Sample Depth (feet)   | 1            | 1            | 1         | 1          | 1          | 1             | 2        | 1       | 1       | 1           |   |       |
| Date of Collection    | 5/30/08      | 6/2/08       | 6/2/08    | 9/18/08    | 9/22/08    | 9/30/08       | 10/10/08 | 8/4/08  | 6/18/08 | 9/12/08     |   |       |
| Dilution Factor       | 1.0          | 1.0          | 1.0       | 1.0        | 1.0        | 1.0           | 1.0      | 1.0     | 1.0     | 1.0         |   |       |
| Percent Moisture      | 9            | 17           | 10        | 22         | 12         | 13            | 21       | 10      | 10      | 8           |   |       |
| Units                 | (ug/kg)      | (ug/kg)      | (ug/kg)   | (ug/kg)    | (ug/kg)    | (ug/kg)       | (ug/kg)  | (ug/kg) | (ug/kg) | (ug/kg)     |   |       |
| Aroclor-1016          | 530 U        | 600 U        | 520 U     | 640 U      | 550 U      | 590 U         | 600 U    | 540 U   | 530 U   | 550 U       |   | 1,000 |
| Aroclor-1221          | 530 U        | 600 U        | 520 U     | 640 U      | 550 U      | 590 U         | 600 U    | 540 U   | 530 U   | 550 U       |   | 1,000 |
| Aroclor-1232          | 530 U        | 600 U        | 520 U     | 640 U      | 550 U      | 590 U         | 600 U    | 540 U   | 530 U   | 550 U       |   | 1,000 |
| Aroclor-1242          | 530 U        | 600 U        | 520 U     | 640 U      | 550 U      | 590 U         | 600 U    | 540 U   | 530 U   | 550 U       |   | 1,000 |
| Aroclor-1248          | 530 U        | 600 U        | 520 U     | 640 U      | 550 U      | 590 U         | 600 U    | 540 U   | 530 U   | 550 U       | 1,000   |       |
| Aroclor-1254          | 530 U        | 600 U        | 520 U     | 640 U      | 550 U      | 590 U         | 600 U    | 540 U   | 530 U   | 550 U       | 1,000   |       |
| Aroclor-1260          | <b>7,600</b> | <b>3,500</b> | 520 U     | 640 U      | 550 U      | <b>44,000</b> | 600 U    | 900     | 530 U   | 550 U       | 1,000   |       |
| <b>Total PCBs</b>     | <b>7,600</b> | <b>3,500</b> | ---       | ---        | ---        | <b>44,000</b> | ---      | 900     | ---     | ---         | 1,000   |       |

| Sample Identification | EP-111  | EP-111(T10) | EP-112       | EP-112(1)     | EP-112(2) | EP-112(3) | EP-112(4)    | EP-112A | EP-113        | EP-113A |   |       |
|-----------------------|---------|-------------|--------------|---------------|-----------|-----------|--------------|---------|---------------|---------|---|-------|
| Grid Location         | I, 11   | I, 11       | I, 12        | I, 12         | I, 12     | I, 12     | I, 12        | I, 12   | I, 13         | I, 13   | NYSDEC<br>Unrestricted Use<br>Soil Clean-Up<br>Objective<br>(ug/kg) |       |
| Sample Depth (feet)   | 1       | 1           | 1            | 1             | 1         | 1         | 1            | 1.5     | 1             | 1.5     |   |       |
| Date of Collection    | 8/4/08  | 9/12/08     | 7/22/08      | 7/28/08       | 7/28/08   | 7/28/08   | 7/28/08      | 8/4/08  | 7/22/08       | 8/4/08  |   |       |
| Dilution Factor       | 1.0     | 1.0         | 1.0          | 1.0           | 1.0       | 1.0       | 1.0          | 1.0     | 1.0           | 1.0     |   |       |
| Percent Moisture      | 7       | 5           | 6            | 20            | 14        | 13        | 15           | 8       | 7             | 10      |   |       |
| Units                 | (ug/kg) | (ug/kg)     | (ug/kg)      | (ug/kg)       | (ug/kg)   | (ug/kg)   | (ug/kg)      | (ug/kg) | (ug/kg)       | (ug/kg) |   |       |
| Aroclor-1016          | 550 U   | 530 U       | 520 U        | 580 U         | 590 U     | 570 U     | 590 U        | 530 U   | 520 U         | 570 U   |   | 1,000 |
| Aroclor-1221          | 550 U   | 530 U       | 520 U        | 580 U         | 590 U     | 570 U     | 590 U        | 530 U   | 520 U         | 570 U   |   | 1,000 |
| Aroclor-1232          | 550 U   | 530 U       | 520 U        | 580 U         | 590 U     | 570 U     | 590 U        | 530 U   | 520 U         | 570 U   |   | 1,000 |
| Aroclor-1242          | 550 U   | 530 U       | 520 U        | 580 U         | 590 U     | 570 U     | 590 U        | 530 U   | 520 U         | 570 U   |   | 1,000 |
| Aroclor-1248          | 550 U   | 530 U       | 520 U        | 580 U         | 590 U     | 570 U     | 590 U        | 530 U   | 520 U         | 570 U   | 1,000   |       |
| Aroclor-1254          | 550 U   | 530 U       | 520 U        | 580 U         | 590 U     | 570 U     | 590 U        | 530 U   | 520 U         | 570 U   | 1,000   |       |
| Aroclor-1260          | 550 U   | 530 U       | <b>1,800</b> | <b>34,000</b> | 590 U     | 570 U     | <b>2,700</b> | 530 U   | <b>17,000</b> | 570 U   | 1,000   |       |
| <b>Total PCBs</b>     | ---     | ---         | <b>1,800</b> | <b>34,000</b> | ---       | ---       | <b>2,700</b> | ---     | <b>17,000</b> | ---     | 1,000   |       |

**QUALIFIERS:**

- B: Compound found in the method blank as well as the sample
- D: Result taken from a reanalysis at a secondary dilution
- J: Compound found at a concentration below the CRDL, value estimated
- U: Compound analyzed for but not detected

**NOTES:**

- All concentrations are in micrograms per kilogram (ug/kg) or parts per billion (ppb)
- 1: 6 NYCRR PART 375 - Table 375-6.8(a): Unrestricted Use Soil Cleanup Objectives (SCOs)
- Indicates value exceeds standard or guidance value

**FORMER BOUCHARD JUNKYARD SITE  
FINAL REMEDIATION REPORT  
POST-EXCAVATION SOIL SAMPLE RESULTS  
POLYCHLORINATED BIPHENYLS**

| Sample Identification | EP-I14(12) | EP-I14(18) | EP-I15(12) | EP-I15(18) | EP-I16(12) | EP-I17  | EP-I18  | EP-I19  | EP-I20  | EP-I20(T1) |           |                  |
|-----------------------|------------|------------|------------|------------|------------|---------|---------|---------|---------|------------|-----------|------------------|
| Grid Location         | I, 14      | I, 14      | I, 15      | I, 15      | I, 16      | I, 17   | I, 18   | I, 19   | I, 20   | I, 20      | NYSDEC    |                  |
| Sample Depth (feet)   | 1          | 1.5        | 1          | 1.5        | 1          | 1       | 1       | 1       | 1       | 1          |           |                  |
| Date of Collection    | 7/15/08    | 7/18/08    | 7/15/08    | 7/18/08    | 7/15/08    | 7/1/08  | 7/1/08  | 6/27/08 | 6/14/08 | 6/30/08    |           | Unrestricted Use |
| Dilution Factor       | 1.0        | 1.0        | 1.0        | 1.0        | 1.0        | 1.0     | 1.0     | 1.0     | 1.0     | 1.0        |           | Soil Clean-Up    |
| Percent Moisture      | 14         | 4          | 18         | 5          | 10         | 15      | 20      | 6       | 6       | 16         | Objective |                  |
| Units                 | (ug/kg)    | (ug/kg)    | (ug/kg)    | (ug/kg)    | (ug/kg)    | (ug/kg) | (ug/kg) | (ug/kg) | (ug/kg) | (ug/kg)    | (ug/kg)   |                  |
| Aroclor-1016          | 590 U      | 520 U      | 620 U      | 540 U      | 540 U      | 580 U   | 590 U   | 540 U   | 500 U   | 580 U      | 1,000     |                  |
| Aroclor-1221          | 590 U      | 520 U      | 620 U      | 540 U      | 540 U      | 580 U   | 590 U   | 540 U   | 500 U   | 580 U      | 1,000     |                  |
| Aroclor-1232          | 590 U      | 520 U      | 620 U      | 540 U      | 540 U      | 580 U   | 590 U   | 540 U   | 500 U   | 580 U      | 1,000     |                  |
| Aroclor-1242          | 590 U      | 520 U      | 620 U      | 540 U      | 540 U      | 580 U   | 590 U   | 540 U   | 500 U   | 580 U      | 1,000     |                  |
| Aroclor-1248          | 590 U      | 520 U      | 620 U      | 540 U      | 540 U      | 580 U   | 590 U   | 540 U   | 500 U   | 580 U      | 1,000     |                  |
| Aroclor-1254          | 590 U      | 520 U      | 620 U      | 540 U      | 540 U      | 580 U   | 590 U   | 540 U   | 500 U   | 580 U      | 1,000     |                  |
| Aroclor-1260          | 590 U      | 520 U      | 620 U      | 540 U      | 540 U      | 500 J   | 590 U   | 730     | 500 U   | 580 U      | 1,000     |                  |
| <b>Total PCBs</b>     | ---        | ---        | ---        | ---        | ---        | ---     | ---     | 730     | ---     | ---        | 1,000     |                  |

| Sample Identification | EP-J21  | EP-J22  | EP-J23  | EP-J24  | EP-J25  | EP-J1   | EP-J2(12) | EP-J2(18) | EP-J3(12)     | EP-J3(18)    |           |                  |
|-----------------------|---------|---------|---------|---------|---------|---------|-----------|-----------|---------------|--------------|-----------|------------------|
| Grid Location         | I, 21   | I, 22   | I, 23   | I, 24   | I, 25   | J, 1    | J, 2      | J, 2      | J, 3          | J, 3         | NYSDEC    |                  |
| Sample Depth (feet)   | 1       | 1       | 1       | 1       | 1       | 1       | 1         | 1         | 1             | 1.5          |           |                  |
| Date of Collection    | 6/12/08 | 6/13/08 | 6/27/08 | 6/26/08 | 6/26/08 | 7/28/08 | 7/28/08   | 7/28/08   | 7/29/08       | 7/28/08      |           | Unrestricted Use |
| Dilution Factor       | 1.0     | 1.0     | 1.0     | 1.0     | 1.0     | 1.0     | 1.0       | 1.0       | 1.0           | 1.0          |           | Soil Clean-Up    |
| Percent Moisture      | 14      | 17      | 7       | 16      | 14      | 15      | 16        | 13        | 15            | 25           | Objective |                  |
| Units                 | (ug/kg) | (ug/kg) | (ug/kg) | (ug/kg) | (ug/kg) | (ug/kg) | (ug/kg)   | (ug/kg)   | (ug/kg)       | (ug/kg)      | (ug/kg)   |                  |
| Aroclor-1016          | 590 U   | 610 U   | 550 U   | 540 U   | 590 U   | 540 U   | 600 U     | 560 U     | 570 U         | 670 U        | 1,000     |                  |
| Aroclor-1221          | 590 U   | 610 U   | 550 U   | 540 U   | 590 U   | 540 U   | 600 U     | 560 U     | 570 U         | 670 U        | 1,000     |                  |
| Aroclor-1232          | 590 U   | 610 U   | 550 U   | 540 U   | 590 U   | 540 U   | 600 U     | 560 U     | 570 U         | 670 U        | 1,000     |                  |
| Aroclor-1242          | 590 U   | 610 U   | 550 U   | 540 U   | 590 U   | 540 U   | 600 U     | 560 U     | 570 U         | 670 U        | 1,000     |                  |
| Aroclor-1248          | 590 U   | 610 U   | 550 U   | 540 U   | 590 U   | 540 U   | 600 U     | 560 U     | 570 U         | 670 U        | 1,000     |                  |
| Aroclor-1254          | 590 U   | 610 U   | 550 U   | 540 U   | 590 U   | 540 U   | 600 U     | 560 U     | 570 U         | 670 U        | 1,000     |                  |
| Aroclor-1260          | 590 U   | 610 U   | 550 U   | 540 U   | 590 U   | 640     | 600 U     | 560 U     | <b>32,000</b> | <b>9,100</b> | 1,000     |                  |
| <b>Total PCBs</b>     | ---     | ---     | ---     | ---     | ---     | 640     | ---       | ---       | <b>32,000</b> | <b>9,100</b> | 1,000     |                  |

**QUALIFIERS:**

- B: Compound found in the method blank as well as the sample
- D: Result taken from a reanalysis at a secondary dilution
- J: Compound found at a concentration below the CRDL, value estimated
- U: Compound analyzed for but not detected

**NOTES:**

- All concentrations are in micrograms per kilogram (ug/kg) or parts per billion (ppb)
- 1: 6 NYCRR PART 375 - Table 375-6.8(a): Unrestricted Use Soil Cleanup Objectives (SCOs)
- Indicates value exceeds standard or guidance value

**FORMER BOUCHARD JUNKYARD SITE  
FINAL REMEDIATION REPORT  
POST-EXCAVATION SOIL SAMPLE RESULTS  
POLYCHLORINATED BIPHENYLS**

| Sample Identification | EP-J3(18A) | EP-J3(18B) | EP-J4   | EP-J5   | EP-J6   | EP-J7   | EP-J8        | EP-J8(1) | EP-J8(2)      | EP-J8(3)     |   |
|-----------------------|------------|------------|---------|---------|---------|---------|--------------|----------|---------------|--------------|---|
| Grid Location         | J, 3       | J, 3       | J, 4    | J, 5    | J, 6    | J, 7    | J, 8         | J, 8     | J, 8          | J, 8         | NYSDEC<br>Unrestricted Use<br>Soil Clean-Up<br>Objective<br>(ug/kg) |
| Sample Depth (feet)   | 2          | 2.5        | 1       | 1       | 1       | 1       | 1            | 1        | 1             | 1            |   |
| Date of Collection    | 7/31/08    | 7/31/08    | 7/28/08 | 5/23/08 | 5/23/08 | 9/2/08  | 9/2/08       | 9/4/08   | 9/4/08        | 9/4/08       |   |
| Dilution Factor       | 1.0        | 1.0        | 1.0     | 1.0     | 1.0     | 1.0     | 1.0          | 1.0      | 1.0           | 1.0          |   |
| Percent Moisture      | 19         | 15         | 14      | 13      | 17      | 16      | 23           | 19       | 16            | 24           |   |
| Units                 | (ug/kg)    | (ug/kg)    | (ug/kg) | (ug/kg) | (ug/kg) | (ug/kg) | (ug/kg)      | (ug/kg)  | (ug/kg)       | (ug/kg)      |   |
| Aroclor-1016          | 620 U      | 590 U      | 560 U   | 590 U   | 560 U   | 610 U   | 660 U        | 630 U    | 610 U         | 650 U        | 1,000   |
| Aroclor-1221          | 620 U      | 590 U      | 560 U   | 590 U   | 560 U   | 610 U   | 660 U        | 630 U    | 610 U         | 650 U        | 1,000   |
| Aroclor-1232          | 620 U      | 590 U      | 560 U   | 590 U   | 560 U   | 610 U   | 660 U        | 630 U    | 610 U         | 650 U        | 1,000   |
| Aroclor-1242          | 620 U      | 590 U      | 560 U   | 590 U   | 560 U   | 610 U   | 660 U        | 630 U    | 610 U         | 650 U        | 1,000   |
| Aroclor-1248          | 620 U      | 590 U      | 560 U   | 590 U   | 560 U   | 610 U   | 660 U        | 630 U    | 610 U         | 650 U        | 1,000   |
| Aroclor-1254          | 620 U      | 590 U      | 560 U   | 590 U   | 560 U   | 610 U   | 660 U        | 630 U    | 610 U         | 650 U        | 1,000   |
| Aroclor-1260          | 620 U      | 590 U      | 560 U   | 590 U   | 560 U   | 610 U   | 3,800        | 810      | 10,000        | 6,800        | 1,000   |
| <b>Total PCBs</b>     | ----       | ----       | ----    | ----    | ----    | ----    | <b>3,800</b> | 810      | <b>10,000</b> | <b>6,800</b> | 1,000   |

| Sample Identification | EP-J8(4)     | EP-J8A  | EP-J8(T12)   | EP-J8(T12)(A) | EP-J9        | EP-J9A       | EP-J9B  | EP-J9(T12)   | EP-J9(T12)(A) | EP-J9(NON-TSCA) |   |
|-----------------------|--------------|---------|--------------|---------------|--------------|--------------|---------|--------------|---------------|-----------------|---|
| Grid Location         | J, 8         | J, 8    | J, 8         | J, 8          | J, 9         | J, 9         | J, 9    | J, 9         | J, 9          | J, 9            | NYSDEC<br>Unrestricted Use<br>Soil Clean-Up<br>Objective<br>(ug/kg) |
| Sample Depth (feet)   | 1            | 2       | 1            | 2             | 1            | 1.5          | 2       | 1            | 2             | 1               |   |
| Date of Collection    | 9/4/08       | 9/15/08 | 9/15/08      | 9/29/08       | 8/4/08       | 8/19/08      | 9/29/08 | 9/15/08      | 9/29/08       | 9/15/08         |   |
| Dilution Factor       | 1.0          | 1.0     | 1.0          | 1.0           | 1.0          | 1.0          | 1.0     | 1.0          | 1.0           | 1.0             |   |
| Percent Moisture      | 24           | 22      | 19           | 17            | 15           | 10           | 12      | 18           | 20            | 21              |   |
| Units                 | (ug/kg)      | (ug/kg) | (ug/kg)      | (ug/kg)       | (ug/kg)      | (ug/kg)      | (ug/kg) | (ug/kg)      | (ug/kg)       | (ug/kg)         |   |
| Aroclor-1016          | 660 U        | 630 U   | 590 U        | 600 U         | 590 U        | 530 U        | 540 U   | 610 U        | 610 U         | 630 U           | 1,000   |
| Aroclor-1221          | 660 U        | 630 U   | 590 U        | 600 U         | 590 U        | 530 U        | 540 U   | 610 U        | 610 U         | 630 U           | 1,000   |
| Aroclor-1232          | 660 U        | 630 U   | 590 U        | 600 U         | 590 U        | 530 U        | 540 U   | 610 U        | 610 U         | 630 U           | 1,000   |
| Aroclor-1242          | 660 U        | 630 U   | 590 U        | 600 U         | 590 U        | 530 U        | 540 U   | 610 U        | 610 U         | 630 U           | 1,000   |
| Aroclor-1248          | 660 U        | 630 U   | 590 U        | 600 U         | 590 U        | 530 U        | 540 U   | 610 U        | 610 U         | 630 U           | 1,000   |
| Aroclor-1254          | 660 U        | 630 U   | 590 U        | 600 U         | 590 U        | 530 U        | 540 U   | 610 U        | 610 U         | 630 U           | 1,000   |
| Aroclor-1260          | 2,300        | 630 U   | 1,600        | 600 U         | 1,300        | 1,200        | 630     | 7,100        | 720           | 8,100           | 1,000   |
| <b>Total PCBs</b>     | <b>2,300</b> | ----    | <b>1,600</b> | ----          | <b>1,300</b> | <b>1,200</b> | 630     | <b>7,100</b> | 720           | <b>8,100</b>    | 1,000   |

**QUALIFIERS:**

- B: Compound found in the method blank as well as the sample
- D: Result taken from a reanalysis at a secondary dilution
- J: Compound found at a concentration below the CRDL, value estimated
- U: Compound analyzed for but not detected

**NOTES:**

- All concentrations are in micrograms per kilogram (ug/kg) or parts per billion (ppb)
- 1: 6 NYCRR PART 375 - Table 375-6.8(a): Unrestricted Use Soil Cleanup Objectives (SCOs)
- Indicates value exceeds standard or guidance value

**FORMER BOUCHARD JUNKYARD SITE  
FINAL REMEDIATION REPORT  
POST-EXCAVATION SOIL SAMPLE RESULTS  
POLYCHLORINATED BIPHENYLS**

| Sample Identification | EP-J9(NON-TSCA)(A) | EP-J10  | EP-J11  | EP-J12  | EP-J12(T7) | EP-J12(T7A) | EP-J13  | EP-J13(T7) | EP-J14  |       |   |
|-----------------------|--------------------|---------|---------|---------|------------|-------------|---------|------------|---------|-------|---|
| Grid Location         | J, 9               | J, 10   | J, 11   | J, 12   | J, 12      | J, 12       | J, 13   | J, 13      | J, 14   |       | NYSDEC<br>Unrestricted Use<br>Soil Clean-Up<br>Objective<br>(ug/kg) |
| Sample Depth (feet)   | 2                  | 1       | 1       | 1       | 1          | 1.5         | 1       | 1          | 1       |       |   |
| Date of Collection    | 9/29/08            | 6/18/08 | 8/7/08  | 7/22/08 | 7/22/08    | 7/31/08     | 7/18/08 | 7/22/08    | 7/18/08 |       |   |
| Dilution Factor       | 1.0                | 1.0     | 1.0     | 1.0     | 1.0        | 1.0         | 1.0     | 1.0        | 1.0     |       |   |
| Percent Moisture      | 19                 | 7       | 7       | 9       | 8          | 6           | 5       | 15         | 3       |       |   |
| Units                 | (ug/kg)            | (ug/kg) | (ug/kg) | (ug/kg) | (ug/kg)    | (ug/kg)     | (ug/kg) | (ug/kg)    | (ug/kg) |       |   |
| Aroclor-1016          | 620 U              | 530 U   | 500 U   | 550 U   | 550 U      | 510 U       | 530 U   | 580 U      | 520 U   | 1,000 |   |
| Aroclor-1221          | 620 U              | 530 U   | 500 U   | 550 U   | 550 U      | 510 U       | 530 U   | 580 U      | 520 U   | 1,000 |   |
| Aroclor-1232          | 620 U              | 530 U   | 500 U   | 550 U   | 550 U      | 510 U       | 530 U   | 580 U      | 520 U   | 1,000 |   |
| Aroclor-1242          | 620 U              | 530 U   | 500 U   | 550 U   | 550 U      | 510 U       | 530 U   | 580 U      | 520 U   | 1,000 |   |
| Aroclor-1248          | 620 U              | 530 U   | 500 U   | 550 U   | 550 U      | 510 U       | 530 U   | 580 U      | 520 U   | 1,000 |   |
| Aroclor-1254          | 620 U              | 530 U   | 500 U   | 550 U   | 550 U      | 510 U       | 530 U   | 580 U      | 520 U   | 1,000 |   |
| Aroclor-1260          | 620 U              | 530 U   | 500 U   | 550 U   | 4,500      | 510 U       | 530 U   | 580 U      | 520 U   | 1,000 |   |
| <b>Total PCBs</b>     | ----               | ----    | ----    | ----    | 4,500      | ----        | ----    | ----       | ----    |       | 1,000   |

| Sample Identification | EP-J15  | EP-J16  | EP-J17  | EP-J18(12) | EP-J18(18) | EP-J19(12) | EP-J19(18) | EP-J20  | EP-J21  | EP-JK18(OVER) |   |       |
|-----------------------|---------|---------|---------|------------|------------|------------|------------|---------|---------|---------------|---|-------|
| Grid Location         | J, 15   | J, 16   | J, 17   | J, 18      | J, 18      | J, 19      | J, 19      | J, 20   | J, 21   | J/K, 18       | NYSDEC<br>Unrestricted Use<br>Soil Clean-Up<br>Objective<br>(ug/kg) |       |
| Sample Depth (feet)   | 1       | 1       | 1       | 1          | 1.5        | 1          | 1.5        | 1       | 1       | 1             |   |       |
| Date of Collection    | 7/18/08 | 7/16/08 | 7/3/08  | 7/3/08     | 7/3/08     | 7/10/08    | 7/10/08    | 6/12/08 | 6/14/08 | 7/3/08        |   |       |
| Dilution Factor       | 1.0     | 1.0     | 1.0     | 1.0        | 1.0        | 1.0        | 1.0        | 1.0     | 1.0     | 1.0           |   |       |
| Percent Moisture      | 15      | 20      | 10      | 11         | 18         | 7          | 4          | 6       | 9       | 18            |   |       |
| Units                 | (ug/kg) | (ug/kg) | (ug/kg) | (ug/kg)    | (ug/kg)    | (ug/kg)    | (ug/kg)    | (ug/kg) | (ug/kg) | (ug/kg)       |   |       |
| Aroclor-1016          | 600 U   | 630 U   | 570 U   | 540 U      | 580 U      | 520 U      | 490 U      | 540 U   | 550 U   | 610 U         |   | 1,000 |
| Aroclor-1221          | 600 U   | 630 U   | 570 U   | 540 U      | 580 U      | 520 U      | 490 U      | 540 U   | 550 U   | 610 U         |   | 1,000 |
| Aroclor-1232          | 600 U   | 630 U   | 570 U   | 540 U      | 580 U      | 520 U      | 490 U      | 540 U   | 550 U   | 610 U         |   | 1,000 |
| Aroclor-1242          | 600 U   | 630 U   | 570 U   | 540 U      | 580 U      | 520 U      | 490 U      | 540 U   | 550 U   | 610 U         |   | 1,000 |
| Aroclor-1248          | 600 U   | 630 U   | 570 U   | 540 U      | 580 U      | 520 U      | 490 U      | 540 U   | 550 U   | 610 U         | 1,000   |       |
| Aroclor-1254          | 600 U   | 630 U   | 570 U   | 540 U      | 580 U      | 520 U      | 490 U      | 540 U   | 550 U   | 610 U         | 1,000   |       |
| Aroclor-1260          | 600 U   | 630 U   | 570 U   | 540 U      | 580 U      | 520 U      | 490 U      | 540 U   | 550 U   | 610 U         | 1,000   |       |
| <b>Total PCBs</b>     | ----    | ----    | ----    | ----       | ----       | ----       | ----       | ----    | ----    | ----          | 1,000   |       |

**QUALIFIERS:**

- B: Compound found in the method blank as well as the sample
- D: Result taken from a reanalysis at a secondary dilution
- J: Compound found at a concentration below the CRDL, value estimated
- U: Compound analyzed for but not detected

**NOTES:**

- All concentrations are in micrograms per kilogram (ug/kg) or parts per billion (ppb)
- 1: 6 NYCRR PART 375 - Table 375-6.8(a): Unrestricted Use Soil Cleanup Objectives (SCOs)
- Indicates value exceeds standard or guidance value

FORMER BOUCHARD JUNKYARD SITE  
FINAL REMEDIATION REPORT  
POST-EXCAVATION SOIL SAMPLE RESULTS  
POLYCHLORINATED BIPHENYLS

| Sample Identification | EP-K1   | EP-K2(12) | EP-K2(18) | EP-K3(12) | EP-K3(18) | EP-K4   | EP-K5   | EP-K6   | EP-K7   | EP-K7(1) |               |
|-----------------------|---------|-----------|-----------|-----------|-----------|---------|---------|---------|---------|----------|---------------|
| Grid Location         | K, 1    | K, 2      | K, 2      | K, 3      | K, 3      | K, 4    | K, 5    | K, 6    | K, 7    | K, 7     | NYSDEC        |
| Sample Depth (feet)   | 1       | 1         | 1.5       | 1         | 1.5       | 1       | 1       | 1       | 1       | 1        |               |
| Date of Collection    | 7/28/08 | 7/28/08   | 7/28/08   | 7/28/08   | 7/28/08   | 7/29/08 | 7/31/08 | 7/31/08 | 9/2/08  | 9/4/08   |               |
| Dilution Factor       | 1.0     | 1.0       | 1.0       | 1.0       | 1.0       | 1.0     | 1.0     | 1.0     | 1.0     | 1.0      | Soil Clean-Up |
| Percent Moisture      | 24      | 26        | 20        | 23        | 24        | 23      | 12      | 20      | 19      | 15       | Objective     |
| Units                 | (ug/kg) | (ug/kg)   | (ug/kg)   | (ug/kg)   | (ug/kg)   | (ug/kg) | (ug/kg) | (ug/kg) | (ug/kg) | (ug/kg)  | (ug/kg)       |
| Aroclor-1016          | 610 U   | 650 U     | 590 U     | 600 U     | 620 U     | 660 U   | 580 U   | 610 U   | 620 U   | 590 U    | 1,000         |
| Aroclor-1221          | 610 U   | 650 U     | 590 U     | 600 U     | 620 U     | 660 U   | 580 U   | 610 U   | 620 U   | 590 U    | 1,000         |
| Aroclor-1232          | 610 U   | 650 U     | 590 U     | 600 U     | 620 U     | 660 U   | 580 U   | 610 U   | 620 U   | 590 U    | 1,000         |
| Aroclor-1242          | 610 U   | 650 U     | 590 U     | 600 U     | 620 U     | 660 U   | 580 U   | 610 U   | 620 U   | 590 U    | 1,000         |
| Aroclor-1248          | 610 U   | 650 U     | 590 U     | 600 U     | 620 U     | 660 U   | 580 U   | 610 U   | 620 U   | 590 U    | 1,000         |
| Aroclor-1254          | 610 U   | 650 U     | 590 U     | 600 U     | 620 U     | 660 U   | 580 U   | 610 U   | 620 U   | 590 U    | 1,000         |
| Aroclor-1260          | 610 U   | 650 U     | 590 U     | 750       | 620 U     | 660 U   | 580 U   | 610 U   | 6,200   | 590 U    | 1,000         |
| <b>Total PCBs</b>     | ----    | ----      | ----      | 750       | ----      | ----    | ----    | ----    | 6,200   | ----     | 1,000         |

| Sample Identification | EP-K7(2) | EP-K7(3) | EP-K7(4) | EP-K7A  | EP-K8   | EP-K8(T12) | EP-K8(T12)(A) | EP-K9   | EP-K9(T12) | EP-K9(T12)(A) |               |
|-----------------------|----------|----------|----------|---------|---------|------------|---------------|---------|------------|---------------|---------------|
| Grid Location         | K, 7     | K, 7     | K, 7     | K, 7    | K, 8    | K, 8       | K, 8          | K, 9    | K, 9       | K, 9          | NYSDEC        |
| Sample Depth (feet)   | 1        | 1        | 1        | 2       | 1       | 1          | 2             | 1       | 1          | 2             |               |
| Date of Collection    | 9/4/08   | 9/4/08   | 9/4/08   | 9/12/08 | 9/4/08  | 9/15/08    | 9/29/08       | 6/18/08 | 9/15/08    | 9/29/08       |               |
| Dilution Factor       | 1.0      | 1.0      | 1.0      | 1.0     | 1.0     | 1.0        | 1.0           | 1.0     | 1.0        | 1.0           | Soil Clean-Up |
| Percent Moisture      | 18       | 20       | 20       | 10      | 18      | 16         | 16            | 7       | 11         | 26            | Objective     |
| Units                 | (ug/kg)  | (ug/kg)  | (ug/kg)  | (ug/kg) | (ug/kg) | (ug/kg)    | (ug/kg)       | (ug/kg) | (ug/kg)    | (ug/kg)       | (ug/kg)       |
| Aroclor-1016          | 600 U    | 640 U    | 640 U    | 520 U   | 600 U   | 610 U      | 600 U         | 530 U   | 540 U      | 660 U         | 1,000         |
| Aroclor-1221          | 600 U    | 640 U    | 640 U    | 520 U   | 600 U   | 610 U      | 600 U         | 530 U   | 540 U      | 660 U         | 1,000         |
| Aroclor-1232          | 600 U    | 640 U    | 640 U    | 520 U   | 600 U   | 610 U      | 600 U         | 530 U   | 540 U      | 660 U         | 1,000         |
| Aroclor-1242          | 600 U    | 640 U    | 640 U    | 520 U   | 600 U   | 610 U      | 600 U         | 530 U   | 540 U      | 660 U         | 1,000         |
| Aroclor-1248          | 600 U    | 640 U    | 640 U    | 520 U   | 600 U   | 610 U      | 600 U         | 530 U   | 540 U      | 660 U         | 1,000         |
| Aroclor-1254          | 600 U    | 640 U    | 640 U    | 520 U   | 600 U   | 610 U      | 600 U         | 530 U   | 540 U      | 660 U         | 1,000         |
| Aroclor-1260          | 600 U    | 640 U    | 11,000   | 520 U   | 600 U   | 3,600      | 600 U         | 530 U   | 2,000      | 660 U         | 1,000         |
| <b>Total PCBs</b>     | ----     | ----     | 11,000   | ----    | ----    | 3,600      | ----          | ----    | 2,000      | ----          | 1,000         |

QUALIFIERS:

- B: Compound found in the method blank as well as the sample
- D: Result taken from a reanalysis at a secondary dilution
- J: Compound found at a concentration below the CRDL, value estimated
- U: Compound analyzed for but not detected

NOTES:

- All concentrations are in micrograms per kilogram (ug/kg) or parts per billion (ppb)
- 1: 6 NYCRR PART 375 - Table 375-6.8(a): Unrestricted Use Soil Cleanup Objectives (SCOs)
- Indicates value exceeds standard or guidance value

**FORMER BOUCHARD JUNKYARD SITE  
FINAL REMEDIATION REPORT  
POST-EXCAVATION SOIL SAMPLE RESULTS  
POLYCHLORINATED BIPHENYLS**

| Sample Identification | EP-K10  | EP-K11       | EP-K11(1) | EP-K11(2) | EP-K11(3) | EP-K11(4) | EP-K12  | EP-K12(T7) | EP-K13  | EP-K13(T7) |   |       |
|-----------------------|---------|--------------|-----------|-----------|-----------|-----------|---------|------------|---------|------------|---|-------|
| Grid Location         | K, 10   | K, 11        | K, 11     | K, 11     | K, 11     | K, 11     | K, 12   | K, 12      | K, 13   | K, 13      | NYSDEC<br>Unrestricted Use<br>Soil Clean-Up<br>Objective<br>(ug/kg) |       |
| Sample Depth (feet)   | 1       | 1            | 1         | 1         | 1         | 1         | 1       | 1          | 1       | 1          |   |       |
| Date of Collection    | 6/18/08 | 8/7/08       | 11/12/08  | 11/12/08  | 11/12/08  | 11/12/08  | 7/18/08 | 7/22/08    | 7/18/08 | 7/22/08    |   |       |
| Dilution Factor       | 1.0     | 1.0          | 1.0       | 1.0       | 1.0       | 1.0       | 1.0     | 1.0        | 1.0     | 1.0        |   |       |
| Percent Moisture      | 11      | 7            | 9         | 8         | 9         | 8         | 6       | 9          | 6       | 4          |   |       |
| Units                 | (ug/kg) | (ug/kg)      | (ug/kg)   | (ug/kg)   | (ug/kg)   | (ug/kg)   | (ug/kg) | (ug/kg)    | (ug/kg) | (ug/kg)    |   |       |
| Aroclor-1016          | 520 U   | 500 U        | 510 U     | 530 U     | 540 U     | 520 U     | 530 U   | 550 U      | 510 U   | 530 U      |   | 1,000 |
| Aroclor-1221          | 520 U   | 500 U        | 510 U     | 530 U     | 540 U     | 520 U     | 530 U   | 550 U      | 510 U   | 530 U      |   | 1,000 |
| Aroclor-1232          | 520 U   | 500 U        | 510 U     | 530 U     | 540 U     | 520 U     | 530 U   | 550 U      | 510 U   | 530 U      |   | 1,000 |
| Aroclor-1242          | 520 U   | 500 U        | 510 U     | 530 U     | 540 U     | 520 U     | 530 U   | 550 U      | 510 U   | 530 U      |   | 1,000 |
| Aroclor-1248          | 520 U   | 500 U        | 510 U     | 530 U     | 540 U     | 520 U     | 530 U   | 550 U      | 510 U   | 530 U      | 1,000   |       |
| Aroclor-1254          | 520 U   | 500 U        | 510 U     | 530 U     | 540 U     | 520 U     | 530 U   | 550 U      | 510 U   | 530 U      | 1,000   |       |
| Aroclor-1260          | 520 U   | 1,700        | 510 U     | 530 U     | 540 U     | 520 U     | 530 U   | 550 U      | 510 U   | 530 U      | 1,000   |       |
| <b>Total PCBs</b>     | ---     | <b>1,700</b> | ---       | ---       | ---       | ---       | ---     | ---        | ---     | ---        | 1,000   |       |

| Sample Identification | EP-K14  | EP-K15  | EP-K16  | EP-K17  | EP-K18  | EP-K19  | EP-K19(18) | EP-K20  | EP-K21  | EP-L1   |   |       |
|-----------------------|---------|---------|---------|---------|---------|---------|------------|---------|---------|---------|---|-------|
| Grid Location         | K, 14   | K, 15   | K, 16   | K, 17   | K, 18   | K, 19   | K, 19      | K, 20   | K, 21   | L, 1    | NYSDEC<br>Unrestricted Use<br>Soil Clean-Up<br>Objective<br>(ug/kg) |       |
| Sample Depth (feet)   | 1       | 1       | 1       | 1       | 1       | 1       | 1.5        | 1       | 1       | 1       |   |       |
| Date of Collection    | 7/18/08 | 7/18/08 | 7/16/08 | 7/14/08 | 7/3/08  | 6/13/08 | 7/14/08    | 6/12/08 | 7/9/08  | 7/28/08 |   |       |
| Dilution Factor       | 1.0     | 1.0     | 1.0     | 1.0     | 1.0     | 1.0     | 1.0        | 1.0     | 1.0     | 1.0     |   |       |
| Percent Moisture      | 4       | 4       | 5       | 10      | 8       | 6       | 4          | 12      | 9       | 27      |   |       |
| Units                 | (ug/kg) | (ug/kg) | (ug/kg) | (ug/kg) | (ug/kg) | (ug/kg) | (ug/kg)    | (ug/kg) | (ug/kg) | (ug/kg) |   |       |
| Aroclor-1016          | 520 U   | 530 U   | 540 U   | 510 U   | 520 U   | 510 U   | 500 U      | 560 U   | 510 U   | 650 U   |   | 1,000 |
| Aroclor-1221          | 520 U   | 530 U   | 540 U   | 510 U   | 520 U   | 510 U   | 500 U      | 560 U   | 510 U   | 650 U   |   | 1,000 |
| Aroclor-1232          | 520 U   | 530 U   | 540 U   | 510 U   | 520 U   | 510 U   | 500 U      | 560 U   | 510 U   | 650 U   |   | 1,000 |
| Aroclor-1242          | 520 U   | 530 U   | 540 U   | 510 U   | 520 U   | 510 U   | 500 U      | 560 U   | 510 U   | 650 U   |   | 1,000 |
| Aroclor-1248          | 520 U   | 530 U   | 540 U   | 510 U   | 520 U   | 510 U   | 500 U      | 560 U   | 510 U   | 650 U   | 1,000   |       |
| Aroclor-1254          | 520 U   | 530 U   | 540 U   | 510 U   | 520 U   | 510 U   | 500 U      | 560 U   | 510 U   | 650 U   | 1,000   |       |
| Aroclor-1260          | 520 U   | 530 U   | 540 U   | 510 U   | 520 U   | 510 U   | 500 U      | 560 U   | 510 U   | 650 U   | 1,000   |       |
| <b>Total PCBs</b>     | ---     | ---     | ---     | ---     | ---     | ---     | ---        | ---     | ---     | ---     | 1,000   |       |

**QUALIFIERS:**

- B: Compound found in the method blank as well as the sample
- D: Result taken from a reanalysis at a secondary dilution
- J: Compound found at a concentration below the CRDL, value estimated
- U: Compound analyzed for but not detected

**NOTES:**

- All concentrations are in micrograms per kilogram (ug/kg) or parts per billion (ppb)
- 1: 6 NYCRR PART 375 - Table 375-6.8(a): Unrestricted Use Soil Cleanup Objectives (SCOs)
- Indicates value exceeds standard or guidance value

FORMER BOUCHARD JUNKYARD SITE  
FINAL REMEDIATION REPORT  
POST-EXCAVATION SOIL SAMPLE RESULTS  
POLYCHLORINATED BIPHENYLS

| Sample Identification | EP-L2        | EP-L2(1)     | EP-L2(2) | EP-L2(3)     | EP-L2(4) | EP-L2A  | EP-L3   | EP-L4   | EP-L5        | EP-L5(1) |   |       |
|-----------------------|--------------|--------------|----------|--------------|----------|---------|---------|---------|--------------|----------|---|-------|
| Grid Location         | L, 2         | L, 2         | L, 2     | L, 2         | L, 2     | L, 2    | L, 3    | L, 4    | L, 5         | L, 5     | NYSDEC<br>Unrestricted Use<br>Soil Clean-Up<br>Objective<br>(ug/kg) |       |
| Sample Depth (feet)   | 1            | 1            | 1        | 1            | 1        | 1.5     | 1       | 1       | 1            | 1        |   |       |
| Date of Collection    | 7/28/08      | 7/31/08      | 7/31/08  | 7/31/08      | 7/31/08  | 8/18/08 | 7/28/08 | 7/29/08 | 7/31/08      | 8/5/08   |   |       |
| Dilution Factor       | 1.0          | 1.0          | 1.0      | 1.0          | 1.0      | 1.0     | 1.0     | 1.0     | 1.0          | 1.0      |   |       |
| Percent Moisture      | 25           | 12           | 21       | 24           | 25       | 20      | 25      | 22      | 16           | 17       |   |       |
| Units                 | (ug/kg)      | (ug/kg)      | (ug/kg)  | (ug/kg)      | (ug/kg)  | (ug/kg) | (ug/kg) | (ug/kg) | (ug/kg)      | (ug/kg)  |   |       |
| Aroclor-1016          | 650 U        | 570 U        | 620 U    | 660 U        | 670 U    | 590 U   | 640 U   | 640 U   | 600 U        | 610 U    |   | 1,000 |
| Aroclor-1221          | 650 U        | 570 U        | 620 U    | 660 U        | 670 U    | 590 U   | 640 U   | 640 U   | 600 U        | 610 U    |   | 1,000 |
| Aroclor-1232          | 650 U        | 570 U        | 620 U    | 660 U        | 670 U    | 590 U   | 640 U   | 640 U   | 600 U        | 610 U    |   | 1,000 |
| Aroclor-1242          | 650 U        | 570 U        | 620 U    | 660 U        | 670 U    | 590 U   | 640 U   | 640 U   | 600 U        | 610 U    |   | 1,000 |
| Aroclor-1248          | 650 U        | 570 U        | 620 U    | 660 U        | 670 U    | 590 U   | 640 U   | 640 U   | 600 U        | 610 U    |   | 1,000 |
| Aroclor-1254          | 650 U        | 570 U        | 620 U    | 660 U        | 670 U    | 590 U   | 640 U   | 640 U   | 600 U        | 610 U    | 1,000   |       |
| Aroclor-1260          | <b>1,800</b> | <b>4,100</b> | 620 J    | <b>1,500</b> | 670 U    | 590 U   | 640 U   | 640 U   | <b>4,300</b> | 610 U    | 1,000   |       |
| <b>Total PCBs</b>     | <b>1,800</b> | <b>4,100</b> | ----     | <b>1,500</b> | ----     | ----    | ----    | ----    | <b>4,300</b> | ----     | 1,000   |       |

| Sample Identification | EP-L5(2)      | EP-L5(3) | EP-L5(4) | EP-L5A  | EP-L6   | EP-L7         | EP-L7A  | EP-L8   | EP-L9   | EP-L10  |   |       |
|-----------------------|---------------|----------|----------|---------|---------|---------------|---------|---------|---------|---------|---|-------|
| Grid Location         | L, 5          | L, 5     | L, 5     | L, 5    | L, 6    | L, 7          | L, 7    | L, 8    | L, 9    | L, 10   | NYSDEC<br>Unrestricted Use<br>Soil Clean-Up<br>Objective<br>(ug/kg) |       |
| Sample Depth (feet)   | 1             | 1        | 1        | 1.5     | 1       | 1             | 2       | 1       | 1       | 1       |   |       |
| Date of Collection    | 8/5/08        | 8/5/08   | 8/5/08   | 8/18/08 | 7/31/08 | 7/31/08       | 8/18/08 | 7/31/08 | 6/18/08 | 6/18/08 |   |       |
| Dilution Factor       | 1.0           | 1.0      | 1.0      | 1.0     | 1.0     | 1.0           | 1.0     | 1.0     | 1.0     | 1.0     |   |       |
| Percent Moisture      | 17            | 21       | 16       | 13      | 7       | 16            | 8       | 24      | 8       | 18      |   |       |
| Units                 | (ug/kg)       | (ug/kg)  | (ug/kg)  | (ug/kg) | (ug/kg) | (ug/kg)       | (ug/kg) | (ug/kg) | (ug/kg) | (ug/kg) |   |       |
| Aroclor-1016          | 610 U         | 620 U    | 580 U    | 570 U   | 550 U   | 600 U         | 500 U   | 670 U   | 540 U   | 590 U   |   | 1,000 |
| Aroclor-1221          | 610 U         | 620 U    | 580 U    | 570 U   | 550 U   | 600 U         | 500 U   | 670 U   | 540 U   | 590 U   |   | 1,000 |
| Aroclor-1232          | 610 U         | 620 U    | 580 U    | 570 U   | 550 U   | 600 U         | 500 U   | 670 U   | 540 U   | 590 U   |   | 1,000 |
| Aroclor-1242          | 610 U         | 620 U    | 580 U    | 570 U   | 550 U   | 600 U         | 500 U   | 670 U   | 540 U   | 590 U   |   | 1,000 |
| Aroclor-1248          | 610 U         | 620 U    | 580 U    | 570 U   | 550 U   | 600 U         | 500 U   | 670 U   | 540 U   | 590 U   |   | 1,000 |
| Aroclor-1254          | 610 U         | 620 U    | 580 U    | 570 U   | 550 U   | 600 U         | 500 U   | 670 U   | 540 U   | 590 U   | 1,000   |       |
| Aroclor-1260          | <b>21,000</b> | 810      | 580 U    | 570 U   | 750     | <b>12,000</b> | 500 U   | 670 U   | 540 U   | 590 U   | 1,000   |       |
| <b>Total PCBs</b>     | <b>21,000</b> | 810      | ----     | ----    | 750     | <b>12,000</b> | ----    | ----    | ----    | ----    | 1,000   |       |

QUALIFIERS:

- B: Compound found in the method blank as well as the sample
- D: Result taken from a reanalysis at a secondary dilution
- J: Compound found at a concentration below the CRDL, value estimated
- U: Compound analyzed for but not detected

NOTES:

- All concentrations are in micrograms per kilogram (ug/kg) or parts per billion (ppb)
- 1: 6 NYCRR PART 375 - Table 375-6.8(a): Unrestricted Use Soil Cleanup Objectives (SCOs)
- Indicates value exceeds standard or guidance value

**FORMER BOUCHARD JUNKYARD SITE  
FINAL REMEDIATION REPORT  
POST-EXCAVATION SOIL SAMPLE RESULTS  
POLYCHLORINATED BIPHENYLS**

| Sample Identification | EP-L11  | EP-L12  | EP-L12(T8) | EP-L13  | EP-L13(T8) | EP-L13(T8A) | EP-L14  | EP-L15  | EP-L16  | EP-L17  |   |
|-----------------------|---------|---------|------------|---------|------------|-------------|---------|---------|---------|---------|---|
| Grid Location         | L, 11   | L, 12   | L, 12      | L, 13   | L, 13      | L, 13       | L, 14   | L, 15   | L, 16   | L, 17   | NYSDEC<br>Unrestricted Use<br>Soil Clean-Up<br>Objective<br>(ug/kg) |
| Sample Depth (feet)   | 1       | 1       | 1          | 1       | 1          | 1.5         | 1       | 1       | 1       | 1       |   |
| Date of Collection    | 8/7/08  | 7/18/08 | 8/19/08    | 7/18/08 | 8/19/08    | 9/11/08     | 7/18/08 | 7/18/08 | 7/16/08 | 7/14/08 |   |
| Dilution Factor       | 1.0     | 1.0     | 1.0        | 1.0     | 1.0        | 1.0         | 1.0     | 1.0     | 1.0     | 1.0     |   |
| Percent Moisture      | 7       | 4       | 6          | 6       | 8          | 7           | 6       | 16      | 13      | 9       |   |
| Units                 | (ug/kg) | (ug/kg) | (ug/kg)    | (ug/kg) | (ug/kg)    | (ug/kg)     | (ug/kg) | (ug/kg) | (ug/kg) | (ug/kg) |   |
| Aroclor-1016          | 520 U   | 530 U   | 530 U      | 520 U   | 530 U      | 480 U       | 510 U   | 610 U   | 590 U   | 500 U   | 1,000   |
| Aroclor-1221          | 520 U   | 530 U   | 530 U      | 520 U   | 530 U      | 480 U       | 510 U   | 610 U   | 590 U   | 500 U   | 1,000   |
| Aroclor-1232          | 520 U   | 530 U   | 530 U      | 520 U   | 530 U      | 480 U       | 510 U   | 610 U   | 590 U   | 500 U   | 1,000   |
| Aroclor-1242          | 520 U   | 530 U   | 530 U      | 520 U   | 530 U      | 480 U       | 510 U   | 610 U   | 590 U   | 500 U   | 1,000   |
| Aroclor-1248          | 520 U   | 530 U   | 530 U      | 520 U   | 530 U      | 480 U       | 510 U   | 610 U   | 590 U   | 500 U   | 1,000   |
| Aroclor-1254          | 520 U   | 530 U   | 530 U      | 520 U   | 530 U      | 480 U       | 510 U   | 610 U   | 590 U   | 500 U   | 1,000   |
| Aroclor-1260          | 520 U   | 690     | 530 U      | 520 U   | 1,700      | 490         | 510 U   | 610 U   | 590 U   | 500 U   | 1,000   |
| <b>Total PCBs</b>     | ---     | 690     | ---        | ---     | 1,700      | 490         | ---     | ---     | ---     | ---     | 1,000   |

| Sample Identification | EP-L18  | EP-L19  | EP-L20  | EP-M1   | EP-M2   | EP-M3   | EP-M4    | EP-M5    | EP-M6    | EP-M7    |   |
|-----------------------|---------|---------|---------|---------|---------|---------|----------|----------|----------|----------|---|
| Grid Location         | L, 18   | L, 19   | L, 20   | M, 1    | M, 2    | M, 3    | M, 4     | M, 5     | M, 6     | M, 7     | NYSDEC<br>Unrestricted Use<br>Soil Clean-Up<br>Objective<br>(ug/kg) |
| Sample Depth (feet)   | 1       | 1       | 1       | 1       | 1       | 1       | 1        | 1        | 1        | 1        |   |
| Date of Collection    | 6/13/08 | 6/12/08 | 6/12/08 | 8/18/08 | 7/28/08 | 7/28/08 | 10/13/08 | 10/13/08 | 10/13/08 | 10/13/08 |   |
| Dilution Factor       | 1.0     | 1.0     | 1.0     | 1.0     | 1.0     | 1.0     | 1.0      | 1.0      | 1.0      | 1.0      |   |
| Percent Moisture      | 12      | 5       | 5       | 17      | 13      | 19      | 5        | 8        | 22       | 21       |   |
| Units                 | (ug/kg) | (ug/kg) | (ug/kg) | (ug/kg) | (ug/kg) | (ug/kg) | (ug/kg)  | (ug/kg)  | (ug/kg)  | (ug/kg)  |   |
| Aroclor-1016          | 580 U   | 530 U   | 540 U   | 600 U   | 560 U   | 630 U   | 510 U    | 500 U    | 610 U    | 580 U    | 1,000   |
| Aroclor-1221          | 580 U   | 530 U   | 540 U   | 600 U   | 560 U   | 630 U   | 510 U    | 500 U    | 610 U    | 580 U    | 1,000   |
| Aroclor-1232          | 580 U   | 530 U   | 540 U   | 600 U   | 560 U   | 630 U   | 510 U    | 500 U    | 610 U    | 580 U    | 1,000   |
| Aroclor-1242          | 580 U   | 530 U   | 540 U   | 600 U   | 560 U   | 630 U   | 510 U    | 500 U    | 610 U    | 580 U    | 1,000   |
| Aroclor-1248          | 580 U   | 530 U   | 540 U   | 600 U   | 560 U   | 630 U   | 510 U    | 500 U    | 610 U    | 580 U    | 1,000   |
| Aroclor-1254          | 580 U   | 530 U   | 540 U   | 600 U   | 560 U   | 630 U   | 510 U    | 500 U    | 610 U    | 580 U    | 1,000   |
| Aroclor-1260          | 580 U   | 530 U   | 540 U   | 600 U   | 560 J   | 980     | 510 U    | 500 U    | 610 U    | 3,600    | 1,000   |
| <b>Total PCBs</b>     | ---     | ---     | ---     | ---     | ---     | 980     | ---      | ---      | ---      | 3,600    | 1,000   |

**QUALIFIERS:**

- B: Compound found in the method blank as well as the sample
- D: Result taken from a reanalysis at a secondary dilution
- J: Compound found at a concentration below the CRDL, value estimated
- U: Compound analyzed for but not detected

**NOTES:**

- All concentrations are in micrograms per kilogram (ug/kg) or parts per billion (ppb)
- 1: 6 NYCRR PART 375 - Table 375-6.8(a): Unrestricted Use Soil Cleanup Objectives (SCOs)
- 
 Indicates value exceeds standard or guidance value

FORMER BOUCHARD JUNKYARD SITE  
FINAL REMEDIATION REPORT  
POST-EXCAVATION SOIL SAMPLE RESULTS  
POLYCHLORINATED BIPHENYLS

| Sample Identification | EP-M7A   | EP-M8   | EP-M8A  | EP-M8(18) | EP-M9   | EP-M10  | EP-M11(12) | EP-M11(12A) | EP-M11(18) | EP-M12(12) |               |
|-----------------------|----------|---------|---------|-----------|---------|---------|------------|-------------|------------|------------|---------------|
| Grid Location         | M, 7     | M, 8    | M, 8    | M, 8      | M, 9    | M, 10   | M, 11      | M, 11       | M, 11      | M, 12      | NYSDEC        |
| Sample Depth (feet)   | 1.5      | 1       | 2       | 1.5       | 1       | 1       | 1          | 1.5         | 1.5        | 1          |               |
| Date of Collection    | 10/17/08 | 9/4/08  | 9/12/08 | 9/15/08   | 6/17/08 | 6/18/08 | 8/18/08    | 9/11/08     | 7/22/08    | 8/18/08    |               |
| Dilution Factor       | 1.0      | 1.0     | 1.0     | 1.0       | 1.0     | 1.0     | 1.0        | 1.0         | 1.0        | 1.0        | Soil Clean-Up |
| Percent Moisture      | 11       | 20      | 25      | 34        | 6       | 4       | 15         | 18          | 6          | 5          | Objective     |
| Units                 | (ug/kg)  | (ug/kg) | (ug/kg) | (ug/kg)   | (ug/kg) | (ug/kg) | (ug/kg)    | (ug/kg)     | (ug/kg)    | (ug/kg)    | (ug/kg)       |
| Aroclor-1016          | 540 U    | 600 U   | 670 U   | 760 U     | 490 U   | 530 U   | 580 U      | 540 U       | 540 U      | 530 U      | 1,000         |
| Aroclor-1221          | 540 U    | 600 U   | 670 U   | 760 U     | 490 U   | 530 U   | 580 U      | 540 U       | 540 U      | 530 U      | 1,000         |
| Aroclor-1232          | 540 U    | 600 U   | 670 U   | 760 U     | 490 U   | 530 U   | 580 U      | 540 U       | 540 U      | 530 U      | 1,000         |
| Aroclor-1242          | 540 U    | 600 U   | 670 U   | 760 U     | 490 U   | 530 U   | 580 U      | 540 U       | 540 U      | 530 U      | 1,000         |
| Aroclor-1248          | 540 U    | 600 U   | 670 U   | 760 U     | 490 U   | 530 U   | 580 U      | 540 U       | 540 U      | 530 U      | 1,000         |
| Aroclor-1254          | 540 U    | 600 U   | 670 U   | 760 U     | 490 U   | 530 U   | 580 U      | 540 U       | 540 U      | 530 U      | 1,000         |
| Aroclor-1260          | 540 U    | 19,000  | 670 U   | 760 U     | 490 U   | 530 U   | 2,500      | 540 U       | 540 U      | 530 U      | 1,000         |
| <b>Total PCBs</b>     | ---      | 19,000  | ---     | ---       | ---     | ---     | 2,500      | ---         | ---        | ---        | 1,000         |

| Sample Identification | EP-M12(T8) | EP-M12(T8A) | EP-M12(18) | EP-M13  | EP-M13(1) | EP-M13(2) | EP-M13(3) | EP-M13A | EP-M13(T8) | EP-M13(T8A) |               |
|-----------------------|------------|-------------|------------|---------|-----------|-----------|-----------|---------|------------|-------------|---------------|
| Grid Location         | M, 12      | M, 12       | M, 12      | M, 13   | M, 13     | M, 13     | M, 13     | M, 13   | M, 13      | M, 13       | NYSDEC        |
| Sample Depth (feet)   | 1          | 2           | 1.5        | 1       | 1         | 1         | 1         | 1.5     | 1          | 1.5         |               |
| Date of Collection    | 8/19/08    | 9/11/08     | 7/22/08    | 7/22/08 | 7/28/08   | 7/28/08   | 7/28/08   | 8/14/08 | 7/22/08    | 7/31/08     |               |
| Dilution Factor       | 1.0        | 1.0         | 1.0        | 1.0     | 1.0       | 1.0       | 1.0       | 1.0     | 1.0        | 1.0         | Soil Clean-Up |
| Percent Moisture      | 17         | 8           | 7          | 17      | 6         | 17        | 18        | 11      | 6          | 5           | Objective     |
| Units                 | (ug/kg)    | (ug/kg)     | (ug/kg)    | (ug/kg) | (ug/kg)   | (ug/kg)   | (ug/kg)   | (ug/kg) | (ug/kg)    | (ug/kg)     | (ug/kg)       |
| Aroclor-1016          | 590 U      | 510 U       | 540 U      | 600 U   | 540 U     | 560 U     | 620 U     | 560 U   | 540 U      | 530 U       | 1,000         |
| Aroclor-1221          | 590 U      | 510 U       | 540 U      | 600 U   | 540 U     | 560 U     | 620 U     | 560 U   | 540 U      | 530 U       | 1,000         |
| Aroclor-1232          | 590 U      | 510 U       | 540 U      | 600 U   | 540 U     | 560 U     | 620 U     | 560 U   | 540 U      | 530 U       | 1,000         |
| Aroclor-1242          | 590 U      | 510 U       | 540 U      | 600 U   | 540 U     | 560 U     | 620 U     | 560 U   | 540 U      | 530 U       | 1,000         |
| Aroclor-1248          | 590 U      | 510 U       | 540 U      | 600 U   | 540 U     | 560 U     | 620 U     | 560 U   | 540 U      | 530 U       | 1,000         |
| Aroclor-1254          | 590 U      | 510 U       | 540 U      | 600 U   | 540 U     | 560 U     | 620 U     | 560 U   | 540 U      | 530 U       | 1,000         |
| Aroclor-1260          | 41,000     | 510 U       | 540 U      | 2,000   | 540 U     | 4,500     | 1,600     | 560 U   | 3,000      | 1,600       | 1,000         |
| <b>Total PCBs</b>     | 41,000     | ---         | ---        | 2,000   | ---       | 4,500     | 1,600     | ---     | 3,000      | 1,600       | 1,000         |

QUALIFIERS:

- B: Compound found in the method blank as well as the sample
- D: Result taken from a reanalysis at a secondary dilution
- J: Compound found at a concentration below the CRDL, value estimated
- U: Compound analyzed for but not detected

NOTES:

- All concentrations are in micrograms per kilogram (ug/kg) or parts per billion (ppb)
- 1: 6 NYCRR PART 375 - Table 375-6.8(a): Unrestricted Use Soil Cleanup Objectives (SCOs)
- Indicates value exceeds standard or guidance value

**FORMER BOUCHARD JUNKYARD SITE  
FINAL REMEDIATION REPORT  
POST-EXCAVATION SOIL SAMPLE RESULTS  
POLYCHLORINATED BIPHENYLS**

| Sample Identification | EP-M13(T8B) | EP-M14       | EP-M14(1) | EP-M14(2) | EP-M14(3) | EP-M14(4)    | EP-M14A | EP-M15(12) | EP-M15(18) | EP-M15(18A) |   |       |
|-----------------------|-------------|--------------|-----------|-----------|-----------|--------------|---------|------------|------------|-------------|---|-------|
| Grid Location         | M, 13       | M, 14        | M, 14     | M, 14     | M, 14     | M, 14        | M, 14   | M, 15      | M, 15      | M, 15       | NYSDEC<br>Unrestricted Use<br>Soil Clean-Up<br>Objective<br>(ug/kg) |       |
| Sample Depth (feet)   | 2           | 1            | 1         | 1         | 1         | 1            | 1.5     | 1          | 1.5        | 2           |   |       |
| Date of Collection    | 8/14/08     | 7/18/08      | 7/29/08   | 7/29/08   | 7/29/08   | 7/29/08      | 8/14/08 | 7/18/08    | 7/18/08    | 8/14/08     |   |       |
| Dilution Factor       | 1.0         | 1.0          | 1.0       | 1.0       | 1.0       | 1.0          | 1.0     | 1.0        | 1.0        | 1.0         |   |       |
| Percent Moisture      | 13          | 16           | 9         | 7         | 15        | 18           | 14      | 17         | 14         | 10          |   |       |
| Units                 | (ug/kg)     | (ug/kg)      | (ug/kg)   | (ug/kg)   | (ug/kg)   | (ug/kg)      | (ug/kg) | (ug/kg)    | (ug/kg)    | (ug/kg)     |   |       |
| Aroclor-1016          | 590 U       | 580 U        | 560 U     | 540 U     | 590 U     | 600 U        | 580 U   | 610 U      | 590 U      | 540 U       |   | 1,000 |
| Aroclor-1221          | 590 U       | 580 U        | 560 U     | 540 U     | 590 U     | 600 U        | 580 U   | 610 U      | 590 U      | 540 U       |   | 1,000 |
| Aroclor-1232          | 590 U       | 580 U        | 560 U     | 540 U     | 590 U     | 600 U        | 580 U   | 610 U      | 590 U      | 540 U       |   | 1,000 |
| Aroclor-1242          | 590 U       | 580 U        | 560 U     | 540 U     | 590 U     | 600 U        | 580 U   | 610 U      | 590 U      | 540 U       |   | 1,000 |
| Aroclor-1248          | 590 U       | 580 U        | 560 U     | 540 U     | 590 U     | 600 U        | 580 U   | 610 U      | 590 U      | 540 U       |   | 1,000 |
| Aroclor-1254          | 590 U       | 580 U        | 560 U     | 540 U     | 590 U     | 600 U        | 580 U   | 610 U      | 590 U      | 540 U       | 1,000   |       |
| Aroclor-1260          | 640         | <b>1,800</b> | 560 U     | 540 U     | 590 U     | <b>2,800</b> | 580 U   | 600 J      | 590 U      | 540 U       | 1,000   |       |
| <b>Total PCBs</b>     | 640         | <b>1,800</b> | ---       | ---       | ---       | <b>2,800</b> | ---     | 600        | ---        | ---         | 1,000   |       |

| Sample Identification | EP-M16  | EP-M17  | EP-M18  | EP-M19  | EP-N5    | EP-N6        | EP-N6A   | EP-N7    | EP-N8(12) | EP-N8(18) |   |       |
|-----------------------|---------|---------|---------|---------|----------|--------------|----------|----------|-----------|-----------|---|-------|
| Grid Location         | M, 16   | M, 17   | M, 18   | M, 19   | N, 5     | N, 6         | N, 6     | N, 7     | N, 8      | N, 8      | NYSDEC<br>Unrestricted Use<br>Soil Clean-Up<br>Objective<br>(ug/kg) |       |
| Sample Depth (feet)   | 1       | 1       | 1       | 1       | 1        | 1            | 1.5      | 1        | 1         | 1.5       |   |       |
| Date of Collection    | 6/12/08 | 6/12/08 | 6/12/08 | 6/13/08 | 10/13/08 | 10/13/08     | 10/17/08 | 10/13/08 | 10/13/08  | 9/15/08   |   |       |
| Dilution Factor       | 1.0     | 1.0     | 1.0     | 1.0     | 1.0      | 1.0          | 1.0      | 1.0      | 1.0       | 1.0       |   |       |
| Percent Moisture      | 5       | 4       | 4       | 8       | 16       | 16           | 20       | 12       | 1         | 41        |   |       |
| Units                 | (ug/kg) | (ug/kg) | (ug/kg) | (ug/kg) | (ug/kg)  | (ug/kg)      | (ug/kg)  | (ug/kg)  | (ug/kg)   | (ug/kg)   |   |       |
| Aroclor-1016          | 520 U   | 500 U   | 530 U   | 540 U   | 520 U    | 580 U        | 600 U    | 540 U    | 520 U     | 830 U     |   | 1,000 |
| Aroclor-1221          | 520 U   | 500 U   | 530 U   | 540 U   | 520 U    | 580 U        | 600 U    | 540 U    | 520 U     | 830 U     |   | 1,000 |
| Aroclor-1232          | 520 U   | 500 U   | 530 U   | 540 U   | 520 U    | 580 U        | 600 U    | 540 U    | 520 U     | 830 U     |   | 1,000 |
| Aroclor-1242          | 520 U   | 500 U   | 530 U   | 540 U   | 520 U    | 580 U        | 600 U    | 540 U    | 520 U     | 830 U     |   | 1,000 |
| Aroclor-1248          | 520 U   | 500 U   | 530 U   | 540 U   | 520 U    | 580 U        | 600 U    | 540 U    | 520 U     | 830 U     |   | 1,000 |
| Aroclor-1254          | 520 U   | 500 U   | 530 U   | 540 U   | 520 U    | 580 U        | 600 U    | 540 U    | 520 U     | 830 U     | 1,000   |       |
| Aroclor-1260          | 520 U   | 500 U   | 530 U   | 540 U   | 520 U    | <b>2,500</b> | 600 U    | 570      | 520 U     | 830 U     | 1,000   |       |
| <b>Total PCBs</b>     | ---     | ---     | ---     | ---     | ---      | <b>2,500</b> | ---      | 570      | ---       | ---       | 1,000   |       |

**QUALIFIERS:**

- B: Compound found in the method blank as well as the sample
- D: Result taken from a reanalysis at a secondary dilution
- J: Compound found at a concentration below the CRDL, value estimated
- U: Compound analyzed for but not detected

**NOTES:**

- All concentrations are in micrograms per kilogram (ug/kg) or parts per billion (ppb)
- 1: 6 NYCRR PART 375 - Table 375-6.8(a): Unrestricted Use Soil Cleanup Objectives (SCOs)
- Indicates value exceeds standard or guidance value

**FORMER BOUCHARD JUNKYARD SITE  
FINAL REMEDIATION REPORT  
POST-EXCAVATION SOIL SAMPLE RESULTS  
POLYCHLORINATED BIPHENYLS**

| Sample Identification | EP-N9   | EP-N10(12)   | EP-N10(12A) | EP-N10(72)   | EP-N10(72A)  | EP-N10(72B) | EP-N10(T9) | EP-N11(18)    | EP-N11(18A) | EP-N11(T9)   |               |
|-----------------------|---------|--------------|-------------|--------------|--------------|-------------|------------|---------------|-------------|--------------|---------------|
| Grid Location         | N, 9    | N, 10        | N, 10       | N, 10        | N, 10        | N, 10       | N, 10      | N, 11         | N, 11       | N, 11        | NYSDEC        |
| Sample Depth (feet)   | 1.5     | 1            | 1.5         | 6            | 7            | 8           | 1          | 1.5           | 2           | 1            |               |
| Date of Collection    | 6/17/08 | 8/7/08       | 9/12/08     | 8/20/08      | 8/28/08      | 9/11/08     | 7/22/08    | 7/22/08       | 8/7/08      | 7/22/08      |               |
| Dilution Factor       | 1.0     | 1.0          | 1.0         | 1.0          | 1.0          | 1.0         | 1.0        | 1.0           | 1.0         | 1.0          | Soil Clean-Up |
| Percent Moisture      | 7       | 9            | 10          | 27           | 16           | 13          | 4          | 7             | 13          | 5            | Objective     |
| Units                 | (ug/kg) | (ug/kg)      | (ug/kg)     | (ug/kg)      | (ug/kg)      | (ug/kg)     | (ug/kg)    | (ug/kg)       | (ug/kg)     | (ug/kg)      | (ug/kg)       |
| Aroclor-1016          | 550 U   | 500 U        | 570 U       | 680 U        | 570 U        | 530 U       | 530 U      | 540 U         | 560 U       | 610 U        | 1,000         |
| Aroclor-1221          | 550 U   | 500 U        | 570 U       | 680 U        | 570 U        | 530 U       | 530 U      | 540 U         | 560 U       | 610 U        | 1,000         |
| Aroclor-1232          | 550 U   | 500 U        | 570 U       | 680 U        | 570 U        | 530 U       | 530 U      | 540 U         | 560 U       | 610 U        | 1,000         |
| Aroclor-1242          | 550 U   | 500 U        | 570 U       | 680 U        | 570 U        | 530 U       | 530 U      | 540 U         | 560 U       | 610 U        | 1,000         |
| Aroclor-1248          | 550 U   | 500 U        | 570 U       | 680 U        | 570 U        | 530 U       | 530 U      | 540 U         | 560 U       | 610 U        | 1,000         |
| Aroclor-1254          | 550 U   | 500 U        | 570 U       | 680 U        | 570 U        | 530 U       | 530 U      | 540 U         | 560 U       | 610 U        | 1,000         |
| Aroclor-1260          | 550 U   | <b>3,300</b> | 570 U       | <b>8,600</b> | <b>2,900</b> | 530 U       | 530 U      | <b>24,000</b> | 560 U       | <b>2,400</b> | 1,000         |
| <b>Total PCBs</b>     | ----    | <b>3,300</b> | ----        | <b>8,600</b> | <b>2,900</b> | ----        | ----       | <b>24,000</b> | ----        | <b>2,400</b> | 1,000         |

| Sample Identification | EP-N11(T9A) | EP-N12(18)   | EP-N12(18A) | EP-N13  | EP-N14  | EP-N15  | EP-N16  | EP-N16(T3)   | EP-N16(T3)(1) | EP-N16(T3)(2) |               |
|-----------------------|-------------|--------------|-------------|---------|---------|---------|---------|--------------|---------------|---------------|---------------|
| Grid Location         | N, 11       | N, 12        | N, 12       | N, 13   | N, 14   | N, 15   | N, 16   | N, 16        | N, 16         | N, 16         | NYSDEC        |
| Sample Depth (feet)   | 1.5         | 1.5          | 2           | 1       | 1       | 1       | 1       | 1            | 1             | 1             |               |
| Date of Collection    | 7/31/08     | 7/22/08      | 9/11/08     | 6/13/08 | 6/13/08 | 6/13/08 | 6/13/08 | 7/10/08      | 7/14/08       | 7/14/08       |               |
| Dilution Factor       | 1.0         | 1.0          | 1.0         | 1.0     | 1.0     | 1.0     | 1.0     | 1.0          | 1.0           | 1.0           | Soil Clean-Up |
| Percent Moisture      | 11          | 5            | 11          | 8       | 20      | 4       | 6       | 6            | 8.3           | 6.6           | Objective     |
| Units                 | (ug/kg)     | (ug/kg)      | (ug/kg)     | (ug/kg) | (ug/kg) | (ug/kg) | (ug/kg) | (ug/kg)      | (ug/kg)       | (ug/kg)       | (ug/kg)       |
| Aroclor-1016          | 570 U       | 530 U        | 490 U       | 550 U   | 600 U   | 500 U   | 520 U   | 530 U        | 500 U         | 550 U         | 1,000         |
| Aroclor-1221          | 570 U       | 530 U        | 490 U       | 550 U   | 600 U   | 500 U   | 520 U   | 530 U        | 500 U         | 550 U         | 1,000         |
| Aroclor-1232          | 570 U       | 530 U        | 490 U       | 550 U   | 600 U   | 500 U   | 520 U   | 530 U        | 500 U         | 550 U         | 1,000         |
| Aroclor-1242          | 570 U       | 530 U        | 490 U       | 550 U   | 600 U   | 500 U   | 520 U   | 530 U        | 500 U         | 550 U         | 1,000         |
| Aroclor-1248          | 570 U       | 530 U        | 490 U       | 550 U   | 600 U   | 500 U   | 520 U   | 530 U        | 500 U         | 550 U         | 1,000         |
| Aroclor-1254          | 570 U       | 530 U        | 490 U       | 550 U   | 600 U   | 500 U   | 520 U   | 530 U        | 500 U         | 550 U         | 1,000         |
| Aroclor-1260          | 570 U       | <b>1,400</b> | 490 U       | 550 U   | 600 U   | 500 U   | 520 U   | <b>1,500</b> | <b>5,300</b>  | 550 U         | 1,000         |
| <b>Total PCBs</b>     | ----        | <b>1,400</b> | ----        | ----    | ----    | ----    | ----    | <b>1,500</b> | <b>5,300</b>  | ----          | 1,000         |

**QUALIFIERS:**

- B: Compound found in the method blank as well as the sample
- D: Result taken from a reanalysis at a secondary dilution
- J: Compound found at a concentration below the CRDL, value estimated
- U: Compound analyzed for but not detected

**NOTES:**

- All concentrations are in micrograms per kilogram (ug/kg) or parts per billion (ppb)
- 1: 6 NYCRR PART 375 - Table 375-6.8(a): Unrestricted Use Soil Cleanup Objectives (SCOs)
- Indicates value exceeds standard or guidance value

FORMER BOUCHARD JUNKYARD SITE  
FINAL REMEDIATION REPORT  
POST-EXCAVATION SOIL SAMPLE RESULTS  
POLYCHLORINATED BIPHENYLS

| Sample Identification | EP-N16(T3)(1A) | EP-N17  | EP-N17(T3) | EP-N18  | EP-O6(12) | EP-O7(12) | EP-O7(18) | EP-O8(12) | EP-O8(18) |                  |
|-----------------------|----------------|---------|------------|---------|-----------|-----------|-----------|-----------|-----------|------------------|
| Grid Location         | N, 16          | N, 17   | N, 17      | N, 18   | O, 6      | O, 7      | O, 7      | O, 8      | O, 8      | NYSDEC           |
| Sample Depth (feet)   | 1.5            | 1       | 1          | 1       | 1         | 1         | 1.5       | 1         | 1.5       |                  |
| Date of Collection    | 7/22/08        | 7/9/08  | 7/10/08    | 7/9/08  | 10/10/08  | 10/10/08  | 19/17/08  | 19/17/08  | 9/15/08   | Unrestricted Use |
| Dilution Factor       | 1.0            | 1.0     | 1.0        | 1.0     | 1.0       | 1.0       | 1.0       | 1.0       | 1.0       | Soil Clean-Up    |
| Percent Moisture      | 5              | 5       | 4          | 19      | 11        | 16        | 10        | 17        | 24        | Objective        |
| Units                 | (ug/kg)        | (ug/kg) | (ug/kg)    | (ug/kg) | (ug/kg)   | (ug/kg)   | (ug/kg)   | (ug/kg)   | (ug/kg)   | (ug/kg)          |
| Aroclor-1016          | 530 U          | 490 U   | 510 U      | 620 U   | 540 U     | 610 U     | 520 U     | 600 U     | 650 U     | 1,000            |
| Aroclor-1221          | 530 U          | 490 U   | 510 U      | 620 U   | 540 U     | 610 U     | 520 U     | 600 U     | 650 U     | 1,000            |
| Aroclor-1232          | 530 U          | 490 U   | 510 U      | 620 U   | 540 U     | 610 U     | 520 U     | 600 U     | 650 U     | 1,000            |
| Aroclor-1242          | 530 U          | 490 U   | 510 U      | 620 U   | 540 U     | 610 U     | 520 U     | 600 U     | 650 U     | 1,000            |
| Aroclor-1248          | 530 U          | 490 U   | 510 U      | 620 U   | 540 U     | 610 U     | 520 U     | 600 U     | 650 U     | 1,000            |
| Aroclor-1254          | 530 U          | 490 U   | 510 U      | 620 U   | 540 U     | 610 U     | 520 U     | 600 U     | 650 U     | 1,000            |
| Aroclor-1260          | 530 U          | 490 U   | 510 U      | 620 U   | 540 U     | 610 U     | 520 U     | 600 U     | 650 U     | 1,000            |
| <b>Total PCBs</b>     | ----           | ----    | ----       | ----    | ----      | ----      | ----      | ----      | ----      | 1,000            |

| Sample Identification | EP-O9   | EP-O10  | EP-O10(T9)   | EP-O10(T9A) | EP-O11(T9) | EP-O12  | EP-O13  | EP-O13(T6)(108) | EP-O14  |                  |
|-----------------------|---------|---------|--------------|-------------|------------|---------|---------|-----------------|---------|------------------|
| Grid Location         | O, 9    | O, 10   | O, 10        | O, 10       | O, 11      | O, 12   | O, 13   | O, 13           | O, 14   | NYSDEC           |
| Sample Depth (feet)   | 1.5     | 1       | 1            | 1.5         | 1          | 1       | 1       | 9               | 1       |                  |
| Date of Collection    | 6/17/08 | 8/7/08  | 7/22/08      | 7/31/08     | 7/22/08    | 6/17/08 | 6/13/08 | 10/14/08        | 6/13/08 | Unrestricted Use |
| Dilution Factor       | 1.0     | 1.0     | 1.0          | 1.0         | 1.0        | 1.0     | 1.0     | 1.0             | 1.0     | Soil Clean-Up    |
| Percent Moisture      | 9       | 6       | 5            | 12          | 17         | 15      | 8       | 17              | 12      | Objective        |
| Units                 | (ug/kg) | (ug/kg) | (ug/kg)      | (ug/kg)     | (ug/kg)    | (ug/kg) | (ug/kg) | (ug/kg)         | (ug/kg) | (ug/kg)          |
| Aroclor-1016          | 560 U   | 500 U   | 540 U        | 570 U       | 610 U      | 600 U   | 540 U   | 580 U           | 570 U   | 1,000            |
| Aroclor-1221          | 560 U   | 500 U   | 540 U        | 570 U       | 610 U      | 600 U   | 540 U   | 580 U           | 570 U   | 1,000            |
| Aroclor-1232          | 560 U   | 500 U   | 540 U        | 570 U       | 610 U      | 600 U   | 540 U   | 580 U           | 570 U   | 1,000            |
| Aroclor-1242          | 560 U   | 500 U   | 540 U        | 570 U       | 610 U      | 600 U   | 540 U   | 580 U           | 570 U   | 1,000            |
| Aroclor-1248          | 560 U   | 500 U   | 540 U        | 570 U       | 610 U      | 600 U   | 540 U   | 580 U           | 570 U   | 1,000            |
| Aroclor-1254          | 560 U   | 500 U   | 540 U        | 570 U       | 610 U      | 600 U   | 540 U   | 580 U           | 570 U   | 1,000            |
| Aroclor-1260          | 560 U   | 500 U   | <b>8,100</b> | 570 U       | 610 U      | 600 U   | 540 U   | 580 U           | 570 U   | 1,000            |
| <b>Total PCBs</b>     | ----    | ----    | <b>8,100</b> | ----        | ----       | ----    | ----    | ----            | ----    | 1,000            |

QUALIFIERS:

- B: Compound found in the method blank as well as the sample
- D: Result taken from a reanalysis at a secondary dilution
- J: Compound found at a concentration below the CRDL, value estimated
- U: Compound analyzed for but not detected

NOTES:

- All concentrations are in micrograms per kilogram (ug/kg) or parts per billion (ppb)
- 1: 6 NYCRR PART 375 - Table 375-6.8(a): Unrestricted Use Soil Cleanup Objectives (SCOs)
- Indicates value exceeds standard or guidance value

**FORMER BOUCHARD JUNKYARD SITE  
FINAL REMEDIATION REPORT  
POST-EXCAVATION SOIL SAMPLE RESULTS  
POLYCHLORINATED BIPHENYLS**

| Sample Identification | EP-O14(T6)(108) | EP-O15  | EP-O16       | EP-O16A | EP-O16(T3) | EP-O17  | EP-O17(T3) | EP-P6(12) | EP-P7(12) | EP-P7(18) |   |
|-----------------------|-----------------|---------|--------------|---------|------------|---------|------------|-----------|-----------|-----------|---|
| Grid Location         | O, 14           | O, 15   | O, 16        | O, 16   | O, 16      | O, 17   | O, 17      | P, 6      | P, 7      | P, 7      | NYSDEC<br>Unrestricted Use<br>Soil Clean-Up<br>Objective<br>(ug/kg) |
| Sample Depth (feet)   | 9               | 1       | 1            | 1.5     | 1          | 1       | 1          | 1         | 1         | 1.5       |   |
| Date of Collection    | 10/14/08        | 8/4/08  | 8/4/08       | 8/14/08 | 7/10/08    | 7/10/08 | 7/10/08    | 10/10/08  | 10/10/08  | 10/10/08  |   |
| Dilution Factor       | 1.0             | 1.0     | 1.0          | 1.0     | 1.0        | 1.0     | 1.0        | 1.0       | 1.0       | 1.0       |   |
| Percent Moisture      | 18              | 21      | 16           | 21      | 7          | 22      | 19         | 6         | 15        | 7         |   |
| Units                 | (ug/kg)         | (ug/kg) | (ug/kg)      | (ug/kg) | (ug/kg)    | (ug/kg) | (ug/kg)    | (ug/kg)   | (ug/kg)   | (ug/kg)   |   |
| Aroclor-1016          | 600 U           | 650 U   | 600 U        | 620 U   | 550 U      | 630 U   | 610 U      | 520 U     | 570 U     | 550 U     | 1,000   |
| Aroclor-1221          | 600 U           | 650 U   | 600 U        | 620 U   | 550 U      | 630 U   | 610 U      | 520 U     | 570 U     | 550 U     | 1,000   |
| Aroclor-1232          | 600 U           | 650 U   | 600 U        | 620 U   | 550 U      | 630 U   | 610 U      | 520 U     | 570 U     | 550 U     | 1,000   |
| Aroclor-1242          | 600 U           | 650 U   | 600 U        | 620 U   | 550 U      | 630 U   | 610 U      | 520 U     | 570 U     | 550 U     | 1,000   |
| Aroclor-1248          | 600 U           | 650 U   | 600 U        | 620 U   | 550 U      | 630 U   | 610 U      | 520 U     | 570 U     | 550 U     | 1,000   |
| Aroclor-1254          | 600 U           | 650 U   | 600 U        | 620 U   | 550 U      | 630 U   | 610 U      | 520 U     | 570 U     | 550 U     | 1,000   |
| Aroclor-1260          | 600 U           | 650 U   | <b>1,400</b> | 620 U   | 550 U      | 630 U   | 610 U      | 520 U     | 570 U     | 550 U     | 1,000   |
| <b>Total PCBs</b>     | ---             | ---     | <b>1,400</b> | ---     | ---        | ---     | ---        | ---       | ---       | ---       | 1,000   |

| Sample Identification | EP-P8(18) | EP-P9   | EP-P10  | EP-P11  | EP-P12  | EP-P13(12) | EP-P13(18) | EP-P13(T6)(108) | EP-P14(12)   | EP-P14(12A) |   |
|-----------------------|-----------|---------|---------|---------|---------|------------|------------|-----------------|--------------|-------------|---|
| Grid Location         | P, 8      | P, 9    | P, 10   | P, 11   | P, 12   | P, 13      | P, 13      | P, 13           | P, 14        | P, 14       | NYSDEC<br>Unrestricted Use<br>Soil Clean-Up<br>Objective<br>(ug/kg) |
| Sample Depth (feet)   | 1.5       | 1.5     | 1       | 1.5     | 1       | 1          | 1.5        | 9               | 1            | 1.5         |   |
| Date of Collection    | 9/5/08    | 6/17/08 | 8/7/08  | 6/17/08 | 6/17/08 | 8/5/08     | 8/5/08     | 10/14/08        | 8/5/08       | 9/11/08     |   |
| Dilution Factor       | 1.0       | 1.0     | 1.0     | 1.0     | 1.0     | 1.0        | 1.0        | 1.0             | 1.0          | 1.0         |   |
| Percent Moisture      | 12        | 22      | 9       | 24      | 17      | 19         | 10         | 19              | 21           | 18          |   |
| Units                 | (ug/kg)   | (ug/kg) | (ug/kg) | (ug/kg) | (ug/kg) | (ug/kg)    | (ug/kg)    | (ug/kg)         | (ug/kg)      | (ug/kg)     |   |
| Aroclor-1016          | 540 U     | 620 U   | 510 U   | 620 U   | 610 U   | 610 U      | 570 U      | 590 U           | 650 U        | 580 U       | 1,000   |
| Aroclor-1221          | 540 U     | 620 U   | 510 U   | 620 U   | 610 U   | 610 U      | 570 U      | 590 U           | 650 U        | 580 U       | 1,000   |
| Aroclor-1232          | 540 U     | 620 U   | 510 U   | 620 U   | 610 U   | 610 U      | 570 U      | 590 U           | 650 U        | 580 U       | 1,000   |
| Aroclor-1242          | 540 U     | 620 U   | 510 U   | 620 U   | 610 U   | 610 U      | 570 U      | 590 U           | 650 U        | 580 U       | 1,000   |
| Aroclor-1248          | 540 U     | 620 U   | 510 U   | 620 U   | 610 U   | 610 U      | 570 U      | 590 U           | 650 U        | 580 U       | 1,000   |
| Aroclor-1254          | 540 U     | 620 U   | 510 U   | 620 U   | 610 U   | 610 U      | 570 U      | 590 U           | 650 U        | 580 U       | 1,000   |
| Aroclor-1260          | 540 U     | 620 U   | 510 U   | 620 U   | 610 U   | 630        | 570 U      | 590 U           | <b>6,400</b> | 580 U       | 1,000   |
| <b>Total PCBs</b>     | ---       | ---     | ---     | ---     | ---     | 630        | ---        | ---             | <b>6,400</b> | ---         | 1,000   |

**QUALIFIERS:**

- B: Compound found in the method blank as well as the sample
- D: Result taken from a reanalysis at a secondary dilution
- J: Compound found at a concentration below the CRDL, value estimated
- U: Compound analyzed for but not detected

**NOTES:**

- All concentrations are in micrograms per kilogram (ug/kg) or parts per billion (ppb)
- 1: 6 NYCRR PART 375 - Table 375-6.8(a): Unrestricted Use Soil Cleanup Objectives (SCOs)
- Indicates value exceeds standard or guidance value

**FORMER BOUCHARD JUNKYARD SITE  
FINAL REMEDIATION REPORT  
POST-EXCAVATION SOIL SAMPLE RESULTS  
POLYCHLORINATED BIPHENYLS**

| Sample Identification | EP-P14(T6)(108) | EP-P15  | EP-P16  | EP-Q9   | EP-Q9A  | EP-Q10  | EP-Q11  | EP-Q12  | EP-Q13(12) | EP-Q13(12A) |                            |
|-----------------------|-----------------|---------|---------|---------|---------|---------|---------|---------|------------|-------------|----------------------------|
| Grid Location         | P, 14           | P, 15   | P, 16   | Q, 9    | Q, 9    | Q, 10   | Q, 11   | Q, 12   | Q, 13      | Q, 13       | NYSDEC<br>Unrestricted Use |
| Sample Depth (feet)   | 9               | 1       | 1       | 1       | 1.5     | 1.5     | 1.5     | 1.5     | 1          | 1.5         |                            |
| Date of Collection    | 10/14/08        | 8/4/08  | 8/4/08  | 6/17/08 | 6/24/08 | 6/17/08 | 6/17/08 | 6/17/08 | 8/5/08     | 9/15/08     |                            |
| Dilution Factor       | 1.0             | 1.0     | 1.0     | 1.0     | 1.0     | 1.0     | 1.0     | 1.0     | 1.0        | 1.0         |                            |
| Percent Moisture      | 24              | 12      | 23      | 13      | 20      | 20      | 16      | 30      | 24         | 17          | Objective<br>(ug/kg)       |
| Units                 | (ug/kg)         | (ug/kg) | (ug/kg) | (ug/kg) | (ug/kg) | (ug/kg) | (ug/kg) | (ug/kg) | (ug/kg)    | (ug/kg)     |                            |
| Aroclor-1016          | 660 U           | 580 U   | 660 U   | 550 U   | 600 U   | 600 U   | 600 U   | 660 U   | 670 U      | 580 U       | 1,000                      |
| Aroclor-1221          | 660 U           | 580 U   | 660 U   | 550 U   | 600 U   | 600 U   | 600 U   | 660 U   | 670 U      | 580 U       | 1,000                      |
| Aroclor-1232          | 660 U           | 580 U   | 660 U   | 550 U   | 600 U   | 600 U   | 600 U   | 660 U   | 670 U      | 580 U       | 1,000                      |
| Aroclor-1242          | 660 U           | 580 U   | 660 U   | 550 U   | 600 U   | 600 U   | 600 U   | 660 U   | 670 U      | 580 U       | 1,000                      |
| Aroclor-1248          | 660 U           | 580 U   | 660 U   | 550 U   | 600 U   | 600 U   | 600 U   | 660 U   | 670 U      | 580 U       | 1,000                      |
| Aroclor-1254          | 660 U           | 580 U   | 660 U   | 550 U   | 600 U   | 600 U   | 600 U   | 660 U   | 670 U      | 580 U       | 1,000                      |
| Aroclor-1260          | 660 U           | 580 U   | 660 U   | 26,000  | 600 U   | 600 U   | 600 U   | 660 U   | 9,800      | 1,500,000 E | 1,000                      |
| <b>Total PCBs</b>     | ----            | ----    | ----    | 26,000  | ----    | ----    | ----    | ----    | 9,800      | 1,500,000   | 1,000                      |

| Sample Identification | EP-Q13(12B) | EP-Q13(30) | EP-Q13(30A) | EP-Q13(30B) | EP-Q14(12) | EP-Q14(30) | EP-R6   | EP-R7   | EP-R8   | EP-R9   |                            |
|-----------------------|-------------|------------|-------------|-------------|------------|------------|---------|---------|---------|---------|----------------------------|
| Grid Location         | Q, 13       | Q, 13      | Q, 13       | Q, 13       | Q, 14      | Q, 14      | R, 6    | R, 7    | R, 8    | R, 9    | NYSDEC<br>Unrestricted Use |
| Sample Depth (feet)   | 4.5         | 2.5        | 3.5         | 4           | 1          | 2.5        | 1       | 1       | 1       | 1       |                            |
| Date of Collection    | 10/13/08    | 8/5/08     | 10/13/08    | 10/16/08    | 8/5/08     | 8/5/08     | 10/6/08 | 10/6/08 | 10/6/08 | 10/9/08 |                            |
| Dilution Factor       | 1.0         | 1.0        | 1.0         | 1.0         | 1.0        | 1.0        | 1.0     | 1.0     | 1.0     | 1.0     |                            |
| Percent Moisture      | 12          | 17         | 10          | 9           | 24         | 13         | 14      | 14      | 15      | 17      | Objective<br>(ug/kg)       |
| Units                 | (ug/kg)     | (ug/kg)    | (ug/kg)     | (ug/kg)     | (ug/kg)    | (ug/kg)    | (ug/kg) | (ug/kg) | (ug/kg) | (ug/kg) |                            |
| Aroclor-1016          | 530 U       | 600 U      | 540 U       | 520 U       | 670 U      | 560 U      | 590 U   | 570 U   | 600 U   | 610 U   | 1,000                      |
| Aroclor-1221          | 530 U       | 600 U      | 540 U       | 520 U       | 670 U      | 560 U      | 590 U   | 570 U   | 600 U   | 610 U   | 1,000                      |
| Aroclor-1232          | 530 U       | 600 U      | 540 U       | 520 U       | 670 U      | 560 U      | 590 U   | 570 U   | 600 U   | 610 U   | 1,000                      |
| Aroclor-1242          | 530 U       | 600 U      | 540 U       | 520 U       | 670 U      | 560 U      | 590 U   | 570 U   | 600 U   | 610 U   | 1,000                      |
| Aroclor-1248          | 530 U       | 600 U      | 540 U       | 520 U       | 670 U      | 560 U      | 590 U   | 570 U   | 600 U   | 610 U   | 1,000                      |
| Aroclor-1254          | 530 U       | 600 U      | 540 U       | 520 U       | 670 U      | 560 U      | 590 U   | 570 U   | 600 U   | 610 U   | 1,000                      |
| Aroclor-1260          | 530 U       | 4,600      | 2,800       | 520 U       | 670 U      | 560 U      | 590 U   | 570 U   | 720     | 5,500   | 1,000                      |
| <b>Total PCBs</b>     | ----        | 4,600      | 2,800       | ----        | ----       | ----       | ----    | ----    | 720     | 5,500   | 1,000                      |

**QUALIFIERS:**

- B: Compound found in the method blank as well as the sample
- D: Result taken from a reanalysis at a secondary dilution
- J: Compound found at a concentration below the CRDL, value estimated
- U: Compound analyzed for but not detected
- E: Compound concentration exceeds the calibration range for analysis

**NOTES:**

- All concentrations are in micrograms per kilogram (ug/kg) or parts per billion (ppb)
- 1: 6 NYCRR PART 375 - Table 375-6.8(a): Unrestricted Use Soil Cleanup Objectives (SCOs)
- Indicates value exceeds standard or guidance value

**FORMER BOUCHARD JUNKYARD SITE  
FINAL REMEDIATION REPORT  
POST-EXCAVATION SOIL SAMPLE RESULTS  
POLYCHLORINATED BIPHENYLS**

| Sample Identification | EP-R9A   | EP-R10   | EP-R11   | EP-R12   | EP-R13(12) | EP-R13(30) | EP-R14(30) | EP-S6   | EP-S7   | EP-S8        |               |
|-----------------------|----------|----------|----------|----------|------------|------------|------------|---------|---------|--------------|---------------|
| Grid Location         | R, 9     | R, 10    | R, 11    | R, 12    | R, 13      | R, 13      | R, 14      | S, 6    | S, 7    | S, 8         | NYSDEC        |
| Sample Depth (feet)   | 2        | 1        | 1        | 1        | 1          | 2.5        | 2.5        | 1       | 1       | 1            |               |
| Date of Collection    | 10/10/08 | 11/12/08 | 11/12/08 | 11/12/08 | 8/5/08     | 8/5/08     | 8/5/08     | 10/6/08 | 10/6/08 | 10/6/08      |               |
| Dilution Factor       | 1.0      | 1.0      | 1.0      | 1.0      | 1.0        | 1.0        | 1.0        | 1.0     | 1.0     | 1.0          | Soil Clean-Up |
| Percent Moisture      | 12       | 6        | 6        | 7        | 27         | 7          | 10         | 32      | 13      | 25           | Objective     |
| Units                 | (ug/kg)  | (ug/kg)  | (ug/kg)  | (ug/kg)  | (ug/kg)    | (ug/kg)    | (ug/kg)    | (ug/kg) | (ug/kg) | (ug/kg)      | (ug/kg)       |
| Aroclor-1016          | 520 U    | 500 U    | 510 U    | 530 U    | 700 U      | 550 U      | 570 U      | 740 U   | 550 U   | 640 U        | 1,000         |
| Aroclor-1221          | 520 U    | 500 U    | 510 U    | 530 U    | 700 U      | 550 U      | 570 U      | 740 U   | 550 U   | 640 U        | 1,000         |
| Aroclor-1232          | 520 U    | 500 U    | 510 U    | 530 U    | 700 U      | 550 U      | 570 U      | 740 U   | 550 U   | 640 U        | 1,000         |
| Aroclor-1242          | 520 U    | 500 U    | 510 U    | 530 U    | 700 U      | 550 U      | 570 U      | 740 U   | 550 U   | 640 U        | 1,000         |
| Aroclor-1248          | 520 U    | 500 U    | 510 U    | 530 U    | 700 U      | 550 U      | 570 U      | 740 U   | 550 U   | 640 U        | 1,000         |
| Aroclor-1254          | 520 U    | 500 U    | 510 U    | 530 U    | 700 U      | 550 U      | 570 U      | 740 U   | 550 U   | 640 U        | 1,000         |
| Aroclor-1260          | 520 U    | 500 U    | 510 U    | 530 U    | 700 U      | 550 U      | 570 U      | 740 U   | 550 U   | <b>2,300</b> | 1,000         |
| <b>Total PCBs</b>     | ----     | ----     | ----     | ----     | ----       | ----       | ----       | ----    | ----    | <b>2,300</b> | 1,000         |

| Sample Identification | EP-S8A  | EP-S9        | EP-S9A  | EP-S10(12)    | EP-S10(12A) | EP-S10(54) | EP-S11(12) | EP-S11(54) | EP-S12  | EP-T6   |               |
|-----------------------|---------|--------------|---------|---------------|-------------|------------|------------|------------|---------|---------|---------------|
| Grid Location         | S, 8    | S, 9         | S, 9    | S, 10         | S, 10       | S, 10      | S, 11      | S, 11      | S, 12   | T, 6    | NYSDEC        |
| Sample Depth (feet)   | 1.5     | 1            | 1.5     | 1             | 2           | 4.5        | 1          | 4.5        | 1       | 1       |               |
| Date of Collection    | 10/7/08 | 10/6/08      | 10/7/08 | 10/6/08       | 10/8/08     | 10/28/08   | 10/7/08    | 10/28/08   | 10/7/08 | 10/6/08 |               |
| Dilution Factor       | 1.0     | 1.0          | 1.0     | 1.0           | 1.0         | 1.0        | 1.0        | 1.0        | 1.0     | 1.0     | Soil Clean-Up |
| Percent Moisture      | 18      | 30           | 15      | 36            | 27          | 18         | 86         | 18         | 60      | 19      | Objective     |
| Units                 | (ug/kg) | (ug/kg)      | (ug/kg) | (ug/kg)       | (ug/kg)     | (ug/kg)    | (ug/kg)    | (ug/kg)    | (ug/kg) | (ug/kg) | (ug/kg)       |
| Aroclor-1016          | 610 U   | 710 U        | 600 U   | 800 U         | 660 U       | 610 U      | 3,500 U    | 590 U      | 1,200 U | 590 U   | 1,000         |
| Aroclor-1221          | 610 U   | 710 U        | 600 U   | 800 U         | 660 U       | 610 U      | 3,500 U    | 590 U      | 1,200 U | 590 U   | 1,000         |
| Aroclor-1232          | 610 U   | 710 U        | 600 U   | 800 U         | 660 U       | 610 U      | 3,500 U    | 590 U      | 1,200 U | 590 U   | 1,000         |
| Aroclor-1242          | 610 U   | 710 U        | 600 U   | 800 U         | 660 U       | 610 U      | 3,500 U    | 590 U      | 1,200 U | 590 U   | 1,000         |
| Aroclor-1248          | 610 U   | 710 U        | 600 U   | 800 U         | 660 U       | 610 U      | 3,500 U    | 590 U      | 1,200 U | 590 U   | 1,000         |
| Aroclor-1254          | 610 U   | 710 U        | 600 U   | 800 U         | 660 U       | 610 U      | 3,500 U    | 590 U      | 1,200 U | 590 U   | 1,000         |
| Aroclor-1260          | 610 U   | <b>2,000</b> | 600 U   | <b>10,000</b> | 660 U       | 610 U      | 3,500 U    | 590 U      | 1,200 U | 590 U   | 1,000         |
| <b>Total PCBs</b>     | ----    | <b>2,000</b> | ----    | <b>10,000</b> | ----        | ----       | ----       | ----       | ----    | ----    | 1,000         |

**QUALIFIERS:**

- B: Compound found in the method blank as well as the sample
- D: Result taken from a reanalysis at a secondary dilution
- J: Compound found at a concentration below the CRDL, value estimated
- U: Compound analyzed for but not detected

**NOTES:**

- All concentrations are in micrograms per kilogram (ug/kg) or parts per billion (ppb)
- 1: 6 NYCRR PART 375 - Table 375-6.8(a): Unrestricted Use Soil Cleanup Objectives (SCOs)
- Indicates value exceeds standard or guidance value

**FORMER BOUCHARD JUNKYARD SITE  
FINAL REMEDIATION REPORT  
POST-EXCAVATION SOIL SAMPLE RESULTS  
POLYCHLORINATED BIPHENYLS**

| Sample Identification | EP-T7        | EP-T7A  | EP-T8   | EP-T11(6) | EP-T11(12) | EP-T12(6) | EP-T12(12) | EP-U7   | EP-U8   | EP-U11(6) |   |       |
|-----------------------|--------------|---------|---------|-----------|------------|-----------|------------|---------|---------|-----------|---|-------|
| Grid Location         | T, 7         | T, 7    | T, 8    | T, 11     | T, 11      | T, 12     | T, 12      | U, 7    | U, 8    | U, 11     | NYSDEC<br>Unrestricted Use<br>Soil Clean-Up<br>Objective<br>(ug/kg) |       |
| Sample Depth (feet)   | 1            | 1.5     | 1       | 0.5       | 1          | 0.5       | 1          | 1       | 1       | 0.5       |   |       |
| Date of Collection    | 9/29/08      | 10/7/08 | 9/29/08 | 9/25/08   | 10/1/08    | 9/25/08   | 10/1/08    | 9/29/08 | 9/29/08 | 9/25/08   |   |       |
| Dilution Factor       | 1.0          | 1.0     | 1.0     | 1.0       | 1.0        | 1.0       | 1.0        | 1.0     | 1.0     | 1.0       |   |       |
| Percent Moisture      | 74           | 64      | 67      | 84        | 85         | 77        | 79         | 85      | 83      | 85        |   |       |
| Units                 | (ug/kg)      | (ug/kg) | (ug/kg) | (ug/kg)   | (ug/kg)    | (ug/kg)   | (ug/kg)    | (ug/kg) | (ug/kg) | (ug/kg)   |   |       |
| Aroclor-1016          | 1,900 U      | 1,400 U | 1,500 U | 3,100 U   | 3,300 U    | 2,100 U   | 2,300 U    | 3,400 U | 2,900 U | 3,400 U   |   | 1,000 |
| Aroclor-1221          | 1,900 U      | 1,400 U | 1,500 U | 3,100 U   | 3,300 U    | 2,100 U   | 2,300 U    | 3,400 U | 2,900 U | 3,400 U   |   | 1,000 |
| Aroclor-1232          | 1,900 U      | 1,400 U | 1,500 U | 3,100 U   | 3,300 U    | 2,100 U   | 2,300 U    | 3,400 U | 2,900 U | 3,400 U   |   | 1,000 |
| Aroclor-1242          | 1,900 U      | 1,400 U | 1,500 U | 3,100 U   | 3,300 U    | 2,100 U   | 2,300 U    | 3,400 U | 2,900 U | 3,400 U   |   | 1,000 |
| Aroclor-1248          | 1,900 U      | 1,400 U | 1,500 U | 3,100 U   | 3,300 U    | 2,100 U   | 2,300 U    | 3,400 U | 2,900 U | 3,400 U   |   | 1,000 |
| Aroclor-1254          | 1,900 U      | 1,400 U | 1,500 U | 3,100 U   | 3,300 U    | 2,100 U   | 2,300 U    | 3,400 U | 2,900 U | 3,400 U   | 1,000   |       |
| Aroclor-1260          | <b>3,400</b> | 1,400 U | 1,500 U | 3,100 U   | 3,300 U    | 2,100 U   | 2,300 U    | 3,400 U | 2,900 U | 3,400 U   | 1,000   |       |
| <b>Total PCBs</b>     | <b>3,400</b> | ----    | ----    | ----      | ----       | ----      | ----       | ----    | ----    | ----      | 1,000   |       |

| Sample Identification | EP-U12(6) | EP-V7   | EP-V8   | EP-UA10(12) | EP-UA10(18)   | EP-UA10(18A) | EP-UA11(12) | EP-VA8       | EP-VA8A      |  |   |       |
|-----------------------|-----------|---------|---------|-------------|---------------|--------------|-------------|--------------|--------------|--|---|-------|
| Grid Location         | U, 12     | V, 7    | V, 8    | UA, 10      | UA, 10        | UA, 10       | UA, 11      | VA, 8        | VA, 8        |  | NYSDEC<br>Unrestricted Use<br>Soil Clean-Up<br>Objective<br>(ug/kg) |       |
| Sample Depth (feet)   | 0.5       | 1       | 1       | 1           | 1.5           | 1.5          | 1           | 1            | 1.5          |  |   |       |
| Date of Collection    | 9/25/08   | 9/29/08 | 9/29/08 | 10/29/08    | 10/29/08      | 10/29/08     | 10/29/08    | 9/16/08      | 10/6/08      |  |   |       |
| Dilution Factor       | 1.0       | 1.0     | 1.0     | 1.0         | 1.0           | 1.0          | 1.0         | 1.0          | 1.0          |  |   |       |
| Percent Moisture      | 81        | 81      | 85      | 11          | 17            | 8            | 12          | 14           | 11           |  |   |       |
| Units                 | (ug/kg)   | (ug/kg) | (ug/kg) | (ug/kg)     | (ug/kg)       | (ug/kg)      | (ug/kg)     | (ug/kg)      | (ug/kg)      |  |   |       |
| Aroclor-1016          | 2,600 U   | 2,600 U | 3,300 U | 560 U       | 580 U         | 500 U        | 570 U       | 560 U        | 550 U        |  |   | 1,000 |
| Aroclor-1221          | 2,600 U   | 2,600 U | 3,300 U | 560 U       | 580 U         | 500 U        | 570 U       | 560 U        | 550 U        |  |   | 1,000 |
| Aroclor-1232          | 2,600 U   | 2,600 U | 3,300 U | 560 U       | 580 U         | 500 U        | 570 U       | 560 U        | 550 U        |  |   | 1,000 |
| Aroclor-1242          | 2,600 U   | 2,600 U | 3,300 U | 560 U       | 580 U         | 500 U        | 570 U       | 560 U        | 550 U        |  |   | 1,000 |
| Aroclor-1248          | 2,600 U   | 2,600 U | 3,300 U | 560 U       | 580 U         | 500 U        | 570 U       | 560 U        | 550 U        |  |   | 1,000 |
| Aroclor-1254          | 2,600 U   | 2,600 U | 3,300 U | 560 U       | 580 U         | 500 U        | 570 U       | 560 U        | 550 U        |  | 1,000   |       |
| Aroclor-1260          | 2,600 U   | 2,600 U | 3,300 U | 560 U       | <b>18,000</b> | 990          | 980         | <b>4,000</b> | <b>1,500</b> |  | 1,000   |       |
| <b>Total PCBs</b>     | ----      | ----    | ----    | ----        | <b>18,000</b> | 990          | 980         | <b>4,000</b> | <b>1,500</b> |  | 1,000   |       |

**QUALIFIERS:**

- B: Compound found in the method blank as well as the sample
- D: Result taken from a reanalysis at a secondary dilution
- J: Compound found at a concentration below the CRDL, value estimated
- U: Compound analyzed for but not detected

**NOTES:**

- All concentrations are in micrograms per kilogram (ug/kg) or parts per billion (ppb)
- 1: 6 NYCRR PART 375 - Table 375-6.8(a): Unrestricted Use Soil Cleanup Objectives (SCOs)
- Indicates value exceeds standard or guidance value

FORMER BOUCHARD JUNKYARD SITE  
FINAL REMEDIATION REPORT  
POST-EXCAVATION SOIL SAMPLE RESULTS  
POLYCHLORINATED BIPHENYLS

| Sample Identification | EP-VA8B  | EP-VA9  | EP-VA10(12) | EP-VA10(12A) | EP-VA10(18) | EP-VA10(18A) | EP-VA11(12) | EP-VA11(12A) | EP-VA11(12B) | EP-WA7  |               |
|-----------------------|----------|---------|-------------|--------------|-------------|--------------|-------------|--------------|--------------|---------|---------------|
| Grid Location         | VA, 8    | VA, 9   | VA, 10      | VA, 10       | VA, 10      | VA, 10       | VA, 11      | VA, 11       | VA, 11       | WA, 7   | NYSDEC        |
| Sample Depth (feet)   | 2        | 1       | 1           | 1            | 1.5         | 1.5          | 1           | 1            | 1.5          | 1       |               |
| Date of Collection    | 10/13/08 | 9/16/08 | 10/29/08    | 10/29/08     | 10/29/08    | 10/29/08     | 10/29/08    | 10/29/08     | 11/12/08     | 9/17/08 |               |
| Dilution Factor       | 1.0      | 1.0     | 1.0         | 1.0          | 1.0         | 1.0          | 1.0         | 1.0          | 1.0          | 1.0     | Soil Clean-Up |
| Percent Moisture      | 11       | 10      | 15          | 6            | 19          | 7            | 17          | 17           | 12           | 13      | Objective     |
| Units                 | (ug/kg)  | (ug/kg) | (ug/kg)     | (ug/kg)      | (ug/kg)     | (ug/kg)      | (ug/kg)     | (ug/kg)      | (ug/kg)      | (ug/kg) | (ug/kg)       |
| Aroclor-1016          | 590 U    | 560 U   | 570 U       | 530 U        | 590 U       | 520 U        | 610 U       | 600 U        | 530 U        | 560 U   | 1,000         |
| Aroclor-1221          | 590 U    | 560 U   | 570 U       | 530 U        | 590 U       | 520 U        | 610 U       | 600 U        | 530 U        | 560 U   | 1,000         |
| Aroclor-1232          | 590 U    | 560 U   | 570 U       | 530 U        | 590 U       | 520 U        | 610 U       | 600 U        | 530 U        | 560 U   | 1,000         |
| Aroclor-1242          | 590 U    | 560 U   | 570 U       | 530 U        | 590 U       | 520 U        | 610 U       | 600 U        | 530 U        | 560 U   | 1,000         |
| Aroclor-1248          | 590 U    | 560 U   | 570 U       | 530 U        | 590 U       | 520 U        | 610 U       | 600 U        | 530 U        | 560 U   | 1,000         |
| Aroclor-1254          | 590 U    | 560 U   | 570 U       | 530 U        | 590 U       | 520 U        | 610 U       | 600 U        | 530 U        | 560 U   | 1,000         |
| Aroclor-1260          | 590 U    | 560 U   | 8,900       | 530 U        | 14,000      | 520 U        | 12,000      | 25,000       | 530 U        | 560 U   | 1,000         |
| <b>Total PCBs</b>     | ----     | ----    | 8,900       | ----         | 14,000      | ----         | 12,000      | 25,000       | ----         | ----    | 1,000         |

| Sample Identification | EP-WA8  | EP-WA9  | EP-WA10(12) | EP-WA11(12) | EP-XA2  | EP-XA3  | EP-XA4  | EP-XA7  | EP-XA8  | EP-XA8A |               |
|-----------------------|---------|---------|-------------|-------------|---------|---------|---------|---------|---------|---------|---------------|
| Grid Location         | WA, 8   | WA, 9   | WA, 10      | WA, 11      | XA, 2   | XA, 3   | XA, 4   | XA, 7   | XA, 8   | XA, 8   | NYSDEC        |
| Sample Depth (feet)   | 1       | 1       | 1           | 1           | 1       | 1       | 1       | 1       | 1       | 1.5     |               |
| Date of Collection    | 9/16/08 | 9/16/08 | 10/29/08    | 10/29/08    | 8/26/08 | 8/26/08 | 8/26/08 | 9/17/08 | 9/17/08 | 10/6/08 |               |
| Dilution Factor       | 1.0     | 1.0     | 1.0         | 1.0         | 1.0     | 1.0     | 1.0     | 1.0     | 1.0     | 1.0     | Soil Clean-Up |
| Percent Moisture      | 17      | 9       | 11          | 15          | 13      | 16      | 22      | 16      | 13      | 9       | Objective     |
| Units                 | (ug/kg) | (ug/kg) | (ug/kg)     | (ug/kg)     | (ug/kg) | (ug/kg) | (ug/kg) | (ug/kg) | (ug/kg) | (ug/kg) | (ug/kg)       |
| Aroclor-1016          | 580 U   | 540 U   | 560 U       | 600 U       | 550 U   | 570 U   | 630 U   | 580 U   | 570 U   | 540 U   | 1,000         |
| Aroclor-1221          | 580 U   | 540 U   | 560 U       | 600 U       | 550 U   | 570 U   | 630 U   | 580 U   | 570 U   | 540 U   | 1,000         |
| Aroclor-1232          | 580 U   | 540 U   | 560 U       | 600 U       | 550 U   | 570 U   | 630 U   | 580 U   | 570 U   | 540 U   | 1,000         |
| Aroclor-1242          | 580 U   | 540 U   | 560 U       | 600 U       | 550 U   | 570 U   | 630 U   | 580 U   | 570 U   | 540 U   | 1,000         |
| Aroclor-1248          | 580 U   | 540 U   | 560 U       | 600 U       | 550 U   | 570 U   | 630 U   | 580 U   | 570 U   | 540 U   | 1,000         |
| Aroclor-1254          | 580 U   | 540 U   | 560 U       | 600 U       | 550 U   | 570 U   | 630 U   | 580 U   | 570 U   | 540 U   | 1,000         |
| Aroclor-1260          | 580 U   | 540 U   | 560 U       | 600 U       | 550 U   | 570 U   | 630 U   | 580 U   | 1,700   | 540 U   | 1,000         |
| <b>Total PCBs</b>     | ----    | ----    | ----        | ----        | ----    | ----    | ----    | ----    | 1,700   | ----    | 1,000         |

QUALIFIERS:

- B: Compound found in the method blank as well as the sample
- D: Result taken from a reanalysis at a secondary dilution
- J: Compound found at a concentration below the CRDL, value estimated
- U: Compound analyzed for but not detected

NOTES:

- All concentrations are in micrograms per kilogram (ug/kg) or parts per billion (ppb)
- 1: 6 NYCRR PART 375 - Table 375-6.8(a): Unrestricted Use Soil Cleanup Objectives (SCOs)
- Indicates value exceeds standard or guidance value

**FORMER BOUCHARD JUNKYARD SITE  
FINAL REMEDIATION REPORT  
POST-EXCAVATION SOIL SAMPLE RESULTS  
POLYCHLORINATED BIPHENYLS**

| Sample Identification | EP-XA9(18)      | EP-XA9(18A) | EP-XA10(18)   | EP-XA10(18A) | EP-XA11(12) | EP-YA1  | EP-YA2  | EP-YA3       | EP-YA3A | EP-YA4       |               |
|-----------------------|-----------------|-------------|---------------|--------------|-------------|---------|---------|--------------|---------|--------------|---------------|
| Grid Location         | XA, 9           | XA, 9       | XA, 10        | XA, 10       | XA, 11      | YA, 1   | YA, 2   | YA, 3        | YA, 3   | YA, 4        | NYSDEC        |
| Sample Depth (feet)   | 1.5             | 2.5         | 1.5           | 2            | 1           | 1       | 1       | 1            | 1.5     | 1            |               |
| Date of Collection    | 9/24/08         | 10/8/08     | 9/24/08       | 10/8/08      | 10/29/08    | 8/26/08 | 8/26/08 | 8/26/08      | 8/28/08 | 8/26/08      |               |
| Dilution Factor       | 1.0             | 1.0         | 1.0           | 1.0          | 1.0         | 1.0     | 1.0     | 1.0          | 1.0     | 1.0          | Soil Clean-Up |
| Percent Moisture      | 10              | 19          | 8             | 7            | 15          | 6       | 10      | 7            | 5       | 24           | Objective     |
| Units                 | (ug/kg)         | (ug/kg)     | (ug/kg)       | (ug/kg)      | (ug/kg)     | (ug/kg) | (ug/kg) | (ug/kg)      | (ug/kg) | (ug/kg)      | (ug/kg)       |
| Aroclor-1016          | 570 U           | 630 U       | 520 U         | 540 U        | 580 U       | 510 U   | 530 U   | 530 U        | 520 U   | 650 U        | 1,000         |
| Aroclor-1221          | 570 U           | 630 U       | 520 U         | 540 U        | 580 U       | 510 U   | 530 U   | 530 U        | 520 U   | 650 U        | 1,000         |
| Aroclor-1232          | 570 U           | 630 U       | 520 U         | 540 U        | 580 U       | 510 U   | 530 U   | 530 U        | 520 U   | 650 U        | 1,000         |
| Aroclor-1242          | 570 U           | 630 U       | 520 U         | 540 U        | 580 U       | 510 U   | 530 U   | 530 U        | 520 U   | 650 U        | 1,000         |
| Aroclor-1248          | 570 U           | 630 U       | 520 U         | 540 U        | 580 U       | 510 U   | 530 U   | 530 U        | 520 U   | 650 U        | 1,000         |
| Aroclor-1254          | 570 U           | 630 U       | 520 U         | 540 U        | 580 U       | 510 U   | 530 U   | 530 U        | 520 U   | 650 U        | 1,000         |
| Aroclor-1260          | <b>40,000 E</b> | 630 U       | <b>45,000</b> | 540 U        | 580 U       | 510 U   | 910     | <b>1,100</b> | 520 U   | <b>7,400</b> | 1,000         |
| <b>Total PCBs</b>     | <b>40,000</b>   | ----        | <b>45,000</b> | ----         | ----        | ----    | 910     | <b>1,100</b> | ----    | <b>7,400</b> | 1,000         |

| Sample Identification | EP-YA4A      | EP-YA4B | EP-YA5       | EP-YA5A | EP-YA6  | EP-YA7  | EP-YA8(12)   | EP-YA8(12A) | EP-YA8(18) | EP-YA9(18)   |               |
|-----------------------|--------------|---------|--------------|---------|---------|---------|--------------|-------------|------------|--------------|---------------|
| Grid Location         | YA, 4        | YA, 4   | YA, 5        | YA, 5   | YA, 6   | YA, 7   | YA, 8        | YA, 8       | YA, 8      | YA, 9        | NYSDEC        |
| Sample Depth (feet)   | 1.5          | 2       | 1            | 1.5     | 1       | 1       | 1            | 1.5         | 1.5        | 1.5          |               |
| Date of Collection    | 8/28/08      | 9/2/08  | 8/26/08      | 8/28/08 | 9/17/08 | 9/17/08 | 9/17/08      | 9/24/08     | 9/24/08    | 9/24/08      |               |
| Dilution Factor       | 1.0          | 1.0     | 1.0          | 1.0     | 1.0     | 1.0     | 1.0          | 1.0         | 1.0        | 1.0          | Soil Clean-Up |
| Percent Moisture      | 6            | 30      | 6            | 10      | 10      | 19      | 17           | 9           | 12         | 15           | Objective     |
| Units                 | (ug/kg)      | (ug/kg) | (ug/kg)      | (ug/kg) | (ug/kg) | (ug/kg) | (ug/kg)      | (ug/kg)     | (ug/kg)    | (ug/kg)      | (ug/kg)       |
| Aroclor-1016          | 500 U        | 660 U   | 530 U        | 560 U   | 570 U   | 620 U   | 610 U        | 550 U       | 580 U      | 580 U        | 1,000         |
| Aroclor-1221          | 500 U        | 660 U   | 530 U        | 560 U   | 570 U   | 620 U   | 610 U        | 550 U       | 580 U      | 580 U        | 1,000         |
| Aroclor-1232          | 500 U        | 660 U   | 530 U        | 560 U   | 570 U   | 620 U   | 610 U        | 550 U       | 580 U      | 580 U        | 1,000         |
| Aroclor-1242          | 500 U        | 660 U   | 530 U        | 560 U   | 570 U   | 620 U   | 610 U        | 550 U       | 580 U      | 580 U        | 1,000         |
| Aroclor-1248          | 500 U        | 660 U   | 530 U        | 560 U   | 570 U   | 620 U   | 610 U        | 550 U       | 580 U      | 580 U        | 1,000         |
| Aroclor-1254          | 500 U        | 660 U   | 530 U        | 560 U   | 570 U   | 620 U   | 610 U        | 550 U       | 580 U      | 580 U        | 1,000         |
| Aroclor-1260          | <b>2,300</b> | 660 U   | <b>4,300</b> | 560 U   | 570 U   | 620 U   | <b>4,300</b> | 550 U       | 810        | <b>2,700</b> | 1,000         |
| <b>Total PCBs</b>     | <b>2,300</b> | ----    | <b>4,300</b> | ----    | ----    | ----    | <b>4,300</b> | ----        | 810        | <b>2,700</b> | 1,000         |

**QUALIFIERS:**

- B: Compound found in the method blank as well as the sample
- D: Result taken from a reanalysis at a secondary dilution
- J: Compound found at a concentration below the CRDL, value estimated
- U: Compound analyzed for but not detected
- E: Compound concentration exceeds the calibration range for analysis

**NOTES:**

- All concentrations are in micrograms per kilogram (ug/kg) or parts per billion (ppb)
- 1: 6 NYCRR PART 375 - Table 375-6.8(a): Unrestricted Use Soil Cleanup Objectives (SCOs)
- Indicates value exceeds standard or guidance value

FORMER BOUCHARD JUNKYARD SITE  
FINAL REMEDIATION REPORT  
POST-EXCAVATION SOIL SAMPLE RESULTS  
POLYCHLORINATED BIPHENYLS

| Sample Identification | EP-YA9(18A)  | EP-YA10(18)   | EP-YA10(18A) | EP-YA10(18B) | EP-YA11(18)  | EP-YA11(18A) | EP-ZA1  | EP-ZA2  | EP-ZA3  | EP-ZA4  |               |
|-----------------------|--------------|---------------|--------------|--------------|--------------|--------------|---------|---------|---------|---------|---------------|
| Grid Location         | YA, 9        | YA, 10        | YA, 10       | YA, 10       | YA, 11       | YA, 11       | ZA, 1   | ZA, 2   | ZA, 3   | ZA, 4   | NYSDEC        |
| Sample Depth (feet)   | 2            | 1.5           | 2.5          | 3            | 1.5          | 1.5          | 1       | 1       | 1       | 1       |               |
| Date of Collection    | 10/8/08      | 9/24/08       | 10/8/08      | 10/29/08     | 10/29/08     | 10/29/08     | 8/26/08 | 8/26/08 | 8/26/08 | 8/26/08 |               |
| Dilution Factor       | 1.0          | 1.0           | 1.0          | 1.0          | 1.0          | 1.0          | 1.0     | 1.0     | 1.0     | 1.0     | Soil Clean-Up |
| Percent Moisture      | 17           | 10            | 23           | 20           | 17           | 23           | 12      | 20      | 22      | 16      | Objective     |
| Units                 | (ug/kg)      | (ug/kg)       | (ug/kg)      | (ug/kg)      | (ug/kg)      | (ug/kg)      | (ug/kg) | (ug/kg) | (ug/kg) | (ug/kg) | (ug/kg)       |
| Aroclor-1016          | 610 U        | 530 U         | 620 U        | 610 U        | 610 U        | 660 U        | 550 U   | 630 U   | 630 U   | 600 U   | 1,000         |
| Aroclor-1221          | 610 U        | 530 U         | 620 U        | 610 U        | 610 U        | 660 U        | 550 U   | 630 U   | 630 U   | 600 U   | 1,000         |
| Aroclor-1232          | 610 U        | 530 U         | 620 U        | 610 U        | 610 U        | 660 U        | 550 U   | 630 U   | 630 U   | 600 U   | 1,000         |
| Aroclor-1242          | 610 U        | 530 U         | 620 U        | 610 U        | 610 U        | 660 U        | 550 U   | 630 U   | 630 U   | 600 U   | 1,000         |
| Aroclor-1248          | 610 U        | 530 U         | 620 U        | 610 U        | 610 U        | 660 U        | 550 U   | 630 U   | 630 U   | 600 U   | 1,000         |
| Aroclor-1254          | 610 U        | 530 U         | 620 U        | 610 U        | 610 U        | 660 U        | 550 U   | 630 U   | 630 U   | 600 U   | 1,000         |
| Aroclor-1260          | 1,000        | 21,000        | 2,000        | 610 U        | 2,800        | 660 U        | 650     | 630 U   | 630 U   | 680     | 1,000         |
| <b>Total PCBs</b>     | <b>1,000</b> | <b>21,000</b> | <b>2,000</b> | ---          | <b>2,800</b> | ---          | 650     | ---     | ---     | 680     | 1,000         |

| Sample Identification | EP-ZA5  | EP-ZA6(ATREE) | EP-ZA6  | EP-ZA7       | EP-ZA7A | EP-ZA8(18) | EP-ZA9(18)     | EP-ZA9(18A)(1) | EP-ZA9(18A)(2) | EP-ZA9(18A)(3) |               |
|-----------------------|---------|---------------|---------|--------------|---------|------------|----------------|----------------|----------------|----------------|---------------|
| Grid Location         | ZA, 5   | ZA, 6         | ZA, 6   | ZA, 7        | ZA, 7   | ZA, 8      | ZA, 9          | ZA, 9          | ZA, 9          | ZA, 9          | NYSDEC        |
| Sample Depth (feet)   | 1       | 0.2           | 1       | 1            | 1.5     | 1.5        | 1.5            | 2.5            | 3.5            | 4.5            |               |
| Date of Collection    | 8/26/08 | 9/11/08       | 9/17/08 | 9/17/08      | 9/24/08 | 9/24/08    | 10/10/08       | 10/17/08       | 10/17/08       | 10/17/08       |               |
| Dilution Factor       | 1.0     | 1.0           | 1.0     | 1.0          | 1.0     | 1.0        | 1.0            | 1.0            | 1.0            | 1.0            | Soil Clean-Up |
| Percent Moisture      | 10      | 22            | 11      | 15           | 4       | 7          | 21             | 5              | 6              | 5              | Objective     |
| Units                 | (ug/kg) | (ug/kg)       | (ug/kg) | (ug/kg)      | (ug/kg) | (ug/kg)    | (ug/kg)        | (ug/kg)        | (ug/kg)        | (ug/kg)        | (ug/kg)       |
| Aroclor-1016          | 560 U   | 640 U         | 540 U   | 580 U        | 520 U   | 540 U      | 610 U          | 530 U          | 540 U          | 530 U          | 1,000         |
| Aroclor-1221          | 560 U   | 640 U         | 540 U   | 580 U        | 520 U   | 540 U      | 610 U          | 530 U          | 540 U          | 530 U          | 1,000         |
| Aroclor-1232          | 560 U   | 640 U         | 540 U   | 580 U        | 520 U   | 540 U      | 610 U          | 530 U          | 540 U          | 530 U          | 1,000         |
| Aroclor-1242          | 560 U   | 640 U         | 540 U   | 580 U        | 520 U   | 540 U      | 610 U          | 530 U          | 540 U          | 530 U          | 1,000         |
| Aroclor-1248          | 560 U   | 640 U         | 540 U   | 580 U        | 520 U   | 540 U      | 610 U          | 530 U          | 540 U          | 530 U          | 1,000         |
| Aroclor-1254          | 560 U   | 640 U         | 540 U   | 580 U        | 520 U   | 540 U      | 610 U          | 530 U          | 540 U          | 530 U          | 1,000         |
| Aroclor-1260          | 560 U   | 12,000        | 540 U   | 2,100        | 520 U   | 540 U      | 160,000 E      | 530 U          | 540 U          | 530 U          | 1,000         |
| <b>Total PCBs</b>     | ---     | <b>12,000</b> | ---     | <b>2,100</b> | ---     | ---        | <b>160,000</b> | ---            | ---            | ---            | 1,000         |

QUALIFIERS:

- B: Compound found in the method blank as well as the sample
- D: Result taken from a reanalysis at a secondary dilution
- J: Compound found at a concentration below the CRDL, value estimated
- U: Compound analyzed for but not detected
- E: Compound concentration exceeds the calibration range for analysis

NOTES:

- All concentrations are in micrograms per kilogram (ug/kg) or parts per billion (ppb)
- 1: 6 NYCRR PART 375 - Table 375-6.8(a): Unrestricted Use Soil Cleanup Objectives (SCOs)
- Indicates value exceeds standard or guidance value

FORMER BOUCHARD JUNKYARD SITE  
FINAL REMEDIATION REPORT  
POST-EXCAVATION SOIL SAMPLE RESULTS  
POLYCHLORINATED BIPHENYLS

| Sample Identification | EP-ZA10(18)   | EP-ZA10(18A)(1) | EP-ZA10(18A)(2) | EP-ZA10(18A)(3) | EP-ZA11(18) | EP-PSW01 | EP-PSW02 | EP-PSW03 | EP-PSW04 | EP-PSW05 |               |
|-----------------------|---------------|-----------------|-----------------|-----------------|-------------|----------|----------|----------|----------|----------|---------------|
| Grid Location         | ZA, 10        | ZA, 10          | ZA, 10          | ZA, 10          | ZA, 11      | PSW, 01  | PSW, 02  | PSW, 03  | PSW, 04  | PSW, 05  | NYSDEC        |
| Sample Depth (feet)   | 1.5           | 2.5             | 3.5             | 4.5             | 1.5         | ---      | ---      | ---      | ---      | ---      |               |
| Date of Collection    | 10/10/08      | 10/17/08        | 10/17/08        | 10/17/08        | 10/29/08    | 6/17/08  | 6/17/08  | 6/17/08  | 6/17/08  | 6/25/08  |               |
| Dilution Factor       | 1.0           | 1.0             | 1.0             | 1.0             | 1.0         | 1.0      | 1.0      | 1.0      | 1.0      | 1.0      | Soil Clean-Up |
| Percent Moisture      | 16            | 18              | 8               | 6               | 21          | 25       | 22       | 18       | 26       | 32       | Objective     |
| Units                 | (ug/kg)       | (ug/kg)         | (ug/kg)         | (ug/kg)         | (ug/kg)     | (ug/kg)  | (ug/kg)  | (ug/kg)  | (ug/kg)  | (ug/kg)  | (ug/kg)       |
| Aroclor-1016          | 560 U         | 600 U           | 510 U           | 520 U           | 620 U       | 680 U    | 640 U    | 600 U    | 680 U    | 720 U    | 1,000         |
| Aroclor-1221          | 560 U         | 600 U           | 510 U           | 520 U           | 620 U       | 680 U    | 640 U    | 600 U    | 680 U    | 720 U    | 1,000         |
| Aroclor-1232          | 560 U         | 600 U           | 510 U           | 520 U           | 620 U       | 680 U    | 640 U    | 600 U    | 680 U    | 720 U    | 1,000         |
| Aroclor-1242          | 560 U         | 600 U           | 510 U           | 520 U           | 620 U       | 680 U    | 640 U    | 600 U    | 680 U    | 720 U    | 1,000         |
| Aroclor-1248          | 560 U         | 600 U           | 510 U           | 520 U           | 620 U       | 680 U    | 640 U    | 600 U    | 680 U    | 720 U    | 1,000         |
| Aroclor-1254          | 560 U         | 600 U           | 510 U           | 520 U           | 620 U       | 680 U    | 640 U    | 600 U    | 680 U    | 720 U    | 1,000         |
| Aroclor-1260          | 67,000 E      | 600 U           | 670             | 520 U           | 850         | 680 U    | 640 U    | 590 J    | 680 U    | 760      | 1,000         |
| <b>Total PCBs</b>     | <b>67,000</b> | ----            | 670             | ----            | 850         | ----     | ----     | ----     | ----     | 760      | 1,000         |

| Sample Identification | EP-PSW06 | EP-PSW07 | EP-PSW07A | EP-PSW07B      | EP-PSW08 | EP-PSW08A | EP-PSW08B      | EP-PSW09 | EP-PSW10 | EP-PSW11 |               |
|-----------------------|----------|----------|-----------|----------------|----------|-----------|----------------|----------|----------|----------|---------------|
| Grid Location         | PSW, 06  | PSW, 07  | PSW, 07   | PSW, 07        | PSW, 08  | PSW, 08   | PSW, 08        | PSW, 09  | PSW, 10  | PSW, 11  | NYSDEC        |
| Sample Depth (feet)   | ---      | ---      | ---       | ---            | ---      | ---       | ---            | ---      | ---      | ---      |               |
| Date of Collection    | 6/25/08  | 6/26/08  | 7/1/08    | 7/2/08         | 6/26/08  | 7/1/08    | 7/2/08         | 6/26/08  | 6/26/08  | 7/7/08   |               |
| Dilution Factor       | 1.0      | 1.0      |           |                | 1.0      |           |                | 1.0      | 1.0      | 1.0      | Soil Clean-Up |
| Percent Moisture      | 16       | 23       |           |                | 17       |           |                | 10       | 11       | 17       | Objective     |
| Units                 | (ug/kg)  | (ug/kg)  | (ug/kg)   | (ug/kg)        | (ug/kg)  | (ug/kg)   | (ug/kg)        | (ug/kg)  | (ug/kg)  | (ug/kg)  | (ug/kg)       |
| Aroclor-1016          | 610 U    | 640 U    |           | 16             | 600 U    |           | 16             | 540 U    | 570 U    | 600 U    | 1,000         |
| Aroclor-1221          | 610 U    | 640 J    | SAMPLE    | DELINEATION    | 600 J    | SAMPLE    | DELINEATION    | 540 U    | 570 U    | 600 U    | 1,000         |
| Aroclor-1232          | 610 U    | 640 U    | JAR       | SAMPLES        | 600 U    | JAR       | SAMPLES        | 540 U    | 570 U    | 600 U    | 1,000         |
| Aroclor-1242          | 610 U    | 640 U    | BROKEN    | COLLECTED      | 600 U    | BROKEN    | COLLECTED      | 540 U    | 570 U    | 600 U    | 1,000         |
| Aroclor-1248          | 610 U    | 640 U    |           | 7/3/2008       | 600 U    |           | 7/3/2008       | 540 U    | 570 U    | 600 U    | 1,000         |
| Aroclor-1254          | 610 U    | 640 U    |           | SEE PATELL     | 600 U    |           | SEE PATELL     | 540 U    | 570 U    | 600 U    | 1,000         |
| Aroclor-1260          | 610 U    | 1800     |           | SAMPLE RESULTS | 2,200    |           | SAMPLE RESULTS | 540 U    | 570 U    | 600 U    | 1,000         |
| <b>Total PCBs</b>     | ----     | ----     | ----      | ----           | 2,200    | ----      | ----           | ----     | ----     | ----     | 1,000         |

QUALIFIERS:

- B: Compound found in the method blank as well as the sample
- D: Result taken from a reanalysis at a secondary dilution
- J: Compound found at a concentration below the CRDL, value estimated
- U: Compound analyzed for but not detected
- E: Compound concentration exceeds the calibration range for analysis

NOTES:

- All concentrations are in micrograms per kilogram (ug/kg) or parts per billion (ppb)
- 1: 6 NYCRR PART 375 - Table 375-6.8(a): Unrestricted Use Soil Cleanup Objectives (SCOs)
- Indicates value exceeds standard or guidance value

**FORMER BOUCHARD JUNKYARD SITE  
FINAL REMEDIATION REPORT  
POST-EXCAVATION SOIL SAMPLE RESULTS  
POLYCHLORINATED BIPHENYLS**

| Sample Identification | EP-PSW12 | EP-PSW13 | EP-PSW14 | EP-PSW15 | EP-PSW16 | EP-PSW16(1) | EP-PSW16(2) | EP-PSW16(3) | EP-PSW16(4) | EP-PSW17 |   |       |
|-----------------------|----------|----------|----------|----------|----------|-------------|-------------|-------------|-------------|----------|---|-------|
| Grid Location         | PSW, 12  | PSW, 13  | PSW, 14  | PSW, 15  | PSW, 16  | PSW, 16     | PSW, 16     | PSW, 16     | PSW, 16     | PSW, 17  | NYSDEC<br>Unrestricted Use<br>Soil Clean-Up<br>Objective<br>(ug/kg) |       |
| Sample Depth (feet)   | ---      | ---      | ---      | ---      | ---      | ---         | ---         | ---         | ---         | ---      |   |       |
| Date of Collection    | 7/9/08   | 7/9/08   | 7/9/08   | 7/9/08   | 7/29/08  | 8/5/08      | 8/5/08      | 8/7/08      | 8/7/08      | 7/29/08  |   |       |
| Dilution Factor       | 1.0      | 1.0      | 1.0      | 1.0      | 1.0      | 1.0         | 1.0         | 1.0         | 1.0         | 1.0      |   |       |
| Percent Moisture      | 14       | 18       | 17       | 20       | 14       | 11          | 8           | 18          | 15          | 17       |   |       |
| Units                 | (ug/kg)  | (ug/kg)  | (ug/kg)  | (ug/kg)  | (ug/kg)  | (ug/kg)     | (ug/kg)     | (ug/kg)     | (ug/kg)     | (ug/kg)  |   |       |
| Aroclor-1016          | 540 U    | 580 U    | 570 U    | 640 U    | 590 U    | 560 U       | 540 U       | 600 U       | 590 U       | 510 U    |   | 1,000 |
| Aroclor-1221          | 540 U    | 580 U    | 570 U    | 640 U    | 590 U    | 560 U       | 540 U       | 600 U       | 590 U       | 510 U    |   | 1,000 |
| Aroclor-1232          | 540 U    | 580 U    | 570 U    | 640 U    | 590 U    | 560 U       | 540 U       | 600 U       | 590 U       | 510 U    |   | 1,000 |
| Aroclor-1242          | 540 U    | 580 U    | 570 U    | 640 U    | 590 U    | 560 U       | 540 U       | 600 U       | 590 U       | 510 U    |   | 1,000 |
| Aroclor-1248          | 540 U    | 580 U    | 570 U    | 640 U    | 590 U    | 560 U       | 540 U       | 600 U       | 590 U       | 510 U    |   | 1,000 |
| Aroclor-1254          | 540 U    | 580 U    | 570 U    | 640 U    | 590 U    | 560 U       | 540 U       | 600 U       | 590 U       | 510 U    | 1,000   |       |
| Aroclor-1260          | 540 U    | 580 U    | 570 U    | 640 U    | 12,000   | 1,900       | 4,400       | 600 U       | 940         | 1,200    | 1,000   |       |
| <b>Total PCBs</b>     | ---      | ---      | ---      | ---      | 12,000   | 1,900       | 4,400       | ---         | 940         | 1,200    | 1,000   |       |

| Sample Identification | EP-PSW17(1) | EP-PSW18 | EP-PSW19 | EP-PSW19(1) | EP-PSW19(2) | EP-PSW19(3) | EP-PSW19(4) | EP-PSW20 | EP-PSW20A | EP-PSW21 |   |       |
|-----------------------|-------------|----------|----------|-------------|-------------|-------------|-------------|----------|-----------|----------|---|-------|
| Grid Location         | PSW, 17     | PSW, 18  | PSW, 19  | PSW, 19     | PSW, 19     | PSW, 19     | PSW, 19     | PSW, 20  | PSW, 20   | PSW, 21  | NYSDEC<br>Unrestricted Use<br>Soil Clean-Up<br>Objective<br>(ug/kg) |       |
| Sample Depth (feet)   | ---         | ---      | ---      | ---         | ---         | ---         | ---         | ---      | ---       | ---      |   |       |
| Date of Collection    | 8/5/08      | 7/29/08  | 7/29/08  | 8/5/08      | 8/5/08      | 8/7/08      | 8/7/08      | 7/29/08  | 8/18/08   | 8/5/08   |   |       |
| Dilution Factor       | 1.0         | 1.0      | 1.0      | 1.0         | 1.0         | 1.0         | 1.0         | 1.0      | 1.0       | 1.0      |   |       |
| Percent Moisture      | 14          | 19       | 28       | 21          | 21          | 23          | 13          | 22       | 17        | 26       |   |       |
| Units                 | (ug/kg)     | (ug/kg)  | (ug/kg)  | (ug/kg)     | (ug/kg)     | (ug/kg)     | (ug/kg)     | (ug/kg)  | (ug/kg)   | (ug/kg)  |   |       |
| Aroclor-1016          | 570 U       | 610 U    | 710 U    | 620 U       | 630 U       | 620 U       | 550 U       | 610 U    | 600 U     | 690 U    |   | 1,000 |
| Aroclor-1221          | 570 U       | 610 U    | 710 U    | 620 U       | 630 U       | 620 U       | 550 U       | 610 U    | 600 U     | 690 U    |   | 1,000 |
| Aroclor-1232          | 570 U       | 610 U    | 710 U    | 620 U       | 630 U       | 620 U       | 550 U       | 610 U    | 600 U     | 690 U    |   | 1,000 |
| Aroclor-1242          | 570 U       | 610 U    | 710 U    | 620 U       | 630 U       | 620 U       | 550 U       | 610 U    | 600 U     | 690 U    |   | 1,000 |
| Aroclor-1248          | 570 U       | 610 U    | 710 U    | 620 U       | 630 U       | 620 U       | 550 U       | 610 U    | 600 U     | 690 U    |   | 1,000 |
| Aroclor-1254          | 570 U       | 610 U    | 710 U    | 620 U       | 630 U       | 620 U       | 550 U       | 610 U    | 600 U     | 690 U    | 1,000   |       |
| Aroclor-1260          | 660         | 860      | 2,900    | 1,200       | 2,800       | 940         | 490 J       | 6,500    | 2,800     | 2,500    | 1,000   |       |
| <b>Total PCBs</b>     | 660         | 860      | 2,900    | 1,200       | 2,800       | 940         | ---         | 6,500    | 2,800     | 2,500    | 1,000   |       |

**QUALIFIERS:**

- B: Compound found in the method blank as well as the sample
- D: Result taken from a reanalysis at a secondary dilution
- J: Compound found at a concentration below the CRDL, value estimated
- U: Compound analyzed for but not detected

**NOTES:**

- All concentrations are in micrograms per kilogram (ug/kg) or parts per billion (ppb)
- 1: 6 NYCRR PART 375 - Table 375-6.8(a): Unrestricted Use Soil Cleanup Objectives (SCOs)
- Indicates value exceeds standard or guidance value

FORMER BOUCHARD JUNKYARD SITE  
FINAL REMEDIATION REPORT  
POST-EXCAVATION SOIL SAMPLE RESULTS  
POLYCHLORINATED BIPHENYLS

| Sample Identification | EP-PSW21A    | EP-PSW21B | EP-PSW22 | EP-PSW23 | EP-PSW24 | EP-PSW25 | EP-PSW26 | EP-PSW27     | EP-PSW27A | EP-PSW28     |               |
|-----------------------|--------------|-----------|----------|----------|----------|----------|----------|--------------|-----------|--------------|---------------|
| Grid Location         | PSW, 21      | PSW, 21   | PSW, 22  | PSW, 23  | PSW, 24  | PSW, 25  | PSW, 26  | PSW, 27      | PSW, 27   | PSW, 28      | NYSDEC        |
| Sample Depth (feet)   | ---          | ---       | ---      | ---      | ---      | ---      | ---      | ---          | ---       | ---          |               |
| Date of Collection    | 8/18/08      | 9/4/08    | 8/5/08   | 8/5/08   | 8/13/08  | 8/13/08  | 8/13/08  | 8/13/08      | 9/19/08   | 8/13/08      |               |
| Dilution Factor       | 1.0          | 1.0       | 1.0      | 1.0      | 1.0      | 1.0      | 1.0      | 1.0          | 1.0       | 1.0          | Soil Clean-Up |
| Percent Moisture      | 29           | 27        | 32       | 28       | 8        | 18       | 13       | 10           | 12        | 13           | Objective     |
| Units                 | (ug/kg)      | (ug/kg)   | (ug/kg)  | (ug/kg)  | (ug/kg)  | (ug/kg)  | (ug/kg)  | (ug/kg)      | (ug/kg)   | (ug/kg)      | (ug/kg)       |
| Aroclor-1016          | 720 U        | 700 U     | 750 U    | 710 U    | 520 U    | 610 U    | 560 U    | 530 U        | 580 U     | 560 U        | 1,000         |
| Aroclor-1221          | 720 U        | 700 U     | 750 U    | 710 U    | 520 U    | 610 U    | 560 U    | 530 U        | 580 U     | 560 U        | 1,000         |
| Aroclor-1232          | 720 U        | 700 U     | 750 U    | 710 U    | 520 U    | 610 U    | 560 U    | 530 U        | 580 U     | 560 U        | 1,000         |
| Aroclor-1242          | 720 U        | 700 U     | 750 U    | 710 U    | 520 U    | 610 U    | 560 U    | 530 U        | 580 U     | 560 U        | 1,000         |
| Aroclor-1248          | 720 U        | 700 U     | 750 U    | 710 U    | 520 U    | 610 U    | 560 U    | 530 U        | 580 U     | 560 U        | 1,000         |
| Aroclor-1254          | 720 U        | 700 U     | 750 U    | 710 U    | 520 U    | 610 U    | 560 U    | 530 U        | 580 U     | 560 U        | 1,000         |
| Aroclor-1260          | 3,300        | 700 U     | 750 U    | 710 U    | 520 U    | 610 U    | 890      | 1,900        | 580 U     | 5,100        | 1,000         |
| <b>Total PCBs</b>     | <b>3,300</b> | ---       | ---      | ---      | ---      | ---      | 890      | <b>1,900</b> | ---       | <b>5,100</b> | 1,000         |

| Sample Identification | EP-PSW28A    | EP-PSW28B    | EP-PSW28C | EP-PSW29     | EP-PSW29A    | EP-PSW29B    | EP-PSW29C | EP-PSW30       | EP-PSW31      | EP-PSW32     |               |
|-----------------------|--------------|--------------|-----------|--------------|--------------|--------------|-----------|----------------|---------------|--------------|---------------|
| Grid Location         | PSW, 28      | PSW, 28      | PSW, 28   | PSW, 29      | PSW, 29      | PSW, 29      | PSW, 29   | PSW, 30        | PSW, 31       | PSW, 32      | NYSDEC        |
| Sample Depth (feet)   | ---          | ---          | ---       | ---          | ---          | ---          | ---       | ---            | ---           | ---          |               |
| Date of Collection    | 9/11/08      | 9/29/08      | 11/5/08   | 8/13/08      | 9/11/08      | 9/29/08      | 11/5/08   | 8/14/08        | 8/14/08       | 8/14/08      |               |
| Dilution Factor       | 1.0          | 1.0          | 1.0       | 1.0          | 1.0          | 1.0          | 1.0       | 1.0            | 1.0           | 1.0          | Soil Clean-Up |
| Percent Moisture      | 11           | 21           | 5         | 23           | 19           | 18           | 6         | 24             | 20            | 25           | Objective     |
| Units                 | (ug/kg)      | (ug/kg)      | (ug/kg)   | (ug/kg)      | (ug/kg)      | (ug/kg)      | (ug/kg)   | (ug/kg)        | (ug/kg)       | (ug/kg)      | (ug/kg)       |
| Aroclor-1016          | 500 U        | 630 U        | 480 U     | 610 U        | 580 U        | 600 U        | 520 U     | 660 U          | 640 U         | 650 U        | 1,000         |
| Aroclor-1221          | 500 U        | 630 U        | 480 U     | 610 U        | 580 U        | 600 U        | 520 U     | 660 U          | 640 U         | 650 U        | 1,000         |
| Aroclor-1232          | 500 U        | 630 U        | 480 U     | 610 U        | 580 U        | 600 U        | 520 U     | 660 U          | 640 U         | 650 U        | 1,000         |
| Aroclor-1242          | 500 U        | 630 U        | 480 U     | 610 U        | 580 U        | 600 U        | 520 U     | 660 U          | 640 U         | 650 U        | 1,000         |
| Aroclor-1248          | 500 U        | 630 U        | 480 U     | 610 U        | 580 U        | 600 U        | 520 U     | 660 U          | 640 U         | 650 U        | 1,000         |
| Aroclor-1254          | 500 U        | 630 U        | 480 U     | 610 U        | 580 U        | 600 U        | 520 U     | 660 U          | 640 U         | 650 U        | 1,000         |
| Aroclor-1260          | 5,200        | 1,100        | 480 U     | 1,600        | 2,800        | 2,300        | 520 U     | 190,000        | 15,000        | 7,600        | 1,000         |
| <b>Total PCBs</b>     | <b>5,200</b> | <b>1,100</b> | ---       | <b>1,600</b> | <b>2,800</b> | <b>2,300</b> | ---       | <b>190,000</b> | <b>15,000</b> | <b>7,600</b> | 1,000         |

QUALIFIERS:

- B: Compound found in the method blank as well as the sample
- D: Result taken from a reanalysis at a secondary dilution
- J: Compound found at a concentration below the CRDL, value estimated
- U: Compound analyzed for but not detected

NOTES:

- All concentrations are in micrograms per kilogram (ug/kg) or parts per billion (ppb)
- 1: 6 NYCRR PART 375 - Table 375-6.8(a): Unrestricted Use Soil Cleanup Objectives (SCOs)
- Indicates value exceeds standard or guidance value

FORMER BOUCHARD JUNKYARD SITE  
FINAL REMEDIATION REPORT  
POST-EXCAVATION SOIL SAMPLE RESULTS  
POLYCHLORINATED BIPHENYLS

| Sample Identification | EP-PSW32(1)   | EP-PSW32(2) | EP-PSW33 | EP-PSW34 | EP-PSW35       | EP-PSW35(1)  | EP-PSW35(2)  | EP-PSW35(3) | EP-PSW35(4) | EP-PSW36(4)   |   |       |
|-----------------------|---------------|-------------|----------|----------|----------------|--------------|--------------|-------------|-------------|---------------|---|-------|
| Grid Location         | PSW, 32       | PSW, 32     | PSW, 33  | PSW, 34  | PSW, 35        | PSW, 35      | PSW, 35      | PSW, 35     | PSW, 35     | PSW, 36       | NYSDEC<br>Unrestricted Use<br>Soil Clean-Up<br>Objective<br>(ug/kg) |       |
| Sample Depth (feet)   | ---           | ---         | ---      | ---      | ---            | ---          | ---          | ---         | ---         | ---           |   |       |
| Date of Collection    | 8/19/08       | 8/19/08     | 8/14/08  | 8/14/08  | 8/14/08        | 8/19/08      | 8/19/08      | 8/21/08     | 8/21/08     | 8/26/08       |   |       |
| Dilution Factor       | 1.0           | 1.0         | 1.0      | 1.0      | 1.0            | 1.0          | 1.0          | 1.0         | 1.0         | 1.0           |   |       |
| Percent Moisture      | 26            | 11          | 33       | 17       | 36             | 22           | 25           | 21          | 18          | 15            |   |       |
| Units                 | (ug/kg)       | (ug/kg)     | (ug/kg)  | (ug/kg)  | (ug/kg)        | (ug/kg)      | (ug/kg)      | (ug/kg)     | (ug/kg)     | (ug/kg)       |   |       |
| Aroclor-1016          | 690 U         | 570 U       | 730 U    | 600 U    | 800 U          | 620 U        | 670 U        | 650 U       | 620 U       | 580 U         |   | 1,000 |
| Aroclor-1221          | 690 U         | 570 U       | 730 U    | 600 U    | 800 U          | 620 U        | 670 U        | 650 U       | 620 U       | 580 U         |   | 1,000 |
| Aroclor-1232          | 690 U         | 570 U       | 730 U    | 600 U    | 800 U          | 620 U        | 670 U        | 650 U       | 620 U       | 580 U         |   | 1,000 |
| Aroclor-1242          | 690 U         | 570 U       | 730 U    | 600 U    | 800 U          | 620 U        | 670 U        | 650 U       | 620 U       | 580 U         |   | 1,000 |
| Aroclor-1248          | 690 U         | 570 U       | 730 U    | 600 U    | 800 U          | 620 U        | 670 U        | 650 U       | 620 U       | 580 U         |   | 1,000 |
| Aroclor-1254          | 690 U         | 570 U       | 730 U    | 600 U    | 800 U          | 620 U        | 670 U        | 650 U       | 620 U       | 580 U         | 1,000   |       |
| Aroclor-1260          | <b>16,000</b> | 570 U       | 730 U    | 970      | <b>1,600 P</b> | <b>1,800</b> | <b>2,500</b> | 710         | 980         | <b>10,000</b> | 1,000   |       |
| <b>Total PCBs</b>     | <b>16,000</b> | ---         | ---      | 970      | <b>1,600</b>   | <b>1,800</b> | <b>2,500</b> | 710         | 980         | <b>10,000</b> | 1,000   |       |

| Sample Identification | EP-PSW36(5)     | EP-PSW37     | EP-PSW37(1)   | EP-PSW37(2)   | EP-PSW37(3)  | EP-PSW37(4)  | EP-PSW37(5) | EP-PSW38     | EP-PSW38A    | EP-PSW38B    |   |       |
|-----------------------|-----------------|--------------|---------------|---------------|--------------|--------------|-------------|--------------|--------------|--------------|---|-------|
| Grid Location         | PSW, 36         | PSW, 37      | PSW, 37       | PSW, 37       | PSW, 37      | PSW, 37      | PSW, 37     | PSW, 38      | PSW, 38      | PSW, 38      | NYSDEC<br>Unrestricted Use<br>Soil Clean-Up<br>Objective<br>(ug/kg) |       |
| Sample Depth (feet)   | ---             | ---          | ---           | ---           | ---          | ---          | ---         | ---          | ---          | ---          |   |       |
| Date of Collection    | 9/11/08         | 8/20/08      | 8/21/08       | 8/21/08       | 8/26/08      | 8/26/08      | 9/11/08     | 9/5/08       | 10/8/08      | 10/13/08     |   |       |
| Dilution Factor       | 1.0             | 1.0          | 1.0           | 1.0           | 1.0          | 1.0          | 1.0         | 1.0          | 1.0          | 1.0          |   |       |
| Percent Moisture      | 16              | 12           | 26            | 22            | 12           | 10           | 16          | 15           | 15           | 16           |   |       |
| Units                 | (ug/kg)         | (ug/kg)      | (ug/kg)       | (ug/kg)       | (ug/kg)      | (ug/kg)      | (ug/kg)     | (ug/kg)      | (ug/kg)      | (ug/kg)      |   |       |
| Aroclor-1016          | 620 U           | 530 U        | 690 U         | 650 U         | 570 U        | 570 U        | 580 U       | 550 U        | 570 U        | 580 U        |   | 1,000 |
| Aroclor-1221          | 620 U           | 530 U        | 690 U         | 650 U         | 570 U        | 570 U        | 580 U       | 550 U        | 570 U        | 580 U        |   | 1,000 |
| Aroclor-1232          | 620 U           | 530 U        | 690 U         | 650 U         | 570 U        | 570 U        | 580 U       | 550 U        | 570 U        | 580 U        |   | 1,000 |
| Aroclor-1242          | 620 U           | 530 U        | 690 U         | 650 U         | 570 U        | 570 U        | 580 U       | 550 U        | 570 U        | 580 U        |   | 1,000 |
| Aroclor-1248          | <b>14,000 P</b> | 530 U        | 690 U         | 650 U         | 570 U        | 570 U        | 580 U       | 550 U        | 570 U        | 580 U        |   | 1,000 |
| Aroclor-1254          | 620 U           | 530 U        | 690 U         | 650 U         | 570 U        | 570 U        | 580 U       | 550 U        | 570 U        | 580 U        | 1,000   |       |
| Aroclor-1260          | <b>29,000</b>   | <b>1,900</b> | <b>48,000</b> | <b>22,000</b> | <b>5,400</b> | <b>2,200</b> | 930         | <b>1,300</b> | <b>7,500</b> | <b>3,800</b> | 1,000   |       |
| <b>Total PCBs</b>     | <b>43,000</b>   | <b>1,900</b> | <b>48,000</b> | <b>22,000</b> | <b>5,400</b> | <b>2,200</b> | 930         | <b>1,300</b> | <b>7,500</b> | <b>3,800</b> | 1,000   |       |

QUALIFIERS:

- B: Compound found in the method blank as well as the sample
- D: Result taken from a reanalysis at a secondary dilution
- J: Compound found at a concentration below the CRDL, value estimated
- U: Compound analyzed for but not detected

NOTES:

- All concentrations are in micrograms per kilogram (ug/kg) or parts per billion (ppb)
- 1: 6 NYCRR PART 375 - Table 375-6.8(a): Unrestricted Use Soil Cleanup Objectives (SCOs)
- Indicates value exceeds standard or guidance value

P: Greater than 25% difference for detected concentrations between the two GC columns

FORMER BOUCHARD JUNKYARD SITE  
FINAL REMEDIATION REPORT  
POST-EXCAVATION SOIL SAMPLE RESULTS  
POLYCHLORINATED BIPHENYLS

| Sample Identification | EP-PSW38C | EP-PSW39 | EP-PSW40 | EP-PSW41 | EP-PSW42 | EP-PSW42A | EP-PSW43 | EP-PSW44 | EP-PSW45 | EP-PSW46 |               |
|-----------------------|-----------|----------|----------|----------|----------|-----------|----------|----------|----------|----------|---------------|
| Grid Location         | PSW, 38   | PSW, 39  | PSW, 40  | PSW, 41  | PSW, 42  | PSW, 42   | PSW, 43  | PSW, 44  | PSW, 45  | PSW, 46  | NYSDEC        |
| Sample Depth (feet)   | ---       | ---      | ---      | ---      | ---      | ---       | ---      | ---      | ---      | ---      |               |
| Date of Collection    | 10/17/08  | 9/11/08  | 9/11/08  | 9/11/08  | 9/11/08  | 9/19/08   | 9/11/08  | 9/11/08  | 9/22/08  | 9/23/08  |               |
| Dilution Factor       | 1.0       | 1.0      | 1.0      | 1.0      | 1.0      | 1.0       | 1.0      | 1.0      | 1.0      | 1.0      | Soil Clean-Up |
| Percent Moisture      | 9         | 27       | 29       | 19       | 17       | 24        | 23       | 17       | 8        | 10       | Objective     |
| Units                 | (ug/kg)   | (ug/kg)  | (ug/kg)  | (ug/kg)  | (ug/kg)  | (ug/kg)   | (ug/kg)  | (ug/kg)  | (ug/kg)  | (ug/kg)  | (ug/kg)       |
| Aroclor-1016          | 550 U     | 700 U    | 700 U    | 590 U    | 540 U    | 650 U     | 660 U    | 610 U    | 530 U    | 540 U    | 1,000         |
| Aroclor-1221          | 550 U     | 700 U    | 700 U    | 590 U    | 540 U    | 650 U     | 660 U    | 610 U    | 530 U    | 540 U    | 1,000         |
| Aroclor-1232          | 550 U     | 700 U    | 700 U    | 590 U    | 540 U    | 650 U     | 660 U    | 610 U    | 530 U    | 540 U    | 1,000         |
| Aroclor-1242          | 550 U     | 700 U    | 700 U    | 590 U    | 540 U    | 650 U     | 660 U    | 610 U    | 530 U    | 540 U    | 1,000         |
| Aroclor-1248          | 550 U     | 700 U    | 700 U    | 590 U    | 540 U    | 650 U     | 660 U    | 610 U    | 530 U    | 540 U    | 1,000         |
| Aroclor-1254          | 550 U     | 700 U    | 700 U    | 590 U    | 540 U    | 650 U     | 660 U    | 610 U    | 530 U    | 540 U    | 1,000         |
| Aroclor-1260          | 550 U     | 790      | 930      | 5,600    | 2,100    | 1,300     | 660 U    | 1,800    | 530 U    | 28,000 E | 1,000         |
| <b>Total PCBs</b>     | ---       | 790      | 930      | 5,600    | 2,100    | 1,300     | ---      | 1,800    | ---      | 28,000   | 1,000         |

| Sample Identification | EP-PSW47  | EP-PSW48 | EP-PSW49 | EP-PSW50 | EP-PSW51 | EP-PSW52 | EP-PSW53 | EP-B10(18)-SW(N) | EP-C1-SW(N) | EP-C2-SW(W) |               |
|-----------------------|-----------|----------|----------|----------|----------|----------|----------|------------------|-------------|-------------|---------------|
| Grid Location         | PSW, 47   | PSW, 48  | PSW, 49  | PSW, 50  | PSW, 51  | PSW, 52  | PSW, 53  | B, 10, SW        | C, 1, SW    | C, 2, SW    | NYSDEC        |
| Sample Depth (feet)   | ---       | ---      | ---      | ---      | ---      | ---      | ---      | ---              | ---         | ---         |               |
| Date of Collection    | 10/6/08   | 10/9/08  | 10/9/08  | 10/9/08  | 10/9/08  | 10/9/08  | 11/12/08 | 9/4/08           | 9/23/08     | 9/23/08     |               |
| Dilution Factor       | 1.0       | 1.0      | 1.0      | 1.0      | 1.0      | 1.0      | 1.0      | 1.0              | 1.0         | 1.0         | Soil Clean-Up |
| Percent Moisture      | 16        | 18       | 12       | 26       | 16       | 29       | 6        | 9                | 10          | 10          | Objective     |
| Units                 | (ug/kg)   | (ug/kg)  | (ug/kg)  | (ug/kg)  | (ug/kg)  | (ug/kg)  | (ug/kg)  | (ug/kg)          | (ug/kg)     | (ug/kg)     | (ug/kg)       |
| Aroclor-1016          | 570 U     | 590 U    | 550 U    | 640 U    | 560 U    | 650 U    | 490 U    | 560 U            | 570 U       | 540 U       | 1,000         |
| Aroclor-1221          | 570 U     | 590 U    | 550 U    | 640 U    | 560 U    | 650 U    | 490 U    | 560 U            | 570 U       | 540 U       | 1,000         |
| Aroclor-1232          | 570 U     | 590 U    | 550 U    | 640 U    | 560 U    | 650 U    | 490 U    | 560 U            | 570 U       | 540 U       | 1,000         |
| Aroclor-1242          | 570 U     | 590 U    | 550 U    | 640 U    | 560 U    | 650 U    | 490 U    | 560 U            | 570 U       | 540 U       | 1,000         |
| Aroclor-1248          | 570 U     | 590 U    | 550 U    | 640 U    | 560 U    | 650 U    | 490 U    | 560 U            | 570 U       | 540 U       | 1,000         |
| Aroclor-1254          | 570 U     | 590 U    | 550 U    | 640 U    | 560 U    | 650 U    | 490 U    | 560 U            | 570 U       | 540 U       | 1,000         |
| Aroclor-1260          | 150,000 E | 600      | 550 U    | 640 U    | 560 U    | 650 U    | 490 U    | 560 U            | 570 U       | 540 U       | 1,000         |
| <b>Total PCBs</b>     | 150,000   | 600      | ---      | ---      | ---      | ---      | ---      | ---              | ---         | ---         | 1,000         |

QUALIFIERS:

- B: Compound found in the method blank as well as the sample
- D: Result taken from a reanalysis at a secondary dilution
- J: Compound found at a concentration below the CRDL, value estimated
- U: Compound analyzed for but not detected
- E: Compound concentration exceeds the calibration range for analysis

NOTES:

- All concentrations are in micrograms per kilogram (ug/kg) or parts per billion (ppb)
- 1: 6 NYCRR PART 375 - Table 375-6.8(a): Unrestricted Use Soil Cleanup Objectives (SCOs)
- Indicates value exceeds standard or guidance value

FORMER BOUCHARD JUNKYARD SITE  
FINAL REMEDIATION REPORT  
POST-EXCAVATION SOIL SAMPLE RESULTS  
POLYCHLORINATED BIPHENYLS

| Sample Identification | EP-F1-SW(W) | EP-G1-SW(N) | EP-H1-SW(E) | EP-H1-SW(E)(A) | EP-H7-SW(W) | EP-H7-SW(S) | EP-H8-SW(W) | EP-H8-SW(N) | EP-I7-SW(E) | EP-I8-SW(N) |               |
|-----------------------|-------------|-------------|-------------|----------------|-------------|-------------|-------------|-------------|-------------|-------------|---------------|
| Grid Location         | F, 1, SW    | G, 1, SW    | H, 1, SW    | H, 1, SW       | H, 7, SW    | H, 7, SW    | H, 8, SW    | H, 8, SW    | I, 7, SW    | I, 8, SW    | NYSDEC        |
| Sample Depth (feet)   | ---         | ---         | ---         | ---            | ---         | ---         | ---         | ---         | ---         | ---         |               |
| Date of Collection    | 9/23/08     | 9/29/08     | 10/6/08     | 10/13/08       | 6/6/08      | 6/6/08      | 6/6/08      | 6/6/08      | 9/22/08     | 9/22/08     |               |
| Dilution Factor       | 1.0         | 1.0         | 1.0         | 1.0            | 1.0         | 1.0         | 1.0         | 1.0         | 1.0         | 1.0         | Soil Clean-Up |
| Percent Moisture      | 20          | 9           | 14          | 9              | 7           | 6           | 11          | 13          | 6           | 4           | Objective     |
| Units                 | (ug/kg)     | (ug/kg)     | (ug/kg)     | (ug/kg)        | (ug/kg)     | (ug/kg)     | (ug/kg)     | (ug/kg)     | (ug/kg)     | (ug/kg)     | (ug/kg)       |
| Aroclor-1016          | 600 U       | 510 U       | 580 U       | 550 U          | 530 U       | 500 U       | 550 U       | 590 U       | 530 U       | 520 U       | 1,000         |
| Aroclor-1221          | 600 U       | 510 U       | 580 U       | 550 U          | 530 U       | 500 U       | 550 U       | 590 U       | 530 U       | 520 U       | 1,000         |
| Aroclor-1232          | 600 U       | 510 U       | 580 U       | 550 U          | 530 U       | 500 U       | 550 U       | 590 U       | 530 U       | 520 U       | 1,000         |
| Aroclor-1242          | 600 U       | 510 U       | 580 U       | 550 U          | 530 U       | 500 U       | 550 U       | 590 U       | 530 U       | 520 U       | 1,000         |
| Aroclor-1248          | 600 U       | 510 U       | 580 U       | 550 U          | 530 U       | 500 U       | 550 U       | 590 U       | 530 U       | 520 U       | 1,000         |
| Aroclor-1254          | 600 U       | 510 U       | 580 U       | 550 U          | 530 U       | 500 U       | 550 U       | 590 U       | 530 U       | 520 U       | 1,000         |
| Aroclor-1260          | 600 U       | 510 U       | 1,500       | 580            | 530 U       | 500 U       | 550 U       | 590 U       | 530 U       | 1,900       | 1,000         |
| <b>Total PCBs</b>     | ---         | ---         | 1,500       | 580            | ---         | ---         | ---         | ---         | ---         | 1,900       | 1,000         |

| Sample Identification | EP-I8-SW(N)(A) | EP-N10(72)-SW(E) | EP-N10(72)-SW(W) | EP-N10(72)-SW(W)(A) | EP-O14(T6)-SW(E) | EP-P13(T6)-SW(E) | EP-Q13-SW(W) | EP-Q13(30)-SW(W)(A) | EP-S10(54)-SW(S) | EP-S11(54)-SW(N) |               |
|-----------------------|----------------|------------------|------------------|---------------------|------------------|------------------|--------------|---------------------|------------------|------------------|---------------|
| Grid Location         | I, 8, SW       | N, 10, SW        | N, 10, SW        | N, 10, SW           | O, 14, SW        | P, 13, SW        | Q, 13, SW    | Q, 13, SW           | S, 10, SW        | S, 11, SW        | NYSDEC        |
| Sample Depth (feet)   | ---            | ---              | ---              | ---                 | ---              | ---              | ---          | ---                 | ---              | ---              |               |
| Date of Collection    | 9/30/08        | 8/20/08          | 8/20/08          | 9/4/08              | 10/13/08         | 10/13/08         | 8/5/08       | 10/13/08            | 10/28/08         | 10/28/08         |               |
| Dilution Factor       | 1.0            | 1.0              | 1.0              | 1.0                 | 1.0              | 1.0              | 1.0          | 1.0                 | 1.0              | 1.0              | Soil Clean-Up |
| Percent Moisture      | 5              | 9                | 24               | 11                  | 20               | 20               | 27           | 9                   | 16               | 12               | Objective     |
| Units                 | (ug/kg)        | (ug/kg)          | (ug/kg)          | (ug/kg)             | (ug/kg)          | (ug/kg)          | (ug/kg)      | (ug/kg)             | (ug/kg)          | (ug/kg)          | (ug/kg)       |
| Aroclor-1016          | 510 U          | 540 U            | 650 U            | 560 U               | 630 U            | 640 U            | 680 U        | 540 U               | 610 U            | 550 U            | 1,000         |
| Aroclor-1221          | 510 U          | 540 U            | 650 U            | 560 U               | 630 U            | 640 U            | 680 U        | 540 U               | 610 U            | 550 U            | 1,000         |
| Aroclor-1232          | 510 U          | 540 U            | 650 U            | 560 U               | 630 U            | 640 U            | 680 U        | 540 U               | 610 U            | 550 U            | 1,000         |
| Aroclor-1242          | 510 U          | 540 U            | 650 U            | 560 U               | 630 U            | 640 U            | 680 U        | 540 U               | 610 U            | 550 U            | 1,000         |
| Aroclor-1248          | 510 U          | 540 U            | 650 U            | 560 U               | 630 U            | 640 U            | 680 U        | 540 U               | 610 U            | 550 U            | 1,000         |
| Aroclor-1254          | 510 U          | 540 U            | 650 U            | 560 U               | 630 U            | 640 U            | 680 U        | 540 U               | 610 U            | 550 U            | 1,000         |
| Aroclor-1260          | 510 U          | 850              | 11,000           | 760                 | 630 U            | 640 U            | 42,000       | 540 U               | 610 U            | 550 U            | 1,000         |
| <b>Total PCBs</b>     | ---            | 850              | 11,000           | 760                 | ---              | ---              | 42,000       | ---                 | ---              | ---              | 1,000         |

QUALIFIERS:

- B: Compound found in the method blank as well as the sample
- D: Result taken from a reanalysis at a secondary dilution
- J: Compound found at a concentration below the CRDL, value estimated
- U: Compound analyzed for but not detected

NOTES:

- All concentrations are in micrograms per kilogram (ug/kg) or parts per billion (ppb)
- 1: 6 NYCRR PART 375 - Table 375-6.8(a): Unrestricted Use Soil Cleanup Objectives (SCOs)
- Indicates value exceeds standard or guidance value

FORMER BOUCHARD JUNKYARD SITE  
FINAL REMEDIATION REPORT  
POST-EXCAVATION SOIL SAMPLE RESULTS  
POLYCHLORINATED BIPHENYLS

| Sample Identification | EP-DW(N) | EP-DW(S)     | PATELL-01    | PATELL-02    | PATELL-03 | PATELL-04 | PATELL-05    | PATELL-06    | PATELL-07 | PATELL-08 | PATELL-09    |   |       |
|-----------------------|----------|--------------|--------------|--------------|-----------|-----------|--------------|--------------|-----------|-----------|--------------|---|-------|
| Grid Location         | DW       | DW           | ---          | ---          | ---       | ---       | ---          | ---          | ---       | ---       | ---          | NYSDEC<br>Unrestricted Use<br>Soil Clean-Up<br>Objective<br>(ug/kg) |       |
| Sample Depth (feet)   | 1        | 1            | 1            | 1            | 1         | 1         | 1            | 1            | 1         | 1         | 1            |   |       |
| Date of Collection    | 8/20/08  | 8/20/08      | 7/3/08       | 7/3/08       | 7/3/08    | 7/3/08    | 7/3/08       | 7/3/08       | 7/3/08    | 7/3/08    | 7/3/08       |   |       |
| Dilution Factor       | 1.0      | 1.0          | 1.0          | 1.0          | 1.0       | 1.0       | 1.0          | 1.0          | 1.0       | 1.0       | 1.0          |   |       |
| Percent Moisture      | 3        | 4            | 22           | 20           | 11        | 21        | 16           | 17           | 7         | 21        | 19           |   |       |
| Units                 | (ug/kg)  | (ug/kg)      | (ug/kg)      | (ug/kg)      | (ug/kg)   | (ug/kg)   | (ug/kg)      | (ug/kg)      | (ug/kg)   | (ug/kg)   | (ug/kg)      |   |       |
| Aroclor-1016          | 520 U    | 500 U        | 640 U        | 630 U        | 530 U     | 650 U     | 580 U        | 590 U        | 550 U     | 650 U     | 630 U        |   | 1,000 |
| Aroclor-1221          | 520 U    | 500 U        | 640 U        | 630 U        | 530 U     | 650 U     | 580 U        | 590 U        | 550 U     | 650 U     | 630 U        |   | 1,000 |
| Aroclor-1232          | 520 U    | 500 U        | 640 U        | 630 U        | 530 U     | 650 U     | 580 U        | 590 U        | 550 U     | 650 U     | 630 U        |   | 1,000 |
| Aroclor-1242          | 520 U    | 500 U        | 640 U        | 630 U        | 530 U     | 650 U     | 580 U        | 590 U        | 550 U     | 650 U     | 630 U        |   | 1,000 |
| Aroclor-1248          | 520 U    | 500 U        | 640 U        | 630 U        | 530 U     | 650 U     | 580 U        | 590 U        | 550 U     | 650 U     | 630 U        |   | 1,000 |
| Aroclor-1254          | 520 U    | 500 U        | 640 U        | 630 U        | 530 U     | 650 U     | 580 U        | 590 U        | 550 U     | 650 U     | 630 U        |   | 1,000 |
| Aroclor-1260          | 930      | <b>2,000</b> | <b>1,700</b> | <b>2,900</b> | 530 U     | 650 U     | <b>1,100</b> | <b>5,000</b> | 550 U     | 650 U     | <b>5,600</b> | 1,000   |       |
| <b>Total PCBs</b>     | 930      | <b>2,000</b> | <b>1,700</b> | <b>2,900</b> | ----      | ----      | <b>1,100</b> | <b>5,000</b> | ----      | ----      | <b>5,600</b> | 1,000   |       |

| Sample Identification | PATELL-11    | PATELL-12     | PATELL-13 | PATELL-14    | PATELL-15 | PATELL-16 | PATELL-17 | PATELL-18 | PATELL-19    | PATELL-20 | PATELL-21 |   |       |
|-----------------------|--------------|---------------|-----------|--------------|-----------|-----------|-----------|-----------|--------------|-----------|-----------|---|-------|
| Grid Location         | ---          | ---           | ---       | ---          | ---       | ---       | ---       | ---       | ---          | ---       | ---       | NYSDEC<br>Unrestricted Use<br>Soil Clean-Up<br>Objective<br>(ug/kg) |       |
| Sample Depth (feet)   | 1            | 1             | 1         | 1            | 1         | 1         | 1         | 1         | 1            | 1         | 1         |   |       |
| Date of Collection    | 7/3/08       | 7/3/08        | 7/3/08    | 7/3/08       | 7/3/08    | 7/3/08    | 7/9/08    | 7/9/08    | 7/9/08       | 7/15/08   | 7/15/08   |   |       |
| Dilution Factor       | 1.0          | 1.0           | 1.0       | 1.0          | 1.0       | 1.0       | 1.0       | 1.0       | 1.0          | 1.0       | 1.0       |   |       |
| Percent Moisture      | 25           | 18            | 18        | 22           | 17        | 18        | 13        | 16        | 15           | 11        | 18        |   |       |
| Units                 | (ug/kg)      | (ug/kg)       | (ug/kg)   | (ug/kg)      | (ug/kg)   | (ug/kg)   | (ug/kg)   | (ug/kg)   | (ug/kg)      | (ug/kg)   | (ug/kg)   |   |       |
| Aroclor-1016          | 610 U        | 570 U         | 600 U     | 650 U        | 600 U     | 620 U     | 550 U     | 580 U     | 570 U        | 550 U     | 620 U     |   | 1,000 |
| Aroclor-1221          | 610 U        | 570 U         | 600 U     | 650 U        | 600 U     | 620 U     | 550 U     | 580 U     | 570 U        | 550 U     | 620 U     |   | 1,000 |
| Aroclor-1232          | 610 U        | 570 U         | 600 U     | 650 U        | 600 U     | 620 U     | 550 U     | 580 U     | 570 U        | 550 U     | 620 U     |   | 1,000 |
| Aroclor-1242          | 610 U        | 570 U         | 600 U     | 650 U        | 600 U     | 620 U     | 550 U     | 580 U     | 570 U        | 550 U     | 620 U     |   | 1,000 |
| Aroclor-1248          | 610 U        | 570 U         | 600 U     | 650 U        | 600 U     | 620 U     | 550 U     | 580 U     | 570 U        | 550 U     | 620 U     |   | 1,000 |
| Aroclor-1254          | 610 U        | 570 U         | 600 U     | 650 U        | 600 U     | 620 U     | 550 U     | 580 U     | 570 U        | 550 U     | 620 U     |   | 1,000 |
| Aroclor-1260          | <b>1,800</b> | <b>11,000</b> | 600 U     | <b>4,600</b> | 600 U     | 620 U     | 550 U     | 580 U     | <b>1,400</b> | 550 U     | 620 U     | 1,000   |       |
| <b>Total PCBs</b>     | <b>1,800</b> | <b>11,000</b> | ----      | <b>4,600</b> | ----      | ----      | ----      | ----      | <b>1,400</b> | ----      | ----      | 1,000   |       |

QUALIFIERS:

- B: Compound found in the method blank as well as the sample
- D: Result taken from a reanalysis at a secondary dilution
- J: Compound found at a concentration below the CRDL, value estimated
- U: Compound analyzed for but not detected

NOTES:

- All concentrations are in micrograms per kilogram (ug/kg) or parts per billion (ppb)
- 1: 6 NYCRR PART 375 - Table 375-6.8(a): Unrestricted Use Soil Cleanup Objectives (SCOs)
- Indicates value exceeds standard or guidance value

FORMER BOUCHARD JUNKYARD SITE  
FINAL REMEDIATION REPORT  
POST-EXCAVATION SOIL SAMPLE RESULTS  
POLYCHLORINATED BIPHENYLS

| Sample Identification | PATELL-22 | PATELL-23 | PATELL-24 | PATELL-25 | PATELL-26 | PATELL-27 | PATELL-28 | PATELL-29 | PATELL-30 | PATELL-31        |               |
|-----------------------|-----------|-----------|-----------|-----------|-----------|-----------|-----------|-----------|-----------|------------------|---------------|
| Grid Location         | ---       | ---       | ---       | ---       | ---       | ---       | ---       | ---       | ---       | ---              | NYSDEC        |
| Sample Depth (feet)   | 1         | 1         | 1         | 1         | 1         | 1         | 1         | 1         | 1         | Unrestricted Use |               |
| Date of Collection    | 7/15/08   | 7/15/08   | 7/15/08   | 7/15/08   | 7/15/08   | 7/15/08   | 7/15/08   | 7/15/08   | 7/15/08   |                  |               |
| Dilution Factor       | 1.0       | 1.0       | 1.0       | 1.0       | 1.0       | 1.0       | 1.0       | 1.0       | 1.0       | 1.0              | Soil Clean-Up |
| Percent Moisture      | 21        | 17        | 19        | 16        | 13        | 17        | 11        | 6         | 10        | 19               | Objective     |
| Units                 | (ug/kg)   | (ug/kg)   | (ug/kg)   | (ug/kg)   | (ug/kg)   | (ug/kg)   | (ug/kg)   | (ug/kg)   | (ug/kg)   | (ug/kg)          | (ug/kg)       |
| Aroclor-1016          | 630 U     | 580 U     | 580 U     | 600 U     | 590 U     | 580 U     | 570 U     | 530 U     | 530 U     | 620 U            | 1,000         |
| Aroclor-1221          | 630 U     | 580 U     | 580 U     | 600 U     | 590 U     | 580 U     | 570 U     | 530 U     | 530 U     | 620 U            | 1,000         |
| Aroclor-1232          | 630 U     | 580 U     | 580 U     | 600 U     | 590 U     | 580 U     | 570 U     | 530 U     | 530 U     | 620 U            | 1,000         |
| Aroclor-1242          | 630 U     | 580 U     | 580 U     | 600 U     | 590 U     | 580 U     | 570 U     | 530 U     | 530 U     | 620 U            | 1,000         |
| Aroclor-1248          | 630 U     | 580 U     | 580 U     | 600 U     | 590 U     | 580 U     | 570 U     | 530 U     | 530 U     | 620 U            | 1,000         |
| Aroclor-1254          | 630 U     | 580 U     | 580 U     | 600 U     | 590 U     | 580 U     | 570 U     | 530 U     | 530 U     | 620 U            | 1,000         |
| Aroclor-1260          | 630 U     | 580 U     | 580 U     | 600 U     | 590 U     | 580 U     | 570 U     | 530 U     | 530 U     | 620 U            | 1,000         |
| <b>Total PCBs</b>     | ---       | ---       | ---       | ---       | ---       | ---       | ---       | ---       | ---       | ---              | 1,000         |

| Sample Identification | PATELL-32 | PATELL-33 | PATELL-34 | PATELL-35 | PATELL-36 | PATELL-37 | PATELL-37(RE) | PATELL-38 | PATELL-39 |               |                  |
|-----------------------|-----------|-----------|-----------|-----------|-----------|-----------|---------------|-----------|-----------|---------------|------------------|
| Grid Location         | ---       | ---       | ---       | ---       | ---       | ---       | ---           | ---       | ---       | NYSDEC        |                  |
| Sample Depth (feet)   | 1         | 1         | 1         | 1         | 1         | 1         | 1             | 1         | 1         |               | Unrestricted Use |
| Date of Collection    | 7/15/08   | 7/15/08   | 7/15/08   | 7/15/08   | 7/15/08   | 7/15/08   | 7/15/08       | 7/15/08   | 7/15/08   |               |                  |
| Dilution Factor       | 1.0       | 1.0       | 1.0       | 1.0       | 1.0       | 1.0       | 1.0           | 1.0       | 1.0       | Soil Clean-Up |                  |
| Percent Moisture      | 15        | 13        | 18        | 16        | 18        | 13        | 13            | 18        | 22        | Objective     |                  |
| Units                 | (ug/kg)   | (ug/kg)   | (ug/kg)   | (ug/kg)   | (ug/kg)   | (ug/kg)   | (ug/kg)       | (ug/kg)   | (ug/kg)   | (ug/kg)       |                  |
| Aroclor-1016          | 560 U     | 550 U     | 620 U     | 580 U     | 600 U     | 570 U     | 570 U         | 610 U     | 620 U     | 1,000         |                  |
| Aroclor-1221          | 560 U     | 550 U     | 620 U     | 580 U     | 600 U     | 570 U     | 570 U         | 610 U     | 620 U     | 1,000         |                  |
| Aroclor-1232          | 560 U     | 550 U     | 620 U     | 580 U     | 600 U     | 570 U     | 570 U         | 610 U     | 620 U     | 1,000         |                  |
| Aroclor-1242          | 560 U     | 550 U     | 620 U     | 580 U     | 600 U     | 570 U     | 570 U         | 610 U     | 620 U     | 1,000         |                  |
| Aroclor-1248          | 560 U     | 550 U     | 620 U     | 580 U     | 600 U     | 570 U     | 570 U         | 610 U     | 620 U     | 1,000         |                  |
| Aroclor-1254          | 560 U     | 550 U     | 620 U     | 580 U     | 600 U     | 570 U     | 570 U         | 610 U     | 620 U     | 1,000         |                  |
| Aroclor-1260          | 560 U     | 550 U     | 620 U     | 580 U     | 600 U     | 1,110     | 930           | 610 U     | 620 U     | 1,000         |                  |
| <b>Total PCBs</b>     | ---       | ---       | ---       | ---       | ---       | 1,110     | 930           | ---       | ---       | 1,000         |                  |

QUALIFIERS:

- B: Compound found in the method blank as well as the sample
- D: Result taken from a reanalysis at a secondary dilution
- J: Compound found at a concentration below the CRDL, value estimated
- U: Compound analyzed for but not detected

NOTES:

- All concentrations are in micrograms per kilogram (ug/kg) or parts per billion (ppb)
- 1: 6 NYCRR PART 375 - Table 375-6.8(a): Unrestricted Use Soil Cleanup Objectives (SCOs)
- Indicates value exceeds standard or guidance value

Site Management Plan  
APPENDIX C

Soil Management Provisions

---

Former Bouchard Junkyard Site  
Site No. 411014  
New Lebanon, Columbia County  
January 2015

## SOIL MANAGEMENT PROVISIONS

Residual soil contamination remains in certain areas of the site, so activities that may result in the exposure of residual contamination must be handled in accordance with the Site Management Plan to ensure continued protectiveness of the remedy. The primary focus is to limit the relocation of PCB contaminated soil.

### Removal of Trees and Shrubs

The removal of trees and shrubs at the site may be required as a part of future site development or as a result of the death of existing vegetation. Any tree or shrub removal from identified areas of residual contamination should be limited to the above grade portion of the vegetation. In the event that the roots mass also requires removal, the excavation, handling and disposal of the root mass and soil associated with the root mass must be as described below. Adequate personal protective equipment must be used to prevent exposure to potentially contaminated soil during the removal process, which must be identified by a qualified health and safety professional.

### Excavation of Soil

Excavation of soil at the site may be required as a part of future site development or as a result of miscellaneous site activities. To the extent possible, excavation activities should be avoided within areas of residual contamination identified at the site. The NYSDEC must be notified prior to any excavation activities within the identified areas of residual contamination. Adequate personal protective equipment must be used to prevent exposure to potentially contaminated soil during excavation, which must be identified by a qualified health and safety professional.

Any soil excavation required at the site from areas of residual contamination must be handled appropriately and the NYSDEC must be notified prior to those excavation activities. A work plan must be developed and approved by the NYSDEC prior to initiating any excavation activities from the areas of residual contamination. At a minimum, the work plan must specify the manner in which the soil will be excavated, handled, stored, sampled, transported, and disposed. The work plan must also specify that any backfill material used on-site will be from an approved off-site source. The work plan must identify the procedure for testing and certifying the backfill material.

At a minimum, the following requirements apply to excavations within the areas of residual soil contamination at the Former Bouchard Junkyard Site. Methods for compliance with these requirements shall be addressed in the work plan:

1. All excavations shall be made in the dry.
2. Excavated materials shall be transported to a designated staging area such that they may be tested and properly managed.
3. Excavated materials must be staged on polyethylene sheeting to prevent contact with undisturbed soils.
4. Excavation shall be performed in a manner that will prevent spills and the potential for potentially contaminated soil to be mixed with uncontaminated material.

5. Excavation shall be accomplished by methods which preserve the undisturbed state of subgrade soils.
6. Mobilization of the excavated soil must be prevented through the use of polyethylene sheeting to cover any soil stockpiles or by using appropriate soil erosion control methods established at the end of each day of excavation activities.

### Soil Staging

At a minimum, the following requirements apply to the storage of materials excavated from within the areas of residual soil contamination at the Former Bouchard Junkyard Site. Methods for compliance with these requirements shall be addressed in the work plan:

1. Excavated material shall be placed in temporary storage.
2. Stockpiles shall be constructed to isolate the potentially contaminated material from the environment.
3. Diversion measures shall be employed to prevent storm water run-on and run-off.
4. Roll-off or equivalent units used to store contaminated material shall be water tight.
5. Storage and handling of PCB contaminated soil must comply with all applicable NYSDEC hazardous waste regulations (6 NYCRR Part 317-376) and USEPA PCB TSCA regulations (40 CFR Part 761).

### Waste Transportation and Disposal

The following requirements apply to the transportation and disposal of material excavated from within the areas of residual soil contamination deemed to be unusable at the site. Methods for compliance with these requirements shall be addressed in the work plan:

1. Sampling, classification, manifesting, labeling, transporting and disposing of waste shall be performed in accordance with all applicable federal, state, and local laws and regulations.
2. Materials removed from the site shall be transported directly to the disposal facility.
3. Sampling frequency, analysis methods, and analytical laboratory must be approved by the NYSDEC prior to removal of any material from the site.
4. Letters of commitment shall be obtained from disposal facilities to be used during the project. The letters shall state that the disposal facility is permitted to accept and has the available capacity to receive the waste that will be shipped from the site.
5. All vehicles shall be decontaminated prior to leaving the site.

### Backfill

The following requirements apply to the fill material used to restore the site after excavation has been completed. Methods for compliance with these requirements shall be addressed in the work plan:

1. Fill material used to restore the site shall be similar in physical properties to the material removed. Fill used for building foundations or other construction is exempt from this requirement.
2. The fill material shall be of equal or less permeability than the native soil in or adjacent to the excavated area.
3. Fill shall be uncontaminated pursuant to the remediation standards applicable to the site.
4. Documentation of the quality of the fill shall be provided by a certification stating that it is virgin material from a commercial or noncommercial source.

If documentation of the quality of the fill material cannot be provided, a backfill evaluation proposal, which identifies material characterization protocols, shall be submitted to and approved by the NYSDEC prior to the use of any backfill material.