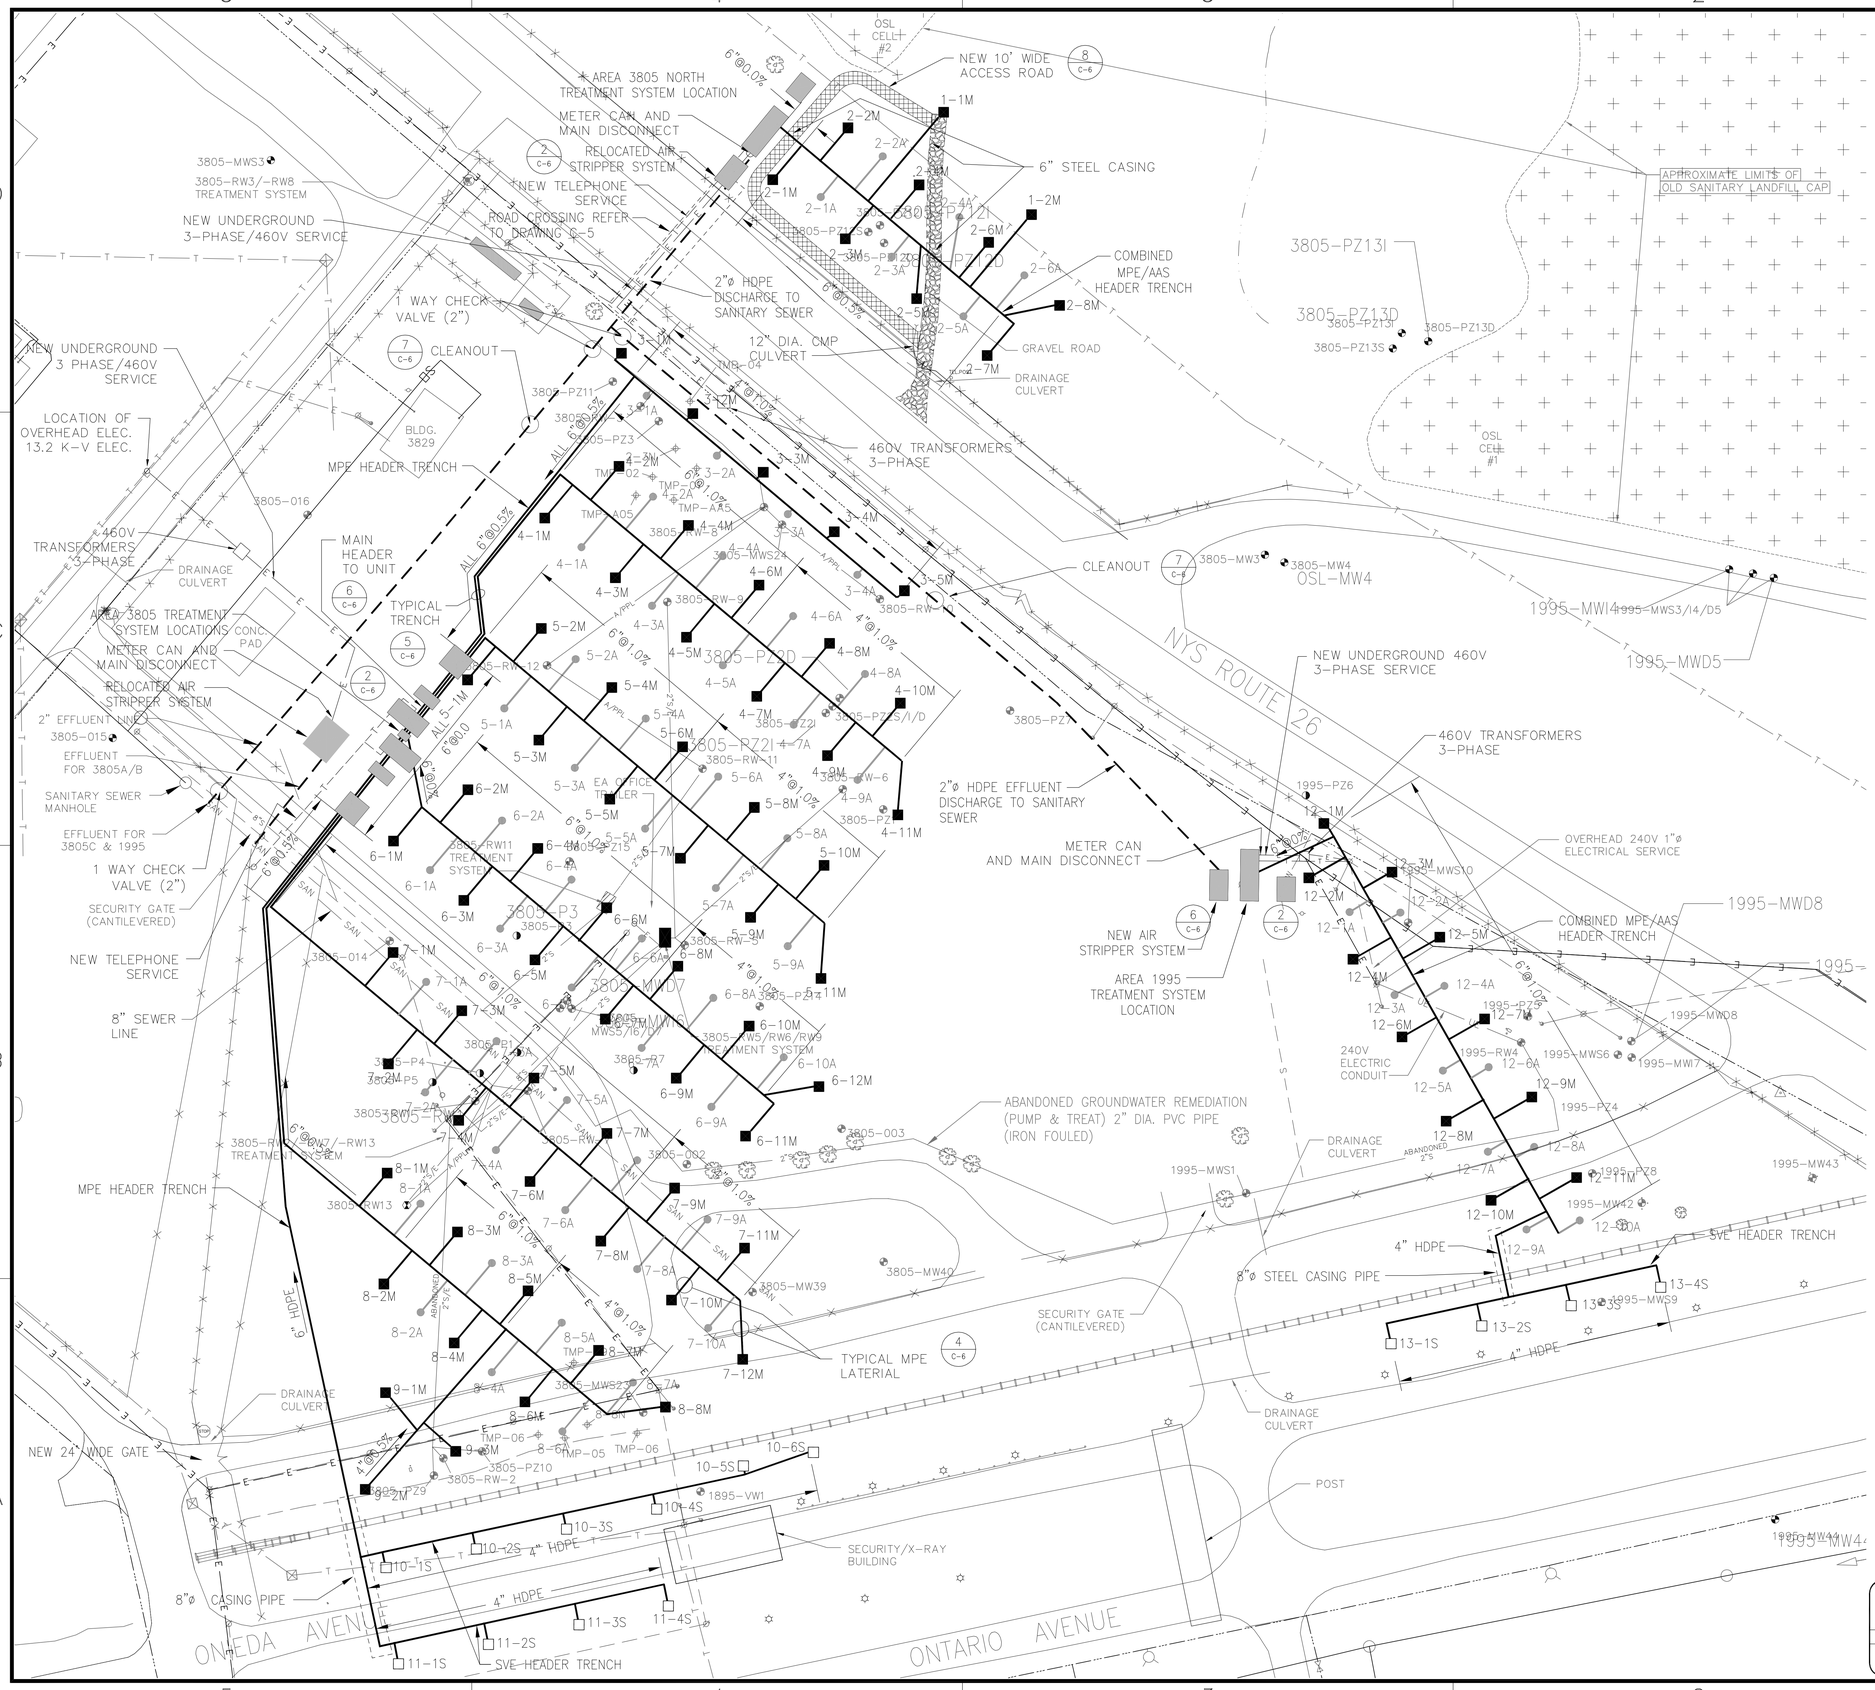


# FINAL AS-BUILT

US Army Corps of Engineers

U.S. ARMY ENGINEER DISTRICT, BALTIMORE
CORPS OF ENGINEERS
BALTIMORE, MARYLAND

SOURCE AREA REMEDIAL SYSTEM
GASOLINE ALLEY AREAS 3805 & 1995
FORT DRUM, NEW YORK

## SVE/MPE TREATMENT SYSTEM PLAN

EA ENGINEERING, P.C.

| DRAWING NUMBER | PLATE |
|---|---|
| N/A | C-3 |

| SCALE: AS NOTED | DATE: SEPT. 2004 | SHEET 3 |
|---|---|---|

FILE PATH: Syracuse_fs/Syracuse/Working Projects\Fort Drum Projects\MARC\Design\drawings from location\final design drawings\C-3.dwg [Layout1]