MULTI PHASE VACUUM EXTRACTION UNIT
Process Flow Diagram

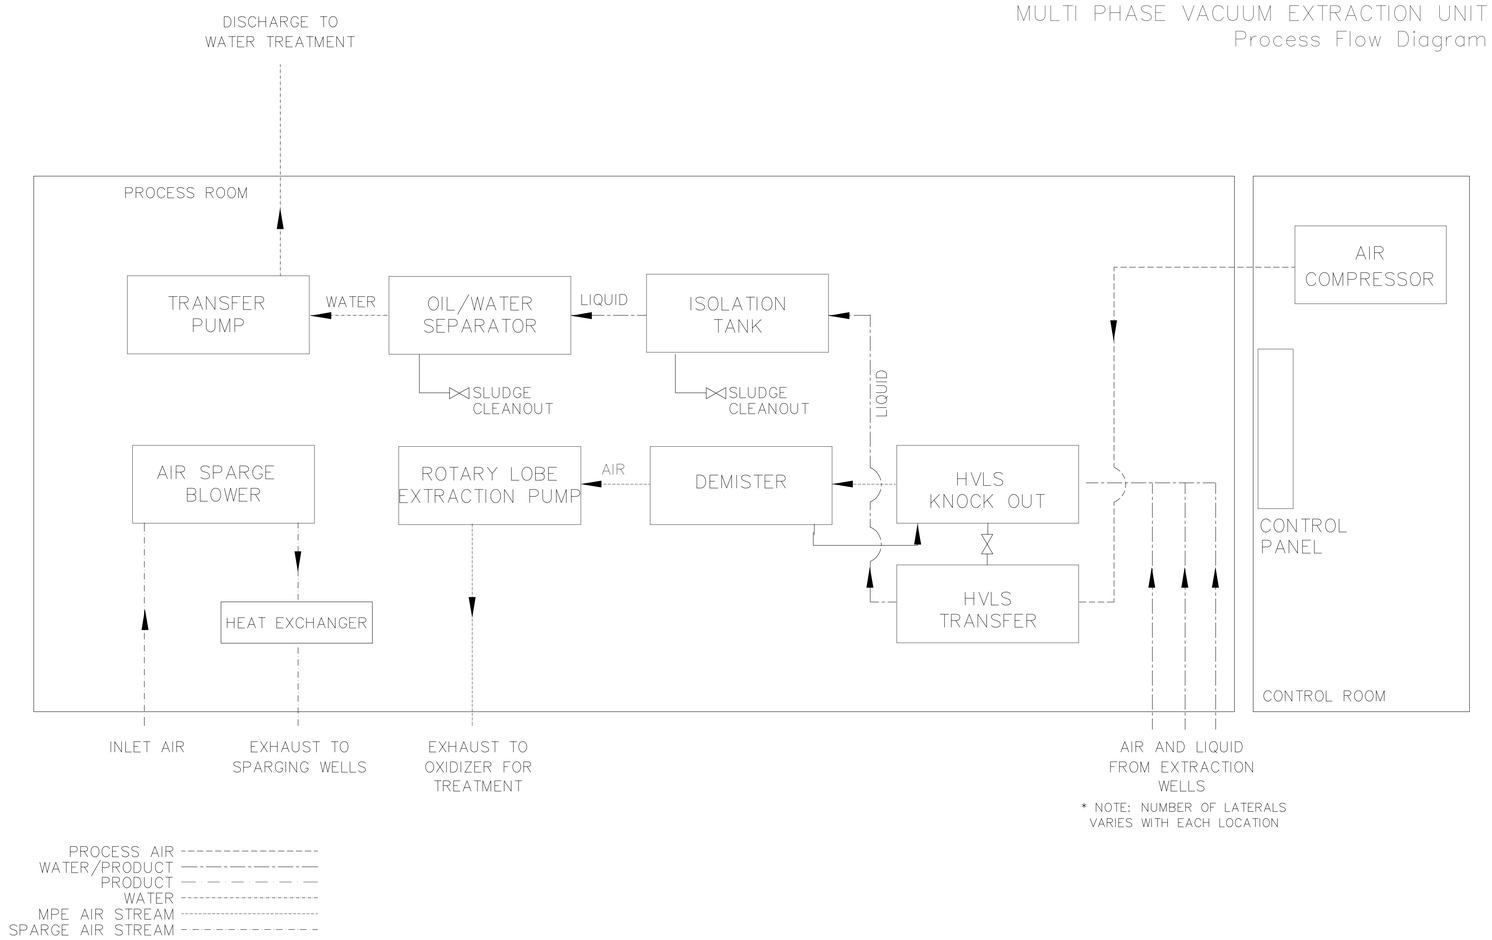


FINAL AS-BUILT

US Army Corps of Engineers

U.S. ARMY ENGINEER DISTRICT, BALTIMORE
CORPS OF ENGINEERS
BALTIMORE, MARYLAND

SOURCE AREA REMEDIAL SYSTEM
GASOLINE ALLEY AREAS 3805 & 1995
FORT DRUM, NEW YORK

TYPICAL SYSTEM PROCESS FLOW DIAGRAM

EA ENGINEERING, P.C.

| DRAWING NUMBER | PLATE |
|---|---|
| N/A | M-1 |

SCALE: AS NOTED | DATE: SEPT. 2004 | SHEET 1

FILE: Syracuse_fy/Syracuse/Working Projects\Fort Drum Projects\MARC\Design\drawings from lovelace\final design drawings\M-1.dwg [Layout1]