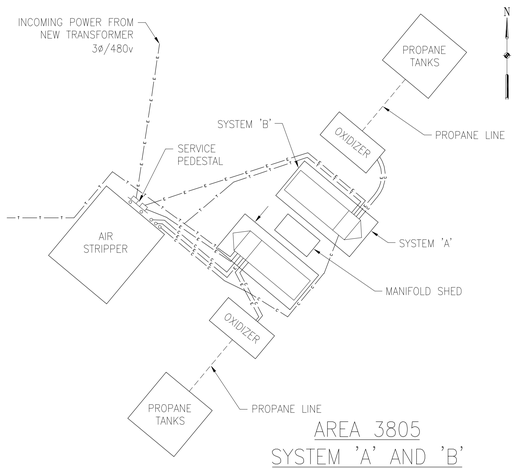


AREA 3805
SYSTEM 'A' AND 'B'
SITE PLAN
SCALE: 1" = 20'-0"

## LEGEND

| | |
|---|---|
| —E—E—E— | ELECTRIC |
| —T—T—T— | TELEPHONE |
| —E—E—E— | CONTROL WIRING (LOW VOLTAGE) |

## NOTES:

1. ELECTRICAL/TELPHONE WIRE PULLED THROUGH CONDUIT INSTALLED WITH PIPING.




AREA 3805
SYSTEM 'A' AND 'B'
SITE PLAN
SCALE: 1" = 20'-0"

## LEGEND

| | |
|---|---|
| —V—V—V— | WATER |
| —EV—EV—EV— | EFFLUENT VAPOR |

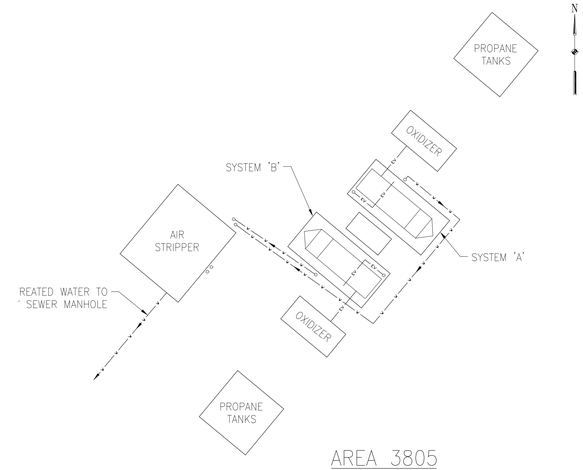


NOTE: ALL VERTICAL WATER LINES ARE HEAT TRACED AND INSULATED.

DETAIL
NOT TO SCALE




AREA 3805
SYSTEM 'C'
SITE PLAN
SCALE: 1" = 20'-0"
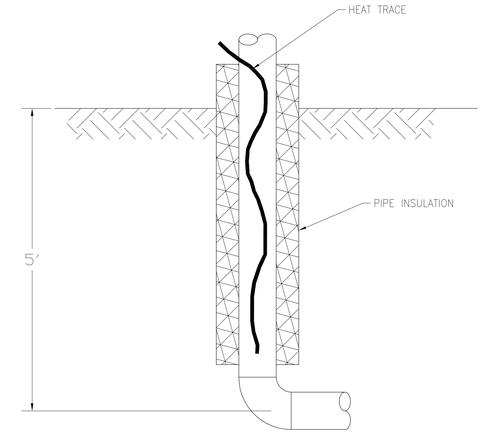
## LEGEND

| | |
|---|---|
| —E—E—E— | ELECTRIC |
| —T—T—T— | TELEPHONE |
| —V—V—V— | WATER |
| —EV—EV—EV— | EFFLUENT VAPOR |

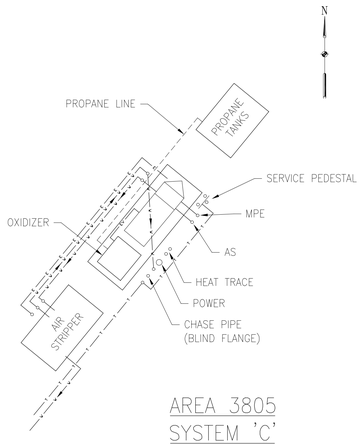


AREA 1995
SITE PLAN
SCALE: 1" = 20'-0"

## LEGEND

| | |
|---|---|
| —E—E—E— | ELECTRIC |
| —T—T—T— | TELEPHONE |
| —V—V—V— | WATER |
| —EV—EV—EV— | EFFLUENT VAPOR |

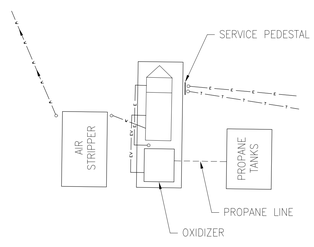


NOTE: MPE AND SPARGING MANIFOLDS ARE STACKED (ONE ABOVE THE OTHER) ON THE TRAILER WALL.

MANIFOLD DETAIL
NOT TO SCALE

FINAL AS-BUILT

US Army Corps of Engineers

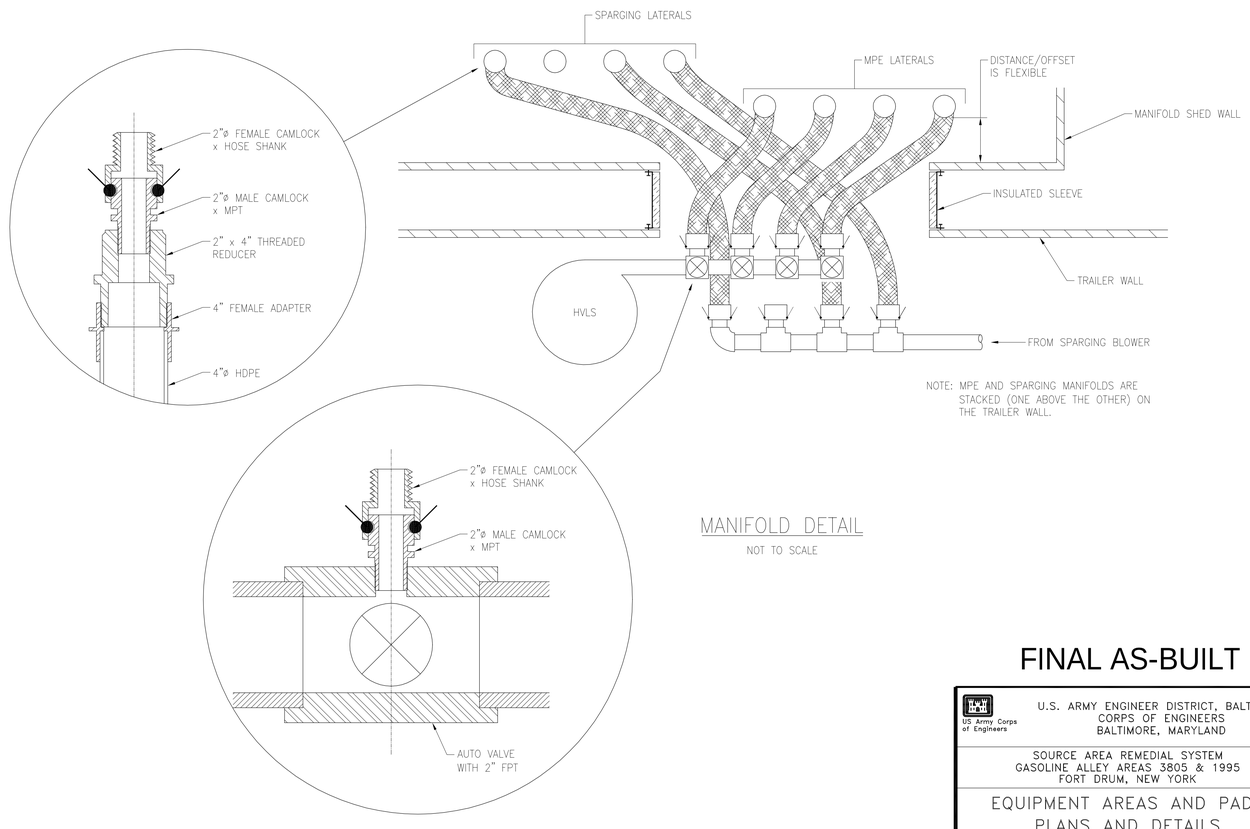U.S. ARMY ENGINEER DISTRICT, BALTIMORE
CORPS OF ENGINEERS
BALTIMORE, MARYLAND

SOURCE AREA REMEDIAL SYSTEM
GASOLINE ALLEY AREAS 3805 & 1995
FORT DRUM, NEW YORK

EQUIPMENT AREAS AND PADS
PLANS AND DETAILS

EA ENGINEERING, P.C.

| DRAWING NUMBER | PLATE |
|---|---|
| N/A | C-6B |

SCALE: AS NOTED | DATE: SEPT. 2004 | SHEET 6B

FILE: Syracuse_Fp/Syracuse/Working Projects/Fort Drum Projects/MARC\Design\drawings from lovelton\Final design drawings\C-6.dwg (Layout1)