


MANIFOLD SHED PLAN VIEW
NOT TO SCALE

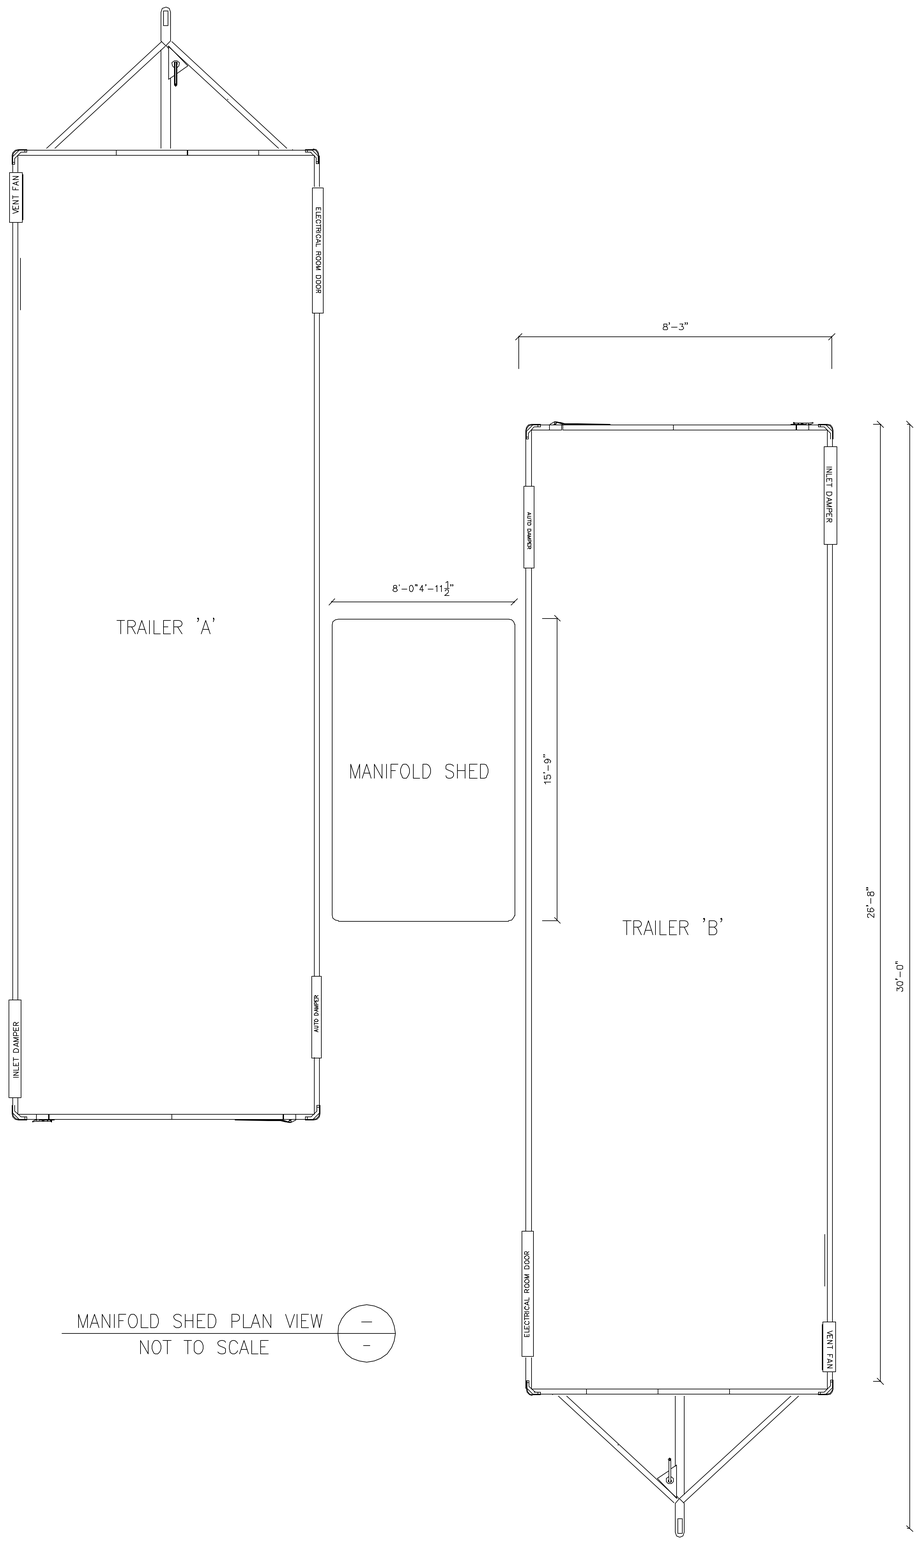


MANIFOLD SHED ELEVATION VIEW
NOT TO SCALE




MANIFOLD SHED FOOTER & WALL DETAIL
NOT TO SCALE

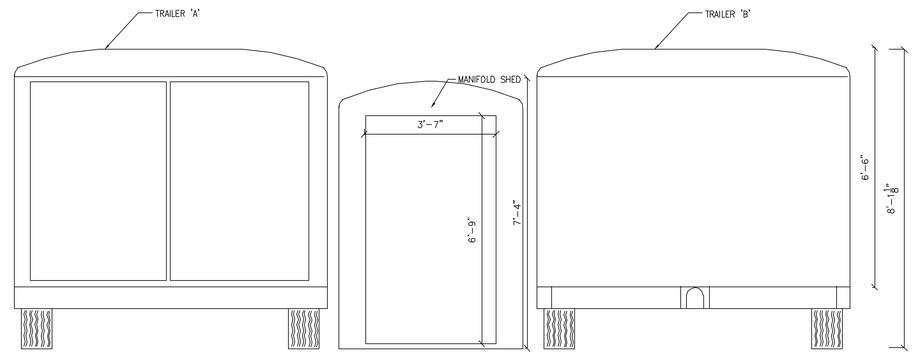


MANIFOLD LAYOUT
NOT TO SCALE

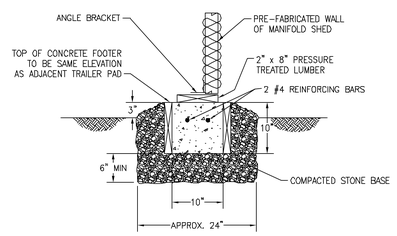


SLEEVE DETAIL
NOT TO SCALE

NOTES:

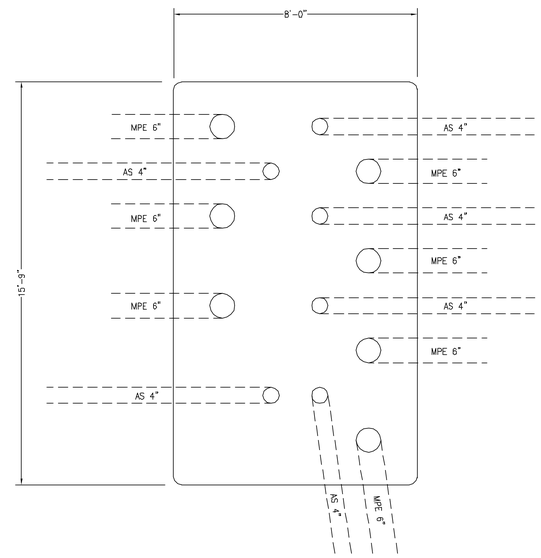1. THE MANIFOLD SHED DIMENSIONS ARE AS FOLLOWS: 15'-9" LONG, 8'-0" WIDE, AND 7'-4" HIGH. DIMENSIONS ARE OUTSIDE DIMENSIONS. THERE IS A HIGH DOOR ON BOTH SIDES OF THE ENCLOSURE.
2. THE BUILDING SITS ON A CONCRETE FOOTING THAT EXTENDS 1'-6" ABOVE GRADE AND ALLOWS FOR APPROXIMATELY 6'-5" OF HEADROOM INSIDE THE SHED.
3. THE TREATMENT UNITS ARE LOCATED AS CLOSE AS PRACTICAL TO THE DOGHOUSE AND THERE IS AN INSULATED SLEEVE INSTALLED TO ALLOW FOR ACCESS TO EACH TREATMENT UNIT, LOCATED AT THE INLET HEADER OF EACH UNIT.

# FINAL AS-BUILT

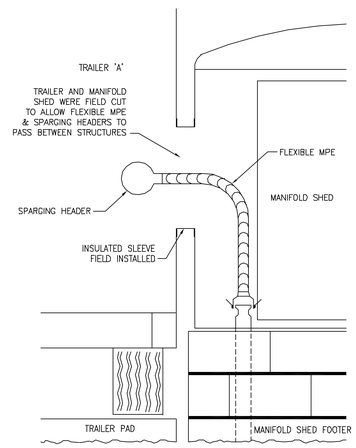US Army Corps of Engineers

U.S. ARMY ENGINEER DISTRICT, BALTIMORE
CORPS OF ENGINEERS
BALTIMORE, MARYLAND

SOURCE AREA REMEDIAL SYSTEM
GASOLINE ALLEY AREAS 3805 & 1995
FORT DRUM, NEW YORK

MANIFOLD SHED FOR
SYSTEMS 'A' AND 'B'

EA ENGINEERING, P.C.

| DRAWING NUMBER | PLATE |
|---|---|
| N/A | C-9 |

SCALE: AS NOTED | DATE: SEPT. 2004 | SHEET 9