# AS-BUILT DRAWINGS
# SOURCE AREA REMEDIAL SYSTEM
## GASOLINE ALLEY AREAS 3805 AND 1995
## FORT DRUM, NEW YORK

Prepared For
U.S. ARMY CORPS OF ENGINEERS - BALTIMORE DISTRICT
BALTIMORE, MARYLAND

Submitted By
CAPE ENVIRONMENTAL MANAGEMENT, INC.
EXTON, PENNSYLVANIA

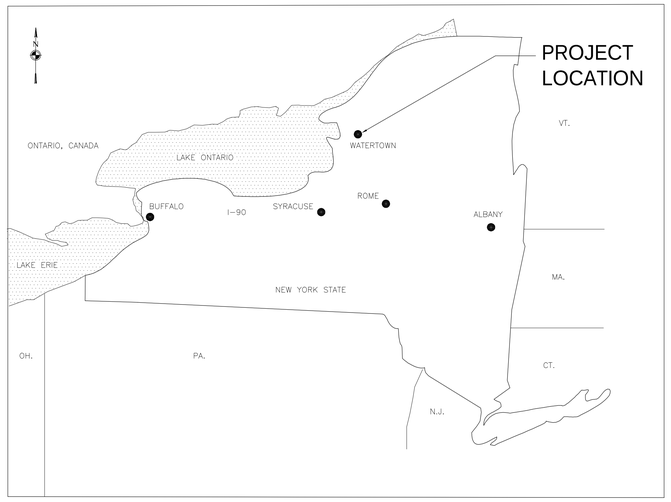


LOCATION MAP

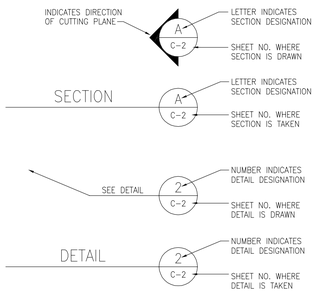


DRAWING INDEX

| DRAWING | TITLE |
|---|---|
| T-1 | TITLE SHEET |
| C-1 | EXISTING SITE CONDITIONS |
| C-2 | WELL INSTALLATION PLAN |
| C-3 | SVE/MPE TREATMENT SYSTEM PLAN |
| C-4 | AIR SPARGE TREATMENT SYSTEM PLAN |
| C-5 | NYS ROUTE 26 ROAD CROSSING |
| C-5A | AREA 3805 SYSTEM 'B' RAILROAD TRACK CROSSING |
| C-5B | AREA 1995 RAILROAD TRACK CROSSING |
| C-6 | TREATMENT SYSTEM DETAILS |
| C-6A | TRANSFORMER PAD PLAN AND DETAILS |
| C-6B | EQUIPMENT AREA AND PAD PLANS AND DETAILS |
| C-7 | WELL DETAIL & WELL INSTALLATION SCHEDULE |
| C-8 | SCHEDULE OF PIPING |
| C-9 | MANIFOLD SHED FOR SYSTEMS 'A' AND 'B' |
| M-1 | TYPICAL SYSTEM PROCESS FLOW DIAGRAM |
| M-2 | AREA 3805 SYSTEMS A & B EQUIPMENT LAYOUT AND SCHEDULE |
| M-3 | AREA 3805 SYSTEM C EQUIPMENT LAYOUT AND SCHEDULE |
| M-4 | AREA 1995 EQUIPMENT LAYOUT AND SCHEDULE |
| M-5 | AREA 3805 SYSTEM A PIPING AND INSTRUMENTATION DIAGRAM |
| M-6 | AREA 3805 SYSTEM B PIPING AND INSTRUMENTATION DIAGRAM |
| M-7 | AREA 3805 SYSTEM C PIPING AND INSTRUMENTATION DIAGRAM |
| M-8 | AREA 1995 PIPING AND INSTRUMENTATION DIAGRAM |
| E-1 | TREATMENT SYSTEM 'A' ELECTRICAL PLAN |
| E-2 | TREATEMENT SYSTEM 'B' ELECTRICAL PLAN |
| E-3 | TREATMENT SYSTEM 'C' ELECTRICAL PLAN |
| E-4 | AREA 1995 SYSTEM ELECTRICAL PLAN |

FINAL AS-BUILT

US Army Corps of Engineers

U.S. ARMY ENGINEER DISTRICT, BALTIMORE
CORPS OF ENGINEERS
BALTIMORE, MARYLAND

SOURCE AREA REMEDIAL SYSTEM
GASOLINE ALLEY AREAS 3805 & 1995
FORT DRUM, NEW YORK

TITLE SHEET

EA ENGINEERING, P.C.

| DRAWING NUMBER | PLATE |
|---|---|
| N/A | T-1 |

SCALE: AS NOTED | DATE: SEPT. 2004 | SHEET 1

FILE PATH: \\LDVETDN1 Q:\Projects\300040\dwg\T-1.dwg [Layout1]