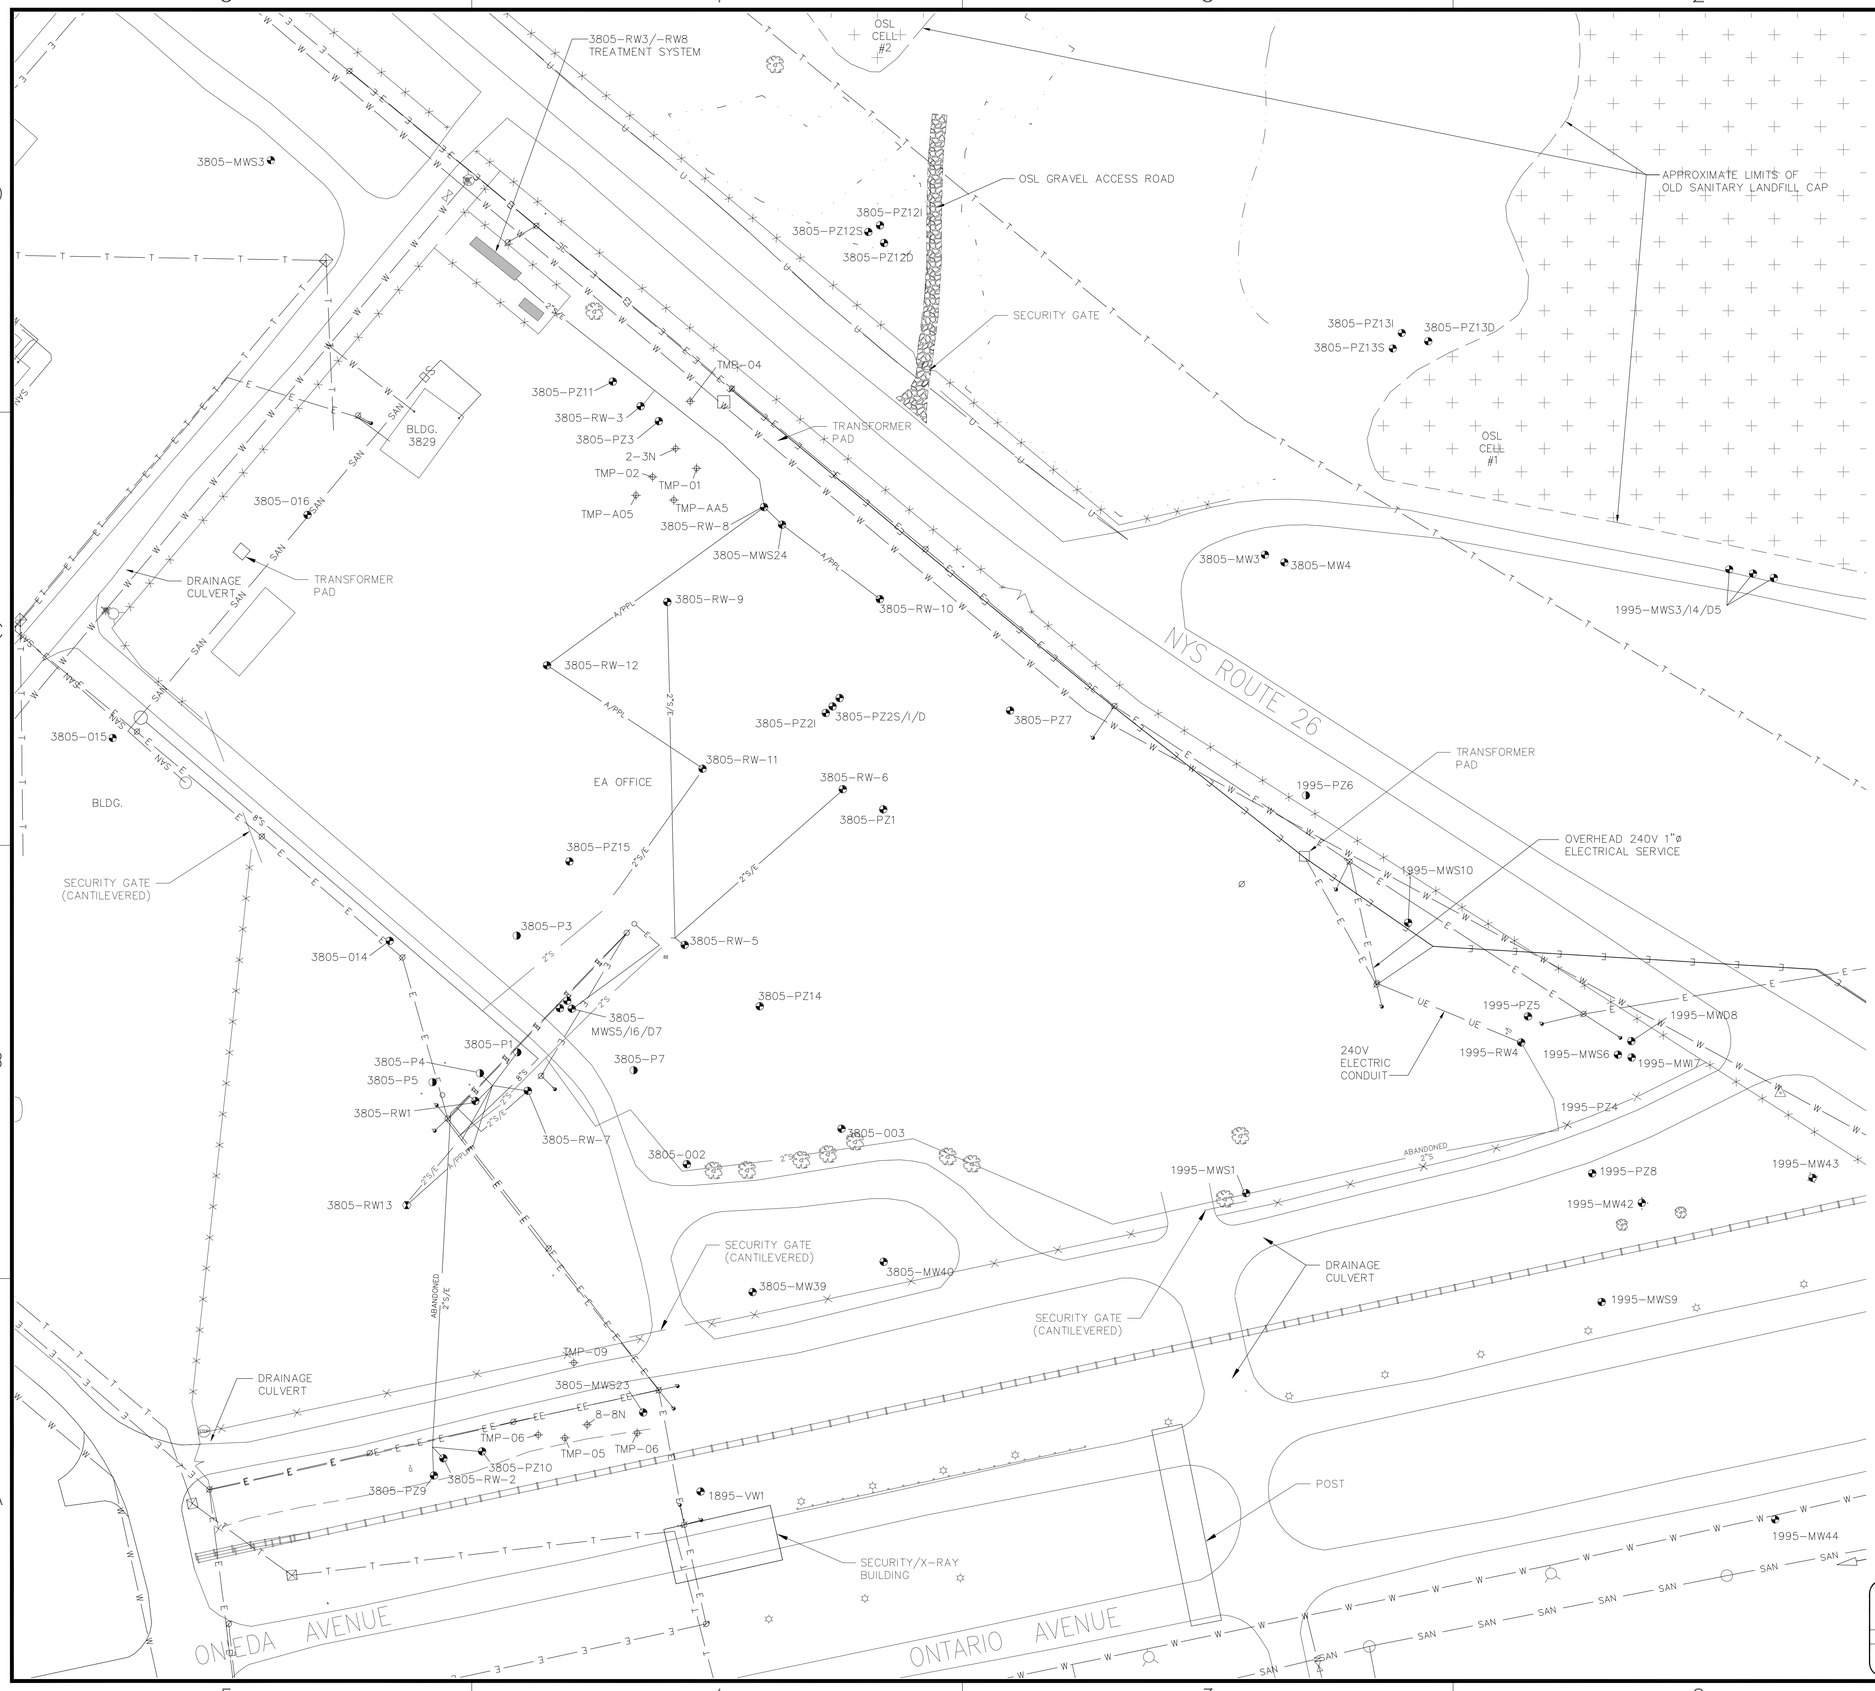


## LEGEND

- 625 — INDEX CONTOUR (5' INTERVAL)
- 605 — INTERMEDIATE CONTOUR (1' INTERVAL)
- NEW FENCELINE
- EXISTING FENCELINE
- ROAD (PAVED)
- RAILROAD
- RAVINE
- MONITORING WELL
- RECOVERY WELL
- PIEZOMETER
- TEMPORARY WELL
- WOODED AREA
- TRAILER
- BUILDING
- UTILITY POLE

## UTILITIES

- E — ELECTRIC SERVICE
- SAN — SANITARY SERVICE
- T — TELEPHONE SERVICE
- W — WATER LINE
- U — COMMUNICATION LINE
- 8"S — ABANDONED BURIED 8" PVC SANITARY LINE (5 FT BGS)
- 2"S — ABANDONED BURIED 2" PVC SANITARY LINE (5 FT BGS)
- 2"S/E — ABANDONED BURIED 2" PVC SANITARY LINE (5 FT BGS) 240V & 12V ELECTRIC CONDUITS (2 FT BGS)
- A/PPL — ABANDONED BURIED PVC AIRLINE & SEPERATE PHASE PRODUCT LINE CONDUIT (2 FT BGS)
- UE — 240V ELECTRIC CONDUIT (2 FT BGS)

## NOTES:

1. UTILITY LOCATIONS ARE APPROXIMATE AND BASED ON AVAILABLE INFORMATION FROM FORT DRUM AND EA ENGINEERING, SCIENCE, AND TECHNOLOGY (EA). UTILITY LOCATIONS WERE FIELD VERIFIED BY CONTRACTOR. ADDITIONAL UTILITIES KNOWN TO BE PRESENT (e.g. BASE COMMUNICATION LINE ON SOUTH SIDE OF ROUTE 26) HAVE NOT BEEN MAPPED BY EA OR FORT DRUM AND ARE NOT SHOWN.
2. TOPOGRAPHIC SURVEY PERFORMED DECEMBER 2002 BY GYMO ARCHITECTURE, ENGINEERING, AND LAND SURVEYING, P.C. . HORIZONTAL AND VERTICAL DATUM ARE BASED ON FORT DRUM COORDINATE SYSTEM. (NAD83-HORIZONTAL AND NGVD88-VERTICAL).
3. IN GENERAL, GROUND SURFACE IS GRAVEL OR GRASS, EXCEPT WHERE INDICATED.
4. NEW ENTRANCE GATE AREA. FEATURES ASSOCIATED WITH ENTRANCE GATE (e.g. BARRIERS, POLES, PAVEMENT, etc.) CAN BE OBTAINED FROM FORT DRUM PUBLIC WORKS DEPARTMENT.

# FINAL AS-BUILT

US Army Corps of Engineers

U.S. ARMY ENGINEER DISTRICT, BALTIMORE
CORPS OF ENGINEERS
BALTIMORE, MARYLAND

SOURCE AREA REMEDIAL SYSTEM
GASOLINE ALLEY AREAS 3805 & 1995
FORT DRUM, NEW YORK

## EXISTING SITE CONDITIONS

EA ENGINEERING, P.C.

| DRAWING NUMBER | PLATE |
|---|---|
| N/A | C-1 |

SCALE: AS NOTED | DATE: SEPT. 2004 | SHEET 1

0 25 50 100
SCALE: 1" = 50'
Verify Scale
Bar is one inch on original drawing.
0 1"

FILE: Syracuse_fp/Syracuse/Working Projects\Fort Drum Projects\MARC\Design\drawings from lovetsch\final design drawings\C-1.dwg [Layout1]