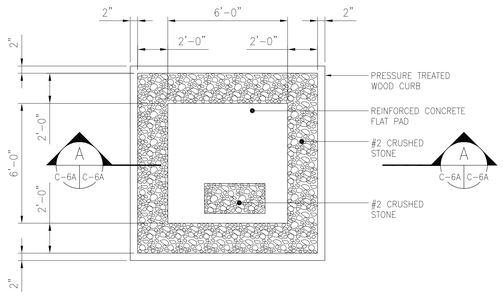


PAD MOUNTED TRANSFORMER AREA PLAN

SCALE: 1/4" = 1'-0"

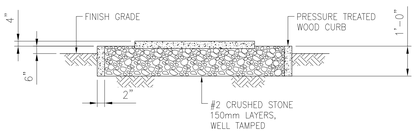


SECTION

SCALE: 1/4" = 1'-0"

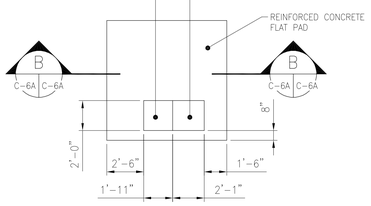


TRANSFORMER PAD PLAN

SCALE: 1/4" = 1'-0"

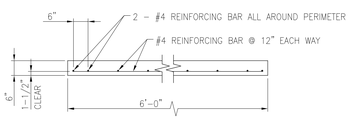


SECTION

SCALE: 1/2" = 1'-0"

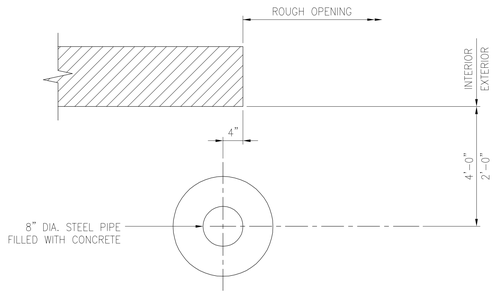


PLAN

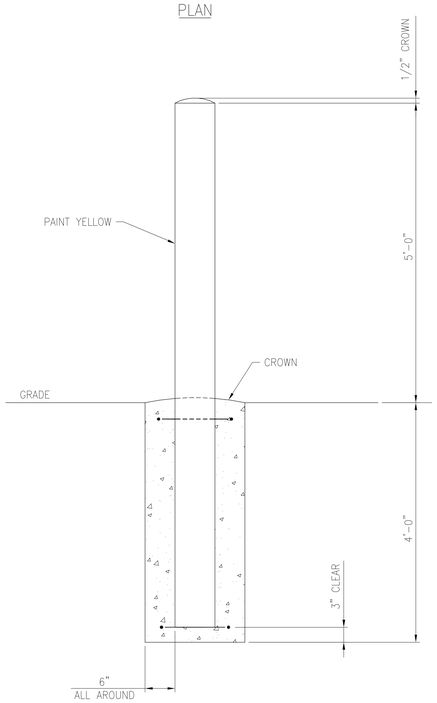


SECTION

TYPICAL BOLLARD DETAIL AT PROPANE TANK LOCATIONS

SCALE: 1" = 1'-0"

CONCRETE EQUIPMENT PAD NOTES:

1. CONCRETE: 4,000 PSI AT 28 DAYS.
2. DEFORM BARS: ASTM A_615M, GRADE 60.
3. 3/4" CHAMFER ALL AROUND, INCLUDING OPENING

FINAL AS-BUILT

US Army Corps of Engineers

U.S. ARMY ENGINEER DISTRICT, BALTIMORE
CORPS OF ENGINEERS
BALTIMORE, MARYLAND

SOURCE AREA REMEDIAL SYSTEM
GASOLINE ALLEY AREAS 3805 & 1995
FORT DRUM, NEW YORK

TRANSFORMER PAD PLANS AND DETAILS

EA ENGINEERING, P.C.

| DRAWING NUMBER | PLATE |
|---|---|
| N/A | C-6A |

SCALE: AS NOTED | DATE: SEPT. 2004 | SHEET 6A

FILE: Syracuse_Fp/Syracuse/Working Projects/Fort Drum Projects/MARC/Design/drawings from lovetson/final design drawings/C-6.dwg [Layout1]