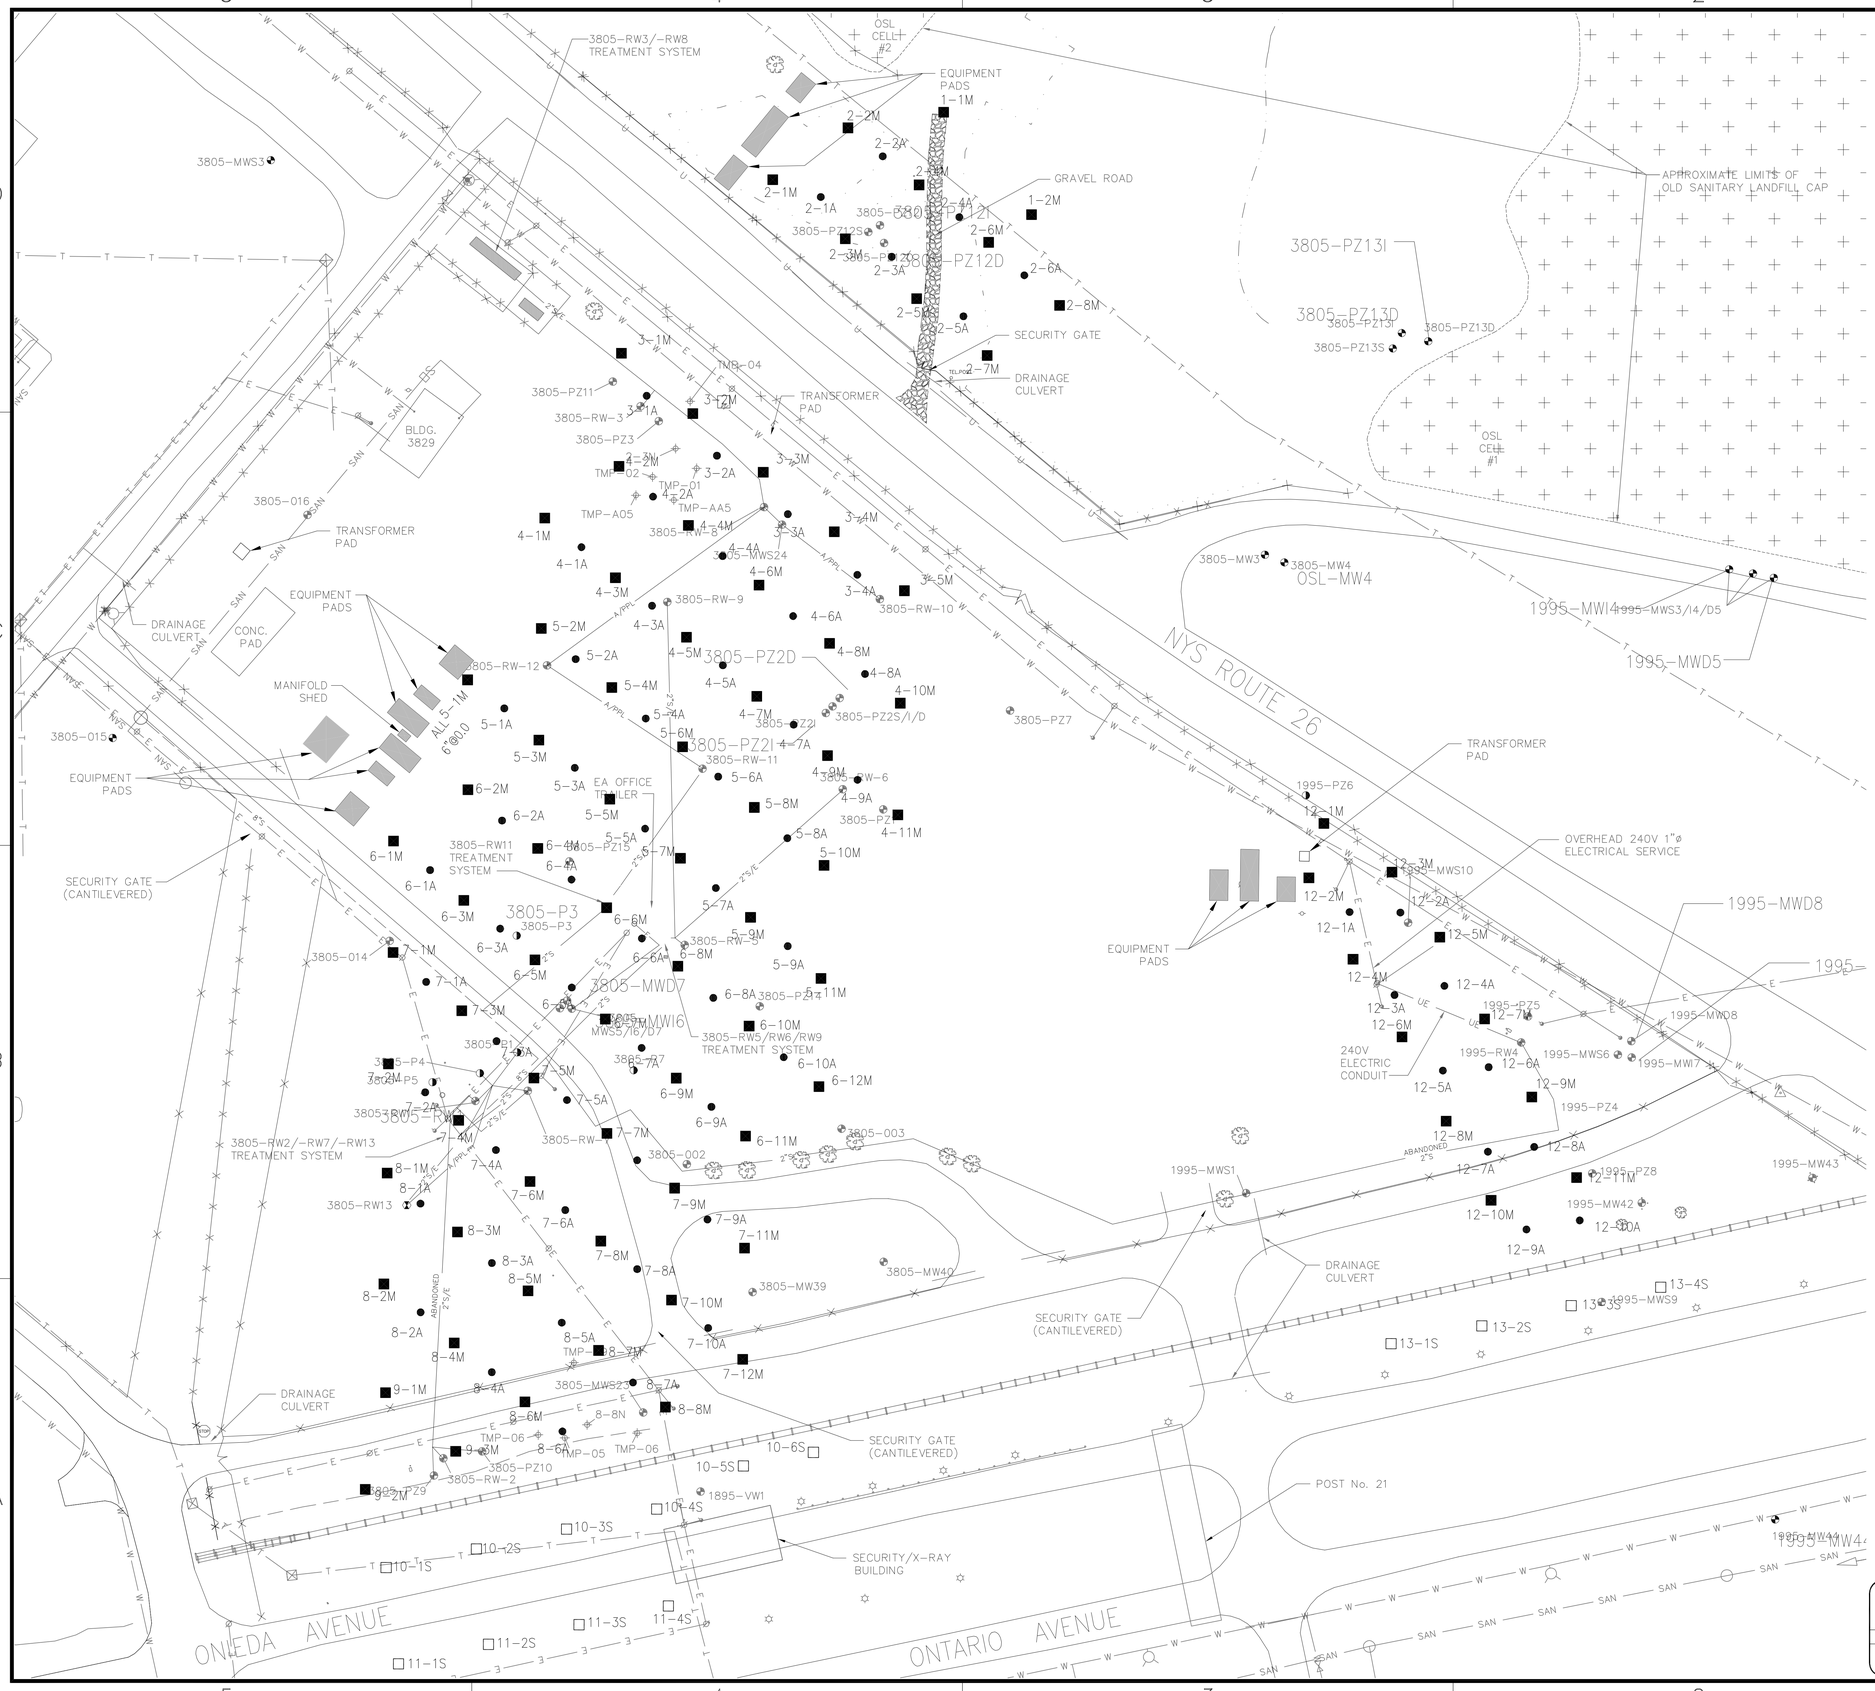


N

## LEGEND

- NEW FENCELINE
- EXISTING FENCELINE
- MULTI-PHASE EXTRACTION (MPE) WELL
- SOIL VAPOR EXTRACTION (SVE) WELL
- AQUIFER AIR SPARGE (AAS) WELL

## UTILITIES

- ELECTRIC SERVICE
- SANITARY SERVICE
- TELEPHONE SERVICE
- WATER LINE
- COMMUNICATION LINE
- ABANONED BURIED 8" PVC SANITARY LINE (5 FT BGS)
- ABANONED BURIED 2" PVC SANITARY LINE (5 FT BGS)
- ABANONED BURIED 2" PVC SANITARY LINE (5 FT BGS) 240V & 12V ELECTRIC CONDUITS (2 FT BGS)
- ABANONED BURIED PVC AIRLINE & SEPARATE PHASE PRODUCT LINE CONDUIT (2 FT BGS)
- 240V ELECTRIC CONDUIT (2 FT BGS)

NOTES:

1. EXISTING SITE FEATURE LOCATIONS (I.E., WELLS, TREATMENT SYSTEM BUILDINGS, ETC.) ARE APPROXIMATE AND BASED ON AVAILABLE INFORMATION. LOCATIONS WERE FIELD VERIFIED BY CONTRACTOR.
2. REFER TO PLATE C-7 FOR NORTHING, EASTING, SCREEN ELEVATIONS, AND WELL CONSTRUCTION FOR THE MPE, SVE, AND AAS WELLS.

# FINAL AS-BUILT

US Army Corps of Engineers

U.S. ARMY ENGINEER DISTRICT, BALTIMORE
CORPS OF ENGINEERS
BALTIMORE, MARYLAND

SOURCE AREA REMEDIAL SYSTEM
GASOLINE ALLEY AREAS 3805 & 1995
FORT DRUM, NEW YORK

## WELL INSTALLATION PLAN

EA ENGINEERING, P.C.

| DRAWING NUMBER | PLATE |
|---|---|
| N/A | C-2 |

SCALE: AS NOTED | DATE: SEPT. 2004 | SHEET 2

0 25 50 100
SCALE: 1" = 50'
Verify Scale
Bar is one inch on original drawing.
0 1"

FILE: Syracuse_fp/Syracuse/Working Projects\Fort Drum Projects\MARC\Design\drawings from lovetsch\final design drawings\C-2.dwg [Layout1]