


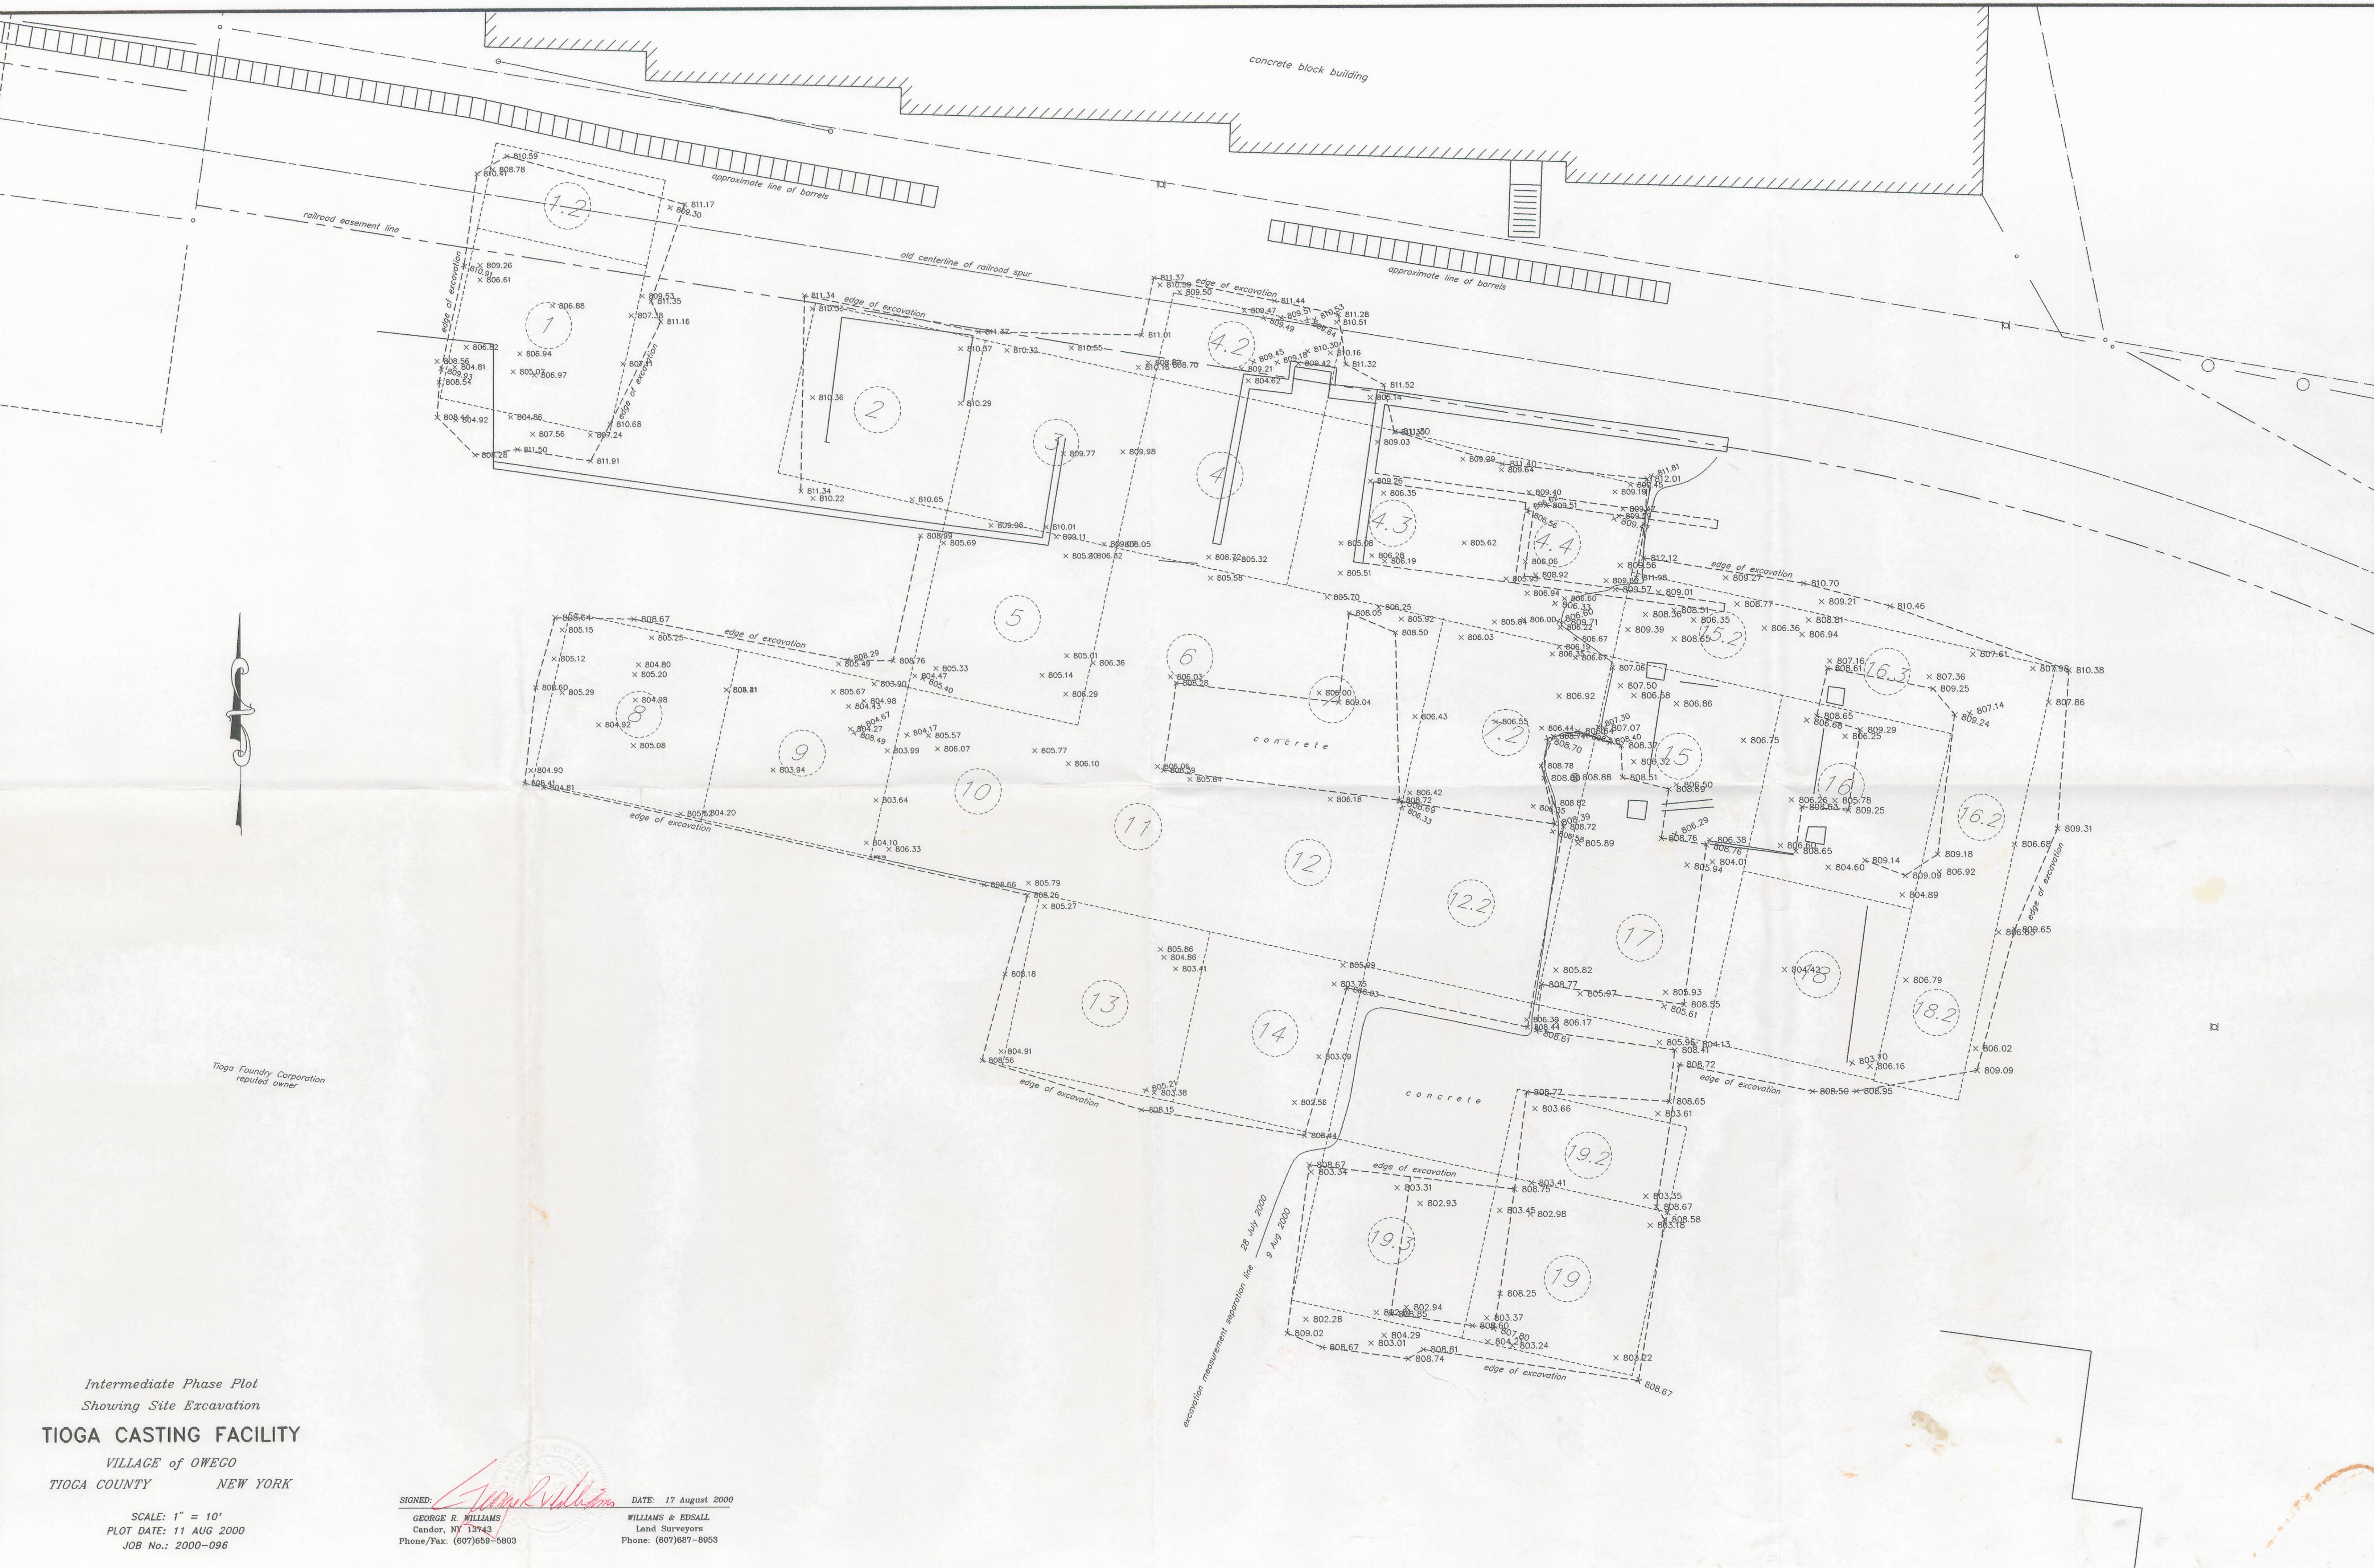

Tioga Foundry Corporation
reputed owner

Intermediate Phase Plot
Showing Site Excavation
TIOGA CASTING FACILITY
VILLAGE of OWEGO
TIOGA COUNTY NEW YORK

SCALE: 1" = 10'
PLOT DATE: 11 AUG 2000
JOB No.: 2000-096

SIGNED: *George R. Williams* DATE: 17 August 2000
GEORGE R. WILLIAMS WILLIAMS & EDSALL
Candor, NY 13743 Land Surveyors
Phone/Fax: (607)659-5803 Phone: (607)687-8953