

Report, hw828076.

1988-9-27. DOTIRM

Daily Reports

LETTER OF TRANSMITTAL

NEW YORK STATE
DEPARTMENT OF TRANSPORTATION
REGION 4 DESIGN
1530 Jefferson Road
Rochester, New York 14623
Ph. 272-3360 Fax. 272-7547

Page 1 of 1 + ATTACHMENTS

Date: 12 / 10 / 1997 P.I.N. 4088 . 11 .

Re: SCOBELL SITE


TO: JIM MORRIS
N.Y.S. DEPT. OF ENV. CONS.
DIV. OF ENVIRONMENTAL REMEDIATION - ROOM 348
50 WOLF RD.
ALBANY, NY 12233-7010

Phone #: 518-457-0315

Fax #: _____

FROM: MARY ELLEN PAPIN

Phone #: 716-272-4826

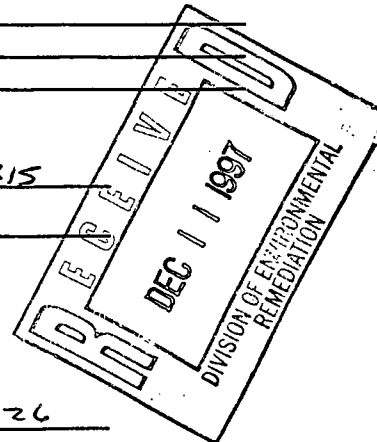

WE ARE SENDING YOU THE FOLLOWING:

- | | | | |
|--------------------------|----------------------|-------------------------------------|--------------------------|
| <input type="checkbox"/> | Preliminary Drawings | <input type="checkbox"/> | Final Prints |
| <input type="checkbox"/> | Copy of letter/memo | <input type="checkbox"/> | Specifications/Estimates |
| <input type="checkbox"/> | Utility Information | <input checked="" type="checkbox"/> | <u>AS LISTED BELOW</u> |

No.	Copies	Description
1	1	KEY TO LOCK ON GATE AT SCOBELL SITE
2	1	MISC. SHEETS FROM THE SCOBELL FILES STORED AT OUR OFFICE, INCL. A MAP SHOWING DIMENSIONS OF CURRENT SITE FENCING, A MAP INDICATING THE OVERALL BOUNDARIES OF HAZARDOUS SOIL REMOVAL, INDIVIDUAL DAILY REPORTS ^{MAPS} INDICATING WHERE SOIL AND ROCK WERE REMOVED
3	1	"AS BUILT" DRAINAGE PLANS FOR THE AREA NEAR TITE SCOBELL SITE

THESE ARE TRANSMITTED (as checked below):

- | | | | | | |
|--------------------------|---|-------------------------------------|----------------------|--------------------------|-------------------|
| <input type="checkbox"/> | For your use | <input checked="" type="checkbox"/> | As requested | <input type="checkbox"/> | reply requested |
| <input type="checkbox"/> | For approval | <input checked="" type="checkbox"/> | For your information | <input type="checkbox"/> | call upon receipt |
| <input type="checkbox"/> | For review and comment (Return by _____) | | | | |
| <input type="checkbox"/> | Comments as noted (correct and return by _____) | | | | |

ADDITIONAL INSTRUCTIONS/REMARKS: I HAVE SPOKEN TO OUR MONROE EAST MAINTENANCE RESIDENCY. THEY WILL CHECK THE SCOBELL FENCES AND MEND ANY HOLES AS GOOD AS POSSIBLE IN TITE NEAR FUTURE. THE LEGAL OWNER'S ^{MAILING} ADDRESS IS NYS DOT, 1530 JEFFERSON RD, ROCHESTER, NY 14623. YOU CAN USE MY NAME AS THE CONTACT. I WILL PASS INFORMATION ON TO OUR MAIN OFFICE - ENV. ANALYSIS BUREAU AS NECESSARY / APPROPRIATE.

COPY TO: FILE

SIGNED: M.E. Papin

(HRR.1 3/9/92)

PLEASE LET ME KNOW IF I HAVE PROVIDED ENOUGH INFORMATION TO ANSWER YOUR QUESTIONS. AS WE DISCUSSED I HAVE LOOKED THROUGH OUR FILES WHICH ARE STORED AT THIS LOCATION. IF THIS INFORMATION IS NOT ADEQUATE WE CAN LOOK BACK INTO THE DEAD FILES WHICH ARE STORED AT ANOTHER LOCATION.

Date: 9-17-00

Day of Week: S M W T F S

I.R. No.: 10

Sheet No. 1 of 4 Sheets

JOB STAMP
 CONTRACT 0500730
 F.A. PROJ. NO. 4088.08.311
 F.I.H. 64210.1311
 HAZARDOUS WASTE CLEANUP
 & BLDG. DEMO. - 1490/1590 INTERCHANGE
 MONROE COUNTY
 CONSULTOR: SEVENSON ENVIRON. SERV.

If pertinent to the Construction Operation		
	AM	PM
Weather	COOL	SUNNY
Temperature	50°F	70°F.

DESCRIPTION OF WORK PERFORMED AND INSPECTED

Specify for Each Operation: Item No., Sub-Contractor (if any), Location and Nature of Work

PRIME: SEVENSON ENVIRONMENTAL SERVICES I

OPERATION TRANSPORTATION OF WASTE CONTAMINATED MATERIAL.

Excavation of the contaminated soil started at 7:10 A.M. Material waste was loaded into Truck from location--(see fig 5). using Backhoe 360 and Dose D65 #443 Komatsu.

Poly was placed ~~over~~ on the ground near the excavation site for the loading trucks to drive over and cover the trailer with the roll over material which covered the hazardous waste material.

ITEM NO.	FS	ES	INTERIM QUANT.	FINAL QUANT.	QUANT. CHK.	DESCRIPTION OF WORK	COMPUTER	
							ENT.	CHK.
						Excavation of ^{waste} Material		
						Transportation of W.M.		

The above described work was incorporated into this project and was inspected by:

Olufunmilayo Arijorin
 Inspector's Signature

Reviewed by: David Zeh 9/29/00
 Date
 Engineer-in-Charge
 Resident Engineer

CONTRACT 0500730
F.A. PROJ. NO. 4089.CB.311
P.I.N. 4089 CP 311
HAZARDOUS WASTE CLEANUP
& BLDG. DEMO. - 1490/1 INTERCHANGE
MONROE COUNTY
CONTRACTOR: SELENDON ENVIRON. SERV.

CONSTRUCTION JOB STAMP

M.I.S. DEPARTMENT OF TRANSPORTATION

Sheet 2 of 4 Prep. by DA Date 9/27/88

Checked by _____ Date _____ Design Ident.: SH.No. _____

County _____ P.I.N. _____

Job Title _____

The D.E.C. rep. requested excavated material collected on the site at a spot should be covered with poly at the end of the operating day. It was done. He further informed the E.I.C. that no one should enter the area of excavation without protective equipment.

Total no. of Trucks was 23.
See attached sheet.

N.B. Contractor erected Fence around the site.


Trucks were decontaminated before they ~~leave~~ left the site.

CONRAIL R.O.B.

fig 5
IR #10
9/27/88


KE-1
Excavation area
9/27/88

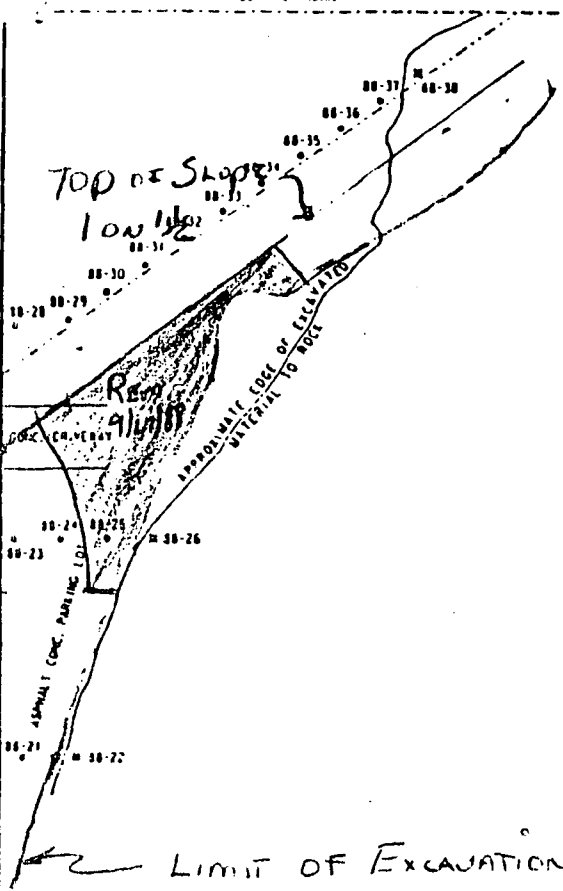


LIMIT OF EXCAVATION

- SOIL 5
- 1 FT. EARTH
- SOIL 1 OF 10 SPREAD SOIL 1
- CHIP 1 CEMENT
- LIQUID
- ▲ BALL 1
- O STAMP WHERE

NOTE: THE PROJECT LIMITS FOR THIS PROJECT ARE WITHIN THE PROPERTY LINES OF THE FORMER SCOBELL CHEMICAL CO.

Sheet 37
9/27/88

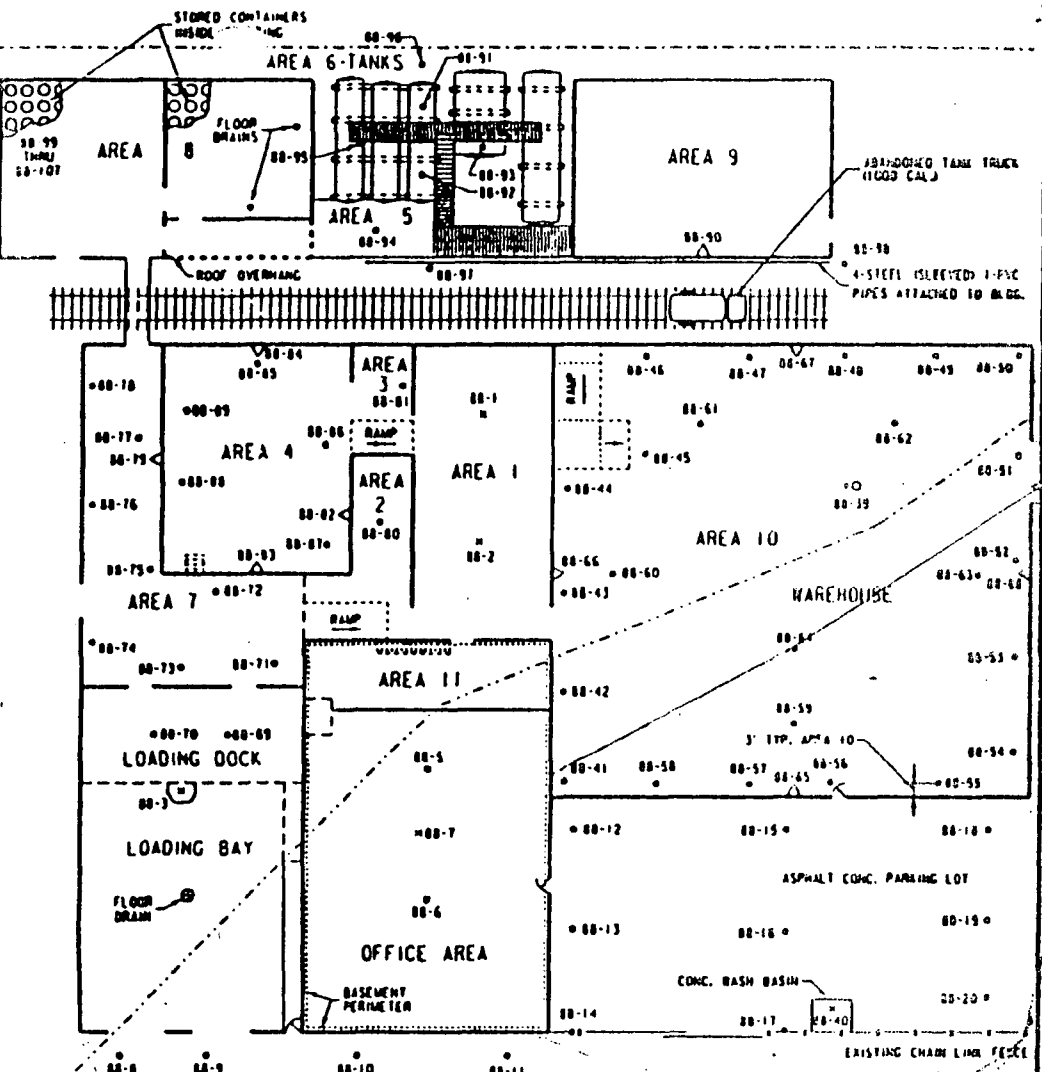

PLAN VIEW OF FORMER SCOBELL CHEMICAL CO.
(11 ROCKWOOD PLACE)

JOB STAMP

CONTRACT D500730
 F.A. PROJ. NO. 4088.08.311
 P.I.N. 4088.08.311
 HAZARDOUS WASTE CLEANUP
 & BLDG. DEMO. - I490/I590 INTERCHANGE
 MONROE COUNTY
 CONTRACTOR: SEVENSON ENVIRON. SERV.

Sheet No. 1 of 3 Sheets

Date SEPT. 27, 1988

Day of Week

S	M	<u>T</u>	W	T	F	S
---	---	----------	---	---	---	---

	AM	PM
Weather	Sunny MILD	Sunny MILD
	High	Low
Temperature	70	55

MAJOR CONTRACT OPERATIONS

I.R. No.	Inspector's Name	Work Assignment and Identification
	H. ZEH	E.I.C.
10	Old ANDRIN	FIELD INSPECTION

Maint. of Traffic & Project Signs: AREA WAS FENCED AT END OF DAY TO KEEP
PEDESTRIANS OUT OF AREA.

REMARKS! SEVENSON CONTRACTOR
 (1) BEGAN HAULING OF HAZARDOUS SOIL FROM NE
CORNER OF SCOBELL PROPERTY TO S.C.A. LANDFILL
IN NIAGARA FALLS. AFTER LOADING TRUCKS
WERE PUSHED INTO 'DECONTAMINATION AREA', TIRMS
COVERED AND TRUCK DECONTAMINATED BY BROOMING
AS DIRECTED BY D.E.C. AND BOB LONG. 'DECON AREA'
WAS IN WAREHOUSE AREA WITH ONLY PLACED ON
25' x 80' AREA. ALL WORKERS IN LOADING AREA
WERE USING 'LEVEL C' PROTECTION (HALF FACE RESPIRATOR
COVERINGS AND GLOVES) FOR PROTECTION. TRUCKS WERE
EXPERIENCING LONG DELAYS AT S.C.A. FOR UNLOADING.
23 LOADS WAS EXHAUSTED AND LOADED OUT THIS
DAY.

VISITORS
 (1) BOB LONG OF D.E.C. WAS HERE MOST OF THE
DAY.

Date: 4-28-88

Day of Week: S M T W T F S

I.R. No.: 11

Sheet No. 1 of 3 Sheets

JOB STAMP

CONTRACT D500730
 P.A. PROJ. NO. 4988.08.311
 P. NO. 4088.08.311
 HAZARIOUS WASTE CLEANUP
 BLDG. DEMO. - I490/I590 INTERCHANGE
 MONROE COUNTY
 CONTRACTOR: SIMENSON ENVIRON. SERV.

If pertinent to the Construction Operation		
	AM	PM
Weather	Cloud	Sunny/cool
Temperature	45°F	60°F

DESCRIPTION OF WORK PERFORMED AND INSPECTED
 Specify for Each Operation: Item No., Sub-Contractor (if any), Location and Nature of Work

PRIME: SEVENSON ENVIRONMENTAL SERVICES

OPERATION: TRANSPORTATION OF WASTE CONTAMINATED MATERIAL.

Contractor continue the waste contaminated material at 7:00 AM and loaded them into the trucks from location (see fig 6). Operation was similar to that of IR#:

Monitea Truck (Mark) brought in gravel for the exit cutlet created (see IR#9)

Three trucks from Prinne collected bould. Rocks ^{away} from ~~site~~ site.

ITEM NO.	FS	ES	INTERIM QUANT.	FINAL QUANT.	QUANT. CHK.	DESCRIPTION OF WORK	COMPUTER ENT. CHK.

The above described work was incorporated into this project and was inspected by:
Alu Arjovis
 Inspector's Signature

Reviewed by: David Z... 9/29/88
 Date
 Engineer-in-Charge
 Resident Engineer

Reverse side used for additional remarks and sketches.

JOB STAMP

Sheet No. 1 of 2 Sheets

Date SEPT 28, 1988

Day of Week S M T (W) T F S

CONTRACT D500730
 F.A. PROJ. NO. 4088.08.311
 P.I.N. 4088.08.311
 HAZARDOUS WASTE CLEANUP
 & BLDG. DEMO. - I490/I590 INTERCHANGE
 MONROE COUNTY
 CONTRACTOR: SEVENSON ENVIRON. SERV.

	AM	PM
Weather	<u>Partly Sunny</u> <u>COOL</u>	<u>Partly Sunny</u> <u>COOL</u>
	High	Low
Temperature	<u>60</u>	<u>48</u>

MAJOR CONTRACT OPERATIONS

I.R. No.	Inspector's Name	Work Assignment and Identification
	<u>H. ZEH</u>	<u>E.I.C.</u>
<u>11</u>	<u>OLV. ANTON</u>	<u>FIELD INSPECTION</u>

Maint. of Traffic & Project Signs: PROTEG AREA WAS FENCED AT END OF DAY TO KEEP PEDIESTRIANS OUT OF AREA. ALL EMPLOYEES IN EXCAVATION AREA AND LOADING AREA WILL OBSERVED

REMARKS: WEAVING LEVEL BC PROTECTION.

SEVENSON CONTRACTOR:
 (1) CONTINUED EXCAVATING HAZARDOUS SOIL FROM NE SECTION OF SCOBEL WORKING SOUTH. AS YESTERDAY A LAYER 1" THICK DOWN 3' IS BEING ENCOUNTERED DO CONTAINING BROKEN BOTTLES AND ORGANIC MATERIAL WITH ODOR.

(2) CONSTRUCTED HAUL ROAD AROUND WEST & NORTH SIDE OF SCOBEL PROPERTY FOR TRUCKS AND WAY TO RWY TO BACK OF PROPERTY. ROAD WAS BUILT FROM 6" CRUSHED RWY

JOB STAMP

CONTRACT D590730
 P.A. PROJ. NO. 4088.08.311
 P.I.N. 4088.08.311
 HAZARDOUS WASTE CONTRACT
 & BLDG. DEMO. - TASF/LOI INTERCHANGE
 MONROE COUNTY
 CONTRACTOR: SEVENSON ENVIRON. SERV.

If pertinent to the Construction Operation		
	AM	PM
Weather	Cool	Cool
Temperature	45°F	60°F

DESCRIPTION OF WORK PERFORMED AND INSPECTED
 Specify for Each Operation: Item No., Sub-Contractor (if any),
 Location and Nature of Work

PRIME: SEVENSON ENVIRONMENTAL SERVICES.

OPERATION: Location see fig 7

Contractor continue to remove contaminated hazardous waste using trucks load them away from the site. Trucks were decontaminated before leaving the area. E.I.C did locate bottom of the slope and the toe of slope which is the base of the bed rock. With the help of Bob Long the DFC rep.

ITEM NO.	FS	ES	INTERIM QUANT.	FINAL QUANT.	QUANT. CHK.	DESCRIPTION OF WORK	COMPUTER ENT. CHK.
						Waste material removed	

The above-described work was incorporated into this project and was inspected by:

[Signature]
 Inspector's Signature

Reviewed by: *[Signature]*

Engineer-in-Charge
 Resident Engineer

9/3/03
 Date

Reverse side used for additional remarks and sketches.

JOB STAMP

CONTRACT D500730
F.A. PROJ. NO. 4088.08.311
P.I.N. 4088.08.311
HAZARDOUS WASTE CLEANUP
& BLDG. DEMO. - I490/I590 INTERCHANGE
MONROE COUNTY
CONTRACTOR: SEVENSON ENVIRON. SERV.

MAJOR CONTRACT OPERATIONS

I.R. No.	Inspector's Name	Work Assignment and Identification
	H. ZEH	F.I.C.
12	OLIV ANTONIN	FIELD INSPECTION

Maint. of Traffic & Project Signs: ORANGE FRINGE PLACED AROUND SCOBELL PROPERTY AT END OF DAY TO KEEP PUB. OUT. ALL WORKERS USING LEVEL RC SAFETY PROTECTION.

REMARKS: SEVENSON - CONTRACTOR

(1) CONTINUED EXCAVATING AND LOADING OUT HAZARDOUS DIRT FROM SCOBELL PROPERTY THIS DAY. MATERIAL IS BEING HAULED TO SCM IN NIAGARA FALLS. TRUCKS ARE STILL EXPERIENCING LONG DELAYS AT DUMP SITE. MATERIAL EXCAVATED THIS DAY AFTER 10:00 AM DID NOT SMELL AS BAD OR CONTAIN GLASS LIKE THE PREVIOUS EXCAVATED MATERIAL HAS. LOADED OUT 25 TRUCKS THIS DAY.

(2) PROBED IN AREAS OF STANDPIPES IN WAREHOUSE TO SEE IF AREA CONTAINS UNDERGROUND TANKS. PIPES LEAD WEST WITH ONE HEADING TOWARDS EASTERN. LARGE TANK MARKED ACID. NO TANKS WERE FOUND.

(3) COUNTO RUBBLE AND DEBRIS PILE FROM BUILDING AREA 1, 2, 3, 4, 7 AS PER D.E.C. REQUEST

Date: Sept. 30, 1900

Day of Week: S M T W T F S

I.R. No.: 13

Sheet No. 1 of 24 Sheets

JOB STAMP
 CONTRACT D500730
 F.A. PROJ. NO. 4088.08.311
 P.I.N. 4088.08.311
 HAZARDOUS WASTE CLEANUP
 & BLDG. DEMO. - I490/I590 INTERCHANGE
 MONROE COUNTY
 CONTRACTOR: SEVENSON ENVIRON. SERV.

If pertinent to the Construction Operation		
	AM	PM
Weather	SUNNY	SUNNY
Temperature	50°F	80°F

DESCRIPTION OF WORK PERFORMED AND INSPECTED
 Specify for Each Operation: Item No., Sub-Contractor (if any), Location and Nature of Work

PRIME: SEVENSON ENVIRONMENTAL SERVICES.

LOCATION: Refer to fig 8.

Locate samples for Rock twenty-five feet apart and four (4) ft from toe of slope i.e. 88-127, 88-126, 88-125 and 88-124. Using air hammer, sample taken at top of rock. Decontaminate of the hammer bit using distilled water. Then excavated down into the rock 6" deep. Took sample and stored in bottles. Sample #4 at 6" depth had evidence of water.

ITEM NO.	FS	ES	INTERIM QUANT.	FINAL QUANT.	QUANT. CHK.	DESCRIPTION OF WORK	COMPUTER	
							ENT.	CHK.
						Knock down Area #9		
						continual excavation waste material (contaminated).		
						steak out		
						collect rock samples.		


The above described work was incorporated into this project and was inspected by:

Olu Anjovis
 Inspector's Signature

Reviewed by: David Zel
 Engineer-in-Charge
 Resident Engineer

10/3/88
 Date

Reverse side used for additional remarks and sketches.

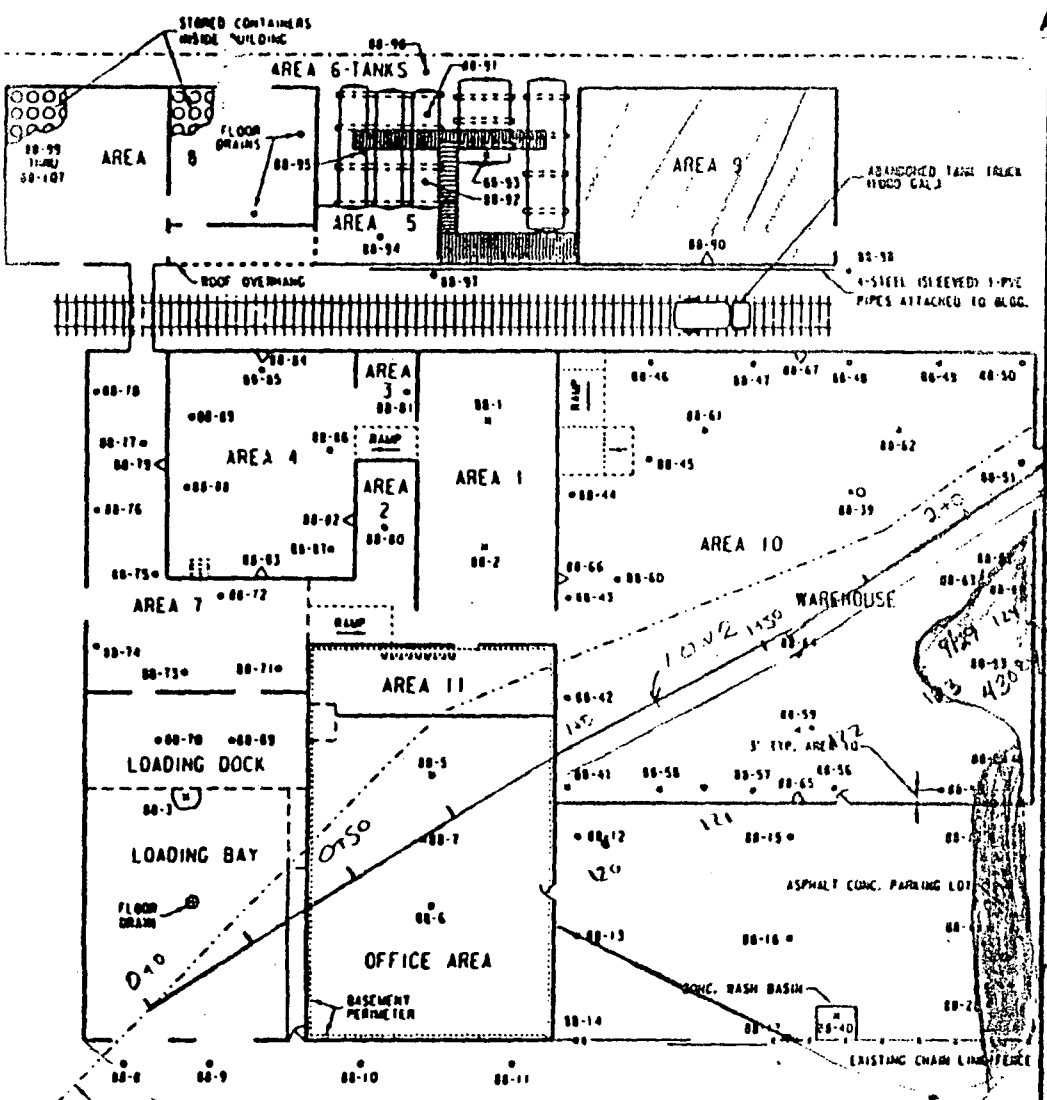

PLAN VIEW OF FORMER SCOBELL CHEMICAL CO.
(1 ROCKWOOD PLACE)

Fence

*TOP OF SLOPE
1 ON 1 1/2*

*Removal
9/11/88
340.72*

*Removal
9/11/88
283.3*

*Removal
9/11/88
430.9*

LIMIT OF EXCAVATION

COMRAIL R.O.W.

KEY

- Area Contaminate waste removed.
- Demolished.

IR#
9/30/88

CONTRACT D500730
F.A. PROJ. NO. 4088.08.311
P.I.N. 4088.08.311
HAZARDOUS WASTE CLEANUP
& BLDG. DEMO. - 1490/1590 INTERCHANGE
MONROE COUNTY
CONTRACTOR: SEVENSON ENVIRON. SERV.

LIMIT OF EXCAVATION
REQUIRED FOR CONSTRUCTION
WORK UNDER CONTRACT
D500730

NOTE: THE PROJECT LIMITS FOR
THIS PROJECT ARE WITHIN
THE PROPERTY LINES OF THE
FORMER SCOBELL CHEMICAL CO.

- SOIL SAM
- 1 FT. EARTH
- SOIL SAM OF EXCAVATION SPREAD SOIL SAM
- CHIP SEAL CONCRETE
- 1 ROUND S
- ▲ BALL SAM
- O STAND P UNDERGROUND

fig 8

*Sheet 39
IR# 1*

JOB STAMP

Sheet No. 1 of 2 Sheets

Date SEPT 30, 1988

Day of Week

S	M	T	W	T	F	S
---	---	---	---	---	----------	---

Weather

	AM	PM
Weather	Sunny Mild	Sunny Warm

Temperature

	High	Low
Temperature	75	55

CONTRACT D500730
F.A. PROJ. NO. 4088.08.311
P.I.N. 4088.08.311
HAZARDOUS WASTE CLEANUP
& BLDG. DEMO. - 1490/1590 INTERCHANGE
MCNROE COUNTY
CONTRACTOR: SEVENSON ENVIRON. SERV.

MAJOR CONTRACT OPERATIONS

I.R. No.	Inspector's Name	Work Assignment and Identification
	H. ZEH	E.I.C.
13	OLU ANTONIU	FIELD INSPECTION

Maint. of Traffic & Project Signs: ORANGE PROTECTIVE FENCE PUT UP AT END OF DAY AROUND FRONT OF SCORRE PROPERTY. ALL WORKERS IN EXCAVATION AREA WORE LEVEL C PROTECTION.

REMARKS: SEVENSON - CONTRACTOR

(1) CONTINUED EXCAVATING AND HAULING DIRT FROM SCORRE PROPERTY TO S.C.A. IN NIAGARA FALLS FOR DISPOSAL. ONLY 10 TRUCKS WERE HAULING OUT THIS DAY BECAUSE S.C.A. WOULD NOT ALLOW TRUCKS TO DUMP ON SATURDAY. IN AREA OF EXCAVATION THIS DAY THERE WAS MOISTURE COMING OUT OF SLOPE AT TOP OF ROCK. ODOOR WAS NOT AS STRONG IN EXCAVATION AREA THIS DAY. H-H METAL LEVELS OF 1.0 TO 4.0 WERE RECORDED THIS DAY.

(2) DEMOLISHED AND CRUSHED AREA 9 BUILDING AND COVERED WITH POLY.

[REDACTED]

(3) CUT UP REMAINING BODY FOR TAKE TRUCK AND CRUSHED.

Date: OCT. 3, 1988

Day of Week: S M T W T F S

I.R. No.: 14

Sheet No. 1 of 4 Sh

JOB STAMP

CONTRACT D500730
 F.A. PROJ. NO. 4088.08.311
 P.I.N. 4088.08.311
 HAZARDOUS WASTE CLEANUP
 & BLDG. DEMO. - I490/I590 INTERCHANGE
 MONROE COUNTY
 CONTRACTOR: SEVENSON ENVIRON. SERV.

If pertinent to the Construction Operation		
	AM	PM
Weather	Cloudy & cool	showers Partly
Temperature	50°F	65°F

DESCRIPTION OF WORK PERFORMED AND INSPECTED

Specify for Each Operation: Item No., Sub-Contractor (if any), Location and Nature of Work

PRIME: SEVENSON ENVIRONMENTAL SERVICES

Contractor continue excavation waste contaminated ~~area~~ material and transporting it away from the site. An estimate area removed refer to fig 9. attached sheet.

Contractor stock piled material and smoothen the N.E slope using the D05E.

Contractor used level C - protection.

Laborers were sent ^{home} at 3:30 p.m. by foreman.

Operation continue until 7:30 p.m., fence erected and material piled was covered with poly.

Total no. of Tracts loaded see attached sheet. (21 loads)

E.I.C. Took some pictures.

ITEM NO.	FS	ES	INTERIM QUANT.	FINAL QUANT.	QUANT. CHK.	DESCRIPTION OF WORK	C	E
						Excavation Continue		
						Transportation Continue		
						Covered pile w/poly.		

The above described work was incorporated into this project and was inspected by:

Oliver Anjorin
Inspector's Signature

Reviewed by: Sheldah 10/6
Date

Engineer-in-Charge
 Resident Engineer

Reverse side used for additional remarks and sketches.

JOB STAMP

Sheet No. 1 of 2 Sheets

Date OCT 3, 1988

Day of Week

S	M	T	W	T	F	S
---	----------	---	---	---	---	---

AM	PM
----	----

Weather	RAINY COOL	RAINY COOL
---------	---------------	---------------

Temperature	High 58	Low 50
-------------	-------------------	------------------

CONTRACT D500730
 F.A. PROJ. NO. 4088.08.311
 P.I.N. 4088.08.311
 HAZARDOUS WASTE CLEANUP
 & BLDG. DEMO. - I490/I590 INTERCHANGE.
 MONROE COUNTY
 CONTRACTOR: SEVENSON ENVIRON. SERV.

MAJOR CONTRACT OPERATIONS

I.R. No.	Inspector's Name	Work Assignment and Identification
	H. ZEH	E.I.C
14	D. ANTOIN	FIELD INSPECTION

Maint. of Traffic & Project Signs: ORANGE SAFETY FENCE PLACED AROUND SITE
 AT END OF DAY. WORKERS WORE LEVEL C PROTECTION
 IN EXCAVATION AREA.

REMARKS: SEVENSON

(1) CONTINUED EXCAVATING AND LOADING OUT HAZARDOUS DIRT FOR DISPOSAL AT S.C.A. IN NIAGARA FALLS. 2 TRUCKS WERE LOADED OUT THIS DAY. MATERIAL LOADED OUT WAS MOSTLY MATERIAL PUSHED AHEAD FROM SLOPE AND N.E. CORNER WHERE Nony's POWER POLE WAS LOCATED. MATERIAL LOADED OUT THIS DAY HAD ONLY MINOR AMOUNTS OF ODOM. NO DRAINAGE FROM SLOPE WAS OBSERVED.

(2) CONTINUED DRESSING UP ^{SLOPE} AND PUSHING EXCESS MATERIAL AHEAD FOR BACKHOE TO LOAD ON TRUCKS. SLOPE OF #1 ON 2 IS BEING COMPACTED WITH BACKHOE BUCKET FOR STABILIZATION.

(3) PLACED POLY MATERIAL OVER EXCAVATED MATERIAL TO KEEP MOISTURE OFF SOIL.

Date: Oct. 7, 1988

Day of Week: S M X W T F S

I.R. No.: 15

Sheet No. 1 of 4 Sheet.

JOB STAMP

CONTRACT #500730
 PLAN PROJ. NO. 4068.06.311
 PLAN NO. 4068.06.311
 HAZARDOUS WASTE CLEANUP

If pertinent to the Construction Operation		
	AM	PM
Weather	Sunny	Cool
Temperature	50°F	60°F

DESCRIPTION OF WORK PERFORMED AND INSPECTED

Specify for Each Operation: Item No., Sub-Contractor (if any), Location and Nature of Work

PRIME: SEVENSONS ENVIRONMENTAL SERVICES.

Contractor continue excavation and loaded out 22 trucks with contaminated soil. refer to fig 10. The laborers did cut off the railroad tracks in front of area #5, 8 and 9. They cut up the pipes and clean up misc. debris. The E.I.C and D.E.C Rep. Mr. Long stake out the sta. 1+00 to 3+50. The slope in the NE corner was smoothly done with the Dozer and laborer covered the slope with pile material from sta. 3+50 to 2+25. The E.I.C requested the Dozer operator to clean feet along the eastern boundary to form a retention berm. To prevent migration of surface water. The operation was carried out P.T.O.

ITEM NO.	FS	ES	INTERIM QUANT.	FINAL QUANT.	QUANT. CHK.	DESCRIPTION OF WORK	COMPUTER	
							ENT.	CHK.
						Continue excavation		
						Cut off RR track		
						Monitor air		
						Covered slope & debris w/ply		
						Erected fence.		
						level C protection.		

The above described work was incorporated into this project and was inspected by:

Alan Anjorin
Inspector's Signature

Reviewed by: David Beh
 Engineer-in-Charge
 Resident Engineer

10/5/88
Date

Reverse side used for additional remarks and sketches.

JOB STAMP

Sheet No. _____ of _____ Sheets

Date OCT. 4, 1988

Day of Week

S	M	T	W	T	F	S
---	---	----------	---	---	---	---

	AM	PM
Weather	COOL PARTLY SUNNY	COOL PARTLY SUNNY
	High	Low
Temperature	60	45

CONTRACT D500730
 F.A. PROJ. NO. 4088.08.311
 P.I.N. 4088.08.311
 HAZARDOUS WASTE CLEANUP
 6 BLDG. DEMO. - 1490/1590 INTERCHANGE
 MONROE COUNTY
 CONTRACTOR: SEVENSON ENVIRON. SERV.

MAJOR CONTRACT OPERATIONS

I.R. No.	Inspector's Name	Work Assignment and Identification
	H. ZEH	E.I.C.
15	D. ANTONIO	INSPECTION - FIELD OPERATIONS

Maint. of Traffic & Project Signs: ALL WORKERS WERE OBSERVED WEARING

LEVEL B/C PROTECTION CLOTHING. ORANGE SAFETY FENCE WAS PLACED AROUND THE SITE TO PROTECT AREA FROM PEDESTRIANS
 REMARKS: SEVENSON

(1) CONTINUED LOADING OUT EXCAVATED HAZARDOUS SOIL FROM SCOBELL SITE THIS DAY FOR DISPOSAL AT S.C.A LANDFILL IN NIAGARA FALLS. PROCEDURES FOLLOWED ARE THOSE INDICATED BY D.E.G. FOR DECONTAMINATION OF HAUL VEHICLES BEFORE LEAVING SITE. MATERIAL EXCAVATED THIS DAY DOES NOT CONTAIN BOTTLES OR CONTAINERS AS OBSERVED DURING LOADING. A STRONG OOR IS EMITED FROM AREA. WIND DIRECTION IS GENERALLY BLOWING FROM NORTH TO SOUTH. MONITORING OF AIR WITH H-NO METER INDICATED LEVELS OF 1.0 TO 4.0. DUST METER LEVELS OF 10 WERE INDICATED. 22 TRUCKS LOADED OUT THIS DAY.

(2) LABORERS WERE CUTTING UP R.R. TRACK AND PIPES FROM R.R. AREA THIS DAY AND PLACING IN HAZARDOUS DEBRIS PILE.

INSPECTOR'S DAILY REPORT

Date: Oct 6 1988

Day of Week: S M T W T F S

I.R. No.: 16

Sheet No. 1 of 5 She

JOB STAMP
 CONTRACT D500730
 F.A. PROJ. NO. 4088.08.311
 P.I.N. 4088.08.311
 HAZARDOUS WASTE CLEANUP
 & BLDG. DEMO. - I490/I590 INTERCHANGE
 MONROE COUNTY
 CONTRACTOR: SEVENSON ENVIRON. SERV.

If pertinent to the Construction Operation		
	AM	PM
Weather	<u>Fair</u>	<u>Rain</u>
Temperature		

DESCRIPTION OF WORK PERFORMED AND INSPECTED

Specify for Each Operation: Item No., Sub-Contractor (if any), Location and Nature of Work

PRIME: SEVENSON ENVIRONMENTAL SERVICES
Contractor continue excavation and loaded out 26 truck with contaminated soil. Refer to fig 11.

At 10:45 A.M., Dr. Paul Hitchcock, Severson's Industrial Hygienist at Nory's operation site, spoke to Nory's workers. Assuring ^{them} that regards what they were doing. He did explain the chemical volatilities and level of H Numeter readings. He reassured them that they had nothing to fear about what we were doing. At the site was the EIC (Hizer), J. B. Bunnissel, consultant, Rich Stein (Foreman), and VP of Nory's and Art Andrews.

Contractor continue the monitoring of the air with H Numeter and dust indicator result with Foreman.

ITEM NO.	FS	ES	INTERIM QUANT.	FINAL QUANT.	QUANT. CHK.	DESCRIPTION OF WORK	COMPUTER	
							ENT.	CHK.
						<u>Nory's meeting</u>		
						<u>Excavation</u>		
						<u>Pictures</u>		

The above described work was incorporated into this project and was inspected by:

Clu Anderson
 Inspector's Signature

Reviewed by: David Beh 10/6/88
 Date
 Engineer-in-Charge
 Resident Engineer

Reverse side used for additional remarks and sketches.

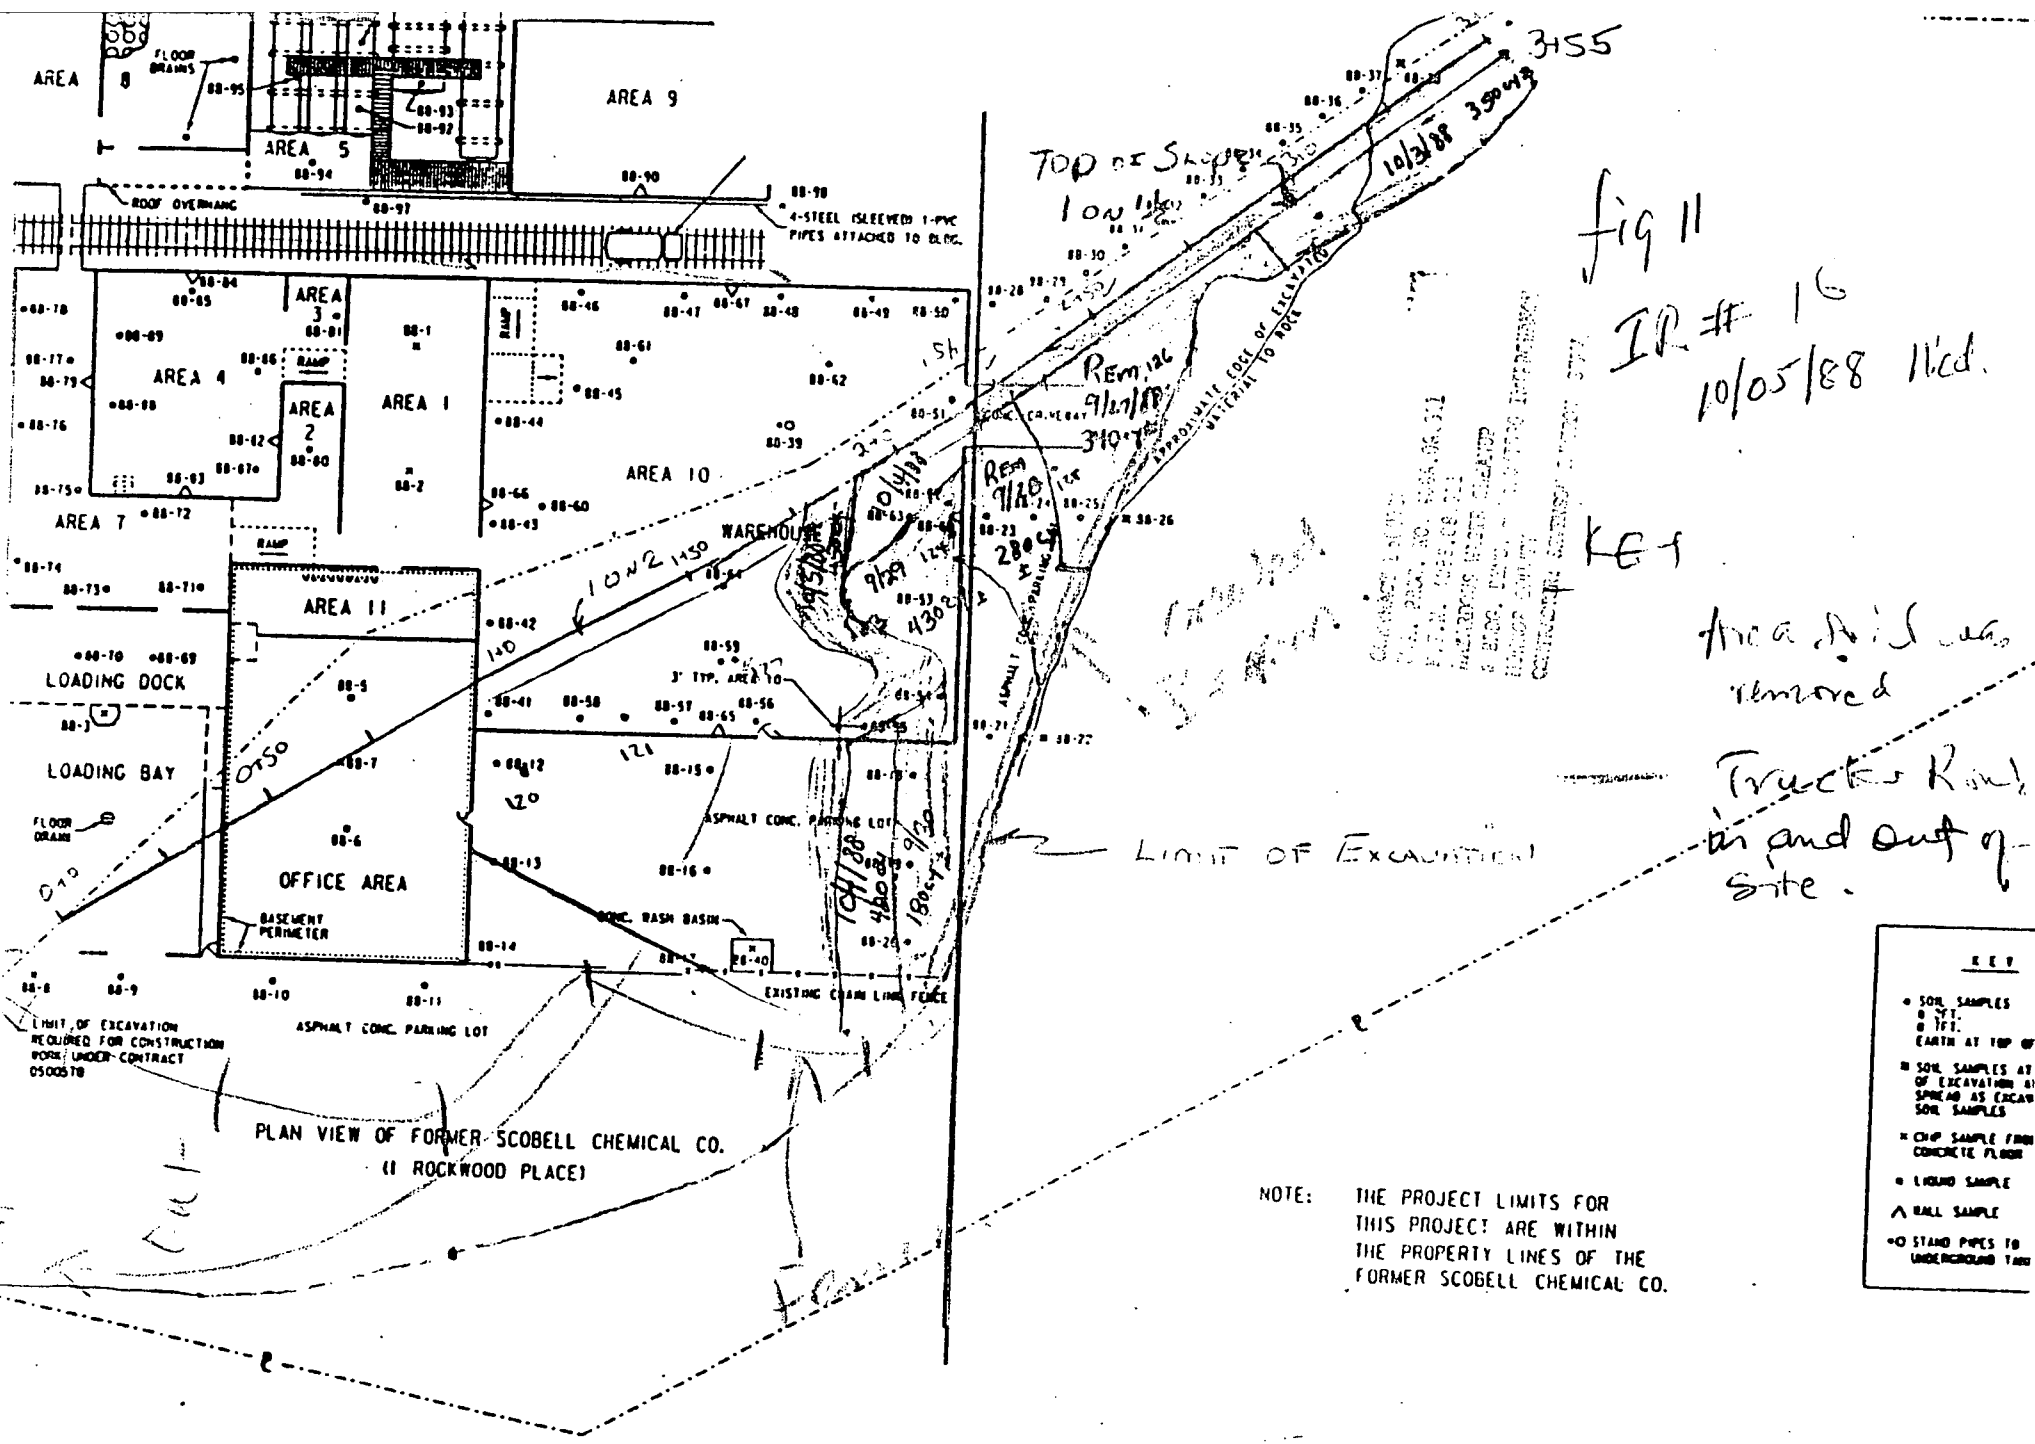


fig 11
 IR # 16
 10/05/88 11cd.

KEY

Area 11 was removed

Truck Road in and out of site.

KEY	
●	SOIL SAMPLES
○	TOP OF EARTH AT TOP OF EXCAVATION
■	SOIL SAMPLES AT SPREAD AS EXCAVATION SOIL SAMPLES
✱	CHIP SAMPLE FROM CONCRETE FLOOR
○	LIQUID SAMPLE
△	SAND SAMPLE
○	STAND PIPES FROM UNDERGROUND TANK

NOTE: THE PROJECT LIMITS FOR THIS PROJECT ARE WITHIN THE PROPERTY LINES OF THE FORMER SCOBELL CHEMICAL CO.

ENGINEER'S DAILY PROJECT DIARY

Page No. 000005

JOB STAMP

Sheet No. 1 of 2 Sheets

Date Oct 5, 1980

Day of Week

S	M	T	(W)	T	F	S
---	---	---	-----	---	---	---

Weather

AM	PM
<u>Partly Sunny</u>	<u>Cloudy</u>

Temperature

High	Low
<u>55</u>	<u>45</u>

CONTRACT D500730
F.A. PROJ. NO. 4088.08.311
P.I.N. 4088.08.311
HAZARDOUS WASTE CLEANUP
& BLDG. DEMO. - I490/I590 INTERCHANGE
MONROE COUNTY
CONTRACTOR: SEVENSON ENVIRON. SERV.

MAJOR CONTRACT OPERATIONS

I.R. No.	Inspector's Name	Work Assignment and Identification
	<u>H. ZRA</u>	<u>E.I.C</u>
<u>16</u>	<u>OLU ANJONW</u>	<u>FIELD INSPECTION</u>

Maint. of Traffic & Project Signs: All project personnel observed wearing Level C protection whenever in work area. Orange fence placed around site to protect area from pedestrians.

REMARKS: SEVENSON - CONTRACTOR

(1) CONTINUED EXCAVATING OUT MATERIAL FOR DISPOSAL AT SCA IN NIAGARA FALLS. 26 TRUCKS WERE LOADED OUT THIS DAY AND DISPOSED OF AS HAZARDOUS. SAME PROCEDURES AS ALWAYS. BEWB WRO FOR DECOM OF TRUCKS. MATERIAL EXCAVATED THIS DAY WAS MEDIUM ODOR AND DID CONTAIN SOME GLASS AND BROKEN CONTAINERS. NO MOISTURE WAS BEING EMITTED FROM SLOPE.

H-NV METR READINGS AND DUST METR READINGS ARE IN CONTRACTORS LOG OF READINGS (COPY ON FILE)

(2) COVERED ADDITIONAL AREAS THROUGHOUT SITE WITH POLY

[REDACTED]

VISITORS

(1) PAUL HITCHO SEVENSON'S CERTIFIED INDUSTRIAL HYGIENIST WAS ON SITE THIS DAY

[REDACTED]

Date: Oct 10, 1988

Day of Week: S M T W X F S

I.R. No.: 17

Sheet No. 1 of 4 Sheets

<p>JOB STAMP</p> <p>CONTRACT D500730 F.A. PROJ. NO. 4088.08.311 P.I.N. 4088.08.311 HAZARDOUS WASTE CLEANUP & BLDG. DEMO. - 1490/1590 INTERCHANGE MOHROE COUNTY CONTRACTOR: SEVENSON ENVIRON. SERV.</p>

If pertinent to the Construction Operation		
	AM	PM
Weather	<u>FAIR</u>	<u>Rain</u>
Temperature		

DESCRIPTION OF WORK PERFORMED AND INSPECTED

Specify for Each Operation: Item No., Sub-Contractor (if any), Location and Nature of Work

PRIME SEVENSONS ENVIR. SERVICES.

Contractor continue uncovering contaminated soils for loading see fig 11, they loaded out 33 trucks see attached sheet.

They did cover the N.E area with poly. Contractor received 7 loads of fill material for the basement and used dozer to spread it.

Covered all excavated soils with poly see pictures.

The E.I.C and Michelle took sample test - about 4:45 pm near North area.

ITEM NO.	FS	ES	INTERIM QUANT.	FINAL QUANT.	QUANT. CHK.	DESCRIPTION OF WORK
						<u>TEST done sample.</u>
						<u>received loads of fill</u>
						<u>Excavation</u>
						<u>covered area w/poly</u>
						<u>picture.</u>

The above described work was incorporated into this project and was inspected by:



Oliver Arjovis
 Inspector's Signature

Reviewed by: David Boh


10/7/88
 Date

- Engineer-in-Charge
- Resident Engineer

Reverse side used for additional remarks and sketches.

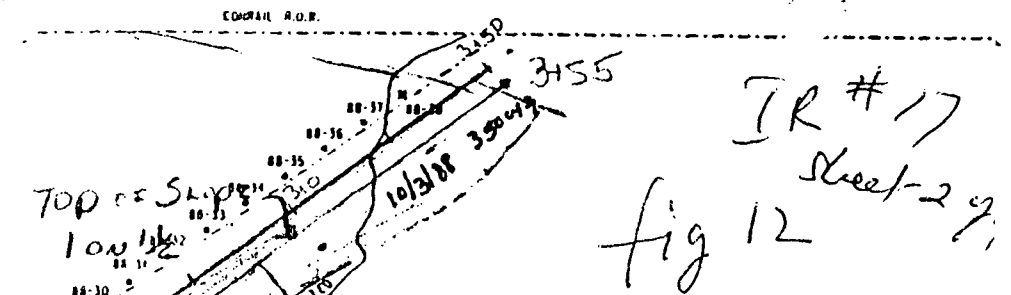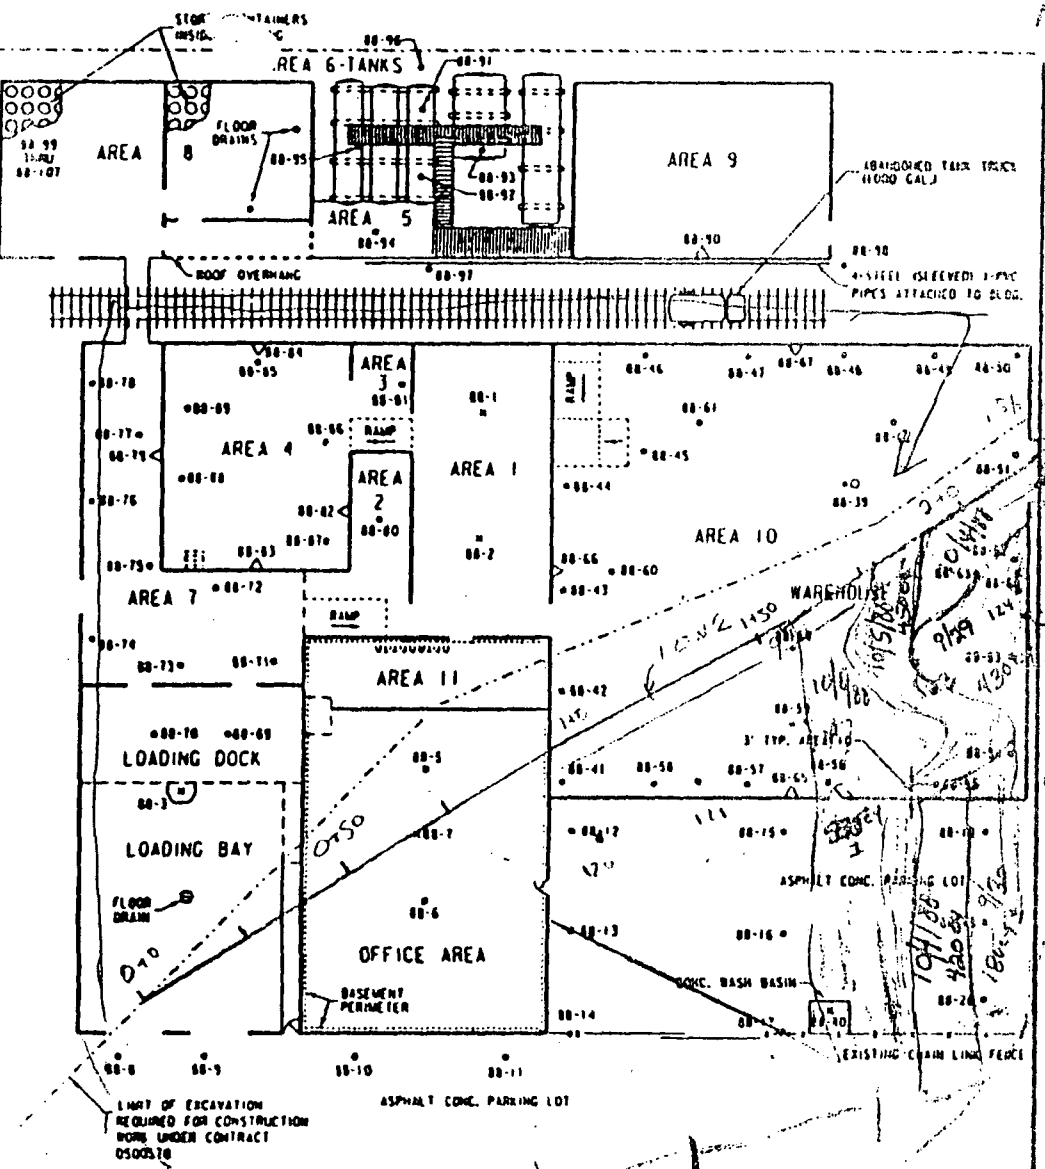

CONTRACT D500730
F.A. PROJ. NO. 4088.08.311
P.I.N. 4088.08.311
HAZARDOUS WASTE CLEANUP
& BLDG. DEMO. - I490/I590 INTERCHANGE
MONROE COUNTY
CONTRACTOR: SEVENSON ENVIRON. SERV.

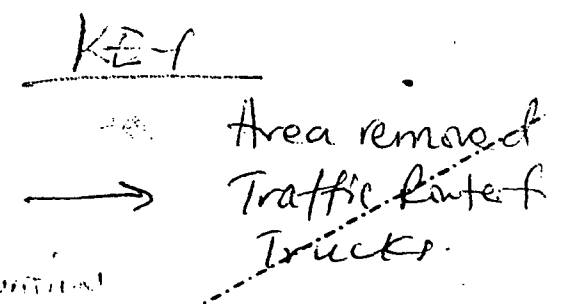

LIMIT OF EXCAVATION

NOTE: THE PROJECT LIMITS FOR THIS PROJECT ARE WITHIN THE PROPERTY LINES OF THE FORMER SCOBELL CHEMICAL CO.

- SOIL 5'
- 1 FT.
- EARTH
- SOIL 5' OF EXCAVATION SPREAD SOIL 5'
- CHIP 5' CONCRETE
- LUMBER
- ▲ WALL 5'
- O STAND 1' UNDER

ENGINEER'S DAILY PROJECT DIARY

Page No. 403087
 Sheet No. _____ of _____ Sheets

Date OCT. 6, 1988

Day of Week

S	M	T	W	<u>T</u>	F	S
---	---	---	---	----------	---	---

	AM	PM
Weather	Cloudy RAIN	Cloudy PARTLY SUN.

	High	Low
Temperature	62	48

JOB STAMP
 CONT. NO. 506730
 F.A. NO. 4088.08.311
 P.I.F. 59.08.311
 HAZARDOUS WASTE CLEANUP
 & BLDG. DEMO. - I490/I590 INTERCHANGE
 MONROE COUNTY
 CONTRACTOR: SEVENSON ENVIRON. SERV.

MAJOR CONTRACT OPERATIONS

I.R. No.	Inspector's Name	Work Assignment and Identification
17	H. ZEH OLY ANSON	E.I.C. FIELD INSPECTION

Maint. of Traffic & Project Signs: ALL PROJECT PERSONEL WEARING LEVEL C SAFETY PROTECTION. ORANGE SAFETY FENCE ERRECTED AT END OF DAY.

- REMARKS: SEVENSON - CONTRACTOR
- CONTINUED EXCAVATING AND LOADING OUT CONTAMINATED SOIL FROM SCORRH SITE FOR DISPOSAL AT S.C.A. TRUCKS WERE LOADED OUT THIS DAY. SAME DECOM. PROCEDURES AS ALWAYS WERE USED. MATERIAL EXCAVATED THIS DAY HAD VERY LITTLE ODOR AND MUCH OF IT WAS CLEAN GRAVEL MATERIAL. VERY LITTLE DEBRIS WAS OBSERVED. WIND WAS VERY CALM THIS DAY. CONTINUAL H-NO AND DUST METER RECORDING WERE TAKEN AROUND SITE.
 - COVERED MORE OF SCORRH SITE WITH POLY TO PROTECT AREA FROM ELEMENTS
 - C.P. WARD TRUCKS DUMPED GRAVEL FILL IN BASEMENT AREA.
 - SURVEYORS STAKED OUT DETOUR 2 HCL LINE & GRADES
 - TALKED WITH DICK ROLLINS OF D.E.C.

Date: OCT 10 1988

Day of Week: S M T W T F S

I.R. No.: 18

Sheet No. 1 of 3 Sheet

JOB STAMP

CONTRACT D500730
 F.A. PROJ. NO. 4088.08.311
 F.I.N. 4088.08.311
 HAZARDOUS WASTE CLEANUP
 & BLDG. DEMO. - 1490/1590 INTERCHANGE
 MONROE COUNTY
 CONTRACTOR: SEVENSON ENVIRON. SERV.

If pertinent to the Construction Operation		
	AM	PM
Weather	<u>Partly Cloudy</u>	<u>Little Shower</u>
Temperature		

DESCRIPTION OF WORK PERFORMED AND INSPECTED
 Specify for Each Operation: Item No., Sub-Contractor (if any),
 Location and Nature of Work

PRIME: SEVENSON ENVIRONMENTAL SERVICES:

Contractor continued to uncover the contaminated soil and loaded it out with 14 trucks see attached sheet for trucks and sheet for area excavated.

Contractor received 8 loads of fill for the basement with Valley Sand and gravel Inc. Trucks. The fill was spread using the dozer.

The D.E.C. Rep. Mr. Bob Long was here and talk with the E.I.C. and Mr. Long left the site at

ITEM NO.	FS	ES	INTERIM QUANT.	FINAL QUANT.	QUANT. CHK.	DESCRIPTION OF WORK	COMPUTER EN

The above described work was incorporated into this project and was inspected by:

Oluy Anjorin
 Inspector's Signature

Reviewed by: Daniel Zel
 Engineer-in-Charge
 Resident Engineer

10/10/88
 Date

Reverse side used for additional remarks and sketches.

JOB STAMP

CONTRACT D500730
 F.A. PROJ. NO. 4088.08.311
 P.I.N. 4088.08.311
 HAZARDOUS WASTE CLEANUP
 & BLDG. DEMO. - I490/I590 INTERCHANGE
 MONROE COUNTY
 CONTRACTOR: SEVENSON ENVIRON. SF

Sheet No. _____ of _____ Sheets

Date OCT. 7, 1988

Day of Week S M T W T (F) S

	AM	PM
Weather	CLOUDY	CLOUDY

MAJOR CONTRACT OPERATIONS

I.R. No.	Inspector's Name	
	H. ZEH	F.I.C.
18	OLU ANTONU	FIELD INSPECTION

Low
36

Maint. of Traffic & Project Signs: All Areas Around Work Area Were Fenced With Orange Fence At End Of Day For Weekend.

All Project Workers Wearing Level C Protection.

REMARKS: SEVENSON - CONTRACTOR

(1) LOADED OUT 14 TRUCKS WITH HAZARDOUS DIRT FOR DISPOSAL AT SCA IN NIAGARA FALLS. MATERIAL EXCAVATED WITH MILD ODOR. WIND WAS CALM THIS DAY.

(2) COVERED UP REMAINING EXPOSED SITE WITH POLY AND ALL OPEN EXCAVATION AREAS

VISITORS - RICK STEIN

(1) J. BREANISSELL, K. McCLEATHAN, Nony, Ali Dali, Art Andrews, T. Zaugh

INSPECTOR'S DAILY REPORT

Date: Oct 10, 1988

Day of Week: S M T W T F S

I.R. No.: 19

Sheet No. 1 of 4 Sheet

JOB STAMP

CONTRACT D500730
 P.A. PROJ. NO. 4088.08.311
 P.I.N. 4088.08.311
 HAZARDOUS WASTE CLEANUP
 & BLDG. DEMO. - I490/I590 INTERCHANGE
 MONROE COUNTY
 CONTRACTOR: SEVENSON ENVIRON. SERV.

If pertinent to the Construction Operation		
	AM	PM
Weather	Rain	Rain
Temperature	See Engineer's Diary	

DESCRIPTION OF WORK PERFORMED AND INSPECTED

Specify for Each Operation: Item No., Sub-Contractor (if any), Location and Nature of Work

PRIME: Severson Environmental Services

Contractor continue excavation and loading contaminated soil. Loaded 37 trucks away from site.

Contractor took tank sampling, see fig 13.

Liquid Sample → 2

Solid Sample → 2 } Area 6 see fig. 13

At 11:30 AM RUPP brought in a 3022 37E.

Which was used to cut access road and spreading material brought for the basement

Received 4 loads of fill for the basement

Contractor did lay down new poly at the decontaminated area for the loading trucks.

ITEM NO.	FS	ES	INTERIM QUANT.	FINAL QUANT.	QUANT. CHK.	DESCRIPTION OF WORK	COMPUTER	
							ENT.	CHK.
						Sample taken from tanks Area 6		
						Removed Cont. Soil		
						Erect fence		

The above described work was incorporated into this project and was inspected by:

Clu Anjorin
 Inspector's Signature

Reviewed by:

David Zel

- Engineer-in-Charge
- Resident Engineer

10/12/88
 Date

Reverse side used for additional remarks and sketches.

JOB STAMP

Sheet No. _____ of _____ Sheets

Date OCT 10, 1988

Day of Week S (M) T W T F S

	AM	PM
Weather	Cloudy Int. Rain	Cloudy Int. Rain

	High	Low
Temperature		

CONTRACT D500730
 P.A. PROJ. NO. 4088.08.311
 P.I.N. 4088.08.311
 HAZARDOUS WASTE CLEANUP
 & BLDG. DEMO. - I490/I590 INTERCHANGE
 MONROE COUNTY
 CONTRACTOR: SEVENSON ENVIRON. SERV.

MAJOR CONTRACT OPERATIONS

I.R. No.	Inspector's Name	Work Assignment and Identification
	H. ZEH	E.I.C.
19	O. ANTONIN	FIELD INSPECTION

Maint. of Traffic & Project Signs: ORANGE SAFETY FENCE PLACED AROUND PROJECT SITE. ALL WORKERS WEARING LEVEL C PROTECTION.

REMARKS: SEVENSON - CONTINUED
 (1) CONTINUED EXCAVATING AND LOADING OUT HAZARDOUS SOIL FOR DISPOSAL AT S.C.A. IN NIAGARA FALLS. 37 TRUCKS WERE LOADED OUT THIS DAY. [REDACTED] WITH NO ODOR. (GRAVEL MATERIAL) H-NUM & DUST METER WERE USED TO MONITOR AIR QUALITY AROUND PROJECT SITE.
 (2) EXCAVATED MATERIALS WERE COVERED WITH BARRIERS TO PROTECT FROM ELEMENTS.
 (3) BEGAN SAMPLING OF MATERIAL IN TANKS FOR TESTING.
 (4) BEGAN GRADING OF FILL MATERIAL IN BASEMENT.

Visitors -
 (1) BOB LONG OF D.E.C. HERE IN A.M. [REDACTED]
 (2) J. BRENESSELL WAS HERE T. [REDACTED]

Date: Oct 11 1988

Day of Week: S M W T F S

I.R. No.: 20

Sheet No. 1 of 2 Sheet

JOB STAMP

CONTRACT D500730
 F.A. PROJ. NO. 4086.C6.311
 P.I.N. 4086.C6.311
 HAZARDOUS WASTE CLEANUP
 & BLDG. DEMO. - I490/I590 INTERCHANGE
 MONROE COUNTY
 CONTRACTOR: SEVENSON ENVIRON. SERV.

If pertinent to the Construction Operation		
	AM	PM
Weather	Cloudy	Cloudy
Temperature	See Engineer's diary	

DESCRIPTION OF WORK PERFORMED AND INSPECTED
 Specify for Each Operation: Item No., Sub-Contractor (if any), Location and Nature of Work

PRIME: Severson Environmental Services. diary.

Contractor continue excavation of hazardous waste material. Loaded 24 Trucks out site to be deposited at Niagara (S.C.A)

Contractor continue to use the H Nometer and dust indicator at the working area

Contractor started receiving the delivery of clay material from Cole Sand & Grate. Received 14 loads of clay.

Spreading of the clay was done using the dozer along the slope and top of slope

ITEM NO.	FS	ES	INTERIM QUANT.	FINAL QUANT.	QUANT. CHK.	DESCRIPTION OF WORK
						began delivery of clay
						delivery of fill
						continue excavation.
						use H Nometer & dust indicator.

The above described work was incorporated into this project and was inspected by:

Clay Arjorin
 Inspector's Signature

Reviewed by: David Zah

10/13/88
 Date

- Engineer-in-Charge
- Resident Engineer

Reverse side used for additional remarks and sketches.

JOB STAMP

Sheet No. 1 of 3 Sheets

Date OCT. 11, 1988

Day of Week

S	M	T	W	T	F	S
---	---	----------	---	---	---	---

Weather

	AM	PM
Weather	CLOUDY COOL	CLOUDY WINDY COOL

Temperature

	High	Low
Temperature	52	40

CONTRACT D500730
F.A. PROJ. NO. 4088.08.311
P.I.N. 4088.08.311
HAZARDOUS WASTE CLEANUP
& BLDG. DEMO. - I490/I590 INTERCHANGE
MONROE COUNTY
CONTRACTOR: SEVENSON ENVIRON. SERV.

MAJOR CONTRACT OPERATIONS

I.R. No.	Inspector's Name	Work Assignment and Identification
	H. ZEH	E.I.C.
20	D. ANTOIN	FIELD INSPECTION

Maint. of Traffic & Project Signs: ORANGE SAFETY FLUOR PLACED AROUND SITE AT END OF DAY. PROJECT WORKERS WEARING LEVEL C PROTECTION

REMARKS: SEVENSON CONTRACTOR

(1) CONTINUED EXCAVATION AND "LOADING" OUT OF "HAZARDOUS" MATERIAL FOR DISPOSAL AT S.C.A. IN NIAGARA FALLS. 24 TRUCKS WERE LOADED OUT THIS DAY. [REDACTED] WINDS WERE STRONG THIS DAY. A NO. METER AND DUST METRE USED AROUND WORK AREA THIS DAY.

(2) EXCAVATED MATERIAL COURSED WITH BULKERS THIS DAY.

(3) BEGAN DELIVERY AND SPREADING OF CLAY MATERIAL FROM SCOTTSVILLE COLE SAND & GRAVEL [REDACTED] MATERIAL BEING PLACED FROM 9" TO 12" THICK.

(4) CONTINUED FILLING OF "N. HALF" OF OFFICE BASEMENT WITH CLEAN FILL.

VISITORS
(1) W.B. LONG OF D.E.C. HERE [REDACTED]

JOB STAMP
 CONTRACT D500730
 F.A. PROJ. NO. 4088.08.311
 P.I.N. 4088.08.311
 HAZARDOUS WASTE CLEANUP
 & BLDG. DEMO. - I490/I590 INTERCHANGE
 MONROE COUNTY
 CONTRACTOR: SEVENSON ENVIRON. SERV.

If pertinent to the Construction Operation		
	AM	PM
Weather	Rainy	Rain
Temperature	See Engineers Diary.	

DESCRIPTION OF WORK PERFORMED AND INSPECTED
 Specify for Each Operation: Item No., Sub-Contractor (if any), Location and Nature of Work

1. Contractor continue excavation of contaminated soil and loaded them in trucks and transported away from site (S.C.A.) see figure 21A
2. Contractor continue fill of basement with clean fill. It was spread using Dozer 37E
3. Delivery of clay material continued. Spreading of the material was done using Dozer D6SE.
4. Contractor used H-nu meter and dust indicator around the work area. Result was low.



ITEM NO.	FS	ES	INTERIM QUANT.	FINAL QUANT.	QUANT. CHK.	DESCRIPTION OF WORK	COMPUTER	
							ENT.	CHK.
						Continue & finished excavation		
						Started removing debris		
						Continue fill of basement		
						Continue delivery of clay		
						H-nu meter & dust indicator used		
						Erect fence.		

The above described work was incorporated into this project and was inspected by:

Alan Anjovini
 Inspector's Signature


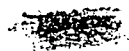
Reviewed by: David Beh
 Engineer-in-Charge
 Resident Engineer

Reverse side used for additional remarks and sketches.

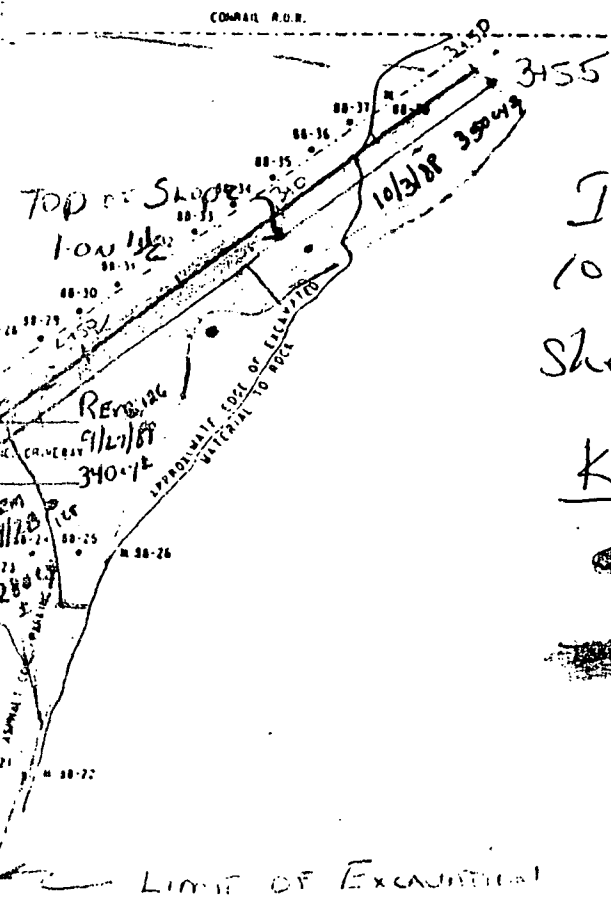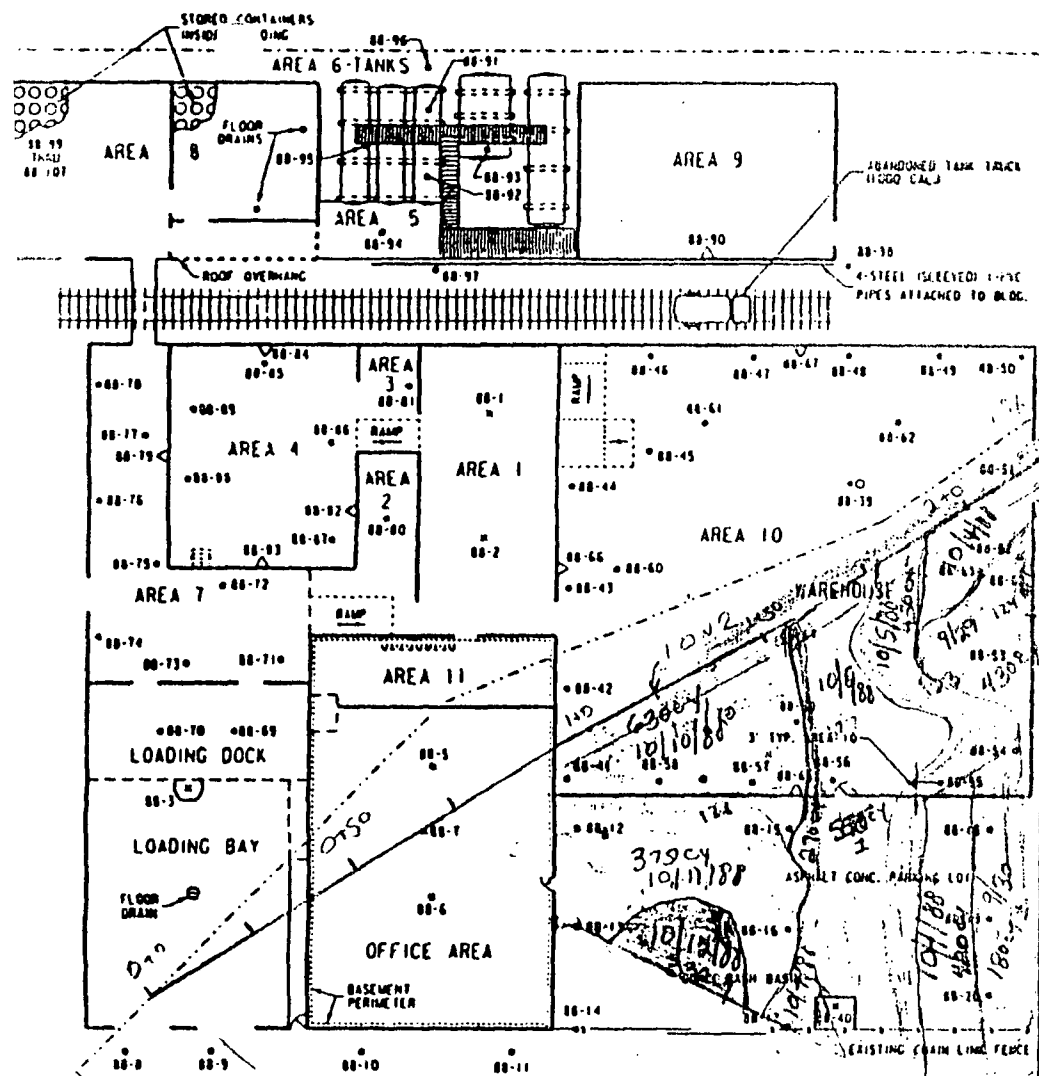

IR # 21
 10/12/88 Wed.
 Sheet 3 of 5

KEY

-  Final excav. Area.
-  Clay mate

LIMIT OF EXCAVATION
 REQUIRED FOR CONSTRUCTION
 WORK UNDER CONTRACT
 D500578

PLAN VIEW OF FORMER SCOBELL CHEMICAL CO.
 (11 ROCKWOOD PLACE)

NOTE: THE PROJECT LIMITS FOR
 THIS PROJECT ARE WITHIN
 THE PROPERTY LINES OF THE
 FORMER SCOBELL CHEMICAL CO.

CONTRACT D50078D
 F.A. PROJ. NO. 4088-08-311
 P.I.N. 4088-08-311
 HAZARDOUS WASTE CLEANUP
 & BLDG. DEMO. - 1490/1590 INTERCHANGE
 MONROE COUNTY
 CONTRACTOR: SEVENSON ENVIRON. SERV.

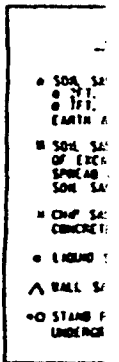


Fig 21A

JOB STAMP

CONTRACT D500730
 F.A. PROJ. NO. 4088.08.311
 P.I.N. 4088.08.311
 HAZARDOUS WASTE CLEANUP
 & BLDG. DEMO. - I490/I590 INTERCHANGE
 MONROE COUNTY
 CONTRACTOR: SEVENSON ENVIRON. SERV.

Sheet No. 1 of 3 Sheets

Date OCT. 12, 1988

Day of Week

S	M	T	W	T	F	S
---	---	---	----------	---	---	---

AM	PM
----	----

Weather

Cloudy COLD FRESH SNOW	Cloudy COLD RAIN
------------------------------	------------------------

High	Low
------	-----

Temperature

45°	34°
-----	-----

MAJOR CONTRACT OPERATIONS

I.R. No.	Inspector's Name	Work Assignment and Identification
	H. ZEH	E.I.C.
21	D. ANTONIN	FIELD INSPECTION

Maint. of Traffic & Project Signs: CHANGE FENCE PLACED AROUND SITE AT
END OF DAY. ALL PROJECT WORKERS WEARING LEVEL C
PROTECTION.

REMARKS: SEVENSON - CONTINUED

(1) CONTINUED AND COMPLETED EXCAVATION OF HAZARDOUS SOIL FOR DISPOSAL AT S.C.A. IN NIAGARA FALLS. 16 TRUCKS WERE LOADED OUT THIS DAY. BEGAN LOADING OUT HAZARDOUS DEBRIS RUBBLE FROM BUILDING AREA 9 AREA 8 - TRUCKS LOADED OUT THIS DAY. MATERIAL LOADED OUT HAD LITTLE OR NO ODDOR AND WAS VERY CLEAN. HAD NO DUST METER READINGS TAKEN AROUND SITE THIS DAY.

(2) CONTINUED DELIVERY AND SPREADING OF CLAY ON SLOPE AREA THIS DAY. TRUCKS DELIVERED.

(3) CONTINUED FILLING OF OFFICE BASEMENT AREA WITH CLEAN FILL MATERIAL FROM MC WATER AUTH.

(4) [REDACTED]

Date: 04 15, 1988

Day of Week: S M T W T F S

I.R. No.: 22

Sheet No. 1 of 3 Sheet:

JOB STAMP

 CONTRACTOR: SEVENSON ENVIRON. SERV.

If pertinent to the Construction Operation		
	AM	PM
Weather	Fair/cool	Fair
Temperature	See Engineers diary	

DESCRIPTION OF WORK PERFORMED AND INSPECTED

Specify for Each Operation: Item No., Sub-Contractor (if any), Location and Nature of Work

PRIME: SEVENSON ENVIRONMENTAL SERVICES

Contractor continue loading the rubble ^{material} from the location indicated in my fig. 22

The material had odor. The formans continuously wet the material to prevent the spread of dust.

Continue spreading of clay material using the dozer.

used H Numerator & dust indicator in the work area. Result indicate low reading.

8 samples of rock were taken at 4 location. p. 7.0



ITEM NO.	FS	ES	INTERIM QUANT.	FINAL QUANT.	QUANT. CHK.	DESCRIPTION OF WORK	COMPUTER ENT. CHK.
						Continue loading rubble.	
						H numerator & dust indicator	

The above described work was incorporated into this project and was inspected by:

Alan Anjorin
Inspector's Signature

Reviewed by: Donald Beh
 Engineer-in-Charge
 Resident Engineer

10/14/88
Date

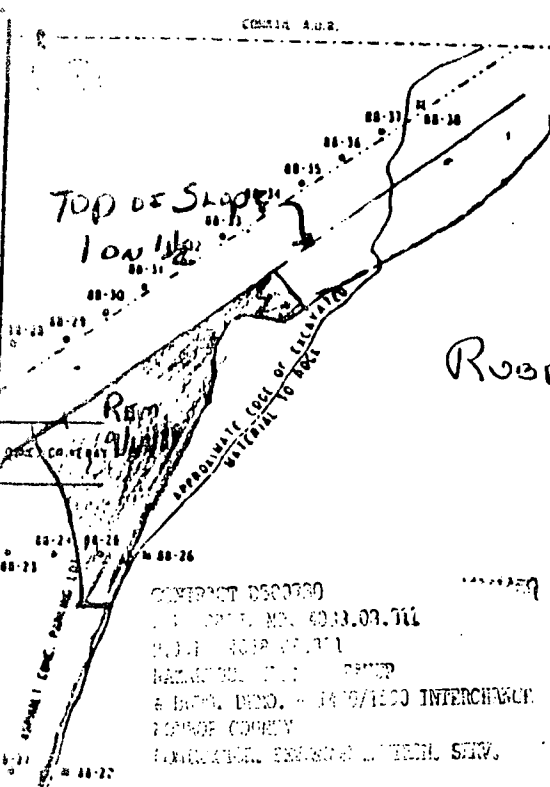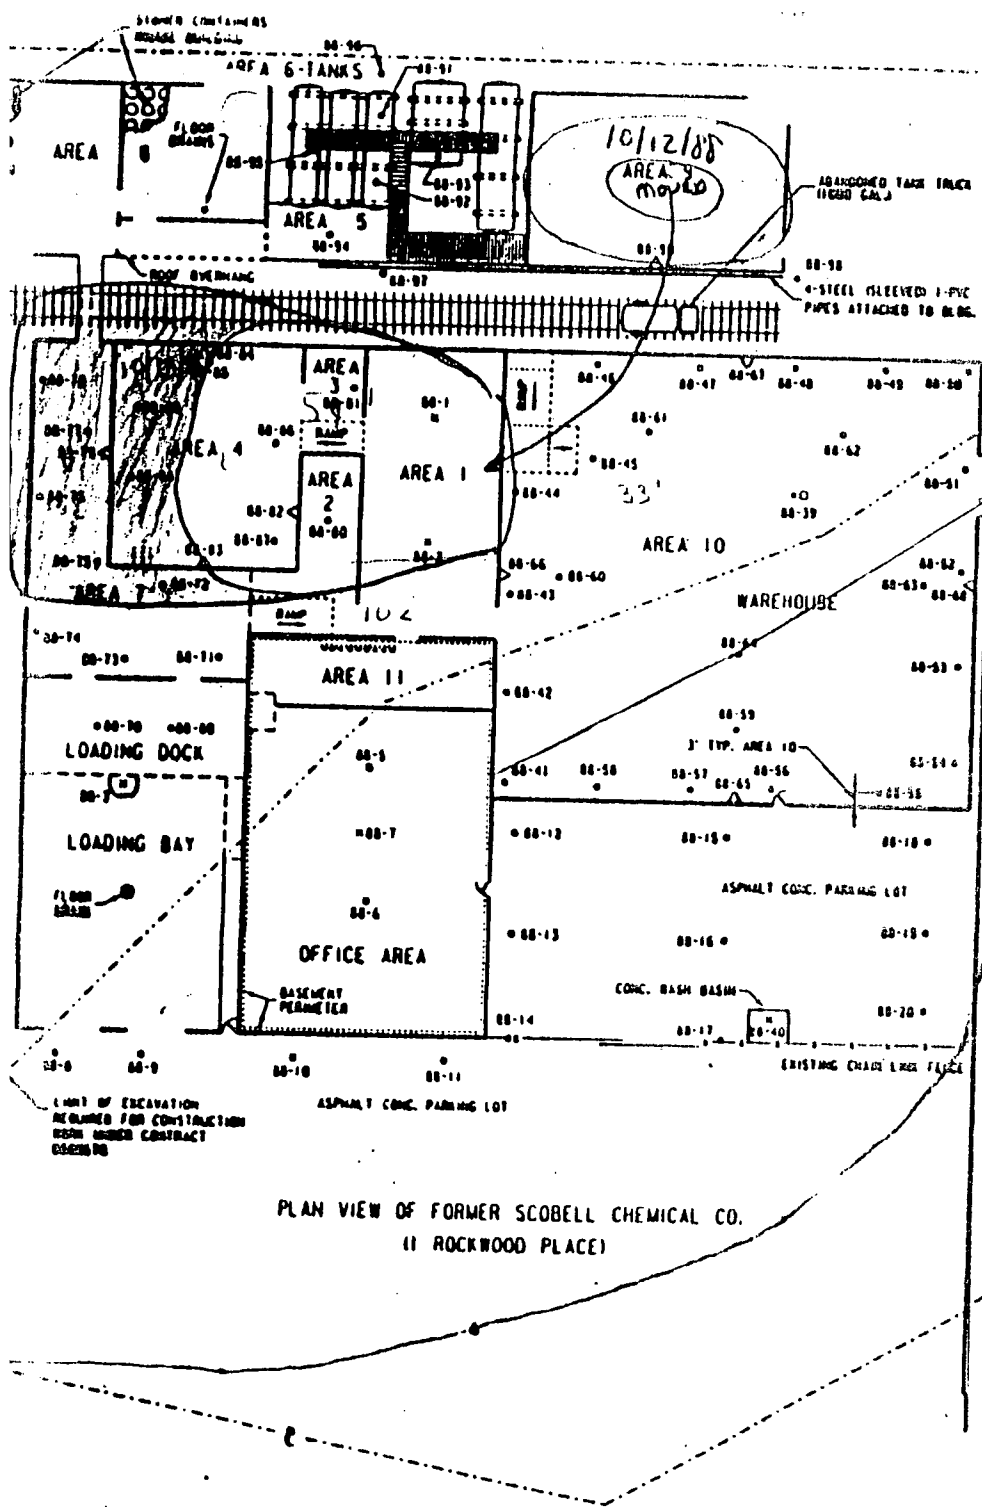

IR # 22
10/13/88 (Thurs)

ROBBER & DRONIS REMOVED

KE+

Area material was being removed


- KEY**
- SOIL SAMPLES
 - SOIL SAMPLES (EARTH AT TOP)
 - SOIL SAMPLES (OF EXCAVATION) (SHOWN AS SOIL SAMPLES)
 - CMP SAMPLE IN CONCRETE FLOOR
 - LIME SAMPLE
 - ▲ BELL SAMPLE
 - STAND PIPES IN UNDERGROUND

NOTE: THE PROJECT LIMITS FOR THIS PROJECT ARE WITHIN THE PROPERTY LINES OF THE FORMER SCOBELL CHEMICAL CO.

fig. 22

JOB STAMP

CONTRACT D500730
 F.A. PROJ. NO. 4088.08.311
 P.I.N. 4088.08.311
 HAZARDOUS WASTE CLEANUP
 & BLDG. DEM. - I490/I590 INTERCHANGE
 MONROE COUNTY
 CONTRACTOR: SEVENSON ENVIRON. SERV.

	AM	PM
Weather	CLOUDY COOL	PARTLY SUNNY-COOL
	High	Low
Temperature	48	37

MAJOR CONTRACT OPERATIONS

I.R. No.	Inspector's Name	Work Assignment and Identification
	H ZEH	E.I.C.
22	Chlo ANTOIN	FIELD Insp

Maint. of Traffic & Project Signs: PLACED ORANGE FENCE AROUND SITE AT END OF DAY. ALL WORKERS WEARING LEVEL C PROTECTION.

REMARKS: (1) CONTINUED LOADING OUT HAZARDOUS RUBBLE FOR DISPOSAL AT S.C.A. IN NIAGARA FALLS. TRUCKS OF RUBBLE LOADED BUT THIS DAY. MATERIAL LOADED OUT HAD VERY LITTLE OIL ON AND WAS CONTINUALLY WET DOWN TO PREVENT DUST. H-MO READINGS AND DUST METER READINGS WERE CHECKED THROUGHOUT DAY. WINDS WERE BRISK FROM W TO E THIS DAY.

(2) CONTINUED DELIVERY AND SPREADING OF CLAY FROM COLL.

(3) CONTINUED DELIVERY OF CLEAN FILL FOR BASEMENT AREA OF OFFICE. (PERINI'S UTILITY OPERATIONS)

(4) RUBBLE PILE WAS COVERED AT END OF DAY.

TRK. COND. (1) DICK ROBBINS CALLED [REDACTED]

Date: OCT. 14th, 1988

Day of Week: S M T W T F S

I.R. No.: 23

Sheet No. 1 of 3 Sheet

JOB STAMP
 CONTRACT D566730
 F.A. PROJ. NO. 4088.08.311
 P.I.N. 4088.08.311
 HAZARDOUS WASTE CLEANUP
 BLDG. DEMO. - 1490/1590 INTERCHANGE
 MONROE COUNTY
 CONTRACTOR: SEVENSON ENVIRON. SERV.

If pertinent to the Construction Operation		
	AM	PM
Weather	clear	clear
Temperature	See Engineer's diary.	

DESCRIPTION OF WORK PERFORMED AND INSPECTED
 Specify for Each Operation: Item No., Sub-Contractor (if any), Location and Nature of Work

PRIME: SEVENSON ENVIRONMENTAL SERVICES:

Contractor continued loading trucks with contained debris. Only 2 trucks loaded. see fig 2BA.

Contractor resampled rock at locations 88-123, 88-124, top of rock and 6" into the rock.

Contractor used the dazer for the slope in boxman area, while the backhoe was being used haul the debris and mashed it to smaller fragments.

At the end of the operation contractor covered

ITEM NO.	FS	ES	INTERIM QUANT.	FINAL QUANT.	QUANT. CHK.	DESCRIPTION OF WORK	COMPUTER	
							ENT.	CHK.
						Removal of debris		
						Pictures		
						Log # - Number & Distances		

The above described work was incorporated into this project and was inspected by:

Alan Arjoris
 Inspector's Signature

Reviewed by: David Zeh 10/17/88
 Date

- Engineer-in-Charge
- Resident Engineer

Reverse side used for additional remarks and sketches.

Date: Oct 11 1980

Day of Week: S M T W T F S

I.R. No.: 24

Sheet No. 1 of 4 Sheets

JOB STAMP
 CONTRACT D500730
 F.A. PROJ. NO. 4088.08.311
 P.I.N. 4088.08.311
 HAZARDOUS WASTE CLEANUP
 & BLDG. DEMO. - 1490/1590 INTERCHANGE
 MONROE COUNTY
 CONTRACTOR: SEVENSON ENVIRON. SERV.

If pertinent to the Construction Operation		
	AM	PM
Weather	clear	Fair
Temperature	see E.I.C. Log	

DESCRIPTION OF WORK PERFORMED AND INSPECTED
 Specify for Each Operation: Item No., Sub-Contractor (if any),
 Location and Nature of Work

PRIME: SEVENSON ENVIRONMENTAL SERVICES.
 Continue removing debris from location as shown on the diag. No trucks was 13 loaded at site.
 Contractor removed 12 drums from area 8 content where wood and cans from area #4. The drums was crushed ~~and~~ with the Backhoe and deposited among the debris. (Picture take see attached sheet 49.)
 Continue delivery of clay. The clay was spread using the dozer. (Picture taken of slope and top of slope)

ITEM NO.	FS	ES	INTERIM QUANT.	FINAL QUANT.	QUANT. CHK.	DESCRIPTION OF WORK	COMPUTER	
							ENT.	CHK.
						Removal of debris		
						Drums crushed		
						Pictures		
						Clay material delivered		
						H-Wahmeter & dust indicator used.		
						Returned Compressor		

The above described work was incorporated into this project and was inspected by:

Oliver Higgins
 Inspector's Signature

Reviewed by: David Beh 10/18/80
 Date
 Engineer-in-Charge
 Resident Engineer

Reverse side used for additional remarks and sketches.

Date: Oct. 10, 1988

Day of Week: S M ~~X~~ W T F S

I.R. No.: 25

Sheet No. 1 of 3 She

JOB STAMP
 CONTRACT D500730
 F.A. PROJ. NO. 4088.08.311
 P.I.N. 4088.08.311
 HAZARDOUS WASTE CLEANUP
 & BLDG. DEMO. - 1490/1590 INTERCHANGE
 MONROE COUNTY
 CONTRACTOR: SEVENSON ENVIRON. SERV.

If pertinent to the Construction Operation		
	AM	PM
Weather	Rain	Rain
Temperature	see Engineer diary.	

DESCRIPTION OF WORK PERFORMED AND INSPECTED

Specify for Each Operation: Item No., Sub-Contractor (if any), Location and Nature of Work

PRIME: SEVENSON ENVIRONMENTAL SERVICES.

Contractor continue to load and transport the debris away from the site see fig 25 Total No. of Tr loaded 8.

unknown
 Samples of ^{air} taken from the drums inside Area 8. (See Picture taken)

Mr. Long & Mitchell collected water (H₂O) sample at 6" below surface in vicinity of the rock sample. They baled out the whole first and took the sample. (Picture taken) unknown.

The front part of building 8 i.e. concrete porch was demolished as requested by E.I.C. & D.E.C. Rep.

ITEM NO.	FS	ES	INTERIM QUANT.	FINAL QUANT.	QUANT. CHK.	DESCRIPTION OF WORK	COMPUTER	
							ENT.	CHK.
						Sample of unknown		
						Sample of water taken		
						Concrete porch demol.		
						Used thru meter		
						erect fence		

The above described work was incorporated into this project and was inspected by:

Olu Arijorin
 Inspector's Signature


Reviewed by:

David Boh

10/19/88
 Date

- Engineer-in-Charge
- Resident Engineer

Reverse side used for additional remarks and sketches.

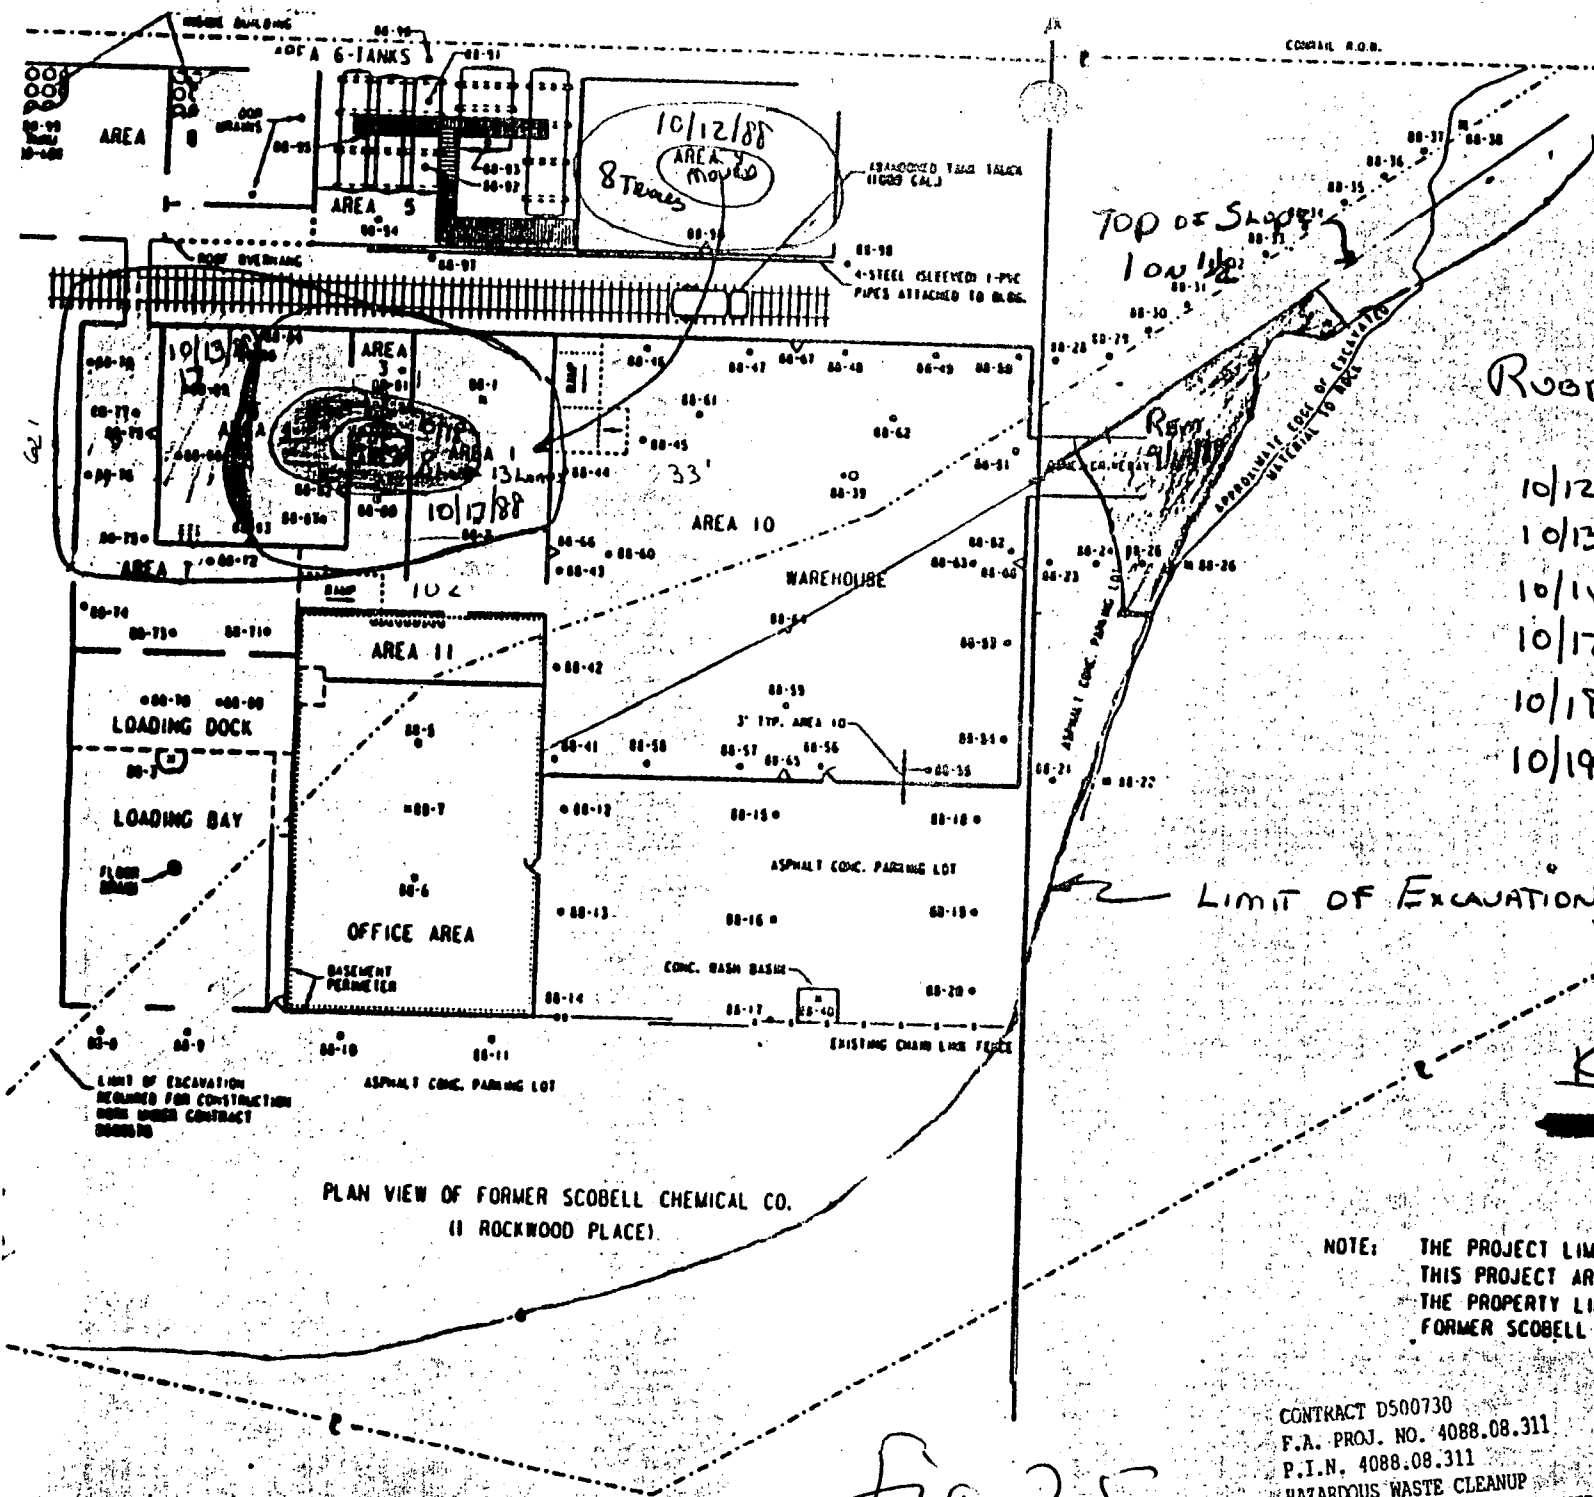

IR # 25
10/18/88
sheet 2 of 3

ROCKWOOD & DENNIS REMOVAL

10/12	8	
10/13	17	25
10/14	2	27
10/12	13	40
10/18	8	48
10/19	6	54

PLAN VIEW OF FORMER SCOBELL CHEMICAL CO.
(1) ROCKWOOD PLACE

NOTE: THE PROJECT LIMITS FOR THIS PROJECT ARE WITHIN THE PROPERTY LINES OF THE FORMER SCOBELL CHEMICAL CO.

CONTRACT D500730
F.A. PROJ. NO. 4088.08.311
P.I.N. 4088.08.311
HAZARDOUS WASTE CLEANUP
6 BLDG. DEMO. - I490/I590 INTERCHANGE
MONROE COUNTY

Fig 25

INSPECTOR'S DAILY REPORT

Date: Oct, 19th 1988

Day of Week: S M T ~~X~~ T F S

I.R. No.: 26

Sheet No. 1 of 3 Sheets

JOB STAMP

CONTRACT D500730
 P.A. PROJ. NO. 4088.08.311
 P.I.N. 4088.08.311
 HAZARDOUS WASTE CLEANUP
 & BLDG. DEMO. - I490/1590 INTERCHANGE
 MONROE COUNTY
 CONTRACTOR: SEVENSON ENVIRON. SERV.

If pertinent to the Construction Operation

	AM	PM
Weather	<u>fair</u>	<u>fair</u>
Temperature	<u>see E.I.C. Daily</u>	

DESCRIPTION OF WORK PERFORMED AND INSPECTED

Specify for Each Operation: Item No., Sub-Contractor (if any), Location and Nature of Work

PRIME SEVENSON ENVIRONMENTAL SERVICES

Contractor loaded out the last load of demo debris using 6 trucks. (Pictures taken) see fig 26 & Table 26B.

They did decontaminate Backhoe 360 using rubber hose.

Contractor did receive I & R Vibratory Roller from Rupp. at 10:40 AM. which was used on the clay material.

Graded the clay material and also placed grade stakes for clay cap. P.H.O.

ITEM NO.	FS	ES	INTERIM QUANT.	FINAL QUANT.	QUANT. CHK.	DESCRIPTION OF WORK	COMPUTER	
							ENT.	CHK.
						Vibratory received		
						gravel delivered		
						finished decontaminating removing		
						contamin. debris		
						decont. Backhoe 360		
						H2O meter used		
						used Roller.		

The above described work was incorporated into this project and was inspected by:


Olav Arjovis
 Inspector's Signature

Reviewed by:

David Beh
 Engineer-in-Charge
 Resident Engineer

10/21/88
 Date

Reverse side used for additional remarks and sketches.

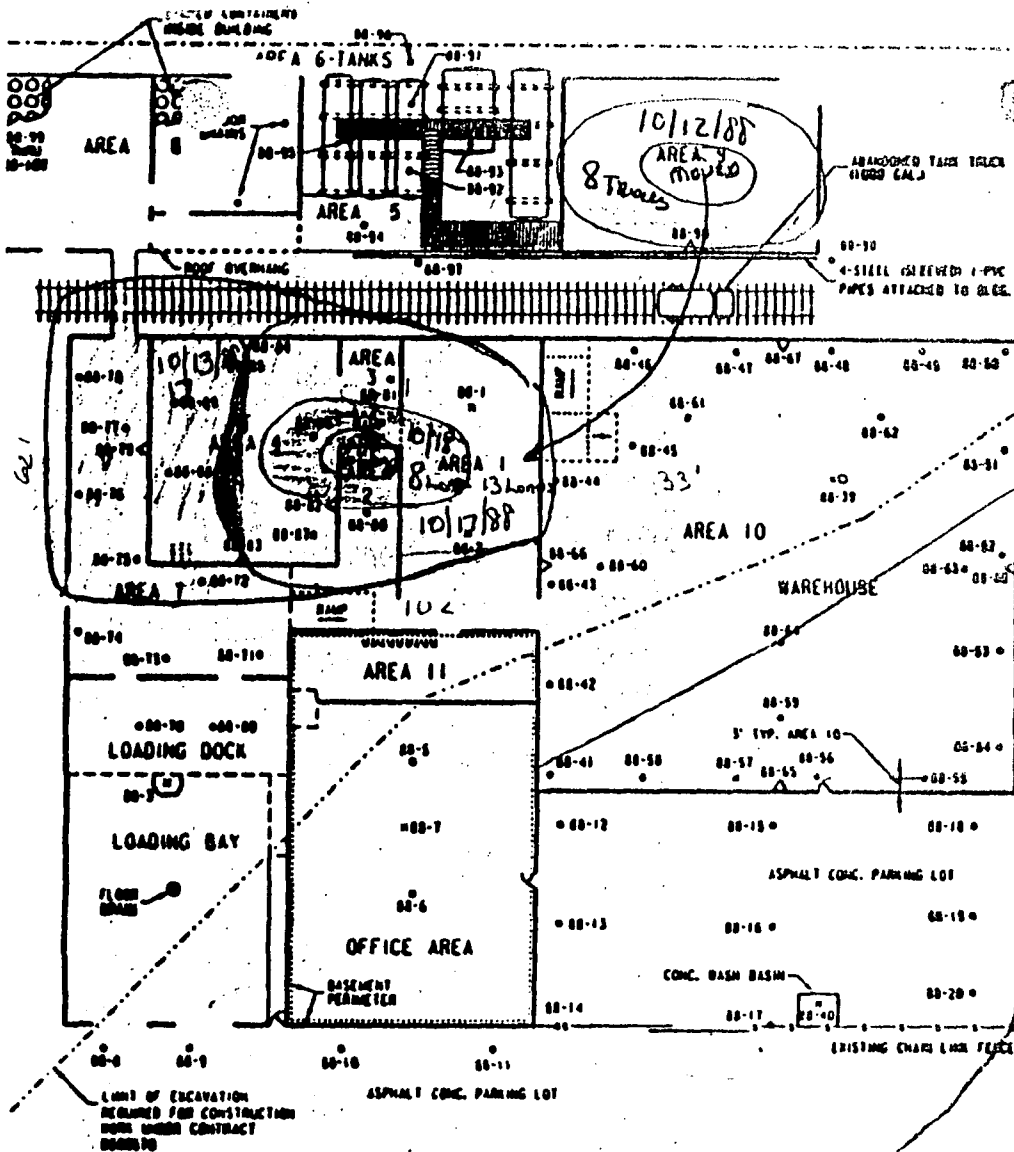

10/19/88
IR # 26
Sheet 2 of 3
ROCKWOOD & DENNIS REMOVAL

10/12	8	
10/13	17	25
10/14	2	27
10/17	13	40
10/18	8	48
10/19	6	54

KEY
Area removed

NOTE: THE PROJECT LIMITS FOR THIS PROJECT ARE WITHIN THE PROPERTY LINES OF THE FORMER SCOBELL CHEMICAL CO.

CONTRACT D500730
F.A. PROJ. NO. 4088.08.311
P.I.N. 4088.08.311
HAZARDOUS WASTE CLEANUP
& BLDG. DEMO. - I490/I590 INTERCHANGE
MONROE COUNTY
CONTRACTOR: SEVENSON ENVIRON. SERV.

Fig 26

Date: Oct. 26, 1988

Day of Week: S M T ~~W~~ T F S

I.R. No.: 31

Sheet No. 1 of 1 Sheet

JOB STAMP

CONTRACT D500730
 P.A. PROJ. NO. 4088.08.311
 P.I.N. 4088.08.311
 HAZARDOUS WASTE CLEANUP
 I-490/I590 INTERCHANGE
 HENRI COUNTY
 CONTRACTOR: SEVENSON ENVIRON. SERV.

If pertinent to the Construction Operation		
	AM	PM
Weather	Rain	Fair
Temperature	see E.I.C's Dairy	

DESCRIPTION OF WORK PERFORMED AND INSPECTED
 Specify for Each Operation: Item No., Sub-Contractor (if any),
 Location and Nature of Work

PRIME: SEVENSONS ENVIRONMENTAL SERVICE.

Contractor received 6 loads of screened topsoil for the north side of access road. However, the topsoil was left in pile. See picture.
 Contractor mounted ram on the Backhoe 360 started use ramming the rock in detour #2 using the dozer to push the rocks into a pile.

New operator came intoday.

ITEM NO.	FS	ES	INTERIM QUANT.	FINAL QUANT.	QUANT. CHK.	DESCRIPTION OF WORK	COMPUTER	
							ENT.	CHK.
						Hoe ramming the rock		
						Received 6 loads of topsoil.		

The above described work was incorporated into this project and was inspected by:

Cla Argerin
 Inspector's Signature

Reviewed by:

David Beh

10/27/88

- Engineer-in-Charge
- Resident Engineer

Date

Reverse side used for additional remarks and sketches.

ENGINEER'S DAILY PROJECT DIARY

Page No. 403043

JOB STAMP

Sheet No. 1 of 2 Sheets

CONTRACT D500730
 F.A. PROJ. NO. 4088.08.311
 P.I.N. 4088.08.311
 HAZARDOUS WASTE CLEANUP
 & BLDG. DEMO. - I490/I590 INTERCHANGE
 MONROE COUNTY
 CONTRACTOR: SEVENSON ENVIRON. SERV.

Date Oct. 26, 1988

Day of Week

S	M	T	W	T	F	S
---	---	---	----------	---	---	---

	AM	PM
Weather	Cloudy Rainy, Cool	Cloudy Cool

	High	Low
Temperature	45	38

MAJOR CONTRACT OPERATIONS

R. No.	Inspector's Name	Work Assignment and Identification
	H. ZEH	E.I.C.
31	O. ANTONIN	Field Inspection

Maint. of Traffic & Project Signs: ORANGE FRONE UP AT END OF DAY.
OFFICE OK THIS DAY FOR FUMES.

REMARKS: SEVENSON - CONTINUATION
 (1) BEGAN DELIVERY OF TOPSOIL ON NORTH SIDE OF
HASH ROAD FOR PLACEMENT 3" DEEP.
 (2) RE ROLLED CLAY MATRIAL ON NORTH SIDE OF
HASH ROAD.
 (3) BEGAN HOR RAMMING AND PUSHING TO THE
SIDE ROCK IN DETOUR #2 AREA STARTING AT
WEST END AND WORKING EAST. ROCK WILL BE
REMOVED ONCE A STOCKPILE IS BUILT. ROCK
REMOVAL [REDACTED]
29' FROM TOP OF SLOPE DOWN LOW 3

Visitors

(1) J. BRUNWESSER WAS HERE IN A.M. [REDACTED]

Date: OCT. 27, 1988

Day of Week: S M T W X F S

I.R. No.: 32

Sheet No. 1 of 1 Sheet

JOB STAMP

CONTRACT D500730
 F.A. PROJ. NO. 4088.08.311
 P.I.N. 4088.08.311
 HAZARDOUS WASTE CLEANUP
 & BLDG. DEMO. - I490/1590 INTERCHANGE
 MONROE COUNTY
 CONTRACTOR: SEVENSON ENVIRON. SERV.

If pertinent to the Construction Operation		
	AM	PM
Weather	Fair	Fair
Temperature	see I.R. entry	

DESCRIPTION OF WORK PERFORMED AND INSPECTED

Specify for Each Operation: Item No., Sub-Contractor (if any), Location and Nature of Work

PRIME: SEVENSON ENVIRONMENTAL SERVICES

Contractor began piling and ripping rock with Backhoe PC 360. They continued ramming the rock for the Detour #2. Stock piling was done with the dozer and PC 400.

The foreman was instructed by the E.I.C to push piles of topsoil into one pile at the south side; using the dozer.

The operator did not wear level C protection. No hard hat; no suit and no gloves. However, the operator was instructed by his foreman (Rick) to observe the protection.

The color of some section of the rock look

ITEM NO.	FS	ES	INTERIM QUANT.	FINAL QUANT.	QUANT. CHK.	DESCRIPTION OF WORK	COMPUTER	
							ENT.	CHK.

The above described work was incorporated into this project and was inspected by:

Oliver Anjorin
Inspector's Signature

Reviewed by: David Beh
 Engineer-in-Charge
 Resident Engineer

10/29/88
Date

Reverse side used for additional remarks and sketches.

ENGINEER'S DAILY PROJECT DIARY

Page No. 4088.27

JOB STAMP

Sheet No. 1 of 2 Sheets

CONTRACT D500730
 F.A. PROJ. NO. 4088.08.311
 P.I.N. 4088.08.311
 HAZARDOUS WASTE CLEANUP
 & BLDG. DEM. - 1490/1590 INTERCHANGE
 HUNTER COUNTY
 CONTRACTOR: SEVENSON ENVIRON. SERV.

Date OCT. 27, 1988

Day of Week

S	M	T	W	T	F	S
---	---	---	---	----------	---	---

AM	PM
----	----

Weather

SUNNY COOL	SUNNY MILD
---------------	---------------

Temperature

High	Low

MAJOR CONTRACT OPERATIONS

I.R. No.	Inspector's Name	Work Assignment and Identification
	H. ZEH	E.I.C.
32	O. ANTONIN	FIELD INSPECTION

Maint. of Traffic & Project Signs: ORANGE FENCE UP ALONG FRONT OF PROPERTY AT END OF DAY. FUMES O.K IN F.O THIS DAY.

REMARKS: SEVENSON -
 1) CONTINUED HOE RAMMING AND REMOVAL OF ROCK IN DETOUR 2 AREA. A SLIGHT ODOR AND BLACK DISCHARGE IS BEING ENCOUNTERED AT STA 1475 TO 2425. ROCK IS BEING PUSHED TO THE SW CORNER FOR REMOVAL AT FUTURE DATE.
 2) MOVED TOPSOIL FROM NORTH SIDE OF HAUL RD TO THE WEST TO ALLOW DISPOSAL OF ROCK IN THIS AREA.

Visitors
 1) LEW GURLEY, C. MOYNIHAN, J. BRENNESSEL AND MYSELF MET OUT ON SITE

Date: 11.20, 1988

Day of Week: SMTWTXS

I.R. No.: 33

Sheet No. 1 of 2 Sheet

JOB STAMP

CONTRACT D500730
F.A. PROJ. NO. 4088.08.311
P.I.N. 4088.08.311
HAZARDOUS WASTE CLEANUP
6 BLEG. DEMO. - I490/I590 INTERCHANGE
MONROE COUNTY
CONTRACTOR: SEVENSON ENVIRON. SERV.

If pertinent to the Construction Operation

	AM	PM
Weather	Sunny	Windy
Temperature	see E.P.C. Diary	

DESCRIPTION OF WORK PERFORMED AND INSPECTED

Specify for Each Operation: Item No., Sub-Contractor (If any), Location and Nature of Work

PRIME: SEVENSON ENVIRONMENTAL SERVICES

Contractor continue hoe ramming the rock, while stock piling was done using Backhoe 400 PC.

The Dozer was used to reduce the original 9" depth clay to 4" - over the original ground at the NE corner of the site. (see fig 33A Pictures taken.)

Clay containment beam was created at North fence line - for the dumping of the contaminated rock that is being excavate from the Detour #2. The excavated rock were stock piled at N.E. corner using one Sevenson dump truck.

P.T.C.

ITEM NO.	FS	ES	INTERIM QUANT.	FINAL QUANT.	QUANT. CHK.	DESCRIPTION OF WORK	COMPUTER	
							ENT.	CHK.
						Excavation of contaminated rock.		
						Hoe - Ramming rock.		


The above described work was incorporated into this project and was inspected by:

Alan Tijonin
Inspector's Signature

Reviewed by: David Zeh
 Engineer-in-Charge
 Resident Engineer

11/29/88
Date

Reverse side used for additional remarks and sketches.

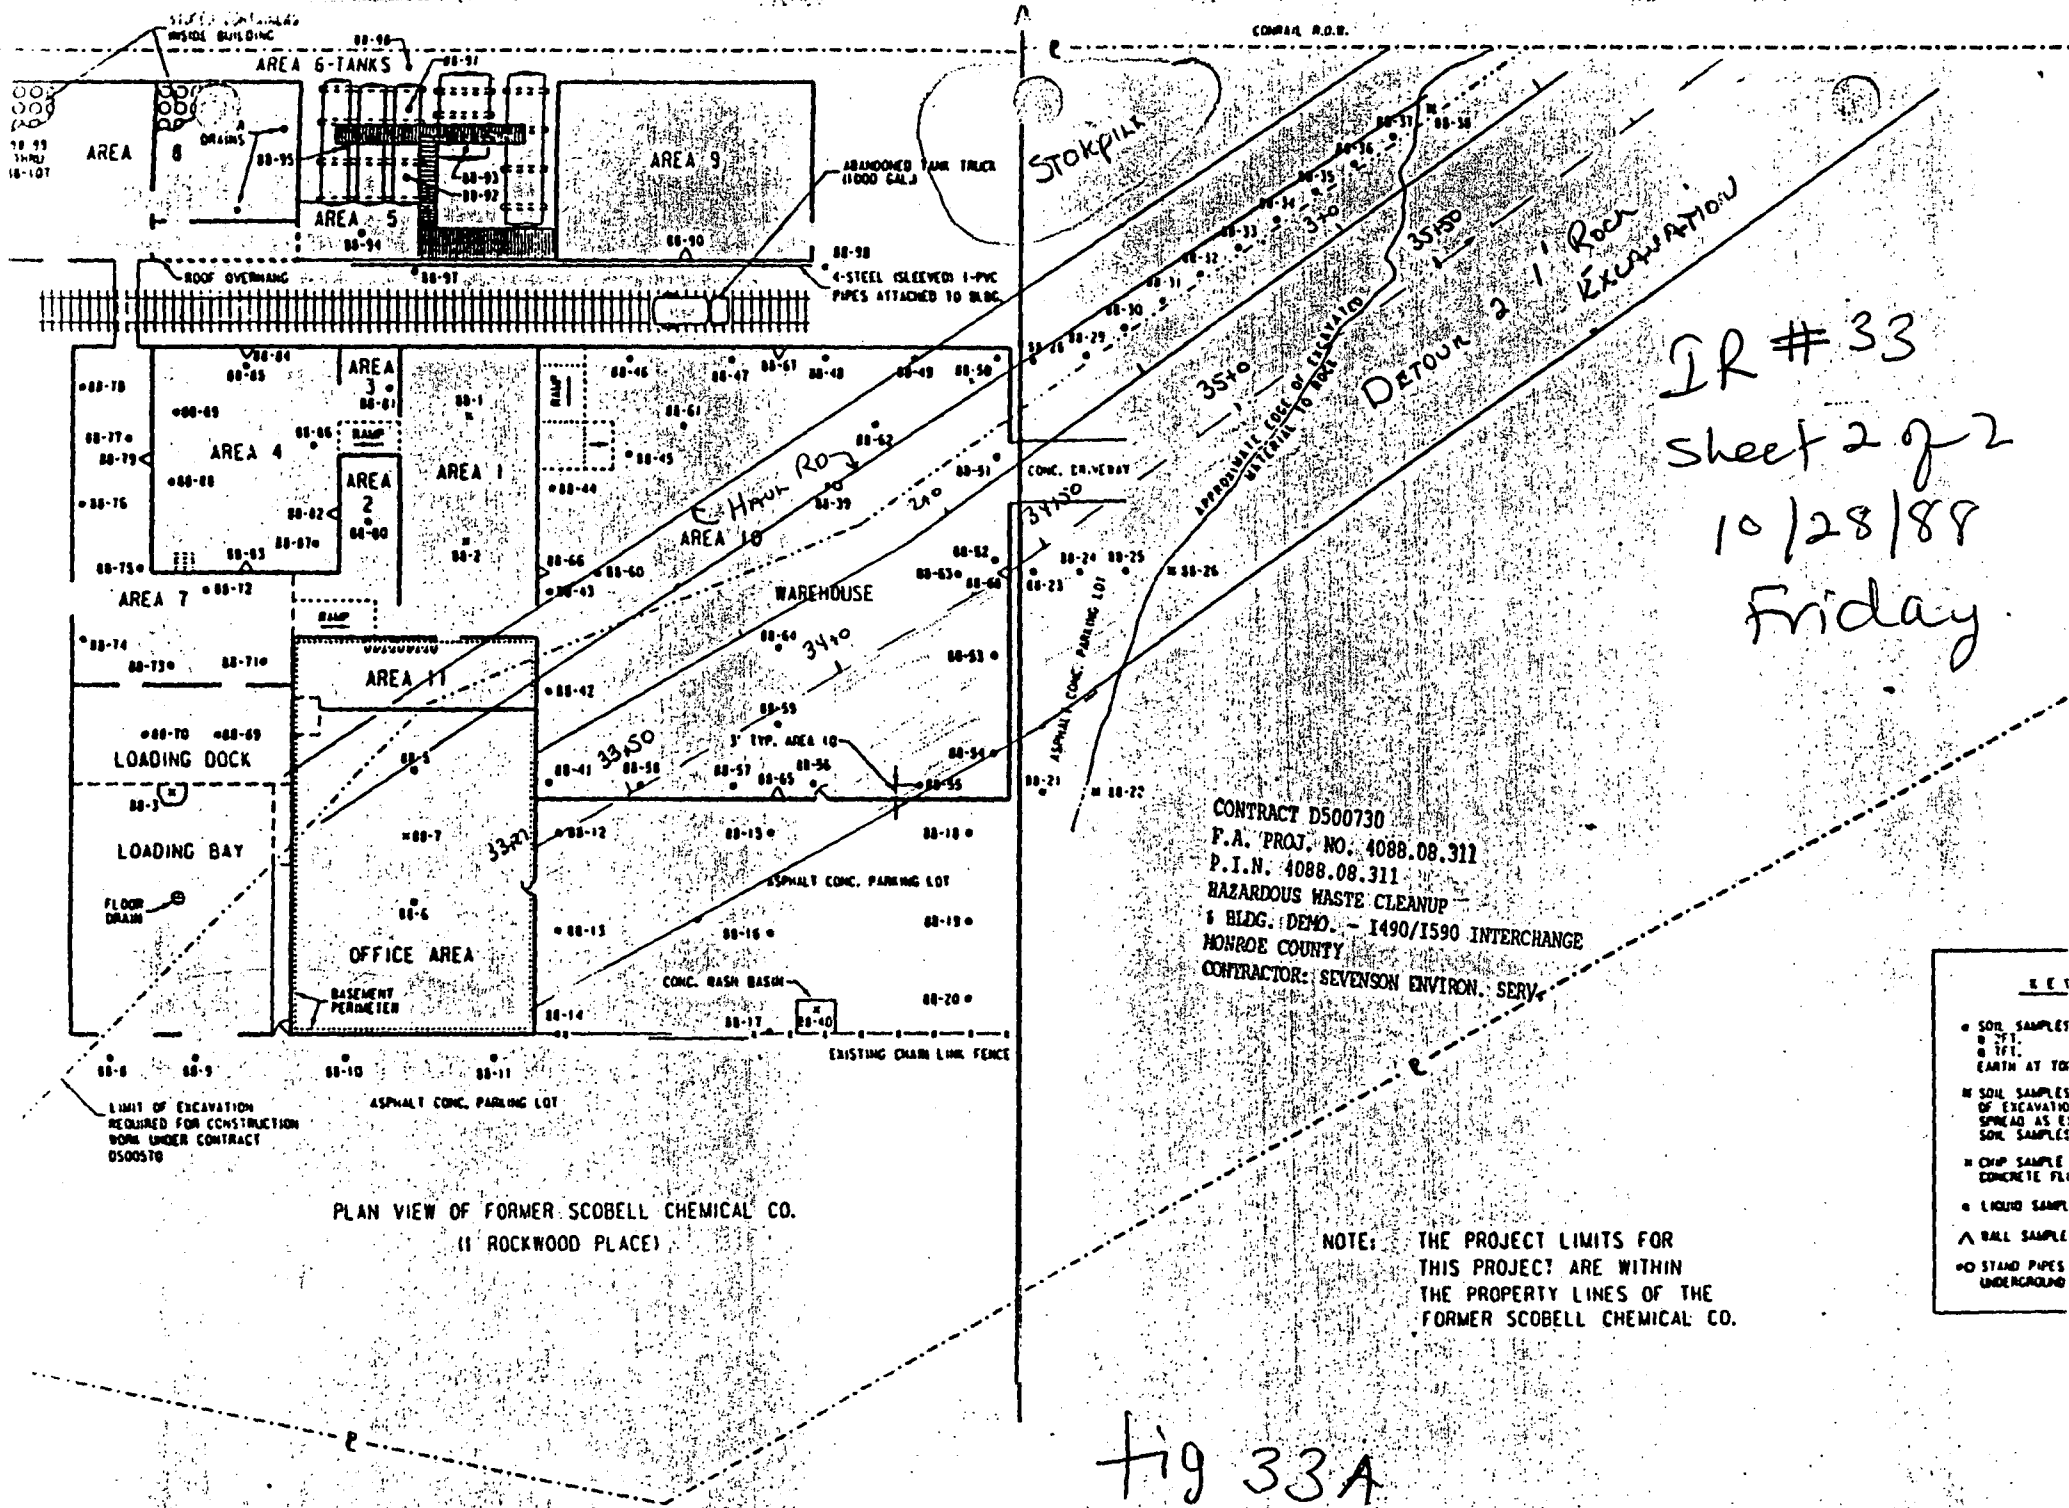

- KEY
- SOIL SAMPLES
0 1 FT.
0 2 FT.
EARTH AT TOP
 - SOIL SAMPLES OF EXCAVATION SPREAD AS E; SOIL SAMPLES
 - CHIP SAMPLE CONCRETE PVI
 - LIQUID SAMPLE
 - △ BALL SAMPLE
 - O STAND PIPES UNDERGROUND

JOB STAMP

Sheet No. 1 of 3 Sheets

Date OCT. 28, 1988

Day of Week

S	M	T	W	T	<u>F</u>	S
---	---	---	---	---	----------	---

CONTRACT D500730
F.A. PROJ. NO. 4088.08.311
P.I.N. 4088.08.311
HAZARDOUS WASTE CLEANUP
& BLDG. DEMO. - I490/1590 INTERCHANGE
MONROE COUNTY
CONTRACTOR: SEVENSON ENVIRON. SERV.

	AM <u>INT. RAIN</u>	PM
Weather	<u>CLOUDY</u> <u>COOL</u>	<u>CLOUDY</u> <u>COLD</u>
	High	Low
Temperature	<u>54</u>	<u>38</u>

MAJOR CONTRACT OPERATIONS

I.R. No.	Inspector's Name	Work Assignment and Identification
	<u>H. ZEH</u>	<u>E.I.C.</u>
<u>33</u>	<u>O. ANTONIN</u>	<u>FIELD INSPECTION</u>

Maint. of Traffic & Project Signs: _____

REMARKS: SEVENSON- CONTRACTOR

(1) CONTINUED HOE RAMMING AND REMOVAL OF ROCK FROM DETOUR #2 AREA FROM STA 34+0± TO 36+00± TO ELEV. SET BY PIRINI SURVEYORS. ROCK IS BEING HAULED UP TOP TO STOCKPILE NORTH OF HAUL RD IN NE CORNER. CERTAIN AREAS OF ROCK ARE BLACK IN BETWEEN LAYERS AND MILD ODOR OF CHEMICALS.

(2) THOUGHT OUT CLAY LIFT NORTH OF HAUL RD IN NE CORNER TO ALLOW DUMPING OF HOE RAMMED ROCK OVER AREA AND PROVIDE DISTINGUISHING LAYER BETWEEN HAZARDOUS SOIL AND ROCK.

(B) HAULING ROCK FROM EXCAVATION UP TOP TO STOCKPILE. 17 LOADS HAULED THIS DAY 204 CY ±

VISITORS

(1) BOB LOUG OF D.R.C. HERE IN AM [REDACTED]

Date: Oct. 30 1988

Day of Week: SMTWTFX

I.R. No.: 34

Sheet No. 1 of 1 Shee

JOB STAMP
 CONTRACT D500730
 F.A. PROJ. NO. 4088.08.311
 P.I.N. 4089.08.311
 HAZARDOUS WASTE CLEANUP
 6 BLDG. DEMO. - I490/I590 INTERCHANGE
 MONROE COUNTY
 CONTRACTOR: SEVENSON ENVIRON. SERV.

If pertinent to the Construction Operation		
	AM	PM
Weather	Fair	Fair
Temperature	See E.I.C.'s Diary	

DESCRIPTION OF WORK PERFORMED AND INSPECTED

Specify for Each Operation: Item No., Sub-Contractor (If any), Location and Nature of Work

PRIME: SEVENSON ENVIRONMENTAL SERVICES

Contractor continue Hoe ramming the rock, while stock piling was done using Backhoe 400 P.C.

Contractor used 3 dump trucks to excavate the rock and stock piled at the N.E. corner.

The chemist of Severson, Mitchell and the Foreman took samples of the black material as requested by the E.I.C. for Lab test. (Pictures taken).

All necessary protection maintenance was taken.

ITEM NO.	FS	ES	INTERIM QUANT.	FINAL QUANT.	QUANT. CHK.	DESCRIPTION OF WORK	COMPUTER	
							ENT.	CHK.
						Hoe ramming.		
						Samples taken		
						stock-pile rock		

The above described work was incorporated into this project and was inspected by:

Olu Ariyarin
 Inspector's Signature

Reviewed by:

David Suh
 Engineer-in-Charge
 Resident Engineer

10/30/88
 Date

Reverse side used for additional remarks and sketches.

Date: Oct. 31, 1988

Day of Week: SMTWTFSS

I.R. No.: 35

Sheet No. 1 of 1 Sheet

JOB STAMP

CONTRACT D500730
 F.A. PROJ. NO. 4088.08.311
 P.I.N. 4088.08.311
 HAZARDOUS WASTE CLEANUP
 & BLDG. DEMO. - I490/I590 INTERCHANGE
 MONROE COUNTY
 CONTRACTOR: SEVENSON ENVIRON. SERV.

If pertinent to the Construction Operation		
	AM	PM
Weather	Fair	Fair
Temperature	See EIC Diary	

DESCRIPTION OF WORK PERFORMED AND INSPECTED

Specify for Each Operation: Item No., Sub-Contractor (if any), Location and Nature of Work

PRIME: SEVENSON ENV. SERVICE

Contractor continued to use ram. and moved rocks onto Scopell site.

A 40ft container for storage of drums was unloaded.

Dr. Paul Hitcho was on site to talk to Nery's workers about the result of water Box Culvert. Meeting held in the D.D.T. office at Tucker Building.

General maintenance was kept.

ITEM NO.	FS	ES	INTERIM QUANT.	FINAL QUANT.	QUANT. CHK.	DESCRIPTION OF WORK	COMPUTER	
							ENT.	CHK.
						Paul Hitcho spoke to Nery's workers.		
						Delivery of 40' container		
						Continue Hot Ram.		

The above described work was incorporated into this project and was inspected by:

Olu Anjorin
Inspector's Signature

Reviewed by:

David Zeh
Date

11/1/88
Date

- Engineer-in-Charge
- Resident Engineer

Reverse side used for additional remarks and sketches.

JOB STAMP

Sheet No. 1 of 3 Sheets

Date OCTOBER 30, 1988

Day of Week S (M) T W T F S

CONTRACT D500730
 F.A. PROJ. NO. 4088.08.311
 P.I.N. 4088.08.311
 HAZARDOUS WASTE CLEANUP
 & BLDG. DEMO. - I490/I590 INTERCHANGE
 MONROE COUNTY
 CONTRACTOR: SEVENSON ENVIRON. SERV.

	AM	PM
Weather	SUNNY COLD	SUNNY MILD
	High	Low
Temperature	50	24°

MAJOR CONTRACT OPERATIONS

I.R. No.	Inspector's Name	Work Assignment and Identification
	H. ZEH	E.I.C
35	O. ANTONIO	FIELD INSPECTION

Maint. of Traffic & Project Signs: ORANGE FENCE PLACED AROUND SITE AT END OF DAY FOR SECURITY. OFFICE READINGS O.K.

REMARKS: SEVENSON-
 (1) CONTINUED HOF RAMMING AND REMOVAL OF ROCK FROM DETOUR 2 AREA AND HAULING UP TO AND STOCKPILING NORTH OF HAUL RD ON SCOBEL PROPERTY. 33 LOADS WERE HAULING UP TOP AND DUMPED THIS DAY. SLIGHT ODOOR AND BLACK DISCHARGE CONTINUED IN AREA STA 3450 → 3540. H-MV READINGS AND DUST READINGS TAKEN THROUGHOUT DAY.

(2) 40' STORAGE TRAILER WAS DELIVERED AND UNLOADED THIS DAY FOR STORAGE OF DRUMS IN BUILDING 8. [REDACTED]

Visitors

(1) Ben Love of D.E.C. HERE TO DAY IN P.M. [REDACTED]

Date: Nov. 1 1988

Day of Week: S M ~~X~~ W T F S

I.R. No.: 36

Sheet No. 1 of 1 Sheet

JOB STAMP

CONTRACT D500730
 F.A. PROJ. NO. 4088.08.311
 P.I.N. 4088.08.311
 HAZARDOUS WASTE CLEANUP
 & BLDG. DEMO. - I490/I590 INTERCHANGE
 MONROE COUNTY
 CONTRACTOR: SEVENSON ENVIRON. SERV.

If pertinent to the Construction Operation		
	AM	PM
Weather	Cloudy	Fair
Temperature	see E.S.C. Diary	

DESCRIPTION OF WORK PERFORMED AND INSPECTED
 Specify for Each Operation: Item No., Sub-Contractor (if any),
 Location and Nature of Work

PRIME: SEVENSON ENV. SERVICES:

Contractor continued to use ram, excavate and moved rocks onto the Scobell site.

Haz-Mat environmental truck from Buffalo came and collect drums Label LP-1 to LP-15 for disposal. See table 36A of sheet 2. Truck left site at 2:00 p.m.

At 3:00 p.m contractor received from RUPP a JCB 1400 Rubber Tire Backhoe.

ITEM NO.	FS	ES	INTERIM QUANT.	FINAL QUANT.	QUANT. CHK.	DESCRIPTION OF WORK	COI ENT
						<u>Haz-Mat collected drums for disposal</u>	
						<u>Continue use - ramming</u>	

The above described work was incorporated into this project and was inspected by:

Oliver Anjorin
Inspector's Signature

Reviewed by:

David Beh

- Engineer-in-Charge
- Resident Engineer

Date

Reverse side used for additional remarks and sketches.

JOB STAMP

Sheet No. 1 of 2 Sheets

Date Nov. 1, 1988

Day of Week

S	M	T	W	T	F	S
---	---	----------	---	---	---	---

CONTRACT D500730
F.A. PROJ. NO. 4088.08.311
P.I.N. 4088.08.311
HAZARDOUS WASTE CLEANUP
& BLDG. DEMO. - I490/I590 INTERCHANGE
MONROE COUNTY
CONTRACTOR: SEVENSON ENVIRON. SERV.

	AM	PM
Weather	Sunny Cool	Sunny Mild
	High	Low
Temperature		

MAJOR CONTRACT OPERATIONS

I.R. No.	Inspector's Name	Work Assignment and Identification
	H ZH	E.I.C.
36	O. ANTOIN	FIELD INSPECTION

Maint. of Traffic & Project Signs: CHANGE FENCE PLACED IN FRONT OF SITE AT
END OF DAY.

REMARKS: SEVENSON-

(1) CONTINUED HOE RAMMING AND REMOVAL OF ROCK FROM
DETOUR 2 AREA AND TRANSPORTING ON TOP MOUTH OF
AVAL RO FOR STOCK PILING. 26 LOADS WERE HAULED
UP TOP THIS DAY. ONE AREA FROM 34+50 → 35+0
STILL HAS A BLACK DISCHARGE AND VERY SLIGHT ODOR.
HNO READINGS AND DUST METER READINGS OK THIS DAY.

(2) REMOVED DRUMS MARKED LP1 THROUGH LP15 AND LOADED
ONTO TRAILER FOR DISPOSAL AT EUSCO INC. IN ARKANSAS.
MANUAL IS BEING TRANSPORTED BY HAZ MAT INC.
- QUARANTINE BAN WAS LIFTED PRIOR TO REMOVAL
FROM BUILDING 8.

VISITORS

(1) Pina Long & Dick Rothlis of M.E.C. Here THIS DAY

JOB STAMP
 CONTRACT D500730
 F.A. PROJ. NO. 4088.08.311
 P.I.N. 4088.08.311
 HAZARDOUS WASTE CLEANUP
 & BLDG. DEMO - I490/I590 INTERCHANGE
 MONROE COUNTY
 CONTRACTOR: SEVENSON ENVIRON. SERV.

If pertinent to the Construction Operation		
	AM	PM
Weather	Fair	Partly Sunny
Temperature	See E.I.C. Diary	

DESCRIPTION OF WORK PERFORMED AND INSPECTED
 Specify for Each Operation: Item No., Sub-Contractor (if any), Location and Nature of Work

PRIME SEVENSON ENVIRONMENTAL SERVICES

Contractor continued hoe ramming the rock, excavate and moved it onto the scobell site.

Removal of all material stored in building #8 was done and placed ^{inside} 40ft container (Red in color) please refer to fig 37. (Picture)

The F.I.C requested that Area #8 should be demolished. It was done using Backhoe 400. The operator observed the health and safety procedures using (level C protection) while demolishing the building. (Picture)

ITEM NO.	FS	ES	INTERIM QUANT.	FINAL QUANT.	QUANT. CHK.	DESCRIPTION OF WORK	COMPUTER	
							ENT.	CHK.
						Contractor continue hoe ramming.		
						Removed drums & stored in container		
						Demolished Area #8		
						Protection		

The above described work was incorporated into this project and was inspected by:

Alu Anjorin
 Inspector's Signature

Reviewed by: David Zeh 11/3/88
 Date

- Engineer-in-Charge
- Resident Engineer

Reverse side used for additional remarks and sketches.

JOB STAMP

Sheet No. 1 of 2 Sheets

CONTRACT D500730
 F.A. PROJ. NO. 4088.08.311
 P.I.N. 4088.08.311
 HAZARDOUS WASTE CLEANUP
 & BLDG. DEMO. - 1490/1590 INTERCHANGE
 MONROE COUNTY
 CONTRACTOR: SEVENSON ENVIRON. SERV.

Date Nov. 2, 1988

Day of Week S M T W T F S

	AM	PM
Weather	COOL RAIN	CLOUDY COOL Int'l W

	High	Low
Temperature	48	40

MAJOR CONTRACT OPERATIONS

I.R. No.	Inspector's Name	Work Assignment and Identification
	H ZEH	E.I.C
37	O. ANTOIN	FIELD INSPECTION

Maint. of Traffic & Project Signs: ORANGE FENCE PUT UP AROUND SITE AT END OF DAY. H-NV READINGS NOT TAKEN IN OFFICE. N. TOLER INFORMED THIS DAY TO KEEP ELEVATOR DOORS CLOSED.

REMARKS: SEVENSON - CONTRACTOR
 (1) CONTINUED HOE RAMMING AND REMOVAL OF ROCK FROM DETOUR 2 AREA AND TRANSPORTATION UP TOP MOUTH OF HAUL RD FOR STORAGE. MATERIAL EXCAVATED STILL CONTAINS BLACK SLUDGE IN AREA 3450 → 35+00. MATERIAL HAS VERY LITTLE ODOR. LOADS HAULED UP TOP THIS DAY. H-NV READINGS AND DUST READINGS TAKEN OK. THIS DAY.

(2) REMOVED REMAINING DRUMS IN BUILDING 8 AND PUT THEM IN ^{40' STORAGE SHED} BUILDING 8 FOR STORAGE ON SITE. BUILDING WAS DOUBLE LOCKED FOR SECURITY. CONTRACTOR = FORGOT TO PUT POLY DOWN PRIOR TO PLACING DRUMS IN STORAGE SHED.

INSPECTOR'S DAILY REPORT

Date: NOV 5 7 1988

Day of Week: SMTW~~FS~~

I.R. No.: 38

Sheet No. 1 of 4 Sheets

JOB STAMP

CONTRACT D500730
 F.A. PROJ. NO. 4088.08.311
 P.I.N. 4088.08.311
 HAZARDOUS WASTE CLEANUP
 & BLDG. DEMO. - I490/I590 INTERCHANGE
 MONROE COUNTY
 CONTRACTOR: SEVENSON ENVIRON. SERV.

If pertinent to the Construction Operation

	AM	PM
Weather	<u>Fair</u>	<u>Sunny</u>
Temperature	<u>see E.I.C. Diary</u>	

DESCRIPTION OF WORK PERFORMED AND INSPECTED

Specify for Each Operation: Item No., Sub-Contractor (if any), Location and Nature of Work

PRIME Contractor: Severson Env. Serv.

Contractor continue to hoe-ramp the rock at the east end of Detour #2. Then moved it with a dump truck up onto the Scheff site. See fig 38A.

Contractor loaded 3 trucks with hazardous waste material and transported it away from Area #8 to SEA. See fig 38A

At 10:30 A.M. the following people (see Page 2) visited the site and held a meeting regards the rock.

ITEM NO.	FS	ES	INTERIM QUANT.	FINAL QUANT.	QUANT. CHK.	DESCRIPTION OF WORK	COMPUTER	
							ENT.	CHK.
						Transportation of Haz. Waste		
						Continue hoe-ramping		
						Covered area #8		
						& rocks with poly.		

The above described work was incorporated into this project and was inspected by:

Olu Ariyori
 Inspector's Signature

Reviewed by:

David Zeh

11/4/88

- Engineer-in-Charge
- Resident Engineer

Date

Reverse side used for additional remarks and sketches.

Nov. 3rd 1988
Sheet 3 of 4

D500730


42

Hazardous debris

KEY
→ Area walked by F. Shuttuck to see the sight. His picture was taken.



Rock debris

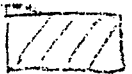


Hazardous debris from Area #8

CONTRACT D500730
F.I.A. PROJ. NO. 4088.08.311
P.I.N. 4088.08.311
HAZARDOUS WASTE CLEANUP
& BLDG. DEMO. - 1490/1590 INTERCHANGE
MONROE COUNTY
CONTRACTOR: SEVENSON ENVIRON. SERV.

PLAN VIEW OF FORMER SCOBELL CHEMICAL CO.
(1. ROCKWOOD PLACE)

F-38A

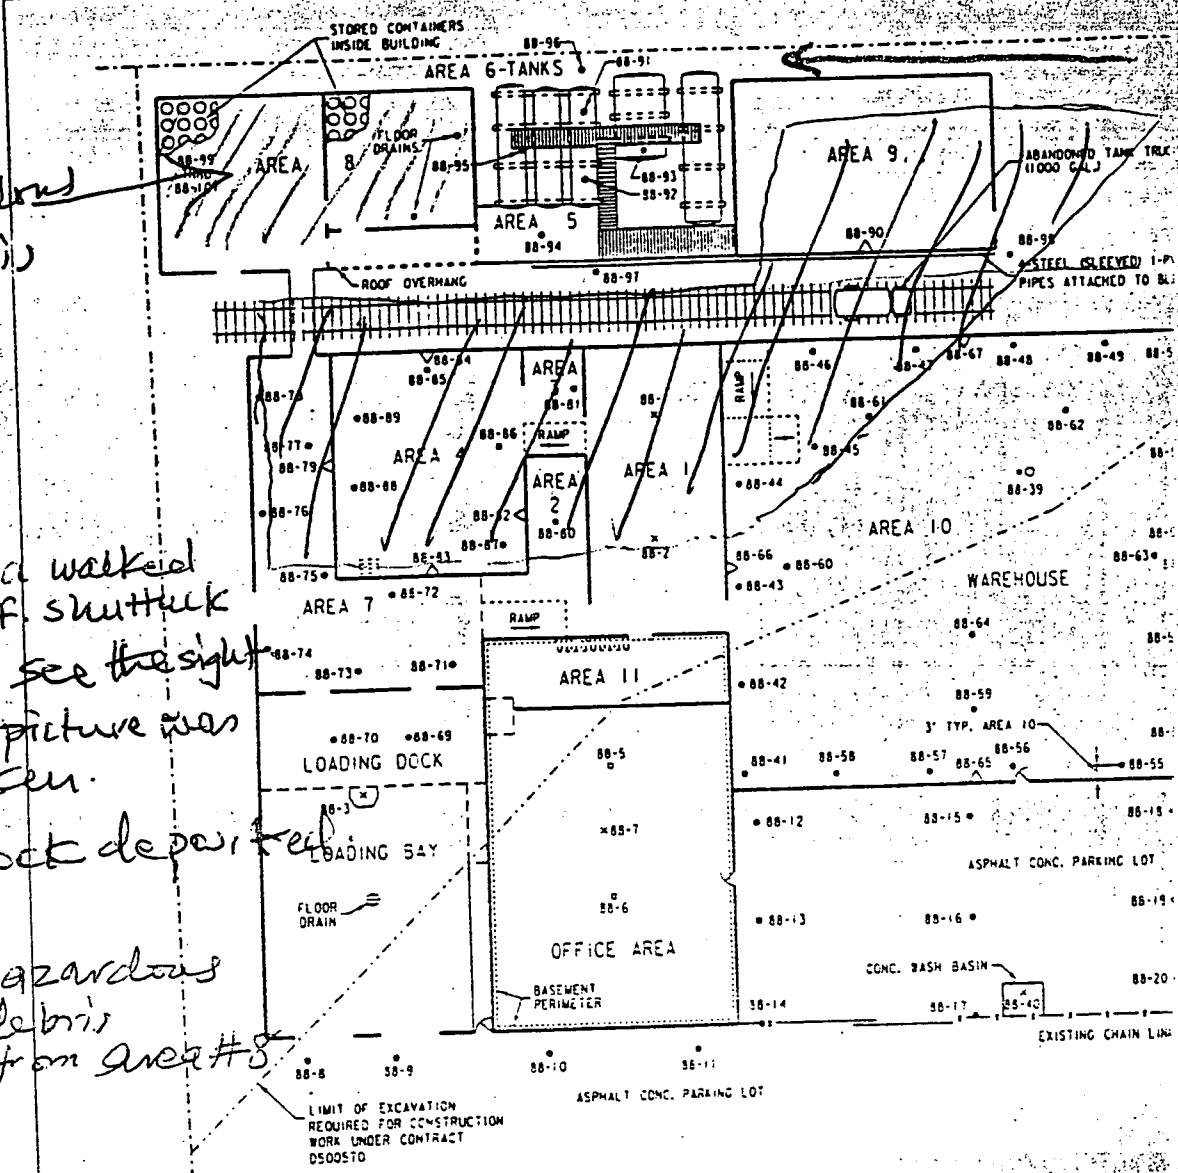

PROJECT SITE PLAN	
DATE	BY
STATE OF NEW YORK DEPARTMENT OF TRANSPORTATION	

- KEY
- SOIL SAMPLES
 - EARTH AT TOP OF ROCK
 - SOIL SAMPLES AT FACE OF EXCAVATION AT SAME SPREAD AS EXCAVATED SOIL SAMPLES
 - * CHIP SAMPLE FROM CONCRETE FLOOR
 - LIQUID SAMPLE
 - △ RAIL SAMPLE
 - STAND PIPES TO UNDERGROUND TANK

PROJECT LIMITS FOR THIS PROJECT ARE WITHIN THE BOUNDARY LINES OF THE FORMER SCOBELL CHEMICAL CO.

JOB STAMP

Sheet No. _____ of _____ Sheets

Date NOVEMBER 3, 1988

Day of Week

S	M	T	W	T	F	S
---	---	---	---	----------	---	---

CONTRACT D500730
 F.A. PROJ. NO. 4088.08.311
 P.I.N. 4088.08.311
 HAZARDOUS WASTE CLEANUP
 & BLDG. DEMO. - I490/I590 INTERCHANGE
 MONROE COUNTY
 CONTRACTOR: SEVENSON ENVIRON. SERV.

	AM	PM
Weather	Sunny COLD	Sunny Mild
	High	Low
Temperature		

MAJOR CONTRACT OPERATIONS

I.R. No.	Inspector's Name	Work Assignment and Identification
	H. ZEH	E.I.C.
38	O. ANTONIO	

Maint. of Traffic & Project Signs: \$ PLACED ORANGE FENCE IN FRONT OF SCHOOL PROPERTY - STORAGE TRAILER DOUBLE LOCKED

REMARKS: SEVENSON---

(1) CONTINUED HOE RAMMING AND REMOVAL OF ROCK FROM DETOUR 2 AREA AND DISPOSAL ON TOP NORTH OF HAUL ROAD. BLACK DISCHARGE IS STILL BEING ENCOUNTERED WITH VERY SLIGHT ODR. 21 LOADS HAUL'D UP TOP THIS DAY.

(2) BEGAN LOADING OUT OF HAZARDOUS DEBRIS FROM AREA 8 BOUNDING FOR DISPOSAL AT SCA IN MOULDER CITY. ONLY 3 TRUCKS HAUL'D OUT THIS DAY. DIFFICULTY GETTING TRUCKS

(3) COVER'D ROCK STOCKPILE AND DEBRIS STOCKPILE WITH POLY.

(4) BUILT CLAY BERM ON BOTTOM IN DETOUR 2 ROCK CUT AREA TO CONTAIN RUNOFF FROM GOING ONTO NONY.

VISITORS - W L. GUNLBY, C. MOYNIHAN, J. BRUNNASSER, MYSELF OF NYS DOT AND P BUSH, F. SHATTUCK, D ROLLINS & B LOVE OF DEC MET AT F.O. THIS DAY

Date: NOV 4 11c

Day of Week: SMTWTFS

I.R. No.: 39

Sheet No. 1 of 3 Sheets

JOB STAMP

CONTRACT D500730
 F.A. PROJ. NO. 4088.08.311
 P.I.N. 4088.08.311
 HAZARDOUS WASTE CLEANUP
 & BLDG. DEMO. - I490/I590 INTERCHANGE
 MONROE COUNTY
 CONTRACTOR: SEVENSON ENVIRON. SERV.

If pertinent to the Construction Operation		
	AM	PM
Weather	SUNNY	Sunny
Temperature	See F.I.C. Dairy	

DESCRIPTION OF WORK PERFORMED AND INSPECTED
 Specify for Each Operation: Item No., Sub-Contractor (if any), Location and Nature of Work

PRIME: SEVENSON ENVIR. SERV.

Construction crew arrived at 6:15 am, Hoe-ramming of rock continue and then moved it up onto SCOBELL SITE.

Continue loading out demo. debris from Area 8 see fig 39A. 7 trucks was loaded

The dozer was used to push rock on scobell site to create space for remainder (Picture taken).

Contractor created a berm at east end

ITEM NO.	FS	ES	INTERIM QUANT.	FINAL QUANT.	QUANT. CHK.	DESCRIPTION OF WORK	COMPUTER	
							ENT.	CHK.
						Continue Hoe ramming		
						Transport debris & load.		
						Covered rock & debris w/ poly.		

The above described work was incorporated into this project and was inspected by:

Alu Anjorin
 Inspector's Signature

Reviewed by: Donald Boh
 Engineer-in-Charge
 Resident Engineer

Date: NOV 4 11c

Reverse side used for additional remarks and sketches.

JOB STAMP

Sheet No. _____ of _____ Sheets

Date NOVEMBER 4, 1988

Day of Week

S	M	T	W	T	F	S
---	---	---	---	---	----------	---

	AM	PM
Weather	Sunny Mild	Sunny Partly Mild-
	High	Low
Temperature	58	42

CONTRACT D500730
 F.A. PROJ. NO. 4088.08.311
 P.I.N. 4088.08.311
 HAZARDOUS WASTE CLEANUP
 & BLDG. DEMO. - I490/I590 INTERCHANGE
 MONROE COUNTY
 CONTRACTOR: SEVENSON ENVIRON. SERV.

MAJOR CONTRACT OPERATIONS

I.R. No.	Inspector's Name	Work Assignment and Identification
	H. ZEH	E.I.C.
39	O. ANTONIN	FIELD INSPECTION

Maint. of Traffic & Project Signs: ORANGE FENCE PLACED W FRONT OF SCOBELL AT END OF DAY. - NO FUMES IN F.O. THIS DAY.

WORKERS WEARING LEVEL C PROTECTION. STORAGE TRAILER DOUBLE LOCKED
 REMARKS: SEVENSON - CONTRACTOR

(1) CONTINUED HOE RAMMING ROCK FROM DETOUR 2 AREA AND HAULING UP TOP THIS DAY. REMOVED OFFICE BASEMENT WALL FOR DETOUR 2 (AS DIRECTED BY J. BREWSTER) DISCHARGE OF BLACK LIQUID SEEMS SOMEWHAT LESS THIS DAY. NO ODOR. 16 TRUCKS HAULED UP TOP THIS DAY.

(2) CONTINUED LOADING OUT OF HAZARDOUS DEBRIS FROM BUILDING 8 FOR TRANSPORTATION TO SEA IN NIAGARA FALLS. 16 TRUCKS WERE LOADED OUT THIS DAY.

(3) LEVHALL OUT DISPOSAL PILL ENOUGH TO DUMP EXC. ROCK.

JOB STAMP

CONTRACT D500730
 F.A. PROJ. NO. 4088.08.311
 I.N. 4038.08.311
 HAZARDOUS WASTE CLEANUP
 REG. DEMO. - I490/I590 INTERCHANGE
 WROE COUNTY
 CONTRACTOR: SEVENSON ENVIRON. SERV.

If pertinent to the Construction Operation		
	AM	PM
Weather	Sunny	Sunny
Temperature	See E.S.C. Diary	

DESCRIPTION OF WORK PERFORMED AND INSPECTED
 Specify for Each Operation: Item No., Sub-Contractor (if any), Location and Nature of Work

PRIME: Severson Env. Serv.

Contractor continue removing rocks up unto Scobell site.

One truck was loaded with demo-debris from area #8. see table

Operators where requested to continue harem the North of East side corner of detour #2.

Contractor created a berm at east end of detour #2 to contain liquid.

ITEM NO.	FS	ES	INTERIM QUANT.	FINAL QUANT.	QUANT. CHK.	DESCRIPTION OF WORK	COMPUTER	
							ENT.	CHK.
						Transpt. 1 load of debris		
						Continue moving rocks		
						Hoe ramming		

The above described work was incorporated into this project and was inspected by:

Oliver Anjovin
 Inspector's Signature

Reviewed by: David Zeh 11/7/88
 Date
 Engineer-in-Charge
 Resident Engineer

Reverse side used for additional remarks and sketches.

JOB STAMP

Sheet No. 1 of 1 Sheets

Date Nov. 5, 1988

Day of Week

S	M	T	W	T	F	S
---	---	---	---	---	---	----------

	AM	PM
Weather	CLEAR SUNNY	CLOUDY WINDY

	High	Low
Temperature	60	48

CONTRACT D500730
 F.A. PROJ. NO. 4088.08.311
 P.I.N. 4088.08.311
 HAZARDOUS WASTE CLEANUP
 & BLDG. DEMO. - 1490/1590 INTERCHANGE
 MONROE COUNTY
 CONTRACTOR: SEVENSON ENVIRON. SERV.

MAJOR CONTRACT OPERATIONS

I.R. No.	Inspector's Name	Work Assignment and Identification
	H. ZEH	E.I.C
40	O. ANTONIN	FIELD INSPECTION

Maint. of Traffic & Project Signs: WORKERS WEARING LAUNCH PROTECTION
STORAGE TRAILER SECURED WITH DOUBLE LOCK

REMARKS: SEVENSON

(1) CONTINUED LOADING OUT EXCAVATED ROCK FROM DETOUR 2 AND HAULING INTO AREA NORTH OF HAUL RD ON SCOBEN PROPERTY. 44 LOADS HAULED UP TOP THIS DAY.

(2) COMPLETED LOADING OUT OF DEBRIS FROM BUILDING 8 AREA FOR DISPOSAL AT S.C.A. 1 TRUCK HAULED OUT THIS DAY.

(3) LEVELING OUT ROCK ON TOP TO ALLOW DUMPS

(4) BUILT BERM TO CONTAIN RUNOFF IN DETOUR 2

Misc

(1) G. DELVECHIO AND J. BRUNSWERK WERE ON SITE TO LOOK AT ROCK CUT ALIGNMENT.

Date: NOV. 1, 1980

Day of Week: SMTWTFSS

I.R. No.: 41

Sheet No. 1 of 1 Sheets

JOB STAMP
 CONTRACT D500730
 F.A. PROJ. NO. 4088.08.311
 P.I.N. 4088.08.311
 HAZARDOUS WASTE CLEANUP
 & BLDG. DEMO. - I490/I590 INTERCHANGE
 MONROE COUNTY
 CONTRACTOR: SEVENSON ENVIRON. SERV.

If pertinent to the Construction Operation		
	AM	PM
Weather	Fair	Cloudy
Temperature	See E.I.	C. Daily

DESCRIPTION OF WORK PERFORMED AND INSPECTED
 Specify for Each Operation: Item No., Sub-Contractor (if any), Location and Nature of Work

PRIME: SEVENSON ENVIRONMENT SERVICE.

Contractor continued to use ram the North of East corner of detour #2, and moved the rocks up into SCOBELL SITE. Dozer was used to push the rocks on Scobell site in order to create space. (see picture taken)

Contractor created a berm at the east end while working on that corner to contain the liquid. However, contractor did mix the liquid and the debris ^{which was} removed ~~it~~ from site with last 2 loads.

ITEM NO.	FS	ES	INTERIM QUANT.	FINAL QUANT.	QUANT. CHK.	DESCRIPTION OF WORK	COMPUTER	
							ENT.	CHK.
						Hoe-ramming detour #2		
						Continue removing rks		
						<u>Took pictures.</u>		

The above described work was incorporated into this project and was inspected by:

Oliver Anjorin
 Inspector's Signature

Reviewed by: David Zeh

11/8/80
 Date

- Engineer-in-Charge
- Resident Engineer

Reverse side used for additional remarks and sketches.

JOB STAMP

Sheet No. _____ of _____ Sheets

Date Nov. 7, 1988

Day of Week

S	(M)	T	W	T	F	S
---	-----	---	---	---	---	---

CONTRACT D500730
 F.A. PROJ. NO. 4088.08.311
 P.I.N. 4088.08.311
 HAZARDOUS WASTE CLEANUP
 & BLDG. DEMO. - I490/I590 INTERCHANGE
 MONROE COUNTY
 CONTRACTOR: SEVENSON ENVIRON. SERV.

	AM	PM
Weather	CLOUDY COOL	CLOUDY COOL
	High	Low
Temperature	48	38

MAJOR CONTRACT OPERATIONS

I.R. No.	Inspector's Name	Work Assignment and Identification
	H. ZRH	E.I.C
41	D. ANDRIN	FIELD INSPECTION

Maint. of Traffic & Project Signs: STORAGE TRAILER SECURED WITH DOUBLE LOCK

REMARKS: SEVENSON - CONTRACTOR
 (1) CONTINUED HOW RAMMING & REMOVING ROCK FROM DETOUR 2 EAST END NORTH WALL & SUMP RESERVOIR AREA AS ORDERED BY J. BREWSTER. 19 LOADS WERE HAULED UP TOP THIS DAY. MATERIAL DID NOT HAVE ANY ODD THAT WAS HAULED THIS DAY.
 (2) WIDENED ROCK CUT TO MAINTAIN MINIMUM 29' WIDTH THROUGHOUT.

Visitors
 IN ROOM LONG OF DEC HERE 10 A.M. - [REDACTED]

INSPECTOR'S DAILY REPORT

Date: NOV. 8 1988

Day of Week: S M ~~X~~ W T F S

I.R. No.: 42

Sheet No. 1 of 1 Sheets

JOB STAMP
 CONTRACT D500730
 F.A. PROJ. NO. 4088.08.311
 P.I.N. 4088.08.311
 HAZARDOUS WASTE CLEANUP
 & BLDG. DEMO. - I490/1590 INTERCHANGE
 MONROE COUNTY
 CONTRACTOR: SEVENSON ENVIRON. SERV.

If pertinent to the Construction Operation		
	AM	PM
Weather	showers	showers
Temperature	see E.I.C. Diary	

DESCRIPTION OF WORK PERFORMED AND INSPECTED
 Specify for Each Operation: Item No., Sub-Contractor (if any), Location and Nature of Work

PRIME: SEVENSON ENVIRONMENTAL SERVICES.

Contractor used the dozer and backhoe 400 to level and shape the rock pile at the top of Scobell site.

Decontaminated the Severson's dump truck and Backhoe 350. Severson's dump truck left the site.

Level C protection was used

They was no D.E.C Rep to-day.
 P.T.O. ✓

ITEM NO.	FS	ES	INTERIM QUANT.	FINAL QUANT.	QUANT. CHK.	DESCRIPTION OF WORK	COMPUTER	
							ENT.	CHK.
						Contractor level & shaped the rock		
						Decontamination of Truck & Backhoe.		

The above described work was incorporated into this project and was inspected by:

Olu Anjorin
 Inspector's Signature

Reviewed by: David Zel
 Engineer-in-Charge
 Resident Engineer

11/9/88
 Date

Reverse side used for additional remarks and sketches.

ENGINEER'S DAILY PROJECT DIARY

Page No. 00052

JOB STAMP

Sheet No. _____ of _____ Sheets

Date Nov 8, 1988

Day of Week S M T W T F S

	AM	PM
Weather	CLOUDY RAIN COOL	CLOUDY RAIN COOL

	High	Low
Temperature	48	40

CONTRACT D500730
 F.A. PROJ. NO. 4088.08.311
 P.I.N. 4088.08.311
 HAZARDOUS WASTE CLEANUP
 6 BLDG. DEMO. - I490/I590 INTERCHANGE
 MONROE COUNTY
 CONTRACTOR: SEVENSON ENVIRON. SERV.

MAJOR CONTRACT OPERATIONS

I.R. No.	Inspector's Name	Work Assignment and Identification
	H. ZEH	E.I.C
42	O. ANTONIN	FIELD INSPECTION

Maint. of Traffic & Project Signs: STORAGE TRAILER SECURED WITH DOUBLE LOCK

REMARKS: SEVENSON CONTRACTOR

(1) MOVED MACHINES FROM DETOUR 2 AREA TO UO TOP. ROCK REMOVAL IS COMPLETE.

(2) BEGAN LEVELING OF ROCK STOCKPILE ON TOP TO ALLOW SAMPLING OF DILE AS DIRECTED BY D.E.C.

(3) DECONTAMINATED 360 BACKHOE & HOE RAM & FOUND 10 WHEELS FOR REMOVAL FROM PROJECT.

Misc.

(1) PERINI BEGAN EXCAVATION OF DIRT WEST OF OFFICE AREA FOR DETOUR 2. ALSO BEGAN HOE RAMMING OFFICE FLOOR FOR REMOVAL. R. STEIN RAN H-NO OVER AREA NOTHING INDICATED - 1.0 ppm. NOTIFIED J. BUNNELL OF READINGS

INSPECTOR'S DAILY REPORT

Date: NOV. 10, 1988

Day of Week: S M T W ~~X~~ F S

I.R. No.: 44
 Sheet No. 1 of 2 Sheets

JOB STAMP
 CONTRACT D500730
 F.A. PROJ. NO. 4088.08.311
 P.I.N. 4088.08.311
 HAZARDOUS WASTE CLEANUP
 & BLDG. DEMO. - 1490/1590 INTERCHANGE
 MONROE COUNTY
 CONTRACTOR: SEVENSON ENVIRON. SERV.

If pertinent to the Construction Operation		
	AM	PM
Weather	Cloudy	Fair
Temperature	See E.S.C. Diary	

DESCRIPTION OF WORK PERFORMED AND INSPECTED
 Specify for Each Operation: Item No., Sub-Contractor (if any),
 Location and Nature of Work

PRIME: Severson Environmental Services

Contractor did cut out some material to create a ramp down from Scobell site into Detour #2. Material was placed North of stockpile. see fig 44

Placed 3 1gal cans marked unknown #2 into over packed in 85gal drums (Yellow in colour are the drums) and stored in container.

Contractor used Backhoe to flat the top of the rock pile and shaped the edges (pictures taken).

P. T. O

ITEM NO.	FS	ES	INTERIM QUANT.	FINAL QUANT.	QUANT. CHK.	DESCRIPTION OF WORK	COMPUTER	
							ENT.	CHK.
						Reshaped stock pile of rock		
						Stored unknown #2		

The above described work was incorporated into this project and was inspected by:

Olu Aiyorin
 Inspector's Signature

Reviewed by: David Suh 11/11/88
 Date
 Engineer-in-Charge
 Resident Engineer

Reverse side used for additional remarks and sketches.

JOB STAMP

Date Nov. 10, 1988

Day of Week

S	M	T	W	T	F	S
---	---	---	---	----------	---	---

AM	PM
----	----

Weather

Cloudy Intermittent	Windy Cool
------------------------	---------------

High	Low
------	-----

Temperature

50	40
----	----

CONTRACT D500730
F.A. PROJ. NO. 4088.08.311
P.I.N. 4088.08.311
HAZARDOUS WASTE CLEANUP
& BLDG. DEMO. - I490/I590 INTERCHANGE
MONROE COUNTY
CONTRACTOR: SEVENSON ENVIRON. SERV.

MAJOR CONTRACT OPERATIONS

I.R. No.	Inspector's Name	Work Assignment and Identification
	H. ZEH	E.I.C.
44	O. ANTONIN	FIELD INSPECTION

Maint. of Traffic & Project Signs: STORAGE TRAILER SECURED WITH DOUBLE LOCK

REMARKS: SEVENSON - CONTRACTOR

(1) CUTTING OUT MATERIAL TO RAMP DOWN FROM SCOBELL INTO DETOUR 2 AREA. MATERIAL WAS PLACED NORTH OF ROCK STOCKPILE (CLEAN MATERIAL)

(2) PLACED 3 1 GAL CONTAINERS MARKED UNKNOWN #2 INTO AN OVERPAC DUMP AND PALLED AROUND 1 GAL CONTAINERS TO PREVENT MOVEMENT INSIDE DUMP.

(3) LABELLED AND SENT 15 \Rightarrow ROCK SAMPLES # 128 abc \rightarrow 142 a, b, c TO GENERAL TESTING FOR ANALYZING THIS DAY.

MEETING

(1) WENT TO R.O. THIS A.M FOR E.I.C MEETING

(2) MET AT J. BREWSTER'S OFFICE THIS A.M FOR WEEKLY STAFF MEETING.