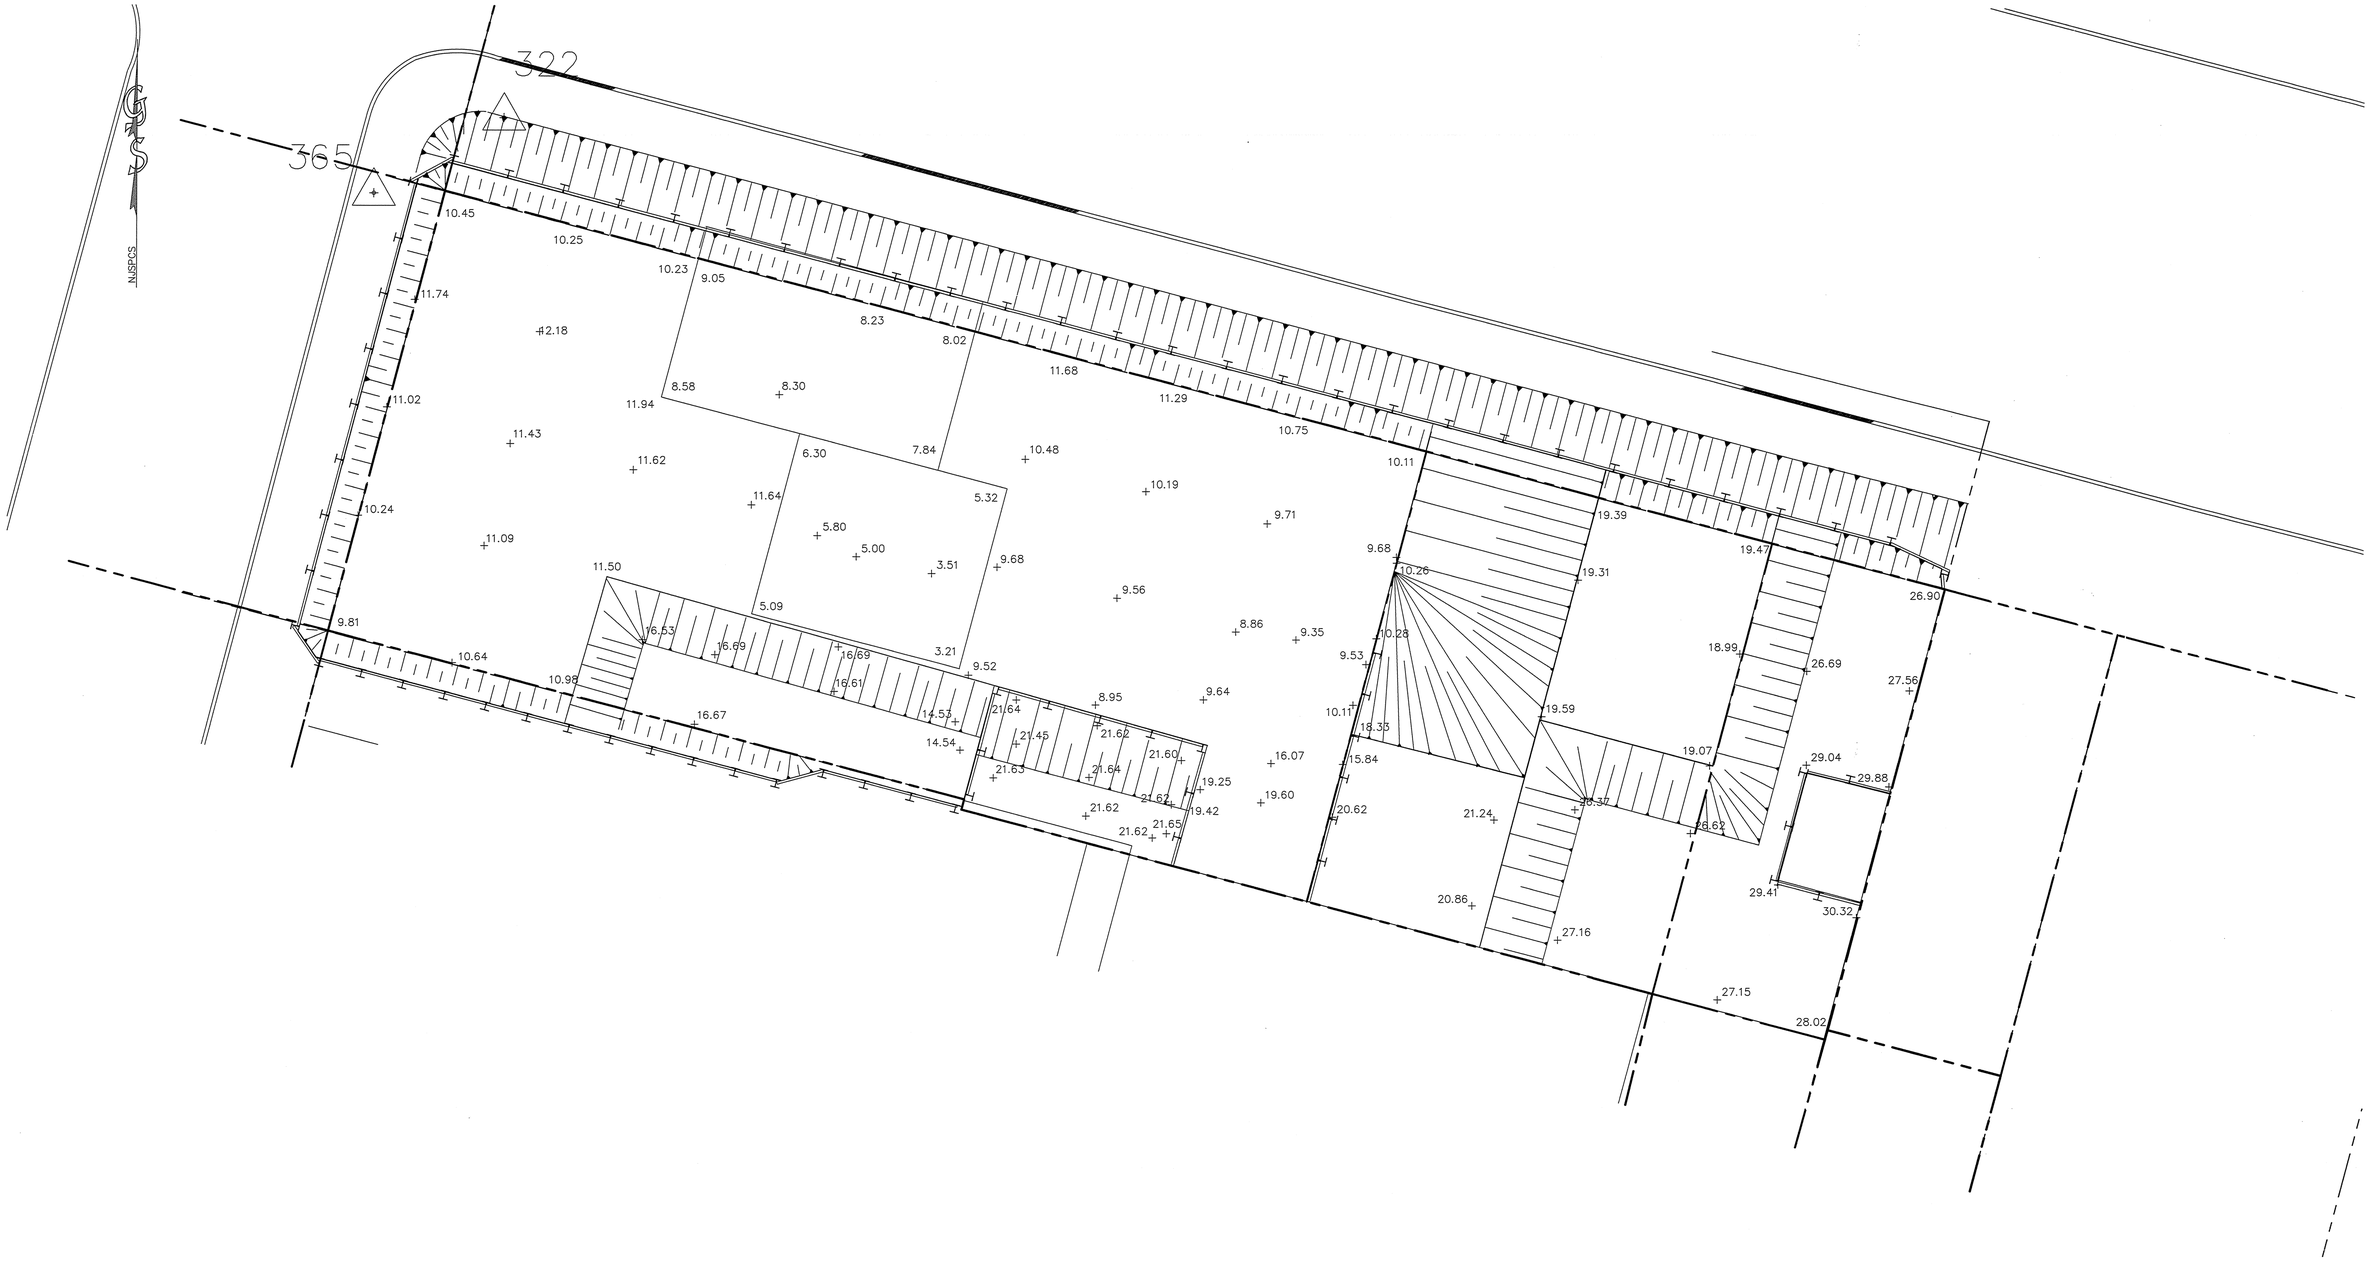

LEGEND

X9.93 -- SURVEY POINTS
FINAL EXCAVATION IN FEET

REV	DATE	BY	CHKD	DESCRIPTION	REFERENCE DRAWING	DWG. NO.
0	8/20/09	DF	AJF	INITIAL		

SCALE: 1"=10'

10 0 20 20

STATE OF NEW YORK
ANGELO JOHN FIORENZA
PROFESSIONAL LAND SURVEYOR
NY LICENSE No. 049468
LICENSED PROFESSIONAL ENGINEER

CERTIFICATE OF AUTHORIZATION NUMBER 24GA27916800

Garden State
ENGINEERING
SURVEYING
& PLANNING
OF NEW YORK, P.C.
Tel.: (212) 840-6331

DRAWN:	DF	PROJECT NAME:	CONTI COURTLANDT CORNERS NEW YORK, NY
DESIGNED:	--		
CHECKED:	AJF	PROJECT NO.:	NY08-103
APPROVED:	AJF	CLASSIFICATION:	N/A

DRAWING TITLE: AS BUILT FINAL EXCAVATION CORTLANDT CORNERS 1

REV. 8/20/09

DRAWING No.: NY08-103-221

0

X:\PROJECT\2008\NY08-103-CONTI-Cortlandt Corners\EP\CORTLAND CORNERS 1 VOLUME\VOL1 VOLUME C3D.dwg Sep 04, 2009-12:27AM